
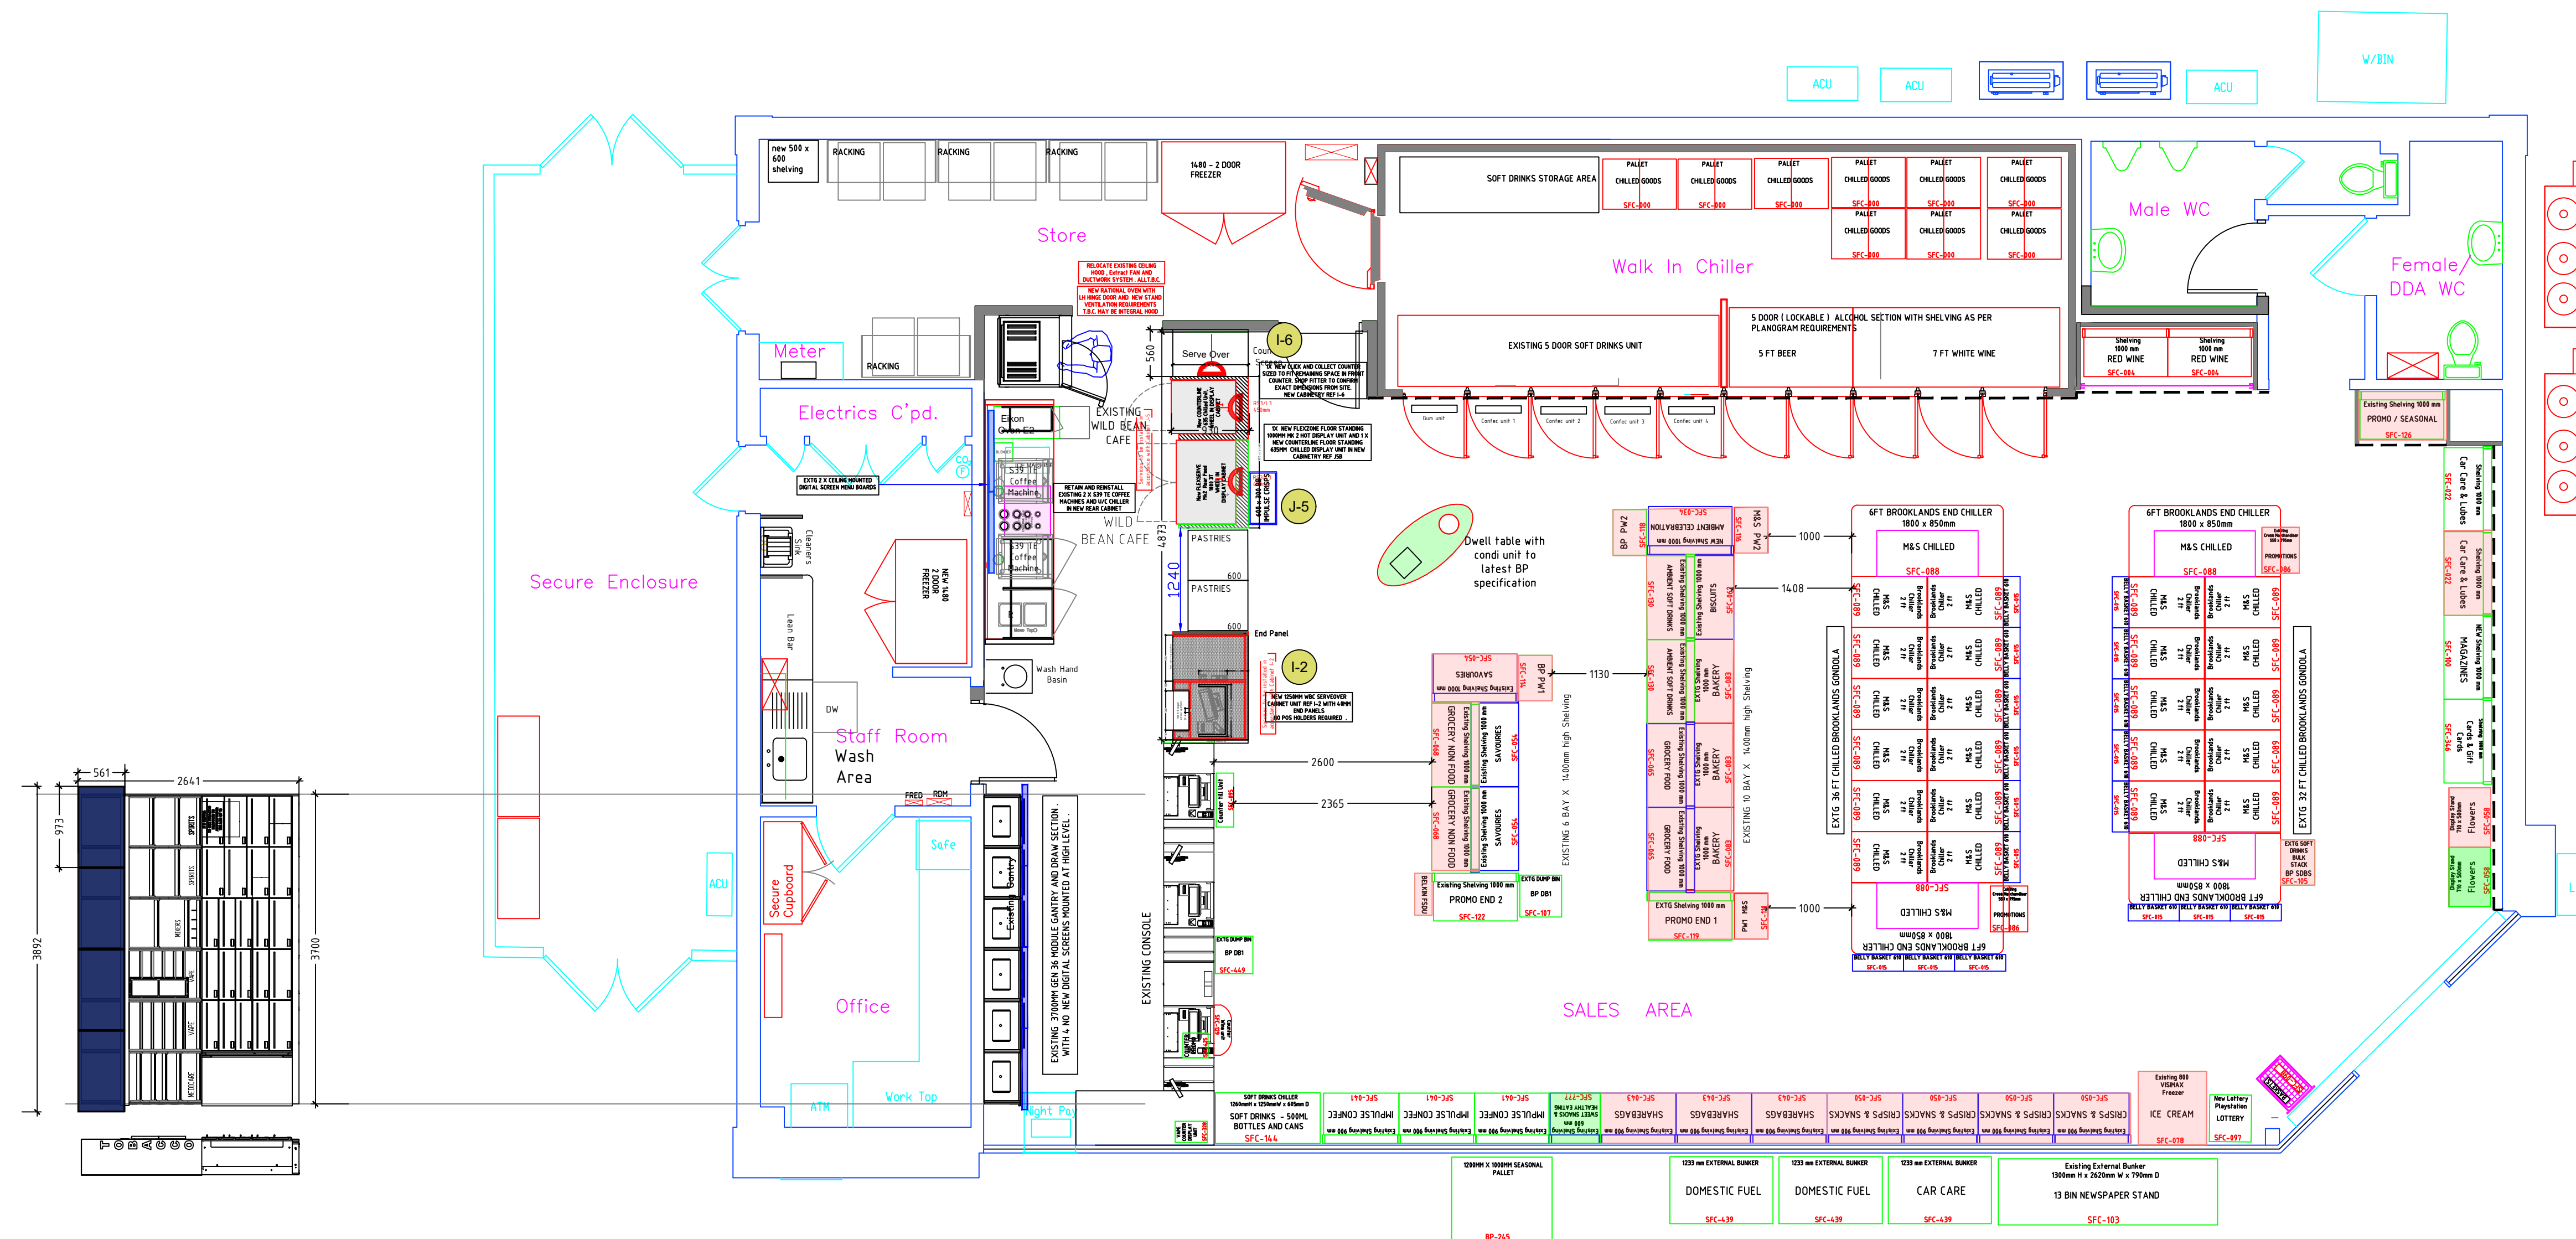
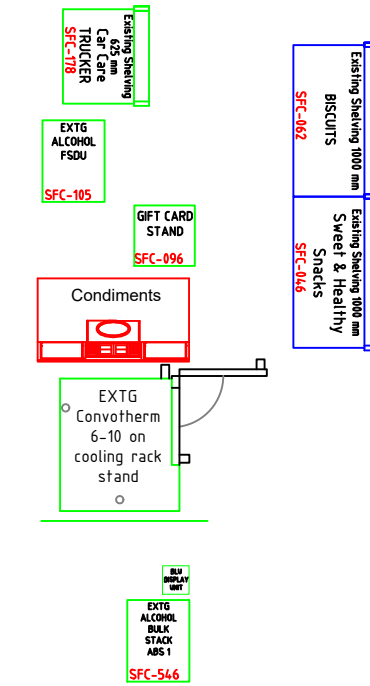


WAVENDON GATE SF CONNECT  
PROPOSED REFRSH , WILD BEAN REFIT AND COMMODITY  
LAYOUT - **APPROVED - 14.04.2022**


1. This drawing has been compiled from Construction Issue drawing details.
2. All reported deviations from the Construction issue drawings have been indicated on the As Built drawing.
3. Do not scale of this drawing

EQUIPMENT  
DELETIONS  
T.B.C.

## PROPOSED GENERAL LAYOUT

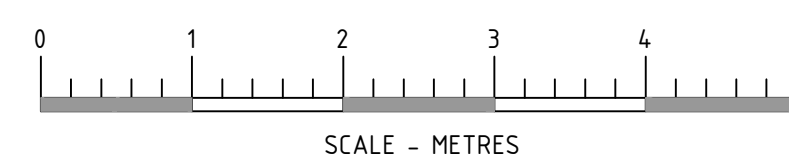

|           |      |                  |
|-----------|------|------------------|
| NR        | DATE | DESCRIPTION      |
| REVISIONS |      |                  |
| STATUS    |      | COMMODITY LAYOUT |

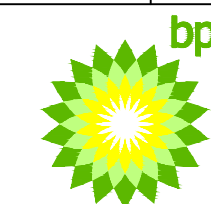

**BP OIL UK Ltd**  
Asset Development

**BP OIL UK Ltd**  
Asset Development  
WITAN GATE HOUSE  
MILTON KEYNES  
BUCKS MK9 1ES  
Tel No 01908 853000  
Fax No 01908 853999

Wavendon Gate SF Connect  
Newport Road,  
Wavendon,  
Milton Keynes, MK7 7AG

DRAWN: M.MERALI  
DATE: APR 2022  
DESIGN CHECKED: \*\*\*\*\*  
DATE: \*\*\*\*\*  
APPROVED: \*\*\*\*\*  
DATE: \*\*\*\*\*  
ATRACK CHECKED: \*\*\*\*\*  
DATE: \*\*\*\*\*  
SCALE: 1:50 at A1

SALES FLOOR PLAN  
PROPOSED COMMODITY AND  
WILD BEAN REFIT LAYOUT

|                 |     |
|-----------------|-----|
| DRAWING NUMBER  | REV |
| 10571-72 - SFCL | -   |

ARCHITECT:

This drawing has been produced in accordance with BP Oil UK Ltd retail design standards & current legal requirements.  
Copyright of BP Oil UK Ltd. Illegal use is prohibited. Reproduction only with permission of BP Oil UK Ltd.  
BP Oil UK Ltd, Asset Development, 500-600 Witan Gate West, Milton Keynes, MK9 1ES