


ORIGINAL

ORIGINAL

E:\04-DIR\01090603 CLPC Issues\SLA 108 (FBO)Plan-01-FBO REDIVIDE.dwg, Layout1, 10/17/2012 9:31:04 AM, lnc

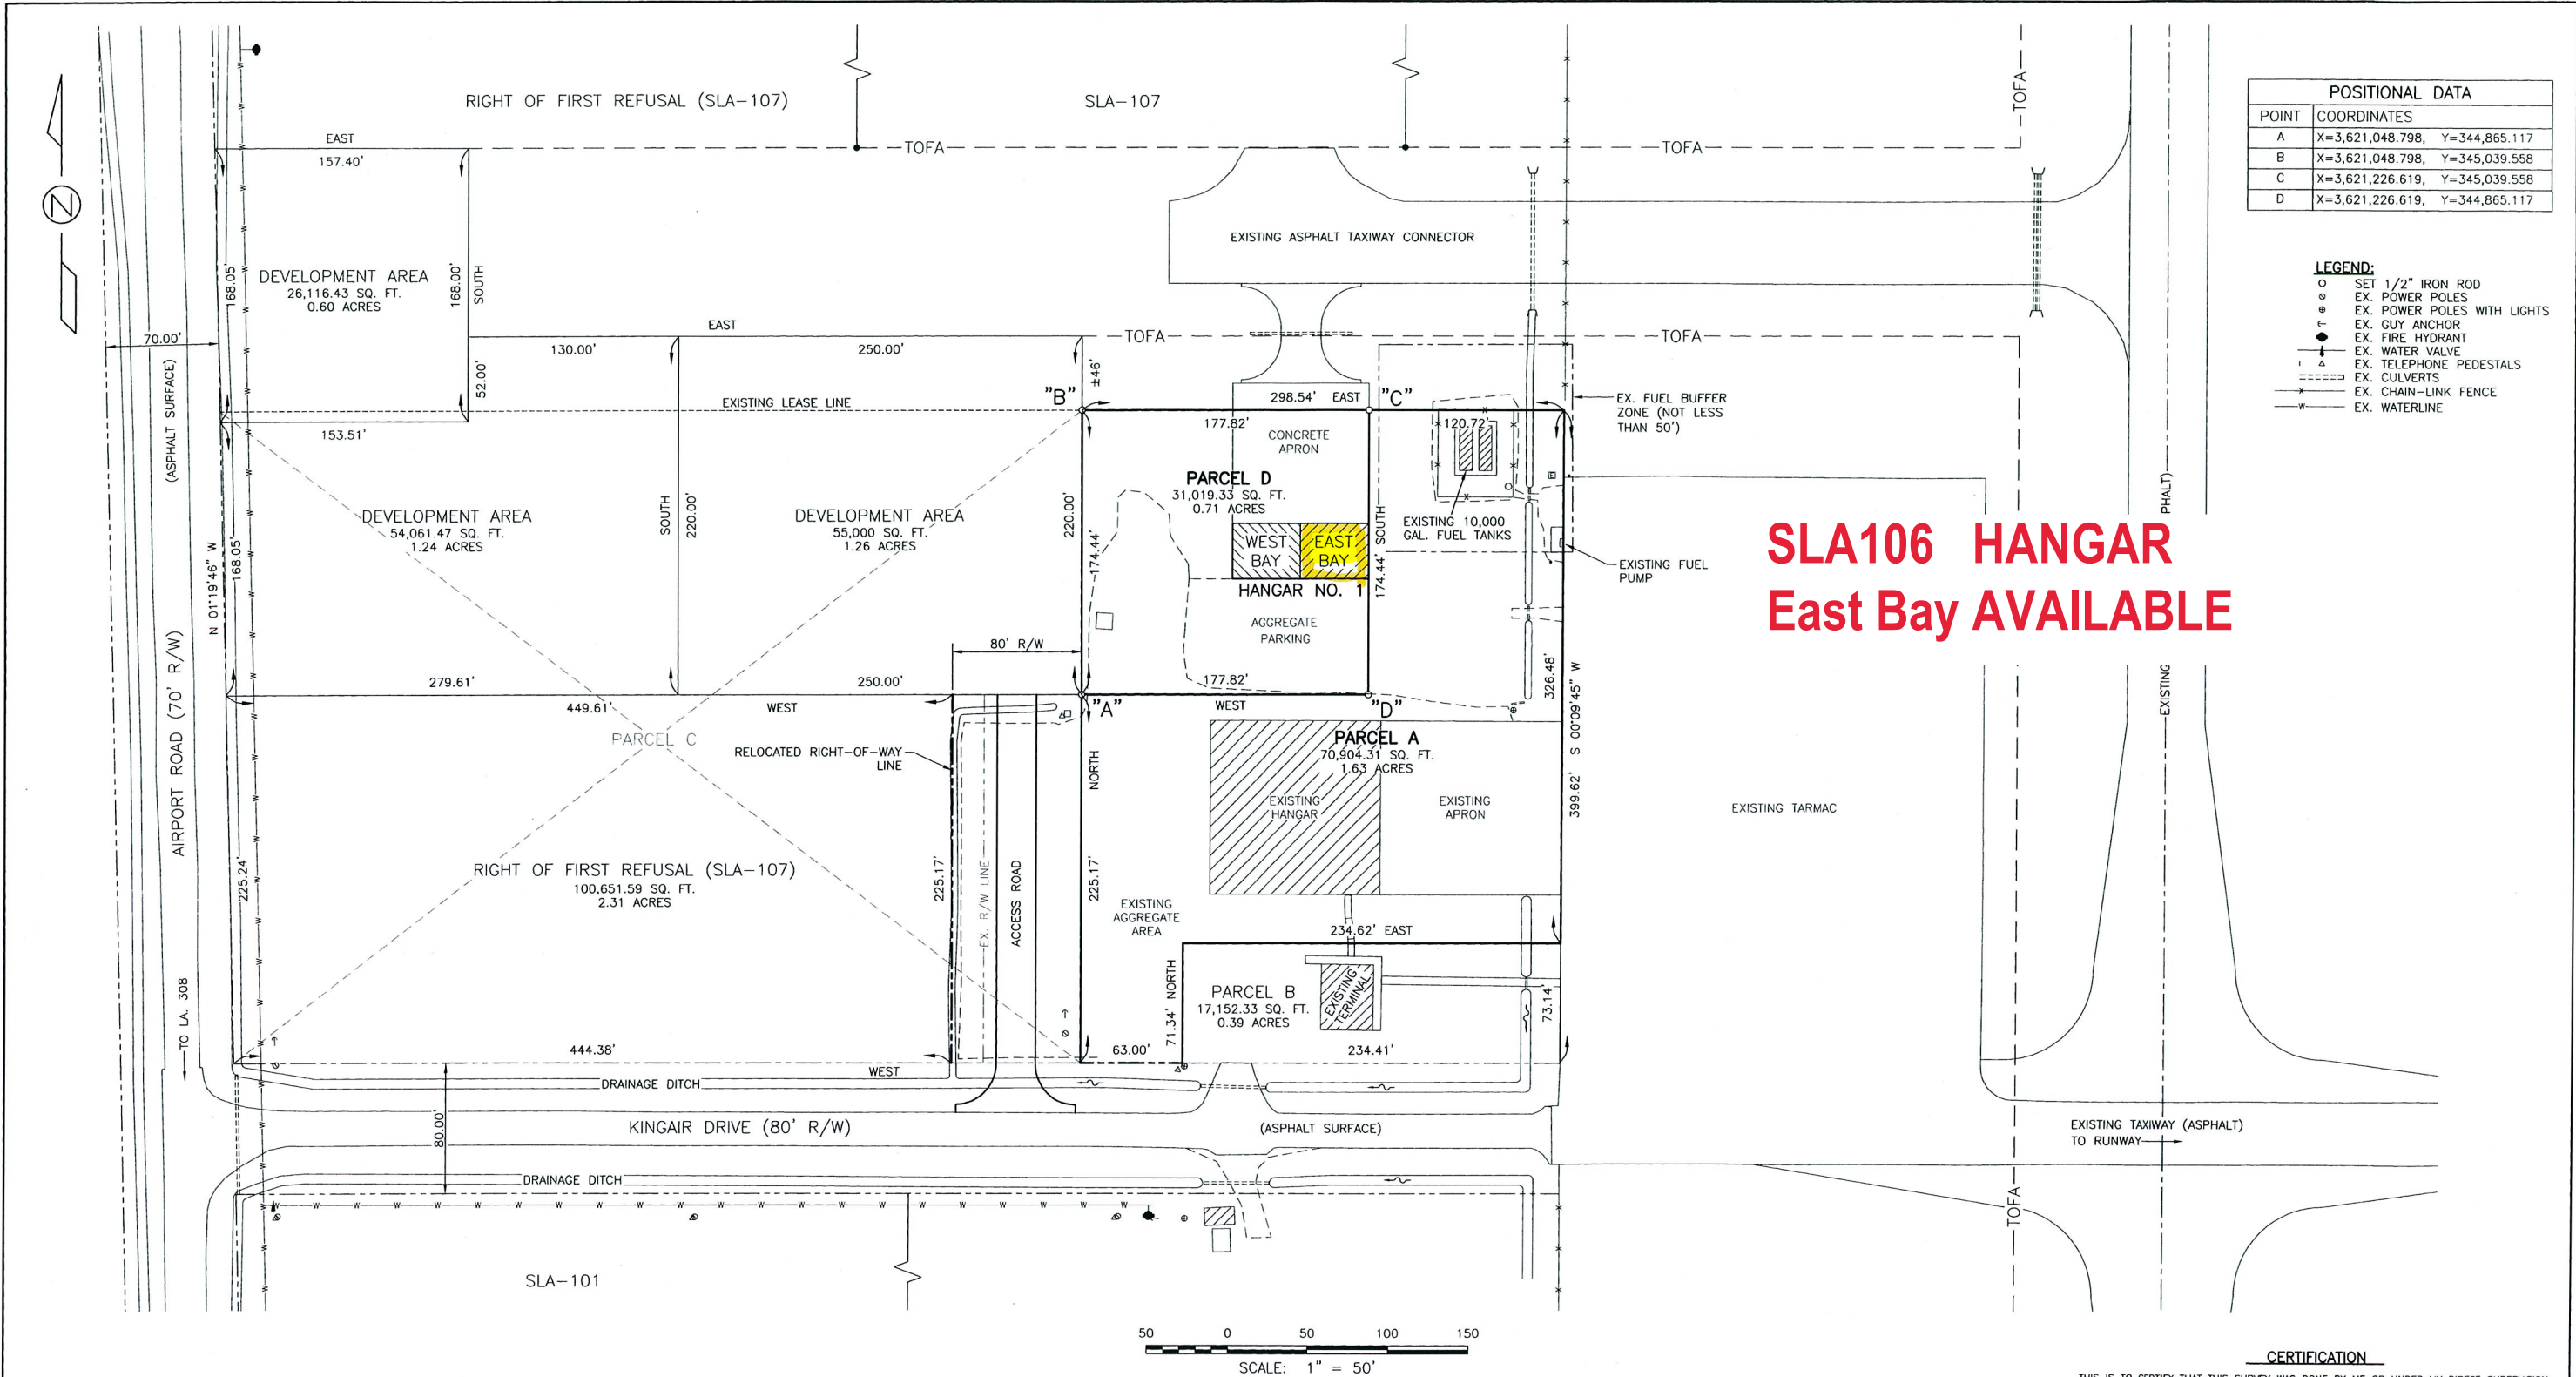

POSITIONAL DATA		
POINT	COORDINATES	
A	X=3,621,048.798,	Y=344,865.117
B	X=3,621,048.798,	Y=345,039.558
C	X=3,621,226.619,	Y=345,039.558
D	X=3,621,226.619,	Y=344,865.117

LEGEND:

- SET 1/2" IRON ROD
- EX. POWER POLES
- EX. POWER POLES WITH LIGHTS
- EX. GUY ANCHOR
- EX. FIRE HYDRANT
- EX. WATER VALVE
- EX. TELEPHONE PEDESTALS
- EX. CULVERTS
- EX. CHAIN-LINK FENCE
- EX. WATERLINE

GENERAL NOTES:

- NO TITLE RESEARCH WAS REQUESTED OR DONE FOR THE INVESTIGATION OF ANY RIGHT-OF-WAYS OR SERVITUDES WHICH MAY AFFECT THE PROPERTY BEING SURVEYED. THEREFORE, EXISTING RIGHT-OF-WAYS OR SERVITUDES ARE NOT SHOWN (IF ANY).
- THE SURVEY OF THIS PROPERTY MAY INCLUDE VISIBLE TOPOGRAPHIC FEATURES. SUB-SURFACE UTILITIES, PIPELINES AND STRUCTURES WERE NOT LOCATED AND ARE NOT SHOWN UNLESS REQUESTED BY THE CLIENT.
- BEARINGS AND COORDINATES ARE BASED ON LOUISIANA STATE PLANE, 1702 LOUISIANA SOUTH ZONE, U.S. SURVEY FEET, NAD 83 (2011) EPOCH 2010.00. VRS PROVIDER IS C4G.
- IF APPLICABLE, SHOWN COORDINATES INDICATE PROPERTY LINE CORNERS. THESE COORDINATES DO NOT INDICATE THE LOCATION OF THE ACTUAL SURVEY MARKER ITSELF. SURVEY MARKERS MAY BE SLIGHTLY OFF OF ACTUAL PROPERTY LINE CORNERS.

REFERENCE MAPS:

- PLAT PREPARED BY PICCIOLA & ASSOCIATES, INC. DATED DECEMBER 14, 2009 AND TITLED "SOUTH LAFOURCHE LEONARD MILLER, JR. AIRPORT", SURVEY PLAT SHOWING PROPERTY OWNED BY THE SOUTH LAFOURCHE LEONARD MILLER, JR. AIRPORT WHICH SHALL BE DESIGNATED AS PARCEL "A"(SLA-108), PARCEL "B" (TERMINAL AREA) AND PARCEL "C" (DEVELOPMENT AREA). BEING IN T-19-S, R-22-E.

CERTIFICATION

THIS IS TO CERTIFY THAT THIS SURVEY WAS DONE BY ME OR UNDER MY DIRECT SUPERVISION AND CONTROL, THAT THE SURVEY WAS DONE ON THE GROUND AND WAS DONE IN ACCORDANCE WITH THE MOST RECENT MINIMUM STANDARDS OF PRACTICE FOR LAND SURVEYORS AS SET FORTH BY THE STATE OF LOUISIANA, BOARD OF REGISTRATION FOR PROFESSIONAL ENGINEERS AND LAND SURVEYORS AND THAT THE ACCURACY SPECIFICATIONS AND POSITIONAL TOLERANCES ARE IN ACCORDANCE WITH A CLASS "C" SURVEY INDICATED IN THE ABOVE STANDARDS.

APPROVED BY:

JOSEPH E. PICCIOLA, II, L.S.
LA. LICENSE NO. 4916
LAND SURVEYOR

EXHIBIT "A"

REVISIONS:	
DATE:	REMARKS:

STAMP:



PICCIOLA & ASSOCIATES, INC.
CIVIL ENGINEERS
LAND SURVEYORS
NAVAL ARCHITECTS
MARINE ENGINEERS

P.O. BOX. 687
CUT OFF, LOUISIANA 70345
(985) 632-5786

DESIGNED BY:
J.C.P.

DRAWN BY:
L.J.G.

CHECKED BY:
J.C.P.

DATE:

OCTOBER 17, 2012

SCALE:

AS SHOWN

SOUTH LAFOURCHE LEONARD MILLER, JR. AIRPORT

PLAT SHOWING THE RE-DIVISION OF PARCEL "A" (SLA-108) AND THE EAST AND WEST BAYS OF HANGAR NO. 1 BELONGING TO THE SOUTH LAFOURCHE LEONARD MILLER, JR. AIRPORT. LOCATED IN T-19-S, R-22-E.

GALLIANO, LA.

LAFOURCHE PARISH


SHEET NO.

1 OF 1

J.N. 0109-0603

ORIGINAL

E:\10-DIR\09151002 GLPC - Small Hangar Foundation\ACAD\AS BUILT\07_13-SHT_HANGAR.dwg, 07-SHT_FLOOR PLAN, 10/2/2012 11:12:28 AM

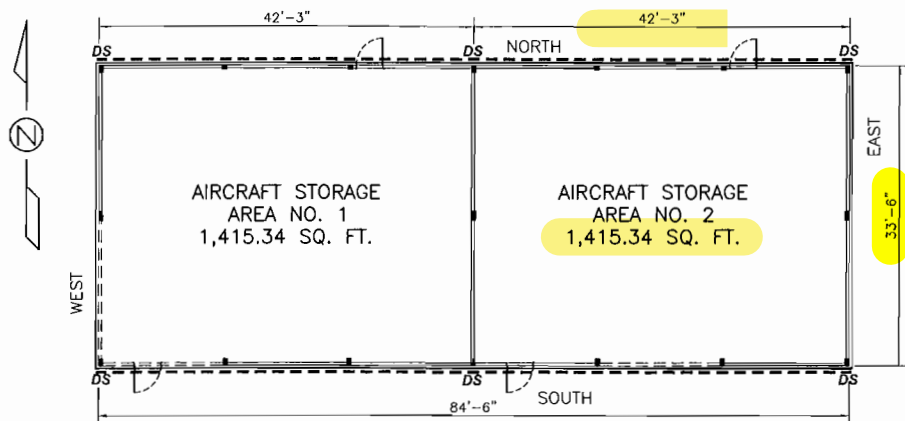

TOTAL AREA:
2,831.68 SQ. FT.

HANGAR KEY PLAN
SCALE: 3/32" = 1'-0"

SCHEDULE OF ELECTRICAL SYMBOLS

SYMBOL	DESCRIPTION
S3	THREE POLE TOGGLE SWITCH
D	HANGAR DOOR OPERATOR, 3/4HP, 240V, 6.9 AMP, SINGLE PHASE MOTOR
PB	24V, PUSH BUTTON STATION-UP/DOWN (HANGAR DR)
⊕	LIGHTING FIXTURE, WALL MOUNTED W/BACKUP BATTERY
⊕	TWO(2) LAMP EXIT-UNIT EMERGENCY LIGHT COMBO W/BACKUP BATTERY
M	400W, LOW BAY, METAL HALIDE LIGHTING FIXTURE
G	GROUNDING WELL


APPROVED HANDHELD FIRE EXTINGUISHER TYPE 4A:80B:C (WALL MOUNTED)
*TOP OF FIRE EXTINGUISHER SHALL BE MOUNTED NOT MORE THAN 5' ABOVE FINISHED FLOOR ELEVATION.

LEGEND:


+3.33 FINISHED FOUNDATION ELEVATIONS
DS DOWN SPOUT LOCATIONS
--- GUTTER LOCATIONS

ELECTRICAL DEMAND LOAD

#1 DEMAND	7662VA
#2 DEMAND	7558VA

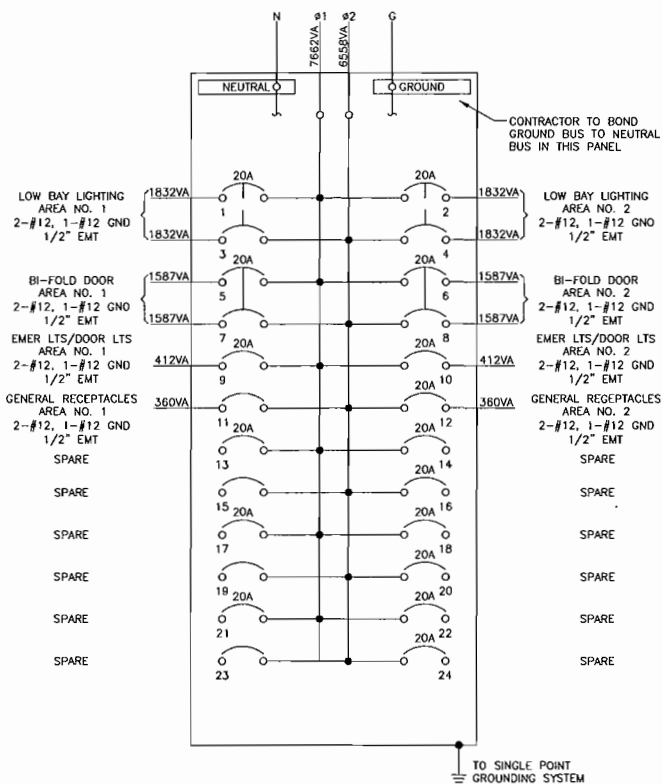

PANEL SCHEDULE-PANEL A
NOT TO SCALE

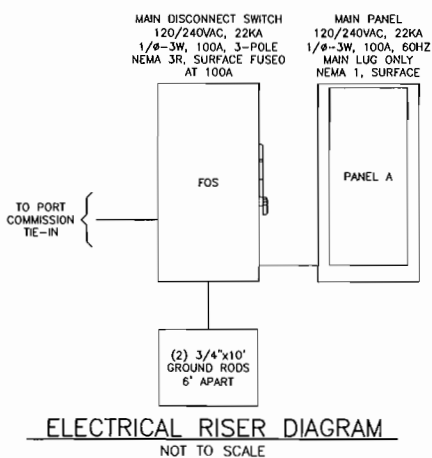

ELECTRICAL RISER DIAGRAM
NOT TO SCALE


EQUIPMENT RATING NOTES:

ALL SERVICE EQUIPMENT SHALL HAVE SHORT CIRCUIT WITHSTAND AND INTERRUPTING RATINGS EXCEEDING THE MAXIMUM AVAILABLE FAULT CURRENT. CONTRACTOR SHALL VERIFY THE MAXIMUM AVAILABLE FAULT CURRENT FROM THE LOCAL SERVICE PROVIDER.

SCHEDULE OF FINISHES

AREAS	WALLS	FLOORING	CEILING	BASE	CEILING HT.
AIRCRAFT STORAGE AREA NO. 1	26 GA. METAL "R" PANELS	CONCRETE (NON-SLIP BROOM FINISH)	26 GA. METAL "R" PANELS	N/A	VARIES
AIRCRAFT STORAGE AREA NO. 2	26 GA. METAL "R" PANELS	CONCRETE (NON-SLIP BROOM FINISH)	26 GA. METAL "R" PANELS	N/A	VARIES

CENTER PARTITION: 29 GA. METAL "R" PANELS (FULL HEIGHT)

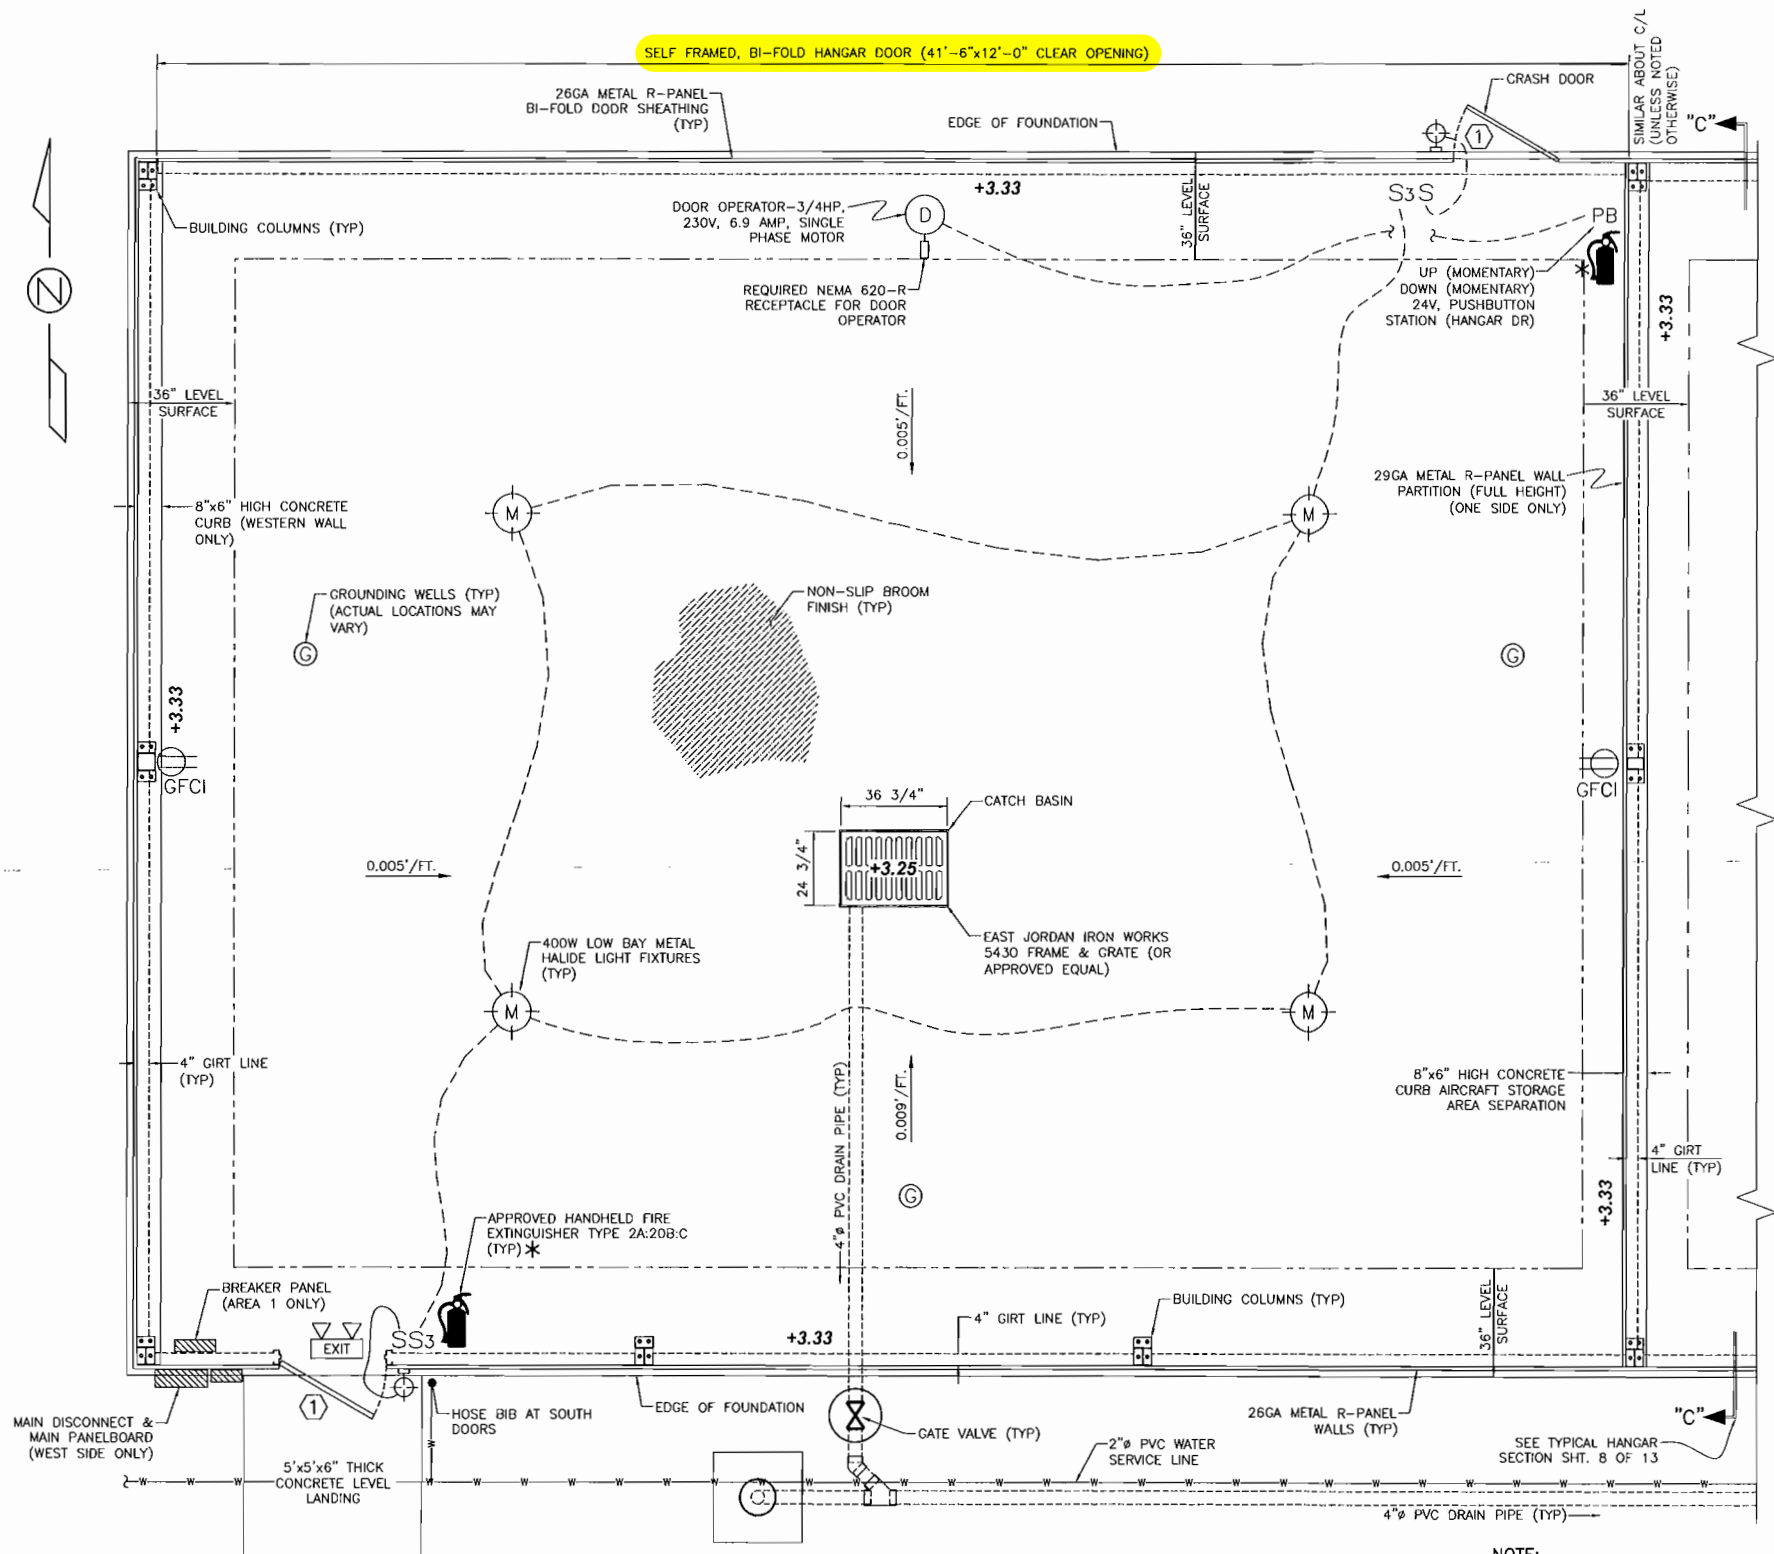


SMALL HANGAR-TYPICAL AIRCRAFT STORAGE AREA FLOOR PLAN
(AIRCRAFT STORAGE AREA NO. 1 SHOWN, AREA NO. 2 SIMILAR)
SCALE: 3/8" = 1'-0"

SCHEDULE OF OPENINGS

MARK	SIZE	QTY.	DESCRIPTION
①	3'-0"x6'-8"x1 3/4"	4	INSULATED, FLUSH METAL DOOR & FRAME WITH MINIMUM 1 1/2"HR FIRE RATING
②	41'-6"x12'-0" (CLEAR)	2	ERECT-A-TUBE, INC. BI-FOLD, SELF FRAMED DOOR SYSTEM (OR APPROVED EQUAL) WIND RATED FOR +46 PSF / -20 PSF

NOTE:
CONTRACTOR SHALL COORDINATE ELECTRICAL SERVICE TIE-IN WITH GREATER LAFOURCHE PORT COMMISSION.

REVISIONS:	REMARKS:
04-25-2011	REVISED AS PER FIRE MARSHAL COMMENTS, REVISED FOUNDATION
05-12-2011	REVISED ELECTRICAL PANEL AND DEMAND LOAD, ADDED RECEPTACLES
06-06-2011	REVISED AS PER FIRE MARSHAL & PLANNING COMMISSION COMMENTS
08-15-2011	REVISED TO INCLUDE METAL BUILDING IN SCOPE OF PROJECT
10-12-2011	ISSUED FOR CONSTRUCTION
10-02-2012	AS-BUILT

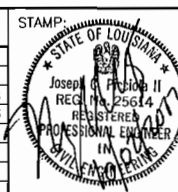

PICCIOLA & ASSOCIATES, INC.
CIVIL ENGINEERS
LAND SURVEYORS
NAVAL ARCHITECTS
MARINE ENGINEERS
P.O. BOX 687
CUT OFF, LOUISIANA 70345
(985) 632-5786
DESIGNED BY: J.C.P.
DRAWN BY: L.J.G.
CHECKED BY: M.V.G.

DATE:
MARCH 2, 2011
SCALE:
AS SHOWN

GREATER LAFOURCHE PORT COMMISSION
SMALL HANGAR AT SOUTH LAFOURCHE LEONARD MILLER, JR. AIRPORT
PHASE II-HANGAR, APRON & TAXIWAY CONNECTOR
HANGAR-FLOOR PLAN
GALLIANO, LA
LAFOURCHE PARISH

SHEET NO.
7 OF 13

AS-BUILT

DRAWING PLOTTED AT HALF SCALE



EAST BAY

1321



