

PROJECT: Prairie Wind Barn
SCOPE: AS BUILT DRAWINGS

Bay & Bent


80 Old Gate Road,
Penn Run PA, 15765

DAN TRIMBLE
AA66 / TIMBER HOME SERVICES

CELL PHONE/TEXT - 412-309-1161

EMAIL:

DANTRIMBLE@TIMBERHOMESERVICES.COM

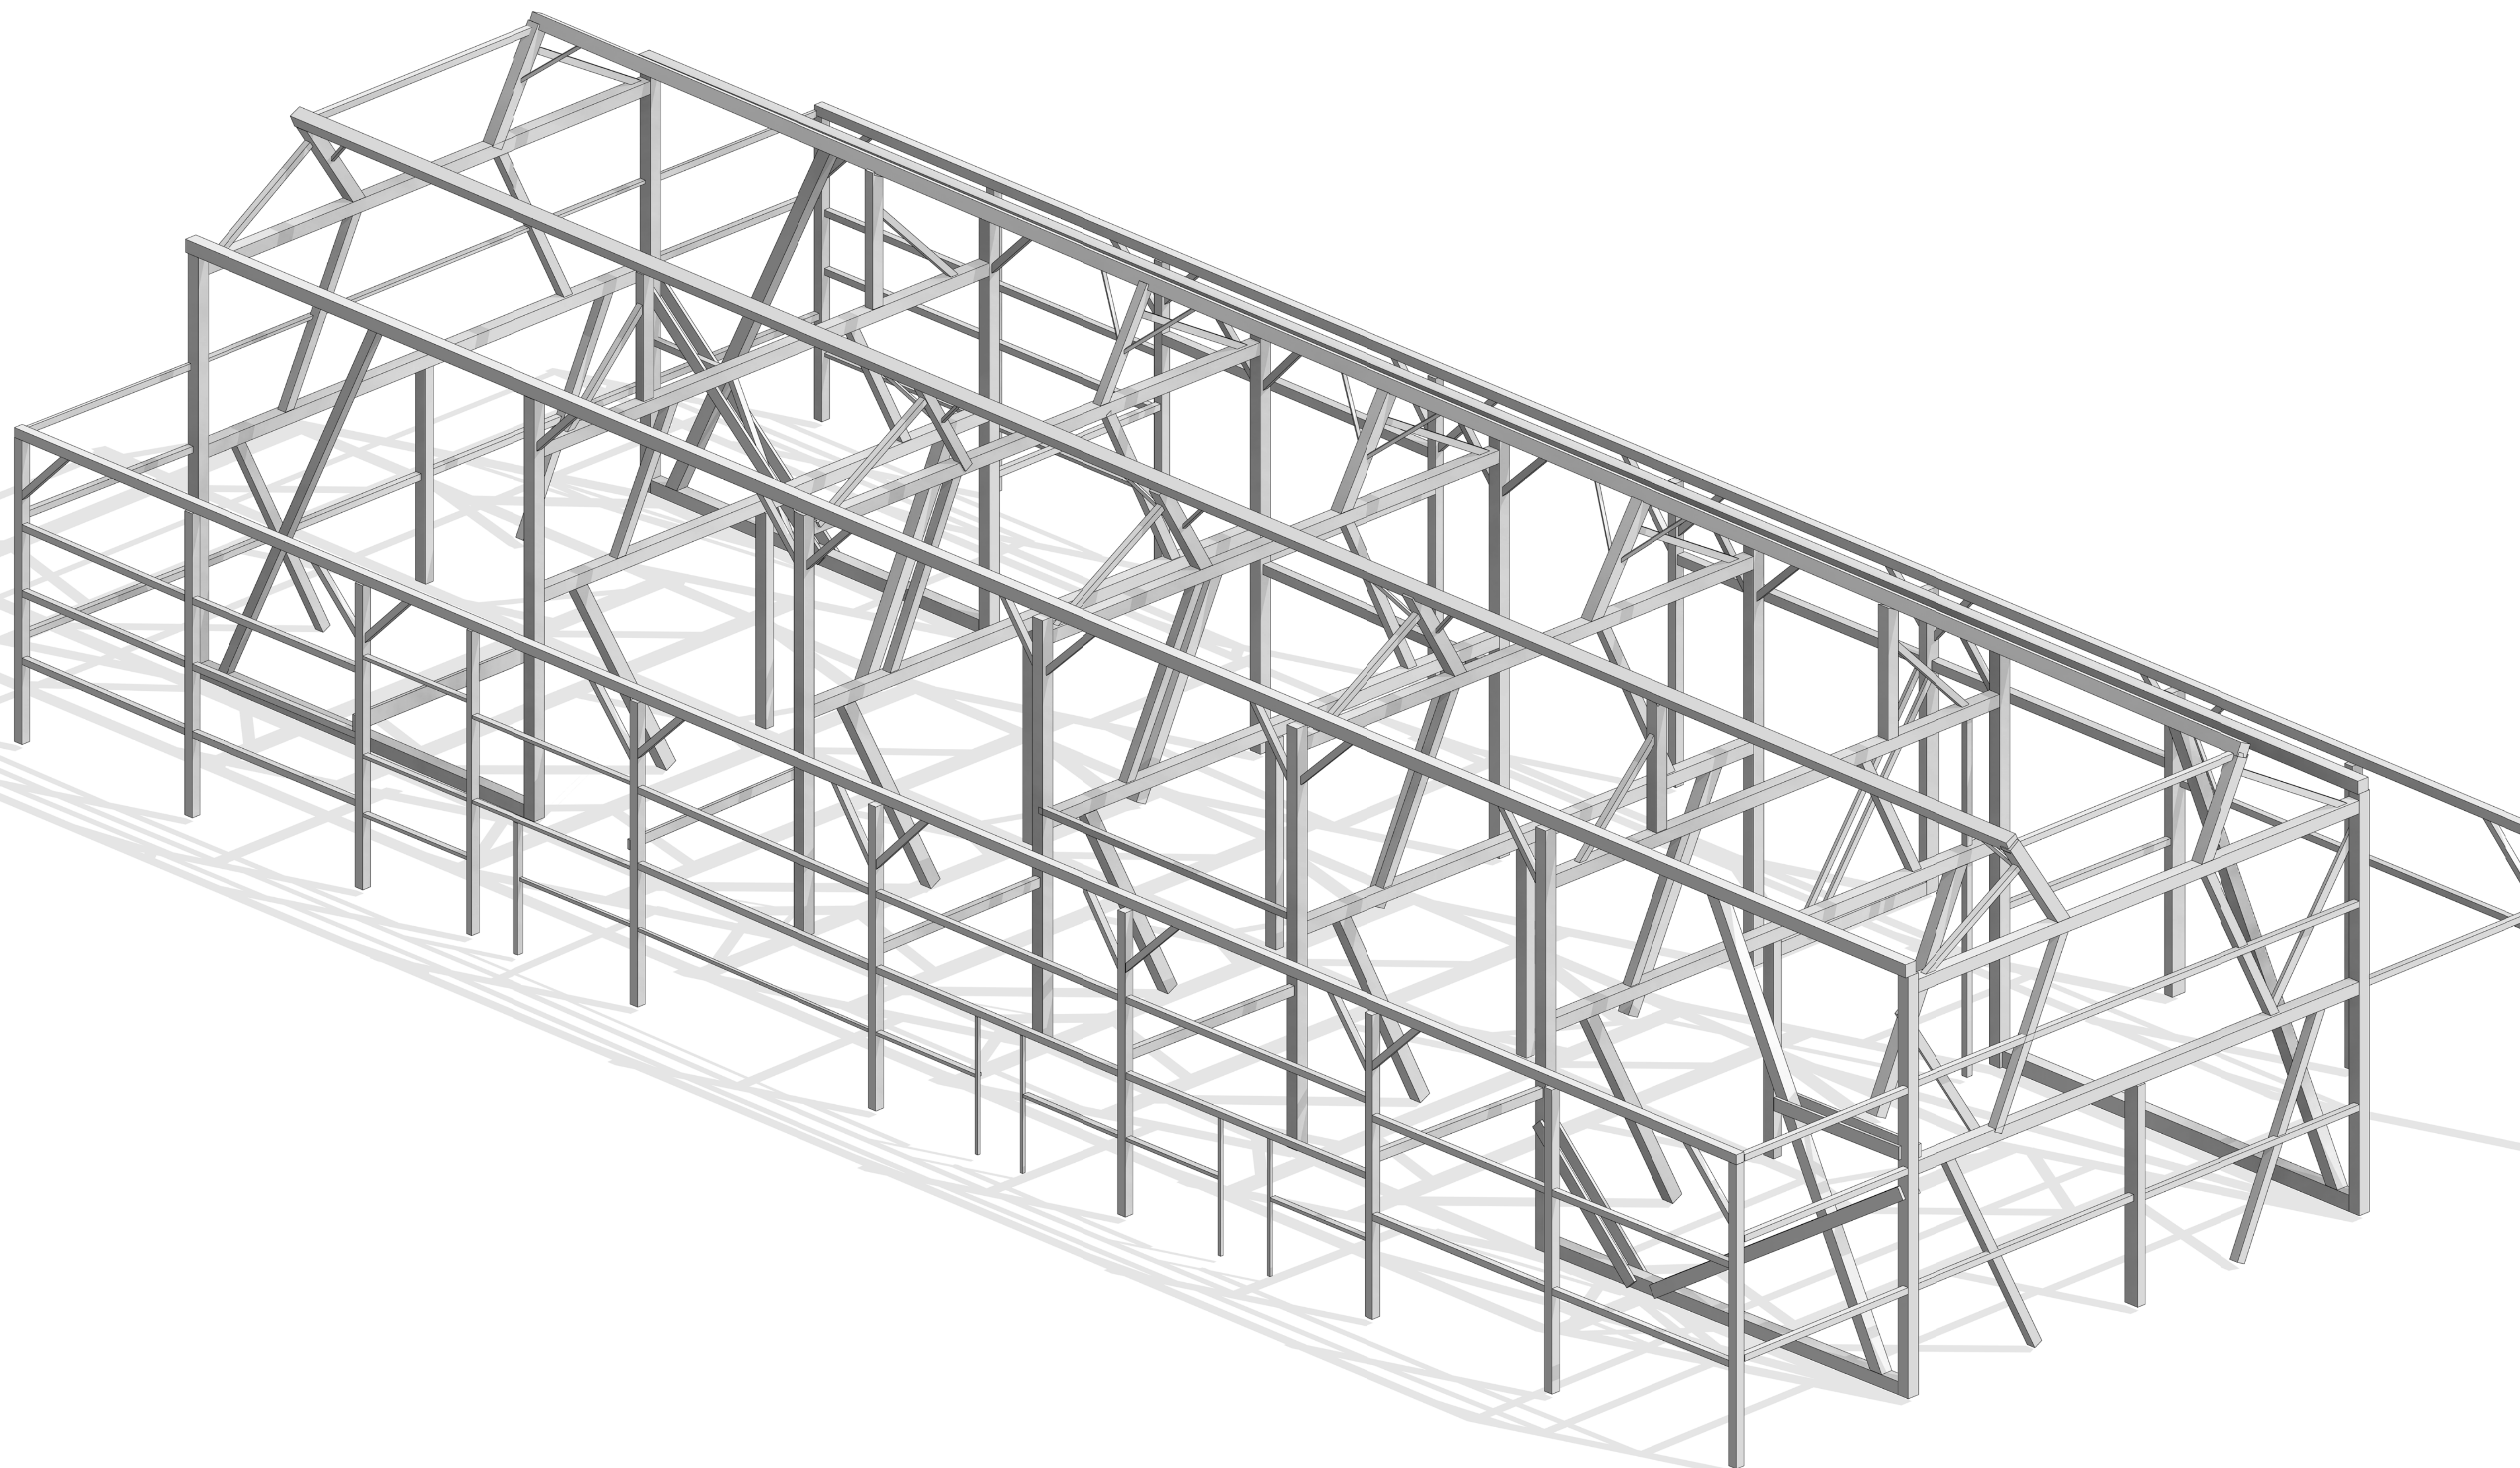

Cover Page

Project Number Project 5

Date 20240902

Drawn By

Checked By

A101

Scale

Bay & Bent


80 Old Gate Road,
Penn Run PA, 15765

DAN TRIMBLE
AA66 / TIMBER HOME SERVICES

CELL PHONE/TEXT - 412-309-1161

EMAIL:

DANTRIMBLE@TIMBERHOMESERVICES.COM

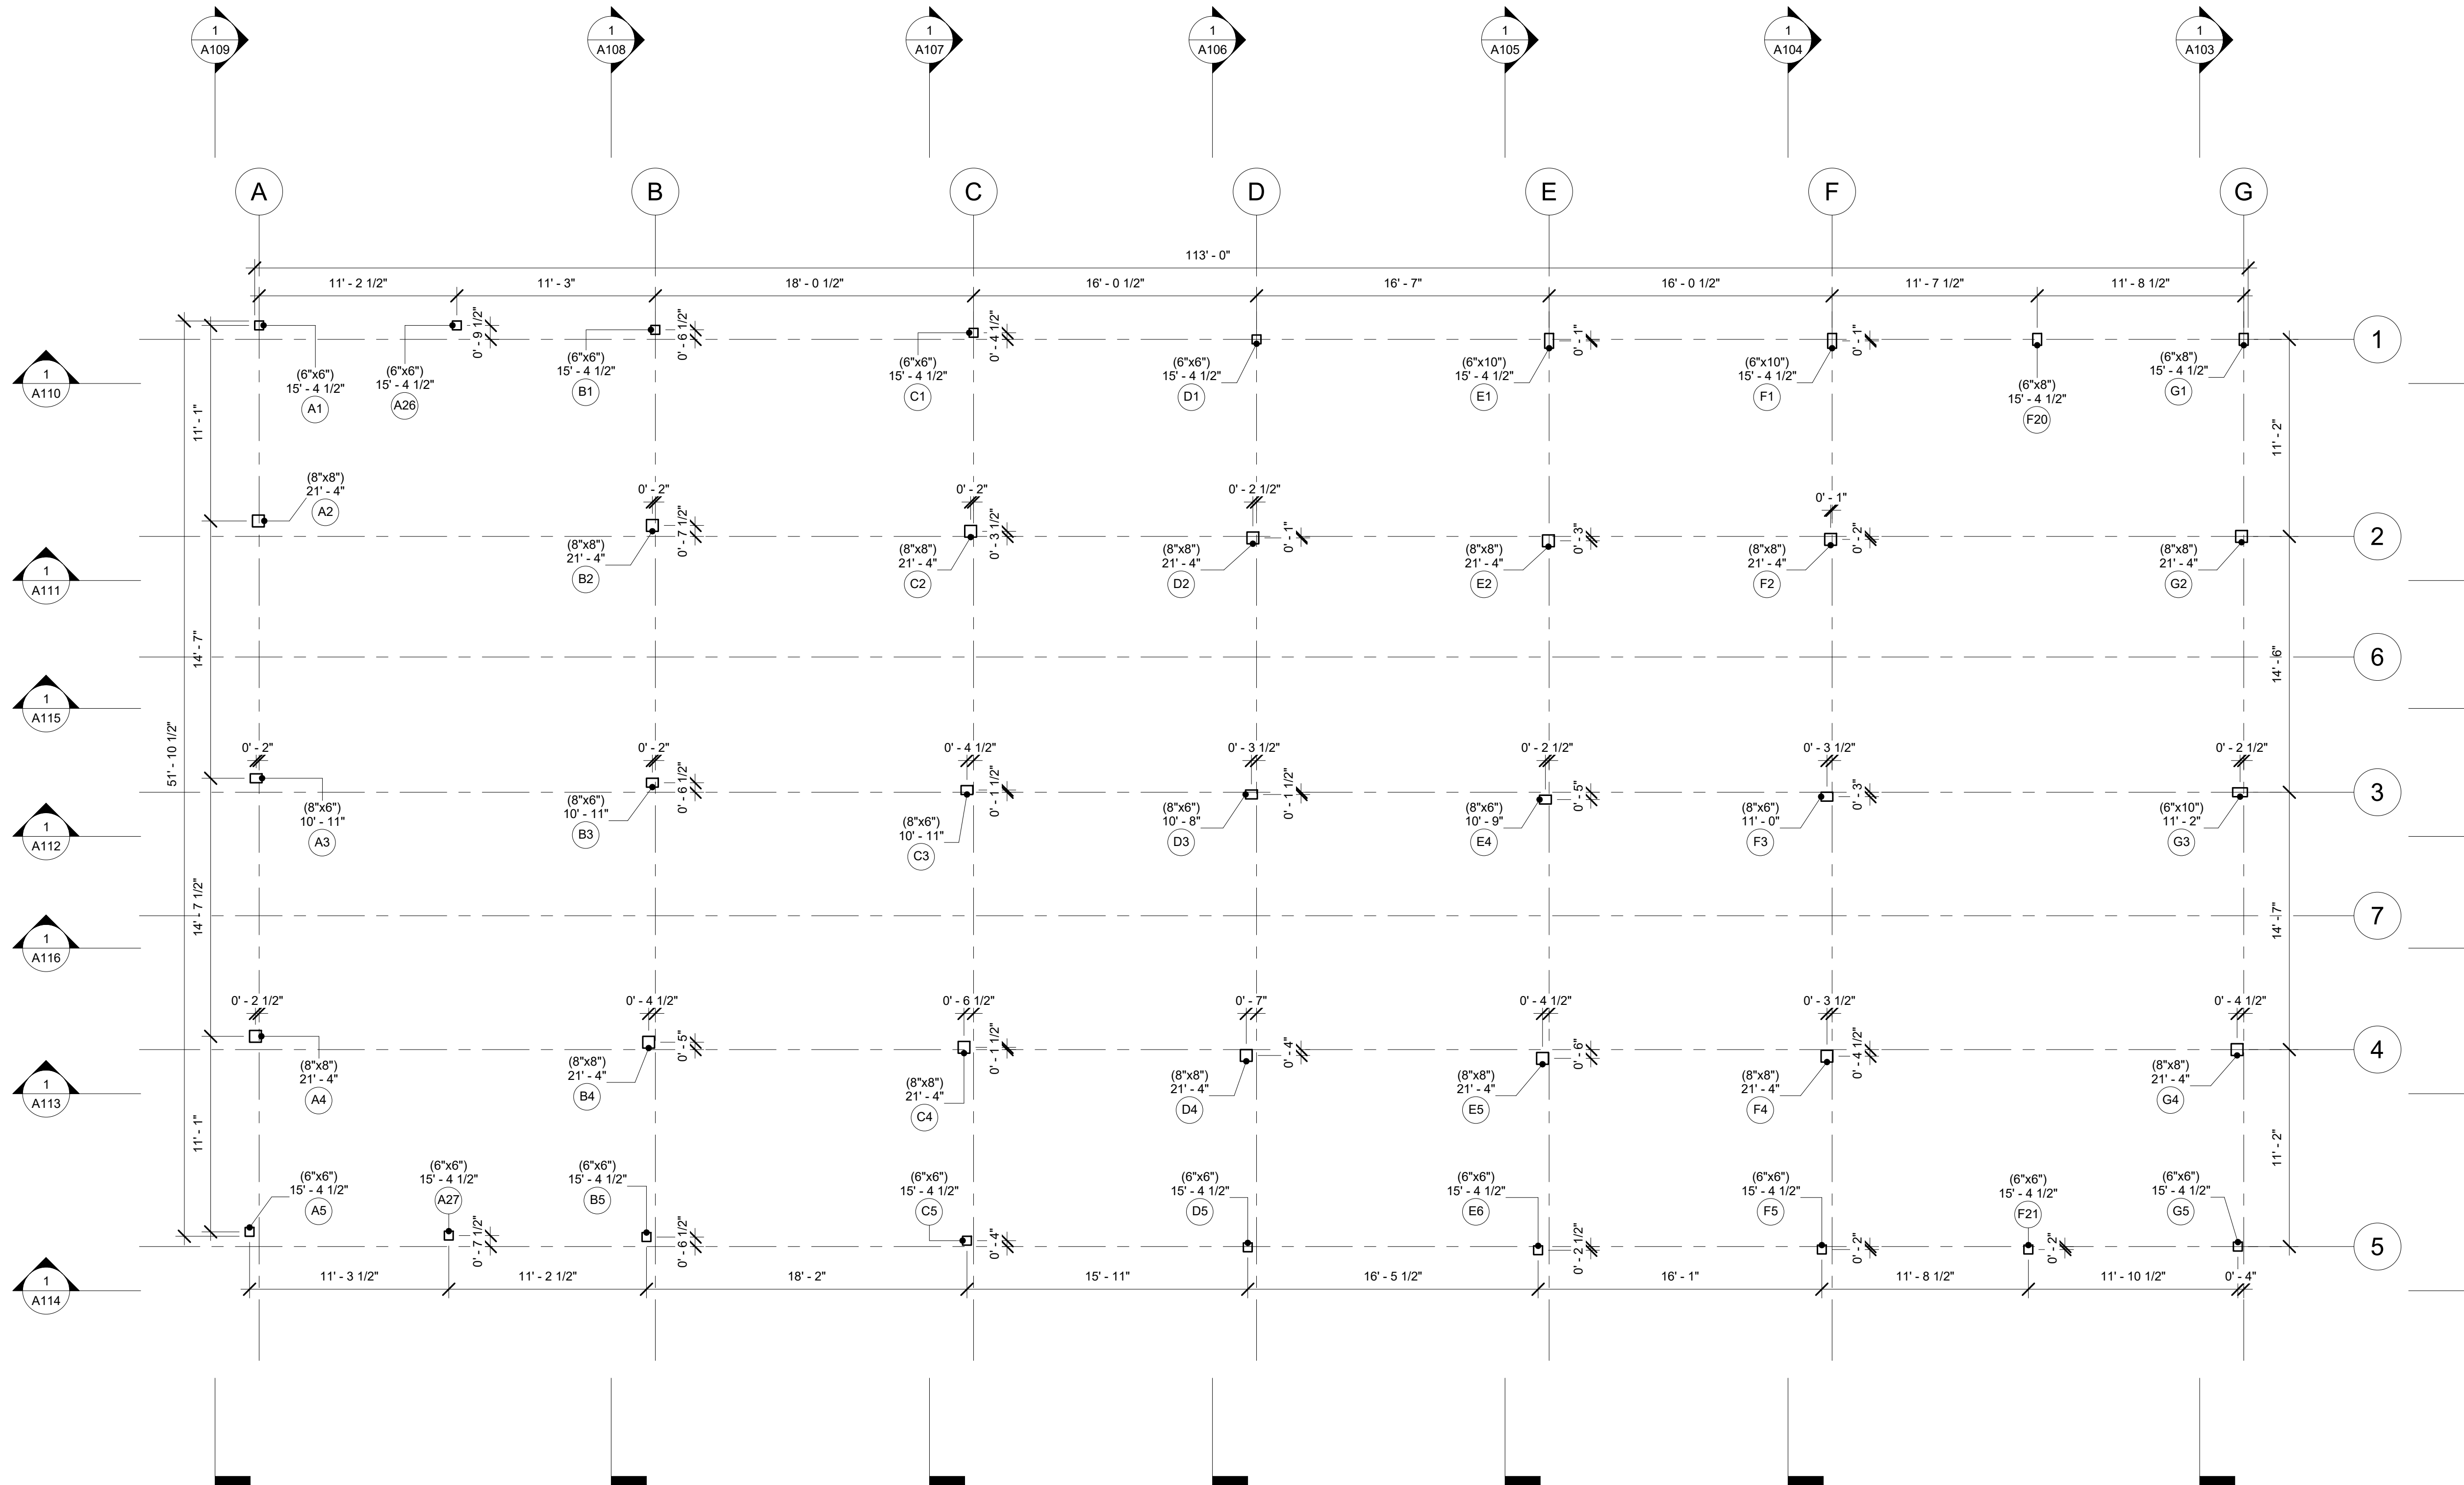

Floor Plan

Project Number Project 5

Date 20240902

Drawn By

Checked By

A102

Scale 3/16" = 1'-0"

Bay & Bent


80 Old Gate Road,
Penn Run PA, 15765

DAN TRIMBLE
AA66 / TIMBER HOME SERVICES

CELL PHONE/TEXT - 412-309-1161

EMAIL:

DANTRIMBLE@TIMBERHOMESERVICES.COM

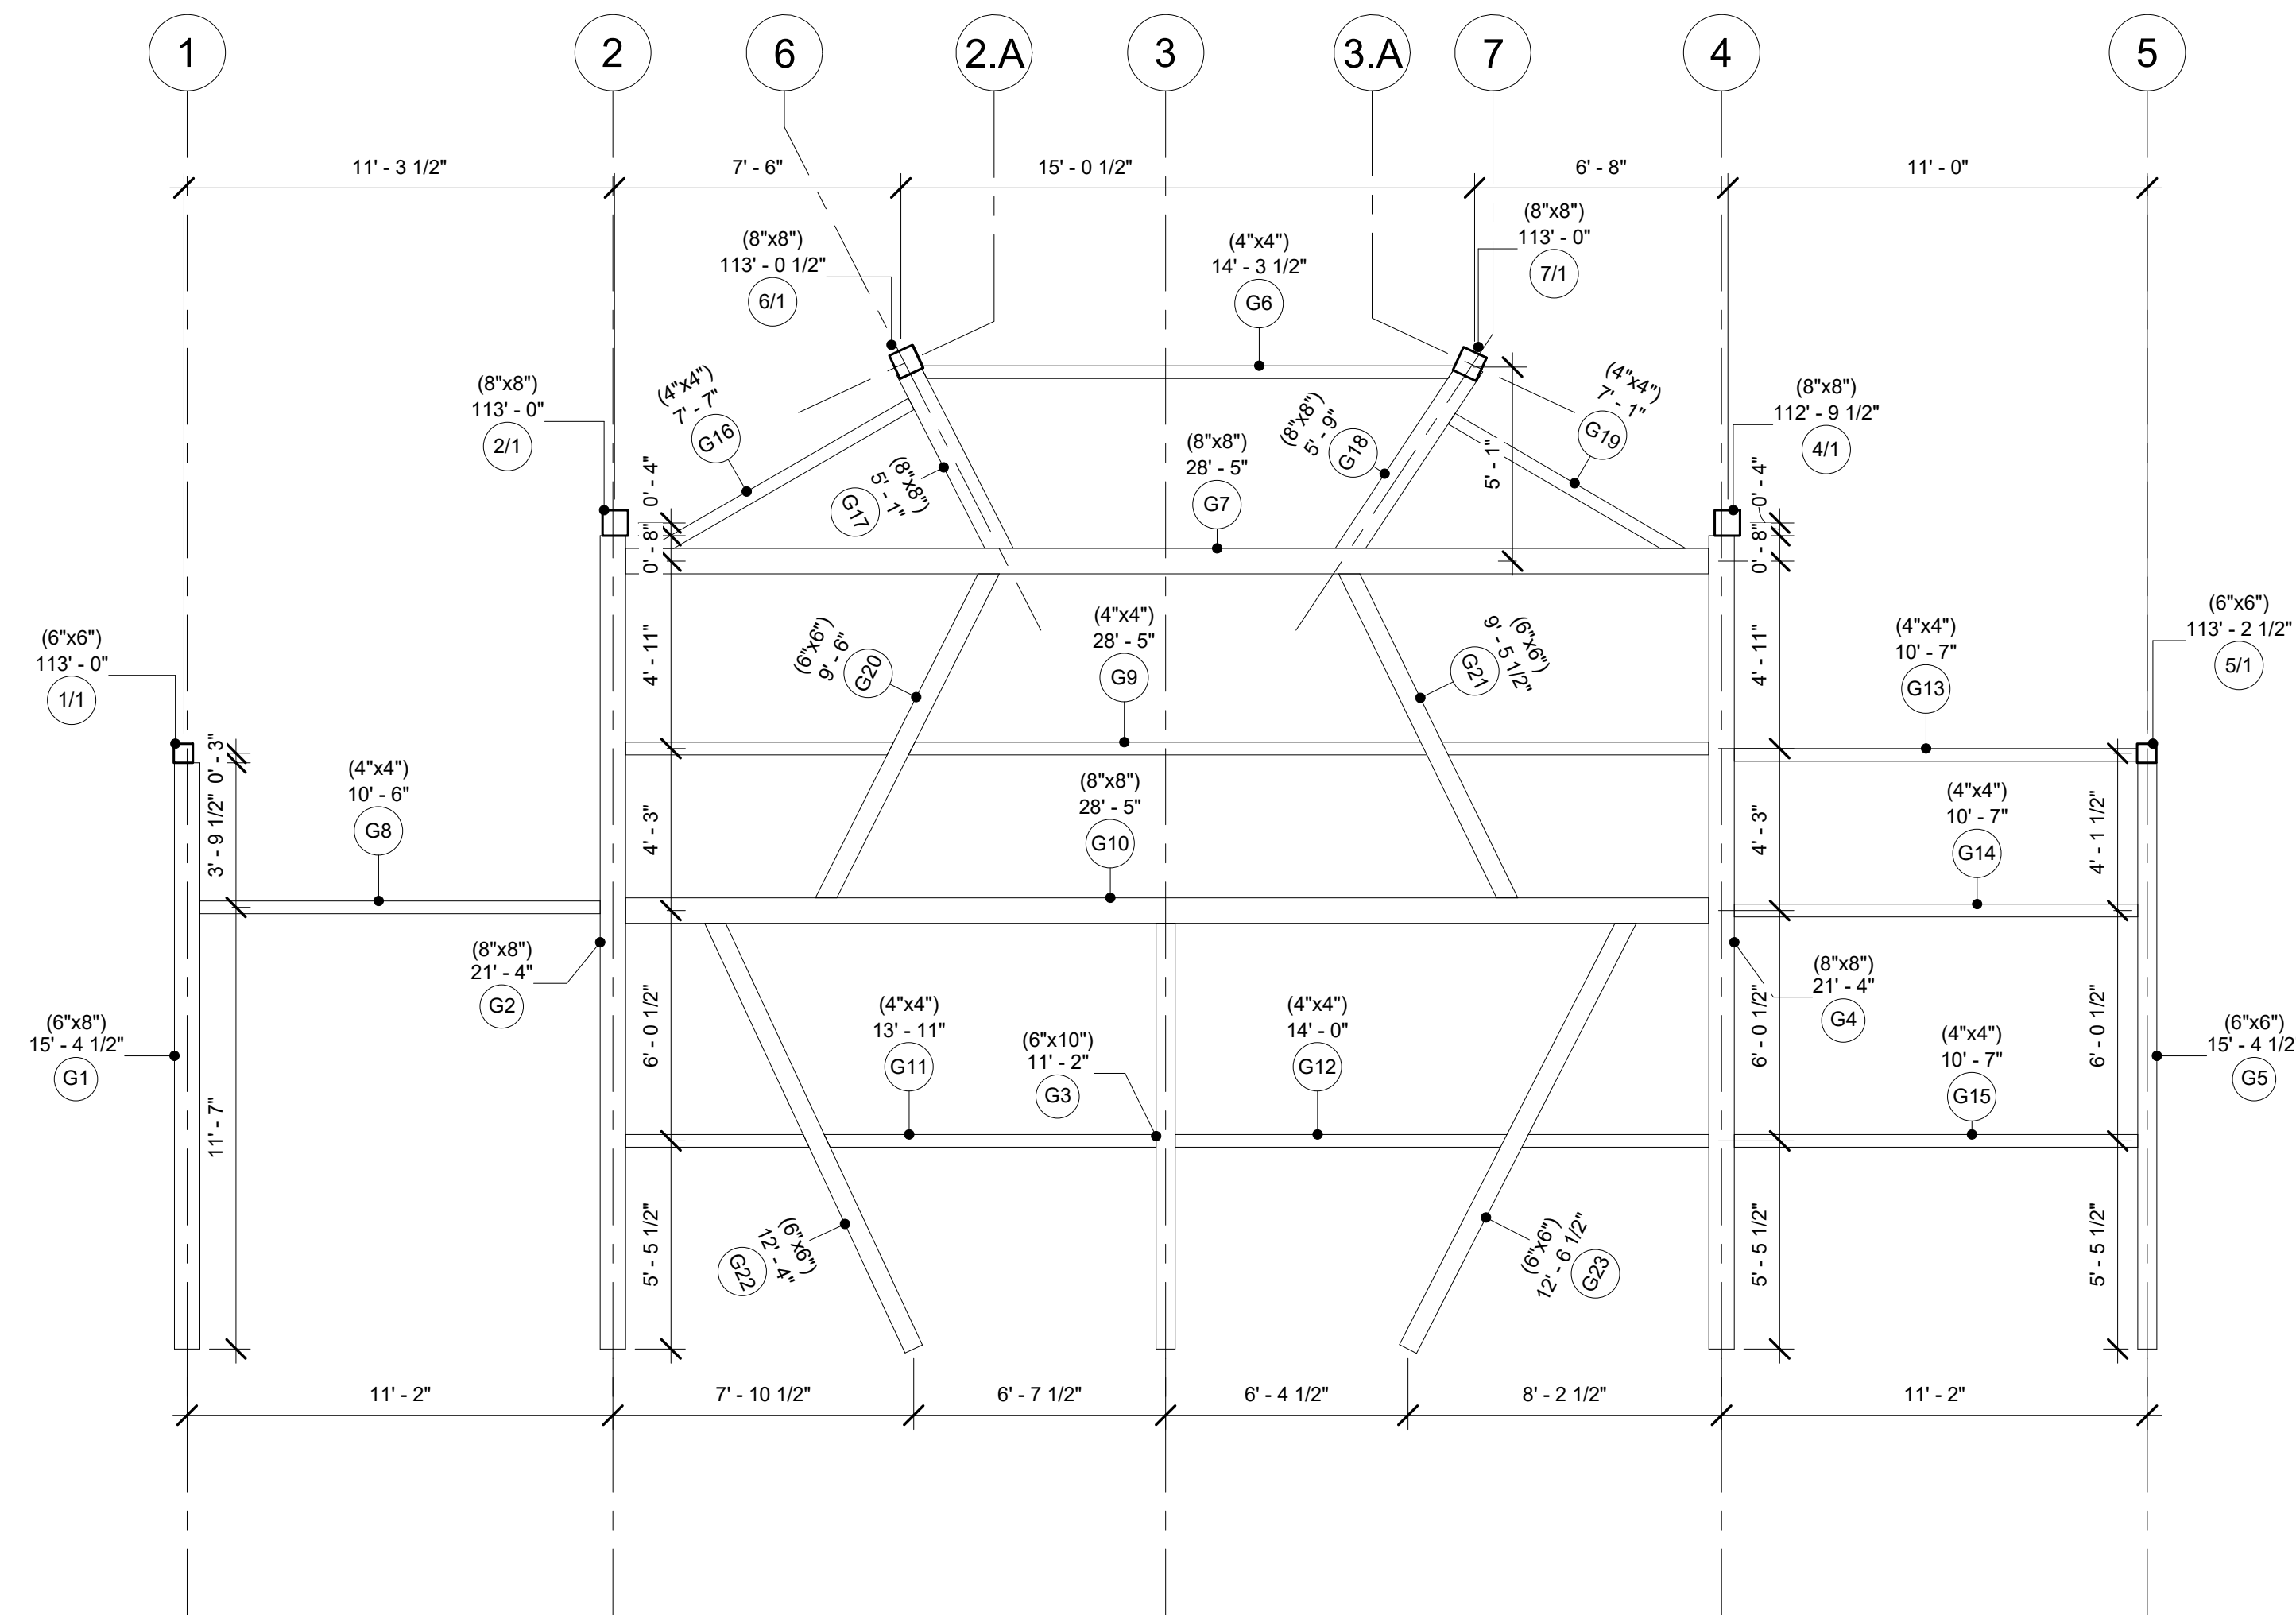

Bent G

Project Number Project 5

Date 20240902

Drawn By

Checked By

A103

Scale 1/4" = 1'-0"

Bay & Bent


80 Old Gate Road,
Penn Run PA, 15765

DAN TRIMBLE
AA66 / TIMBER HOME SERVICES

CELL PHONE/TEXT - 412-309-1161

EMAIL:

DANTRIMBLE@TIMBERHOMESERVICES.COM

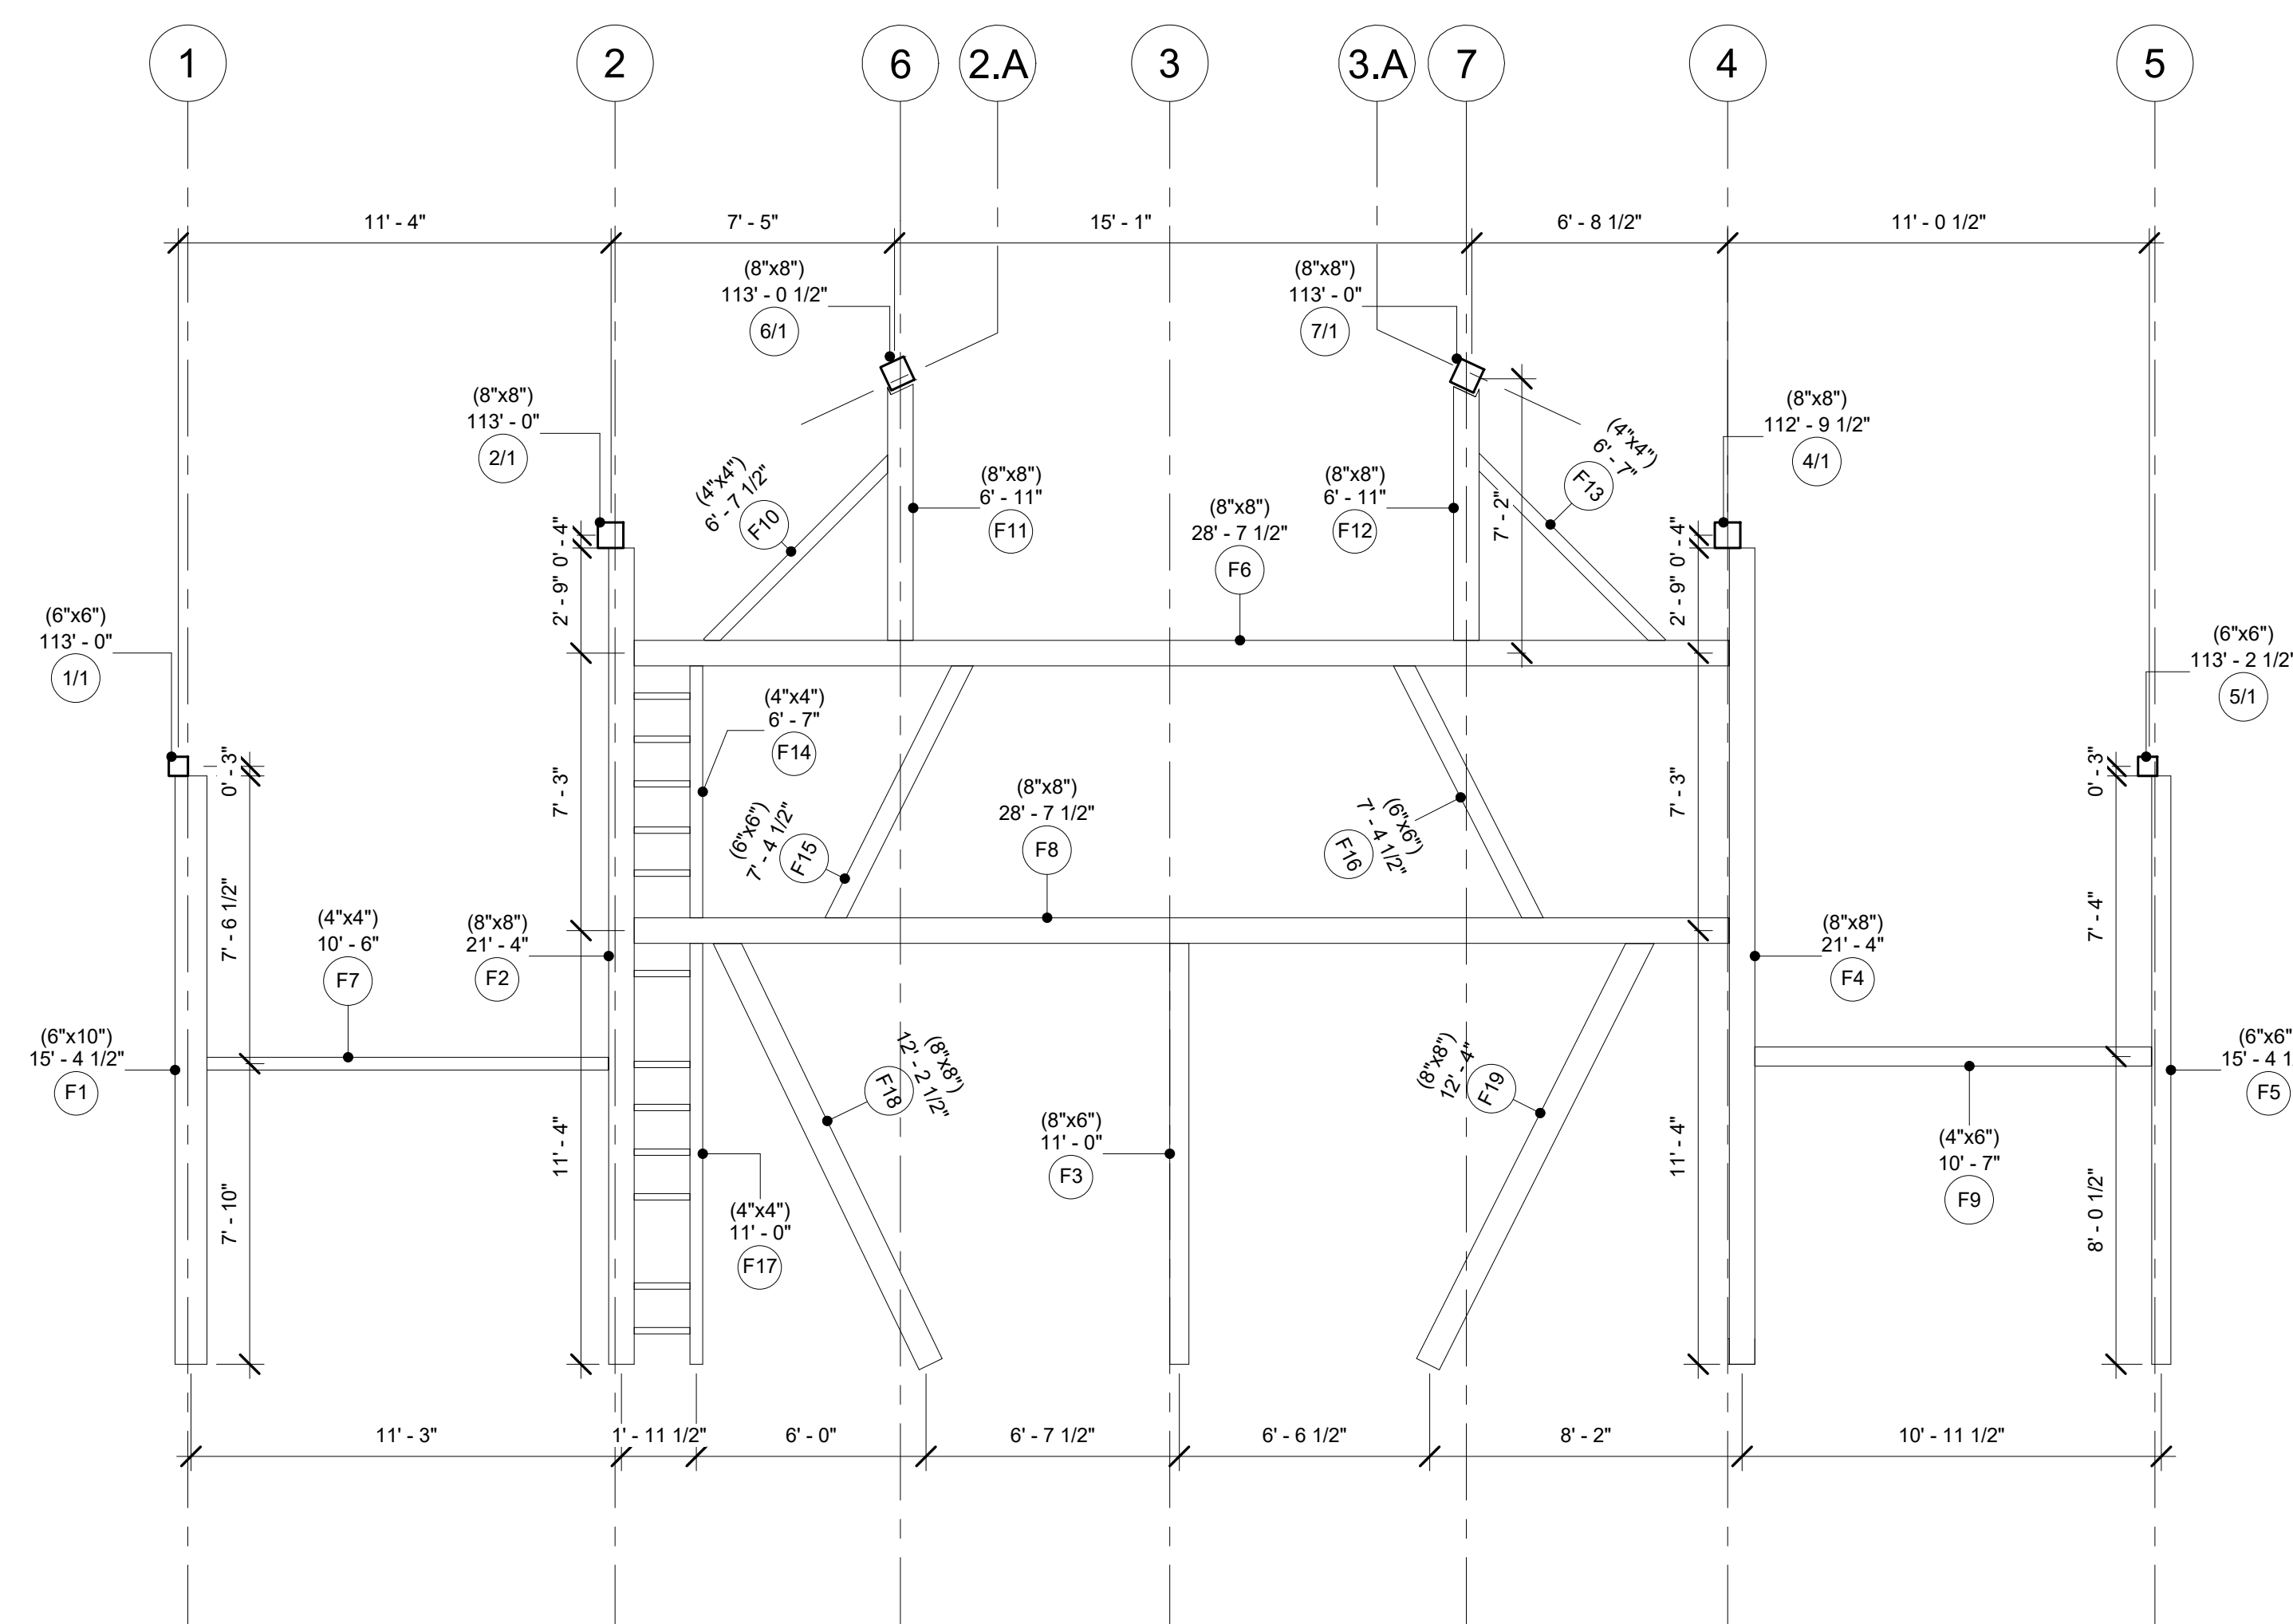

Bent F

Project Number Project 5

Date 20240902

Drawn By

Checked By

A104


Scale 1/4" = 1'-0"

Bay & Bent

80 Old Gate Road,
Penn Run PA, 15765

DAN TRIMBLE
AA66 / TIMBER HOME SERVICES
CELL PHONE/TEXT - 412-309-1161

EMAIL:
DANTRIMBLE@TIMBERHOMESERVICES.COM

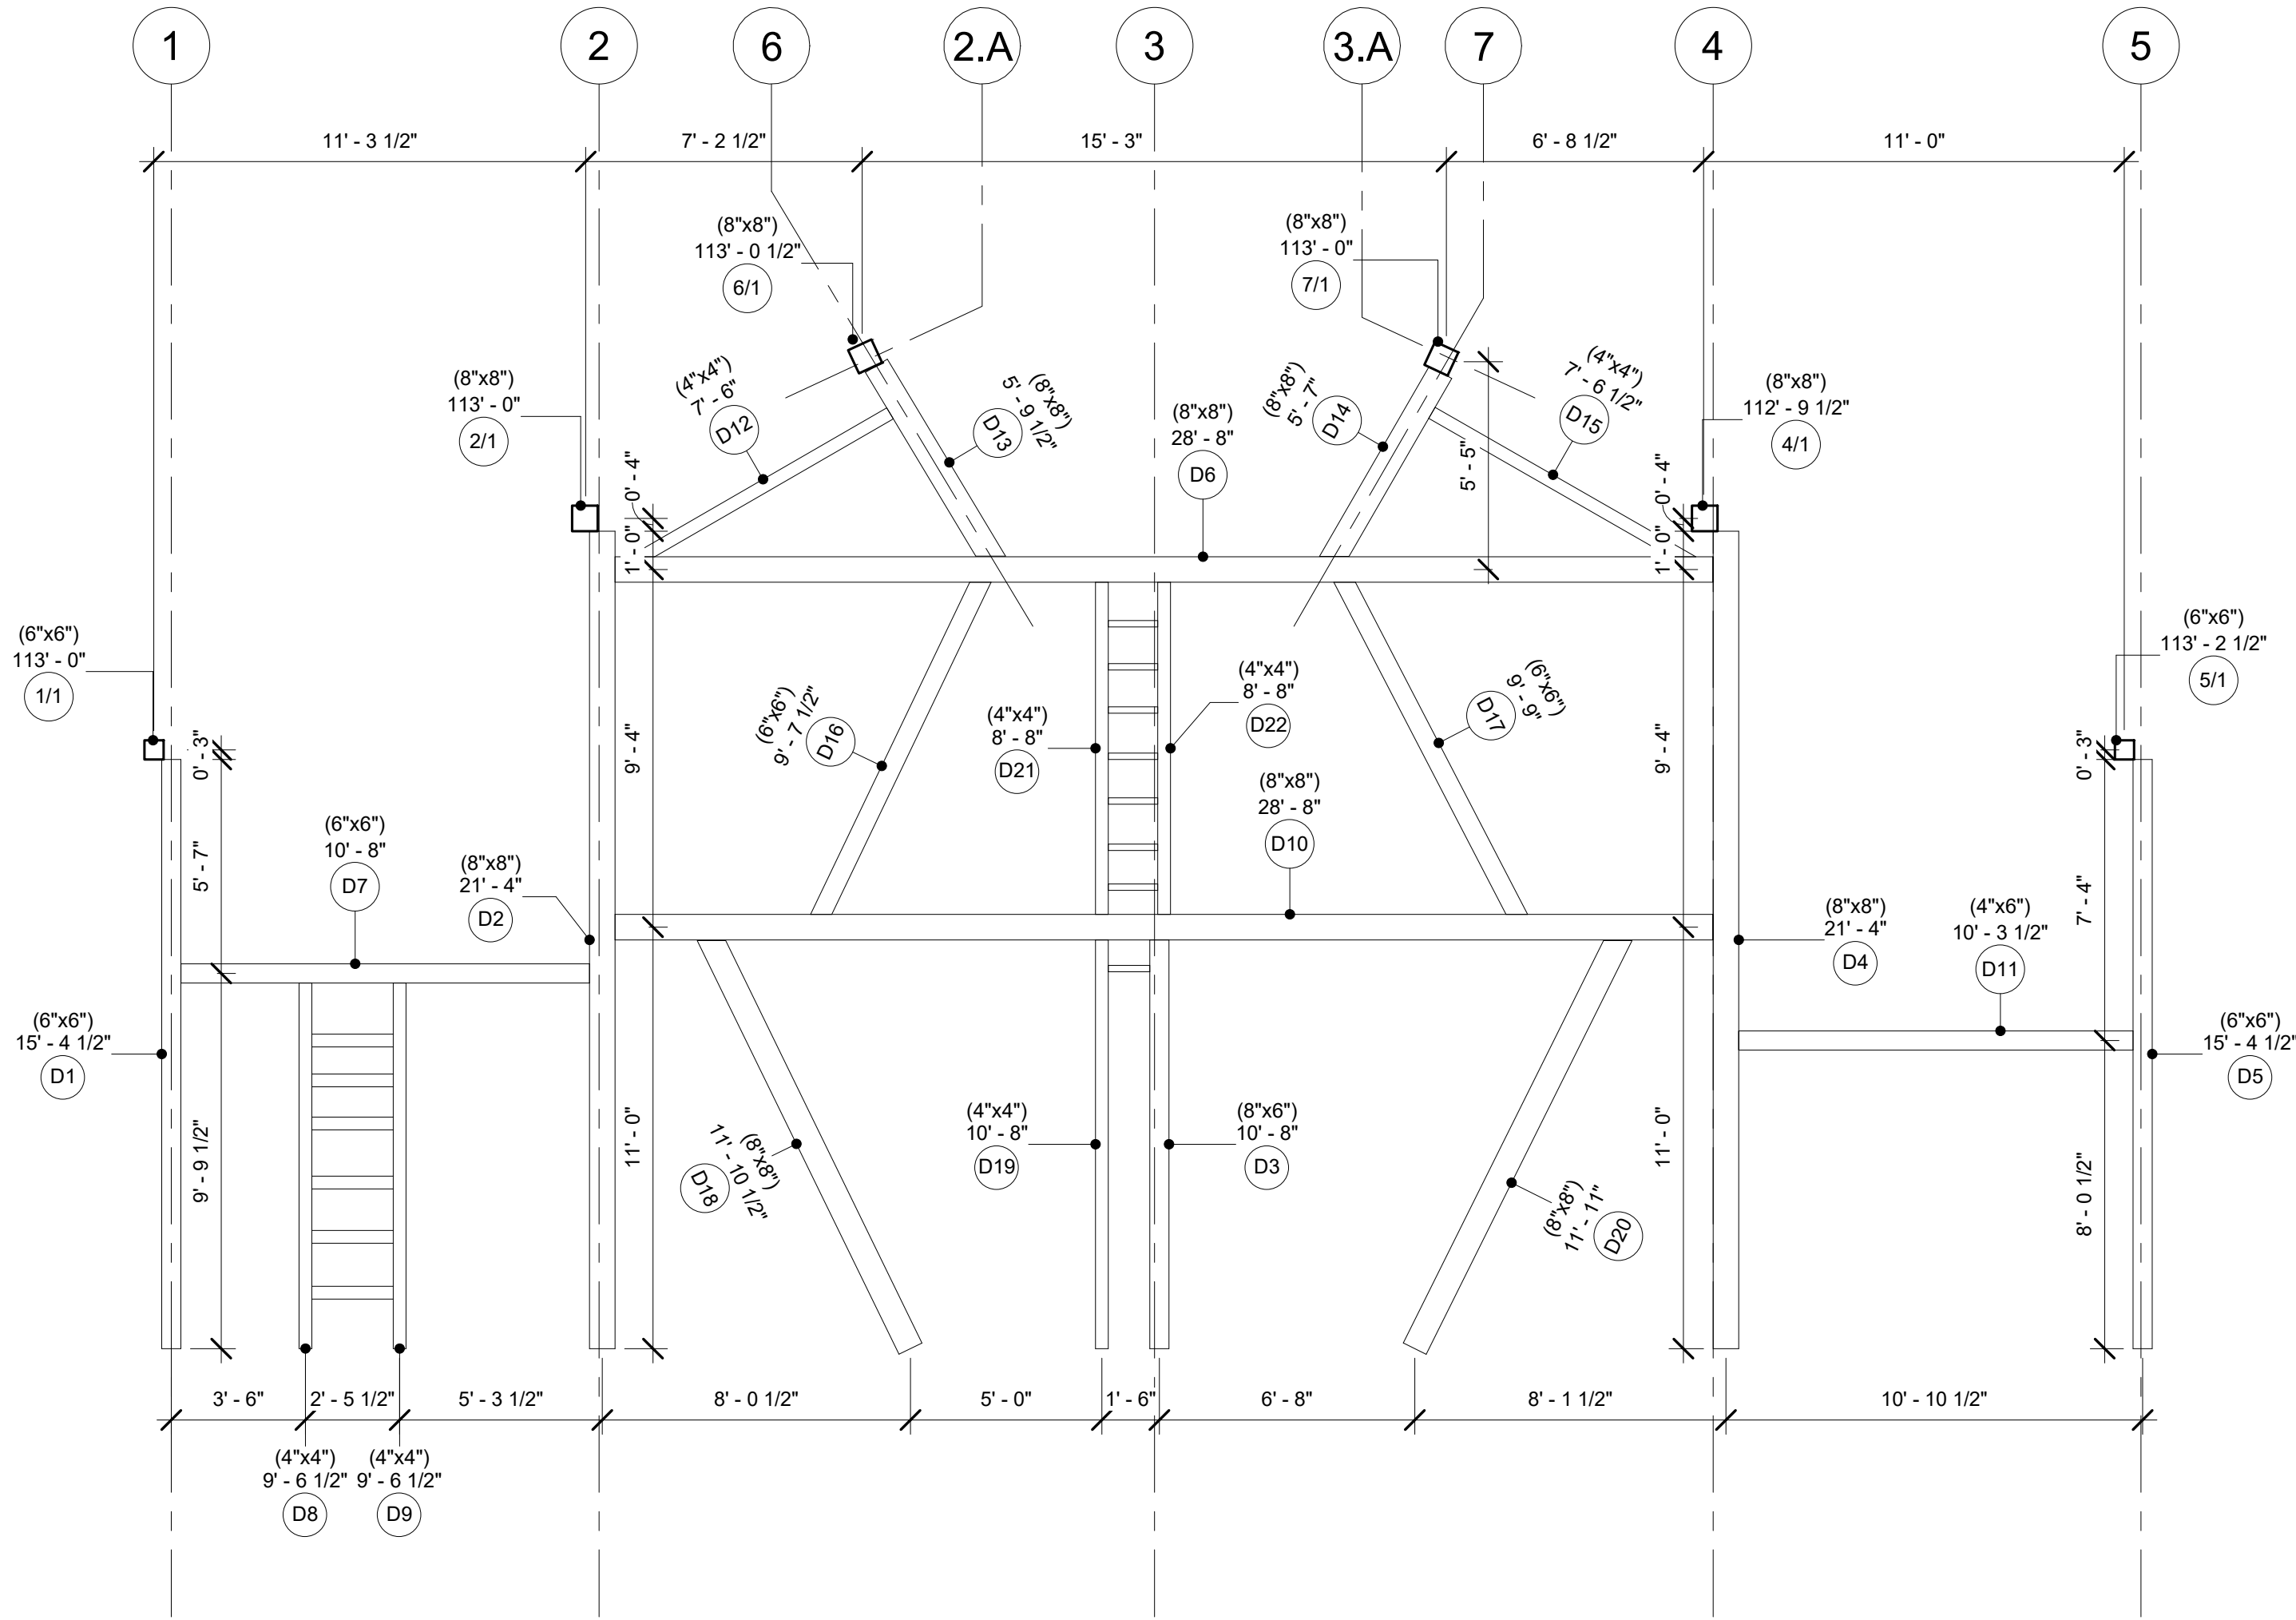

Bent D

Project Number Project 5
Date 20240902
Drawn By
Checked By

A106

Scale 1/4" = 1'-0"

Bay & Bent


80 Old Gate Road,
Penn Run PA, 15765

DAN TRIMBLE
AA66 / TIMBER HOME SERVICES

CELL PHONE/TEXT - 412-309-1161

EMAIL:

DANTRIMBLE@TIMBERHOMESERVICES.COM

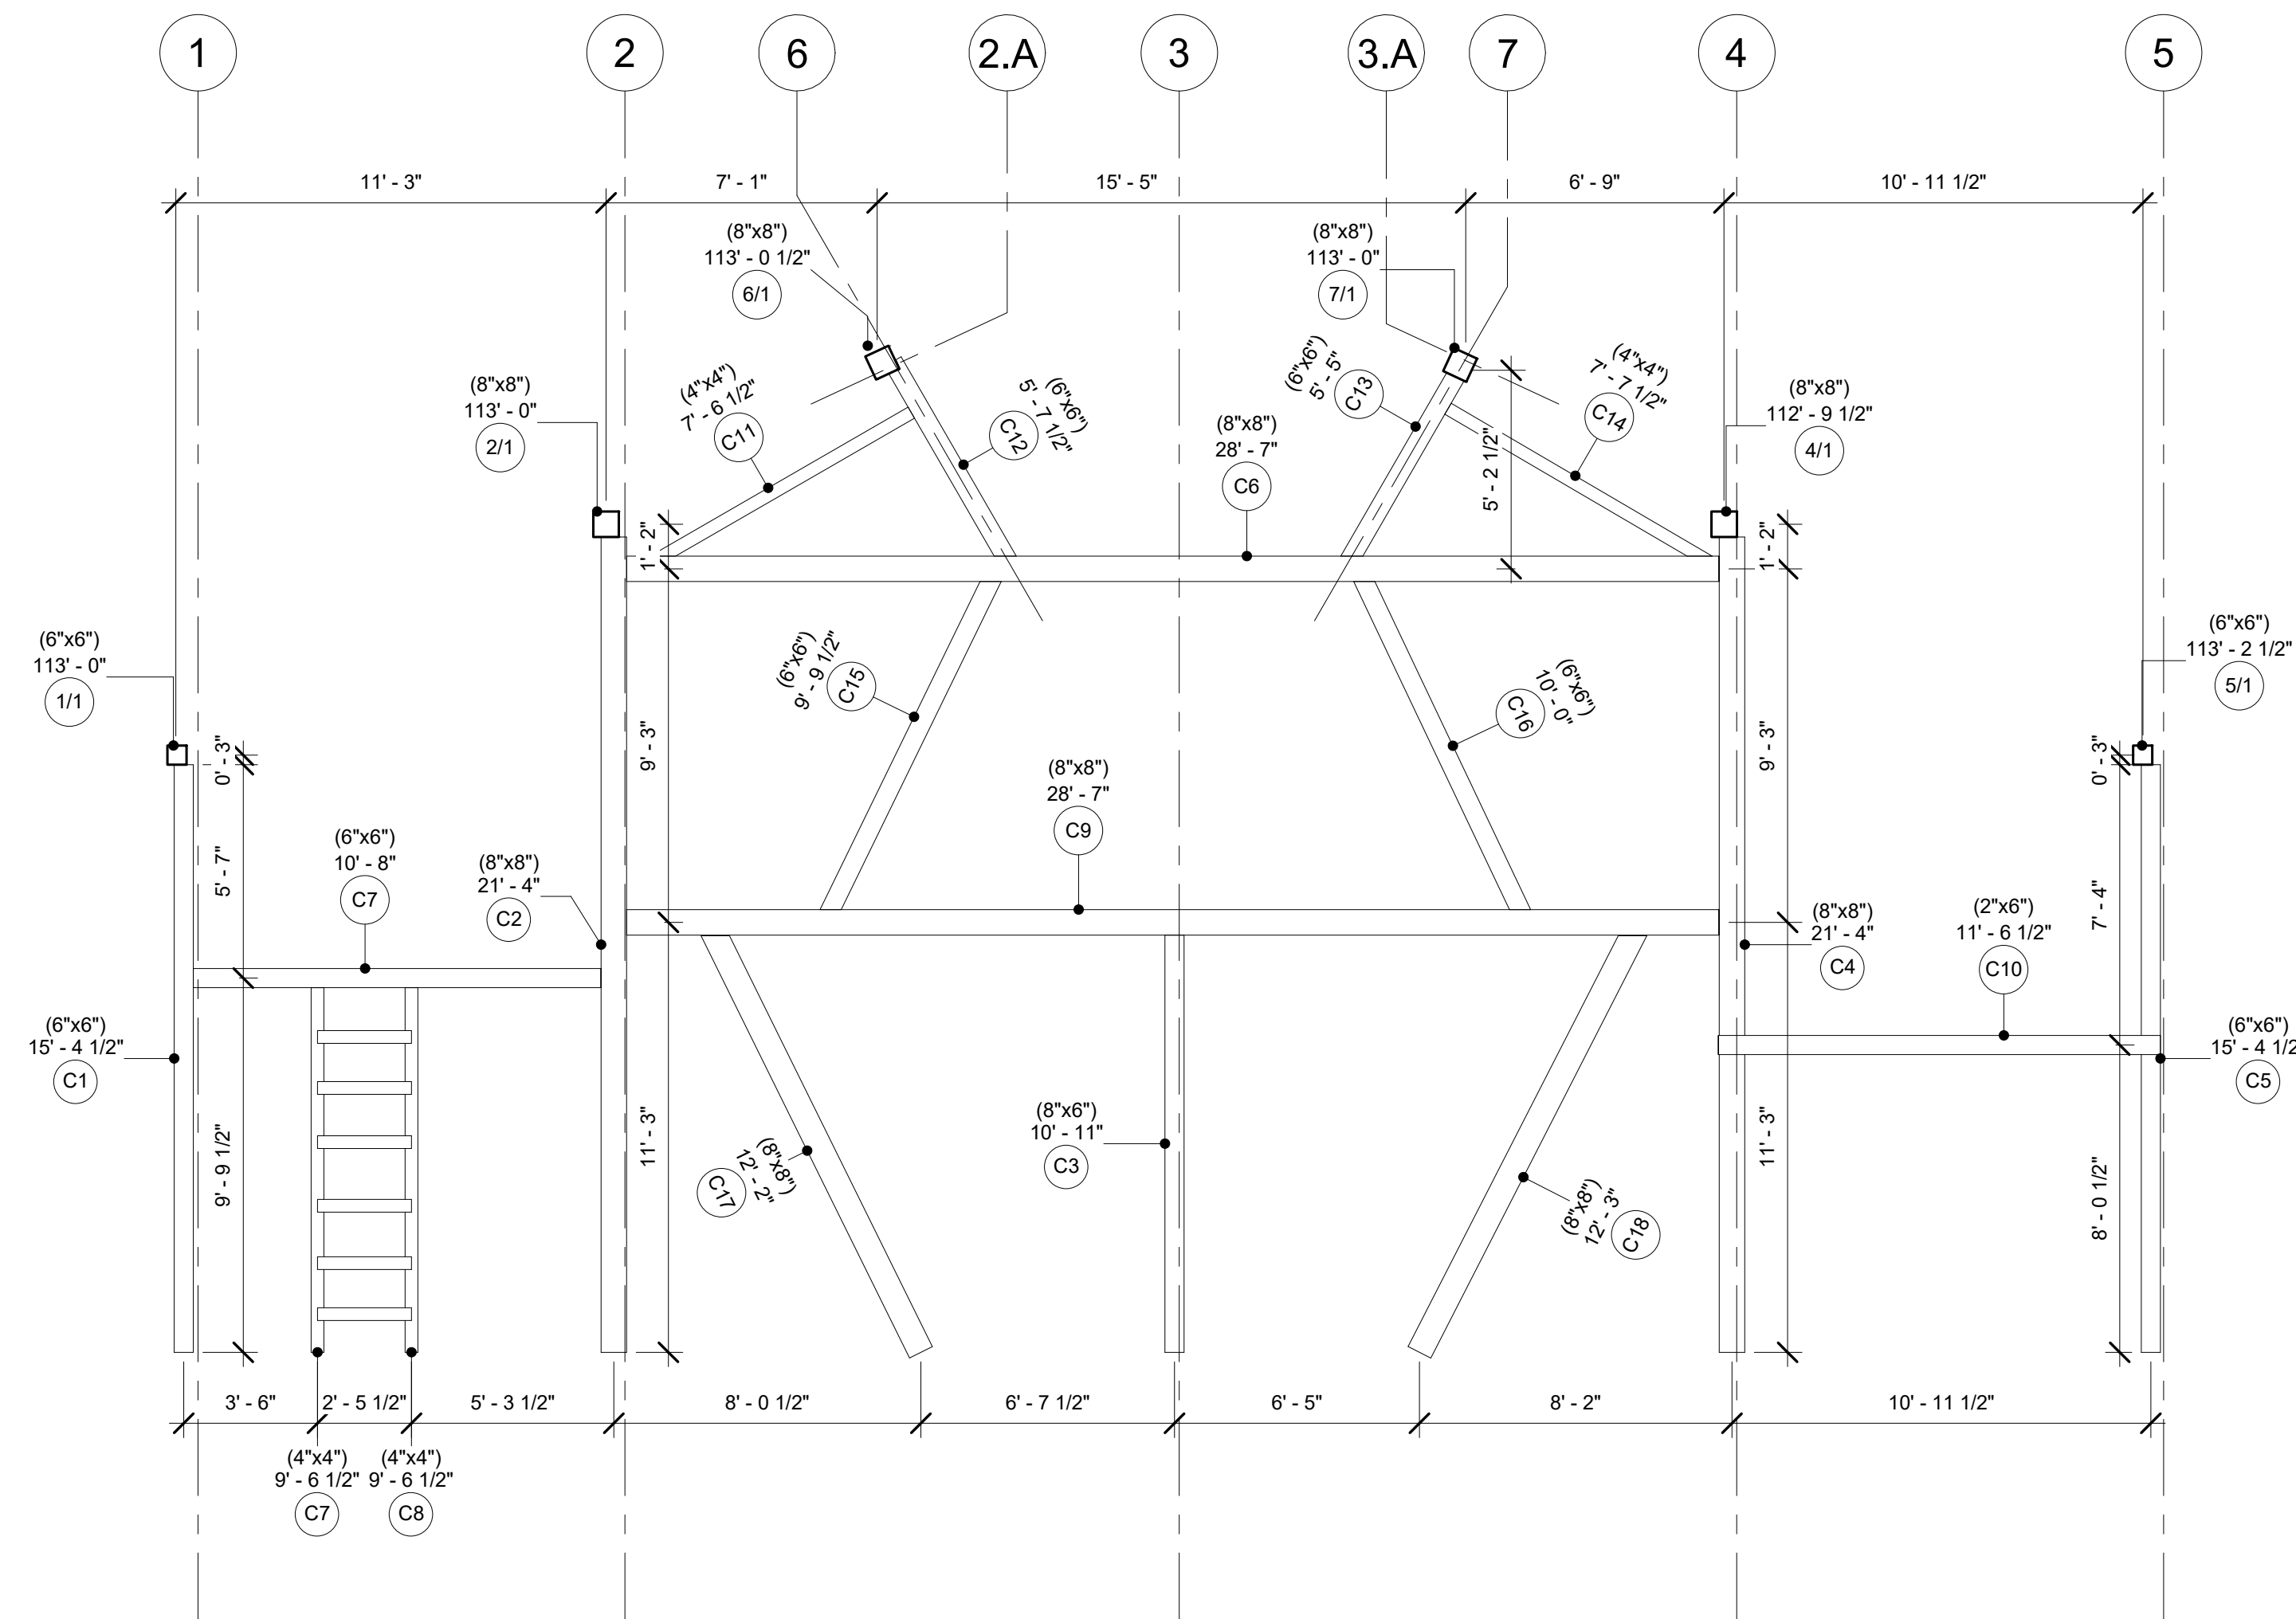

Bent C

Project Number Project 5

Date 20240902

Drawn By

Checked By

A107

Scale 1/4" = 1'-0"

Bay & Bent


80 Old Gate Road,
Penn Run PA, 15765

DAN TRIMBLE
AA66 / TIMBER HOME SERVICES

CELL PHONE/TEXT - 412-309-1161

EMAIL:

DANTRIMBLE@TIMBERHOMESERVICES.COM

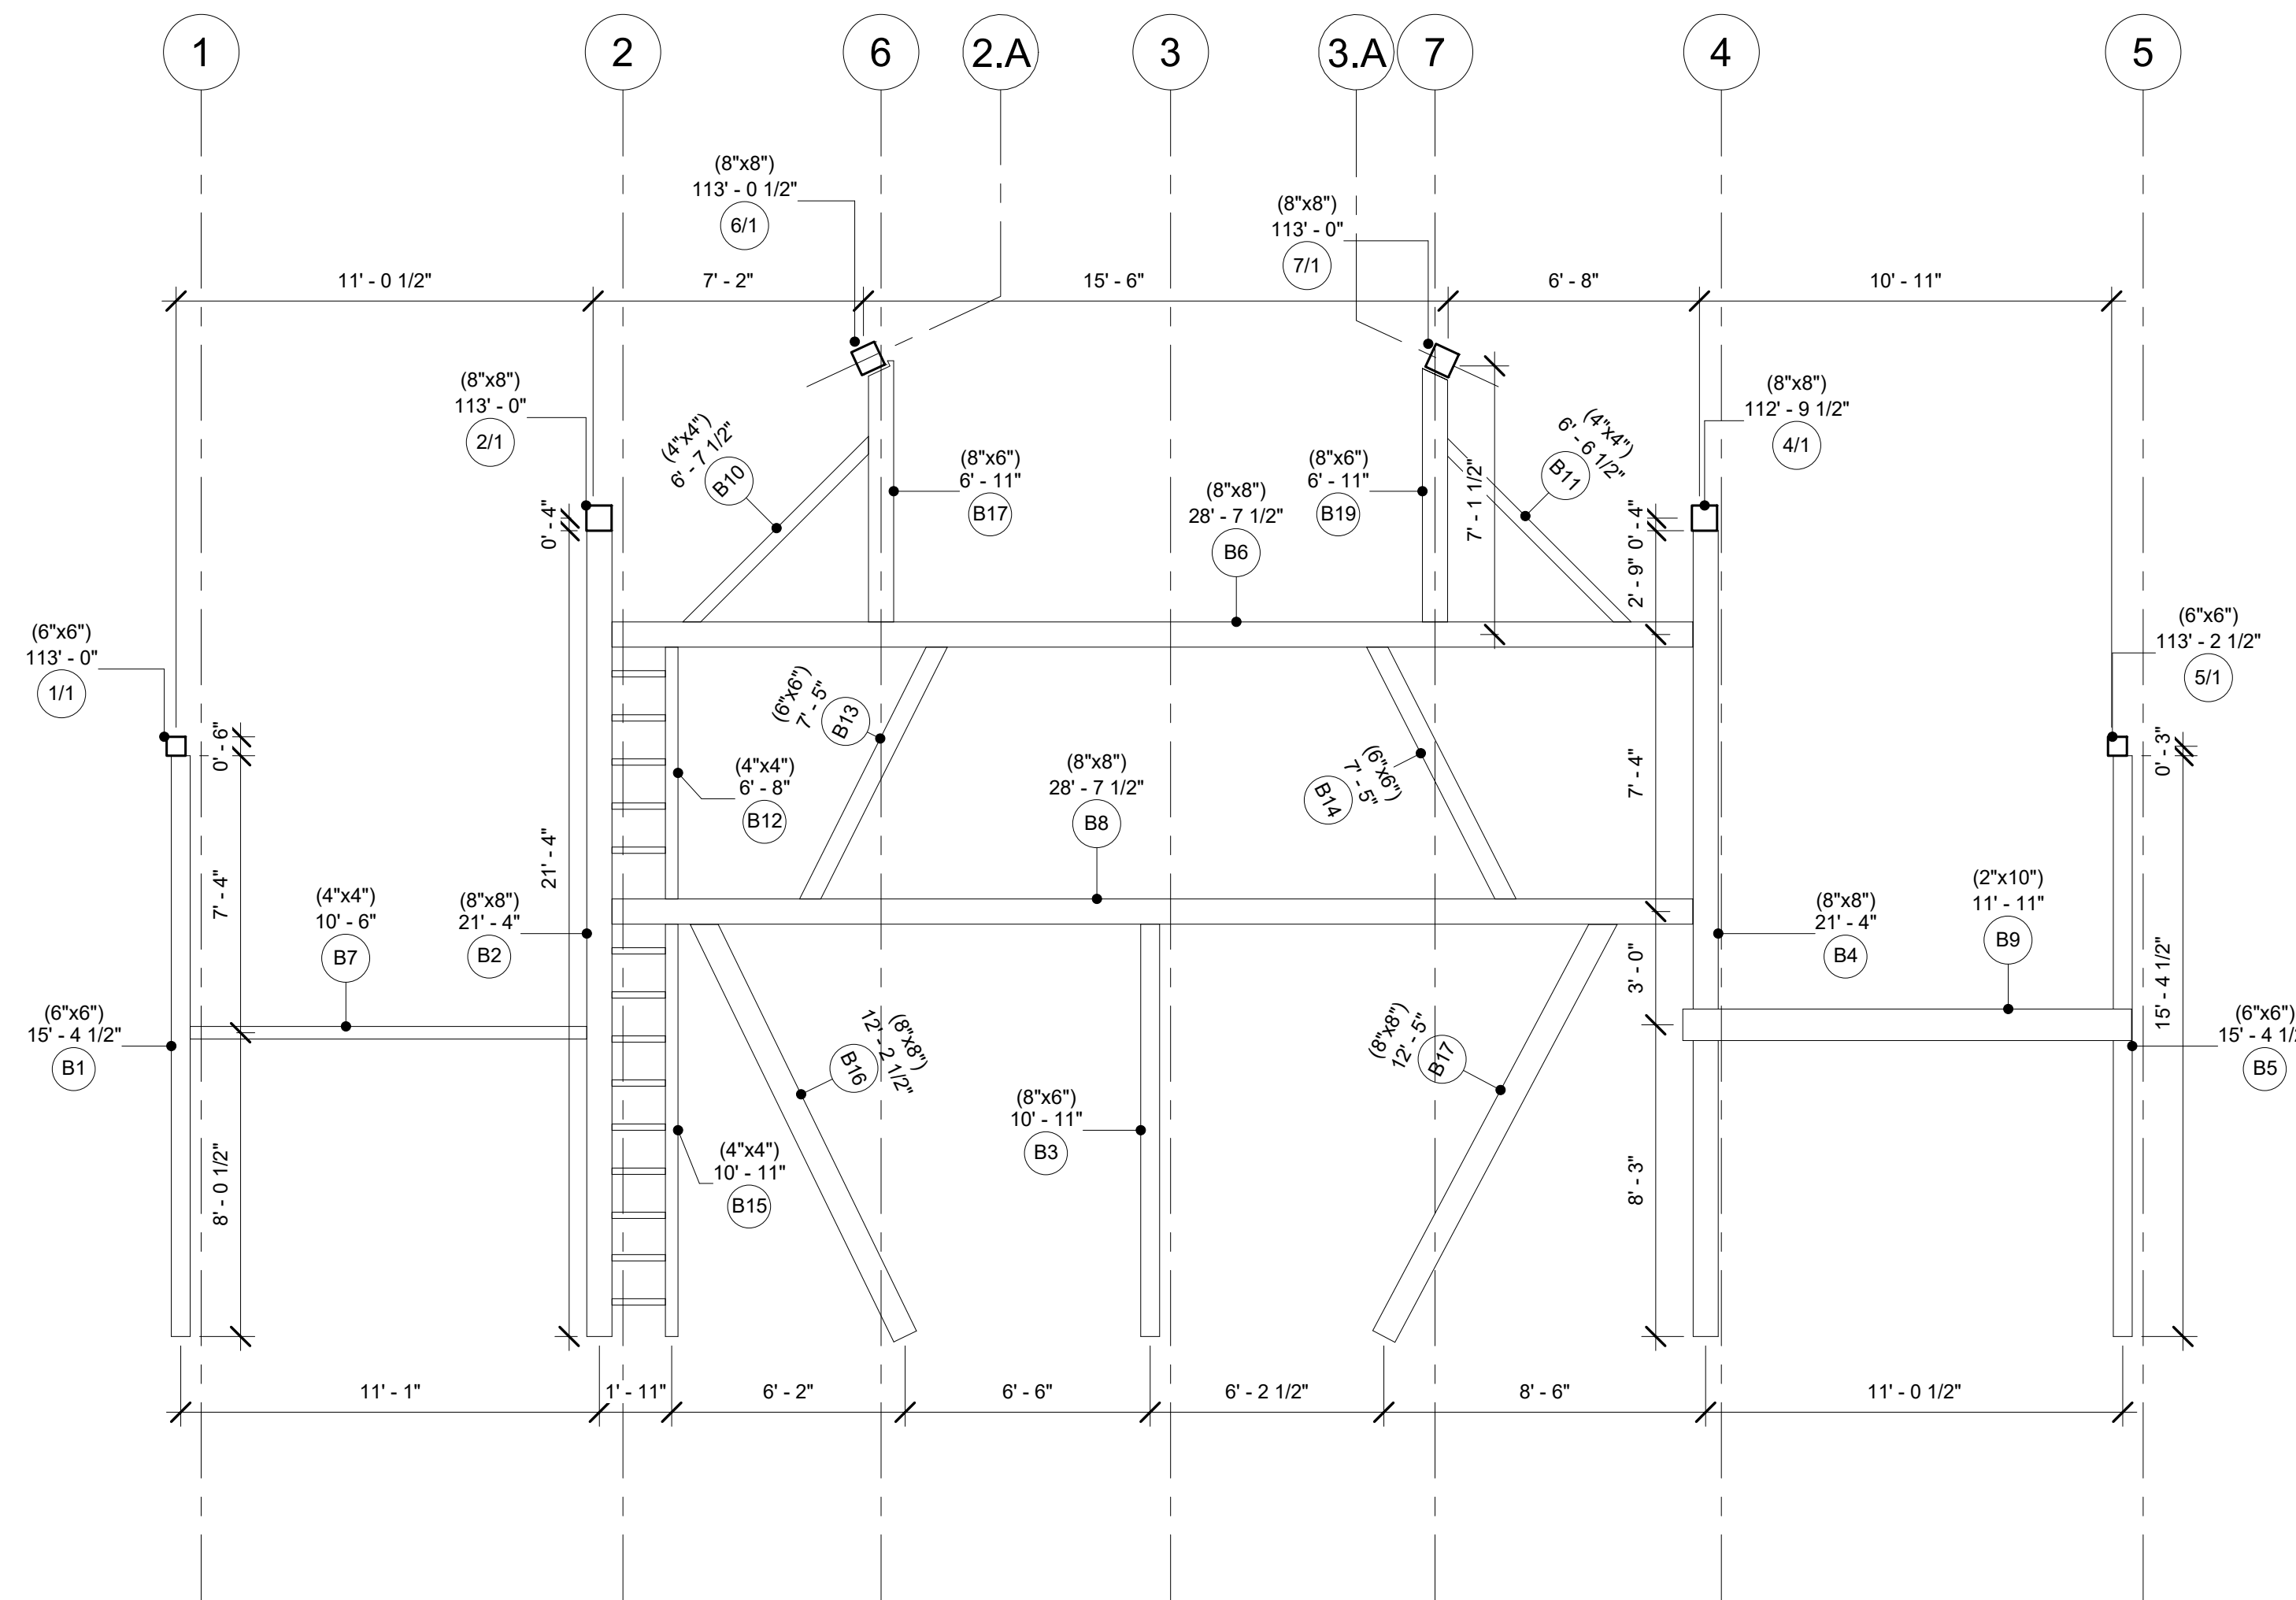

Bent B

Project Number Project 5

Date 20240902

Drawn By

Checked By

A108

Scale 1/4" = 1'-0"

Bay & Bent


80 Old Gate Road,
Penn Run PA, 15765

DAN TRIMBLE
AA66 / TIMBER HOME SERVICES

CELL PHONE/TEXT - 412-309-1161

EMAIL:

DANTRIMBLE@TIMBERHOMESERVICES.COM

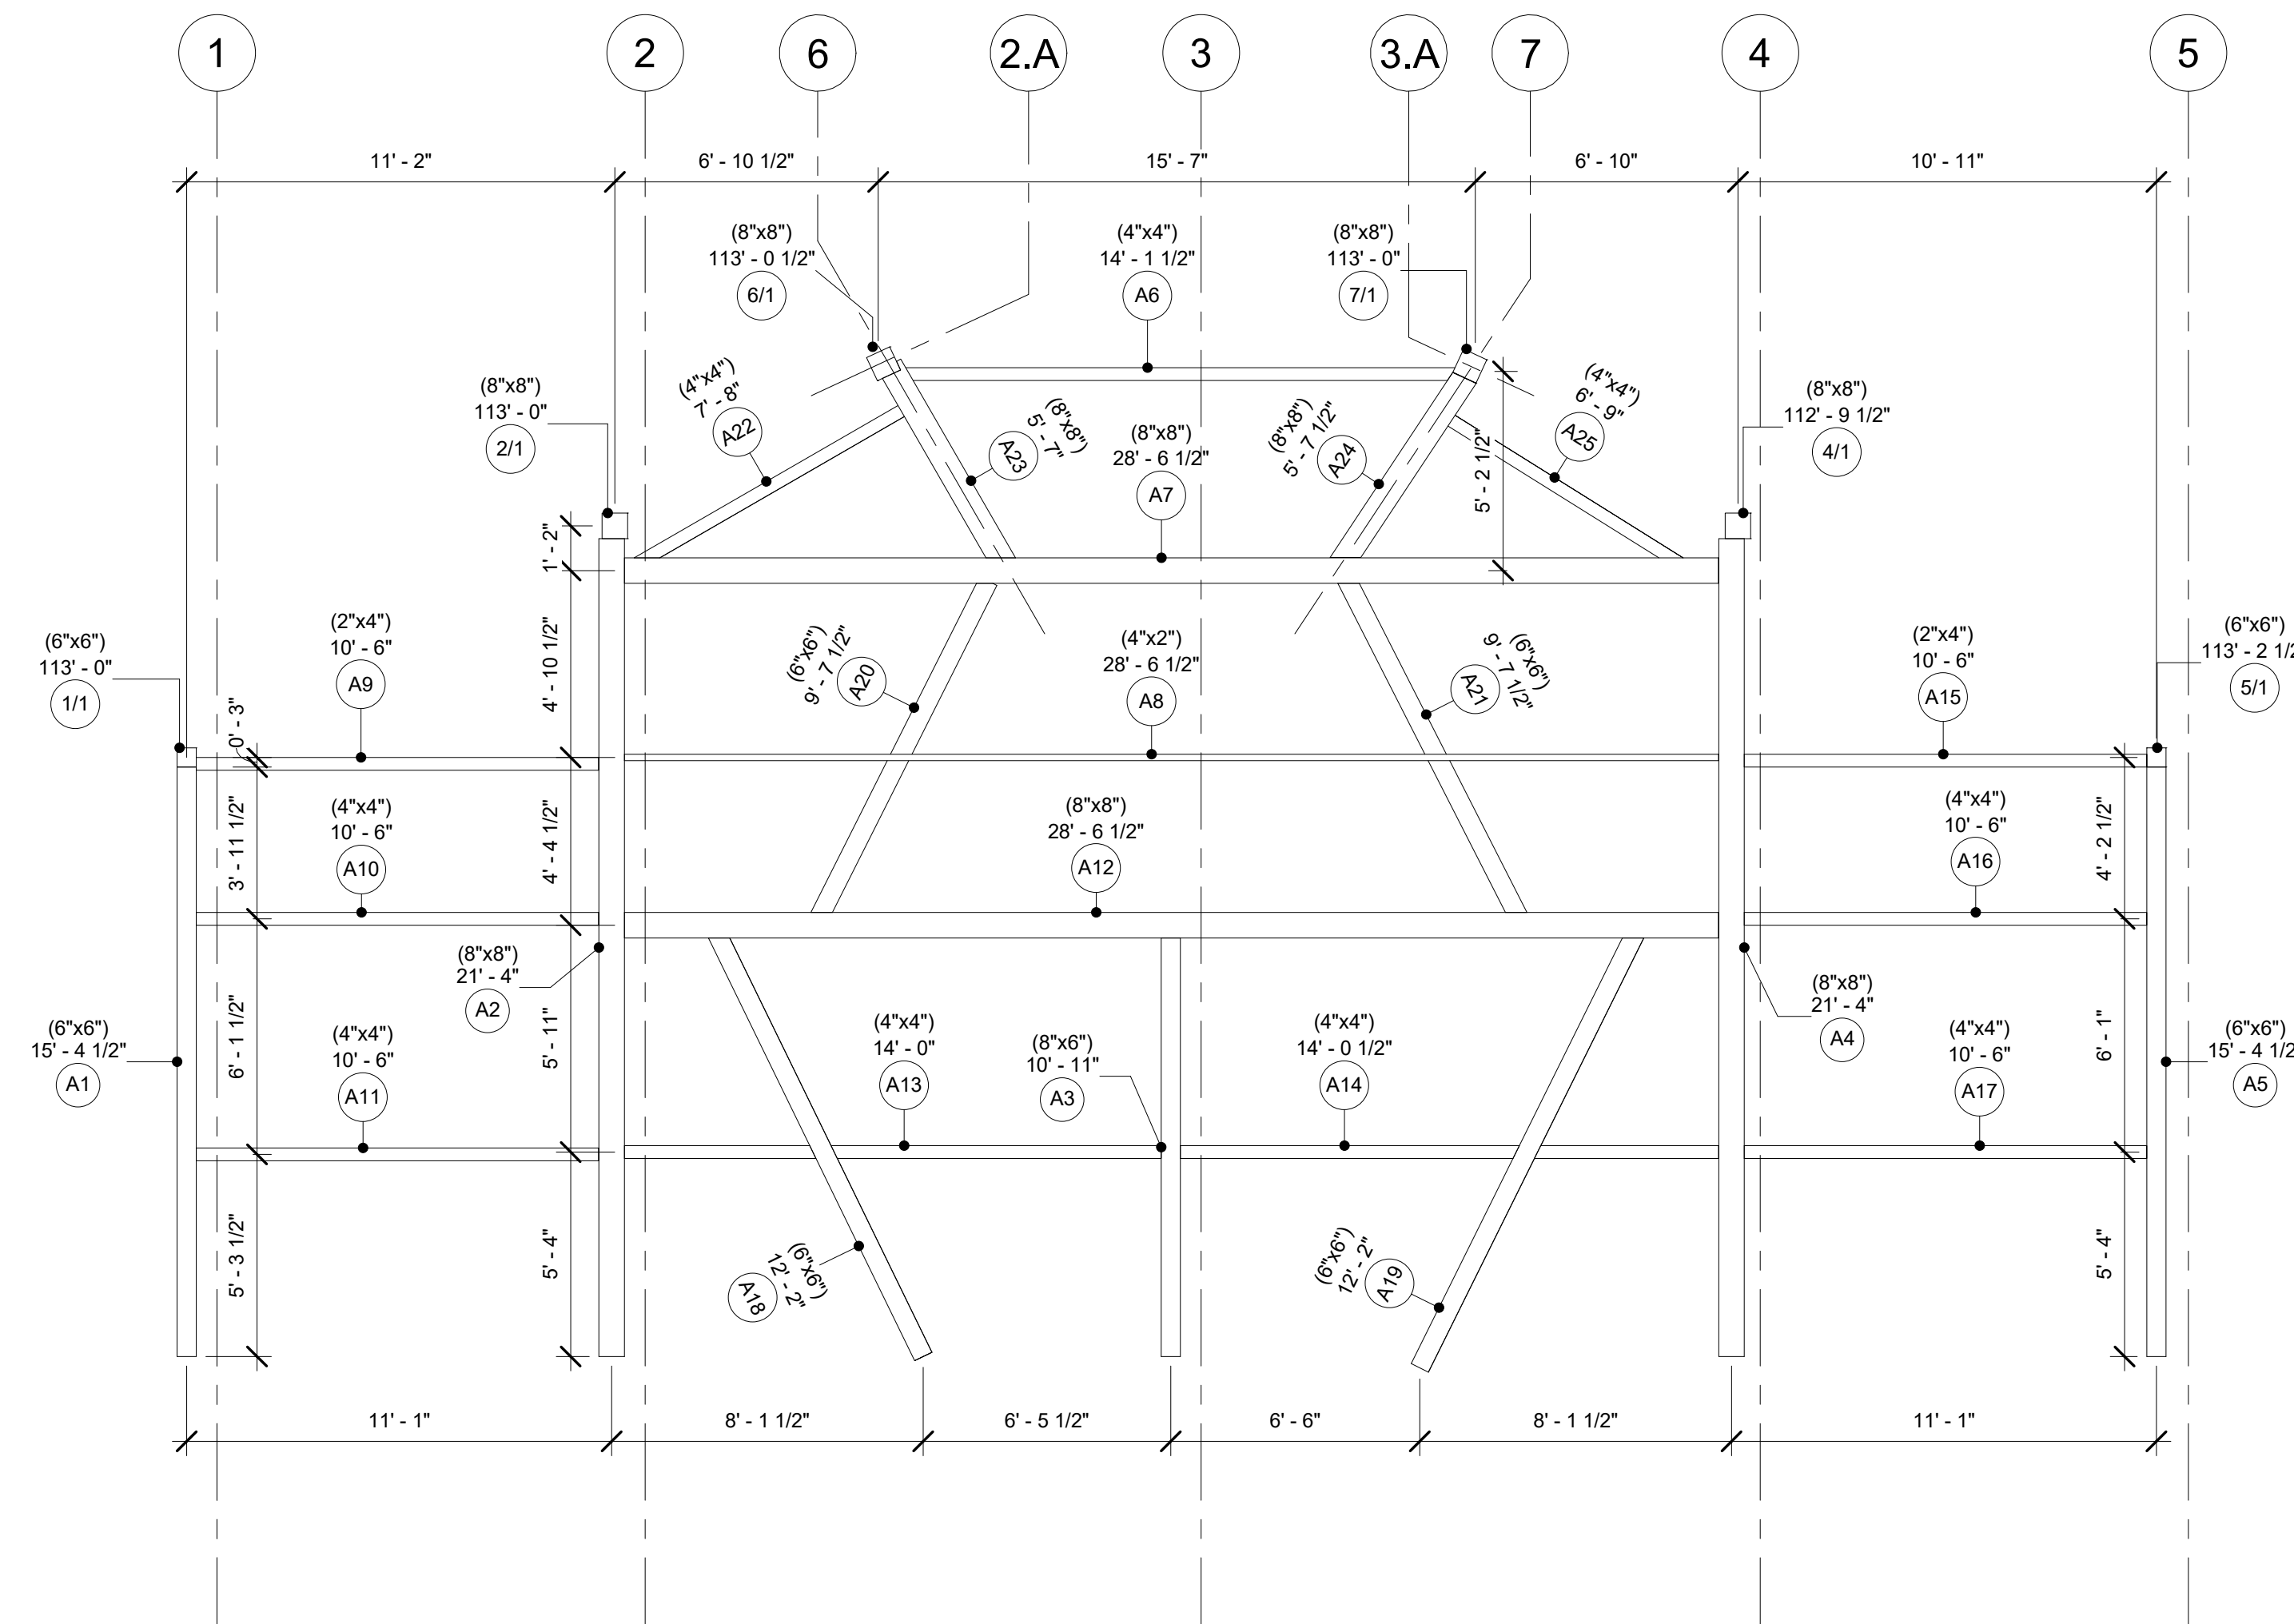

Bent A

Project Number Project 5

Date 20240902

Drawn By

Checked By

A109


Scale 1/4" = 1'-0"

Bay & Bent

80 Old Gate Road,
Penn Run PA, 15765

DAN TRIMBLE
AA66 / TIMBER HOME SERVICES
CELL PHONE/TEXT - 412-309-1161

EMAIL:
DANTRIMBLE@TIMBERHOMESERVICES.COM

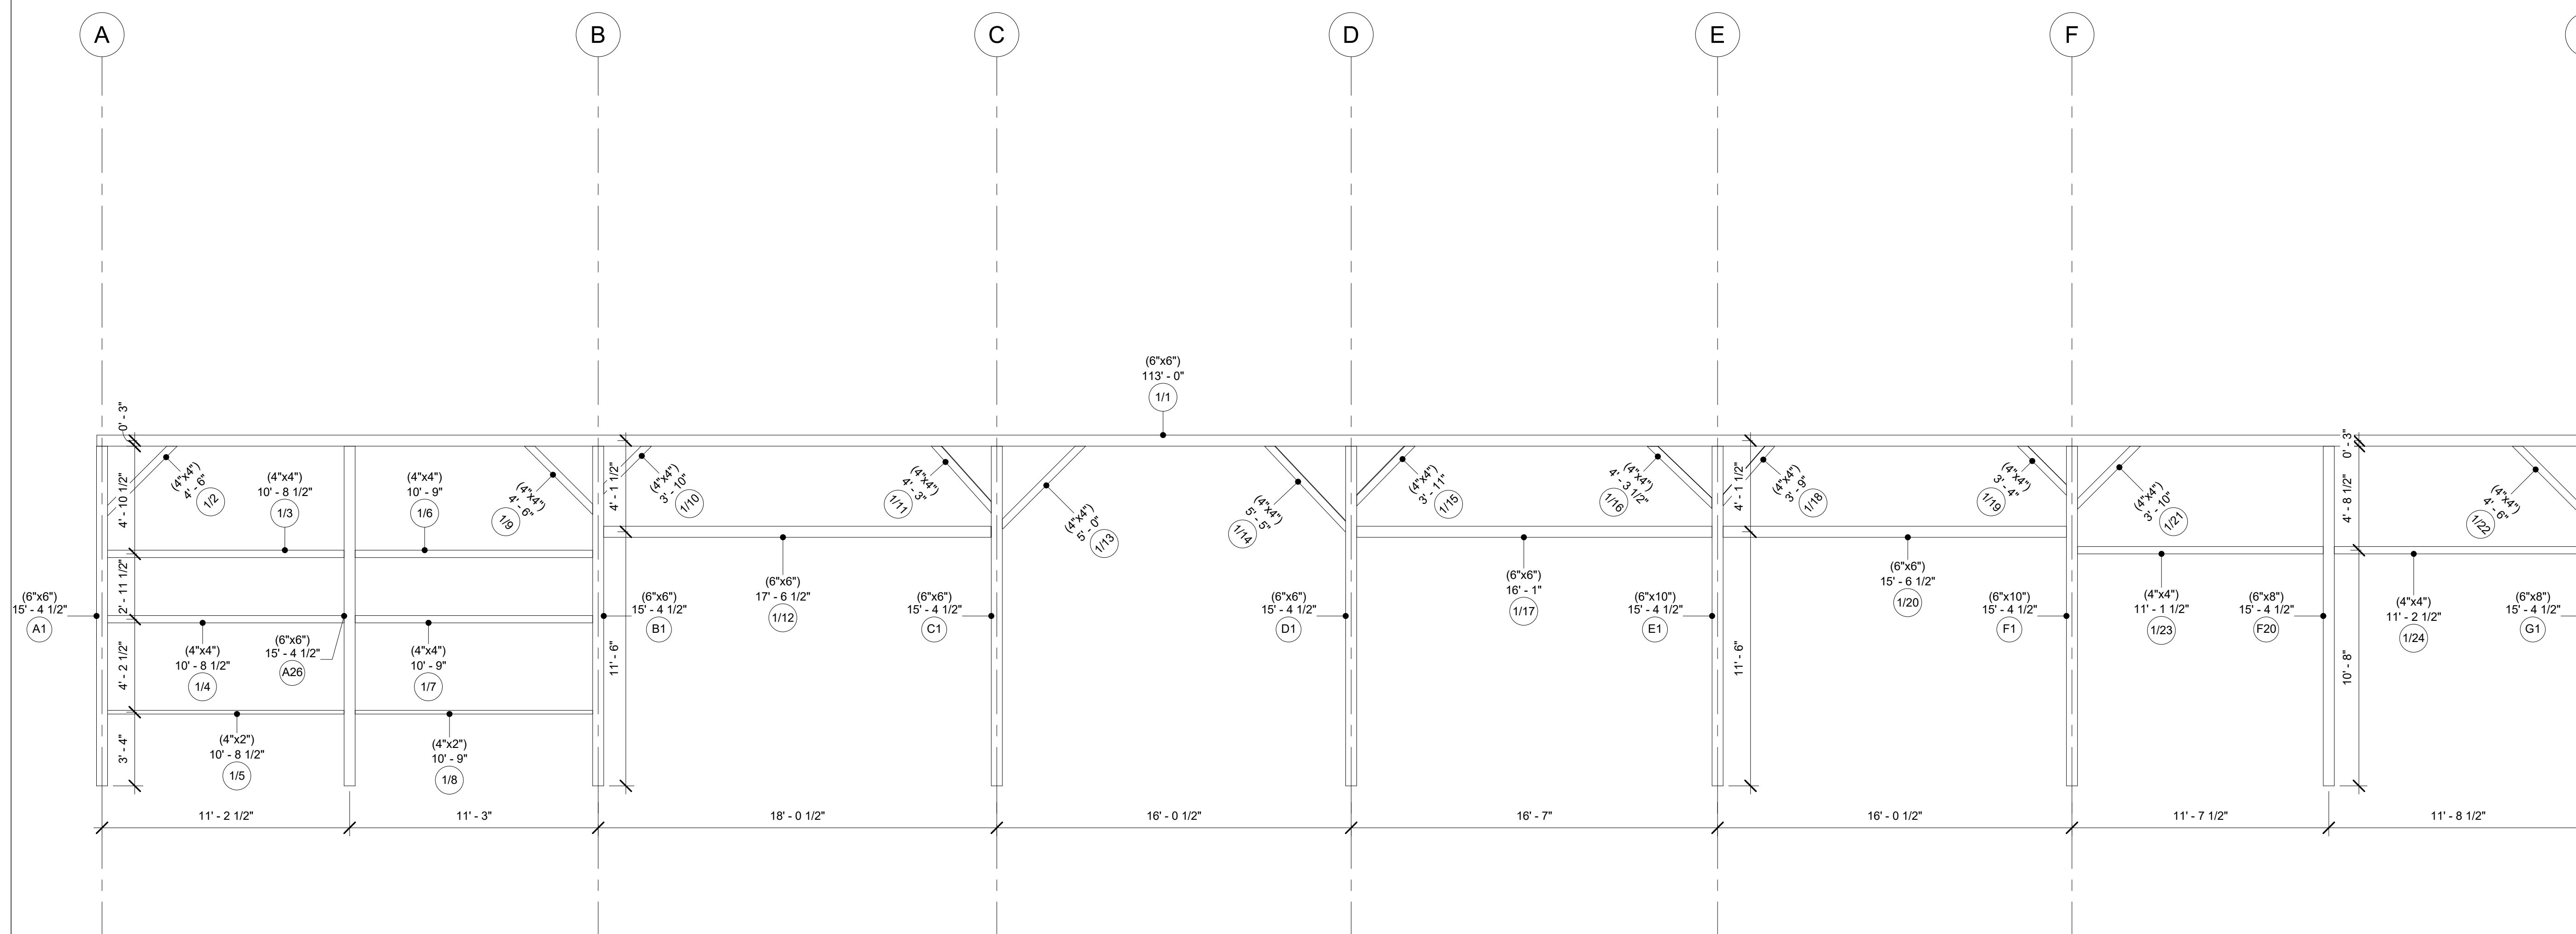

Bent 1

Project Number **Project 5**
Date **20240902**
Drawn By
Checked By

A110


Scale **1/4" = 1'-0"**

Bay & Bent

80 Old Gate Road,
Penn Run PA, 15765

DAN TRIMBLE
AA66 / TIMBER HOME SERVICES
CELL PHONE/TEXT - 412-309-1161

EMAIL:
DANTRIMBLE@TIMBERHOMESERVICES.COM

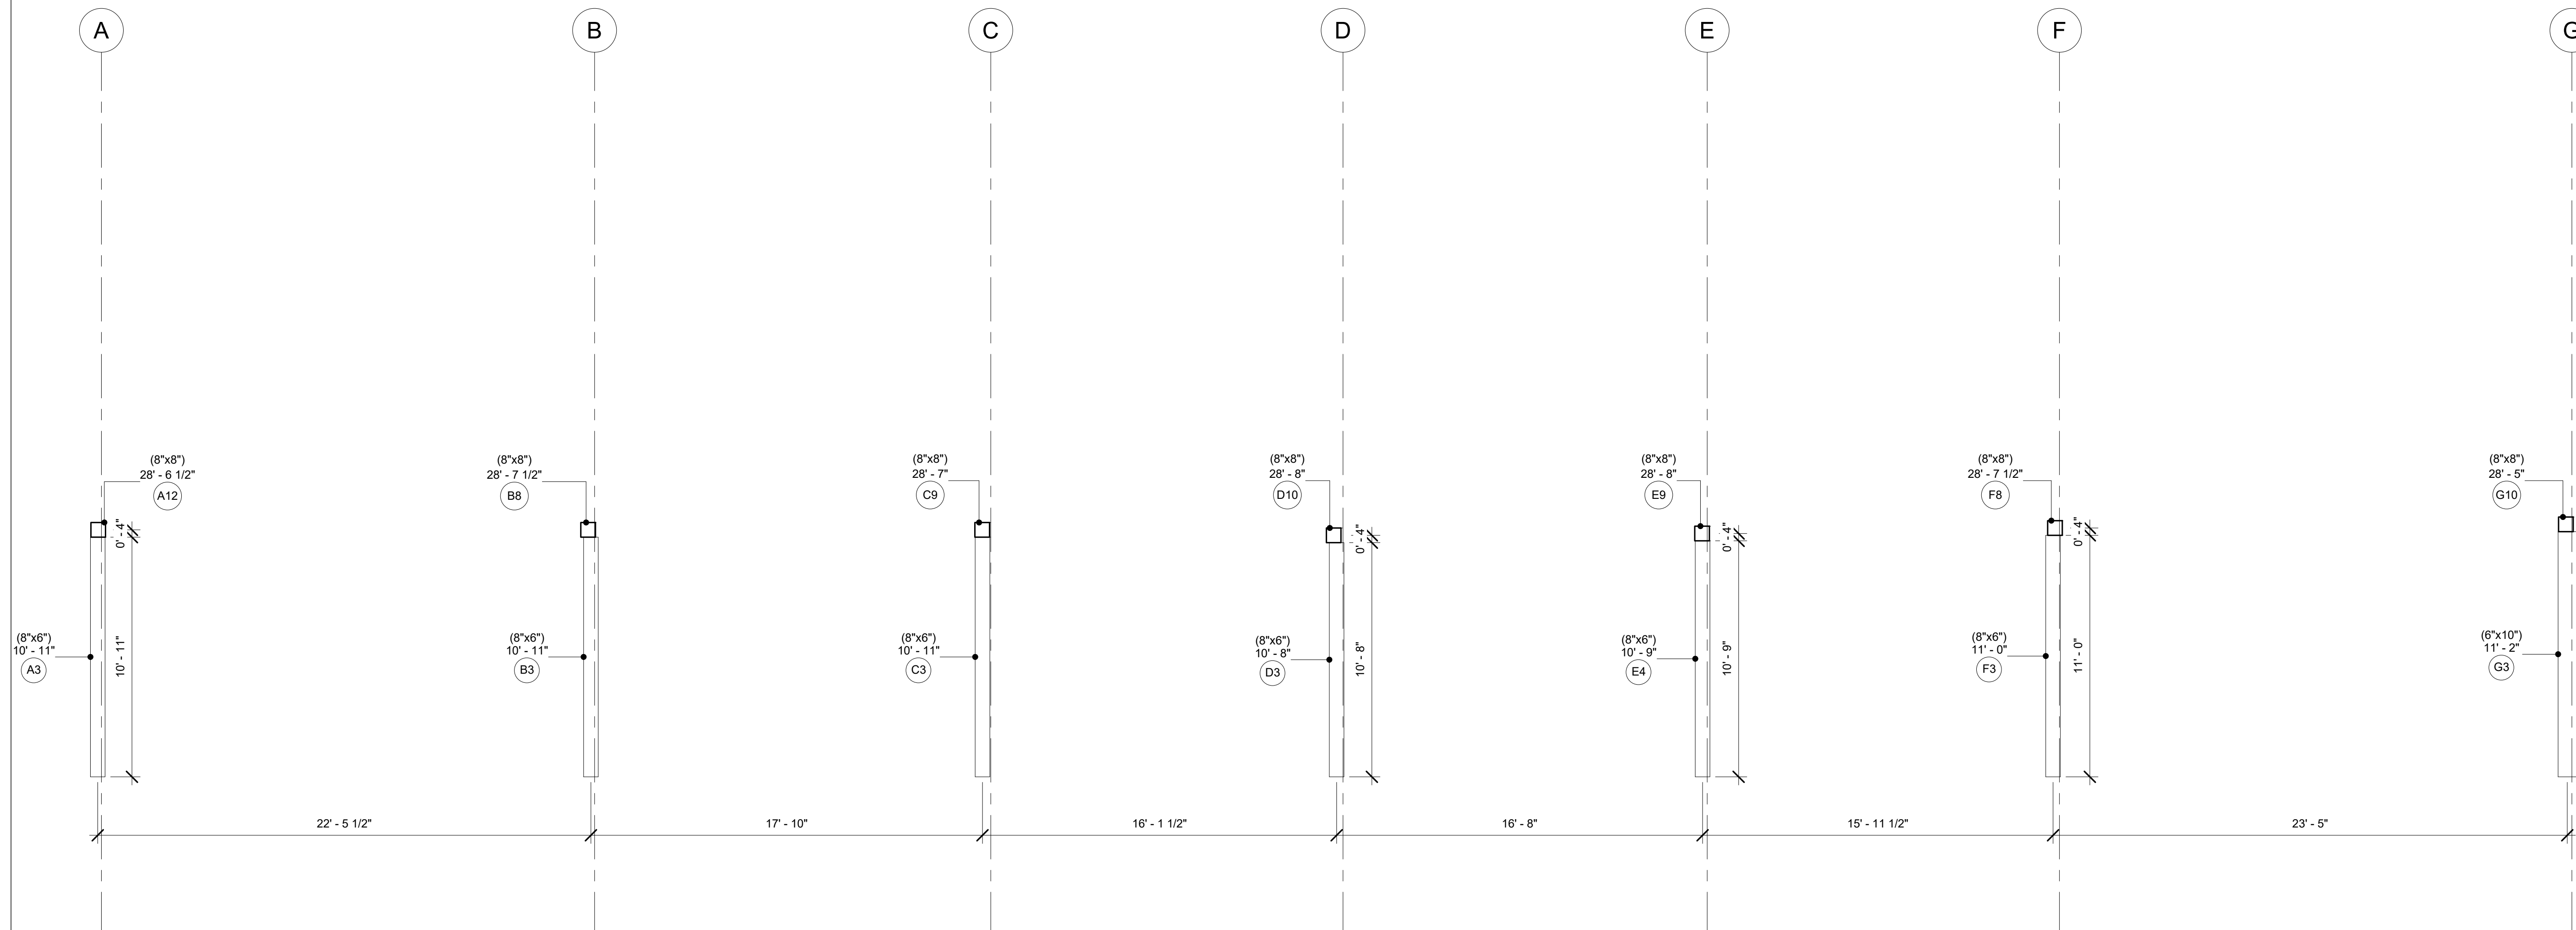

Bent 3

Project Number Project 5
Date 20240902
Drawn By
Checked By

A112

Scale 1/4" = 1'-0"

Bay & Bent


80 Old Gate Road,
Penn Run PA, 15765

DAN TRIMBLE
AA66 / TIMBER HOME SERVICES

CELL PHONE/TEXT - 412-309-1161

EMAIL:

DANTRIMBLE@TIMBERHOMESERVICES.COM

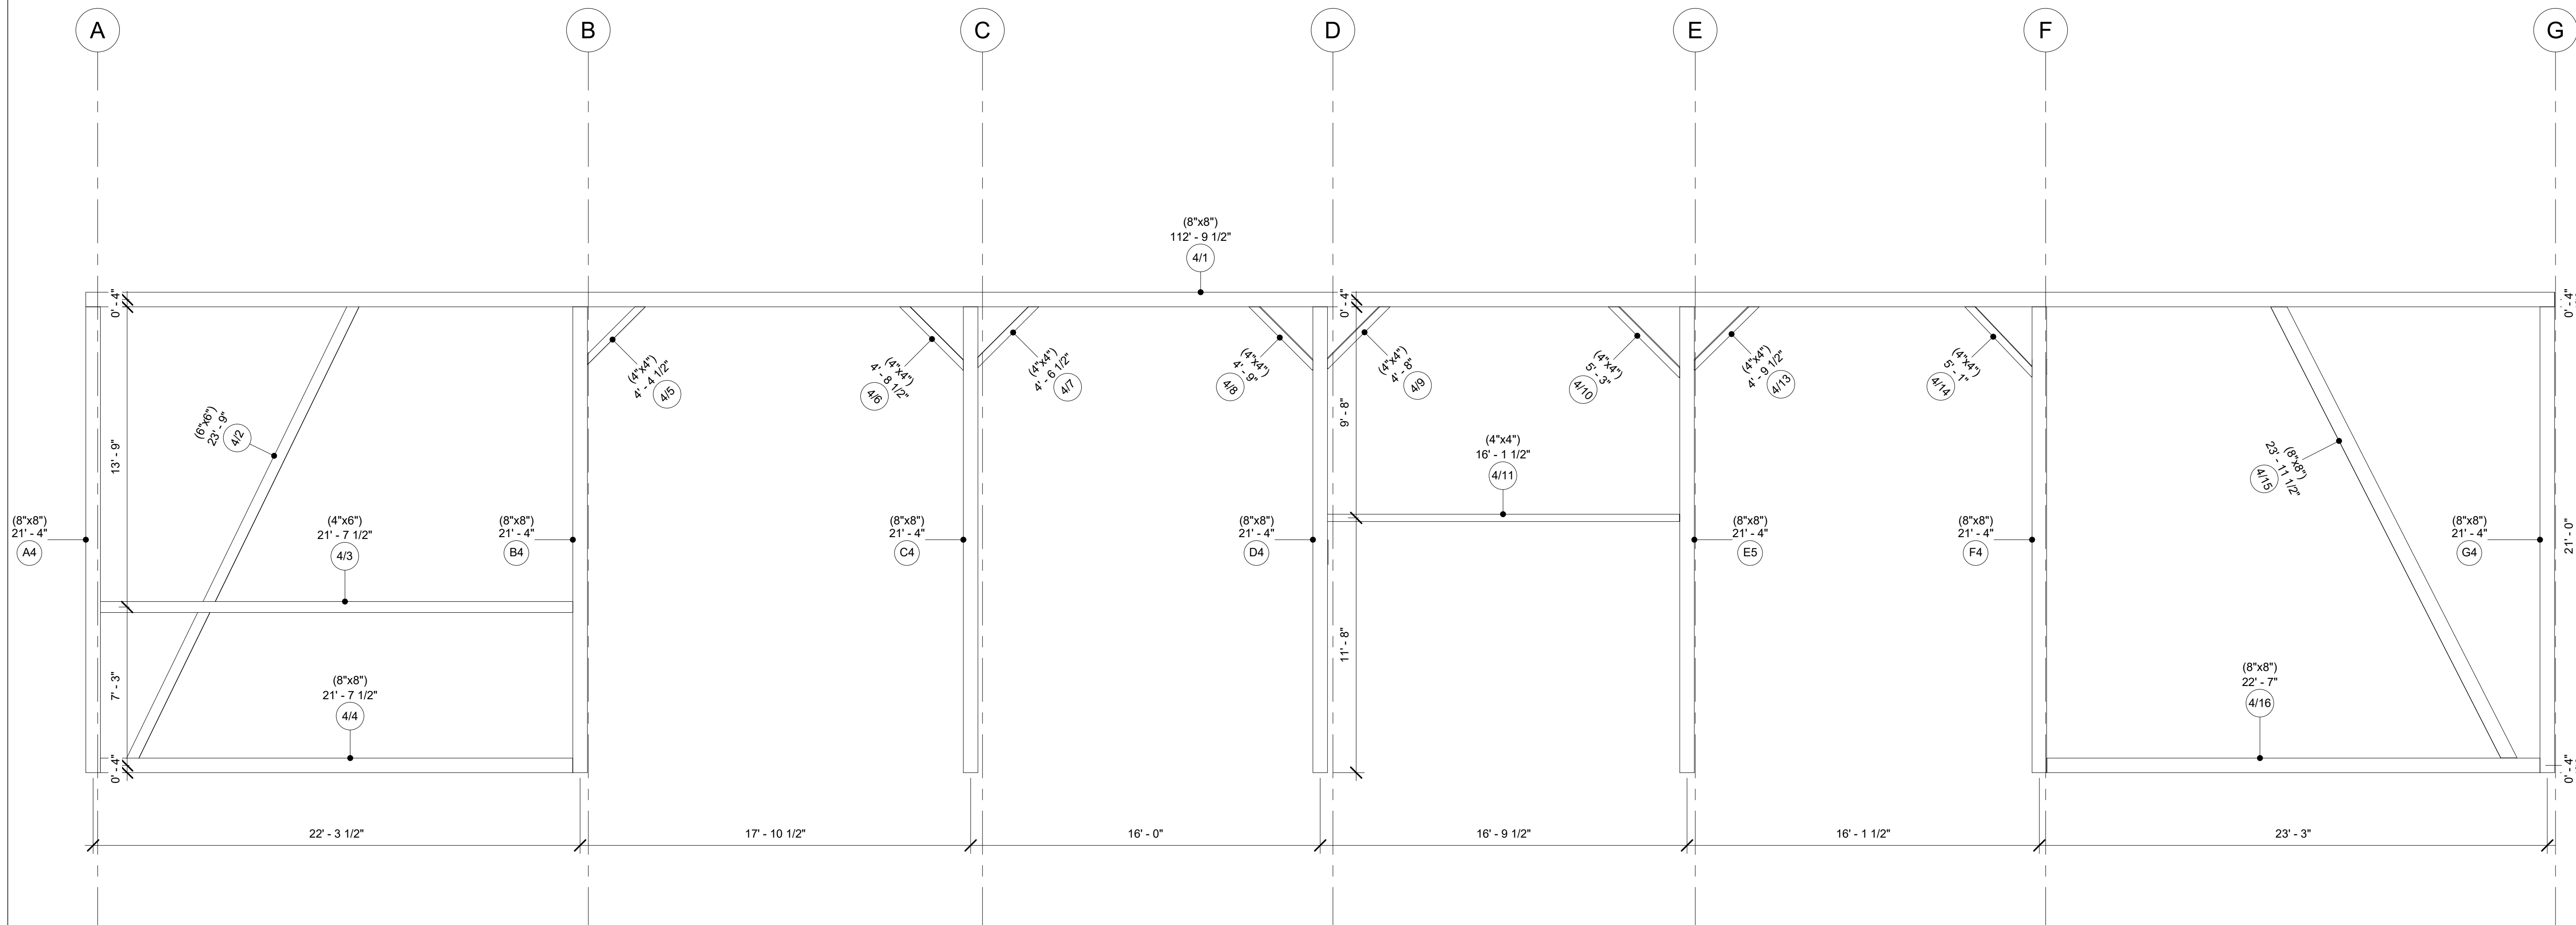

Bent 4

Project Number Project 5

Date 20240902

Drawn By

Checked By

A113

Scale 1/4" = 1'-0"

Bay & Bent


80 Old Gate Road,
Penn Run PA, 15765

DAN TRIMBLE
AA66 / TIMBER HOME SERVICES

CELL PHONE/TEXT - 412-309-1161

EMAIL:

DANTRIMBLE@TIMBERHOMESERVICES.COM

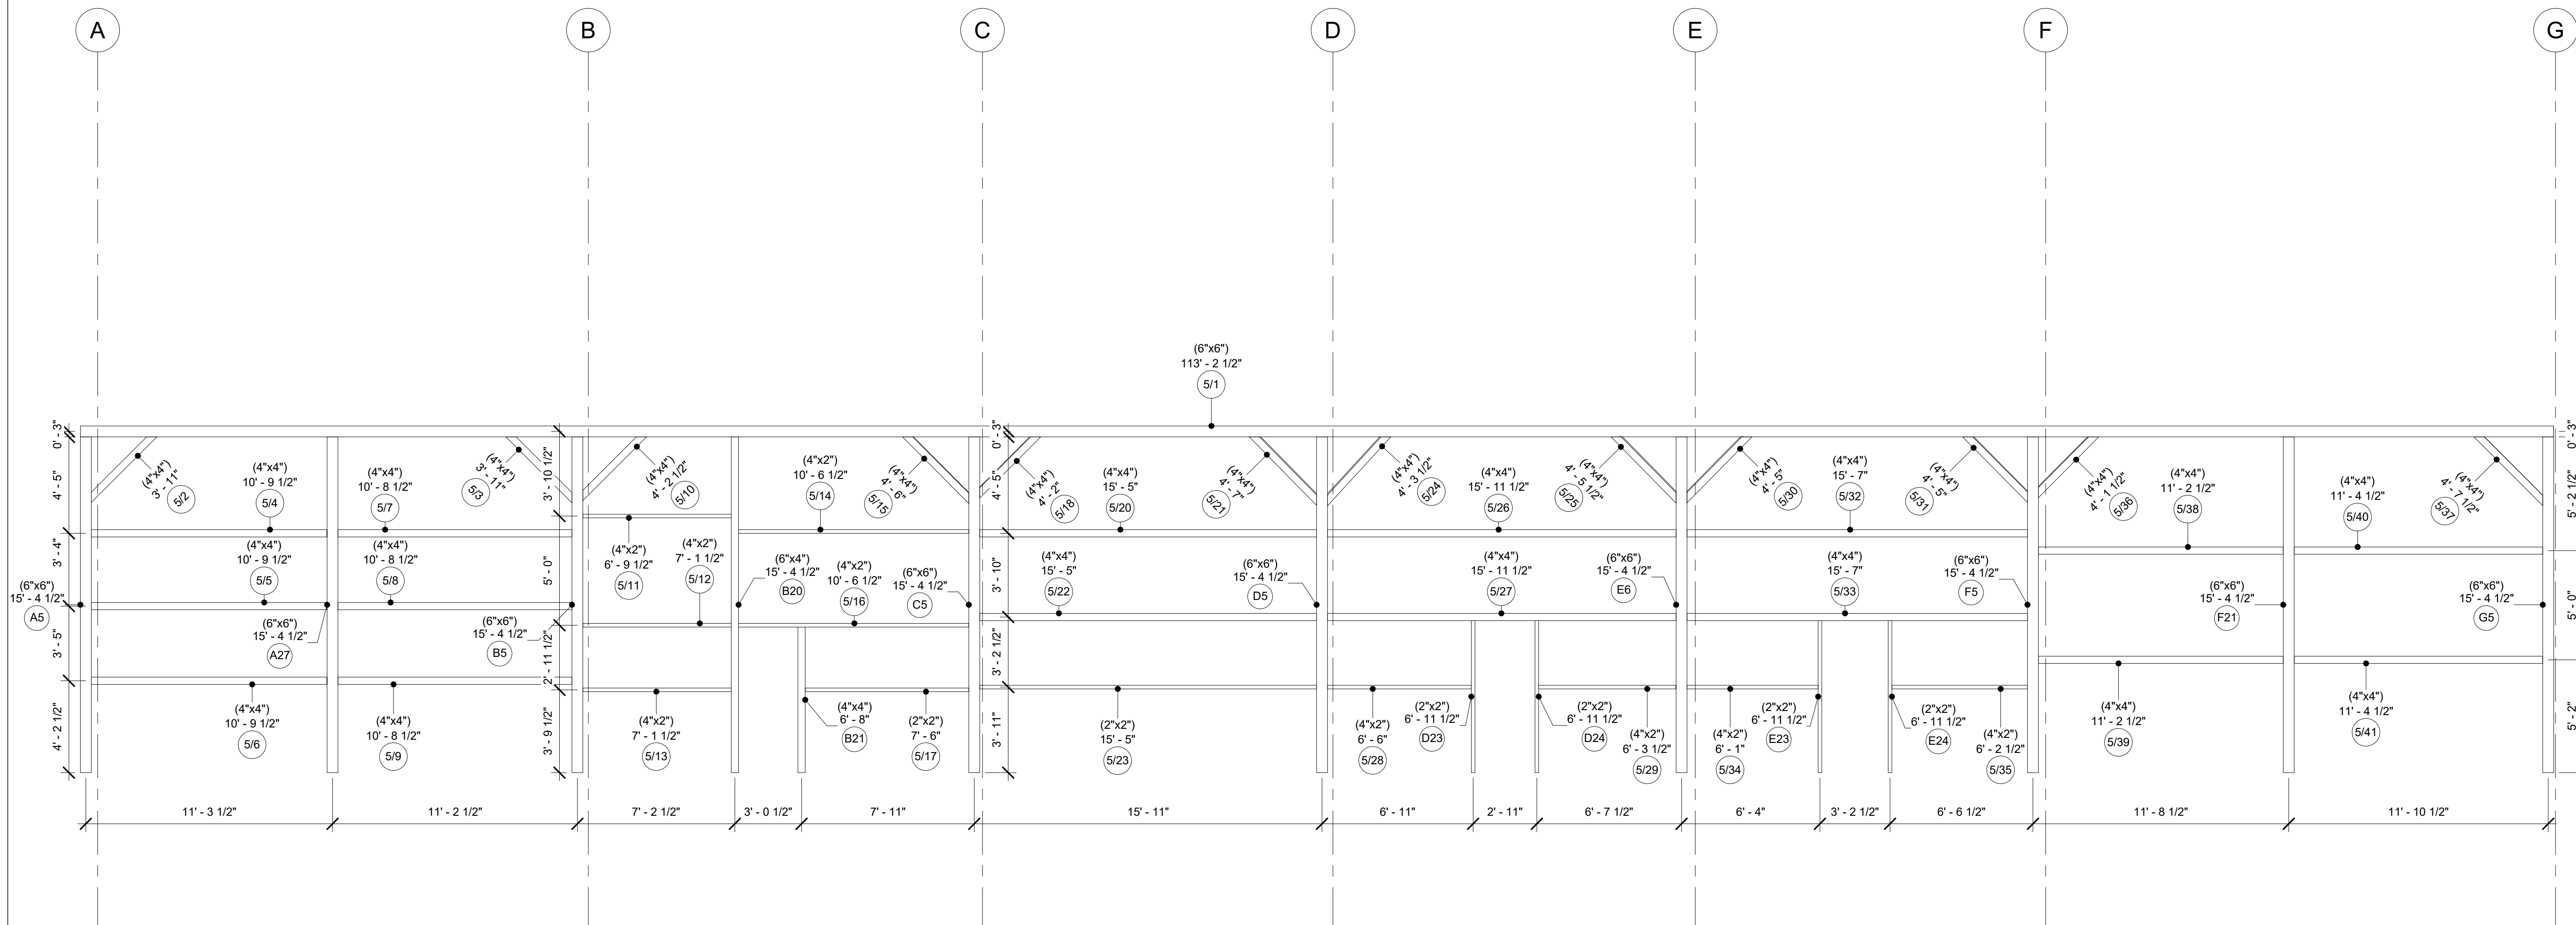

Bent 5

Project Number Project 5

Date 20240902

Drawn By

Checked By

A114

Scale 1/4" = 1'-0"

Bay & Bent


80 Old Gate Road,
Penn Run PA, 15765

DAN TRIMBLE
AA66 / TIMBER HOME SERVICES

CELL PHONE/TEXT - 412-309-1161

EMAIL:

DANTRIMBLE@TIMBERHOMESERVICES.COM

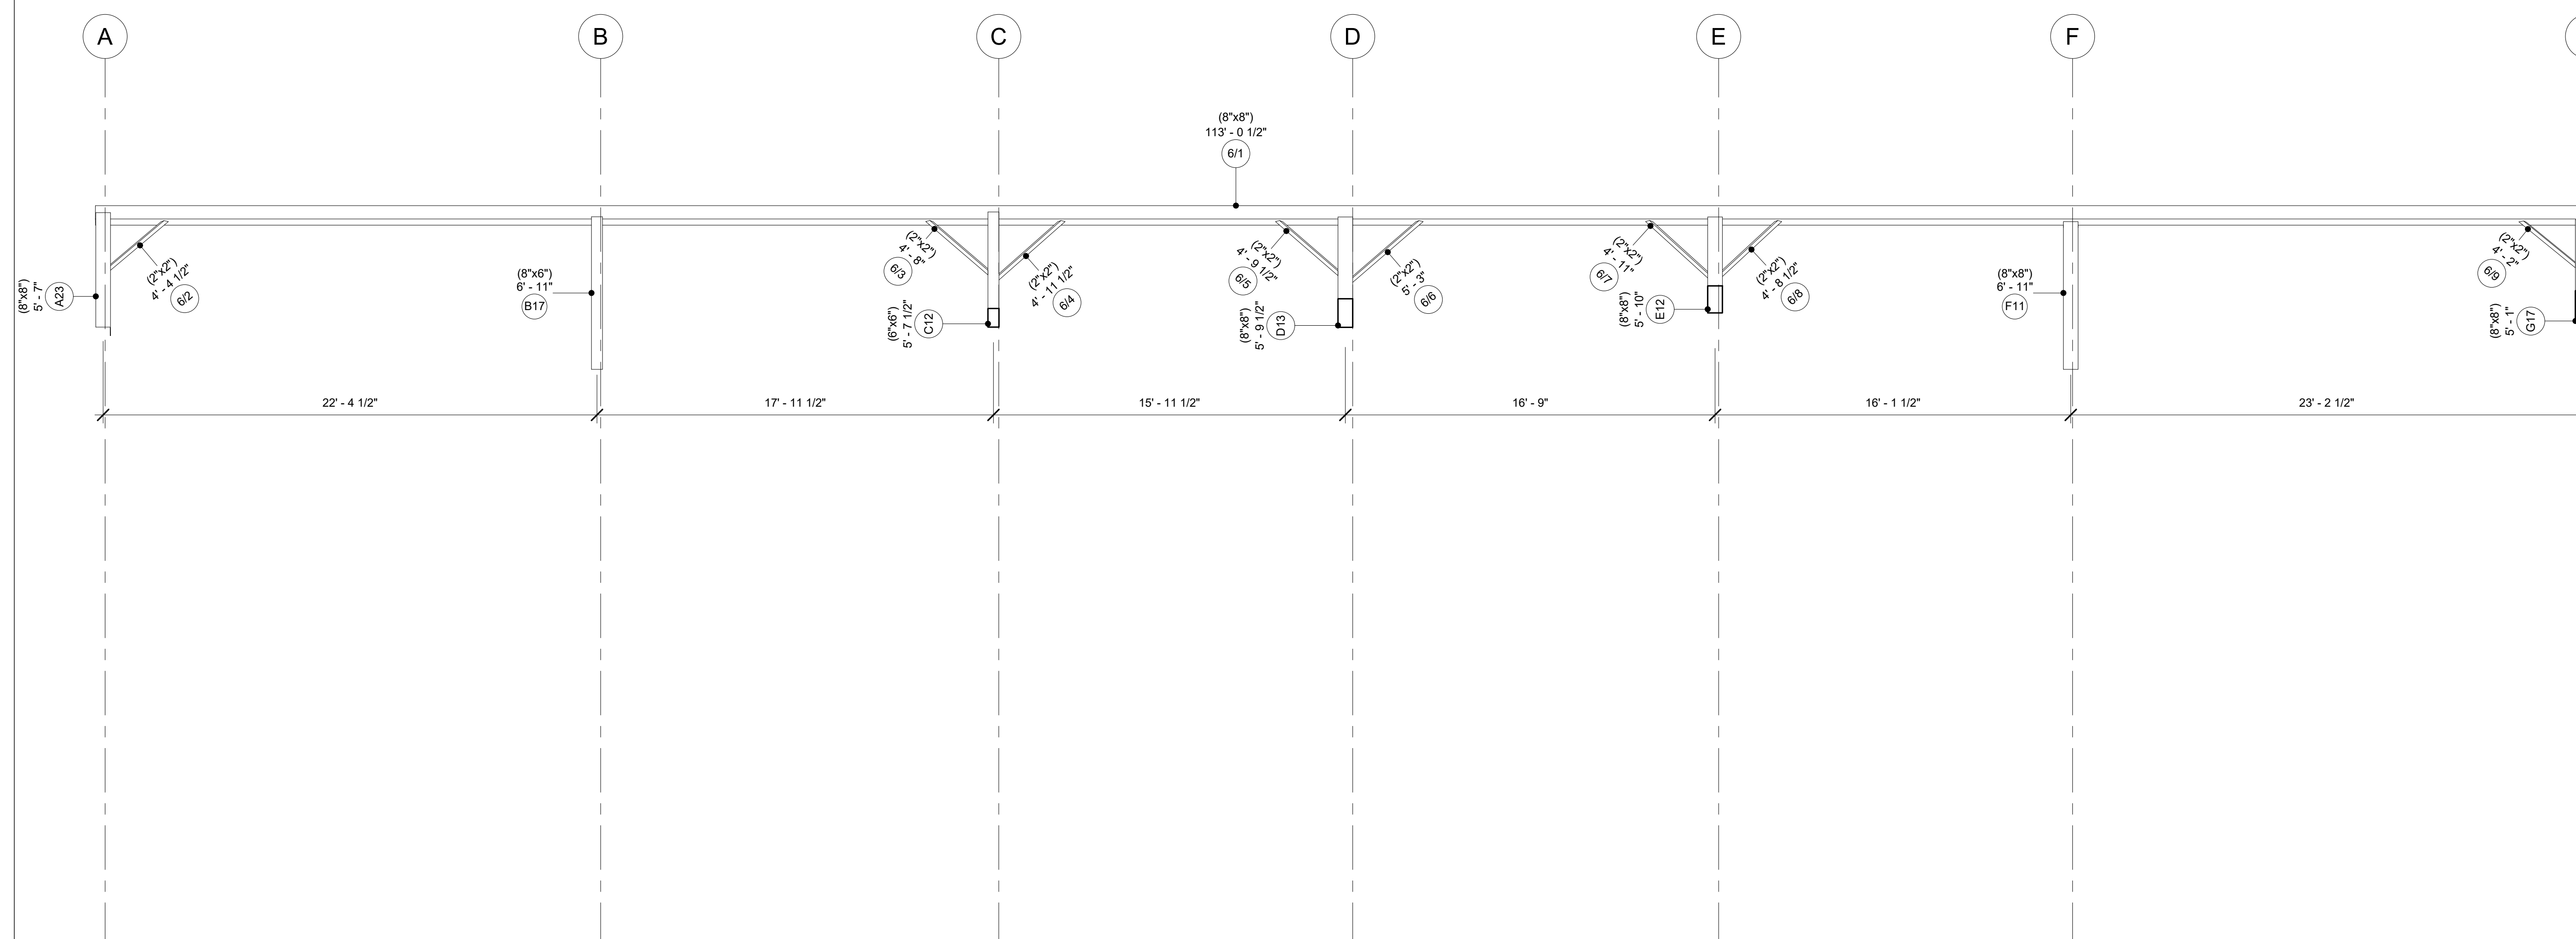

Bent 6

Project Number Project 5

Date 20240902

Drawn By

Checked By

A115

Scale 1/4" = 1'-0"

Bay & Bent


80 Old Gate Road,
Penn Run PA, 15765

DAN TRIMBLE
AA66 / TIMBER HOME SERVICES

CELL PHONE/TEXT - 412-309-1161

EMAIL:

DANTRIMBLE@TIMBERHOMESERVICES.COM

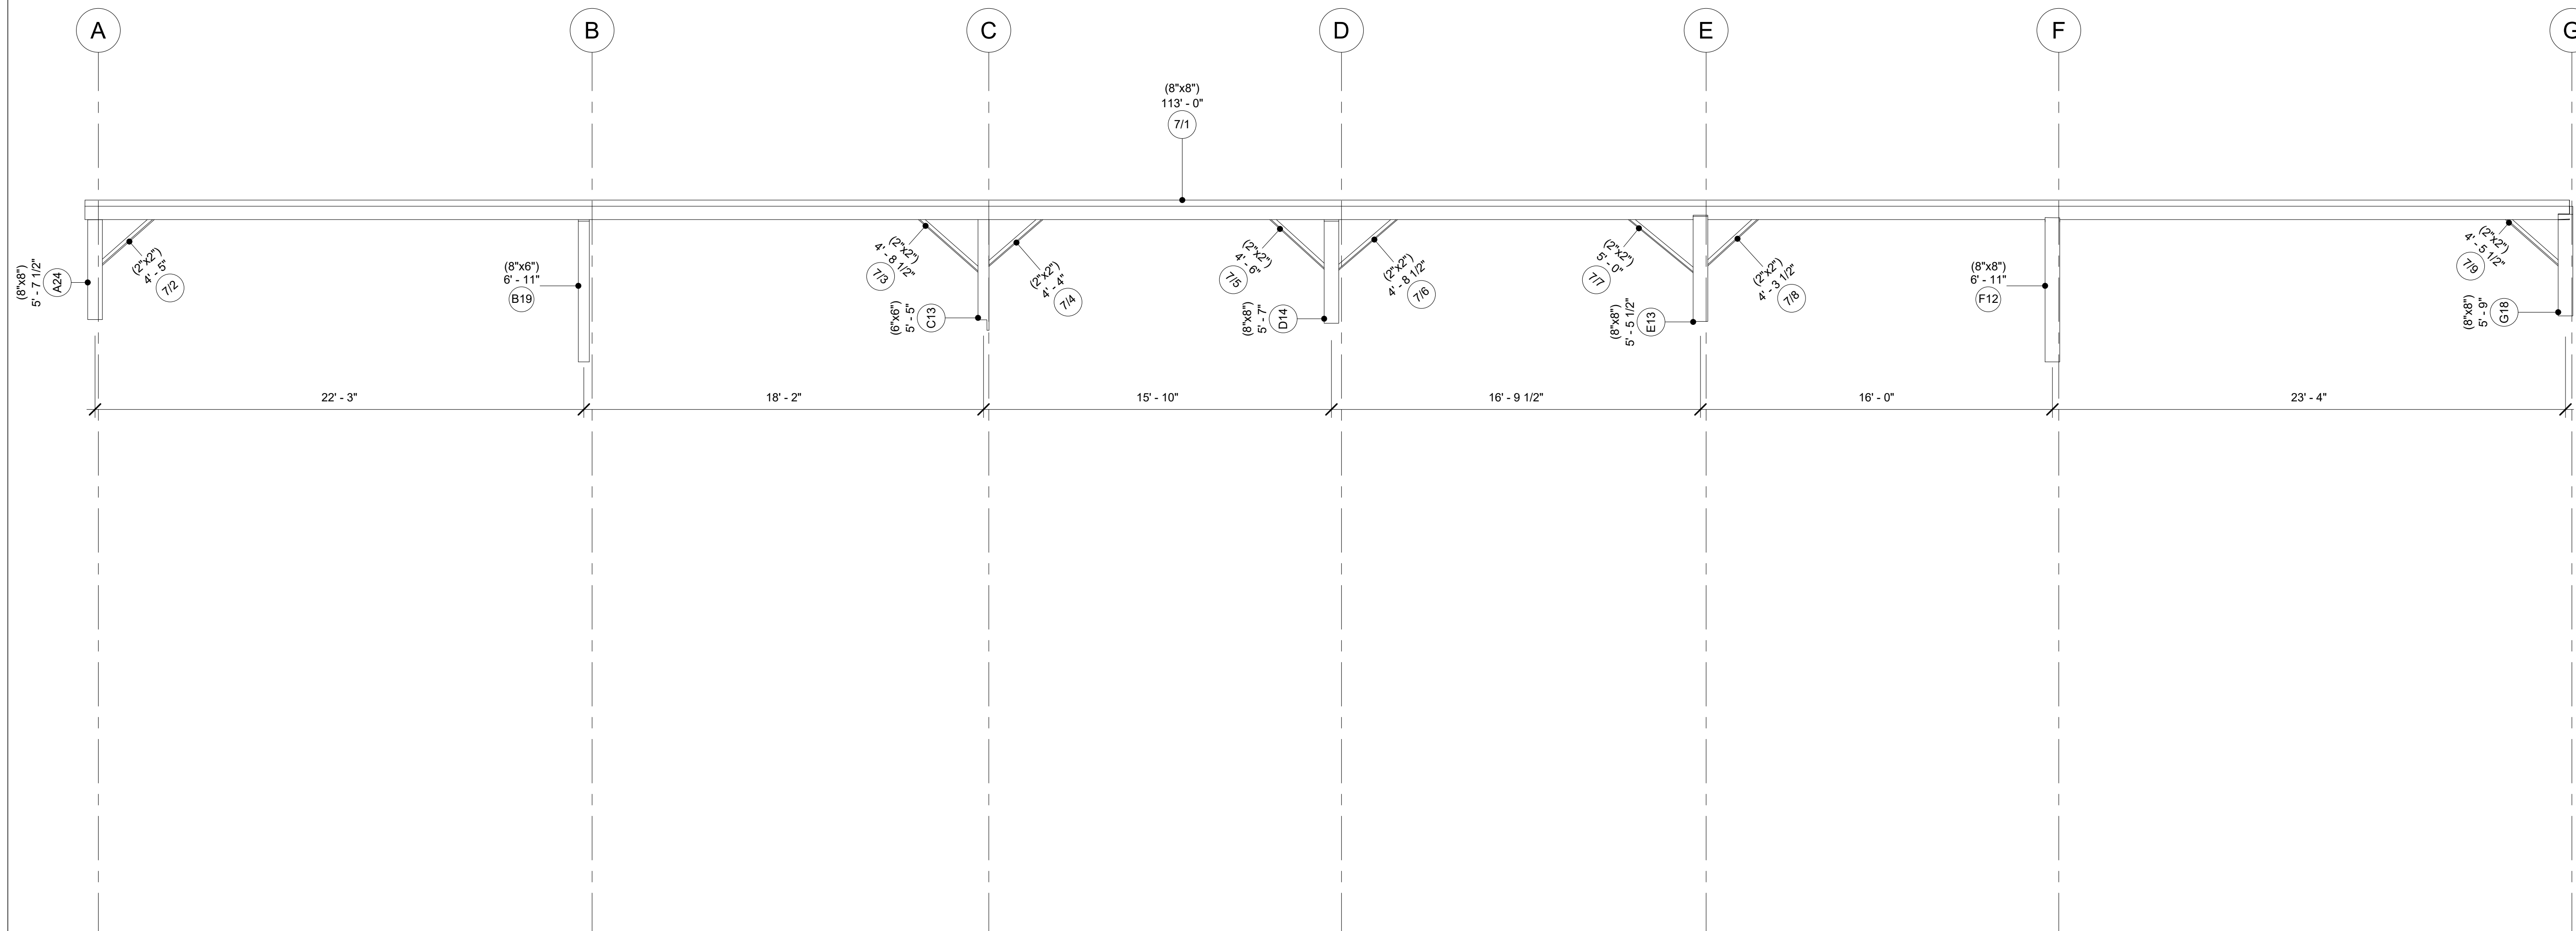

Bent 7

Project Number Project 5

Date 20240902

Drawn By

Checked By

A116

Scale 1/4" = 1'-0"