


PROJECT: Fox Den Barn
SCOPE: AS BUILT DRAWINGS

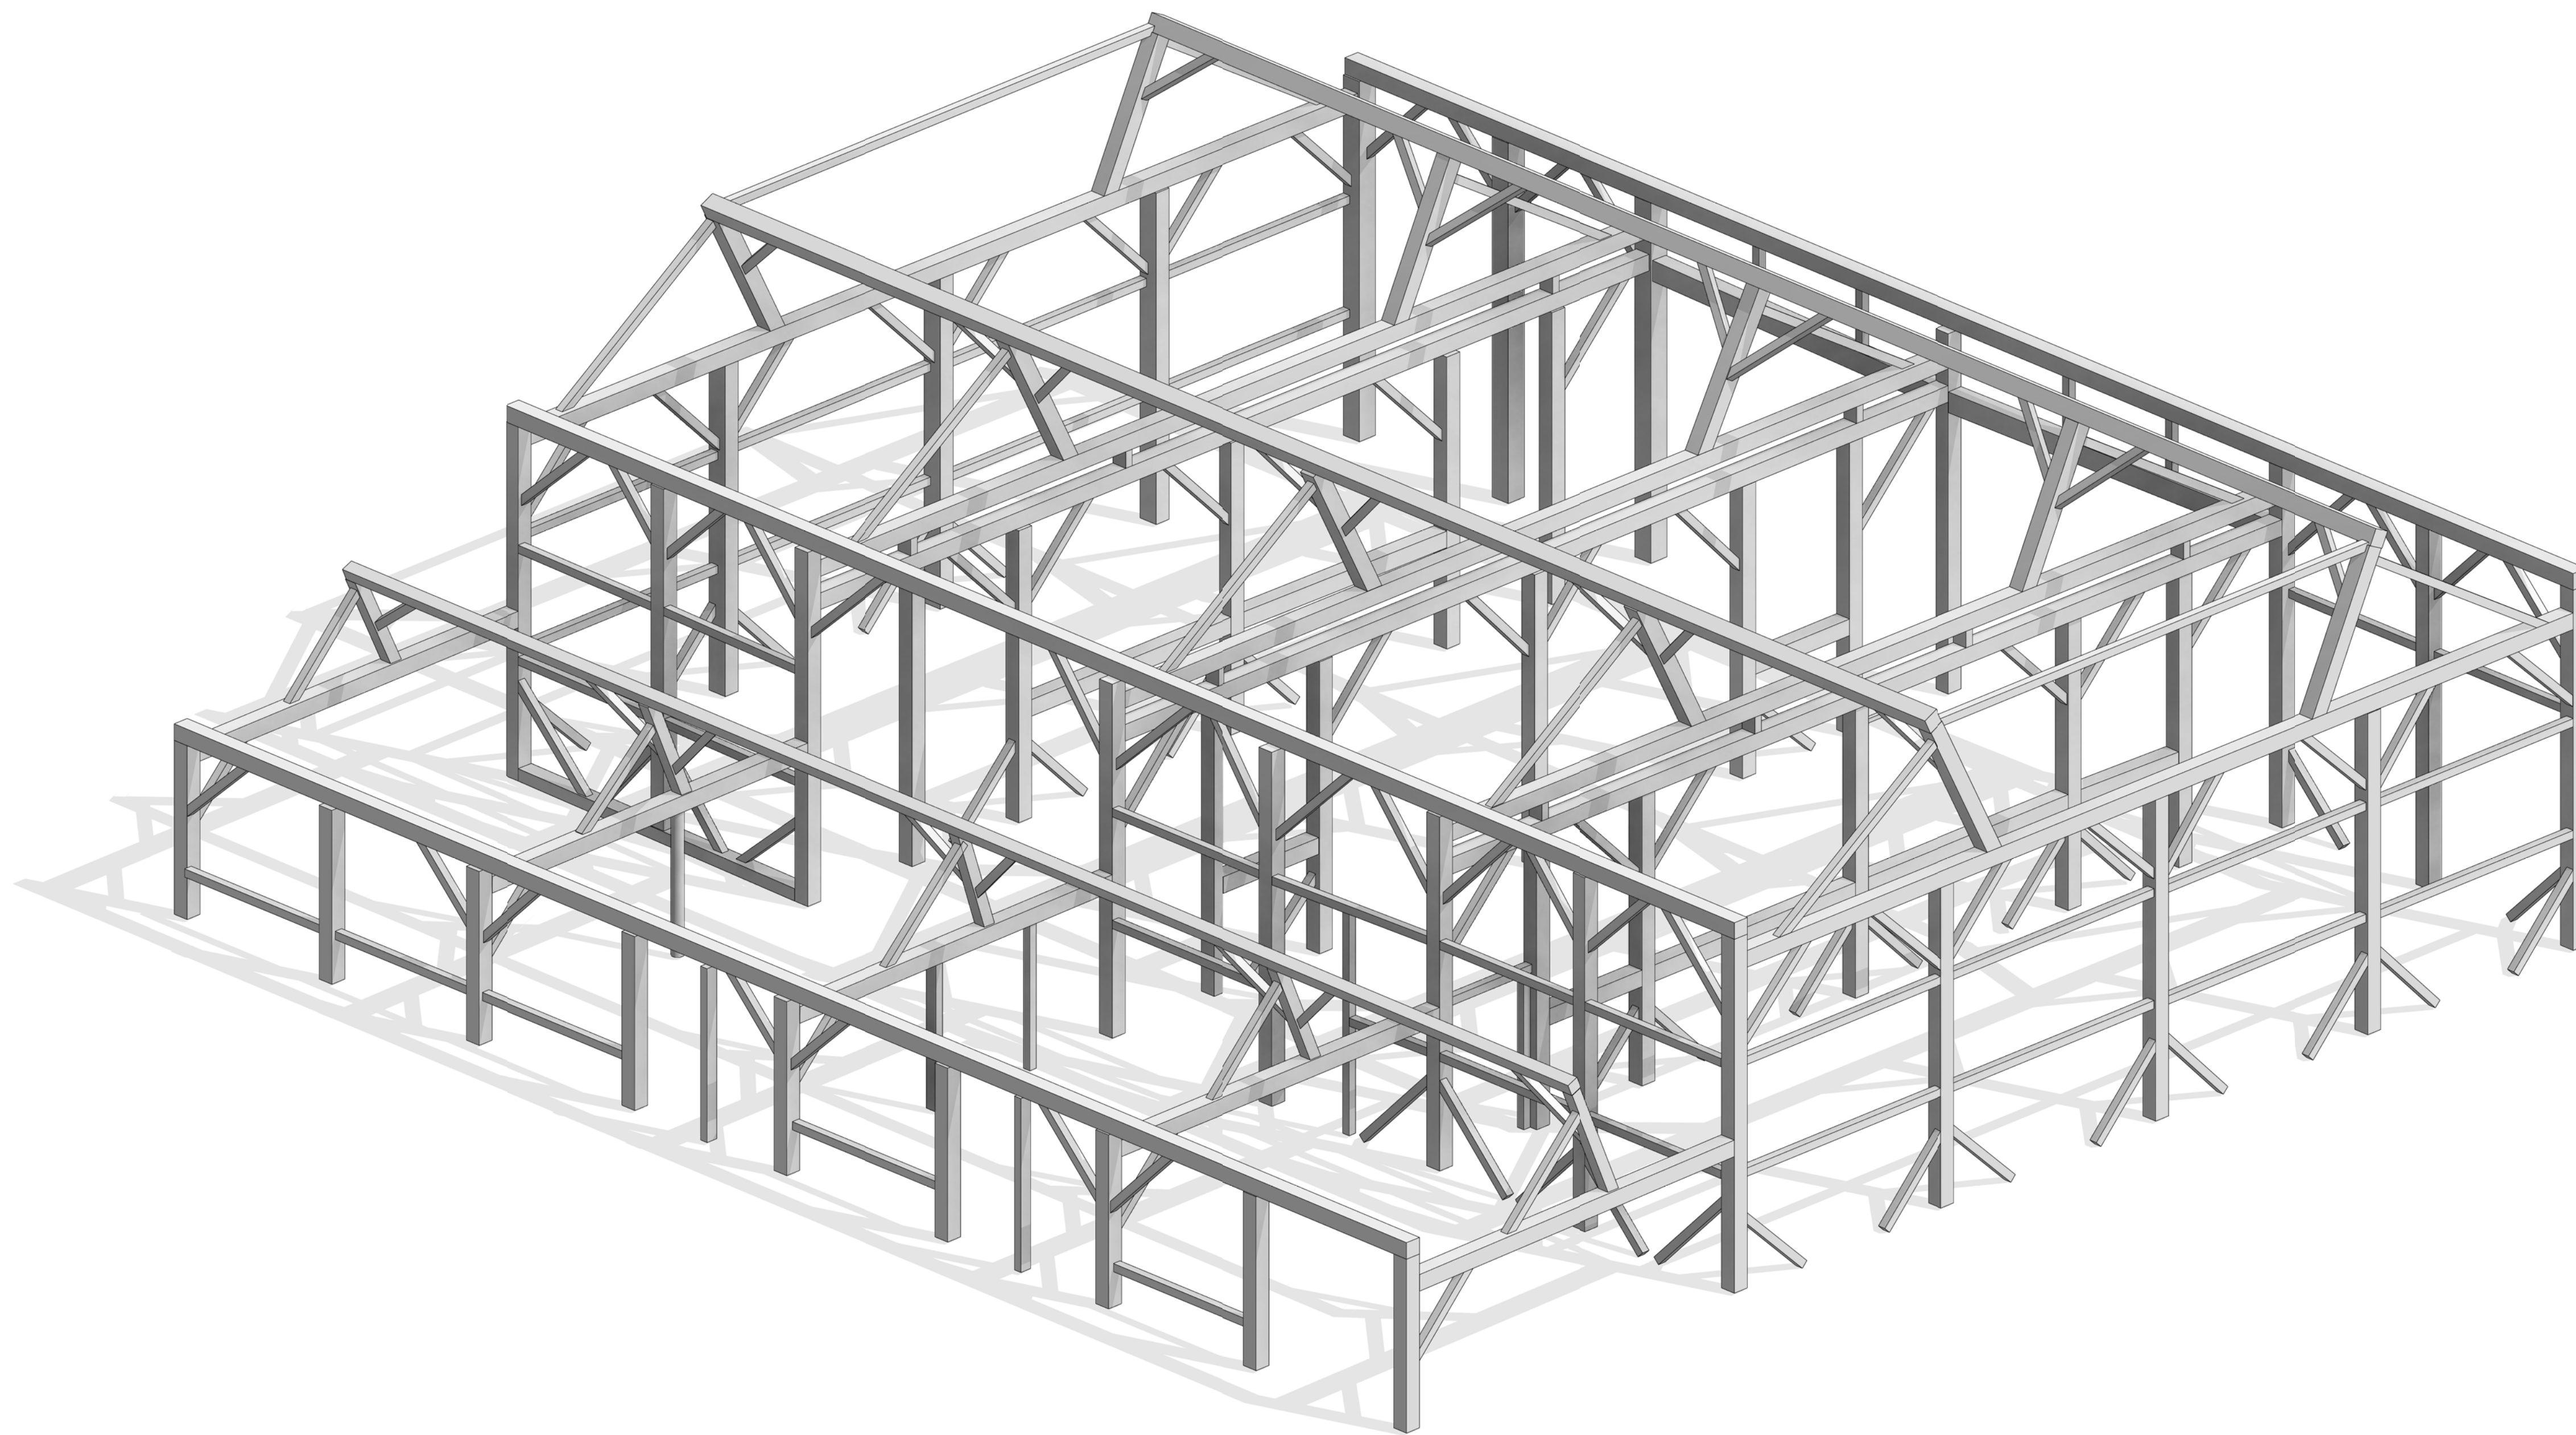

Bay & Bent

80 Old Gate Road,
Penn Run PA, 15765

DAN TRIMBLE
AA66 / TIMBER HOME SERVICES
CELL PHONE/TEXT - 412-309-1161

EMAIL:
DANTRIMBLE@TIMBERHOMESERVICES.COM

Cover Page

Project Number	Project 6
Date	20240912
Drawn By	
Checked By	

A101

Scale

Bay & Bent


80 Old Gate Road,
Penn Run PA, 15765

DAN TRIMBLE
AA66 / TIMBER HOME SERVICES

CELL PHONE/TEXT - 412-309-1161

EMAIL:

DANTRIMBLE@TIMBERHOMESERVICES.COM

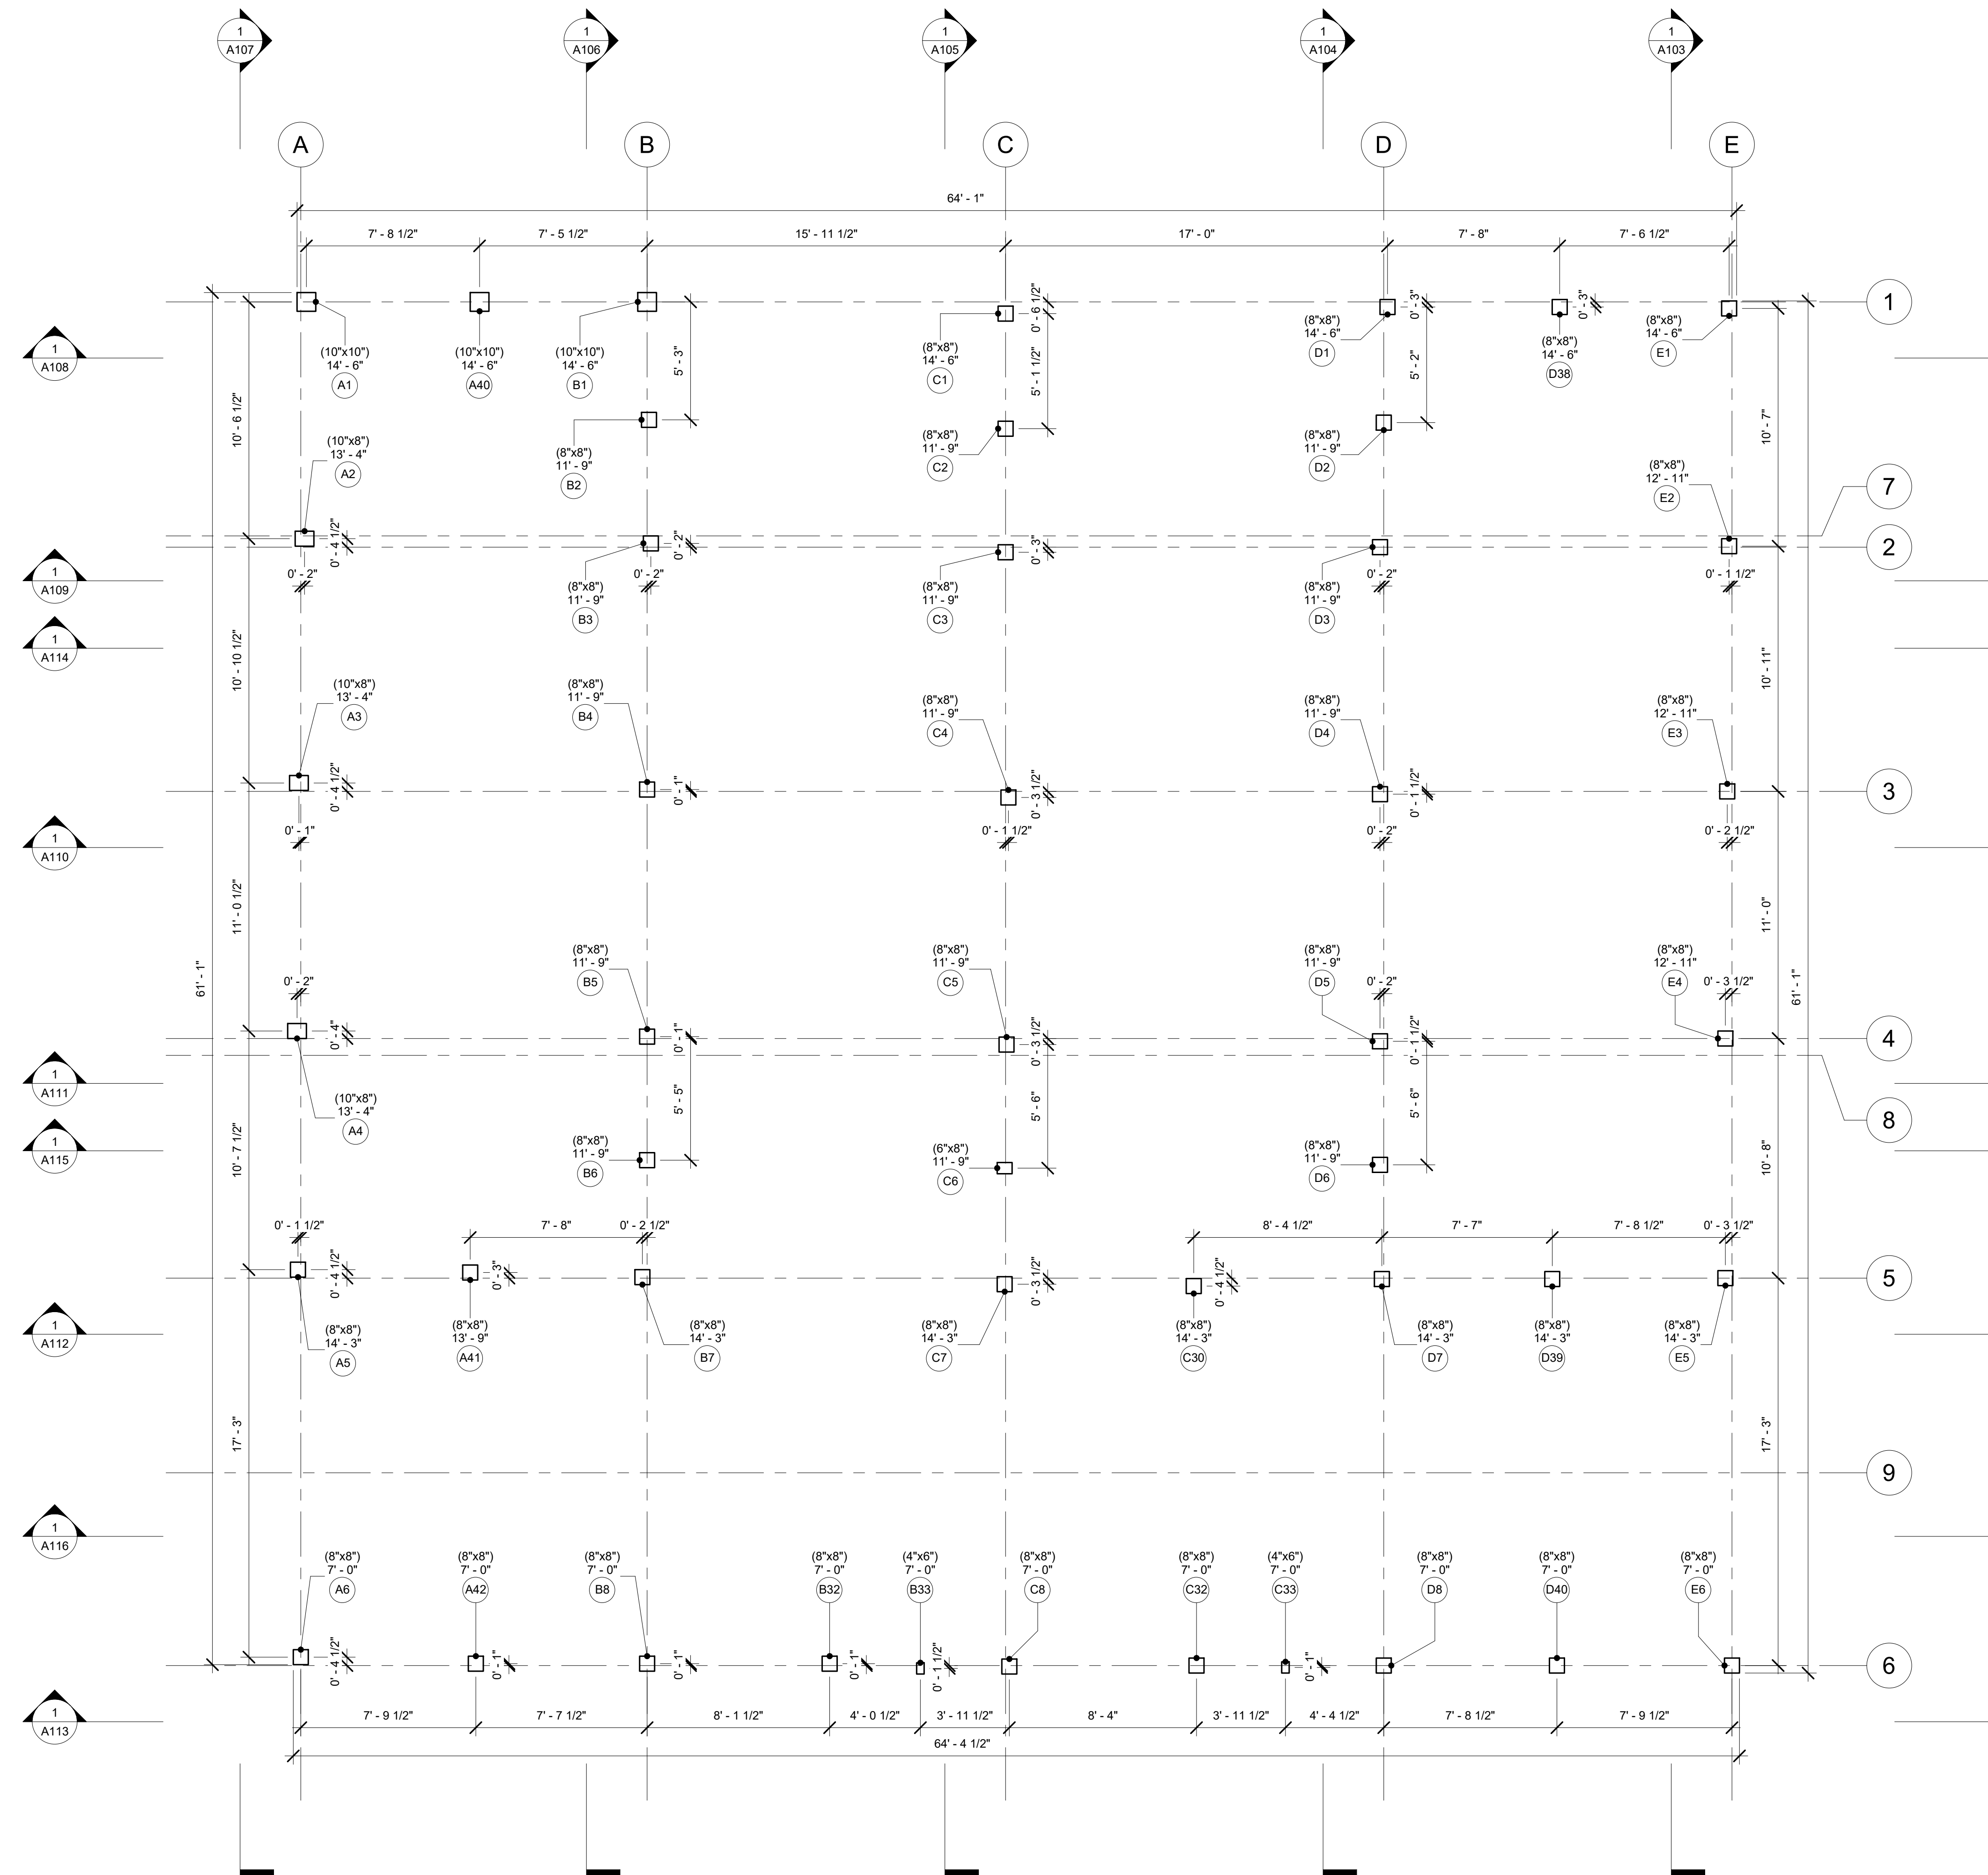

Floor Plan

Project Number Project 6

Date 20240912

Drawn By

Checked By

A102

Scale 1/4" = 1'-0"

Bay & Bent


80 Old Gate Road,
Penn Run PA, 15765

DAN TRIMBLE
AA66 / TIMBER HOME SERVICES

CELL PHONE/TEXT - 412-309-1161

EMAIL:

DANTRIMBLE@TIMBERHOMESERVICES.COM

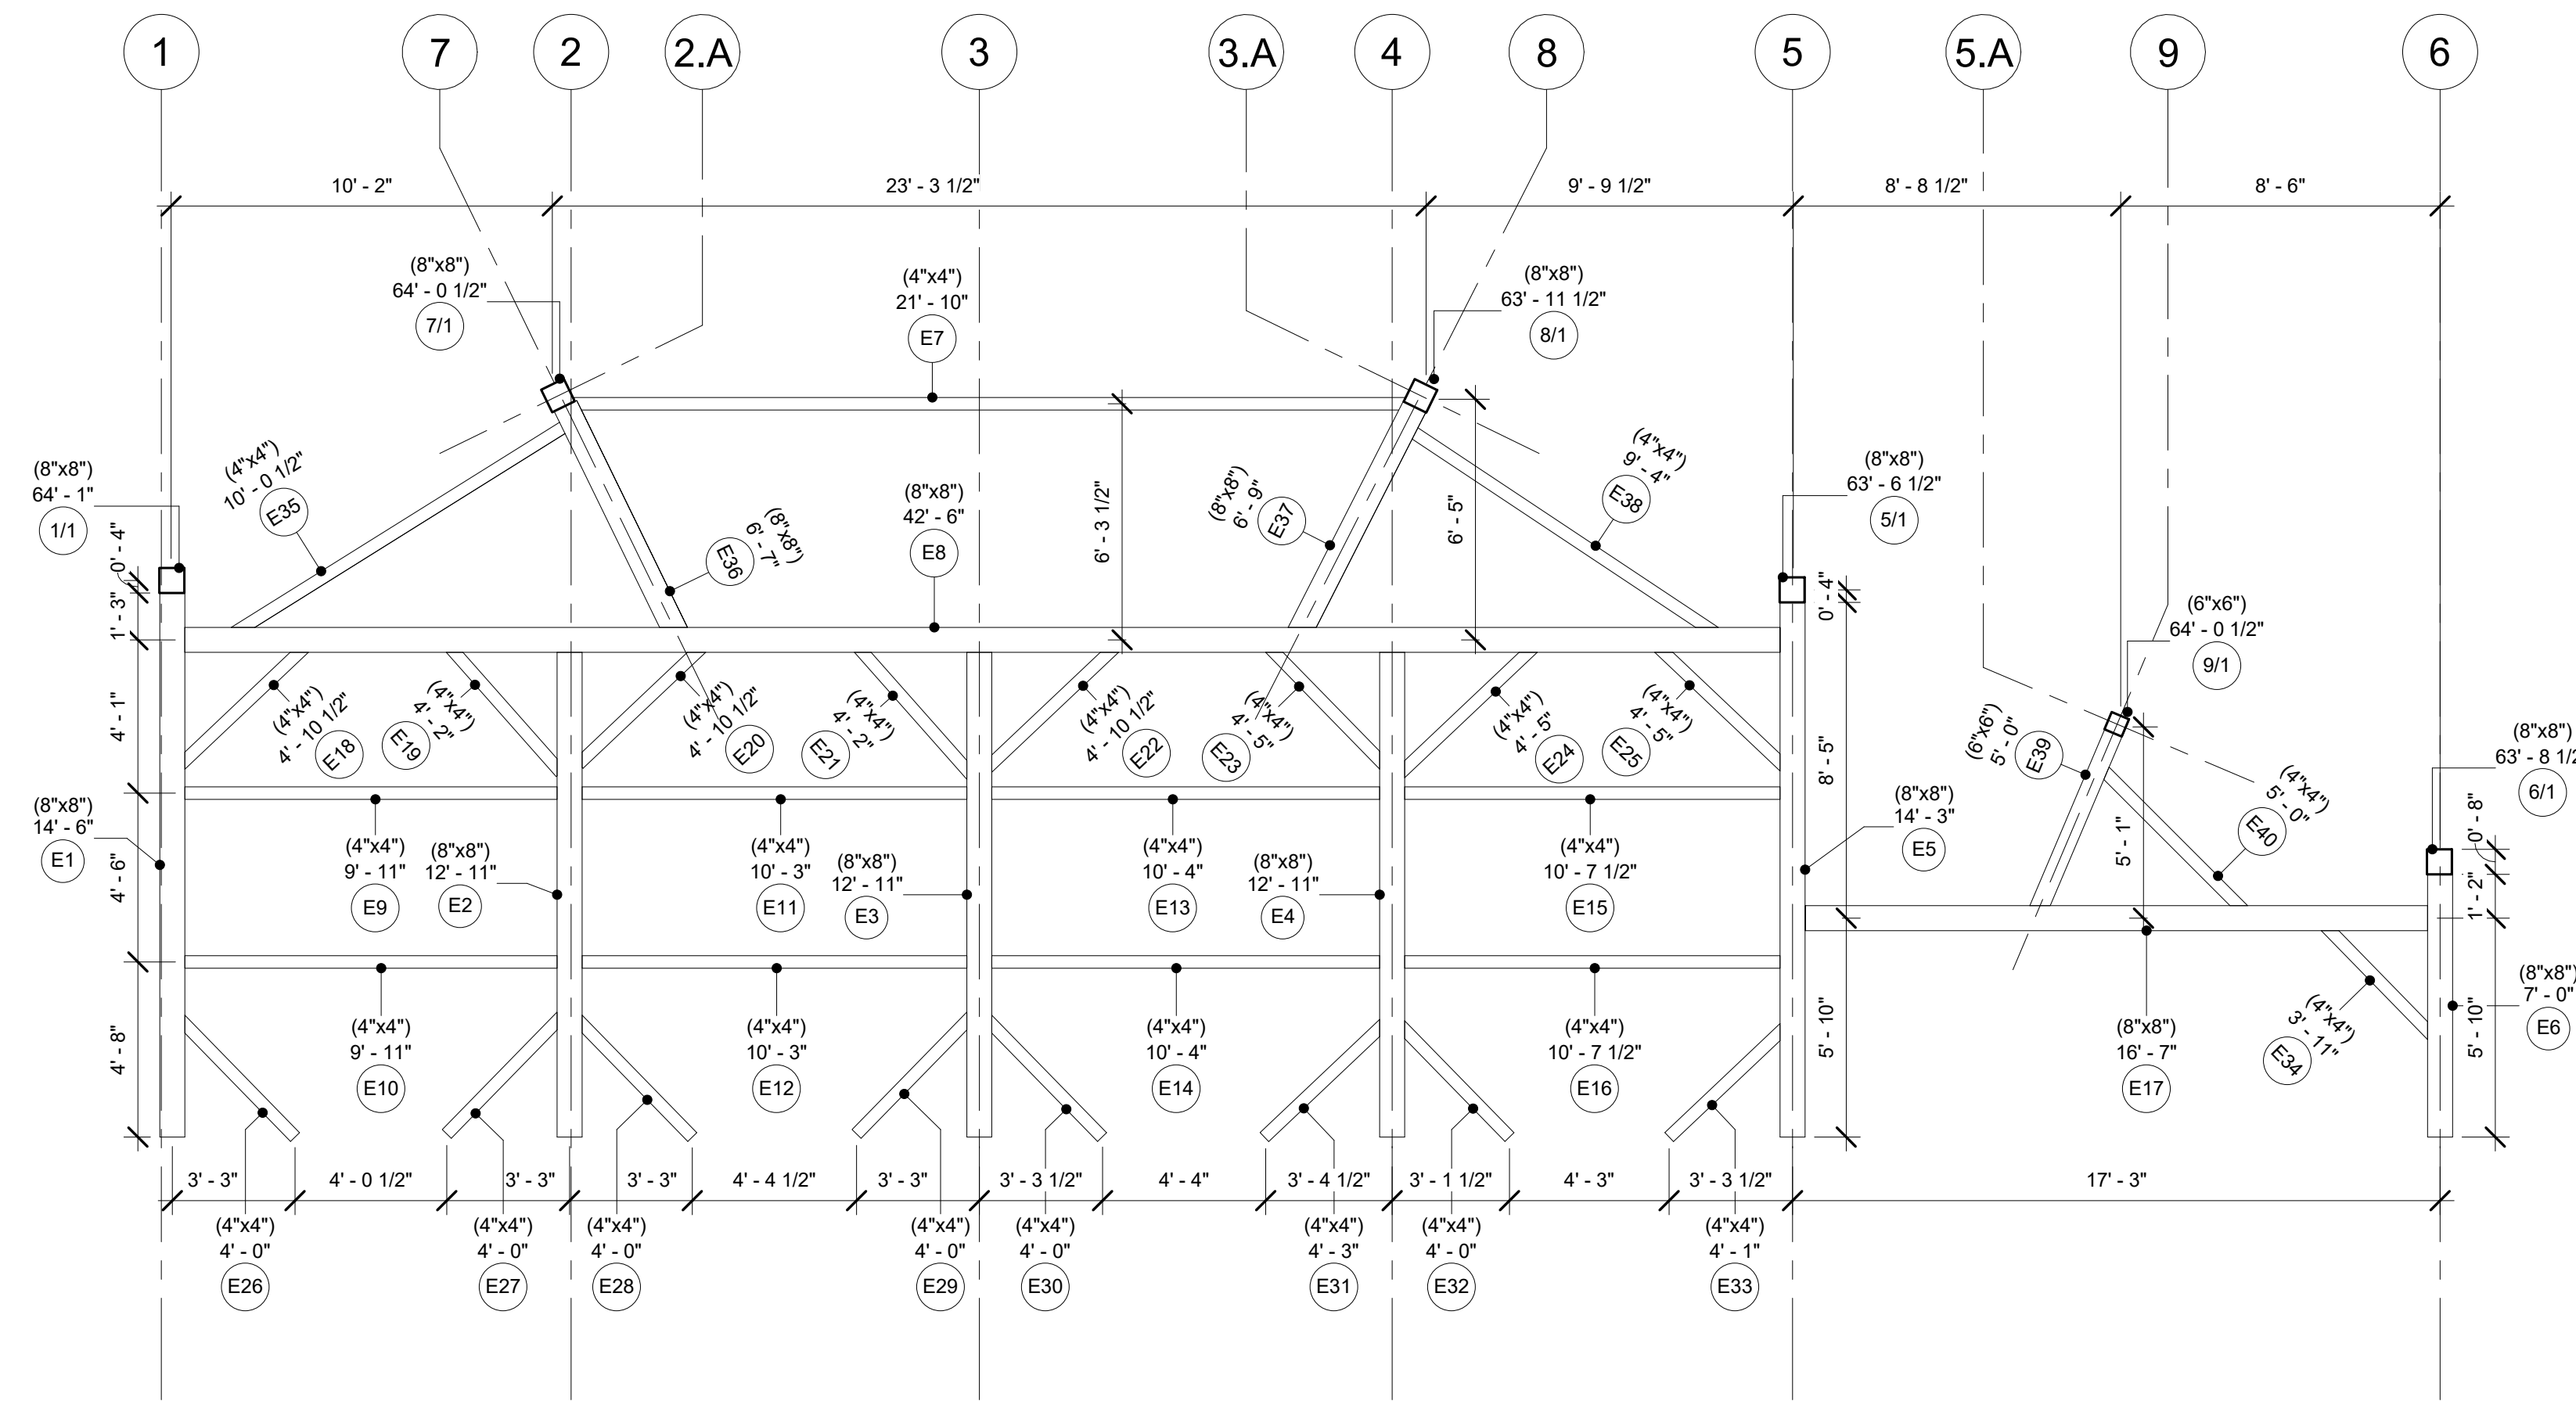

Bent E

Project Number Project 6

Date 20240912

Drawn By

Checked By

A103

Scale 1/4" = 1'-0"

Bay & Bent


80 Old Gate Road,
Penn Run PA, 15765

DAN TRIMBLE
AA66 / TIMBER HOME SERVICES

CELL PHONE/TEXT - 412-309-1161

EMAIL:

DANTRIMBLE@TIMBERHOMESERVICES.COM

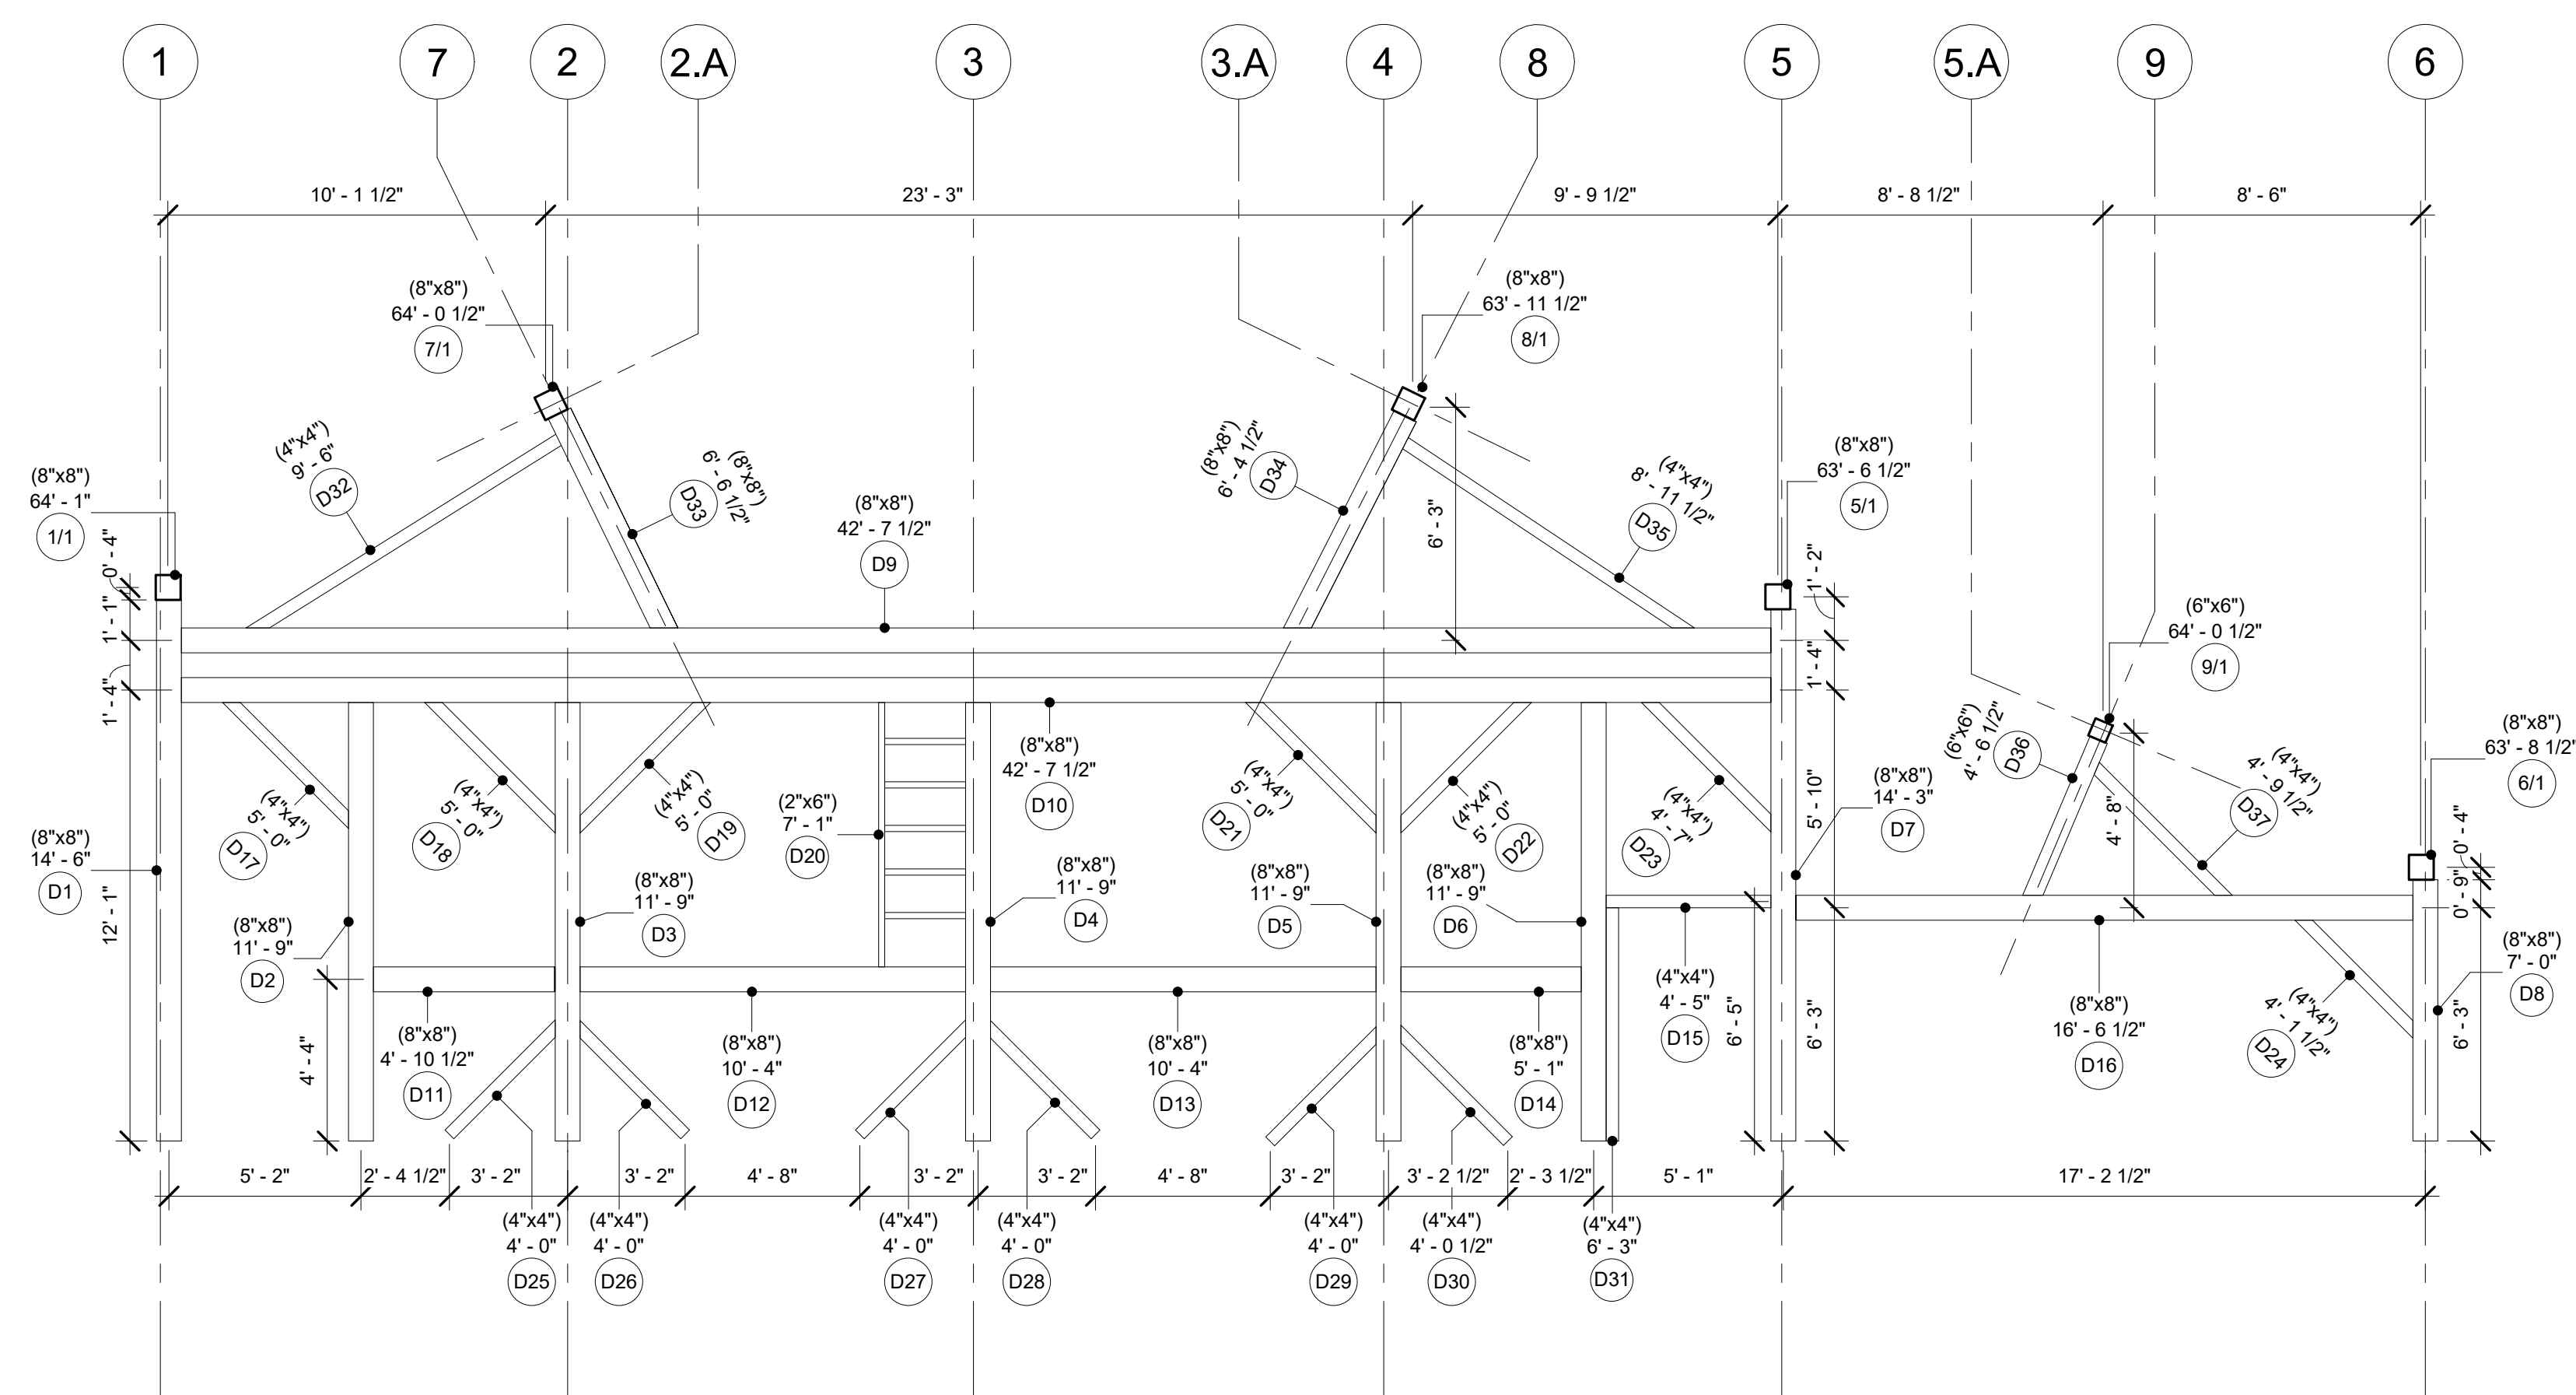

Bent D

Project Number Project 6

Date 20240912

Drawn By

Checked By

A104

Scale 1/4" = 1'-0"

Bay & Bent


80 Old Gate Road,
Penn Run PA, 15765

DAN TRIMBLE
AA66 / TIMBER HOME SERVICES

CELL PHONE/TEXT - 412-309-1161

EMAIL:

DANTRIMBLE@TIMBERHOMESERVICES.COM

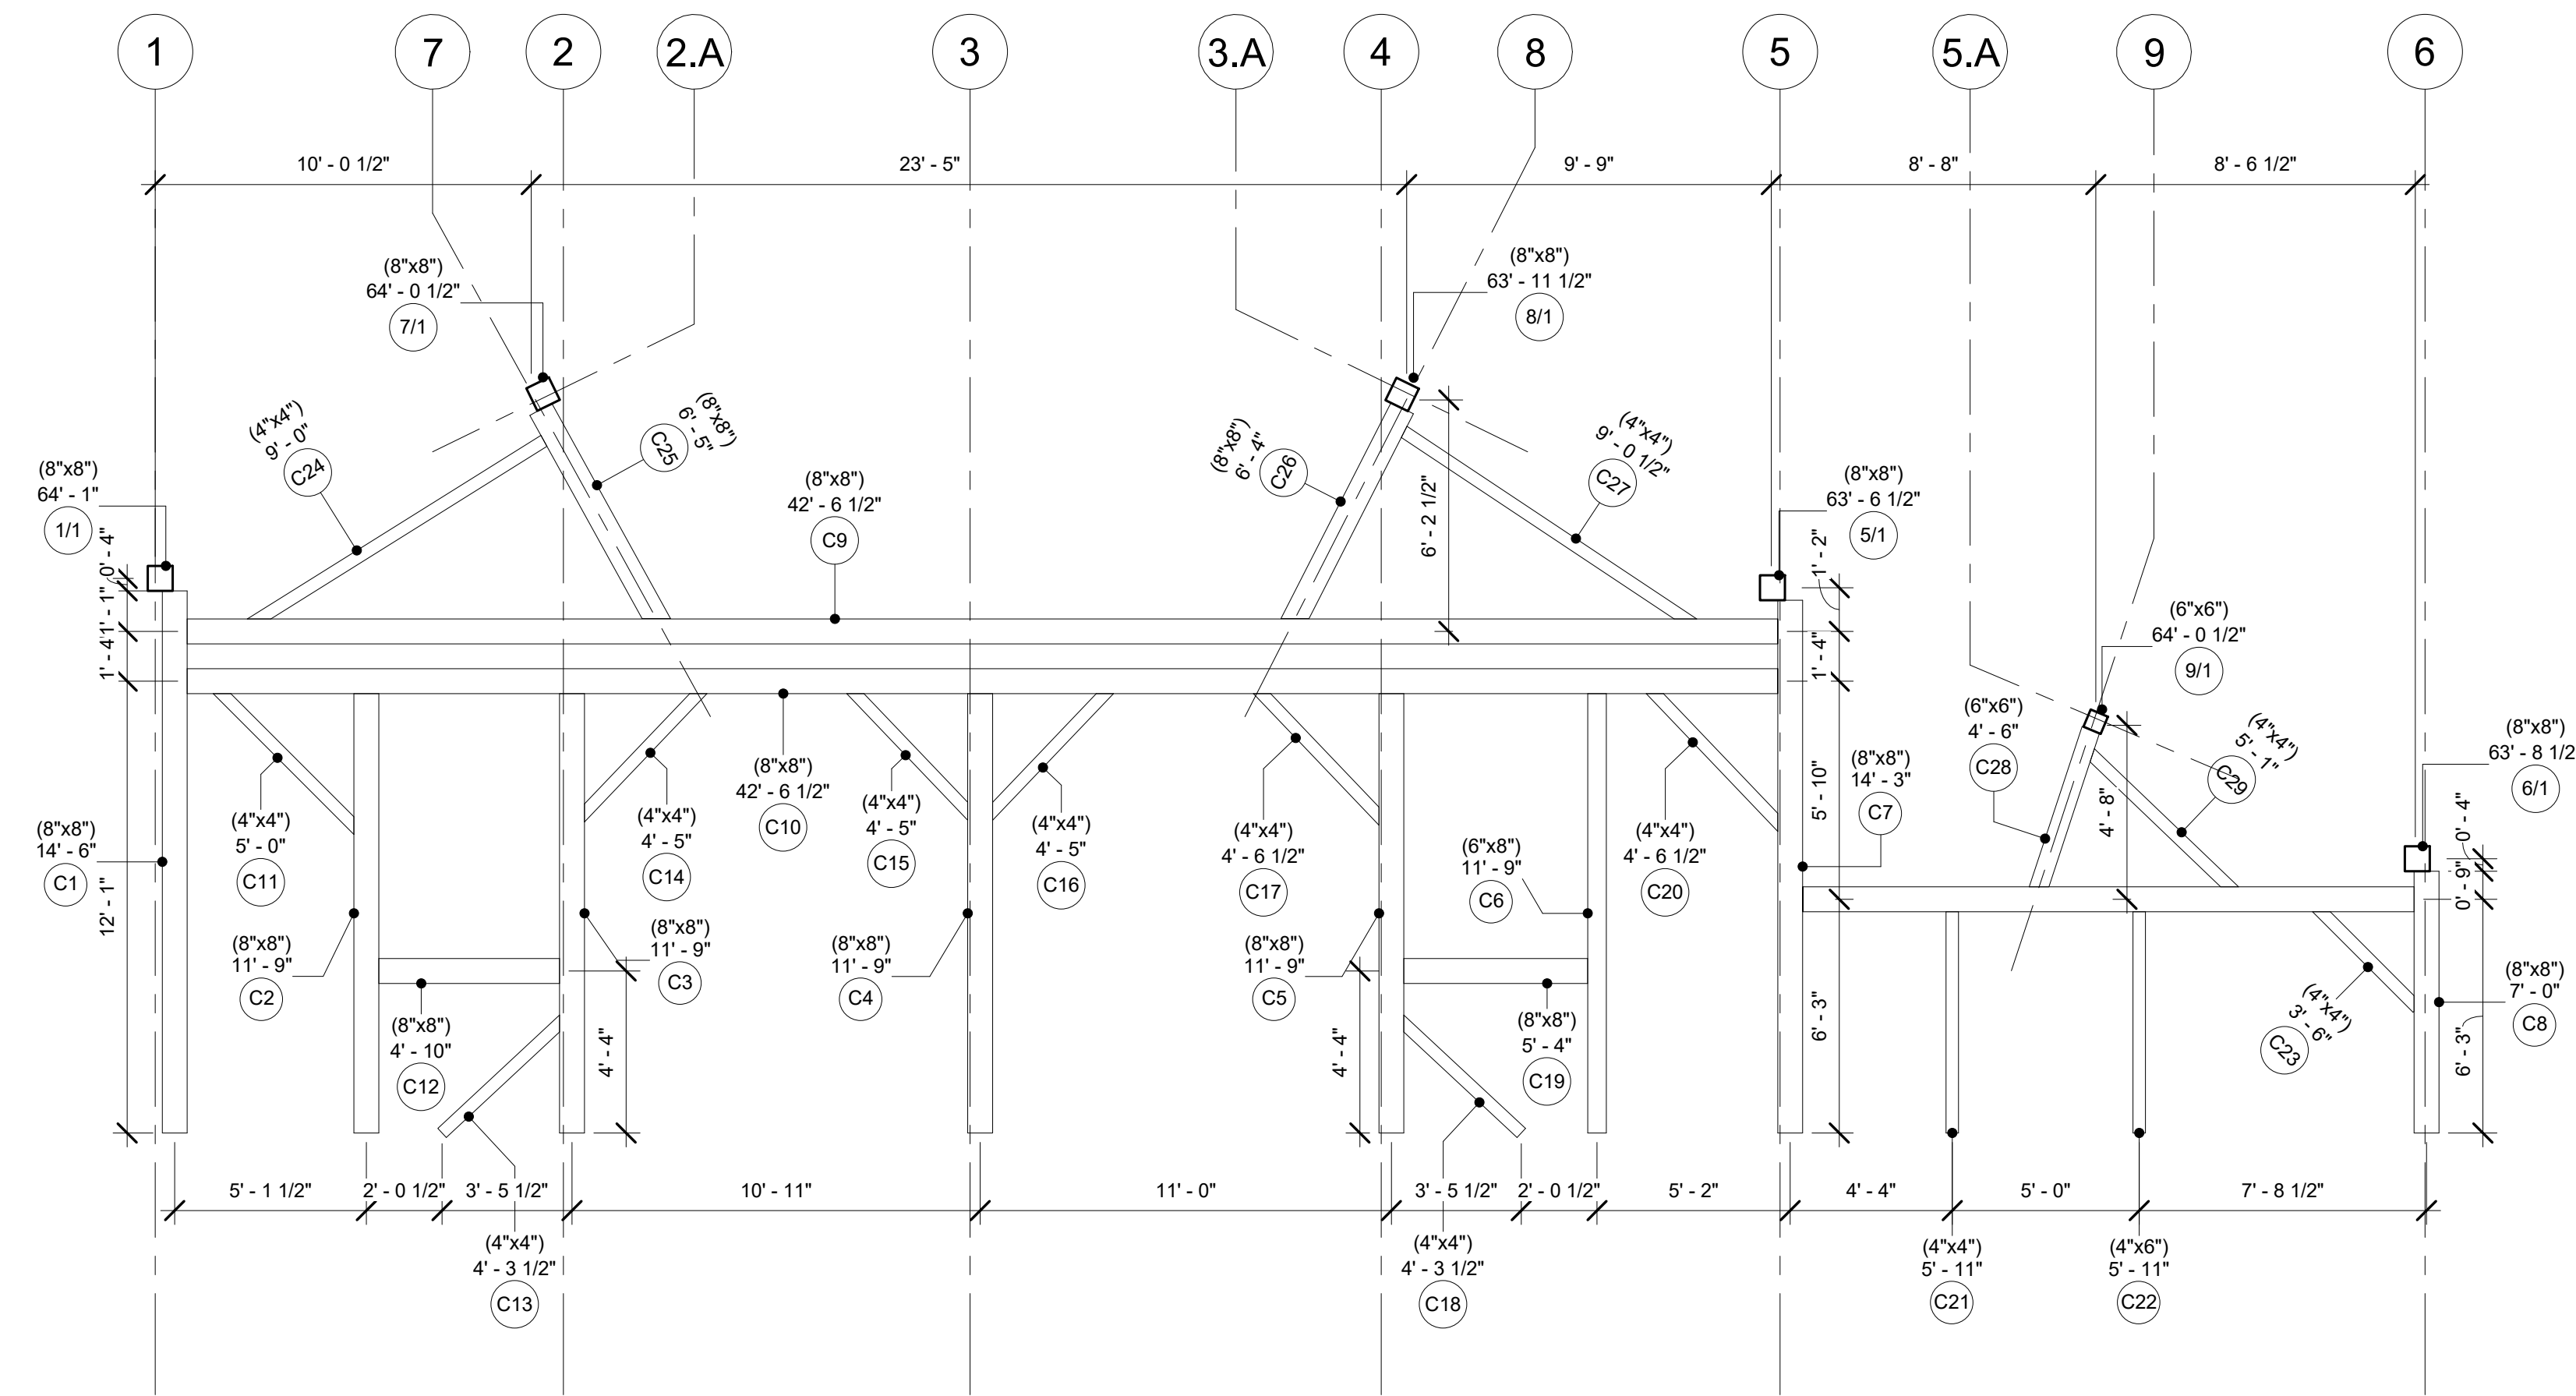

Bent C

Project Number Project 6

Date 20240912

Drawn By

Checked By

A105

Scale 1/4" = 1'-0"

Bay & Bent


80 Old Gate Road,
Penn Run PA, 15765

DAN TRIMBLE
AA66 / TIMBER HOME SERVICES

CELL PHONE/TEXT - 412-309-1161

EMAIL:

DANTRIMBLE@TIMBERHOMESERVICES.COM

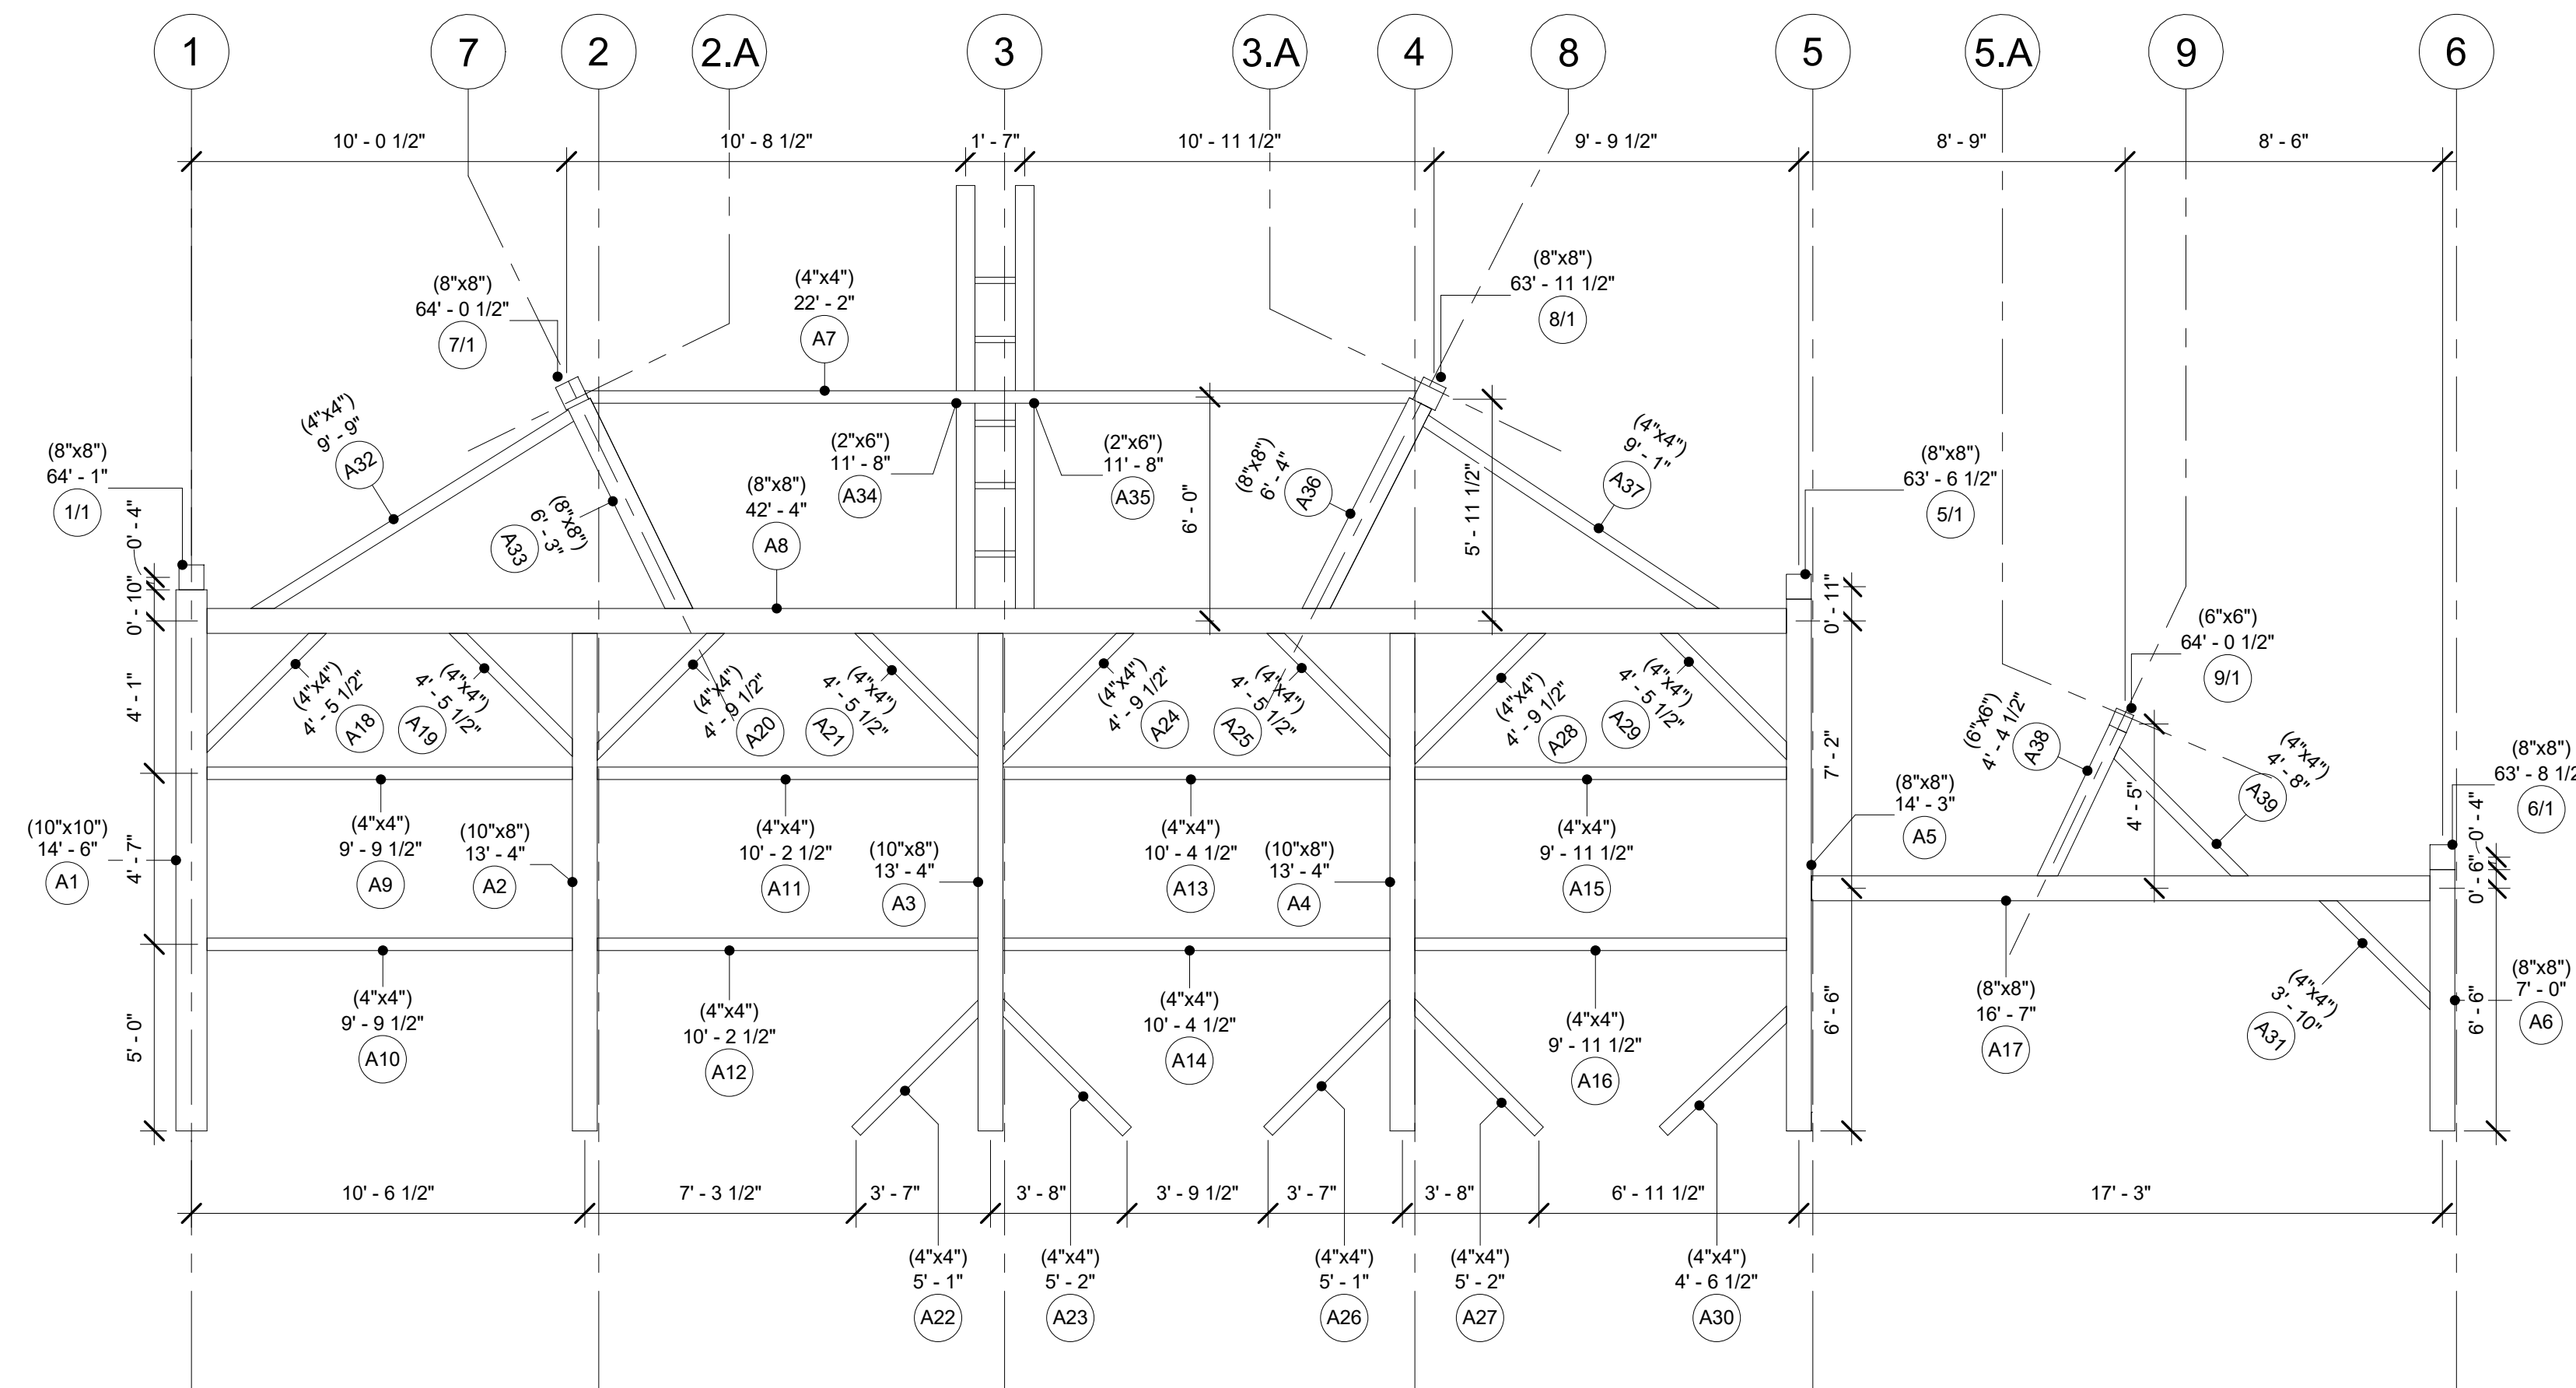

Bent A

Project Number Project 6

Date 20240912

Drawn By

Checked By

A107

Scale 1/4" = 1'-0"

Bay & Bent


80 Old Gate Road,
Penn Run PA, 15765

DAN TRIMBLE
AA66 / TIMBER HOME SERVICES

CELL PHONE/TEXT - 412-309-1161

EMAIL:

DANTRIMBLE@TIMBERHOMESERVICES.COM

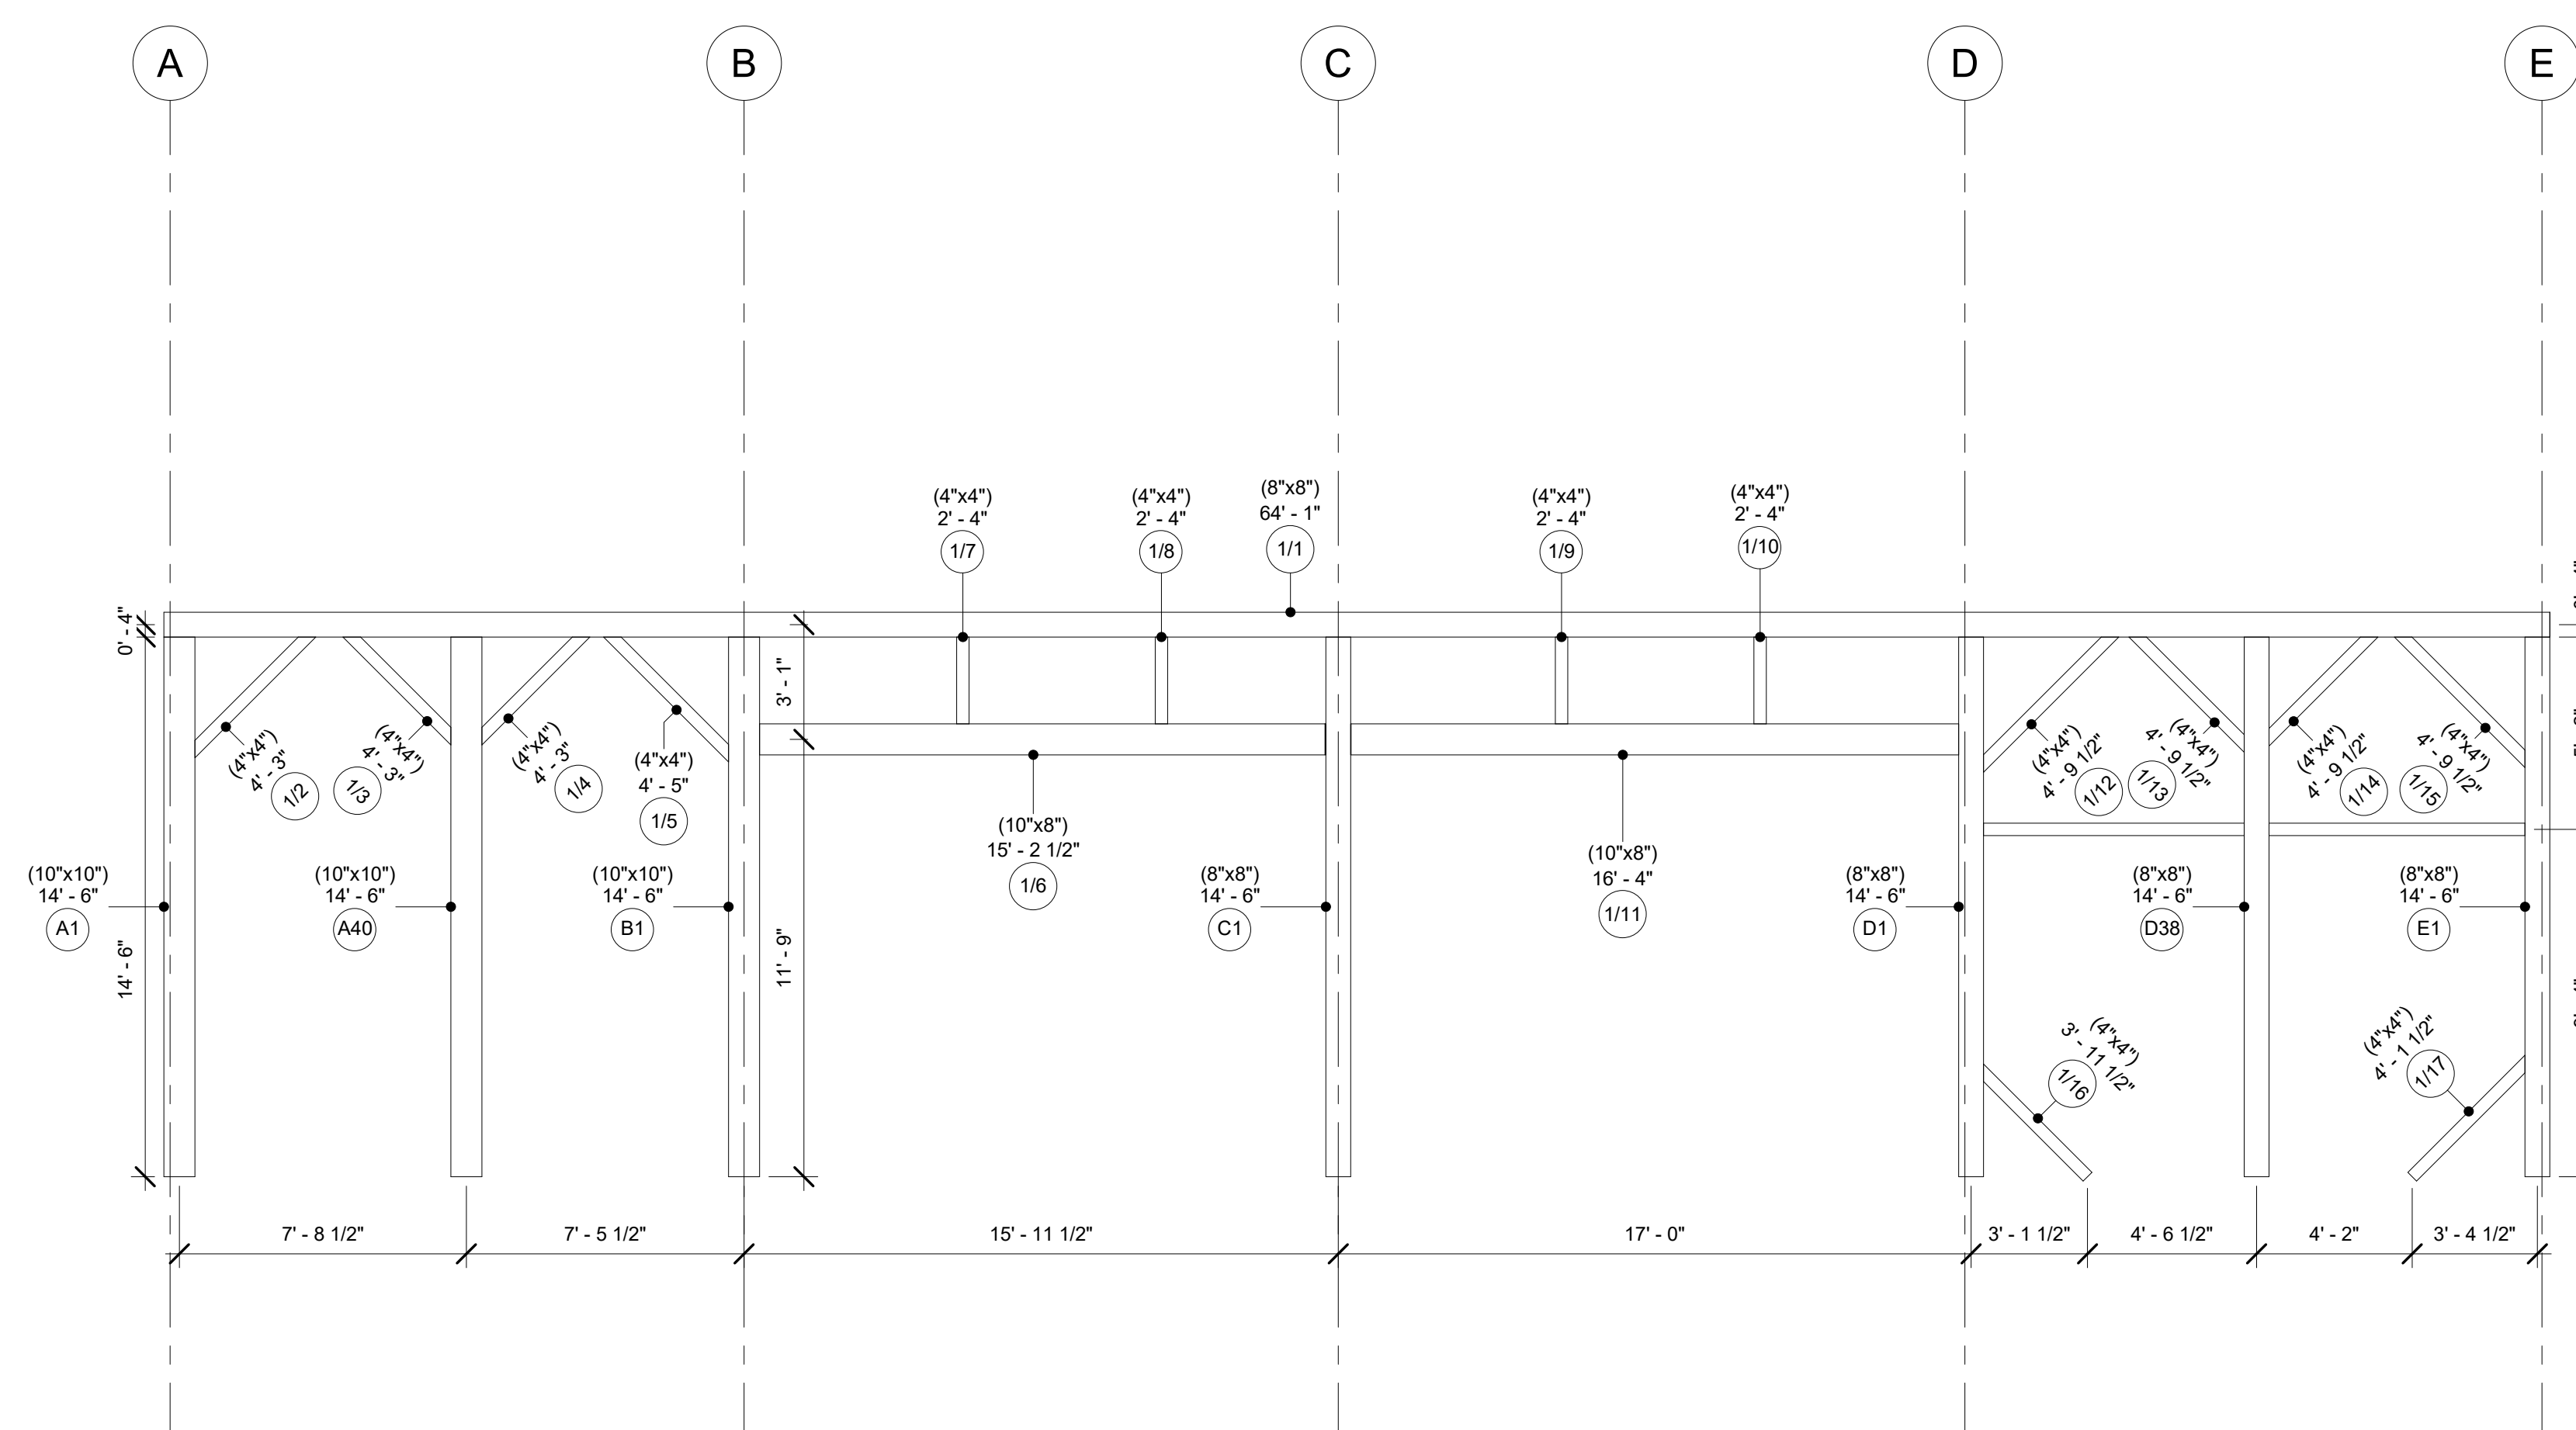

Bent 1

Project Number	Project 6
Date	20240912
Drawn By	
Checked By	

A108

Scale 1/4" = 1'-0"

Bay & Bent


80 Old Gate Road,
Penn Run PA, 15765

DAN TRIMBLE
AA66 / TIMBER HOME SERVICES

CELL PHONE/TEXT - 412-309-1161

EMAIL:

DANTRIMBLE@TIMBERHOMESERVICES.COM

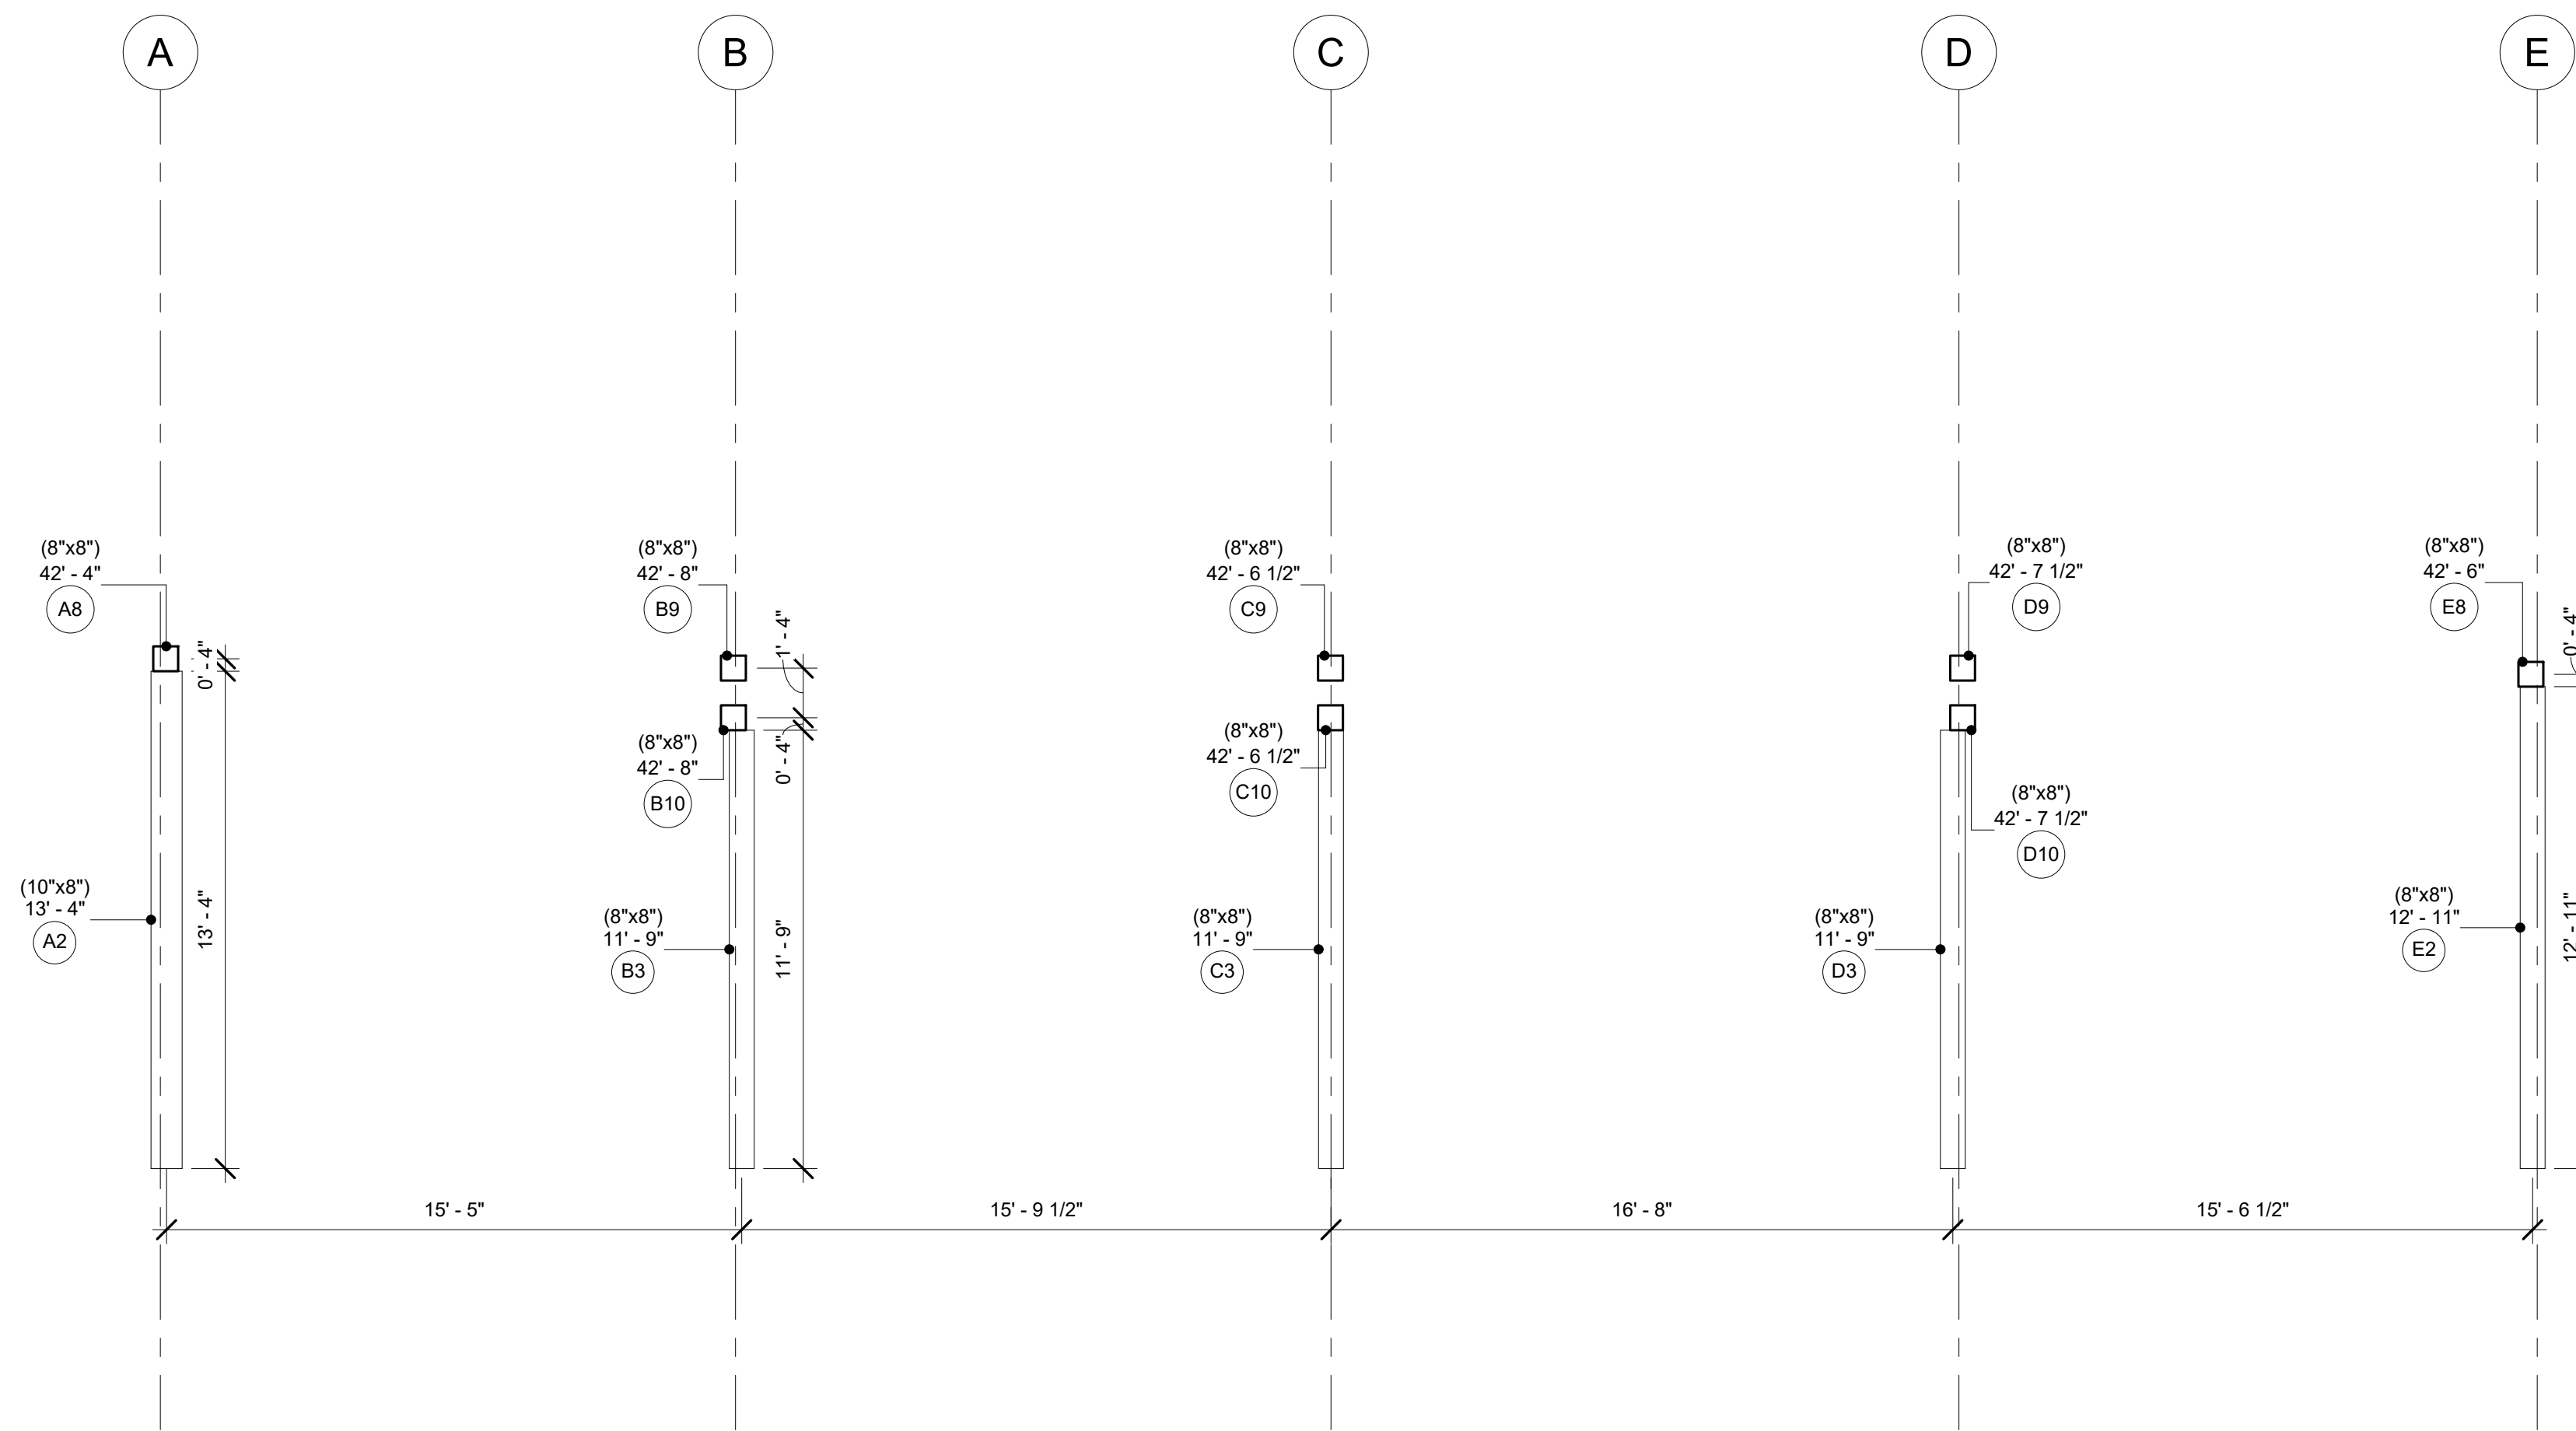

Bent 2

Project Number Project 6

Date 20240912

Drawn By

Checked By

A109

Scale 1/4" = 1'-0"

Bay & Bent


80 Old Gate Road,
Penn Run PA, 15765

DAN TRIMBLE
AA66 / TIMBER HOME SERVICES

CELL PHONE/TEXT - 412-309-1161

EMAIL:

DANTRIMBLE@TIMBERHOMESERVICES.COM

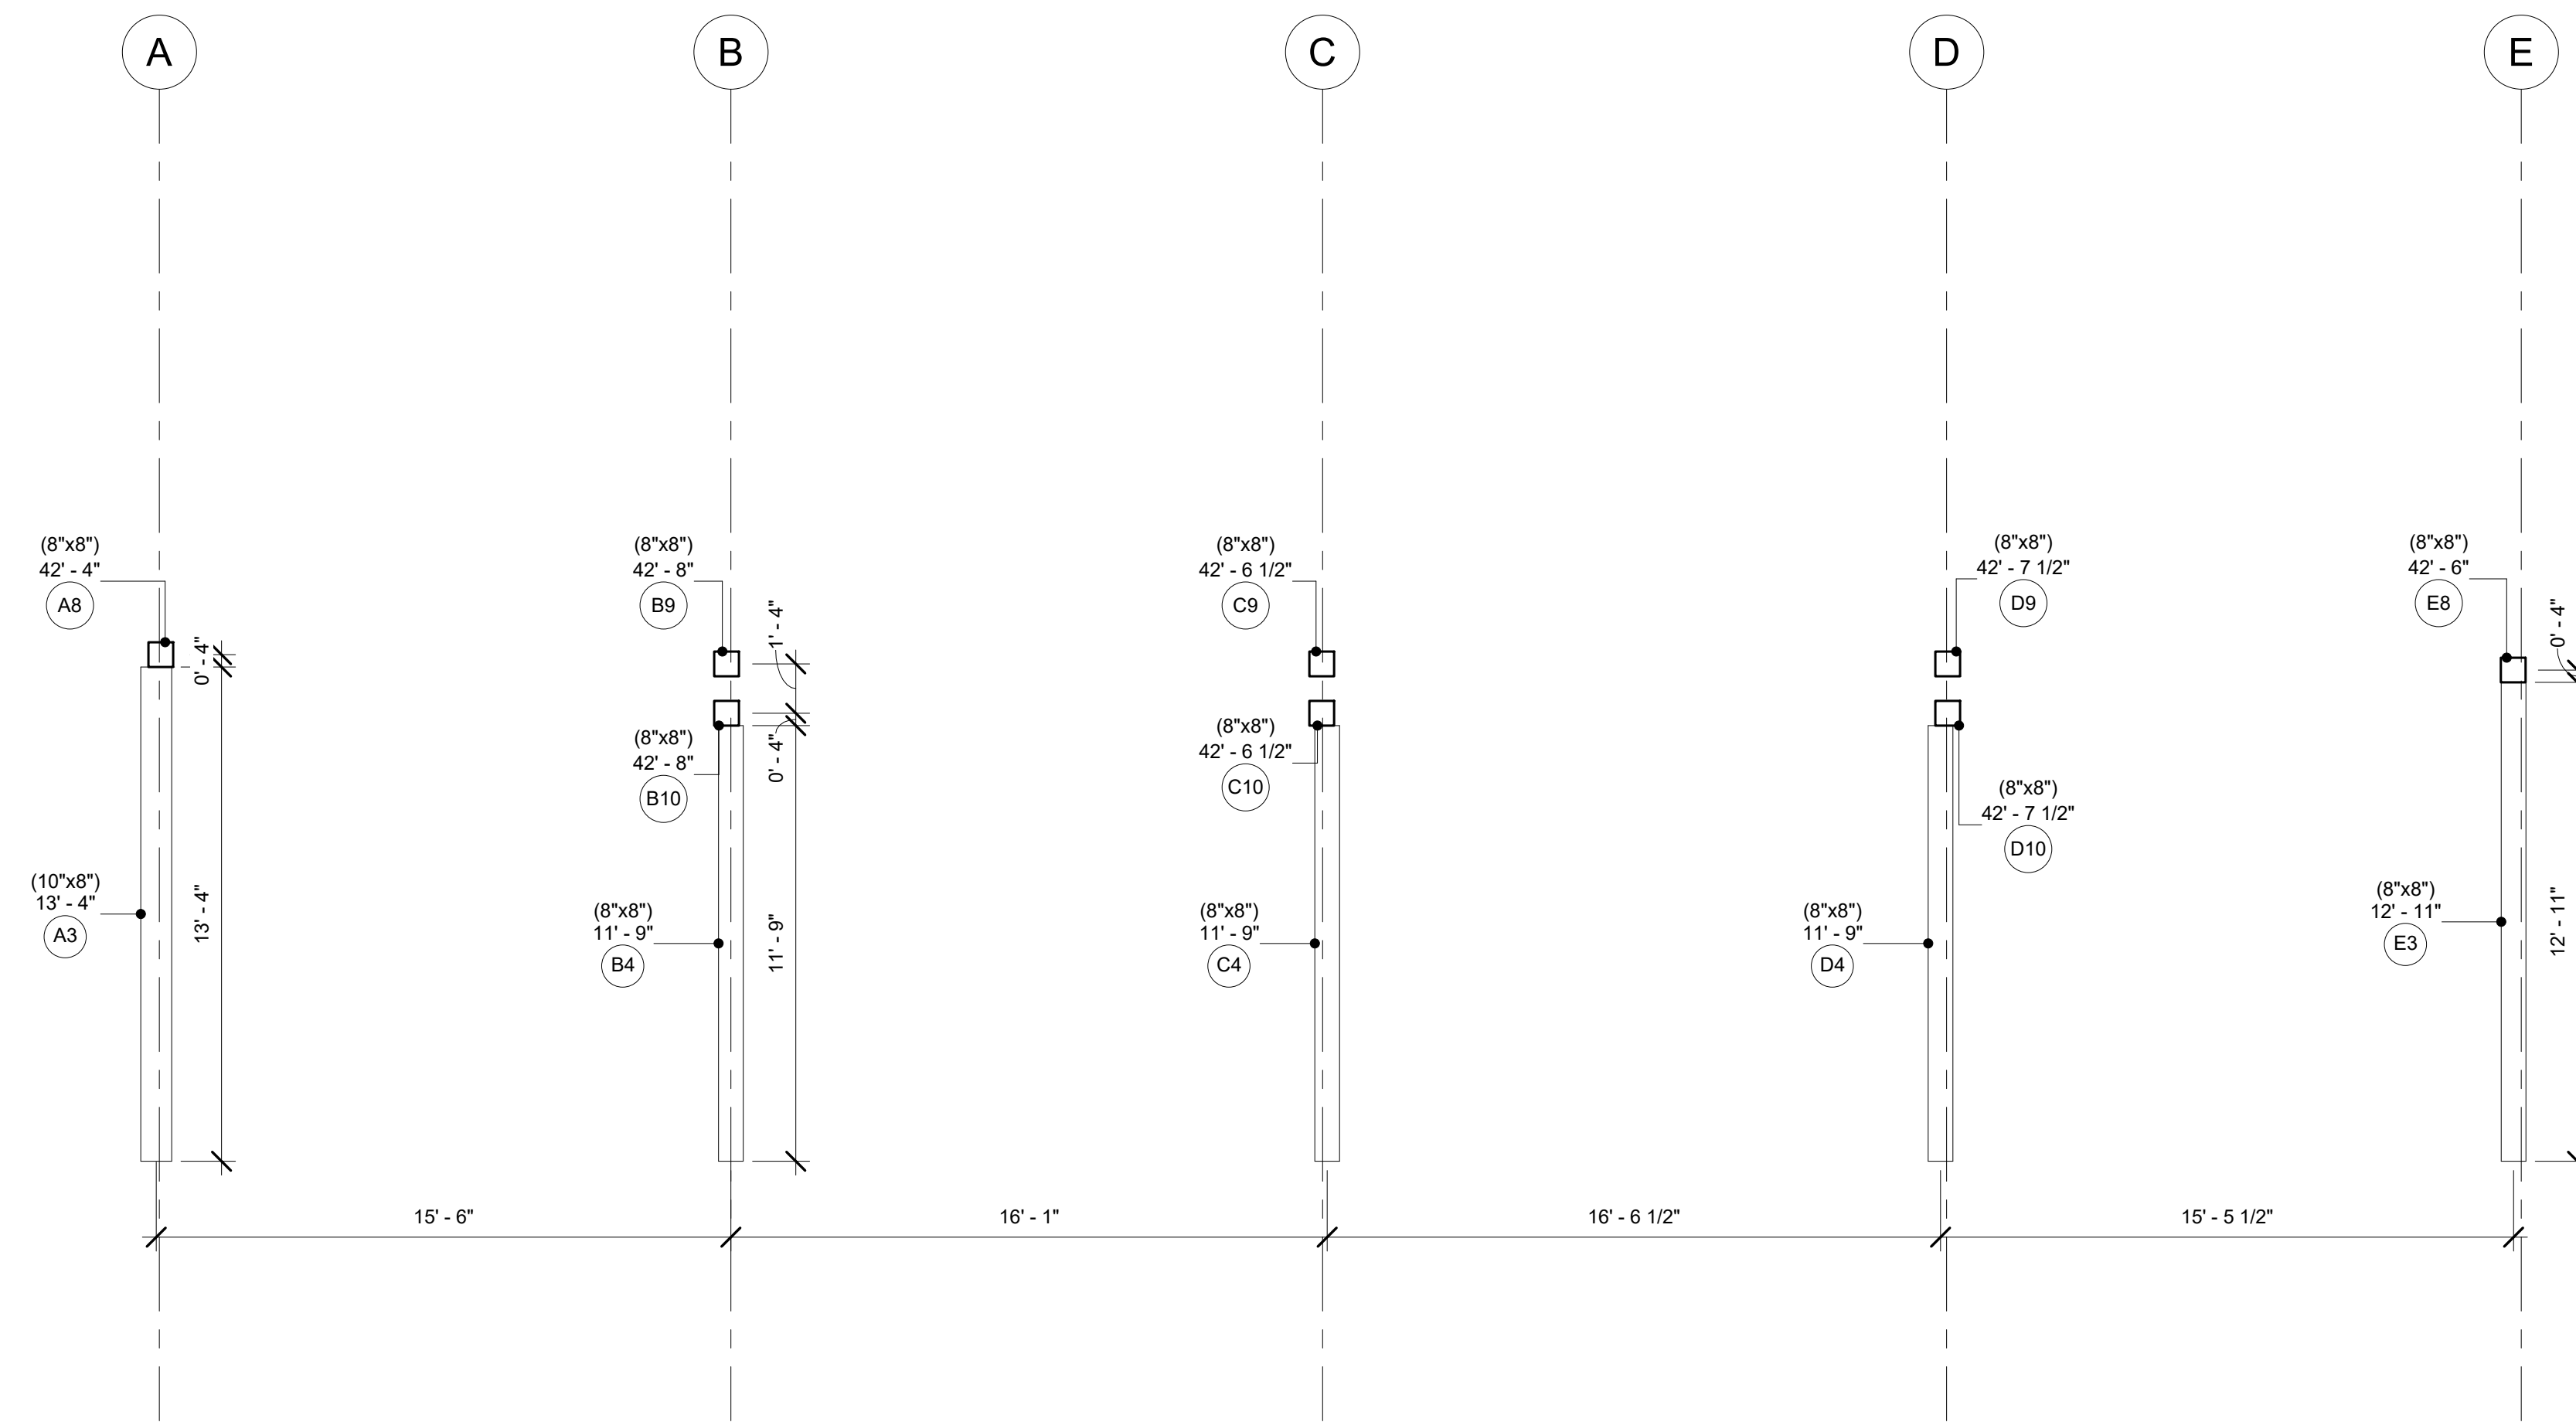

Bent 3

Project Number Project 6

Date 20240912

Drawn By

Checked By

A110

Scale 1/4" = 1'-0"

Bay & Bent


80 Old Gate Road,
Penn Run PA, 15765

DAN TRIMBLE
AA66 / TIMBER HOME SERVICES

CELL PHONE/TEXT - 412-309-1161

EMAIL:

DANTRIMBLE@TIMBERHOMESERVICES.COM

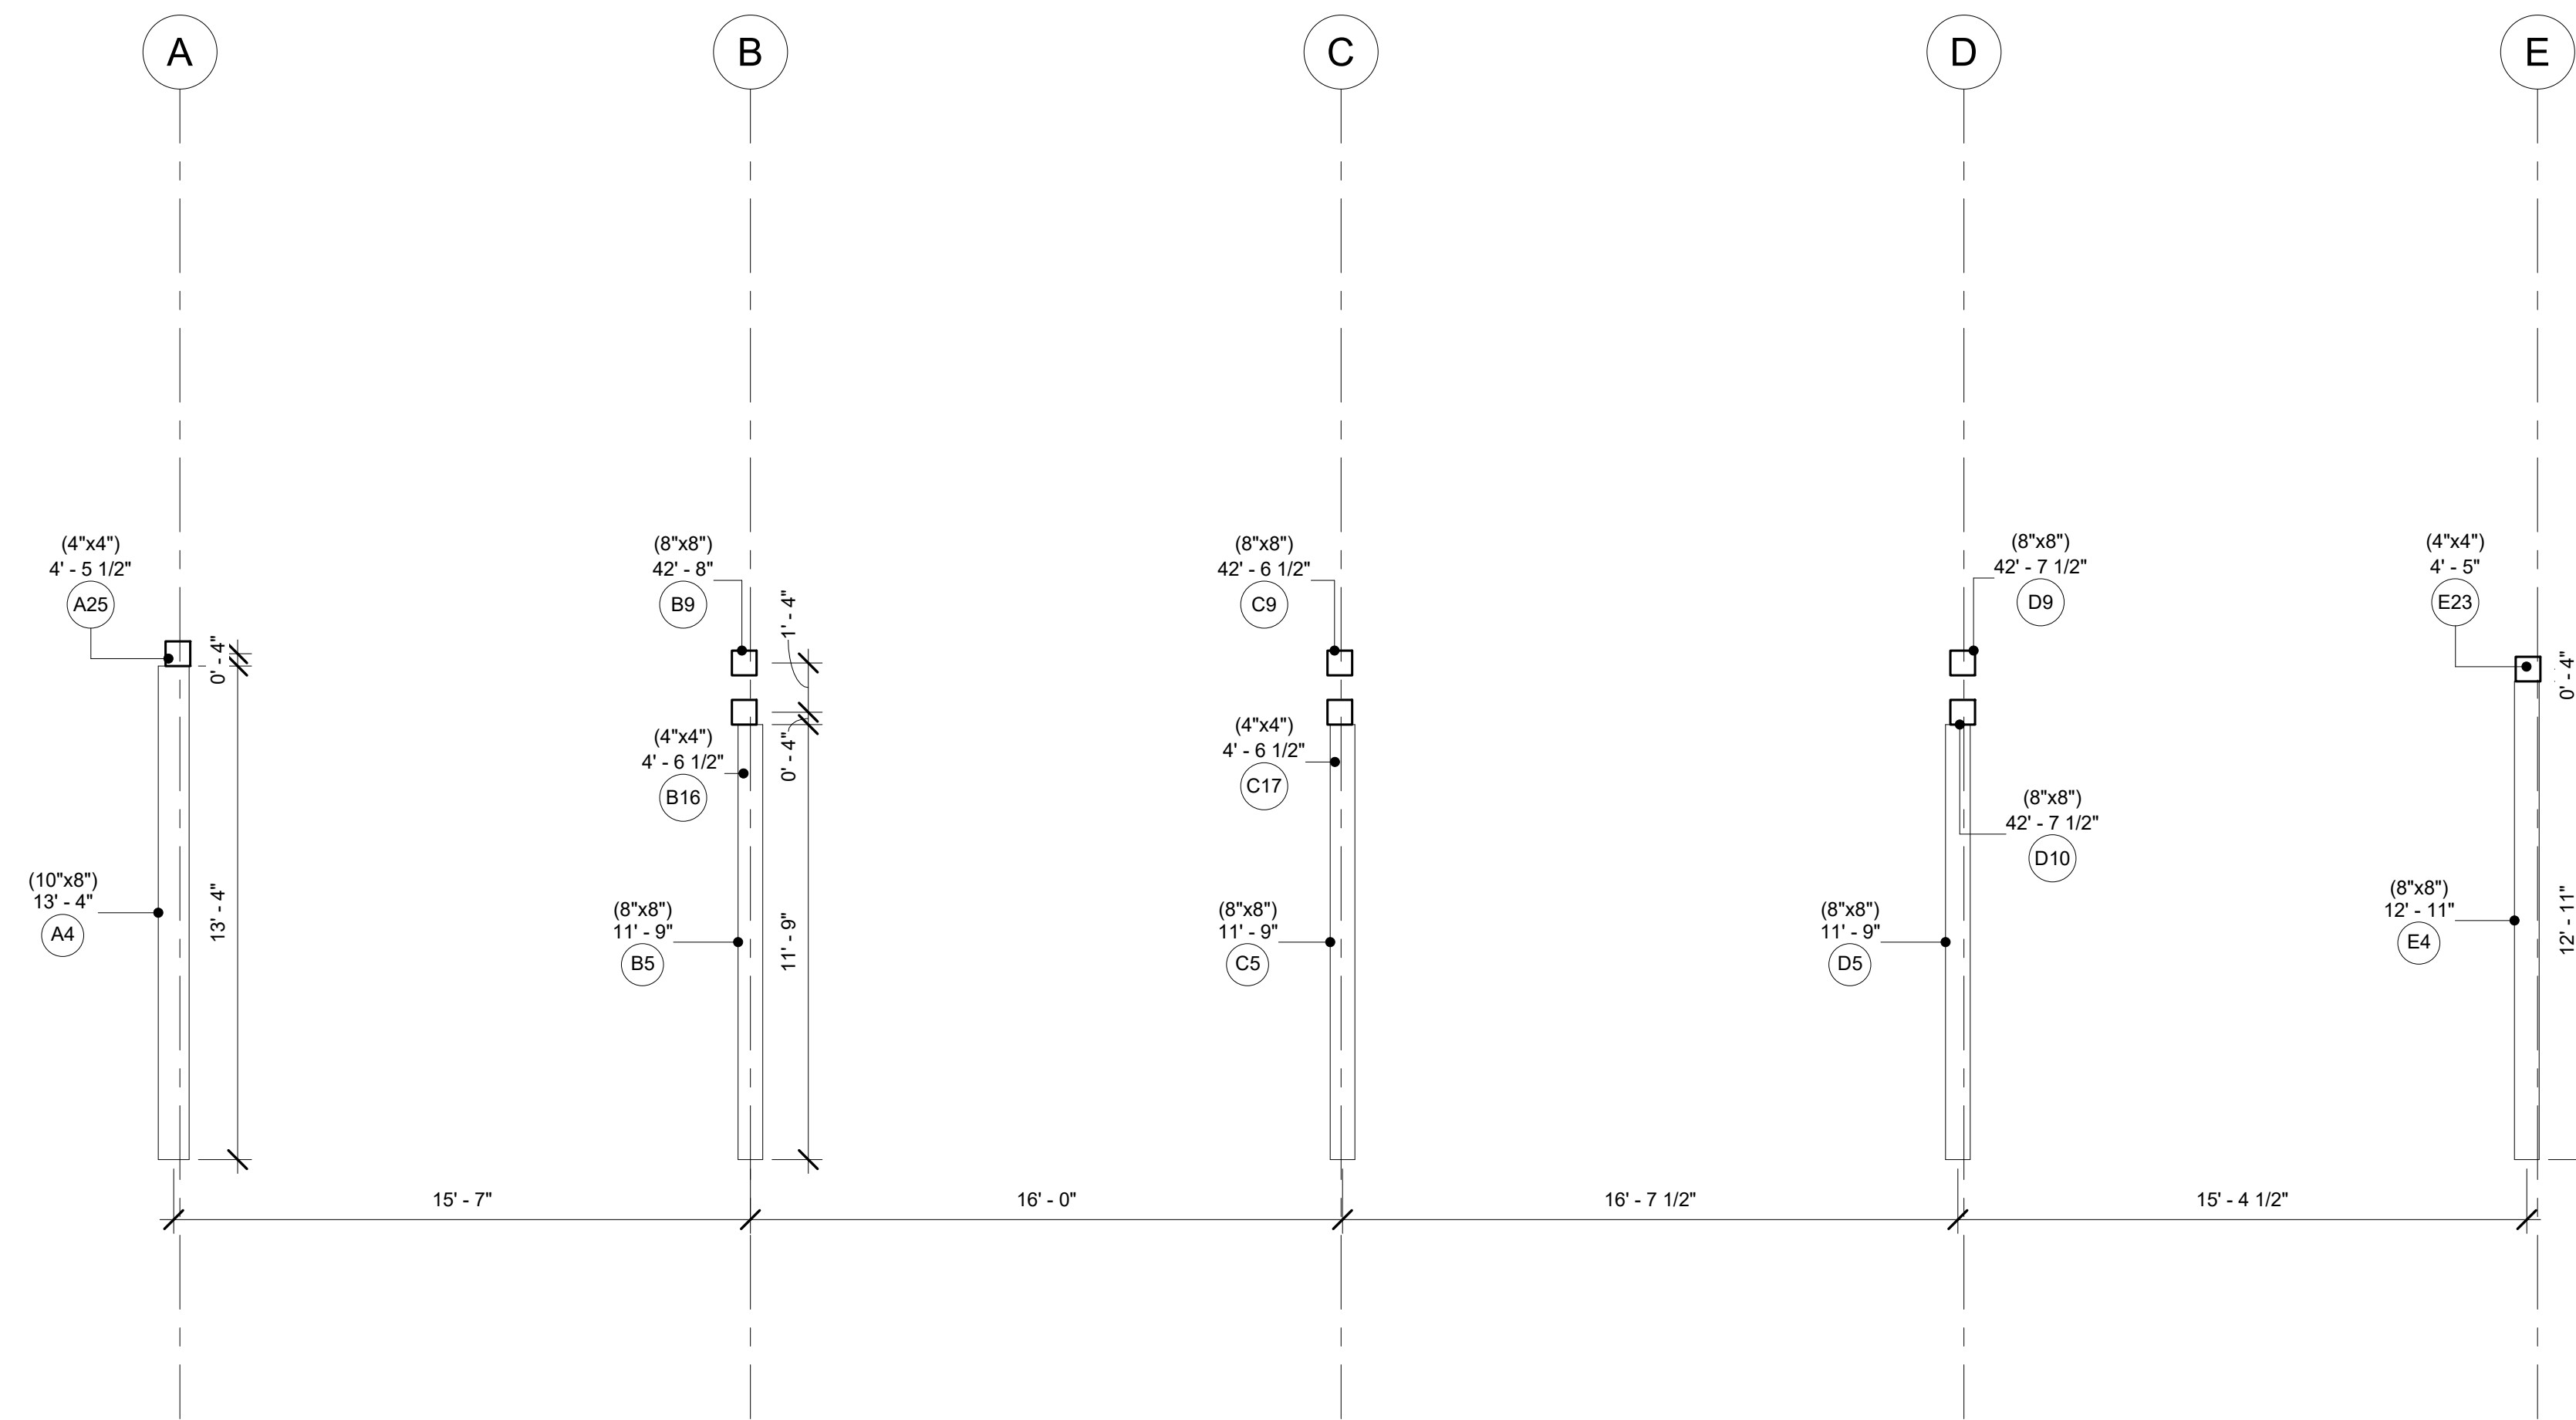

Bent 4

Project Number **Project 6**

Date **20240912**

Drawn By

Checked By

A111

Scale **1/4" = 1'-0"**

Bay & Bent


80 Old Gate Road,
Penn Run PA, 15765

DAN TRIMBLE
AA66 / TIMBER HOME SERVICES

CELL PHONE/TEXT - 412-309-1161

EMAIL:

DANTRIMBLE@TIMBERHOMESERVICES.COM

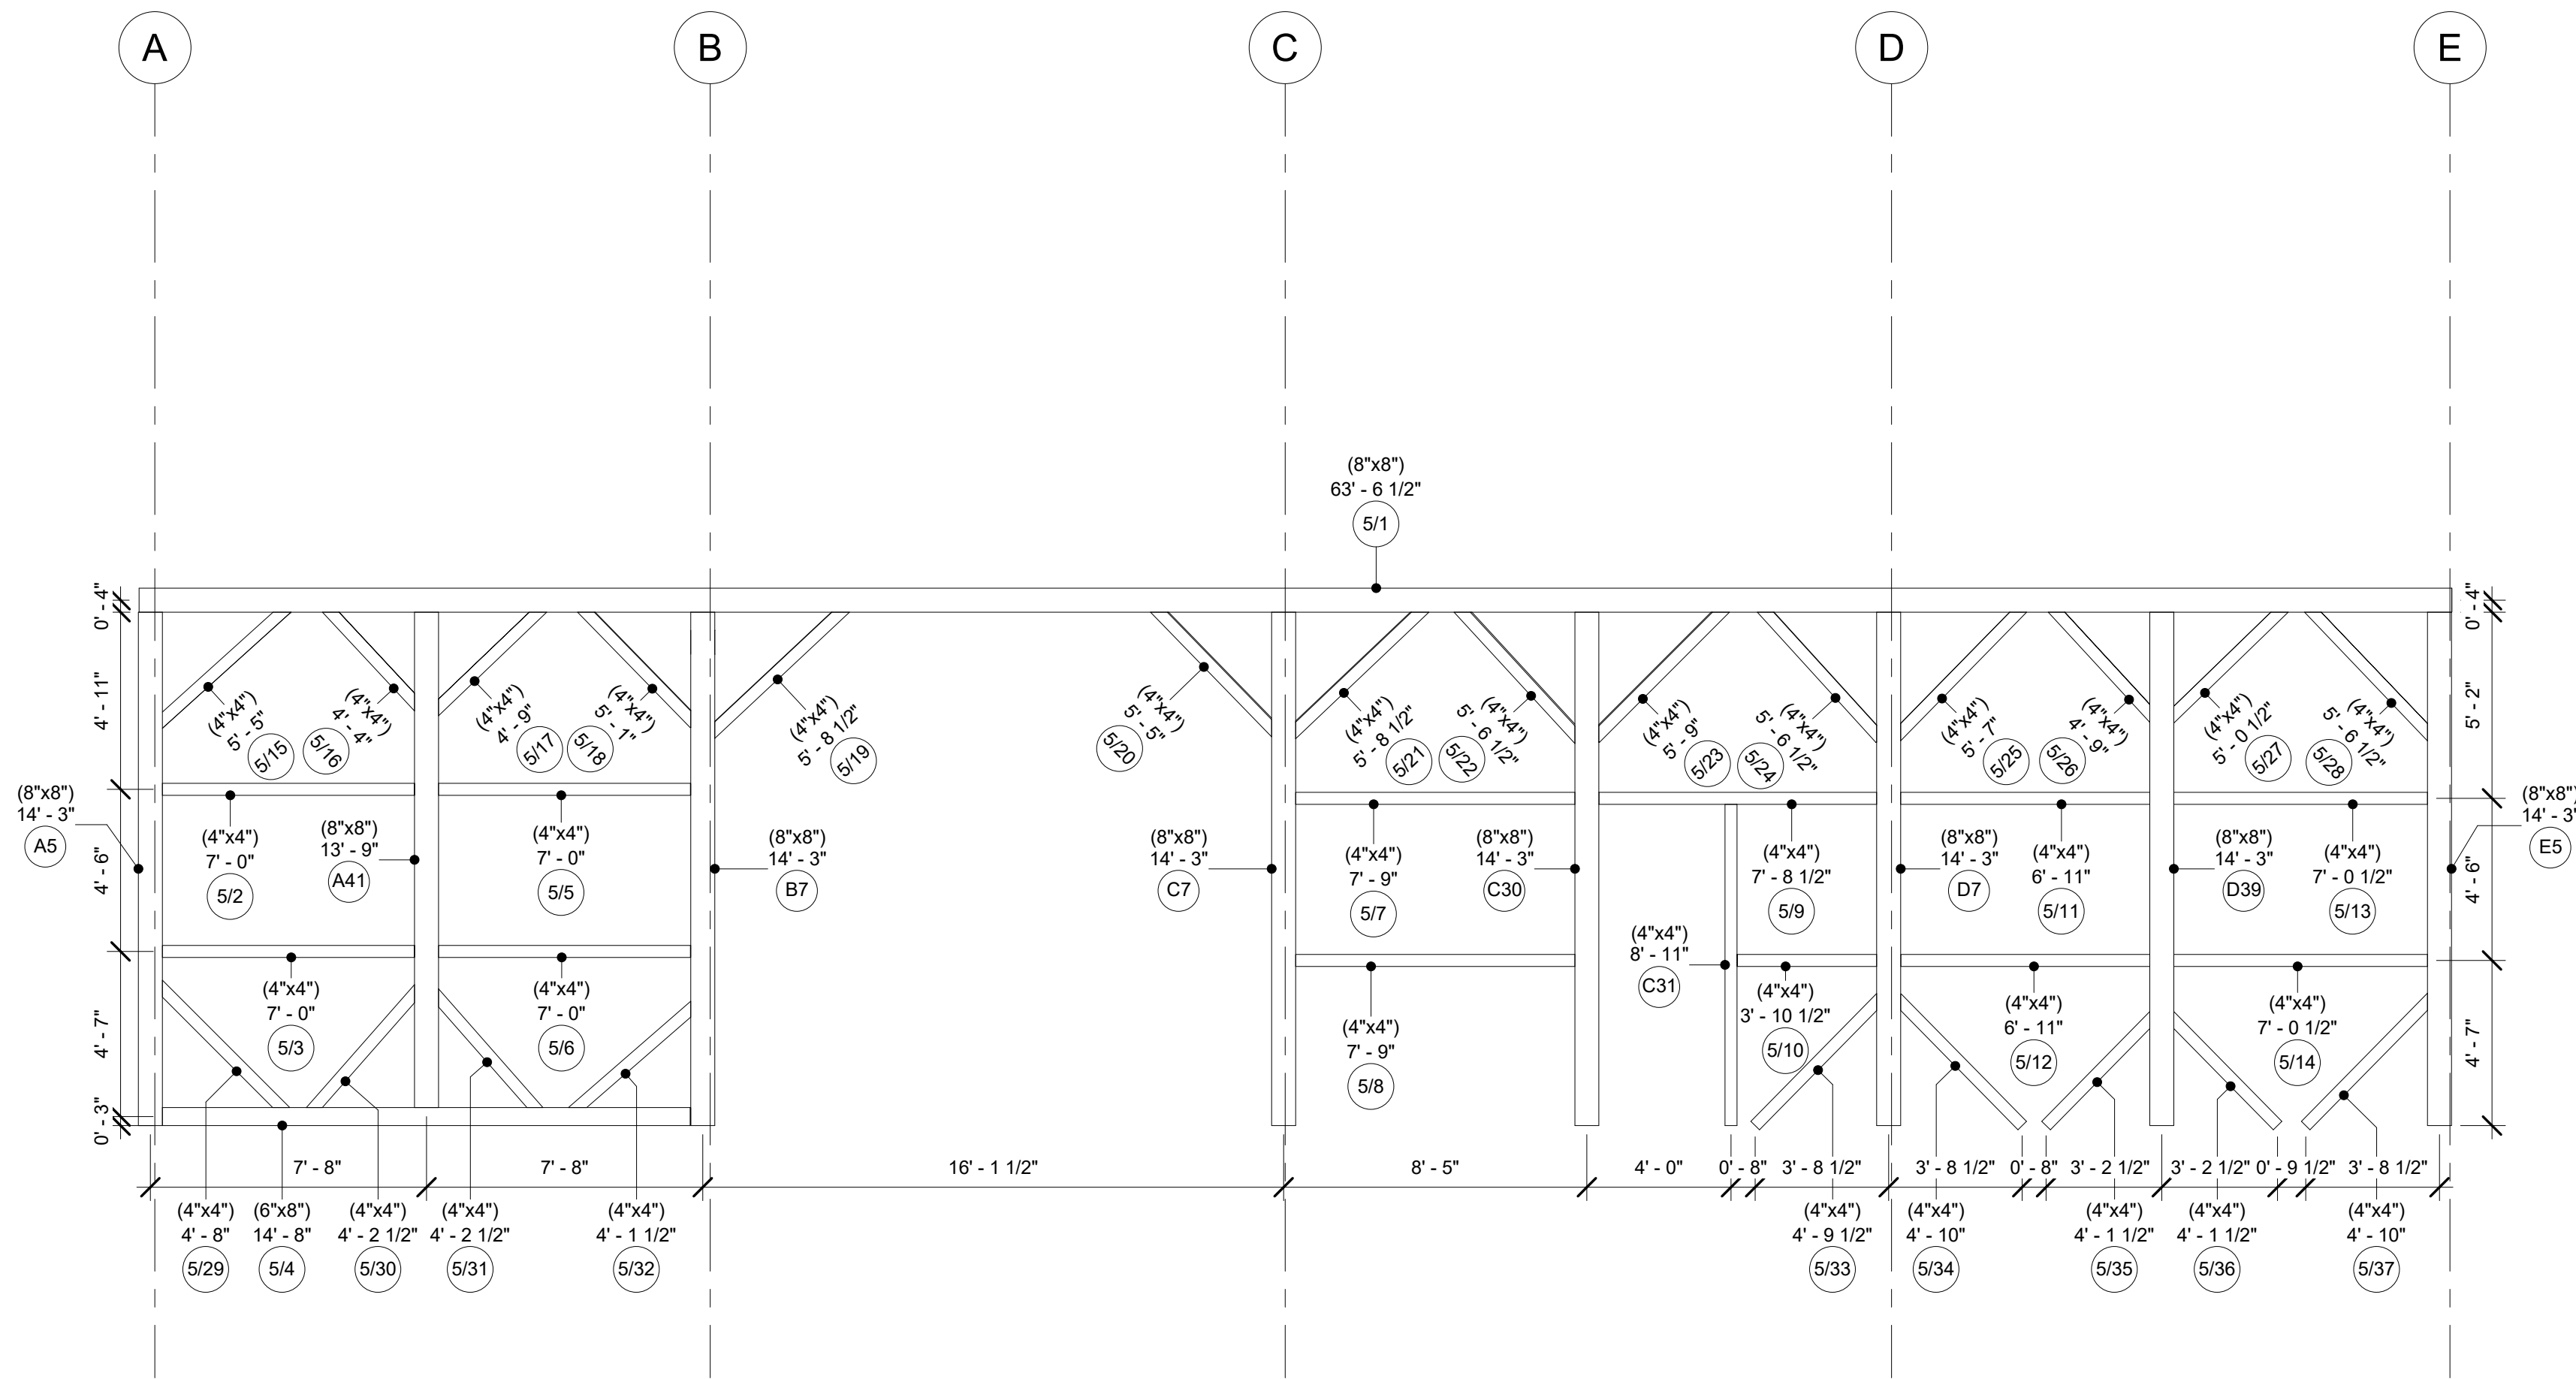

Bent 5

Project Number **Project 6**

Date **20240912**

Drawn By

Checked By

A112

Scale **1/4" = 1'-0"**

Bay & Bent


80 Old Gate Road,
Penn Run PA, 15765

DAN TRIMBLE
AA66 / TIMBER HOME SERVICES

CELL PHONE/TEXT - 412-309-1161

EMAIL:

DANTRIMBLE@TIMBERHOMESERVICES.COM

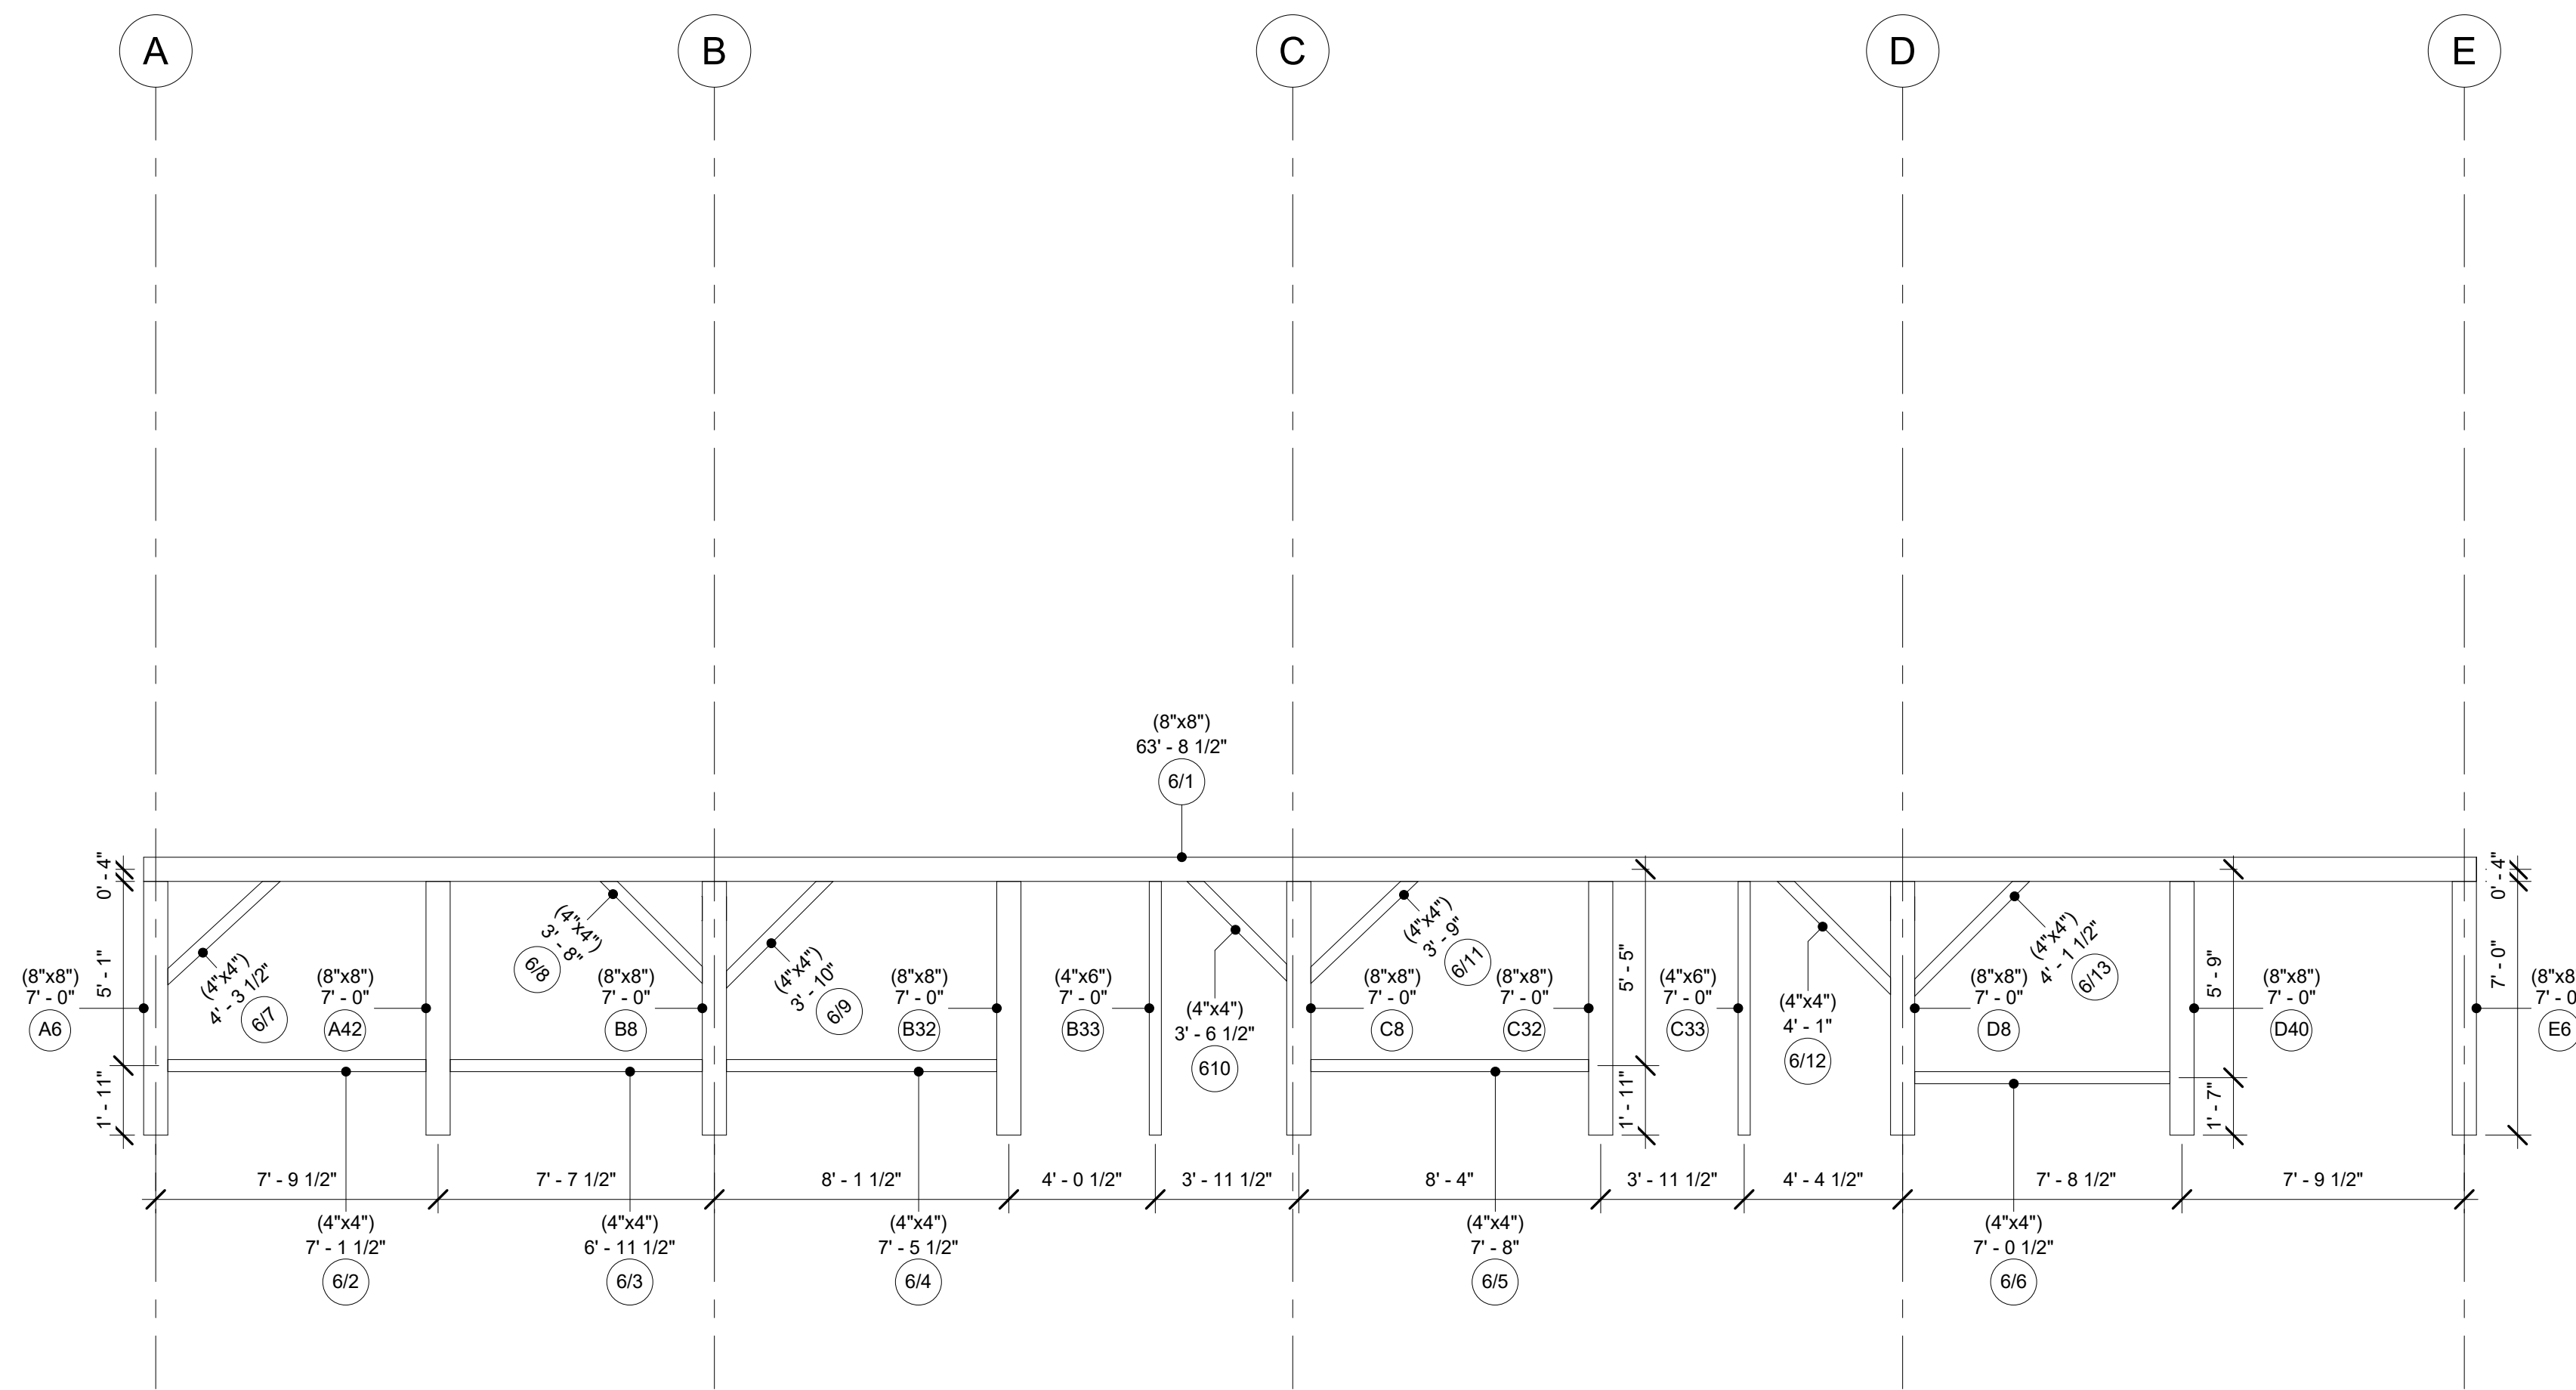

Bent 6

Project Number Project 6

Date 20240912

Drawn By

Checked By

A113

Scale 1/4" = 1'-0"

Bay & Bent


80 Old Gate Road,
Penn Run PA, 15765

DAN TRIMBLE
AA66 / TIMBER HOME SERVICES

CELL PHONE/TEXT - 412-309-1161

EMAIL:

DANTRIMBLE@TIMBERHOMESERVICES.COM

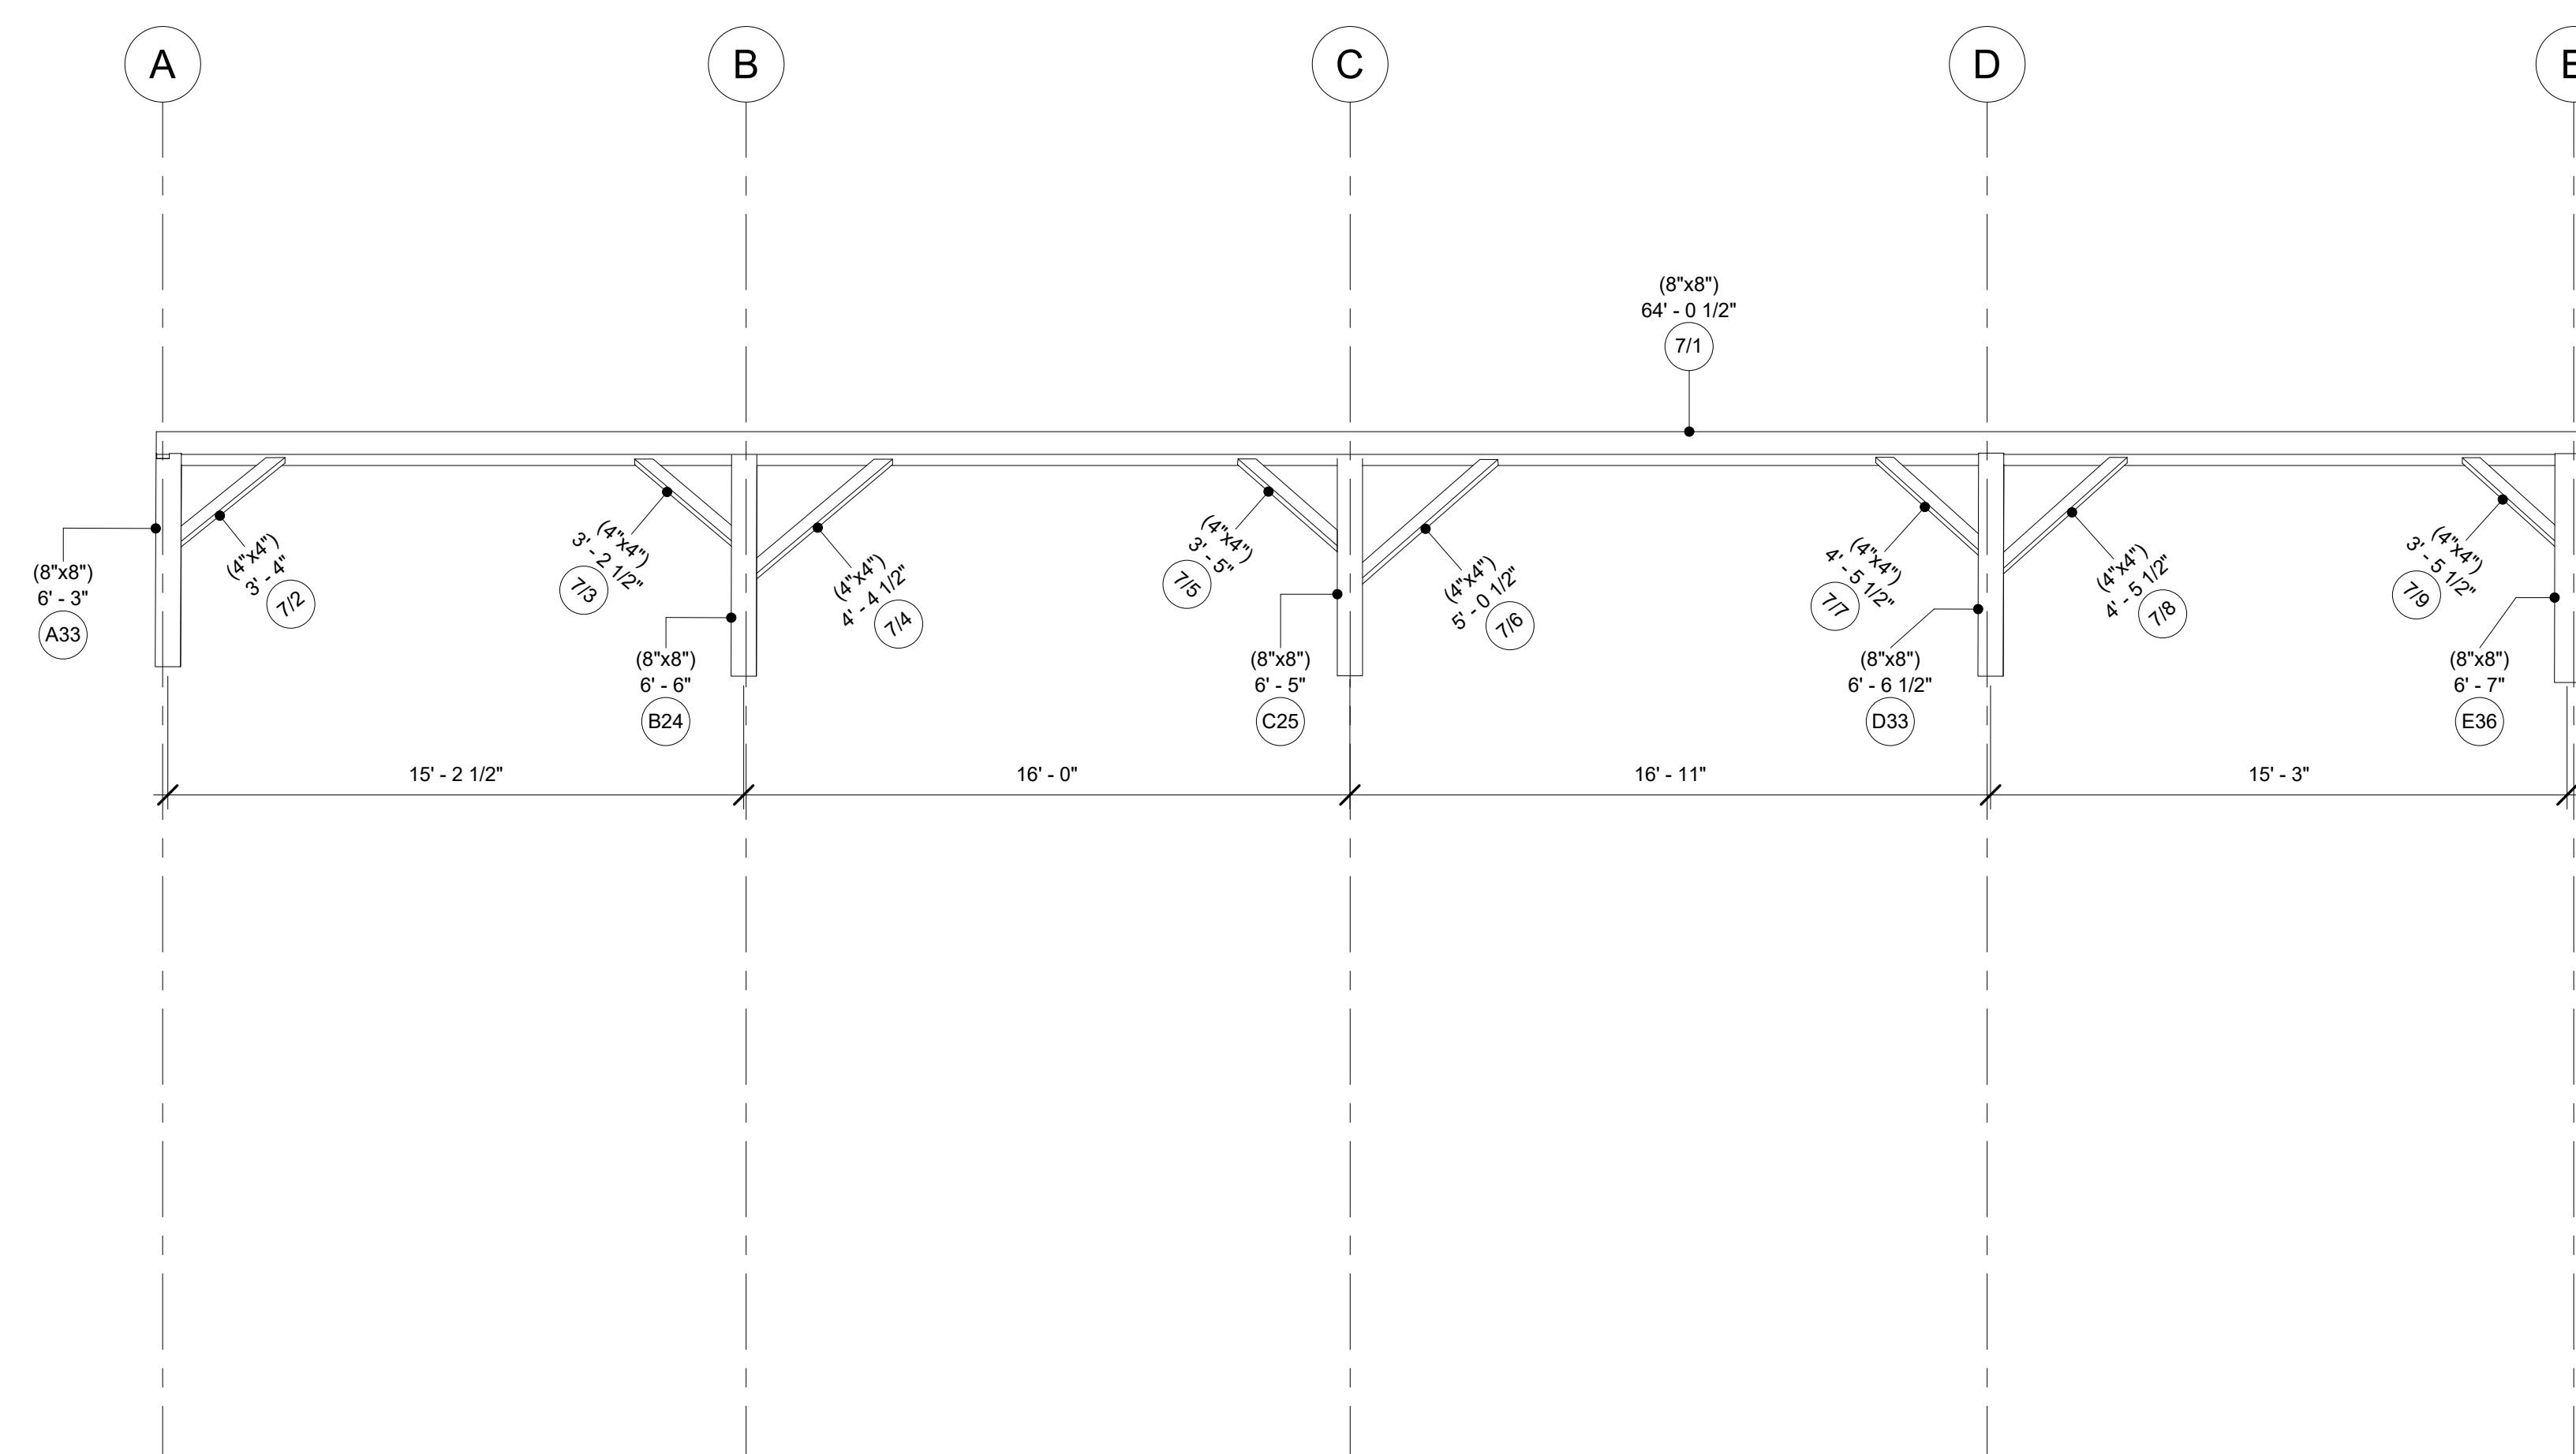

Bent 7

Project Number Project 6

Date 20240912

Drawn By

Checked By

A114

Scale 1/4" = 1'-0"

Bay & Bent


80 Old Gate Road,
Penn Run PA, 15765

DAN TRIMBLE
AA66 / TIMBER HOME SERVICES

CELL PHONE/TEXT - 412-309-1161

EMAIL:

DANTRIMBLE@TIMBERHOMESERVICES.COM

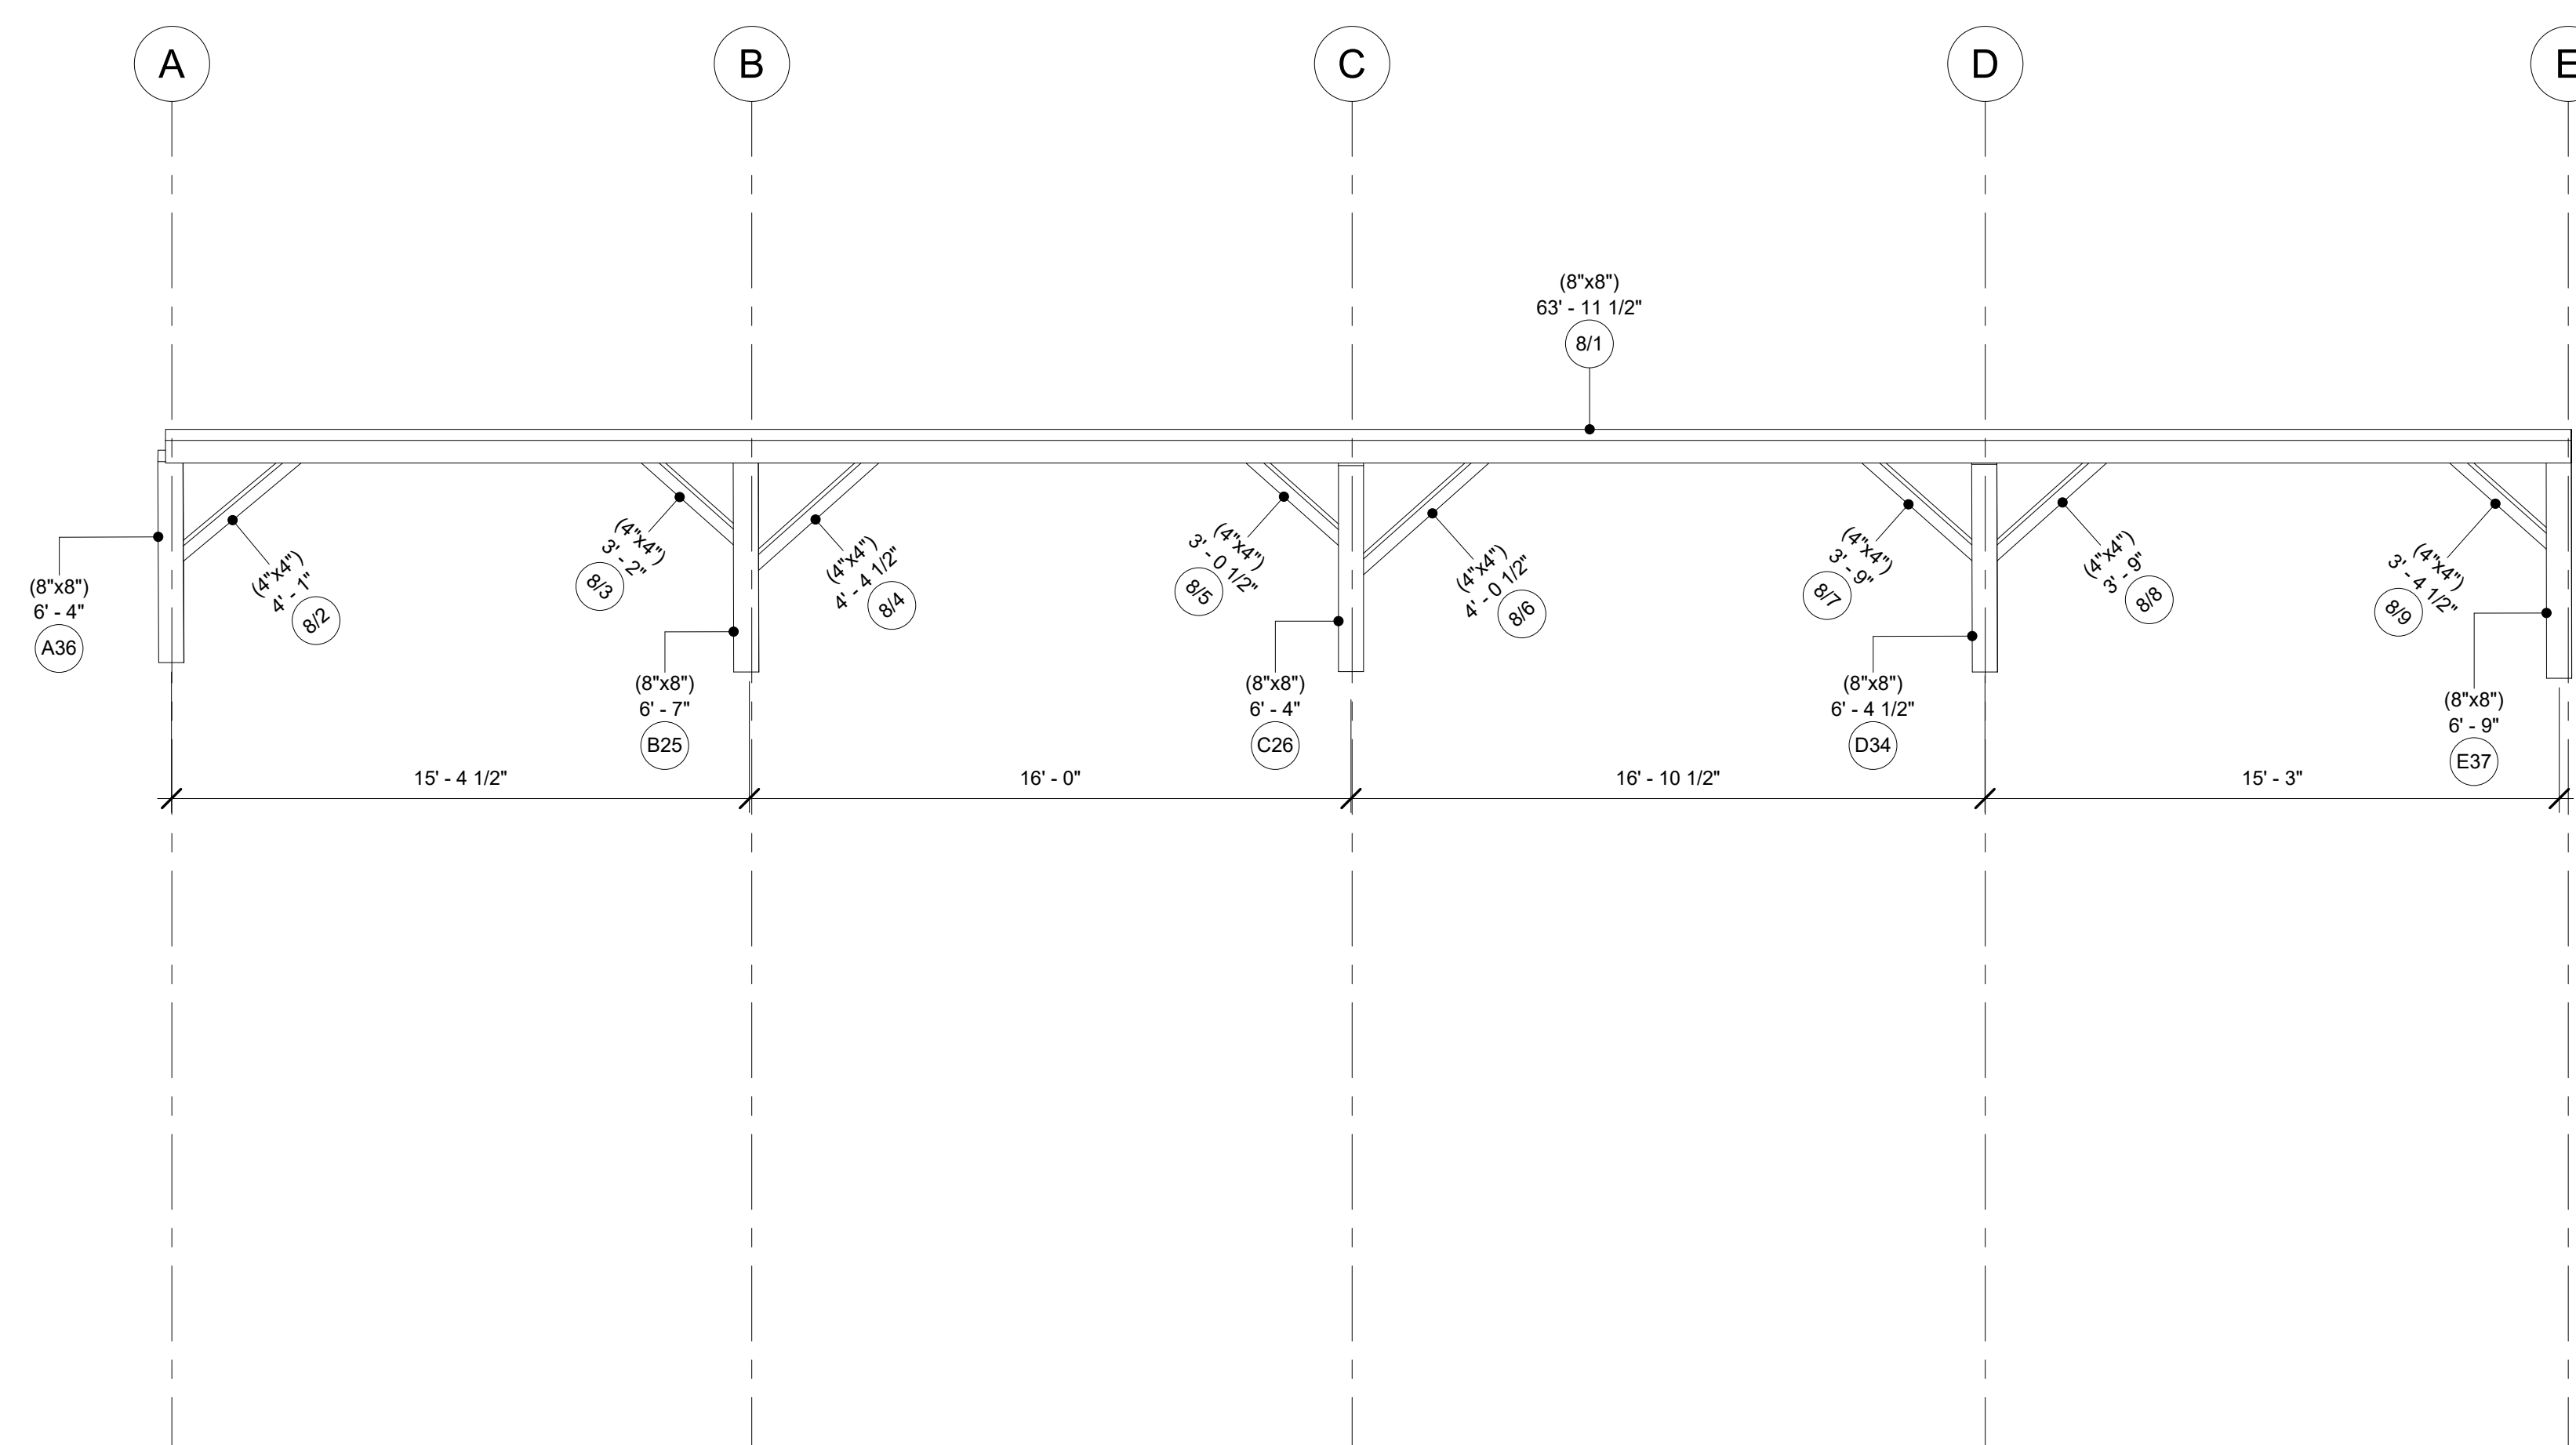

Bent 8

Project Number	Project 6
Date	20240912
Drawn By	
Checked By	

A115

Scale 1/4" = 1'-0"

Bay & Bent


80 Old Gate Road,
Penn Run PA, 15765

DAN TRIMBLE
AA66 / TIMBER HOME SERVICES

CELL PHONE/TEXT - 412-309-1161

EMAIL:

DANTRIMBLE@TIMBERHOMESERVICES.COM

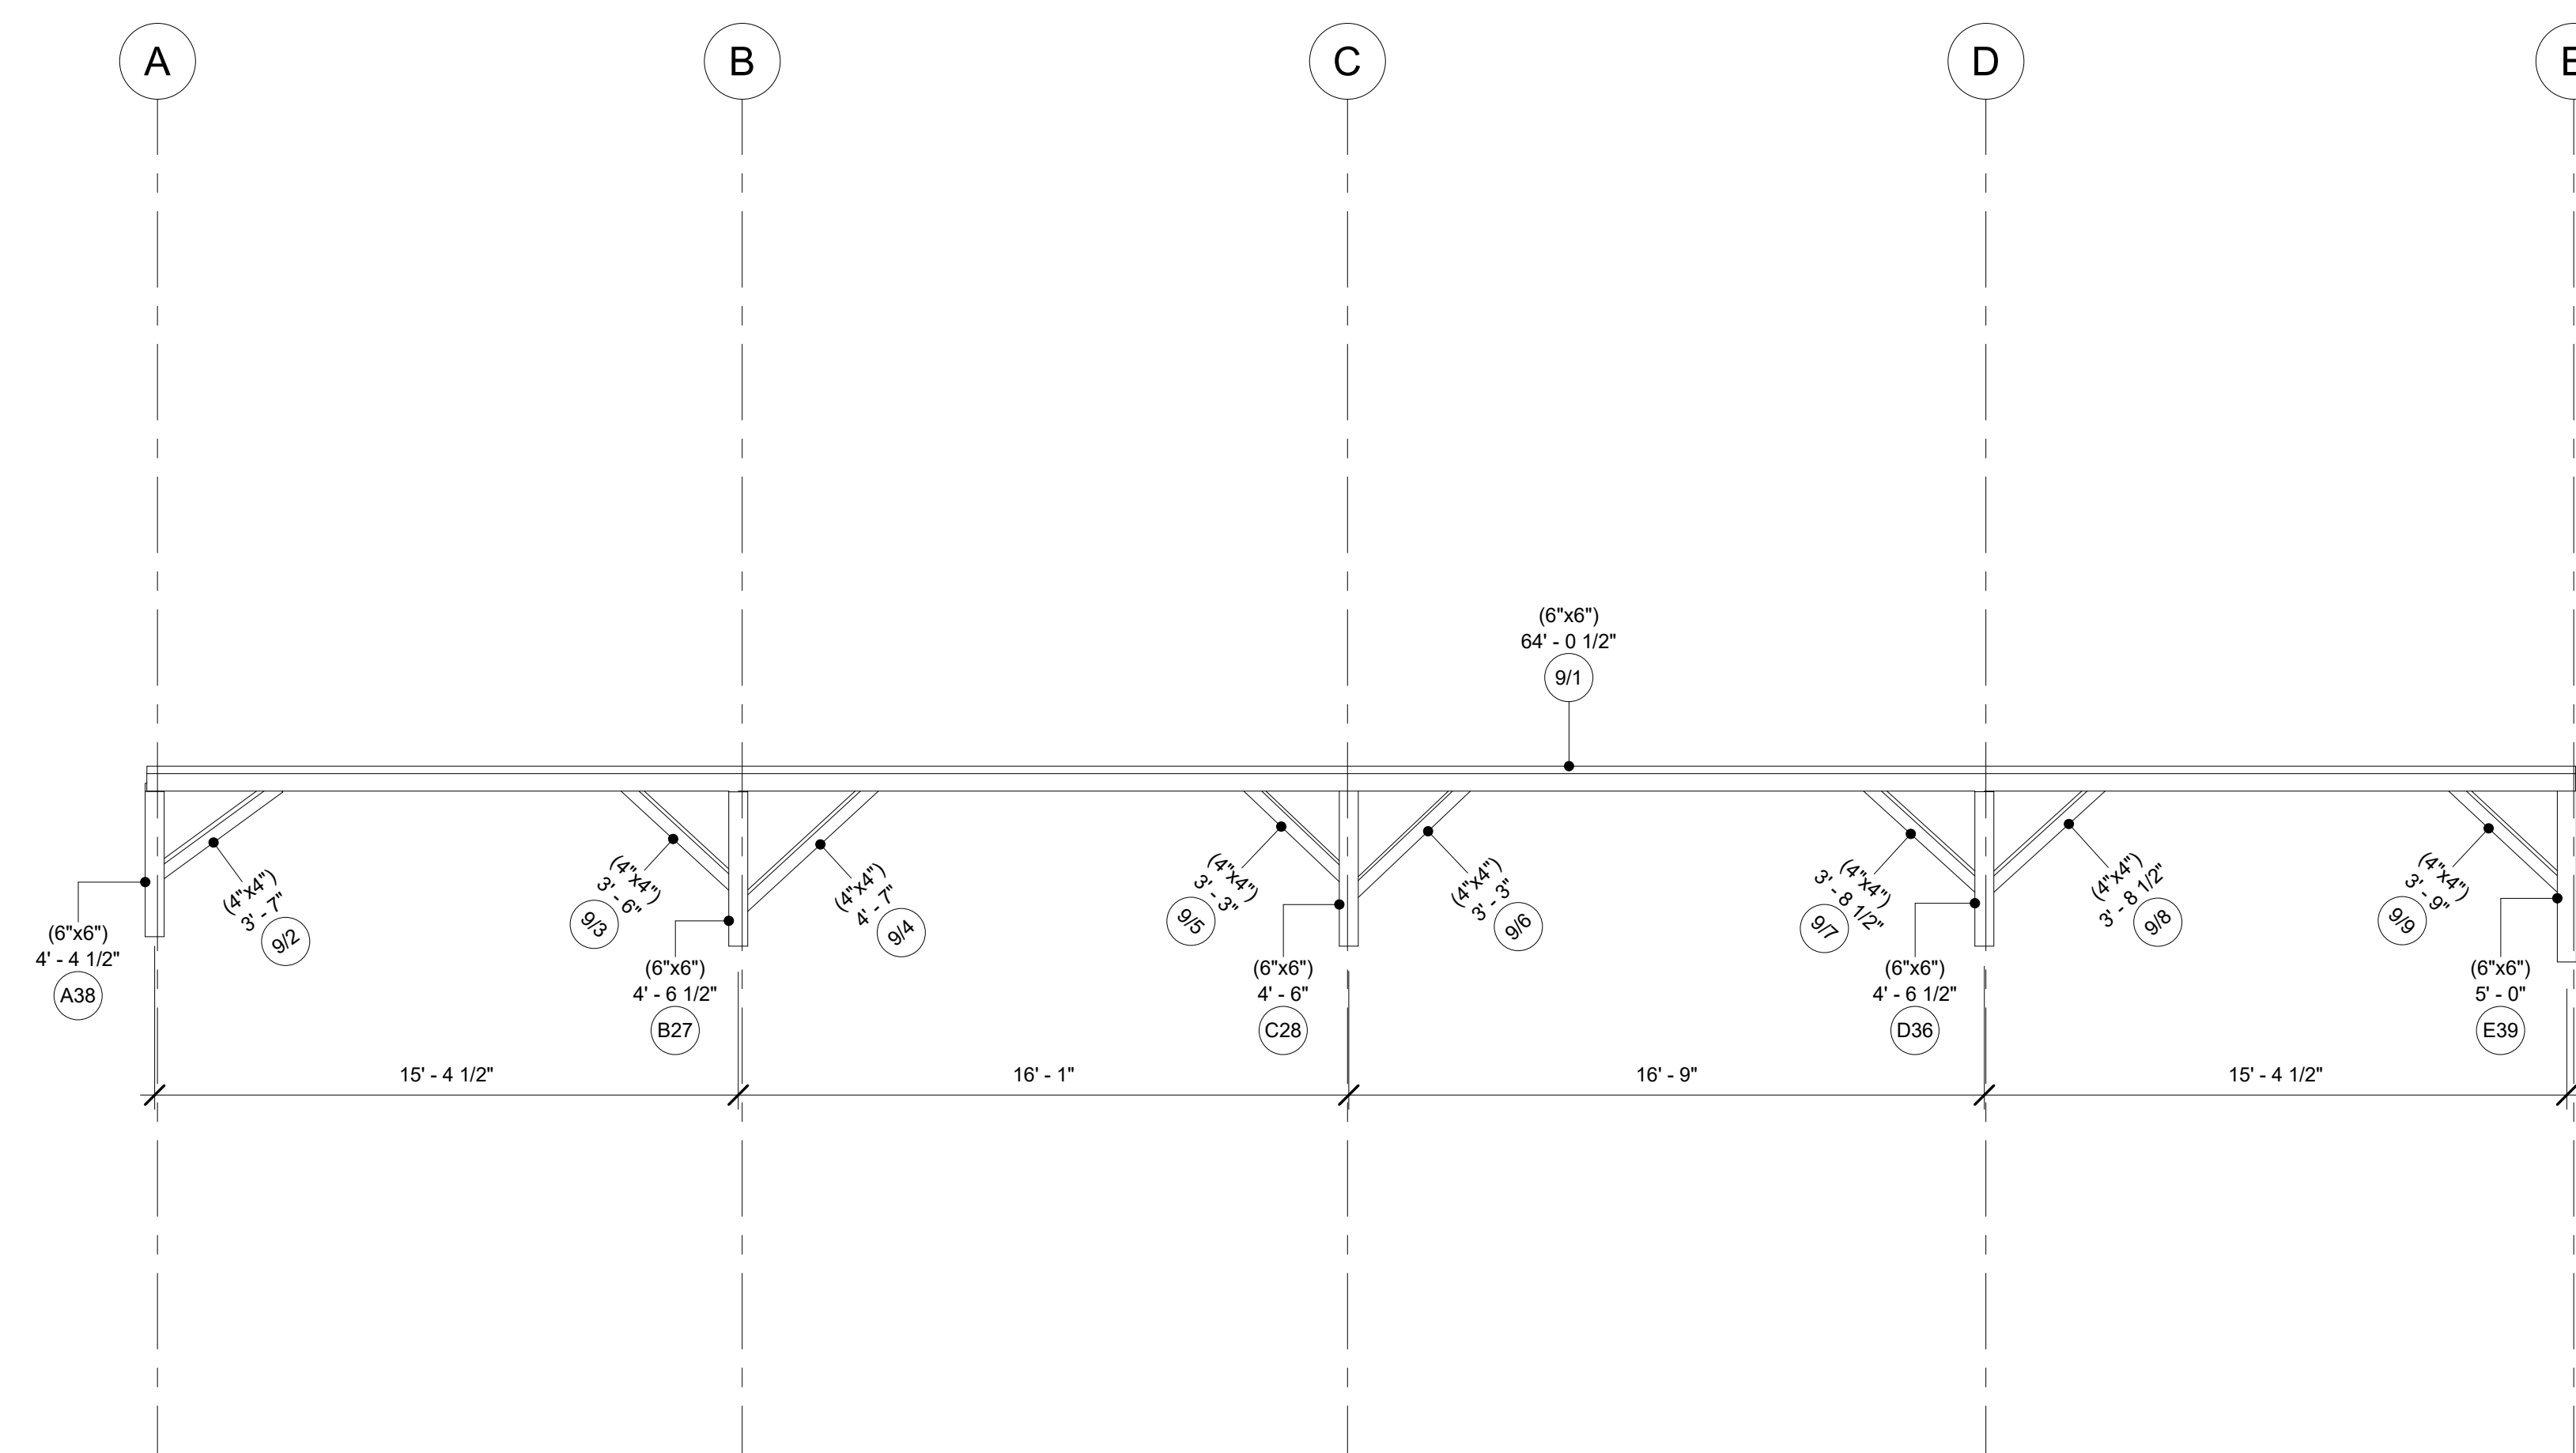

Bent 9

Project Number Project 6

Date 20240912

Drawn By

Checked By

A116

Scale 1/4" = 1'-0"