

PROJECT: 119 Laurel Ridge Retreat
SCOPE: AS BUILT DRAWINGS

**Timber
Home
Services LLC**


80 Old Gate Road,
Penn Run PA, 15765

DAN TRIMBLE
AA66 / TIMBER HOME SERVICES

CELL PHONE/TEXT - 412-309-1161

EMAIL:

DANTRIMBLE@TIMBERHOMESERVICES.COM

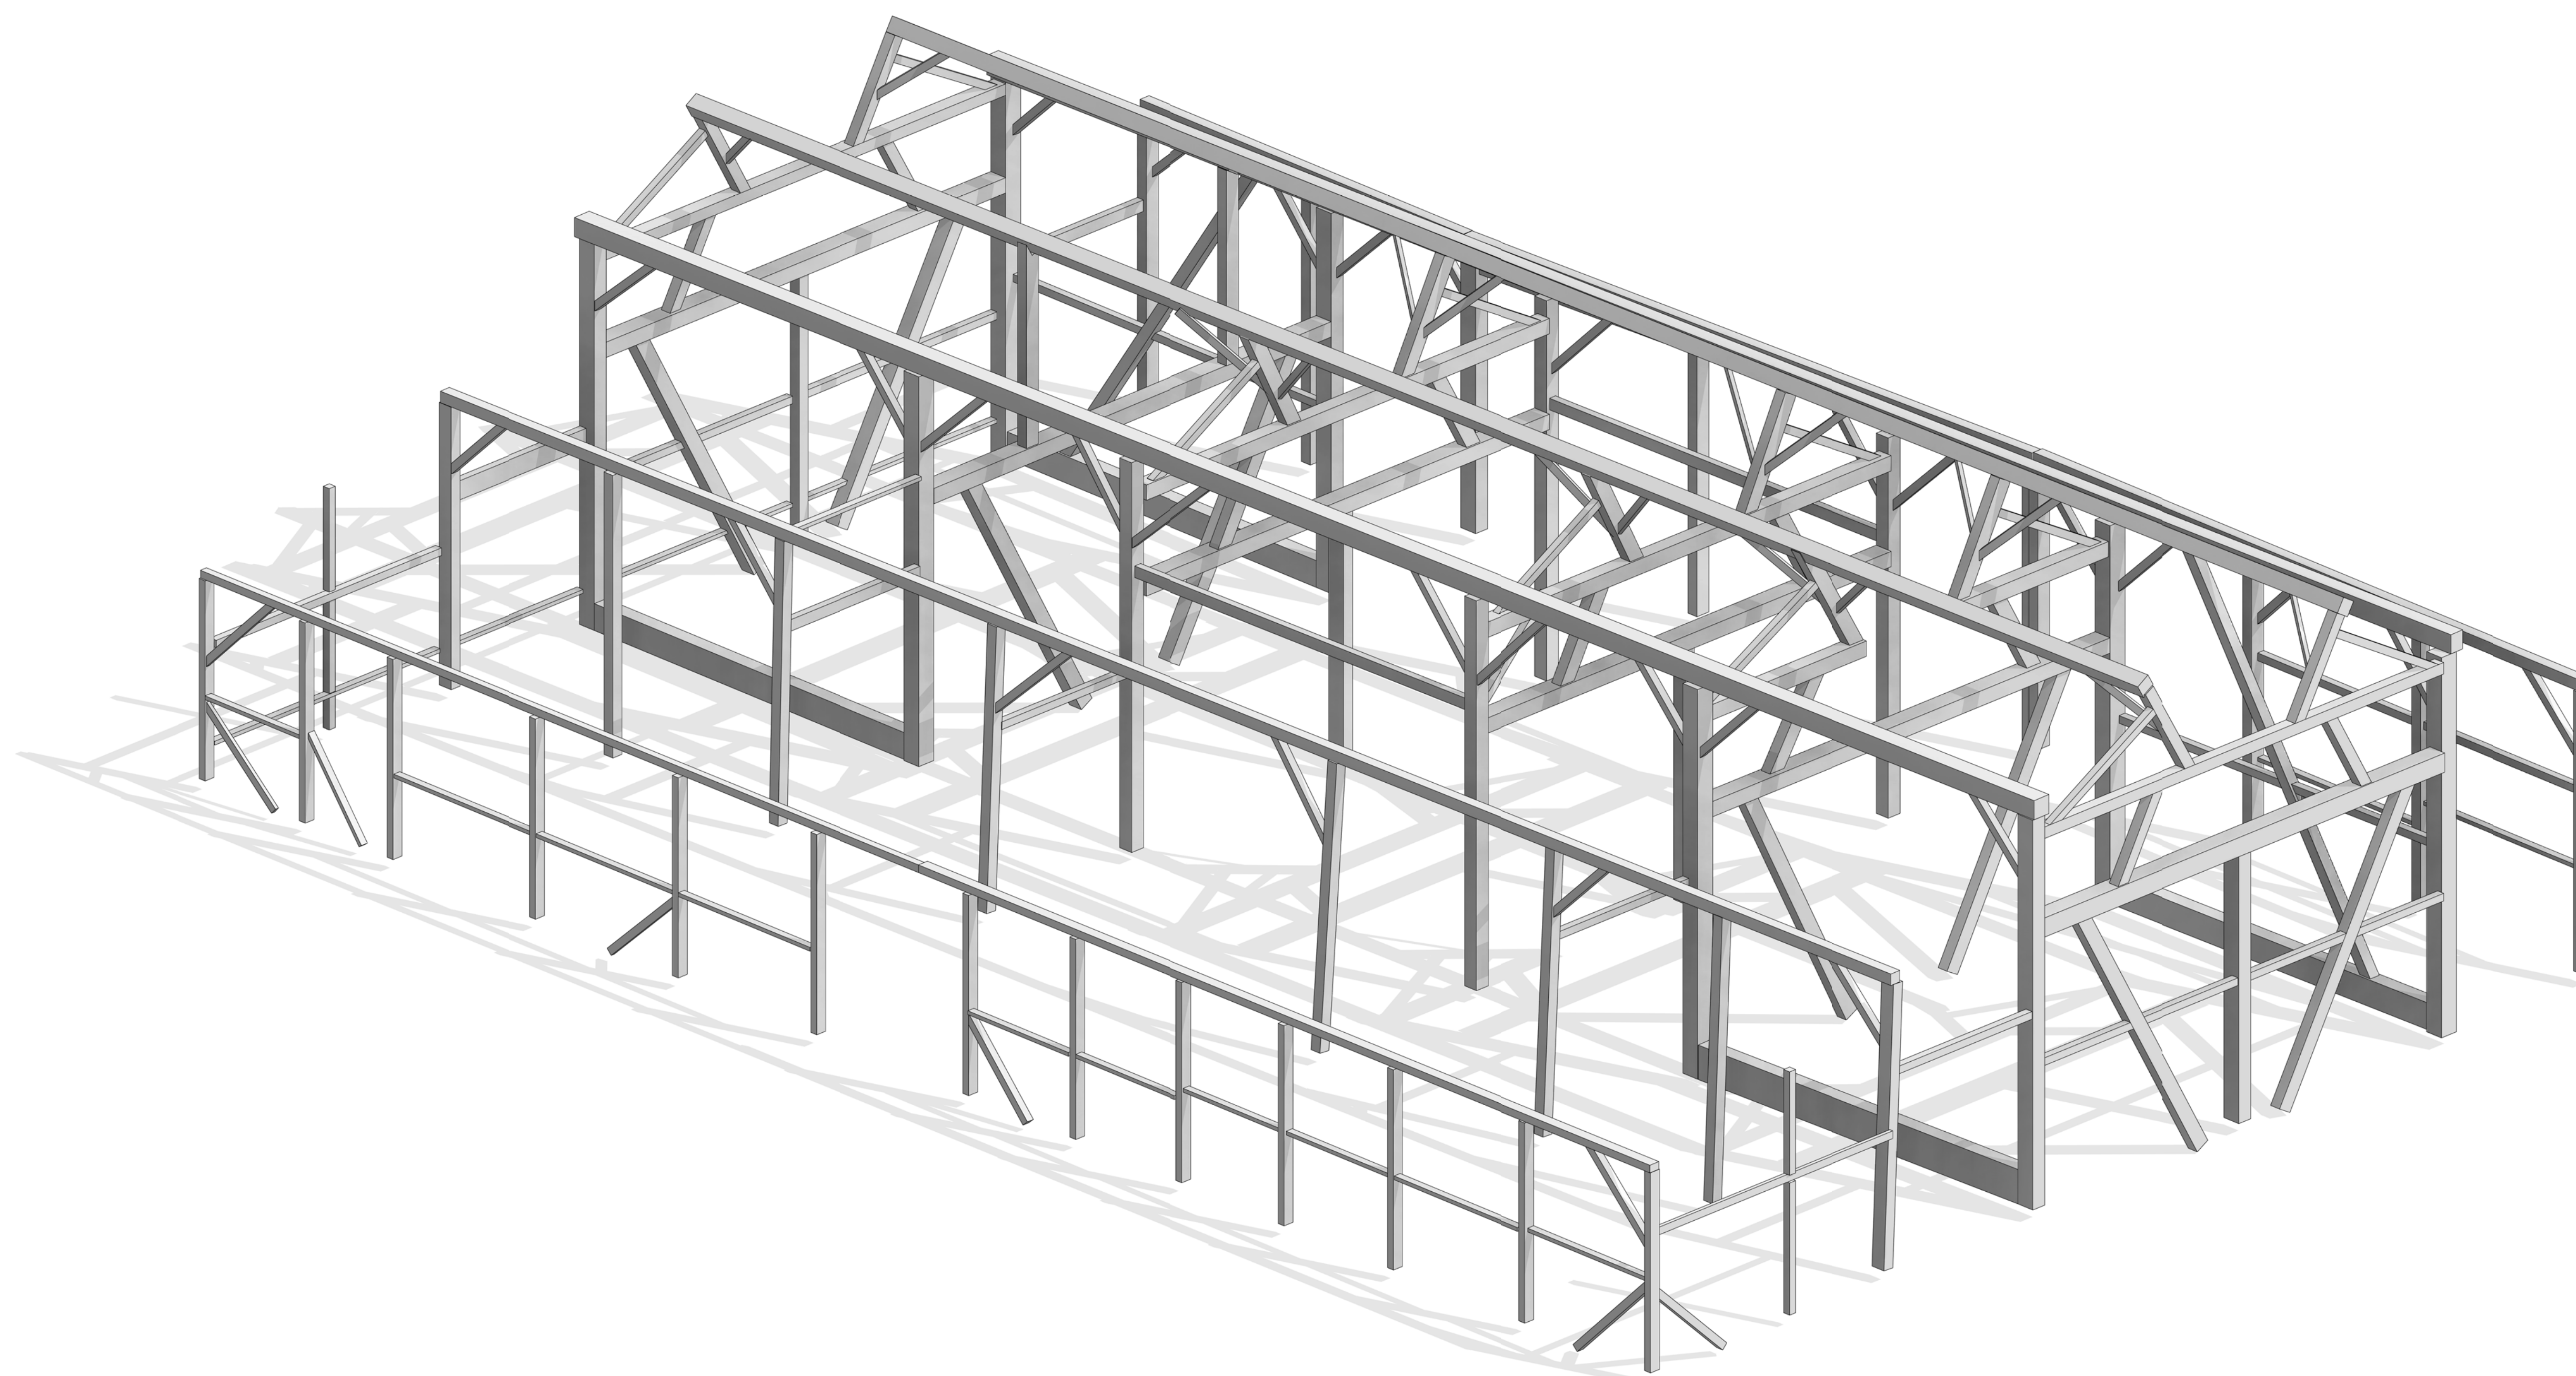

Cover Page

Project Number Project 4

Date 20240821

Drawn By

Checked By

A101

Scale

Timber Home Services LLC

80 Old Gate Road,
Penn Run PA, 15765

DAN TRIMBLE
AA66 / TIMBER HOME SERVICES

CELL PHONE/TEXT - 412-309-1161

EMAIL:

DANTRIMBLE@TIMBERHOMESERVICES.COM

Floor Plan

Project Number Project 4


Date 20240821

Drawn By

Checked By

A102

Scale 1/4" = 1'-0"

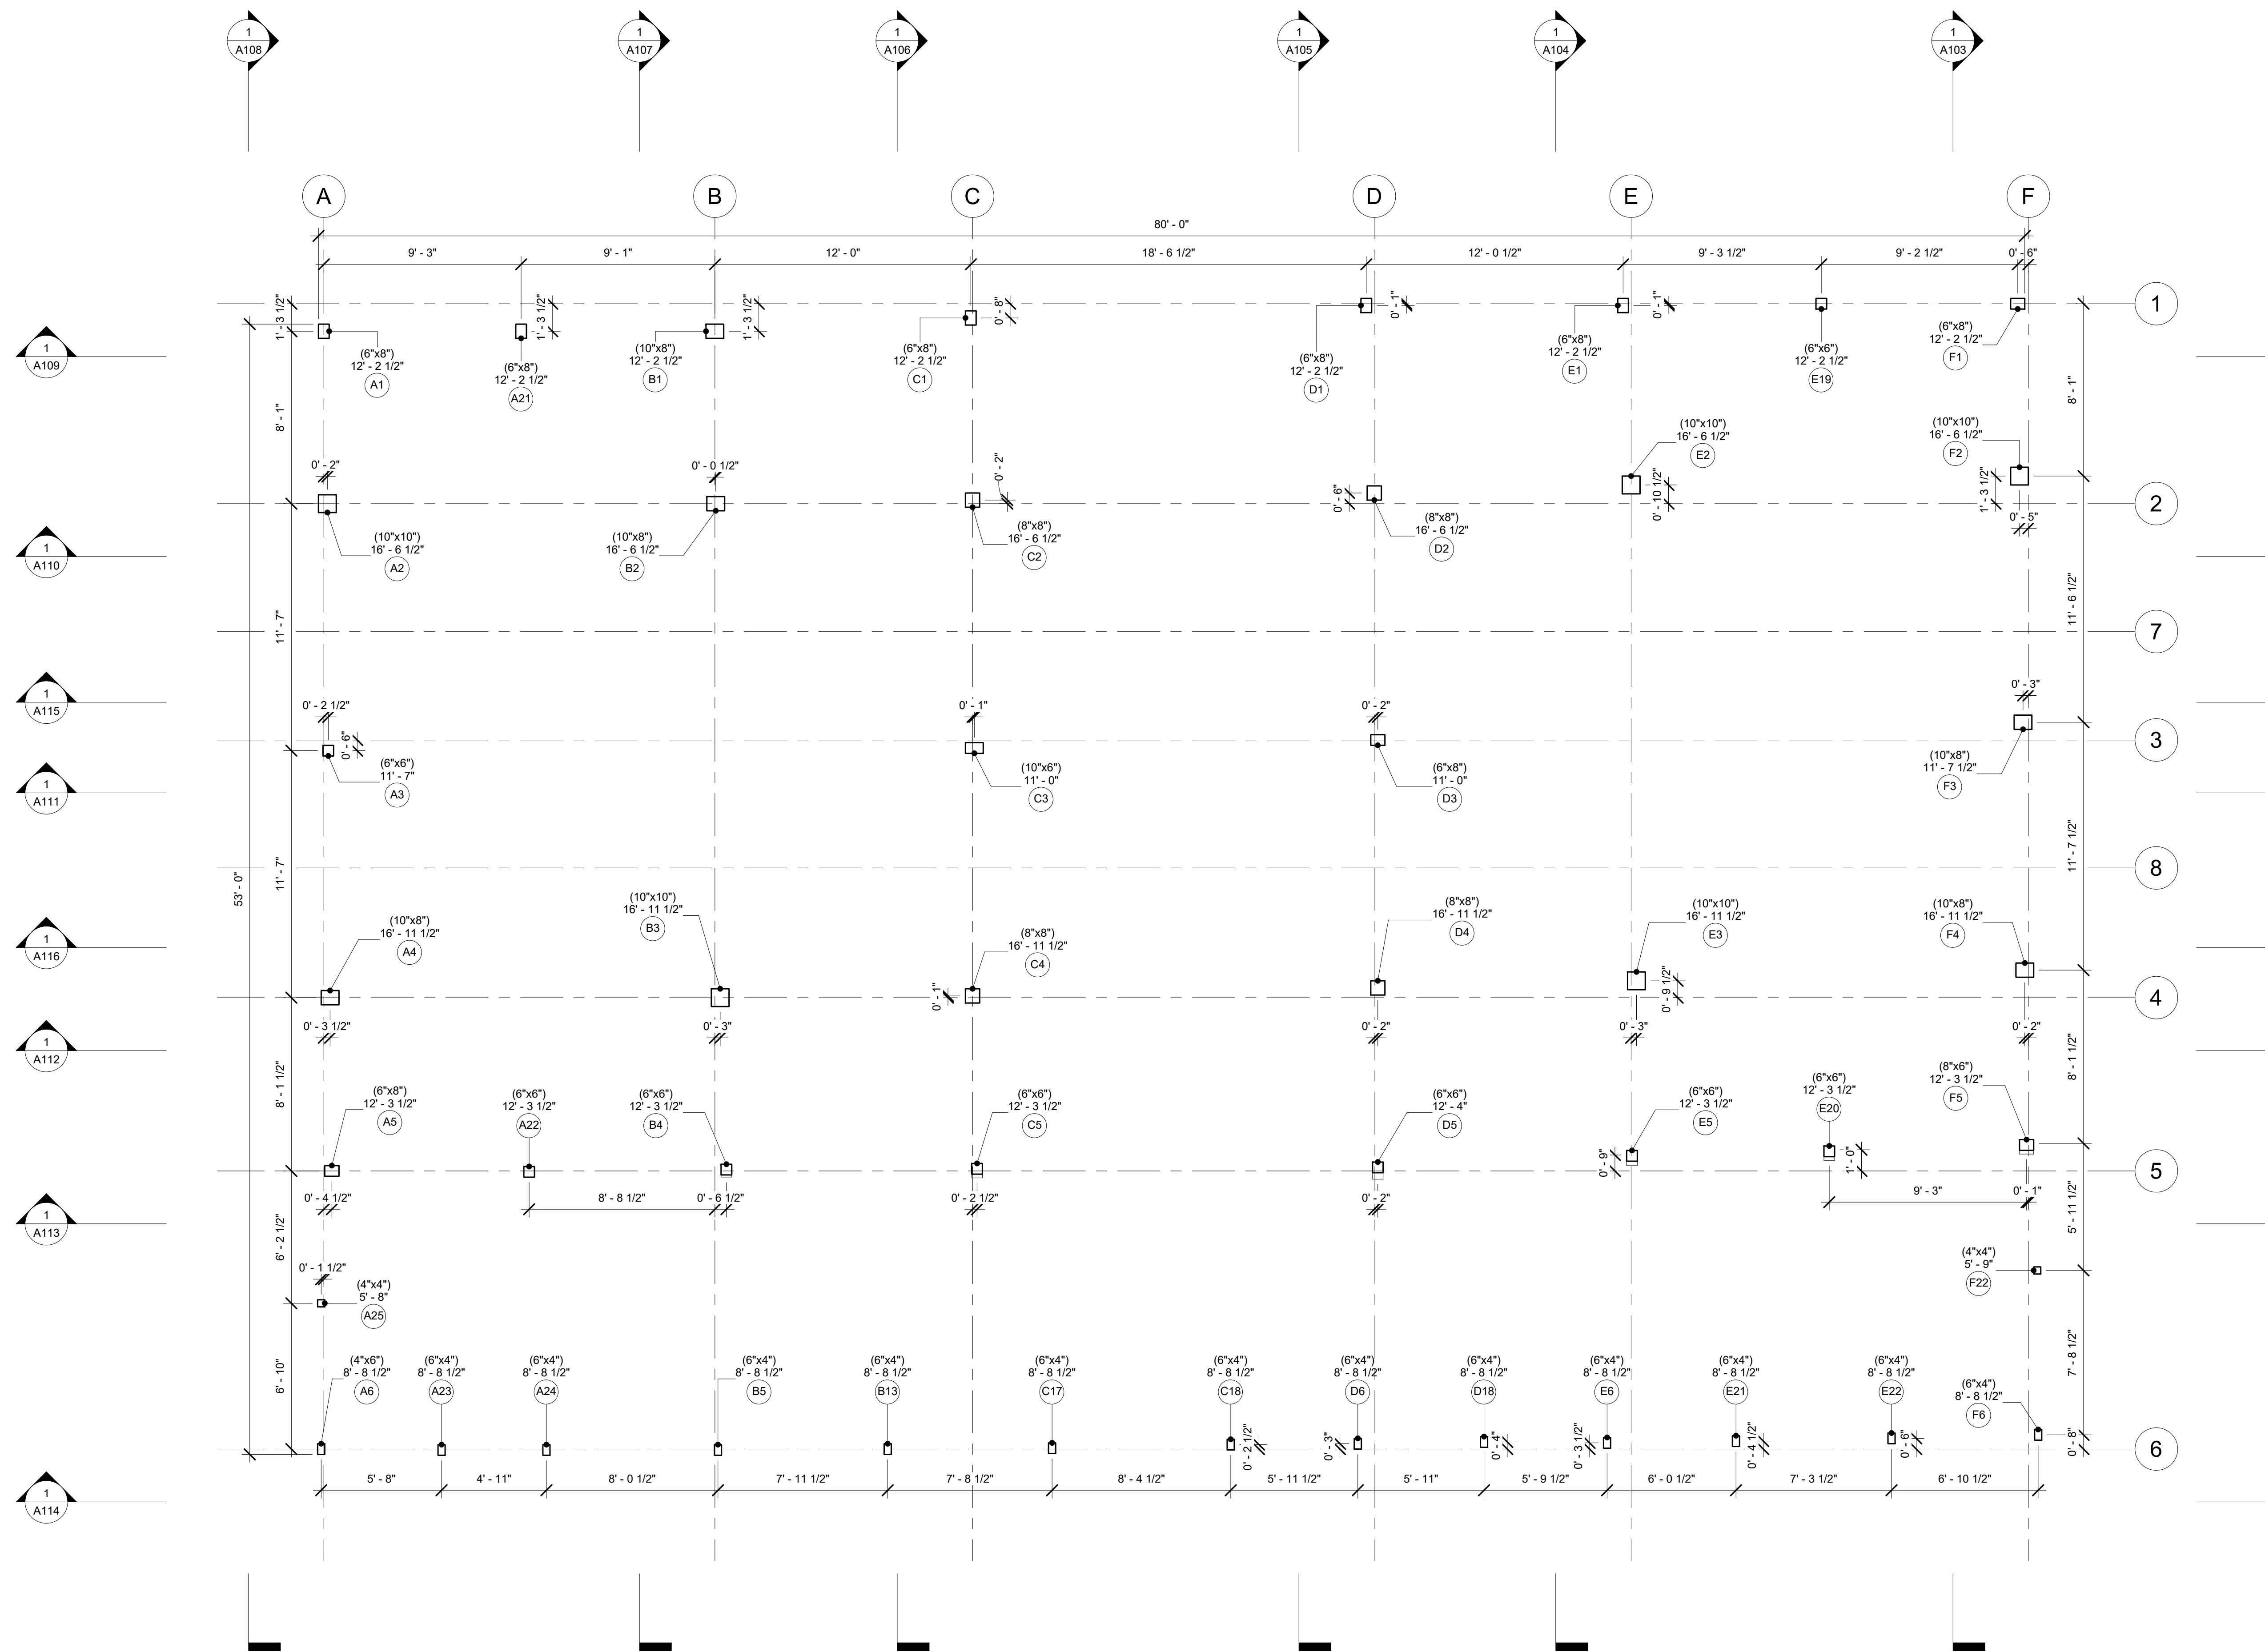


Timber Home Services LLC

80 Old Gate Road,
Penn Run PA, 15765

DAN TRIMBLE
AA66 / TIMBER HOME SERVICES
CELL PHONE/TEXT - 412-309-1161

EMAIL:
DANTRIMBLE@TIMBERHOMESERVICES.COM

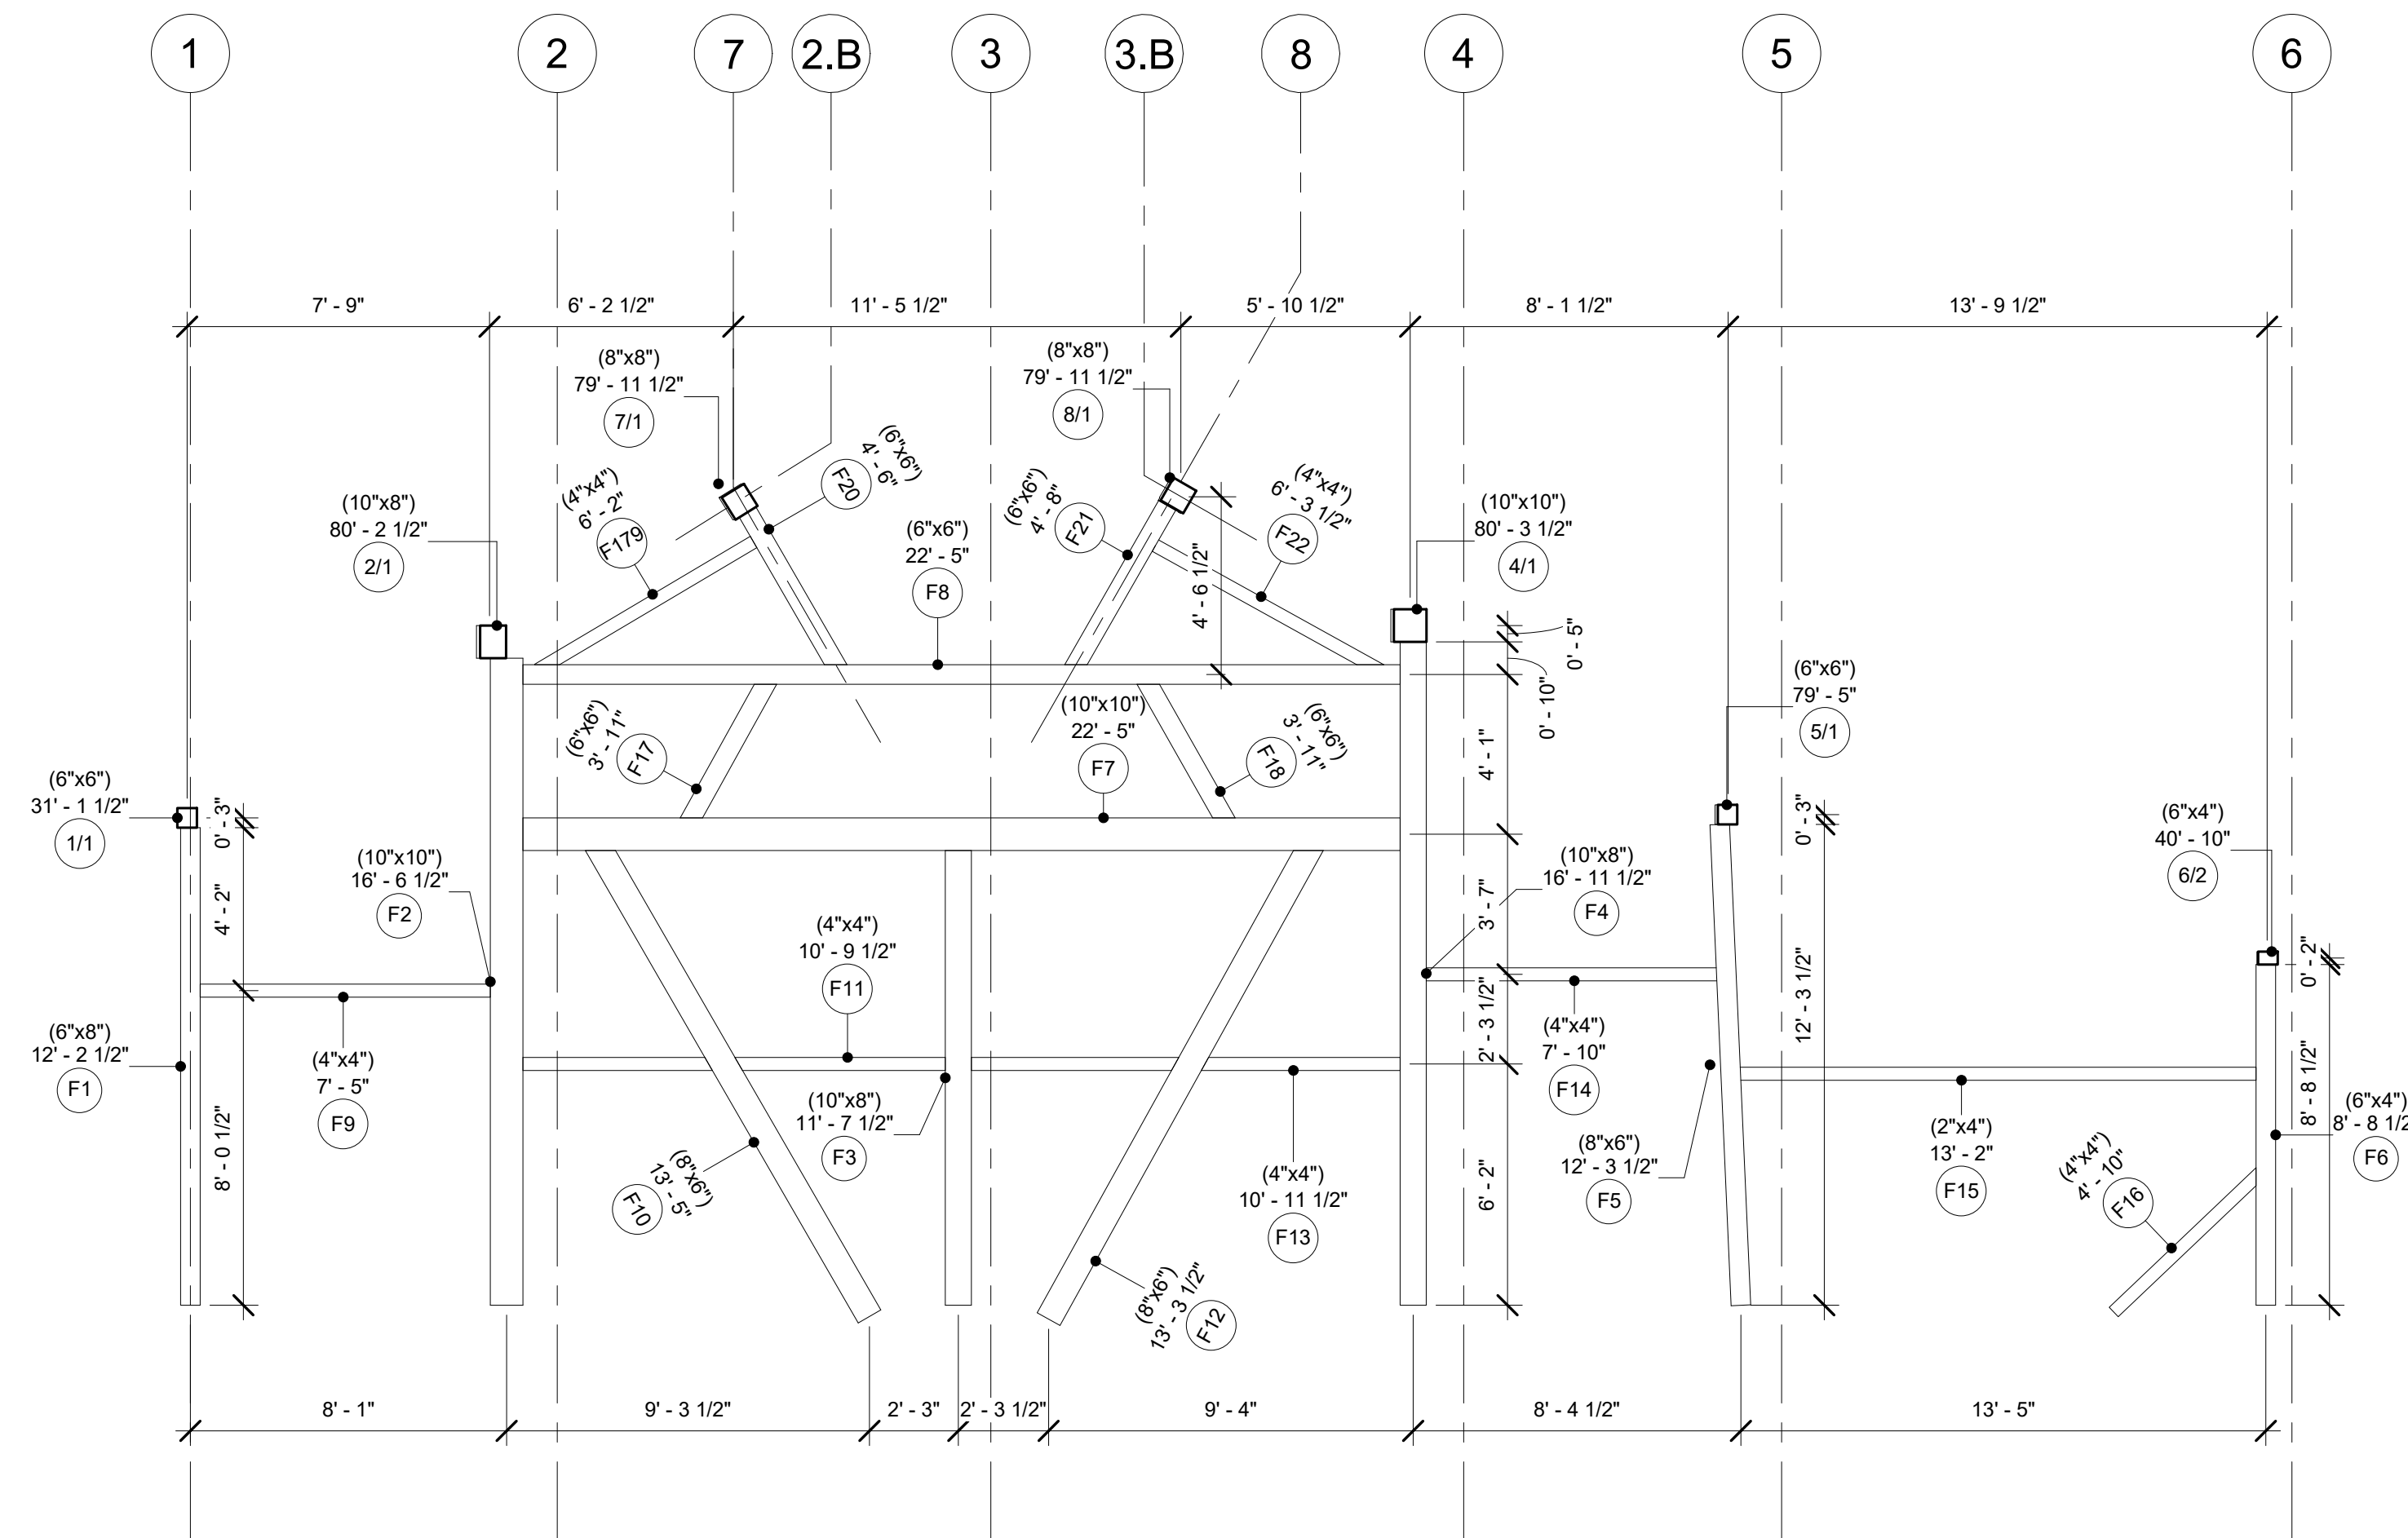

Bent F

Project Number	Project 4
Date	20240821
Drawn By	
Checked By	

A103


Scale 1/4" = 1'-0"

Timber Home Services LLC

80 Old Gate Road,
Penn Run PA, 15765

DAN TRIMBLE
AA66 / TIMBER HOME SERVICES
CELL PHONE/TEXT - 412-309-1161

EMAIL:
DANTRIMBLE@TIMBERHOMESERVICES.COM

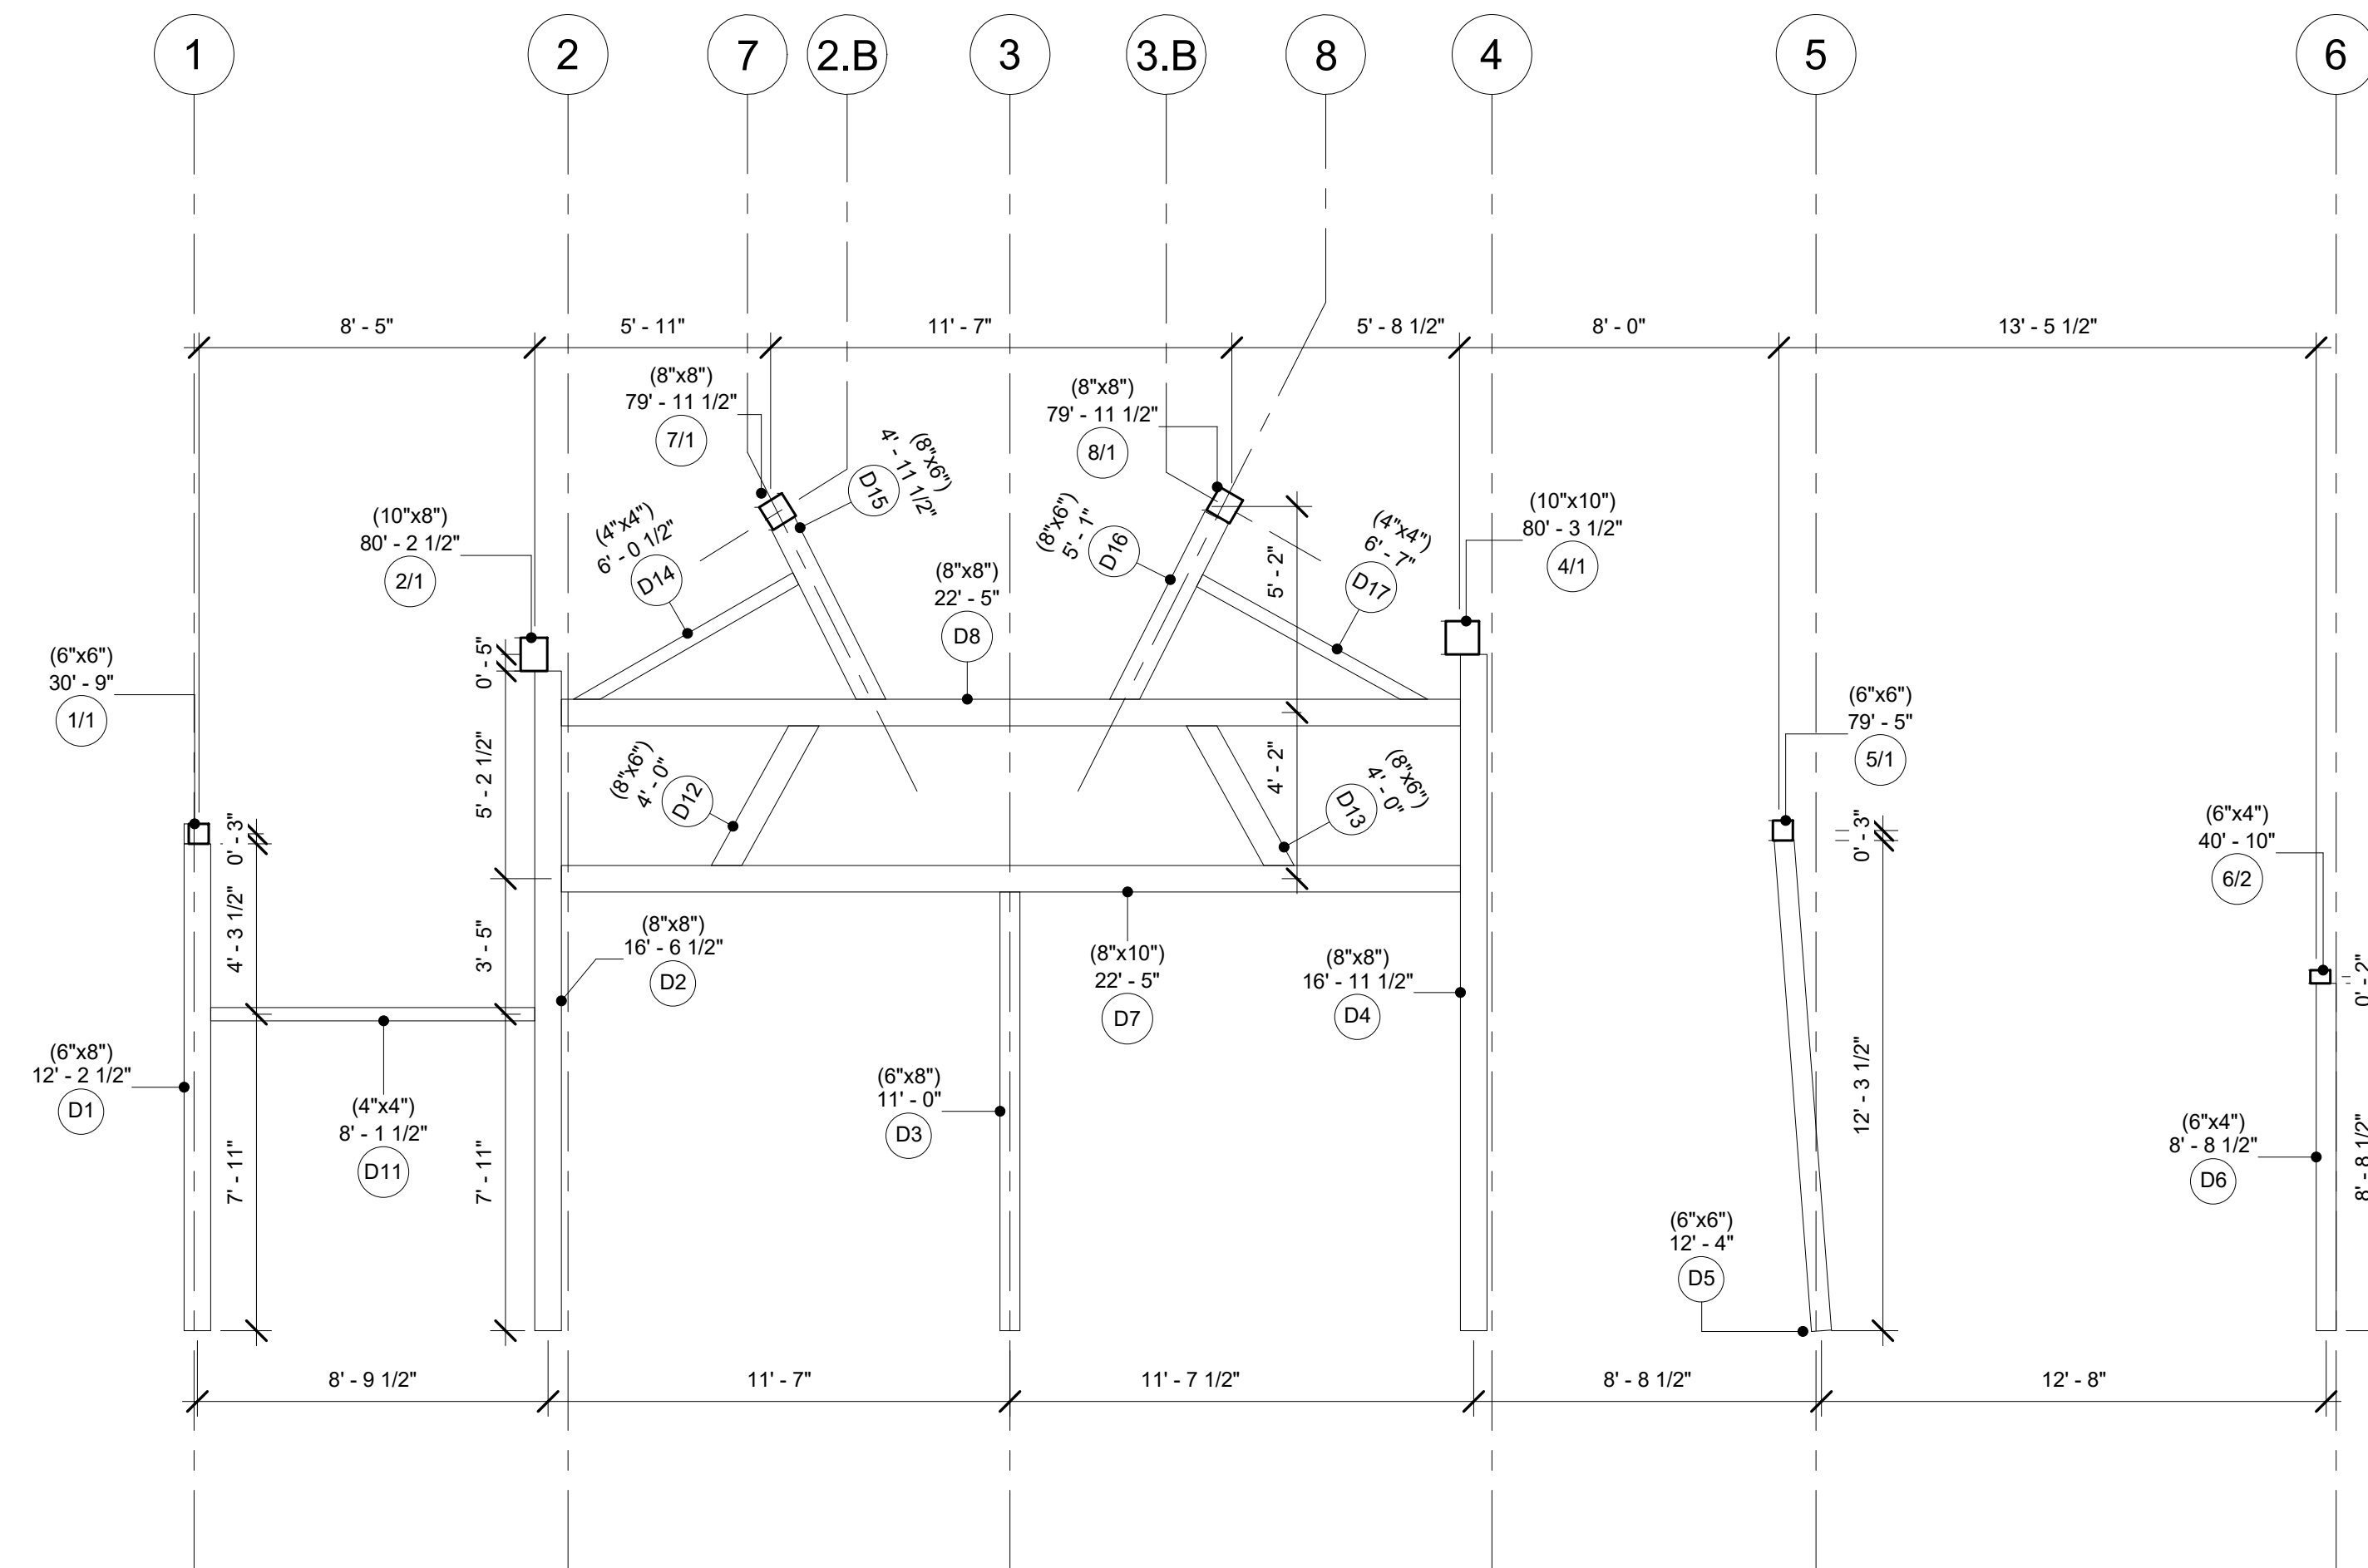

Bent D

Project Number	Project 4
Date	20240821
Drawn By	
Checked By	

A105


Scale 1/4" = 1'-0"

Timber Home Services LLC

80 Old Gate Road,
Penn Run PA, 15765

DAN TRIMBLE
AA66 / TIMBER HOME SERVICES
CELL PHONE/TEXT - 412-309-1161

EMAIL:
DANTRIMBLE@TIMBERHOMESERVICES.COM

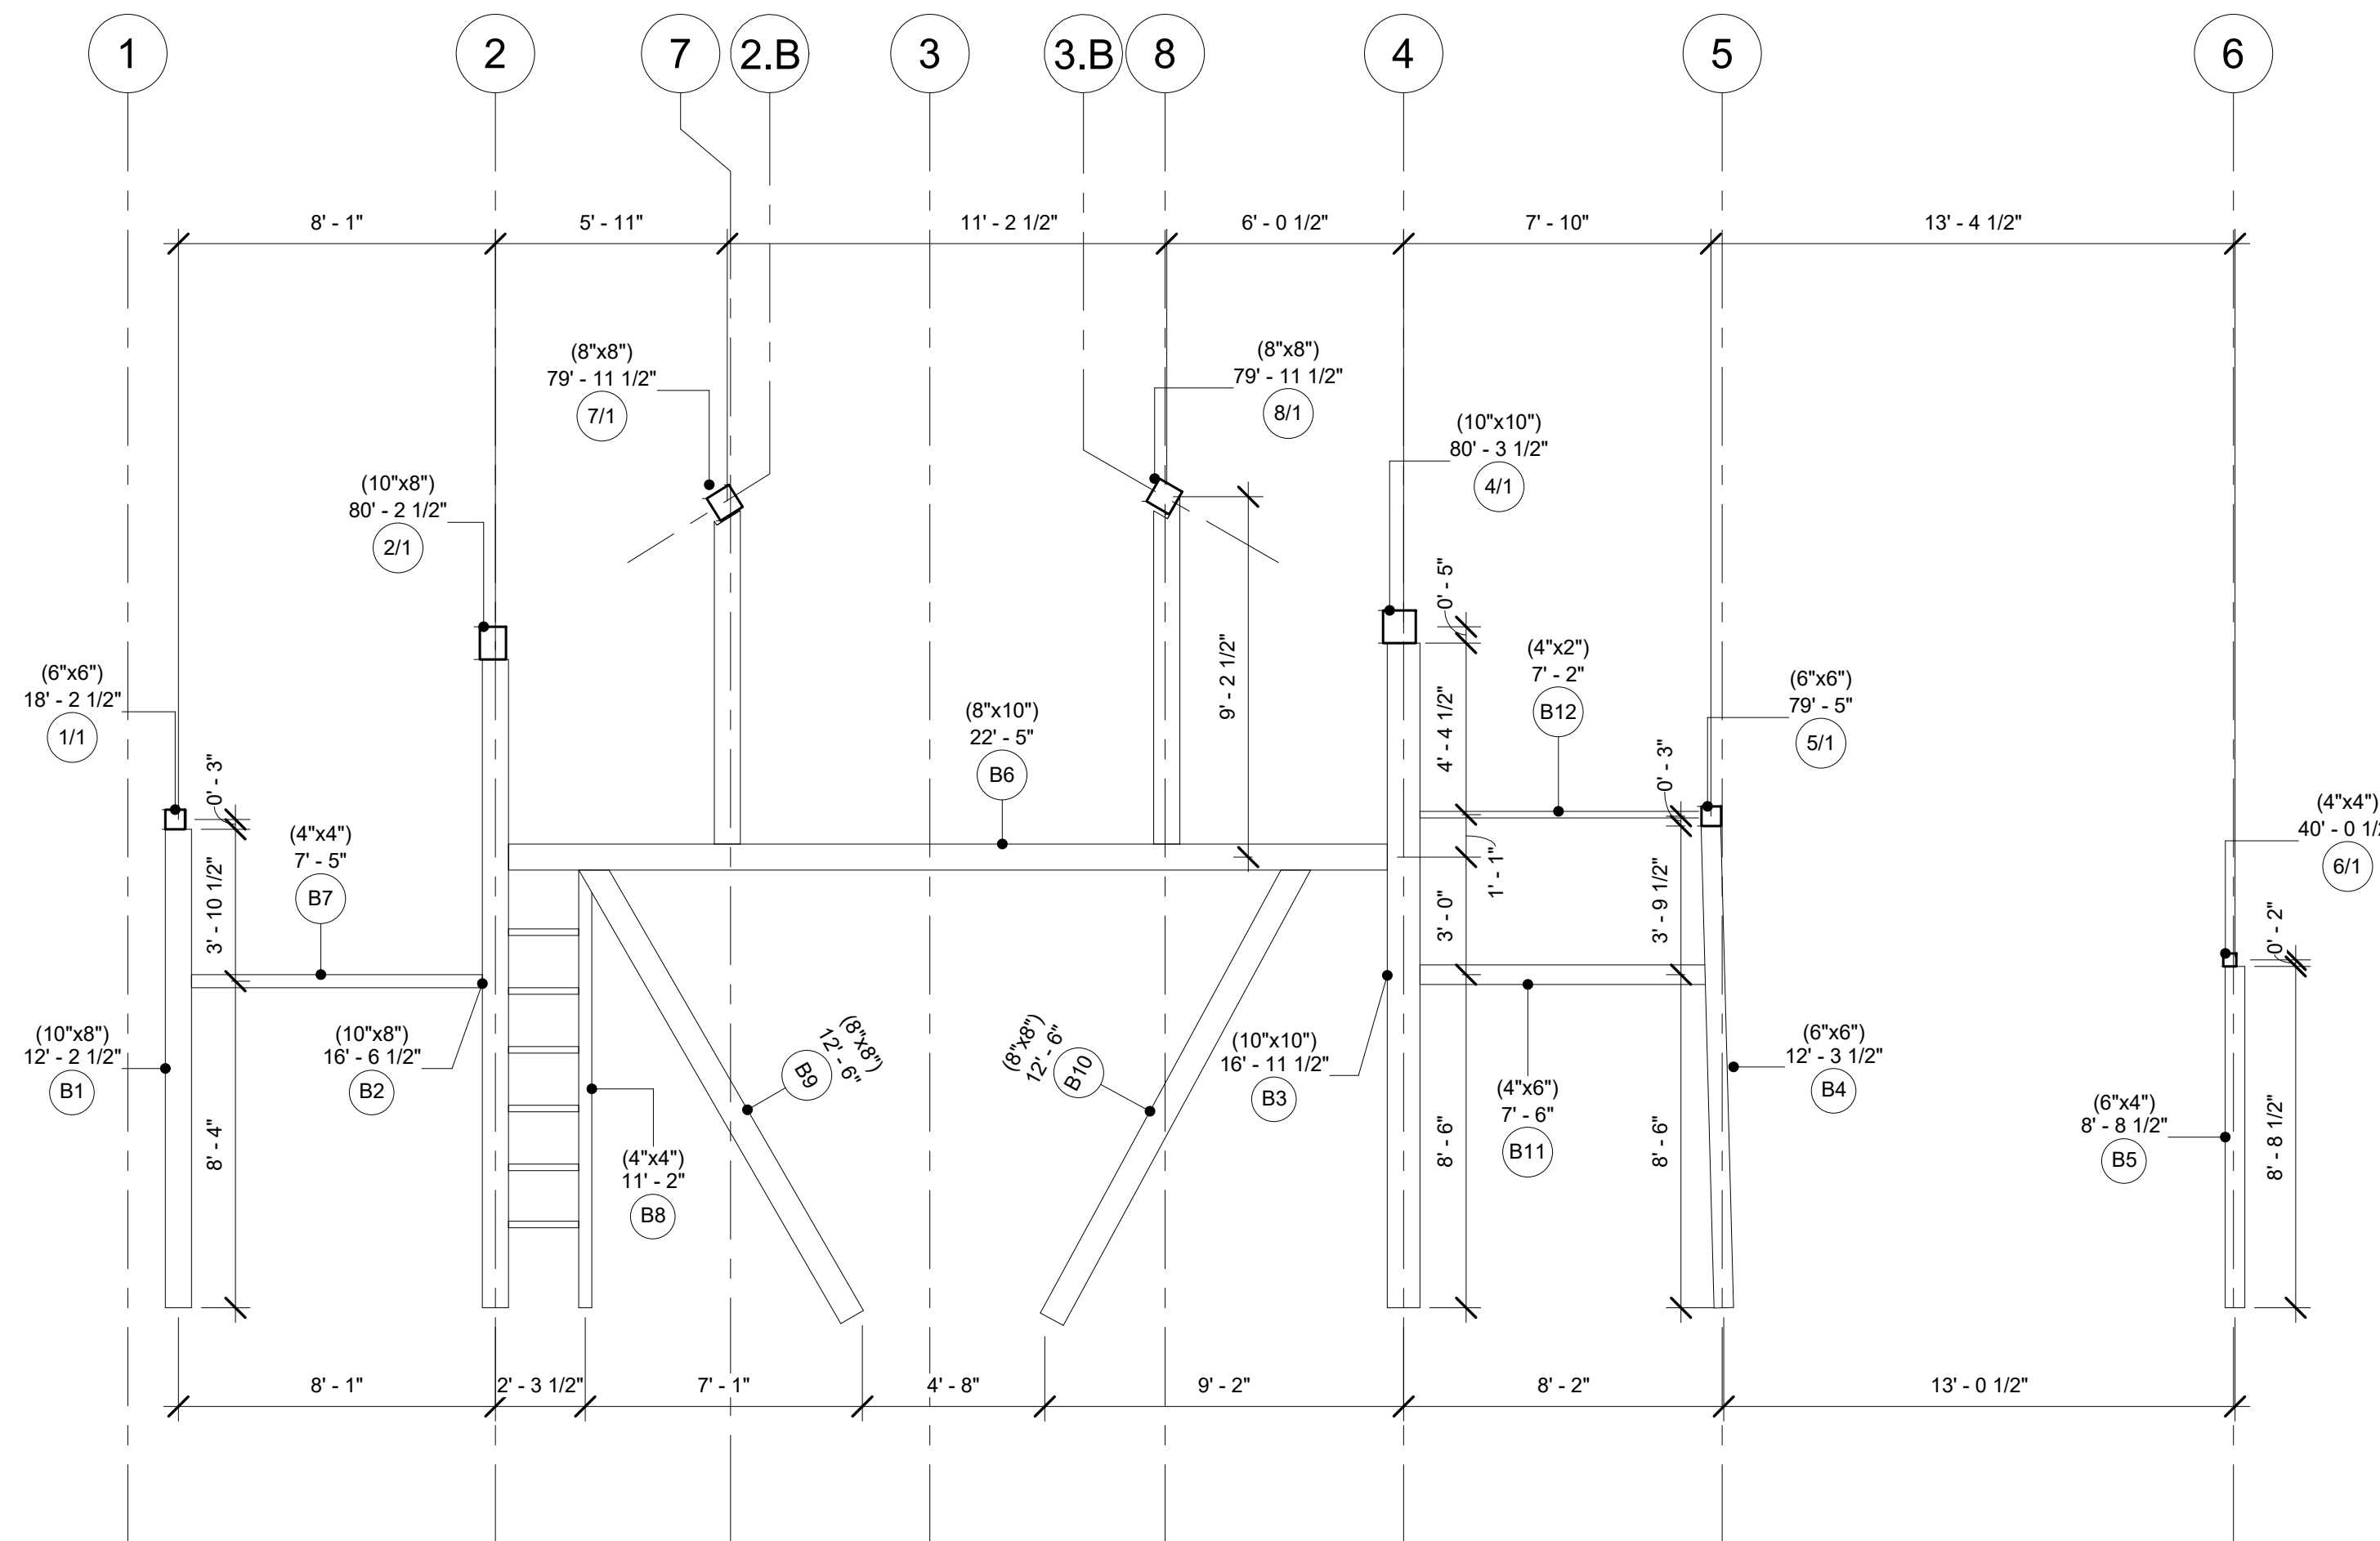

Bent B

Project Number	Project 4
Date	20240821
Drawn By	
Checked By	

A107


Scale 1/4" = 1'-0"

Timber Home Services LLC

80 Old Gate Road,
Penn Run PA, 15765

DAN TRIMBLE
AA66 / TIMBER HOME SERVICES
CELL PHONE/TEXT - 412-309-1161

EMAIL:
DANTRIMBLE@TIMBERHOMESERVICES.COM

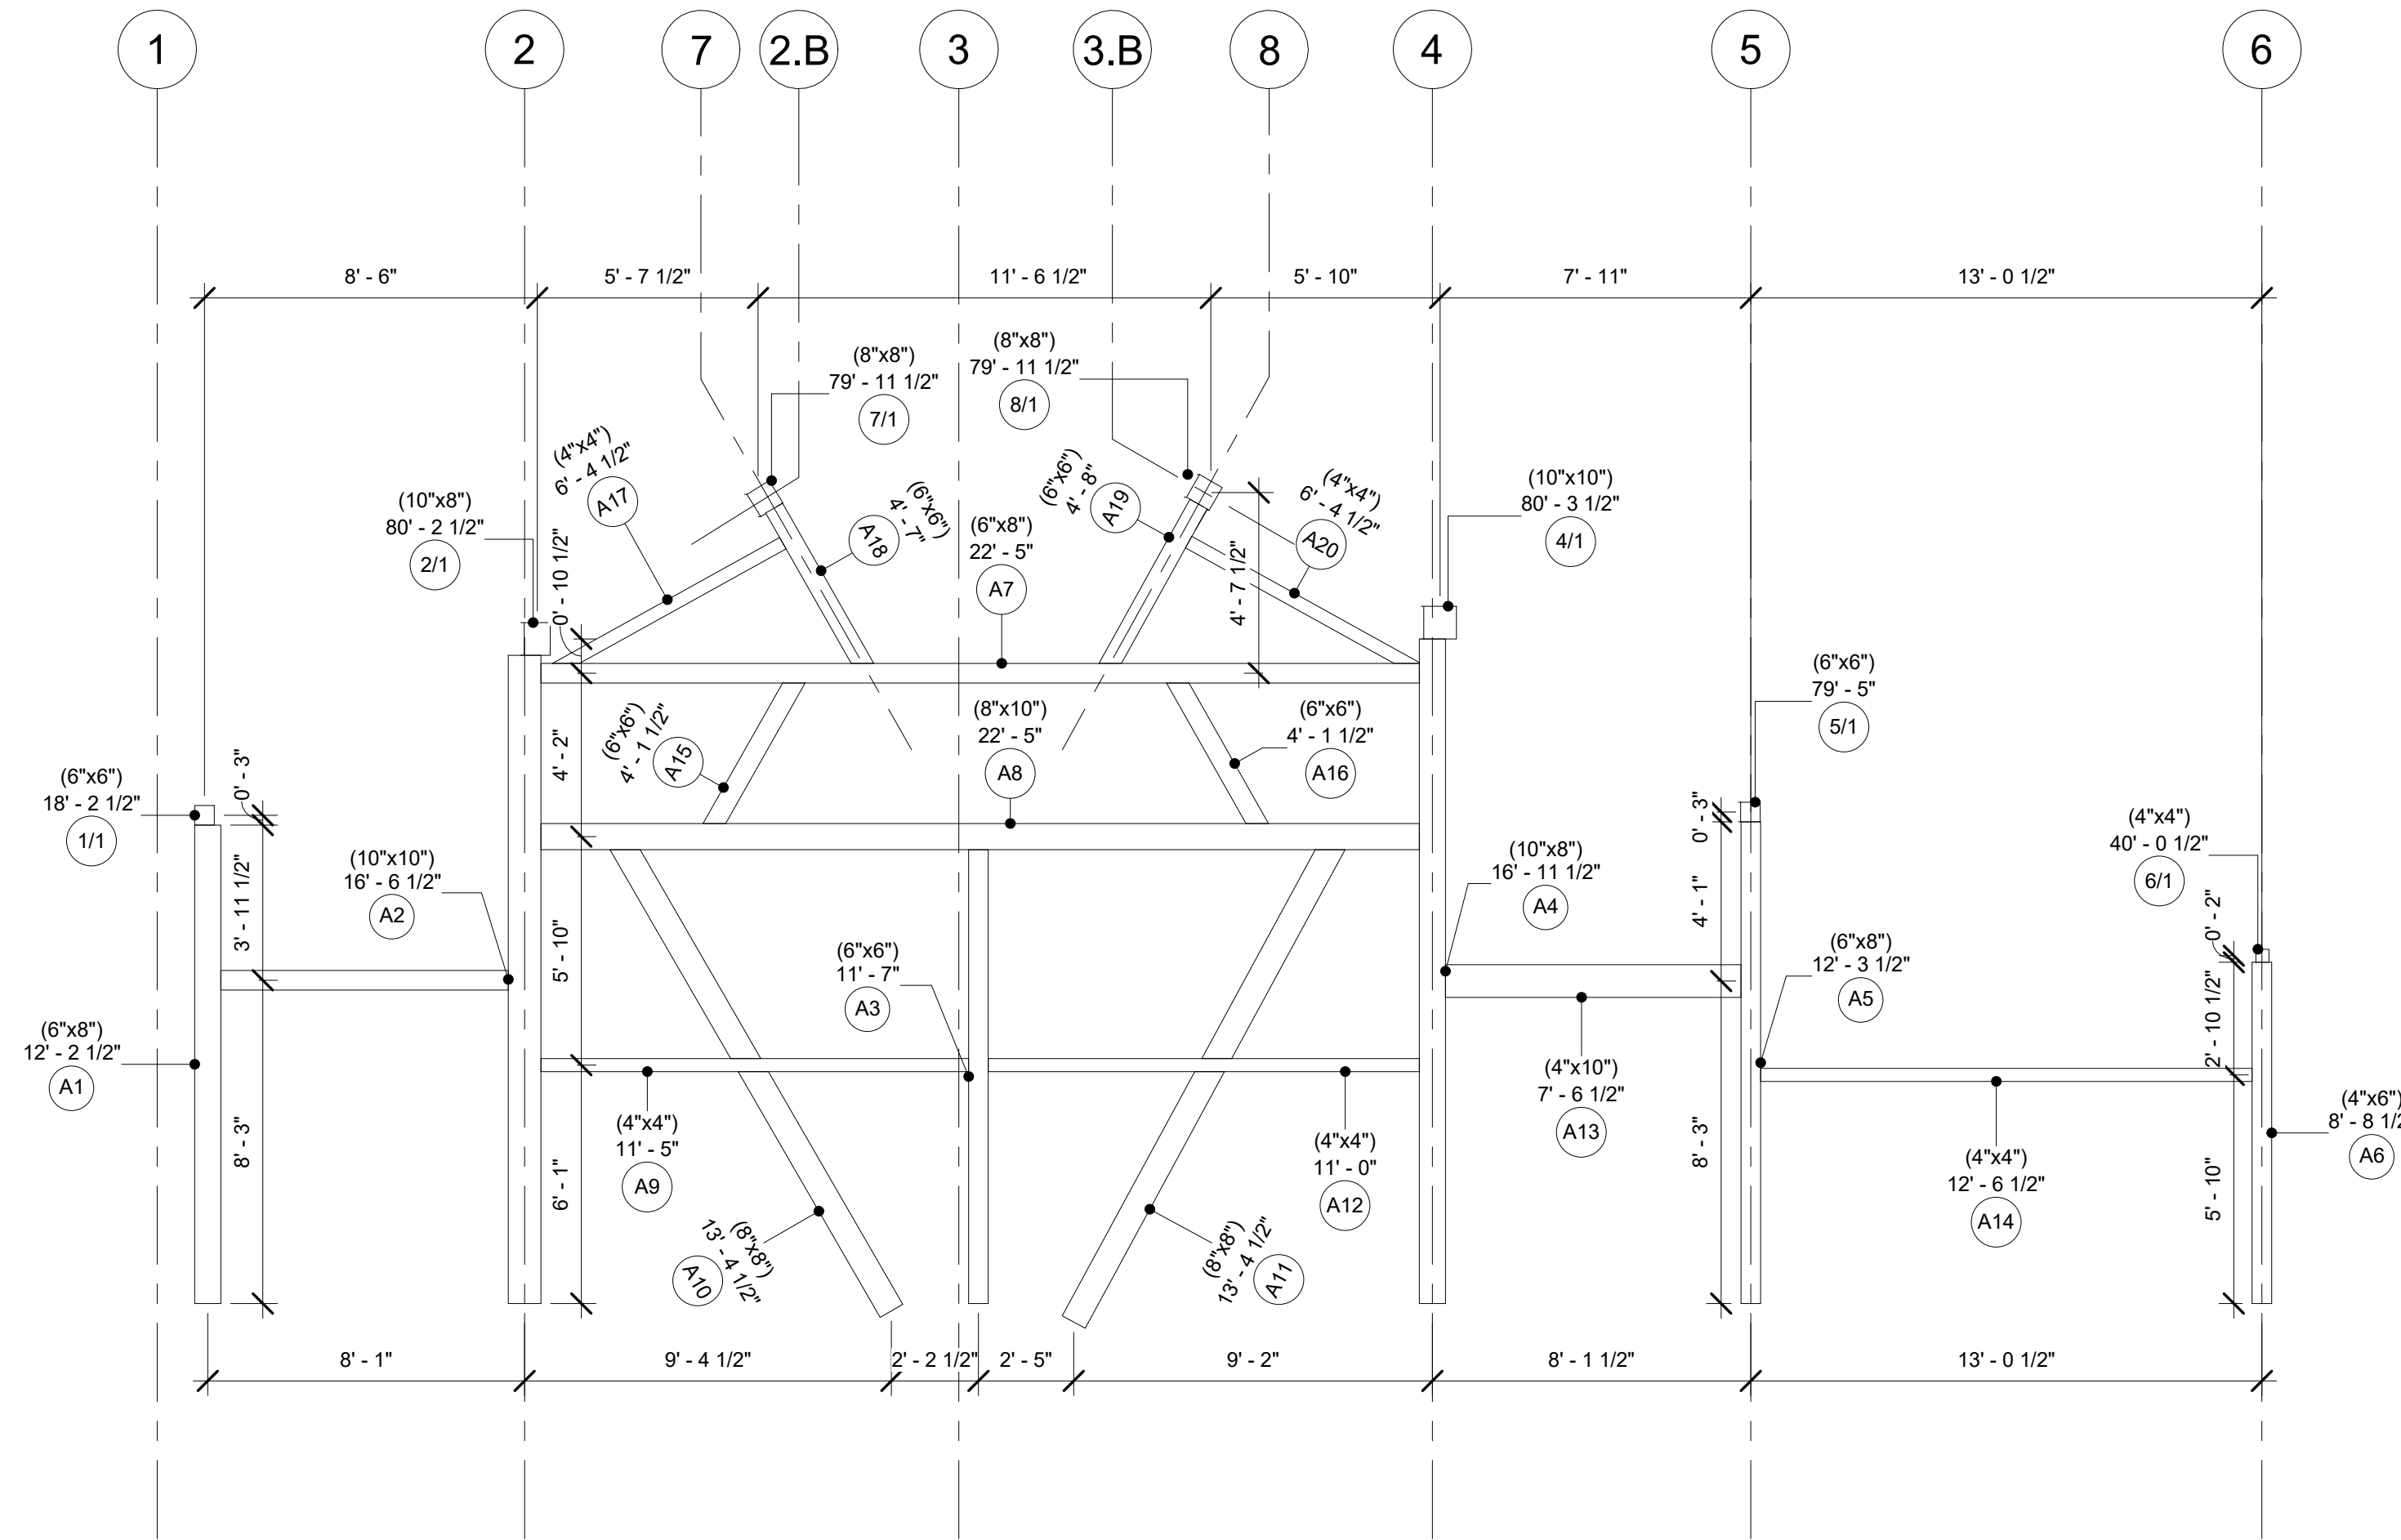

Bent A

Project Number	Project 4
Date	20240821
Drawn By	
Checked By	

A108


Scale 1/4" = 1'-0"

Timber Home Services LLC

80 Old Gate Road,
Penn Run PA, 15765

DAN TRIMBLE
AA66 / TIMBER HOME SERVICES
CELL PHONE/TEXT - 412-309-1161

EMAIL:
DANTRIMBLE@TIMBERHOMESERVICES.COM

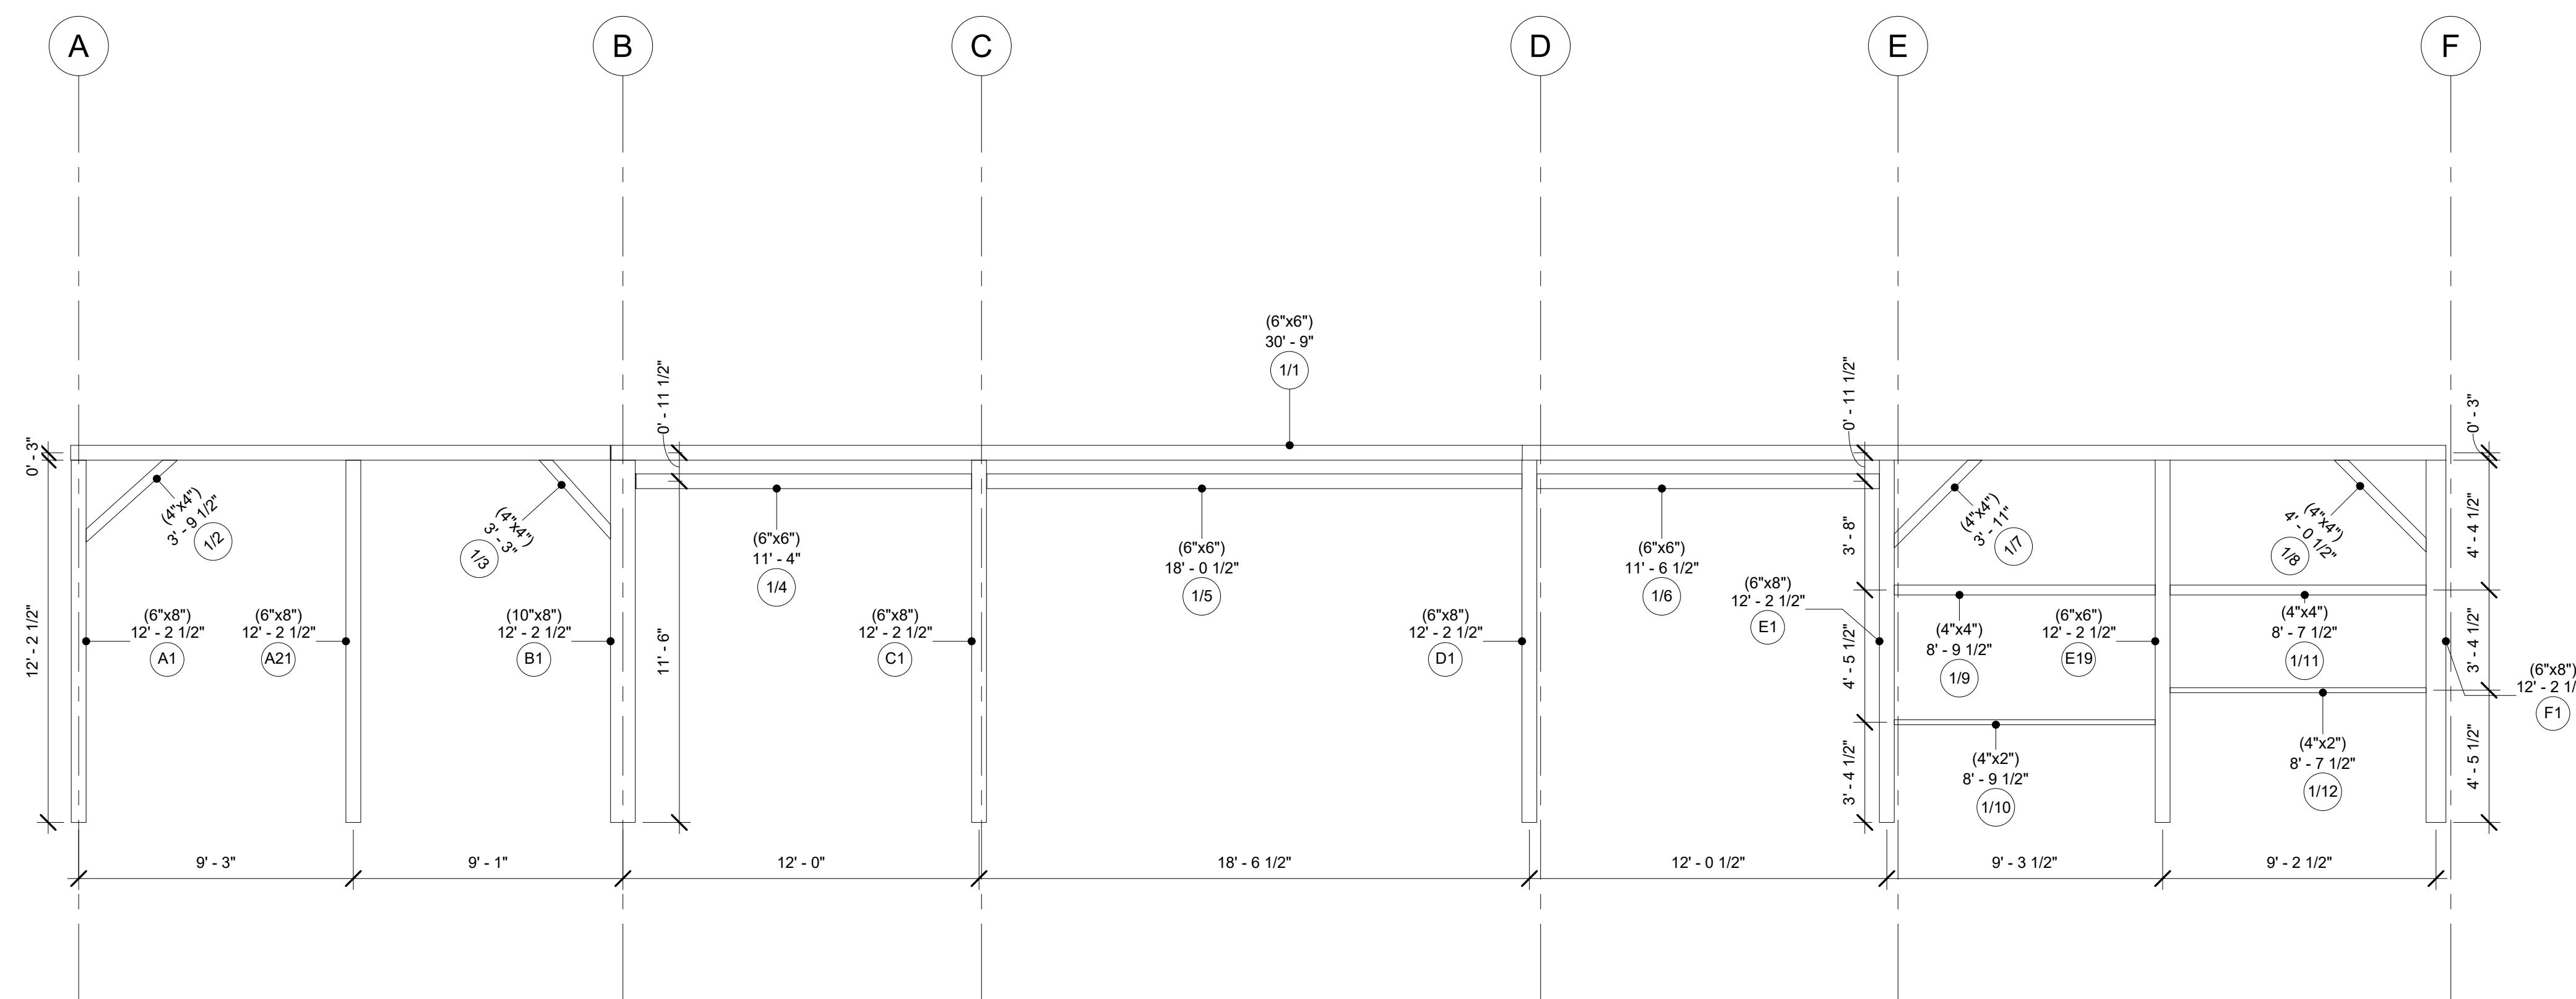

Bent 1

Project Number	Project 4
Date	20240821
Drawn By	
Checked By	

A109

Scale 1/4" = 1'-0"

Timber Home Services LLC


80 Old Gate Road,
Penn Run PA, 15765

DAN TRIMBLE
AA66 / TIMBER HOME SERVICES

CELL PHONE/TEXT - 412-309-1161

EMAIL:

DANTRIMBLE@TIMBERHOMESERVICES.COM

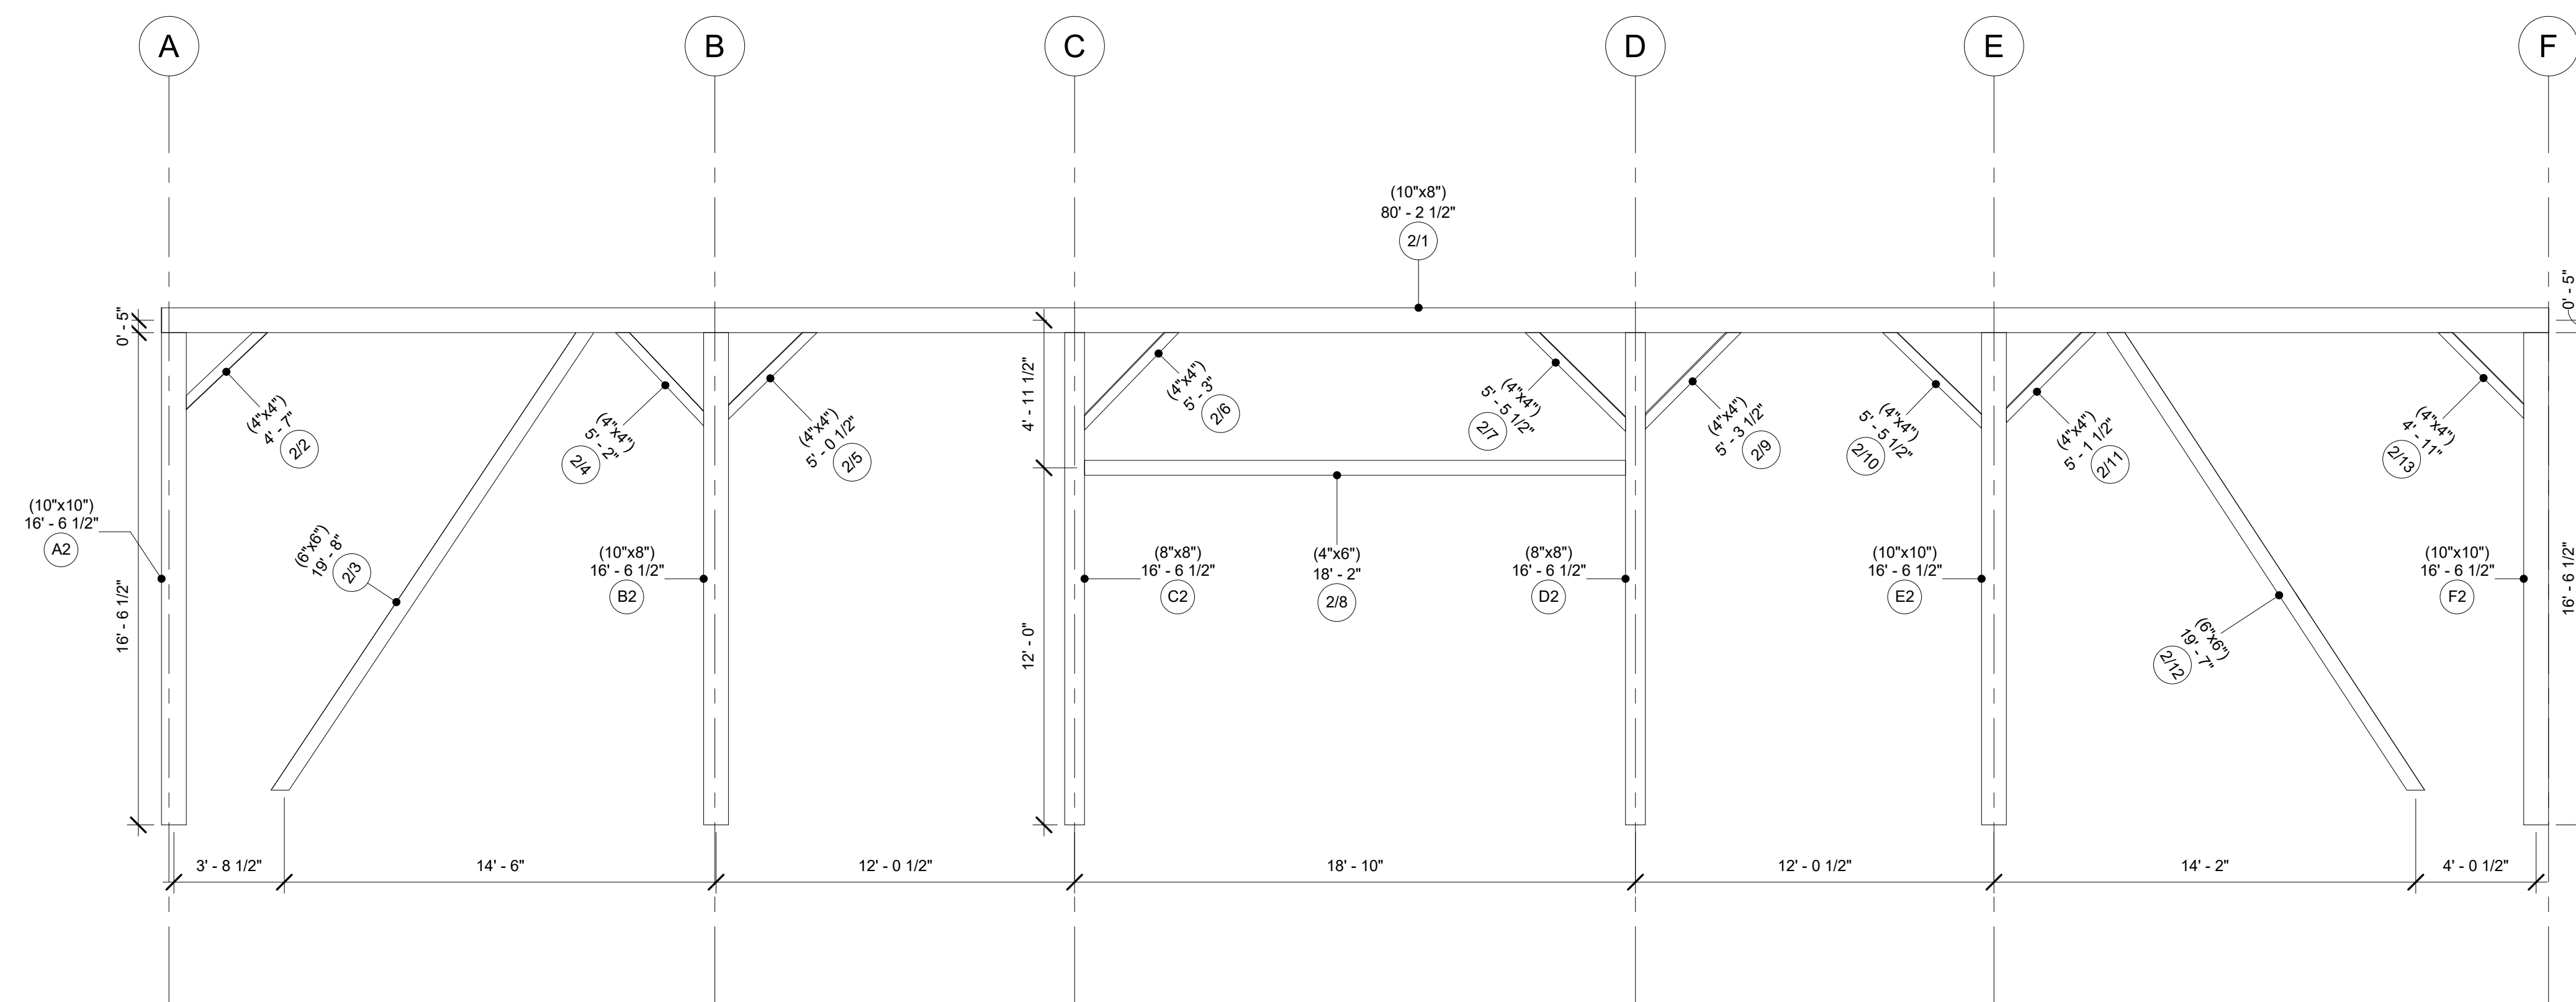

Bent 2

Project Number Project 4

Date 20240821

Drawn By

Checked By

A110


Scale 1/4" = 1'-0"

Timber Home Services LLC

80 Old Gate Road,
Penn Run PA, 15765

DAN TRIMBLE
AA66 / TIMBER HOME SERVICES
CELL PHONE/TEXT - 412-309-1161

EMAIL:
DANTRIMBLE@TIMBERHOMESERVICES.COM

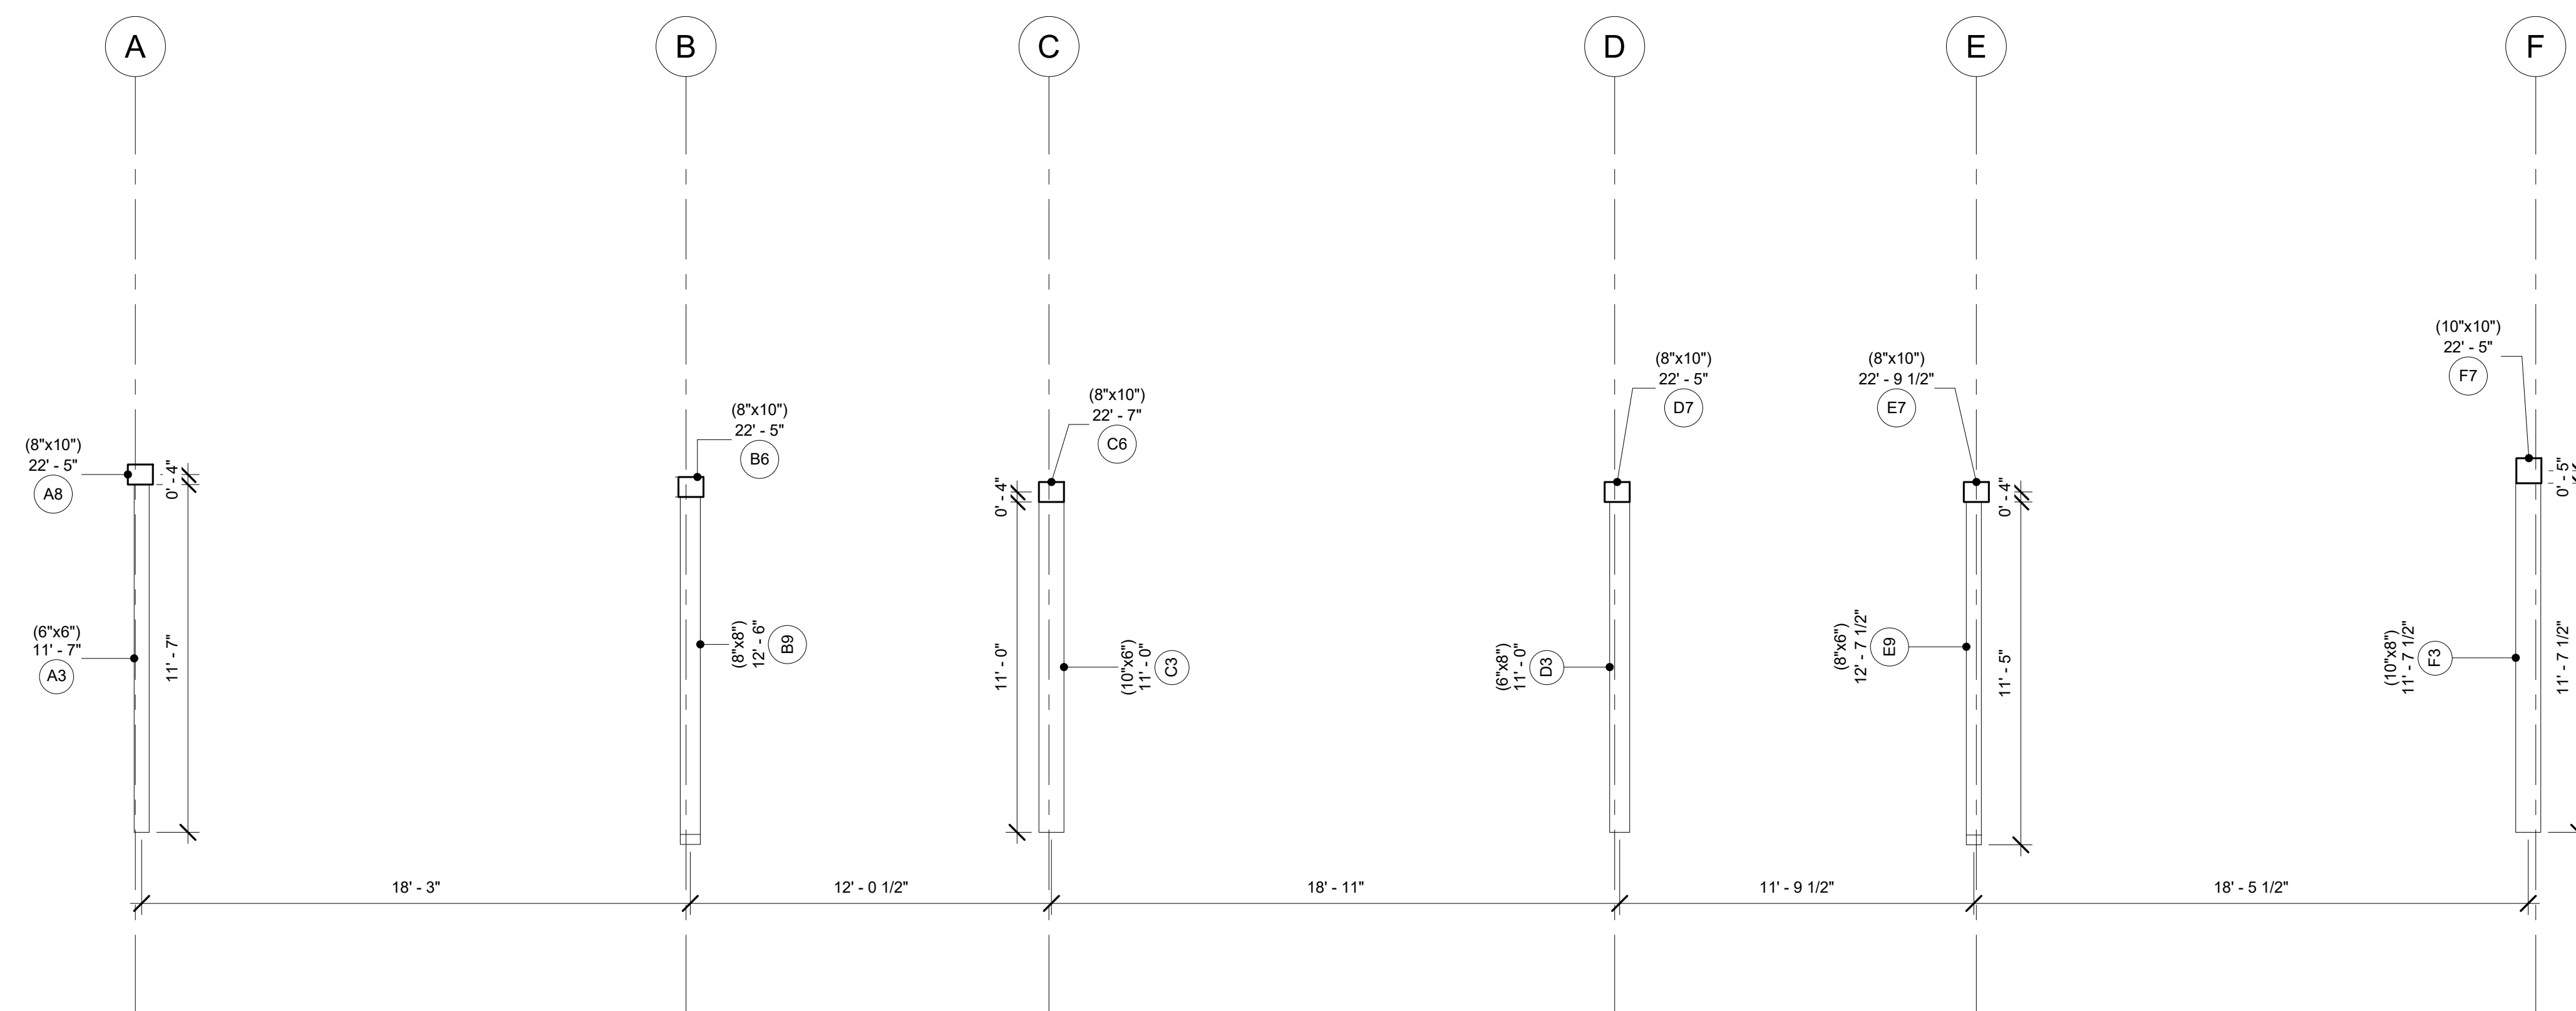

Bent 3

Project Number Project 4
Date 20240821
Drawn By
Checked By

A111


Scale 1/4" = 1'-0"

Timber Home Services LLC

80 Old Gate Road,
Penn Run PA, 15765

DAN TRIMBLE
AA66 / TIMBER HOME SERVICES
CELL PHONE/TEXT - 412-309-1161

EMAIL:
DANTRIMBLE@TIMBERHOMESERVICES.COM

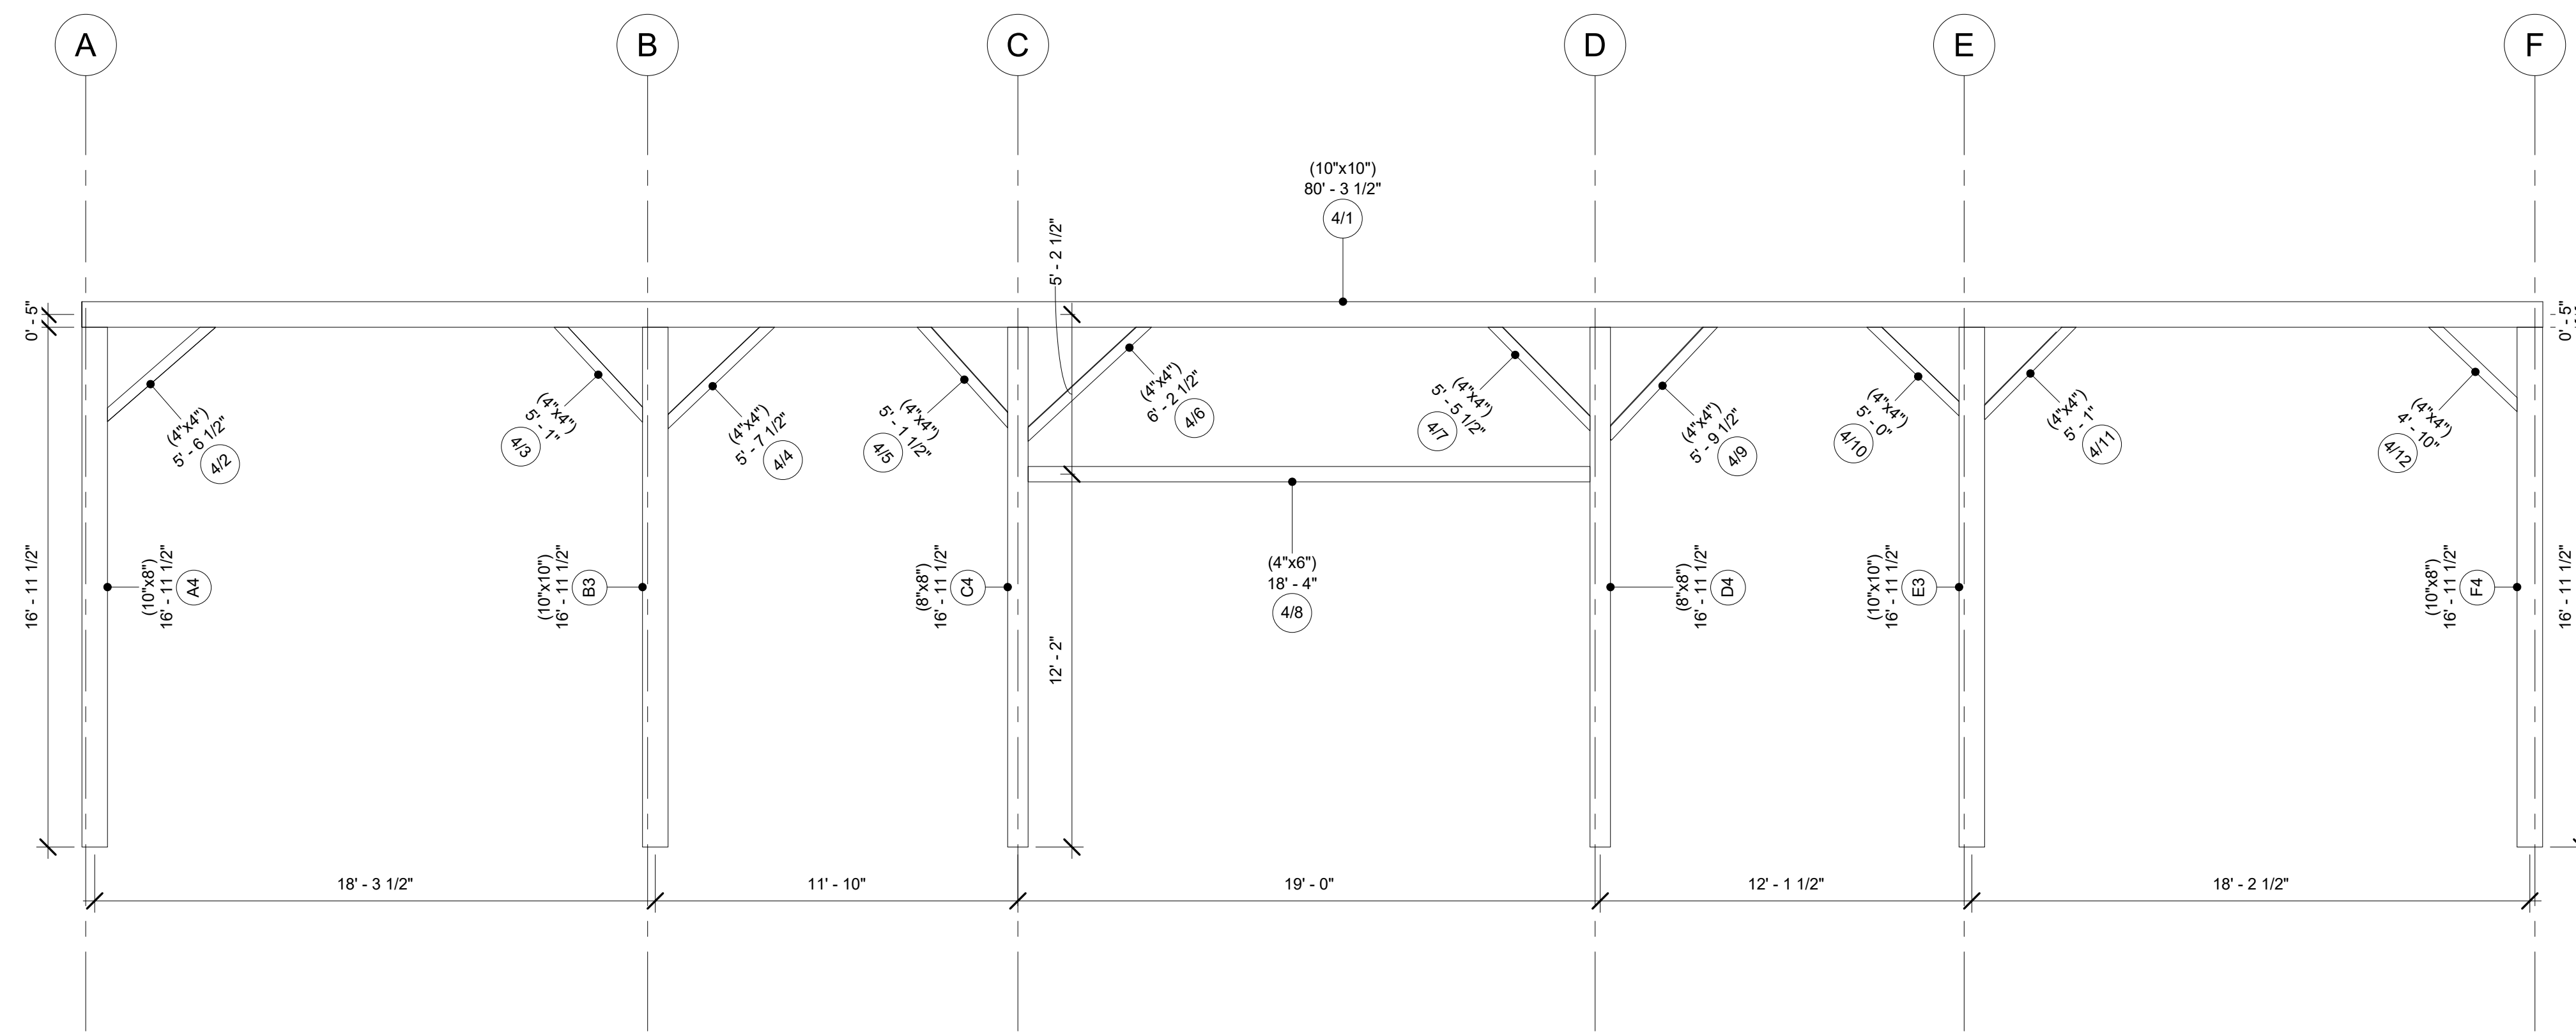

Bent 4

Project Number	Project 4
Date	20240821
Drawn By	
Checked By	

A112


Scale 1/4" = 1'-0"

Timber Home Services LLC

80 Old Gate Road,
Penn Run PA, 15765

DAN TRIMBLE
AA66 / TIMBER HOME SERVICES
CELL PHONE/TEXT - 412-309-1161

EMAIL:
DANTRIMBLE@TIMBERHOMESERVICES.COM

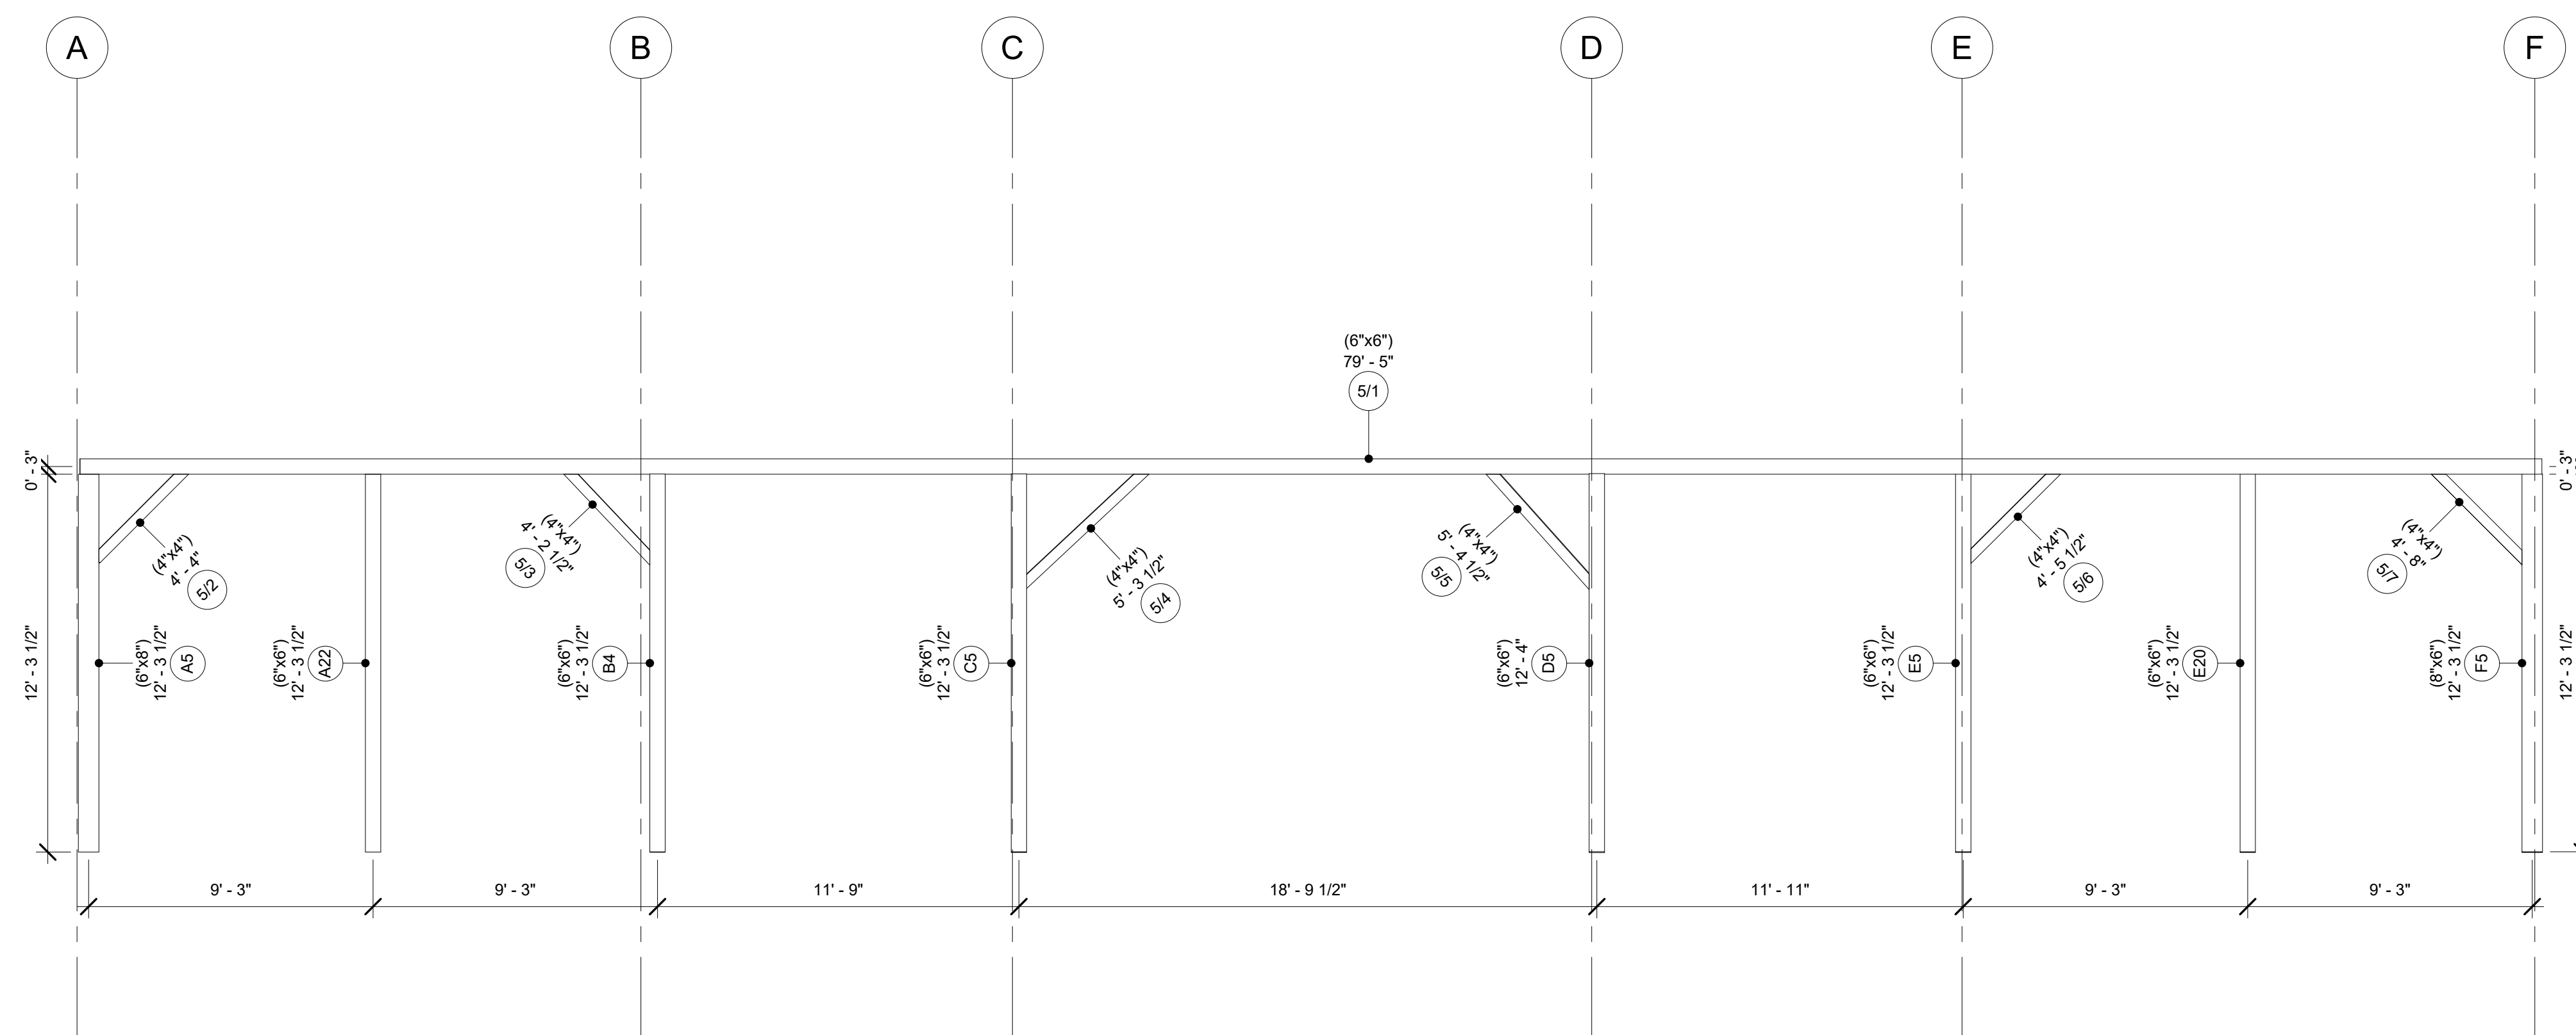

Bent 5

Project Number	Project 4
Date	20240821
Drawn By	
Checked By	

A113

Scale 1/4" = 1'-0"

Timber Home Services LLC


80 Old Gate Road,
Penn Run PA, 15765

DAN TRIMBLE
AA66 / TIMBER HOME SERVICES

CELL PHONE/TEXT - 412-309-1161

EMAIL:

DANTRIMBLE@TIMBERHOMESERVICES.COM

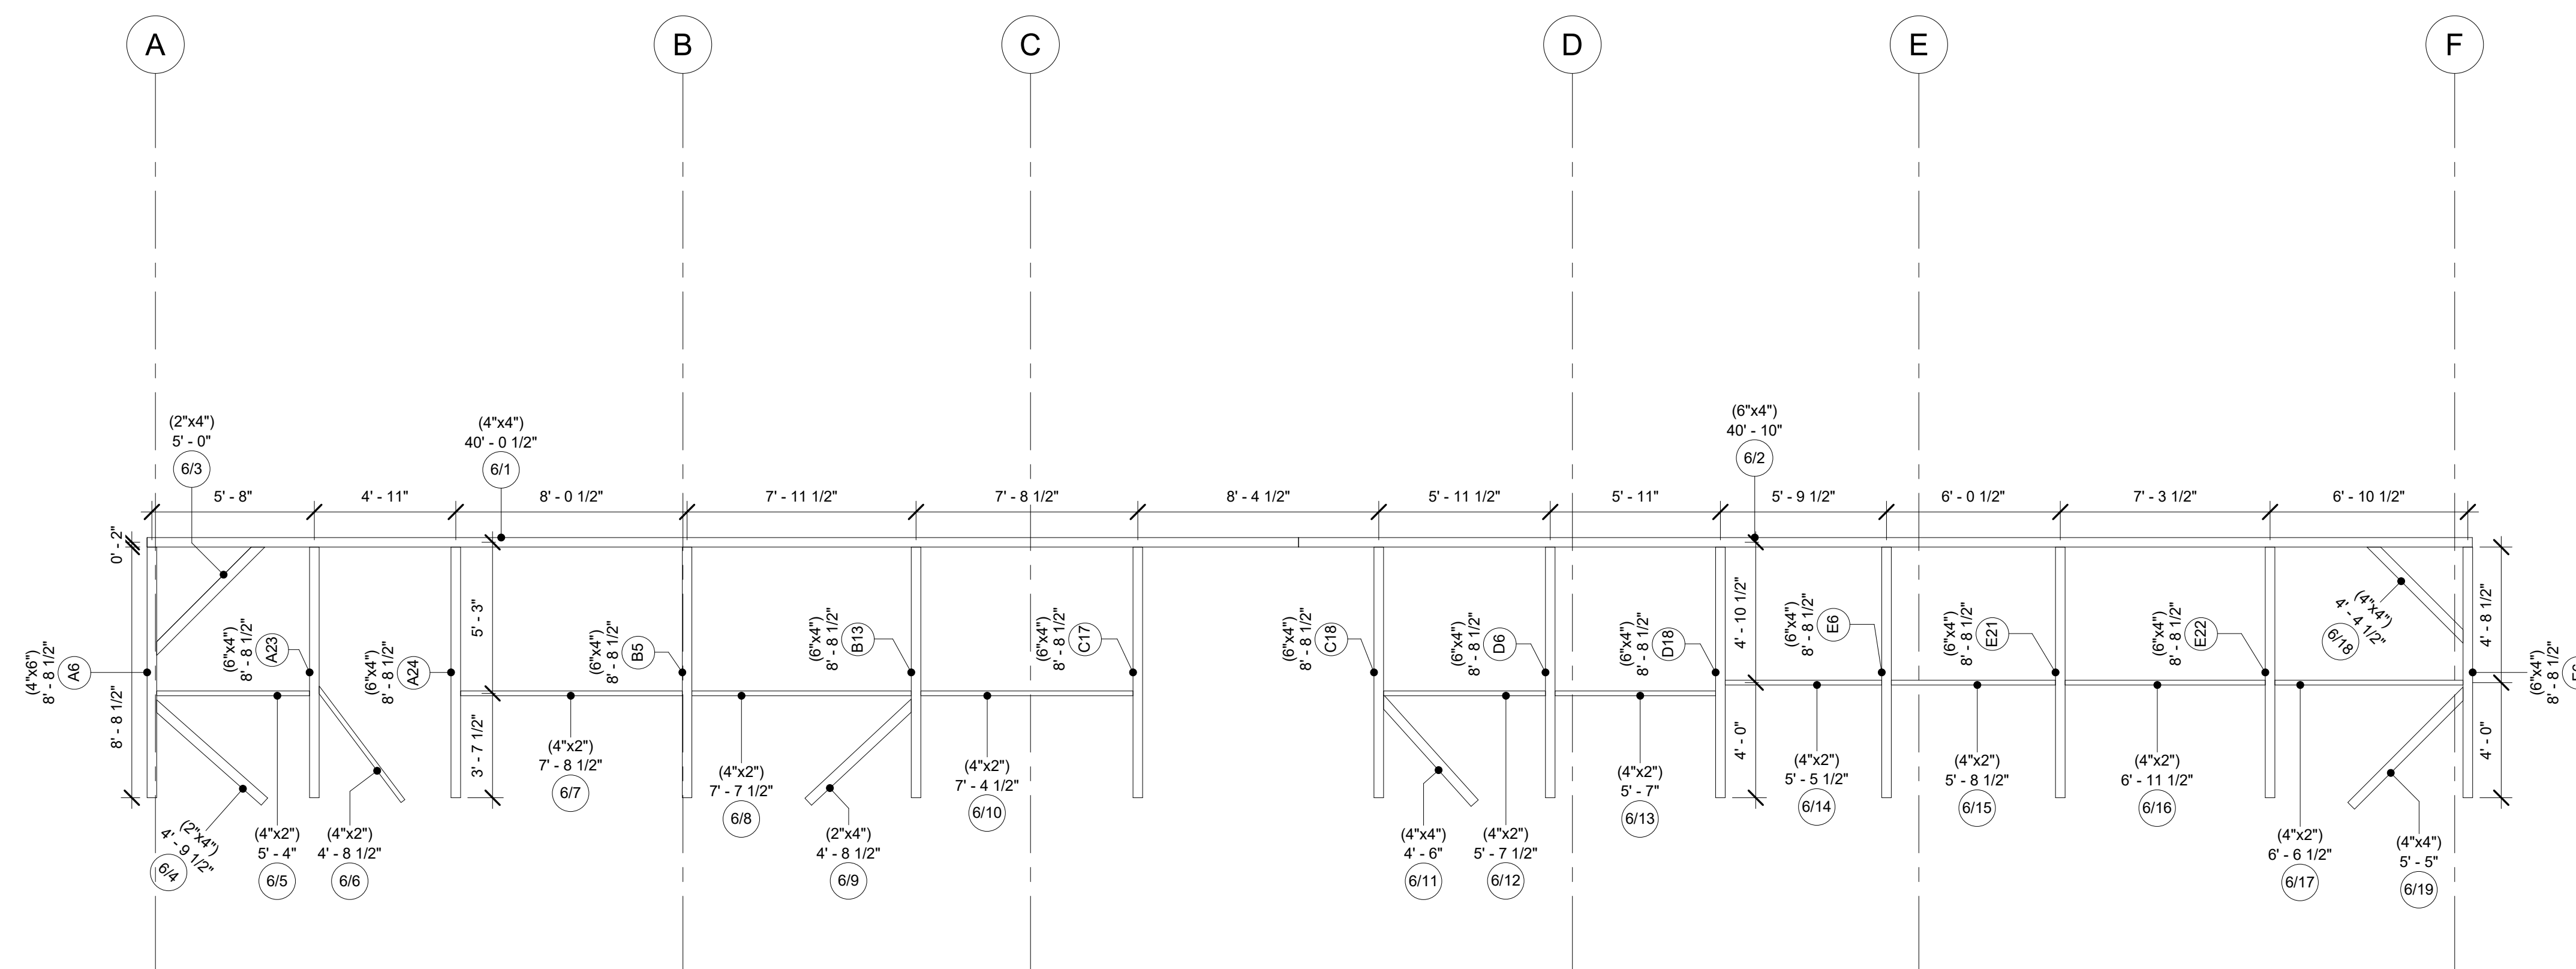

Bent 6

Project Number Project 4

Date 20240821

Drawn By

Checked By

A114


Scale 1/4" = 1'-0"

Timber Home Services LLC

80 Old Gate Road,
Penn Run PA, 15765

DAN TRIMBLE
AA66 / TIMBER HOME SERVICES
CELL PHONE/TEXT - 412-309-1161

EMAIL:
DANTRIMBLE@TIMBERHOMESERVICES.COM

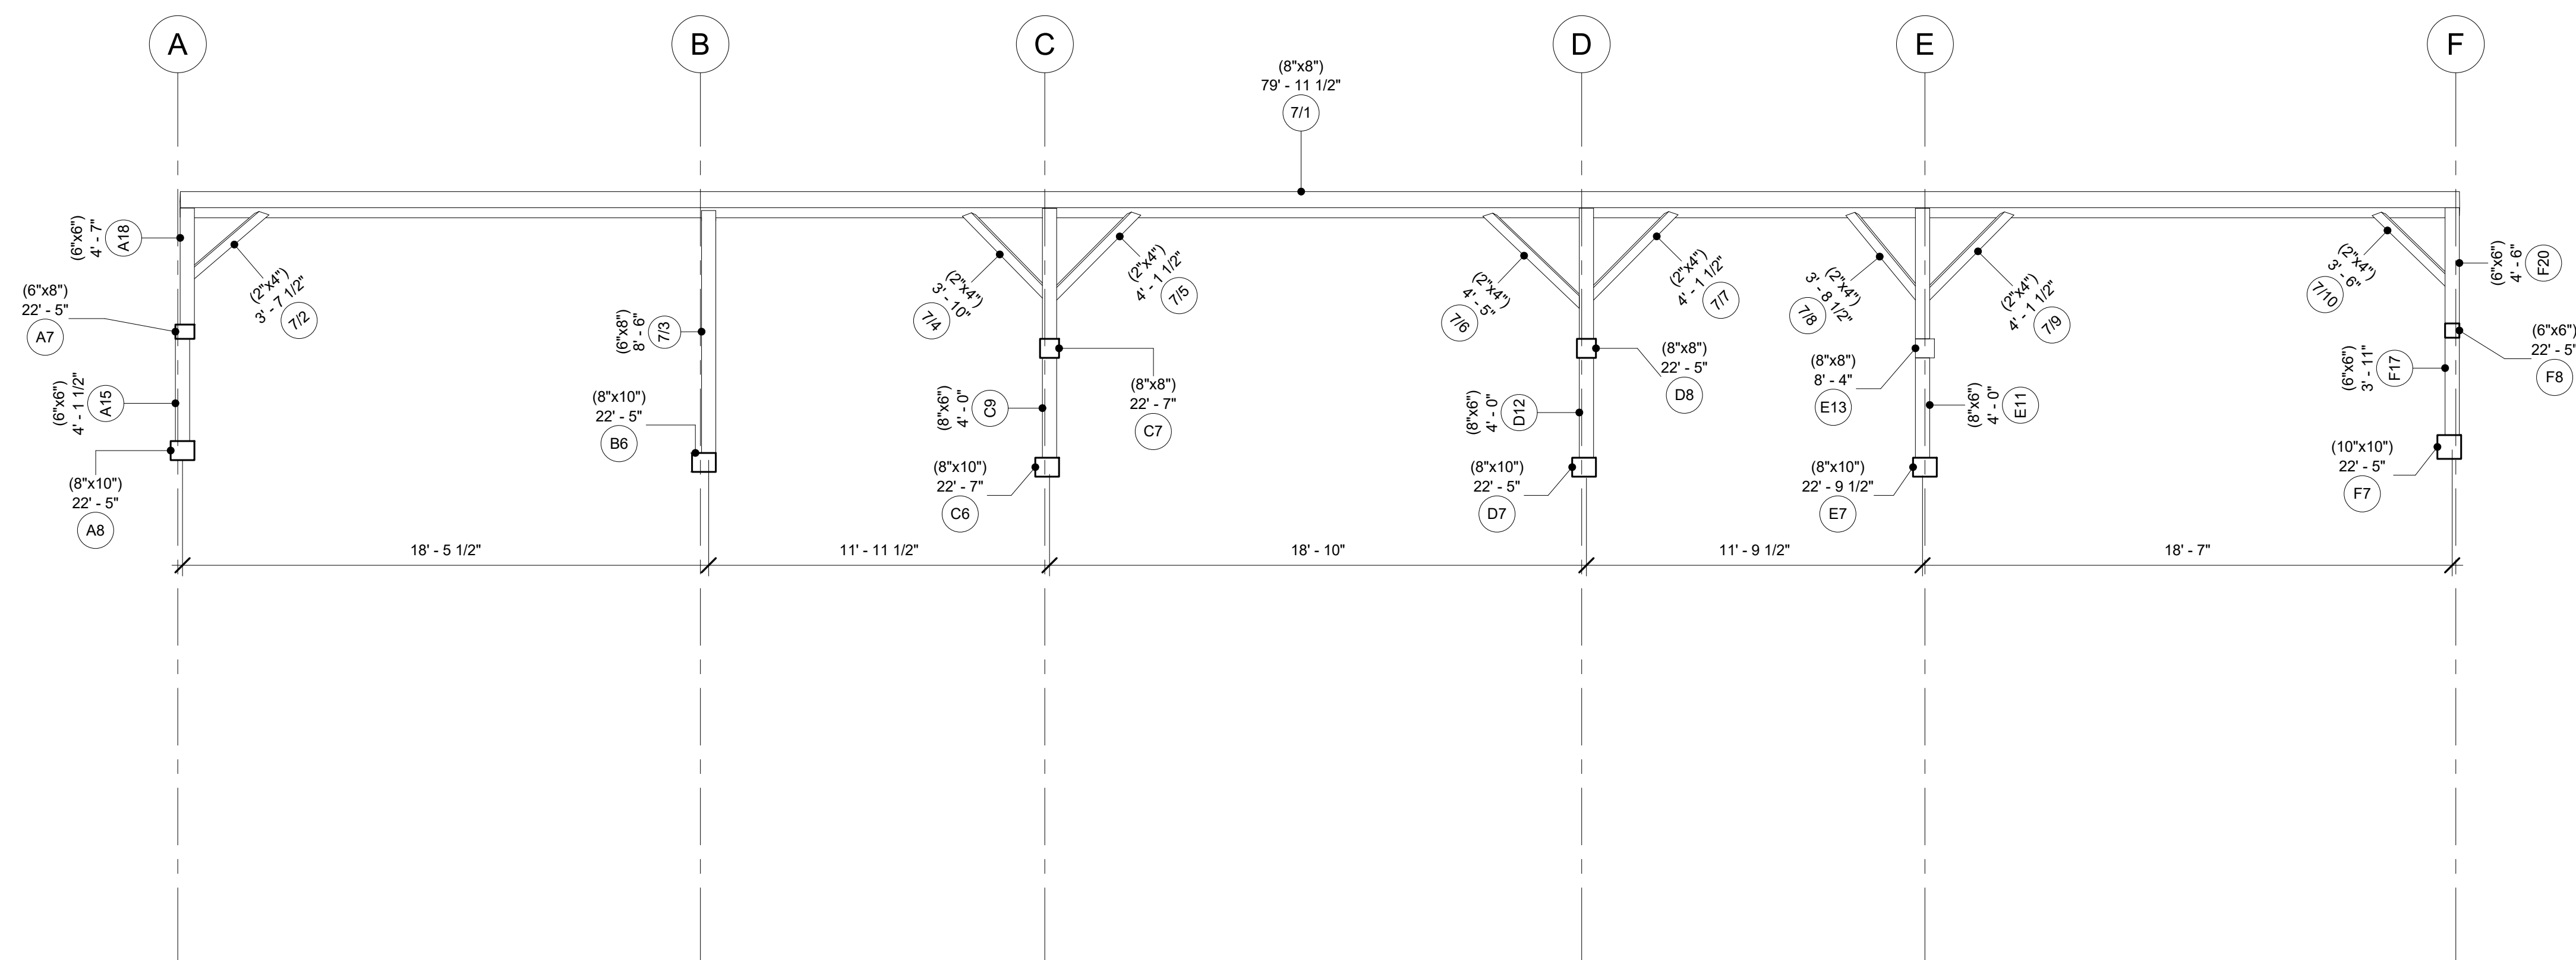

Bent 7

Project Number Project 4
Date 20240821
Drawn By
Checked By

A115


Scale 1/4" = 1'-0"

Timber Home Services LLC

80 Old Gate Road,
Penn Run PA, 15765

DAN TRIMBLE
AA66 / TIMBER HOME SERVICES
CELL PHONE/TEXT - 412-309-1161

EMAIL:
DANTRIMBLE@TIMBERHOMESERVICES.COM

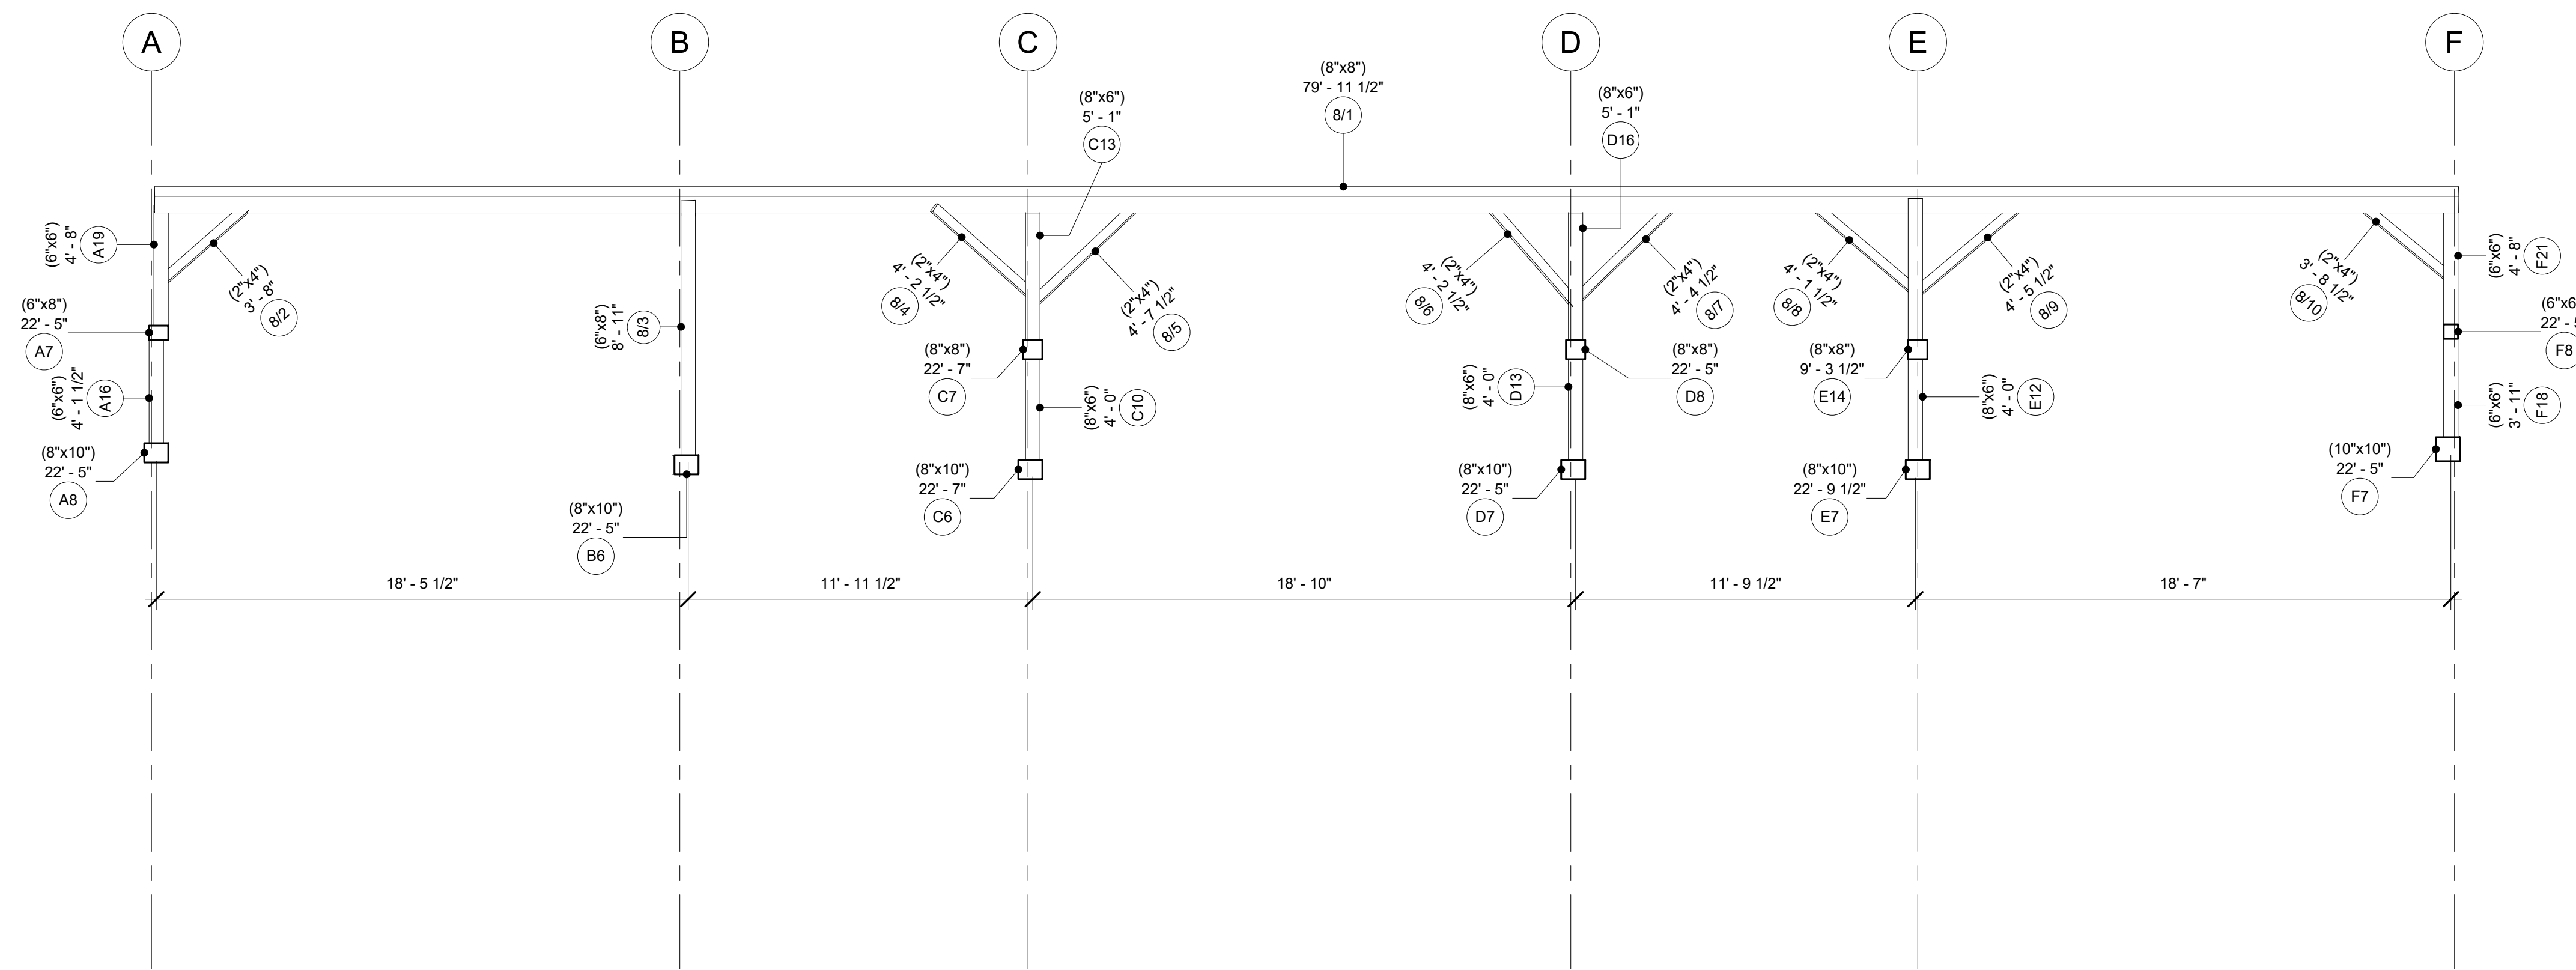

Bent 8

Project Number	Project 4
Date	20240821
Drawn By	
Checked By	

A116

Scale 1/4" = 1'-0"