


PROJECT: 118 Brandywine  
SCOPE: AS BUILT DRAWINGS

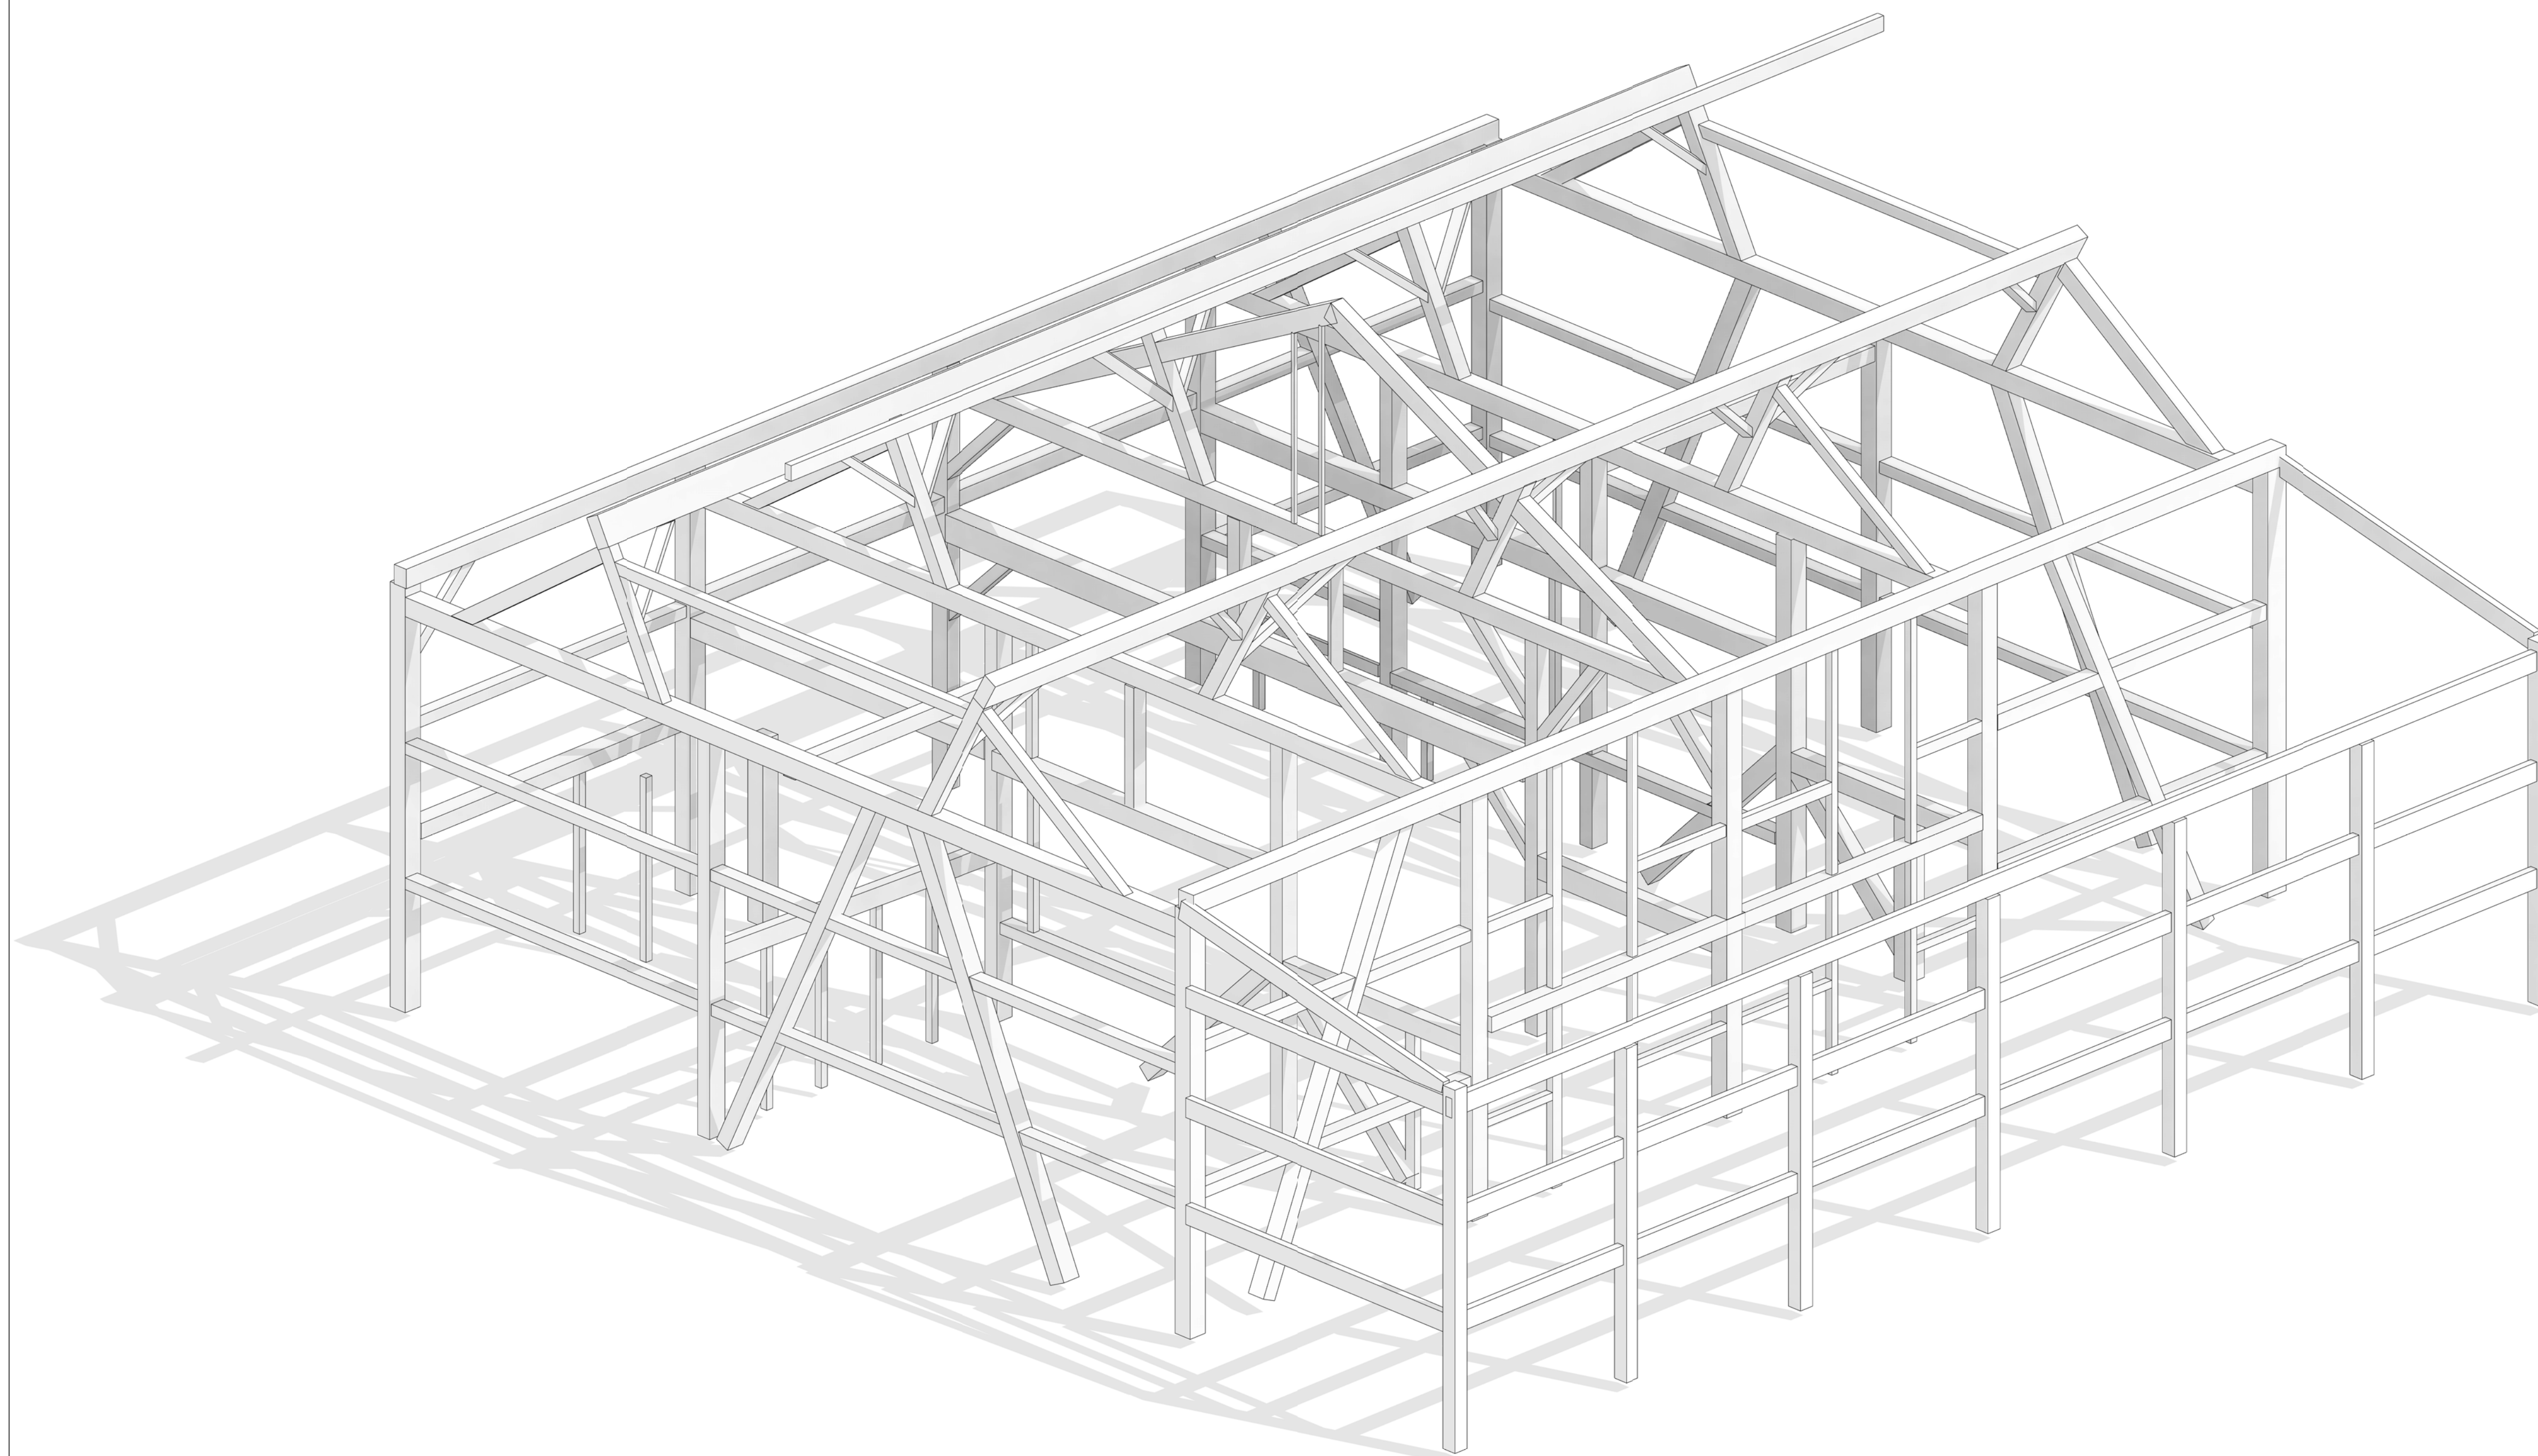

**Timber  
Home  
Services LLC**

80 Old Gate Road,  
Penn Run PA, 15765

**DAN TRIMBLE**  
AA66 / TIMBER HOME SERVICES

CELL PHONE/TEXT - 412-309-1161

EMAIL:

*DANTRIMBLE@TIMBERHOMESERVICES.COM*

**Cover Page**

Project Number **Project 4**

Date **20250419**

Drawn By

Checked By

**A101**

Scale

# Timber Home Services LLC

80 Old Gate Road,  
Penn Run PA, 15765

**DAN TRIMBLE**  
AA66 / TIMBER HOME SERVICES

CELL PHONE/TEXT - 412-309-1161

EMAIL:

DANTRIMBLE@TIMBERHOMESERVICES.COM

## Floor Plan

Project Number Project 4


Date 20250419

Drawn By

Checked By

# A102

Scale 1/4" = 1'-0"

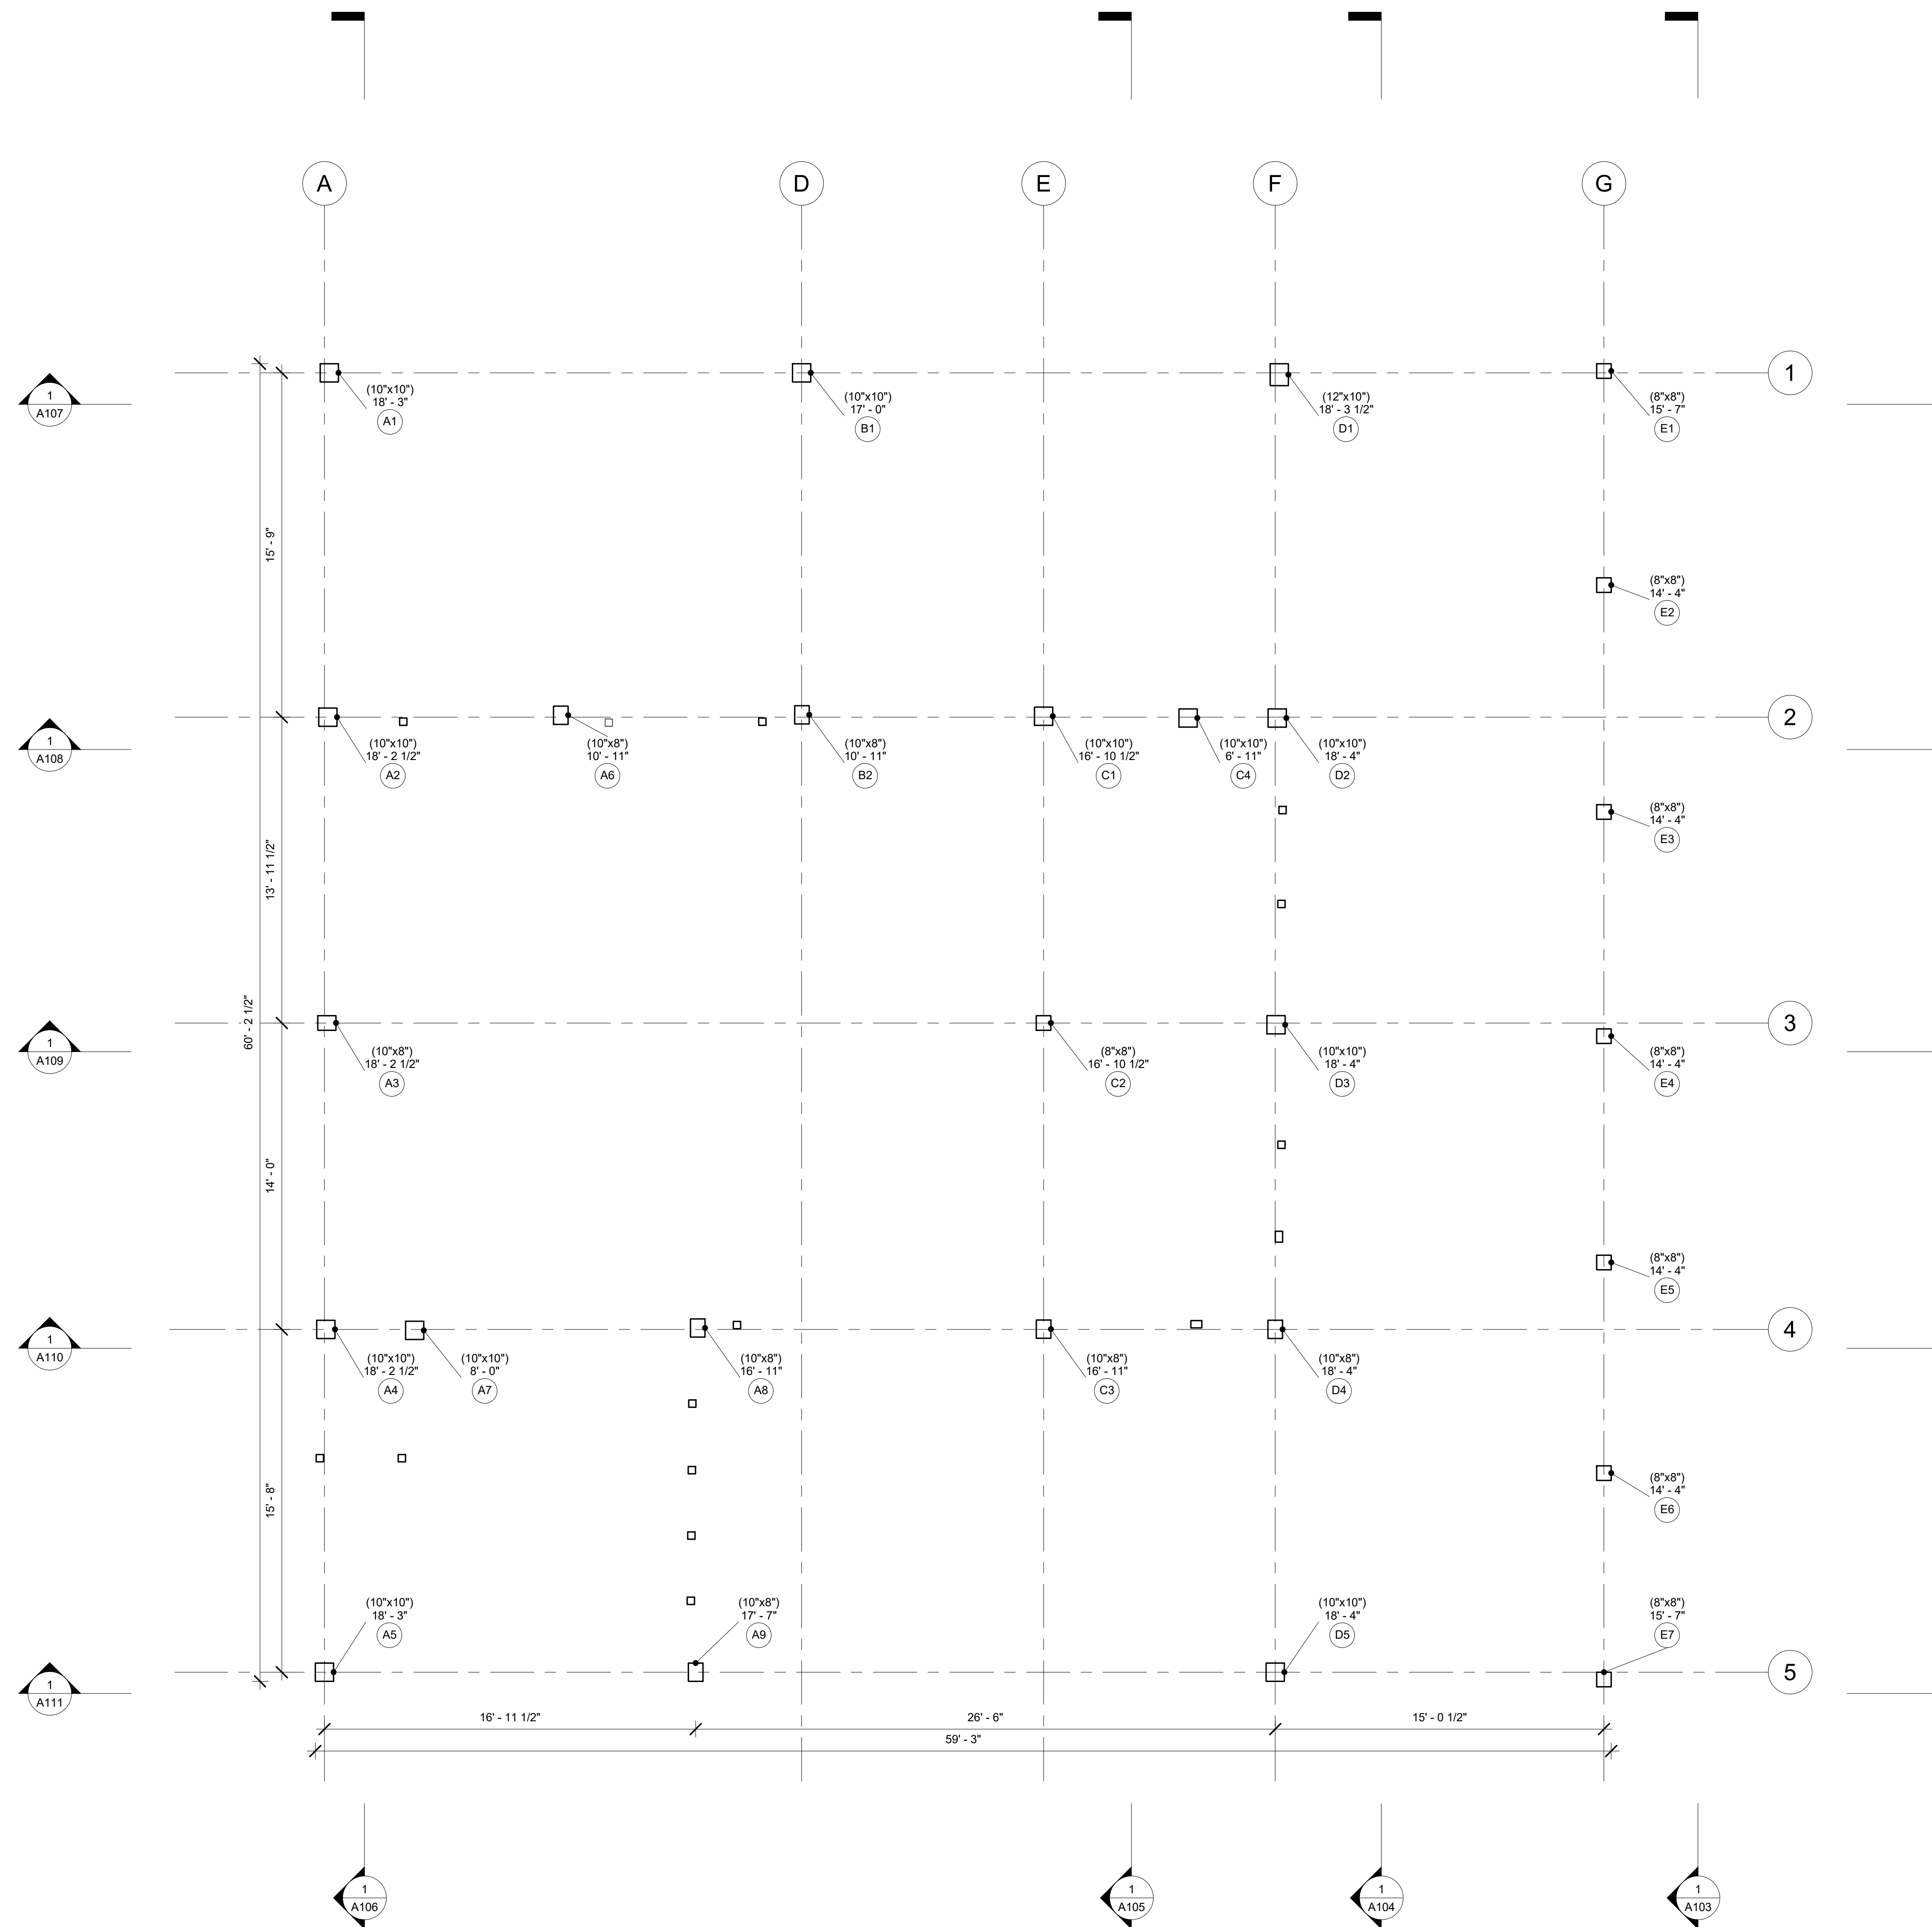


# Timber Home Services LLC

80 Old Gate Road,  
Penn Run PA, 15765

**DAN TRIMBLE**  
AA66 / TIMBER HOME SERVICES  
CELL PHONE/TEXT - 412-309-1161

EMAIL:  
DANTRIMBLE@TIMBERHOMESERVICES.COM

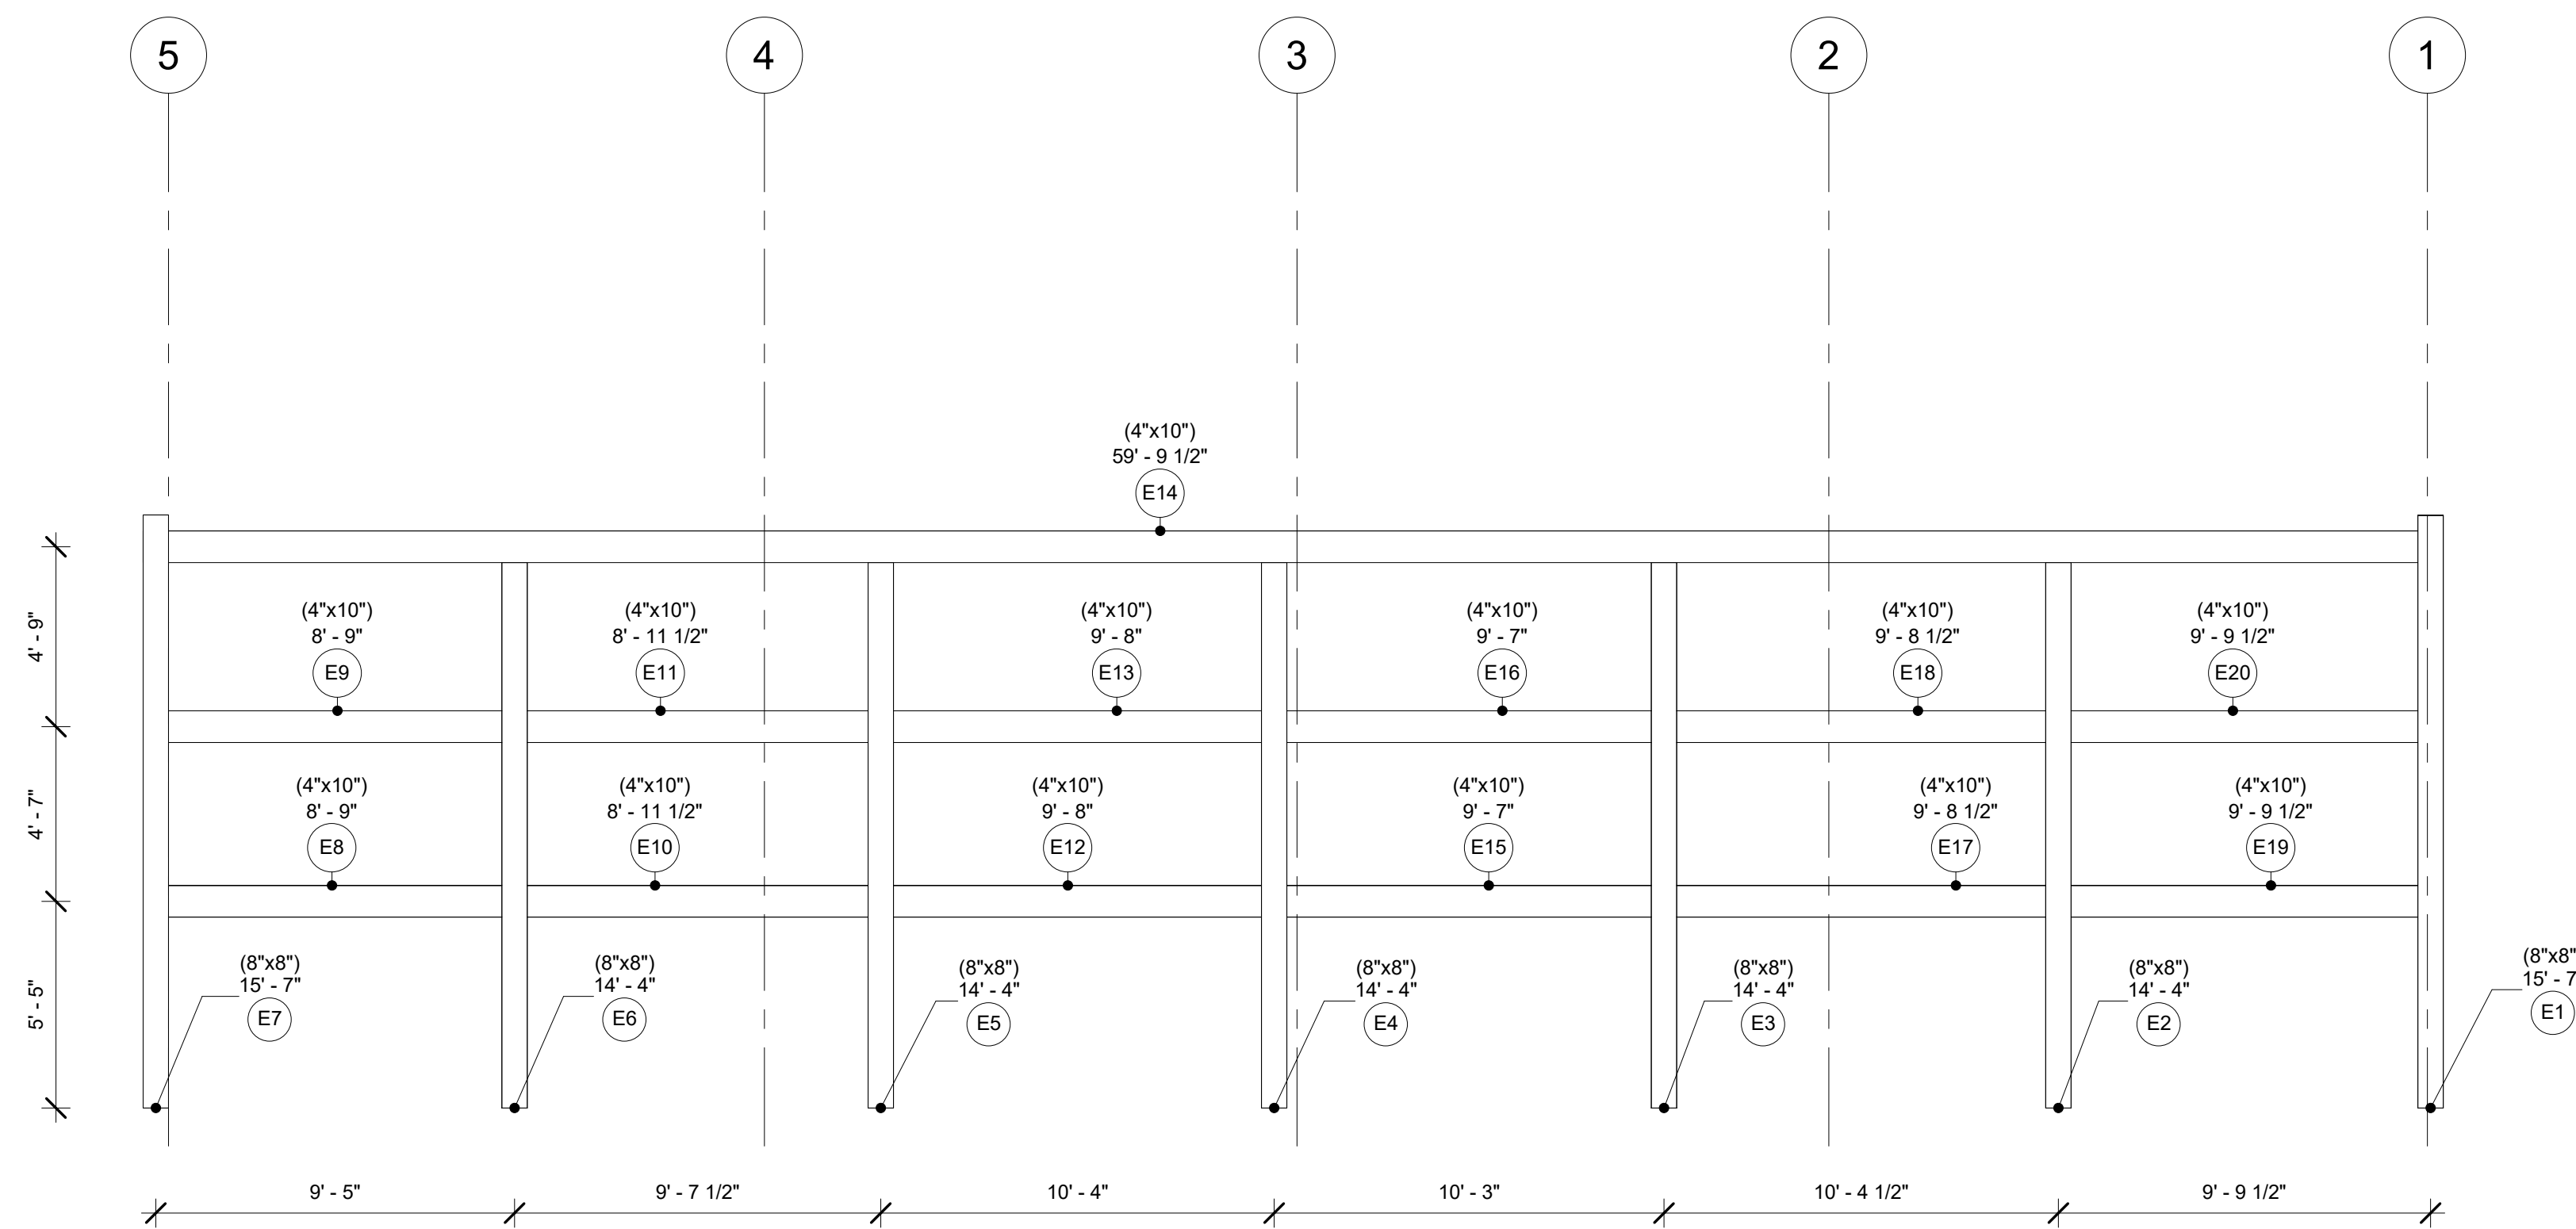

## Bent E

Project Number	Project 4
Date	20250419
Drawn By	
Checked By	

# A103


Scale 1/4" = 1'-0"

# Timber Home Services LLC

80 Old Gate Road,  
Penn Run PA, 15765

**DAN TRIMBLE**  
AA66 / TIMBER HOME SERVICES  
CELL PHONE/TEXT - 412-309-1161

EMAIL:  
DANTRIMBLE@TIMBERHOMESERVICES.COM

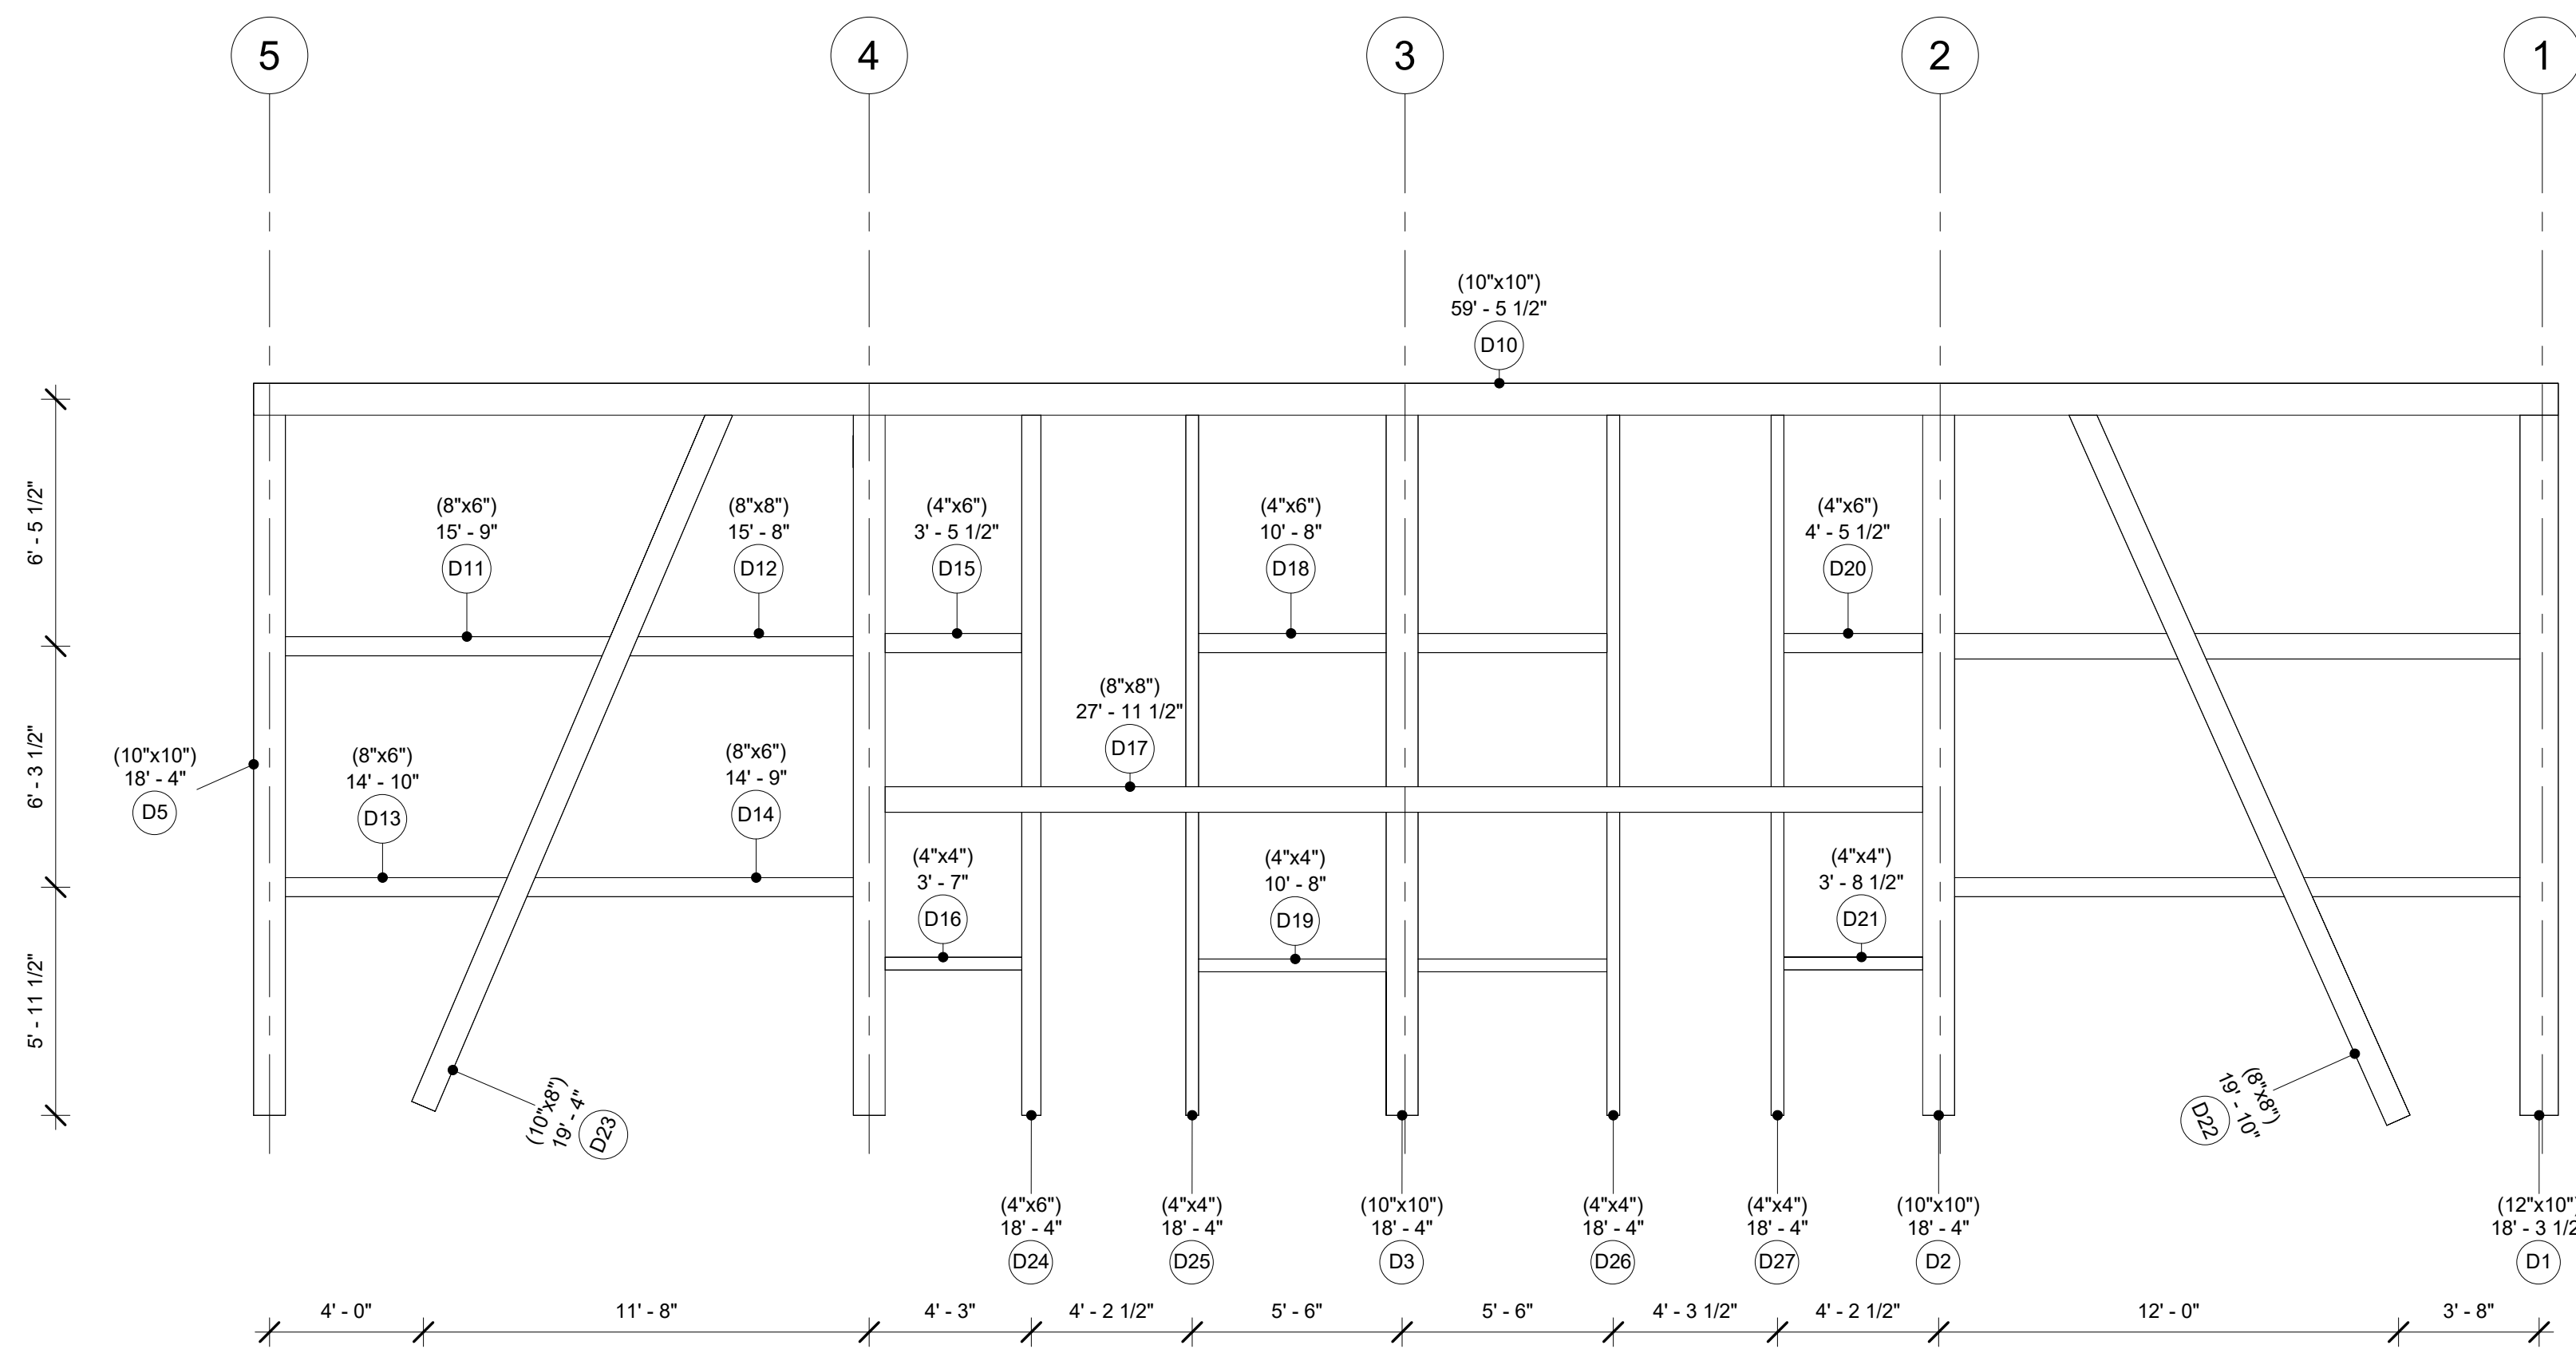

## Bent D

Project Number	Project 4
Date	20250419
Drawn By	
Checked By	

# A104


Scale 1/4" = 1'-0"

# Timber Home Services LLC

80 Old Gate Road,  
Penn Run PA, 15765

**DAN TRIMBLE**  
AA66 / TIMBER HOME SERVICES  
CELL PHONE/TEXT - 412-309-1161

EMAIL:  
DANTRIMBLE@TIMBERHOMESERVICES.COM

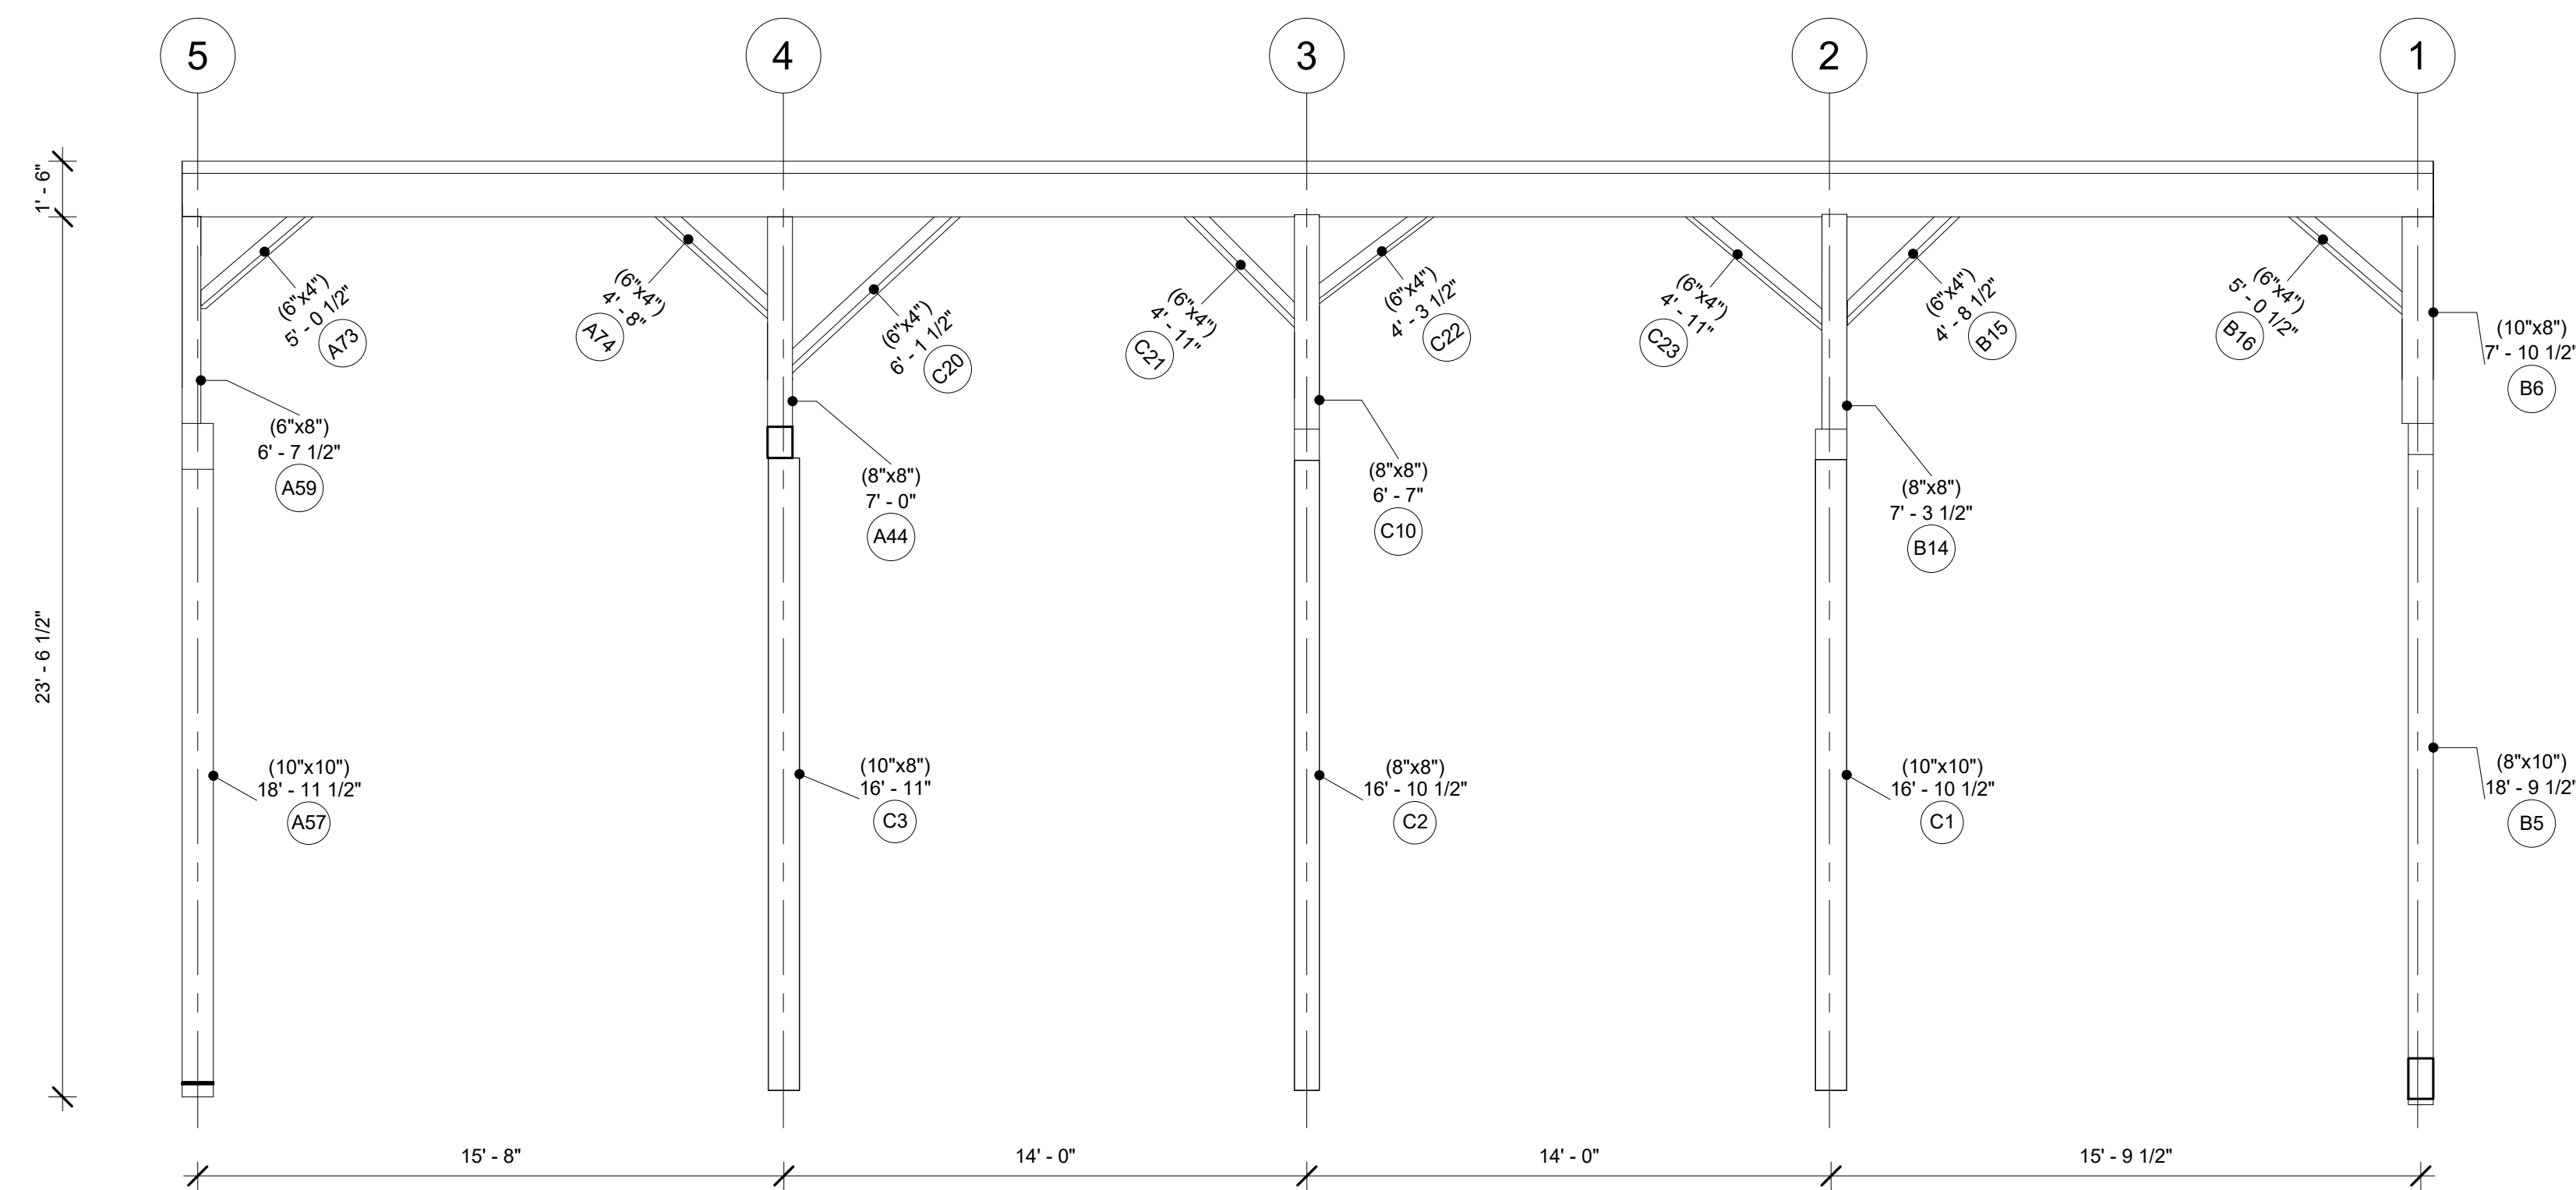

## Bent C

Project Number	Project 4
Date	20250419
Drawn By	
Checked By	

# A105


Scale 1/4" = 1'-0"

# Timber Home Services LLC

80 Old Gate Road,  
Penn Run PA, 15765

**DAN TRIMBLE**  
AA66 / TIMBER HOME SERVICES  
CELL PHONE/TEXT - 412-309-1161

EMAIL:  
DANTRIMBLE@TIMBERHOMESERVICES.COM

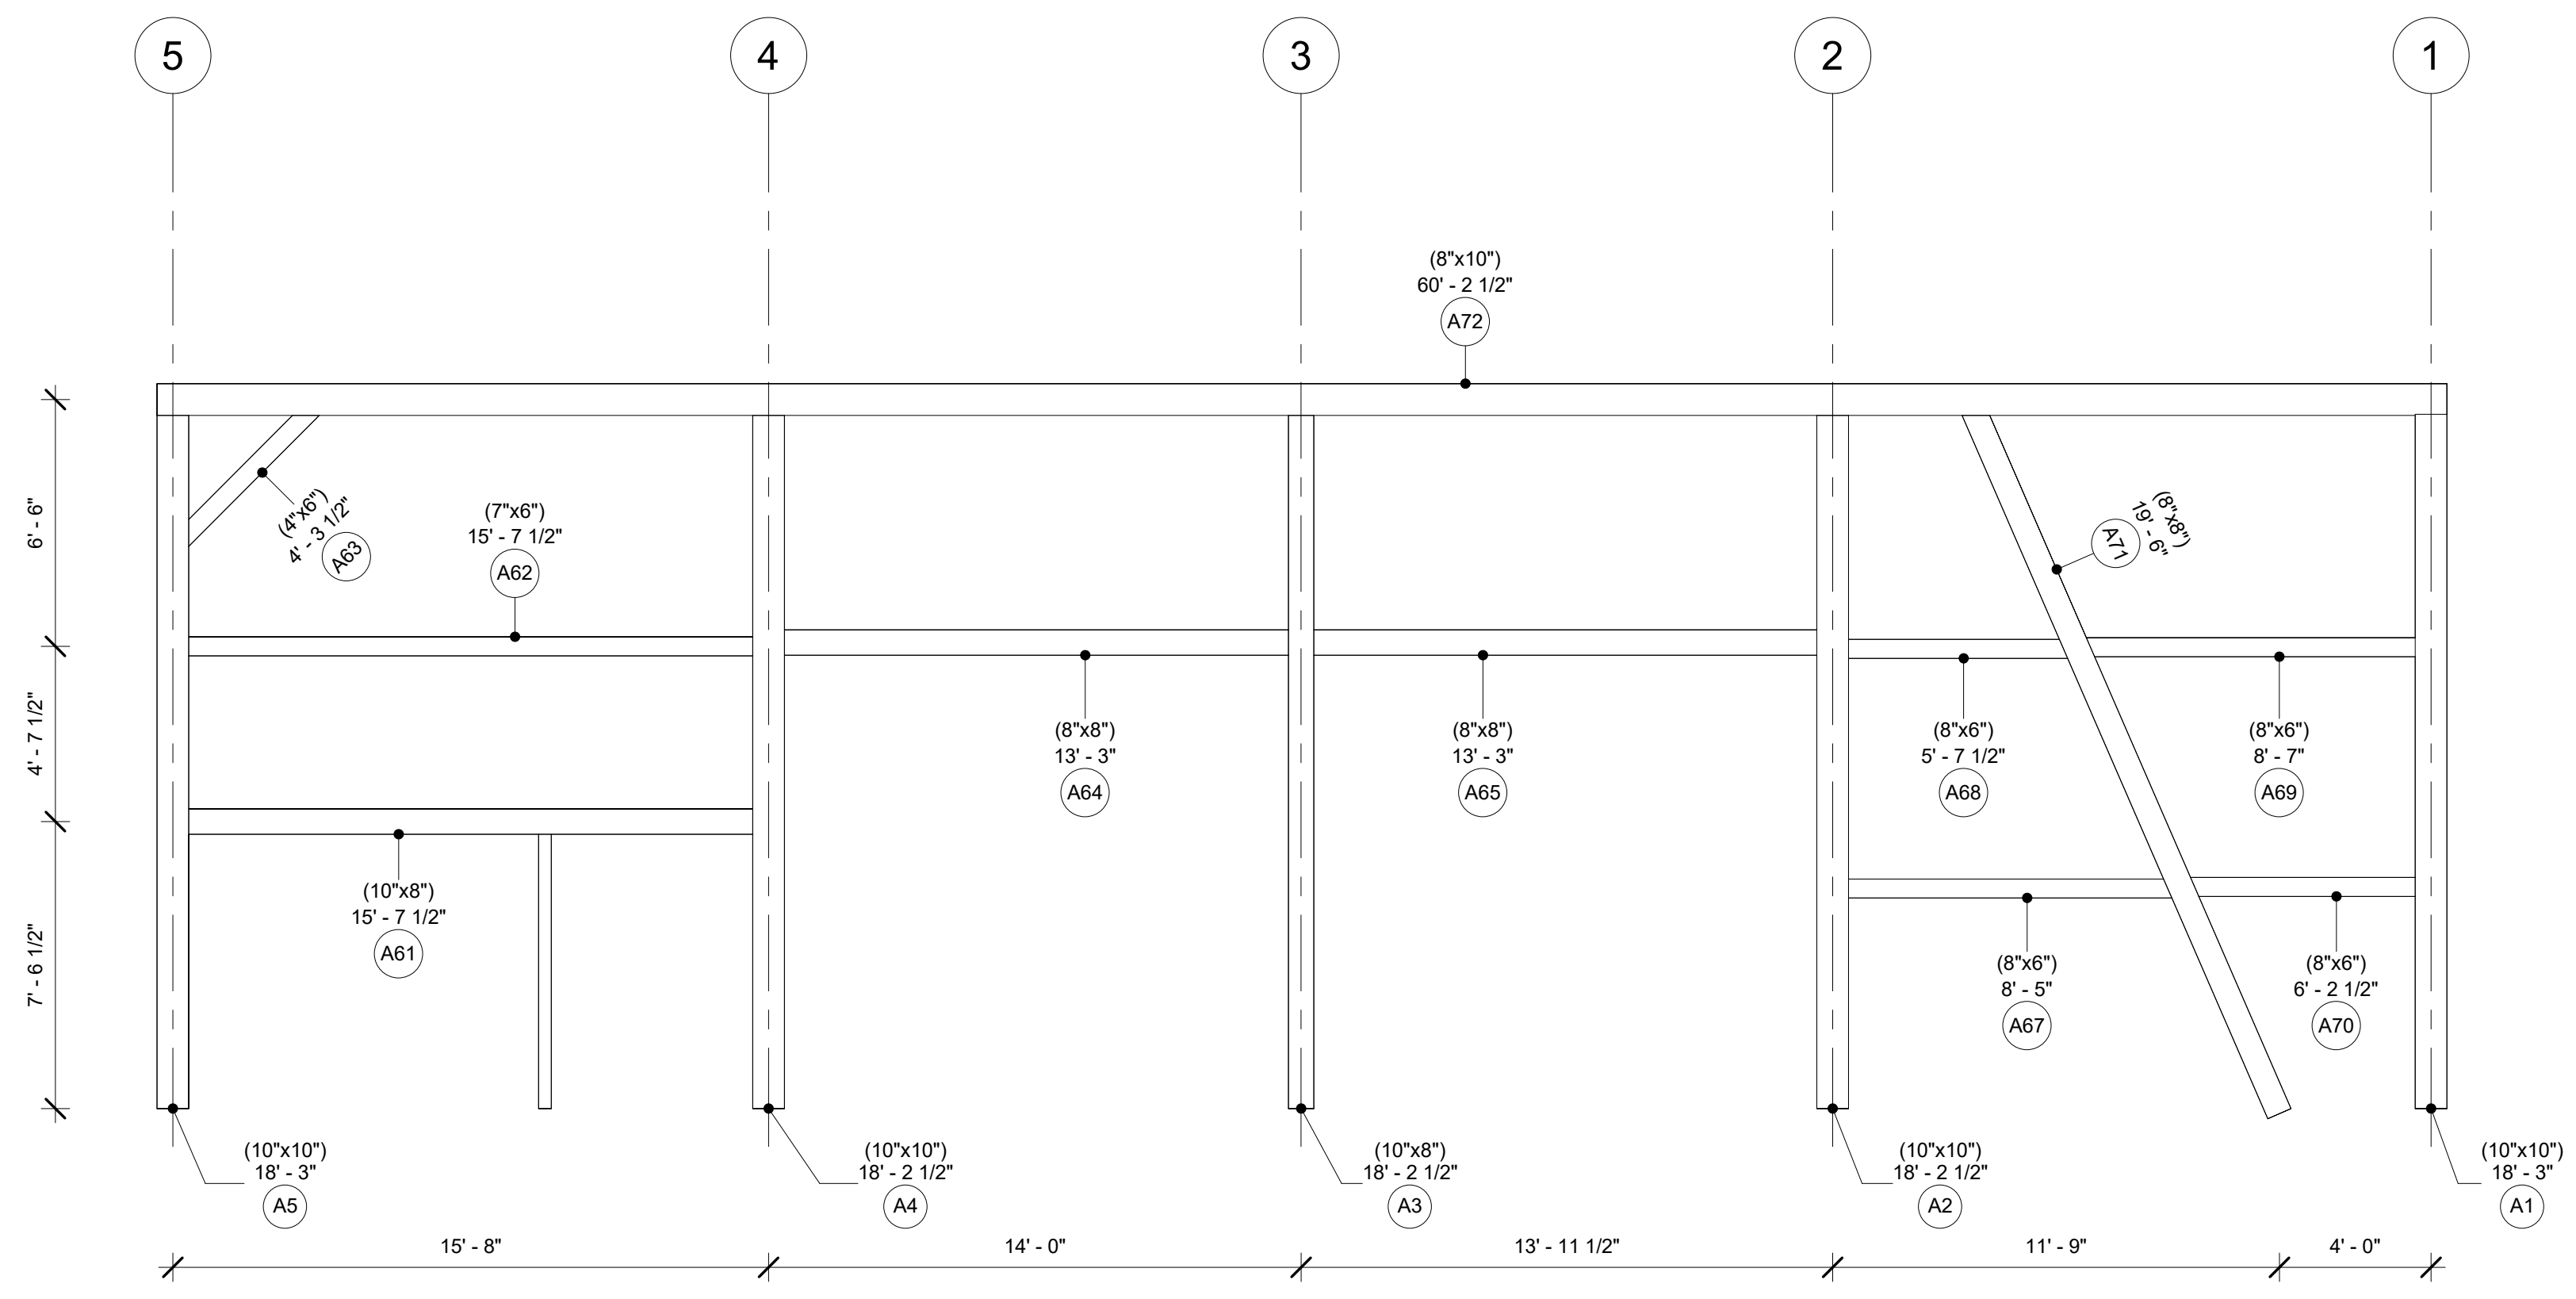

## Bent A

Project Number **Project 4**  
Date **20250419**  
Drawn By  
Checked By

# A106

Scale **1/4" = 1'-0"**

# Timber Home Services LLC


80 Old Gate Road,  
Penn Run PA, 15765

**DAN TRIMBLE**  
AA66 / TIMBER HOME SERVICES

CELL PHONE/TEXT - 412-309-1161

EMAIL:

DANTRIMBLE@TIMBERHOMESERVICES.COM

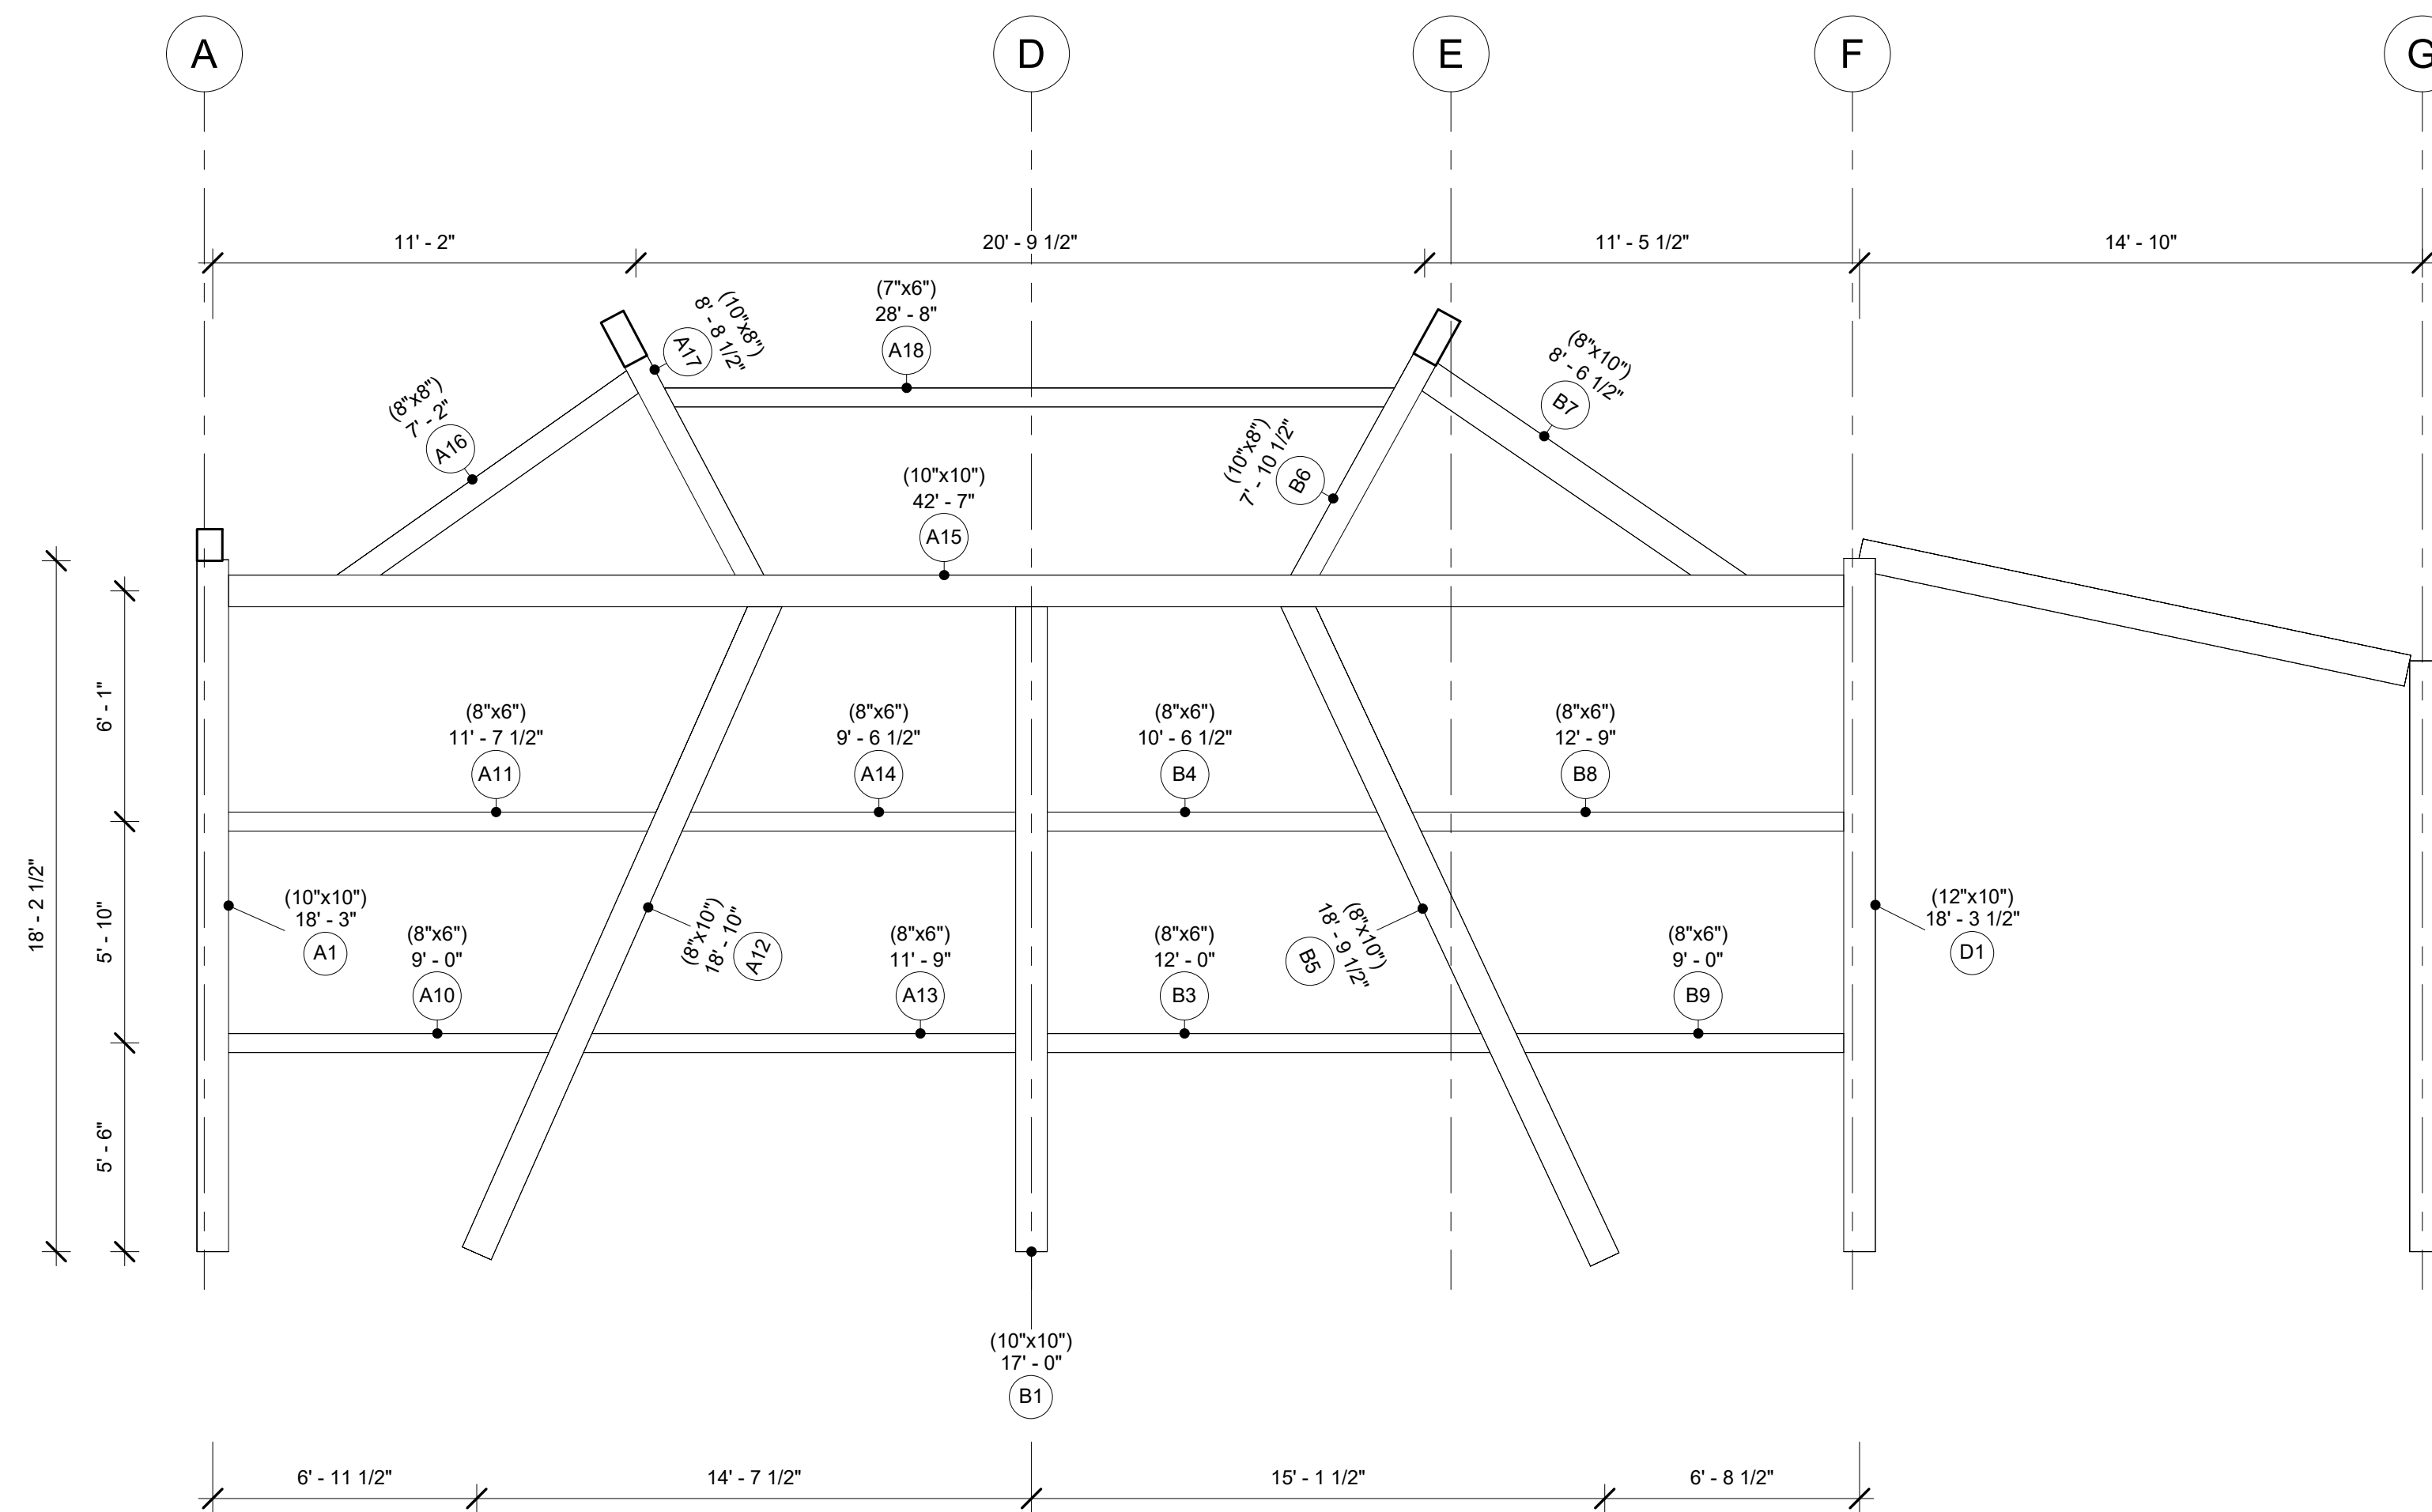

## Bent 1

Project Number Project 4

Date 20250419

Drawn By

Checked By

# A107

Scale 1/4" = 1'-0"



# Timber Home Services LLC


80 Old Gate Road,  
Penn Run PA, 15765

**DAN TRIMBLE**  
AA66 / TIMBER HOME SERVICES

CELL PHONE/TEXT - 412-309-1161

EMAIL:

DANTRIMBLE@TIMBERHOMESERVICES.COM

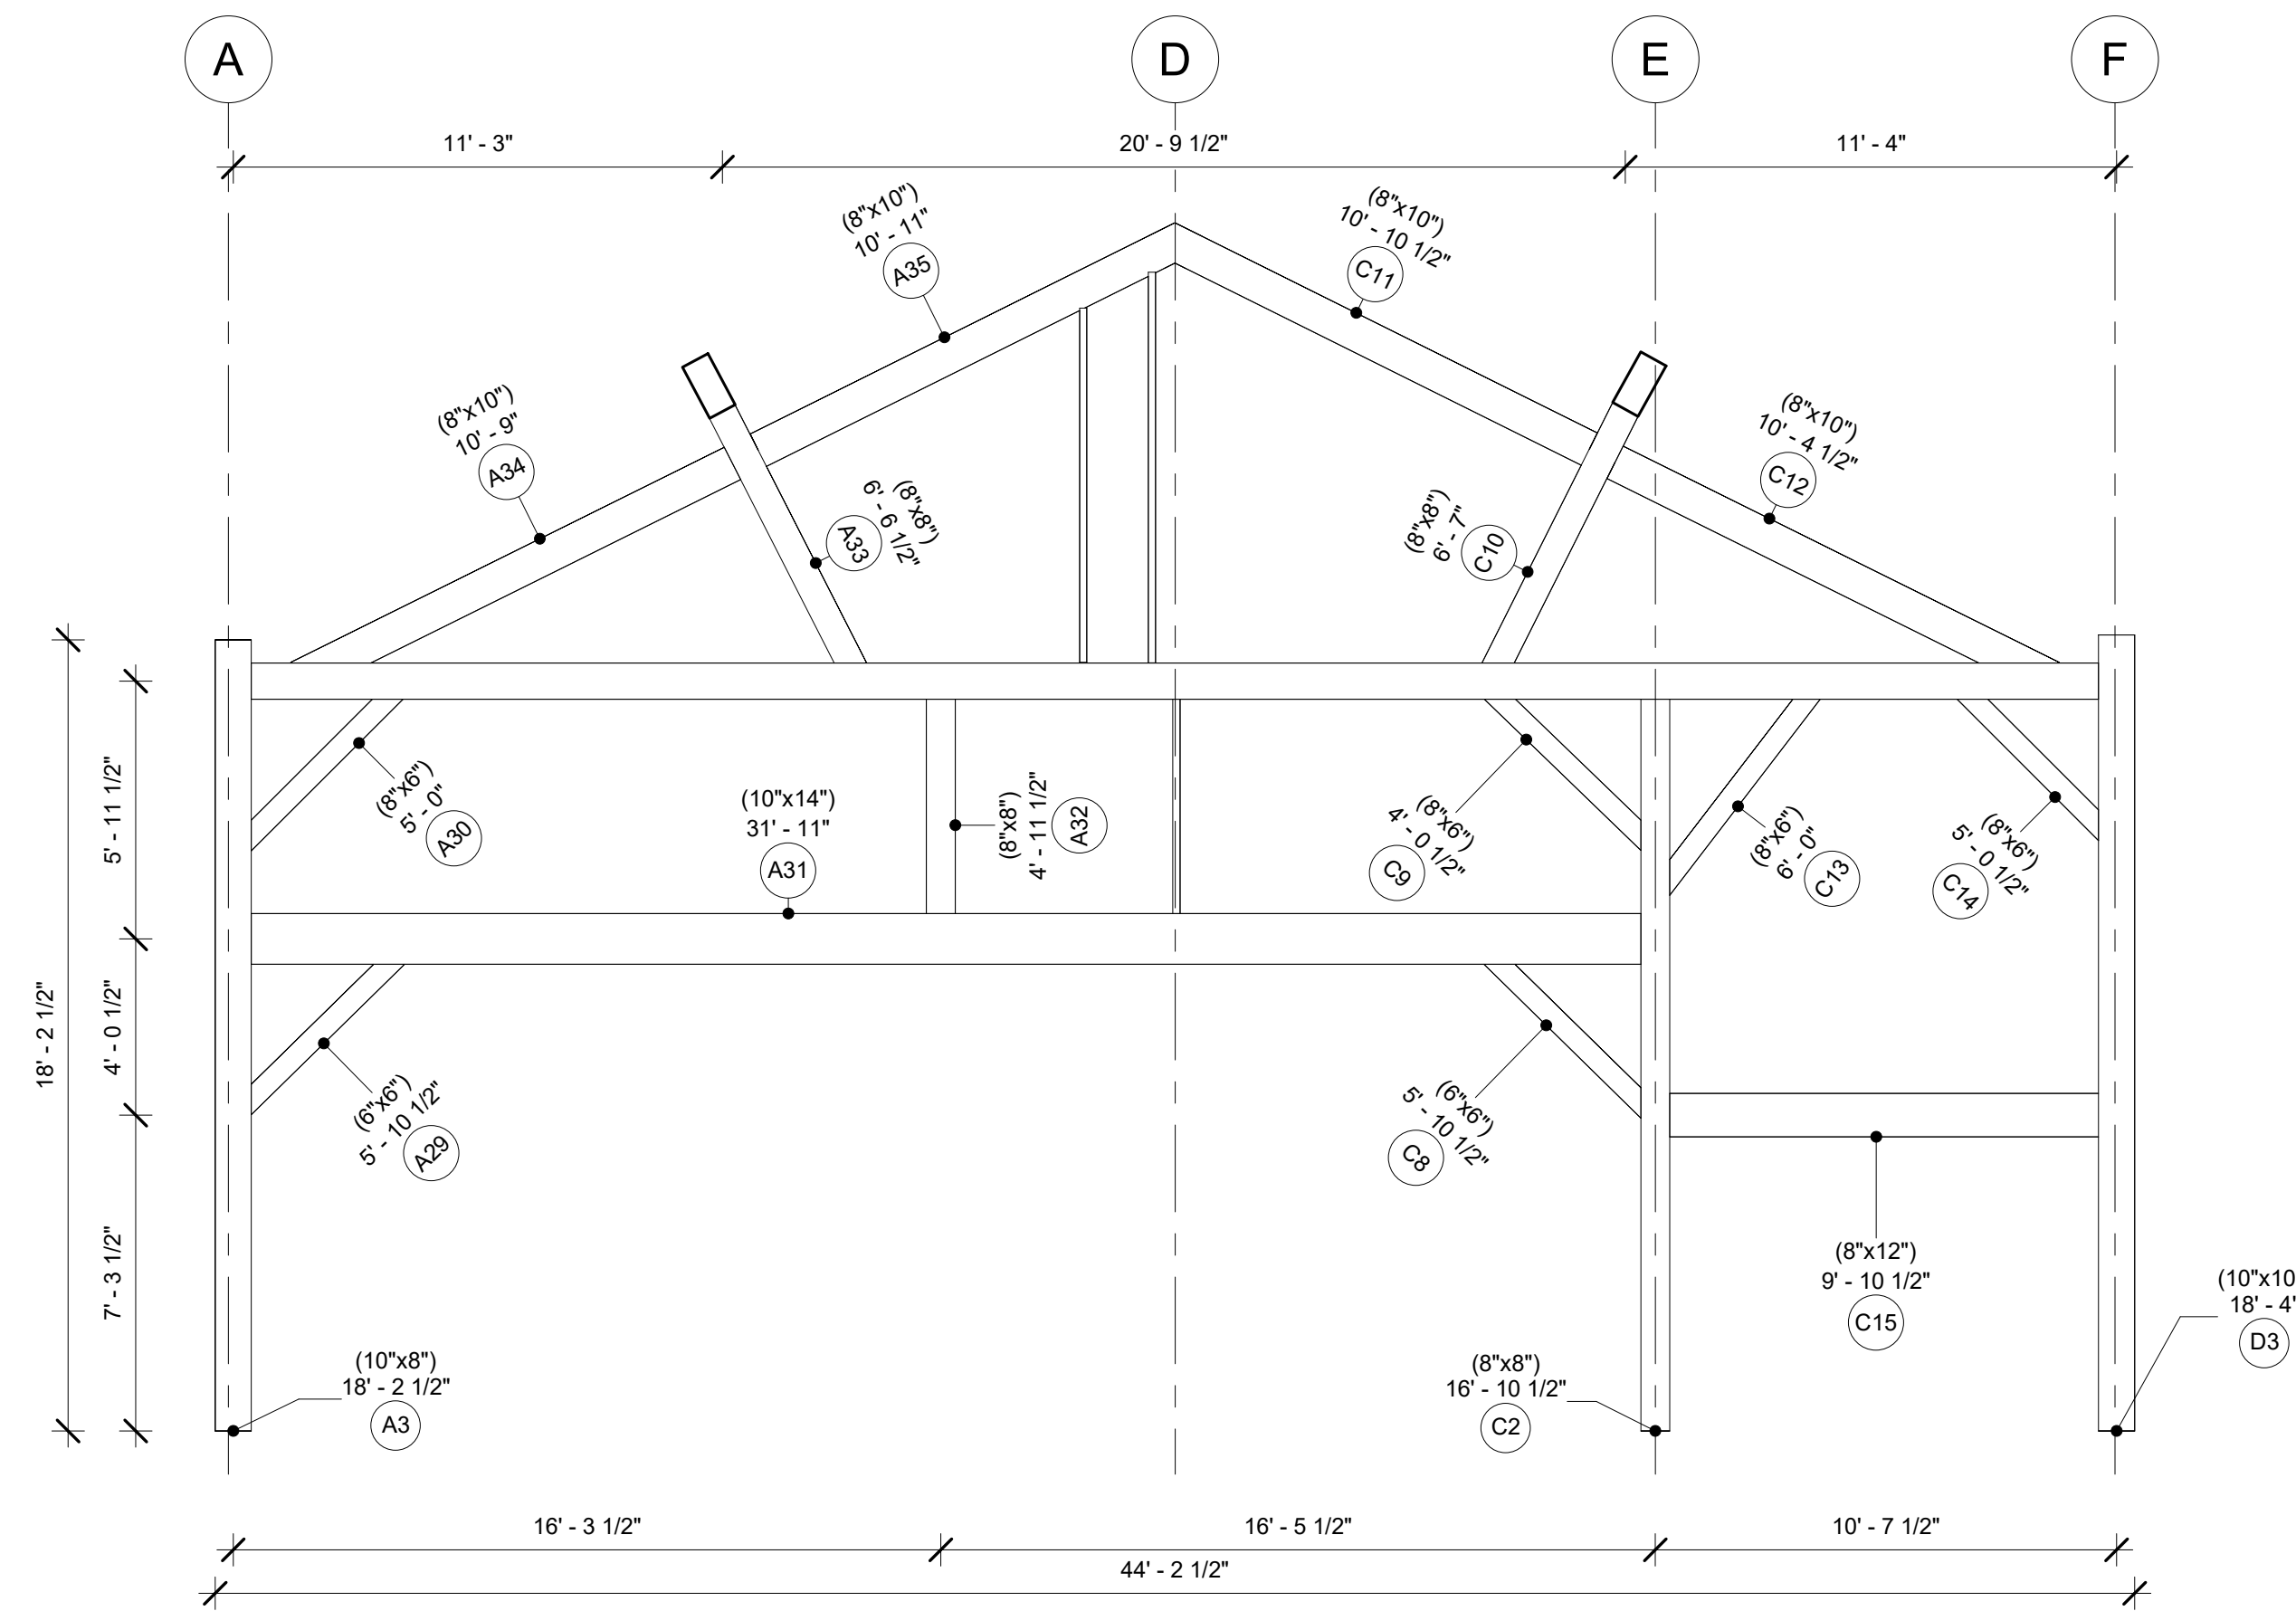

## Bent 3

Project Number Project 4

Date 20250419

Drawn By

Checked By

# A109

Scale 1/4" = 1'-0"

# Timber Home Services LLC


80 Old Gate Road,  
Penn Run PA, 15765

**DAN TRIMBLE**  
AA66 / TIMBER HOME SERVICES

CELL PHONE/TEXT - 412-309-1161

EMAIL:

DANTRIMBLE@TIMBERHOMESERVICES.COM

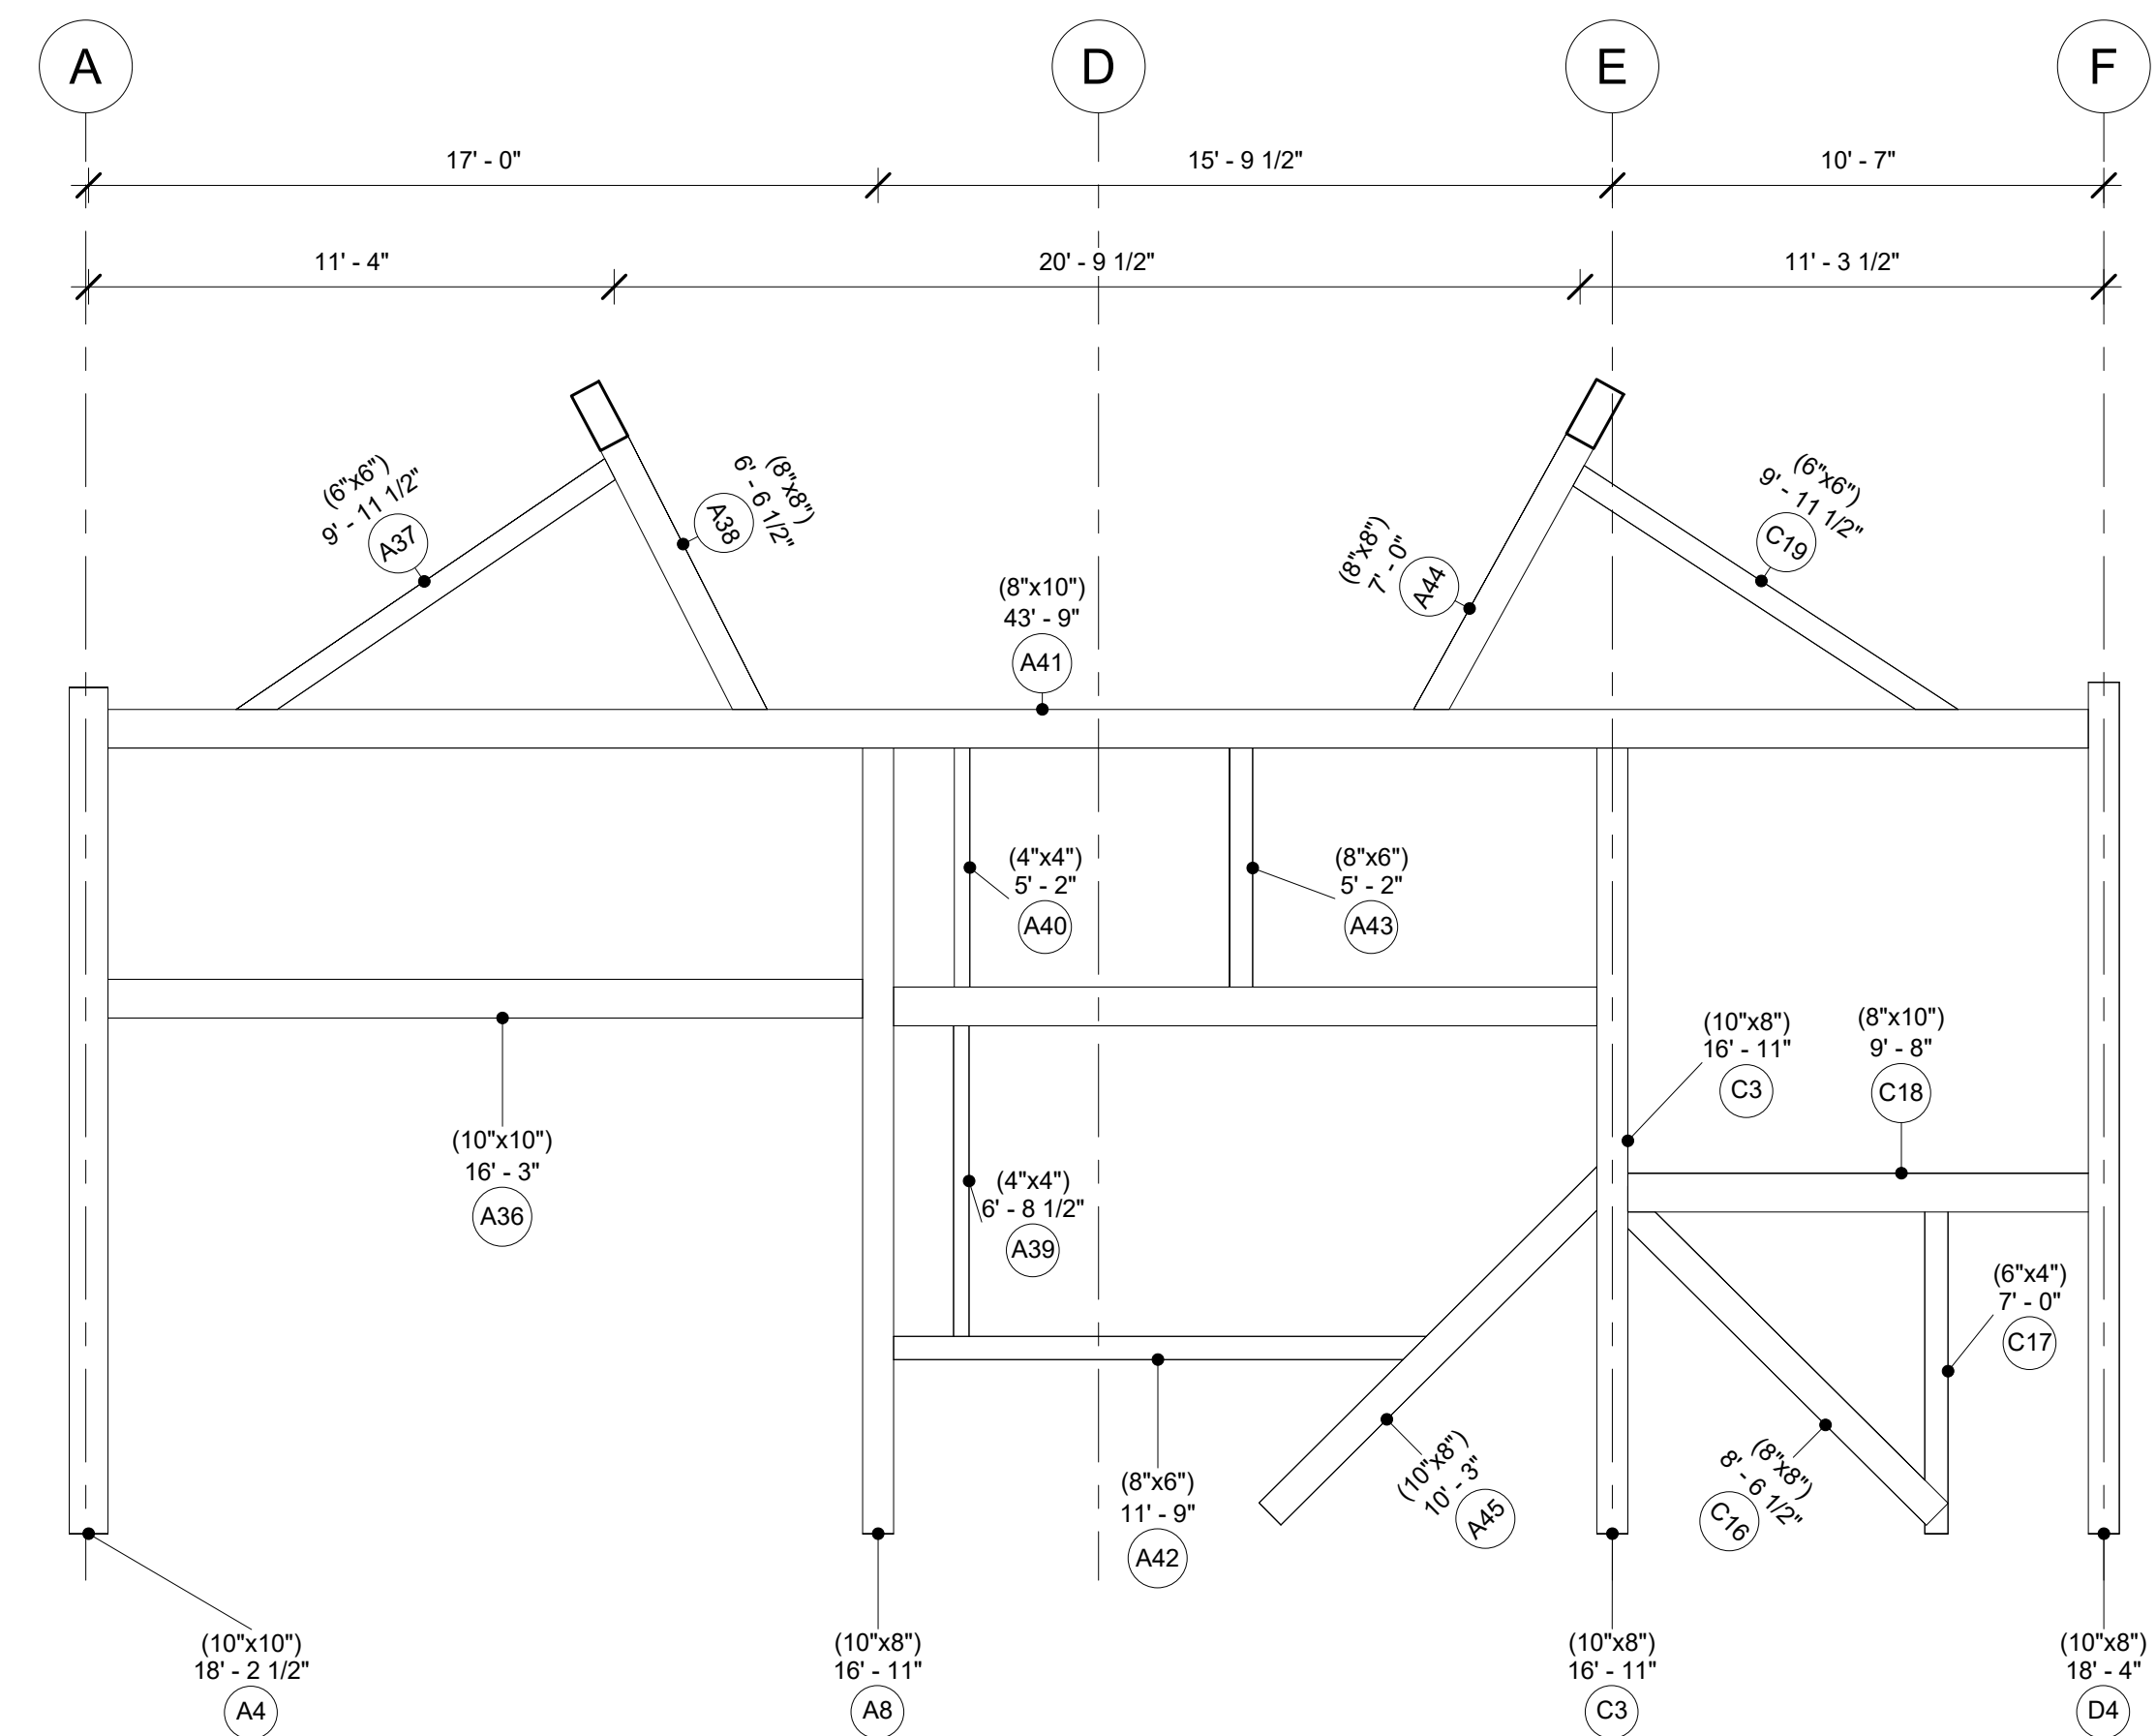

## Bent 4

Project Number Project 4

Date 20250419

Drawn By

Checked By

# A110

Scale 1/4" = 1'-0"

