


PROJECT: Settler's Ridge
SCOPE: AS BUILT DRAWINGS

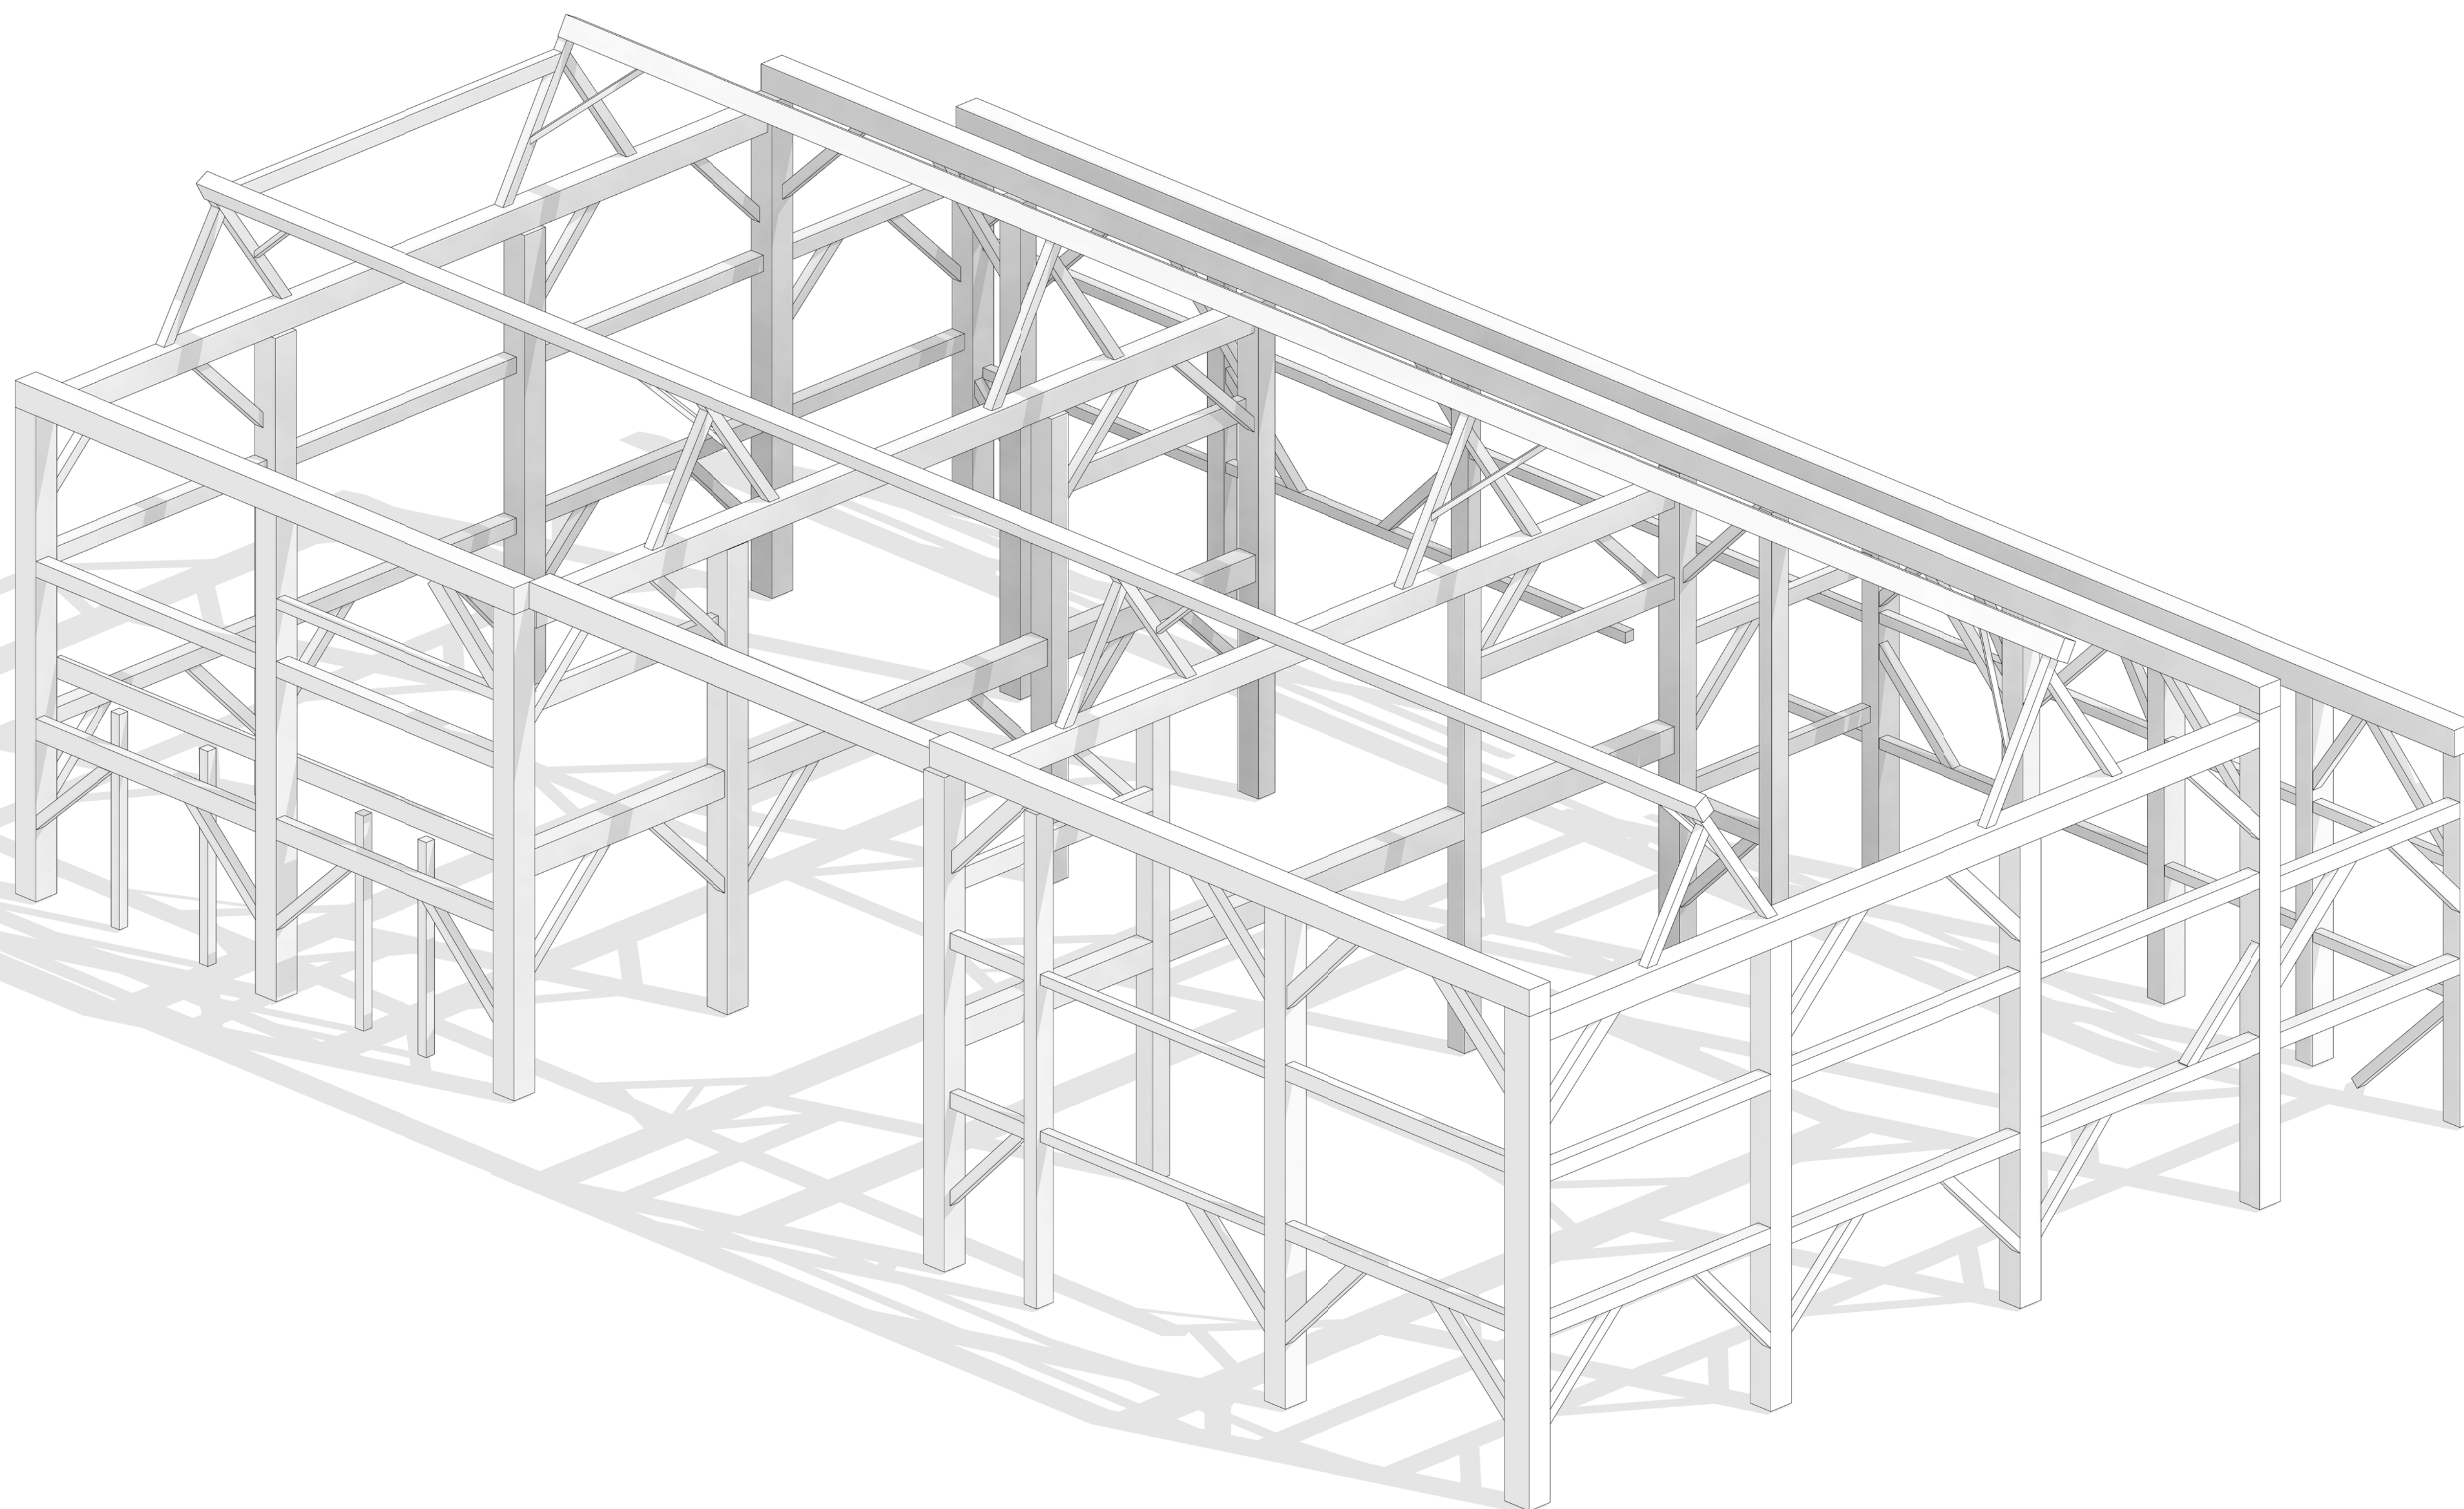

Settler's Ridge


Cover Page

Project Number	Project 12
Date	20250505
Drawn By	
Checked By	

A101

Scale

Settler's Ridge

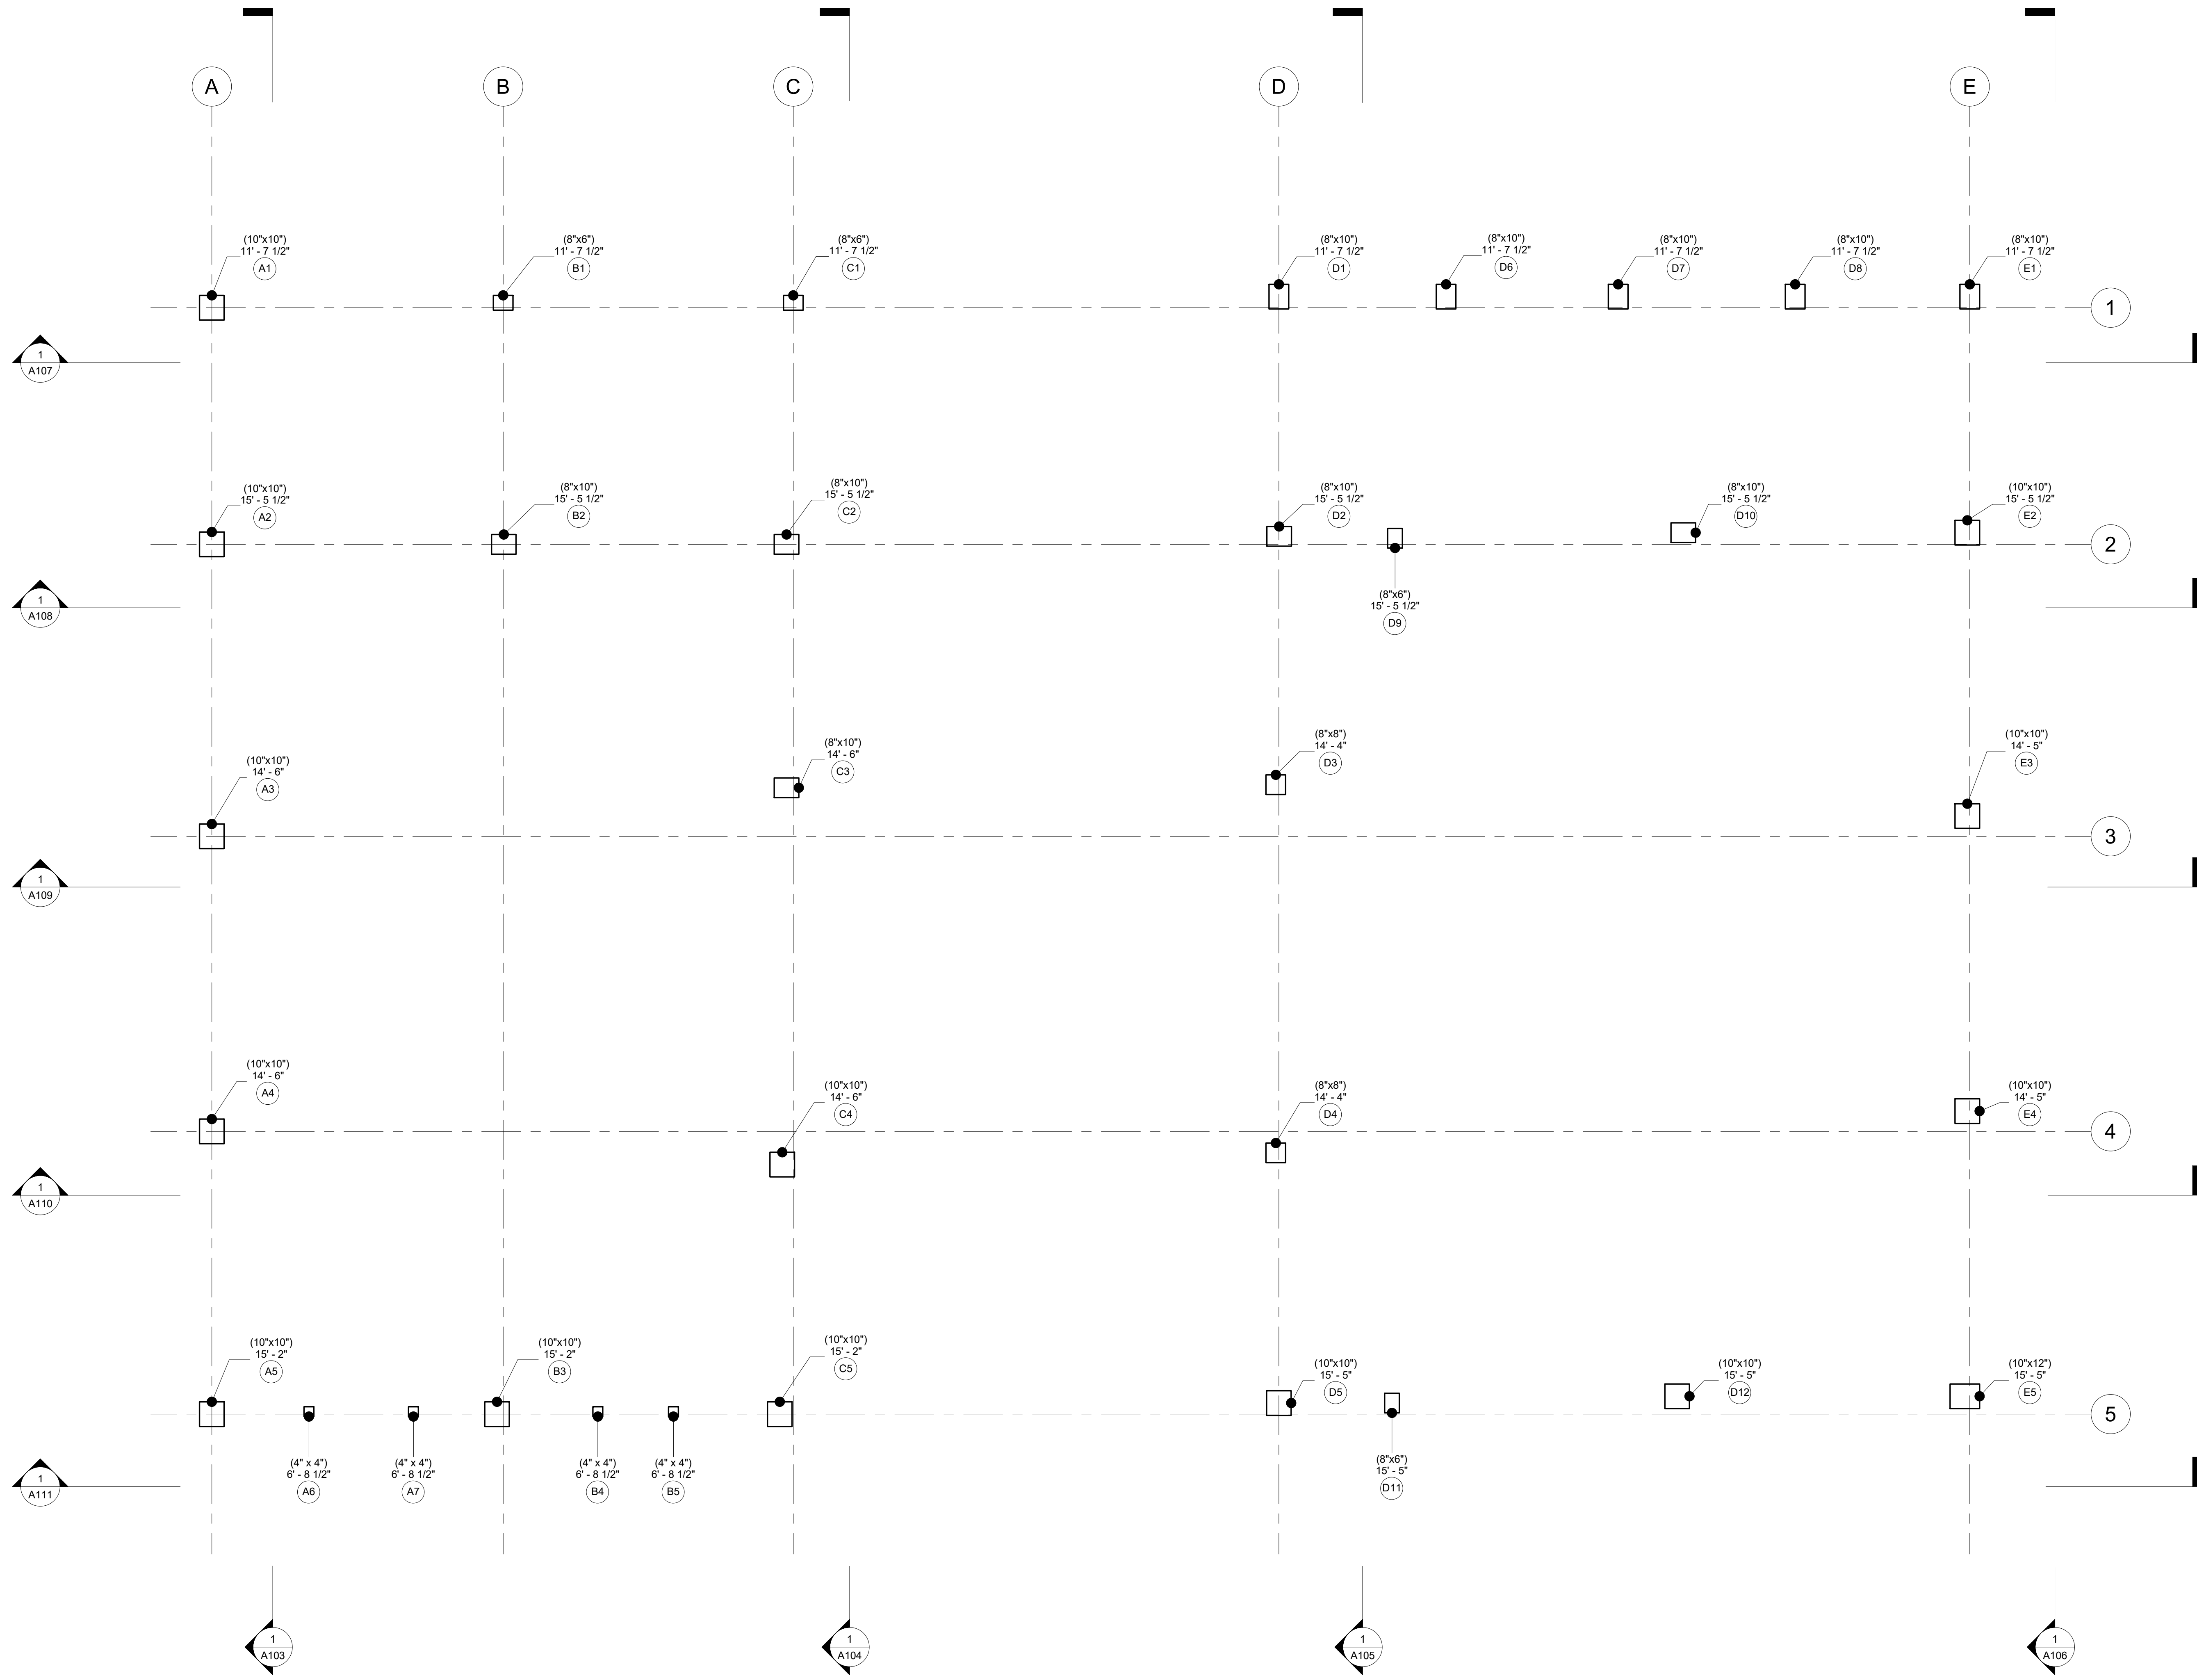


Floor Plan

Project Number Project 12
Date 20250505
Drawn By
Checked By

A102

Scale 3/8" = 1'-0"

Settler's Ridge

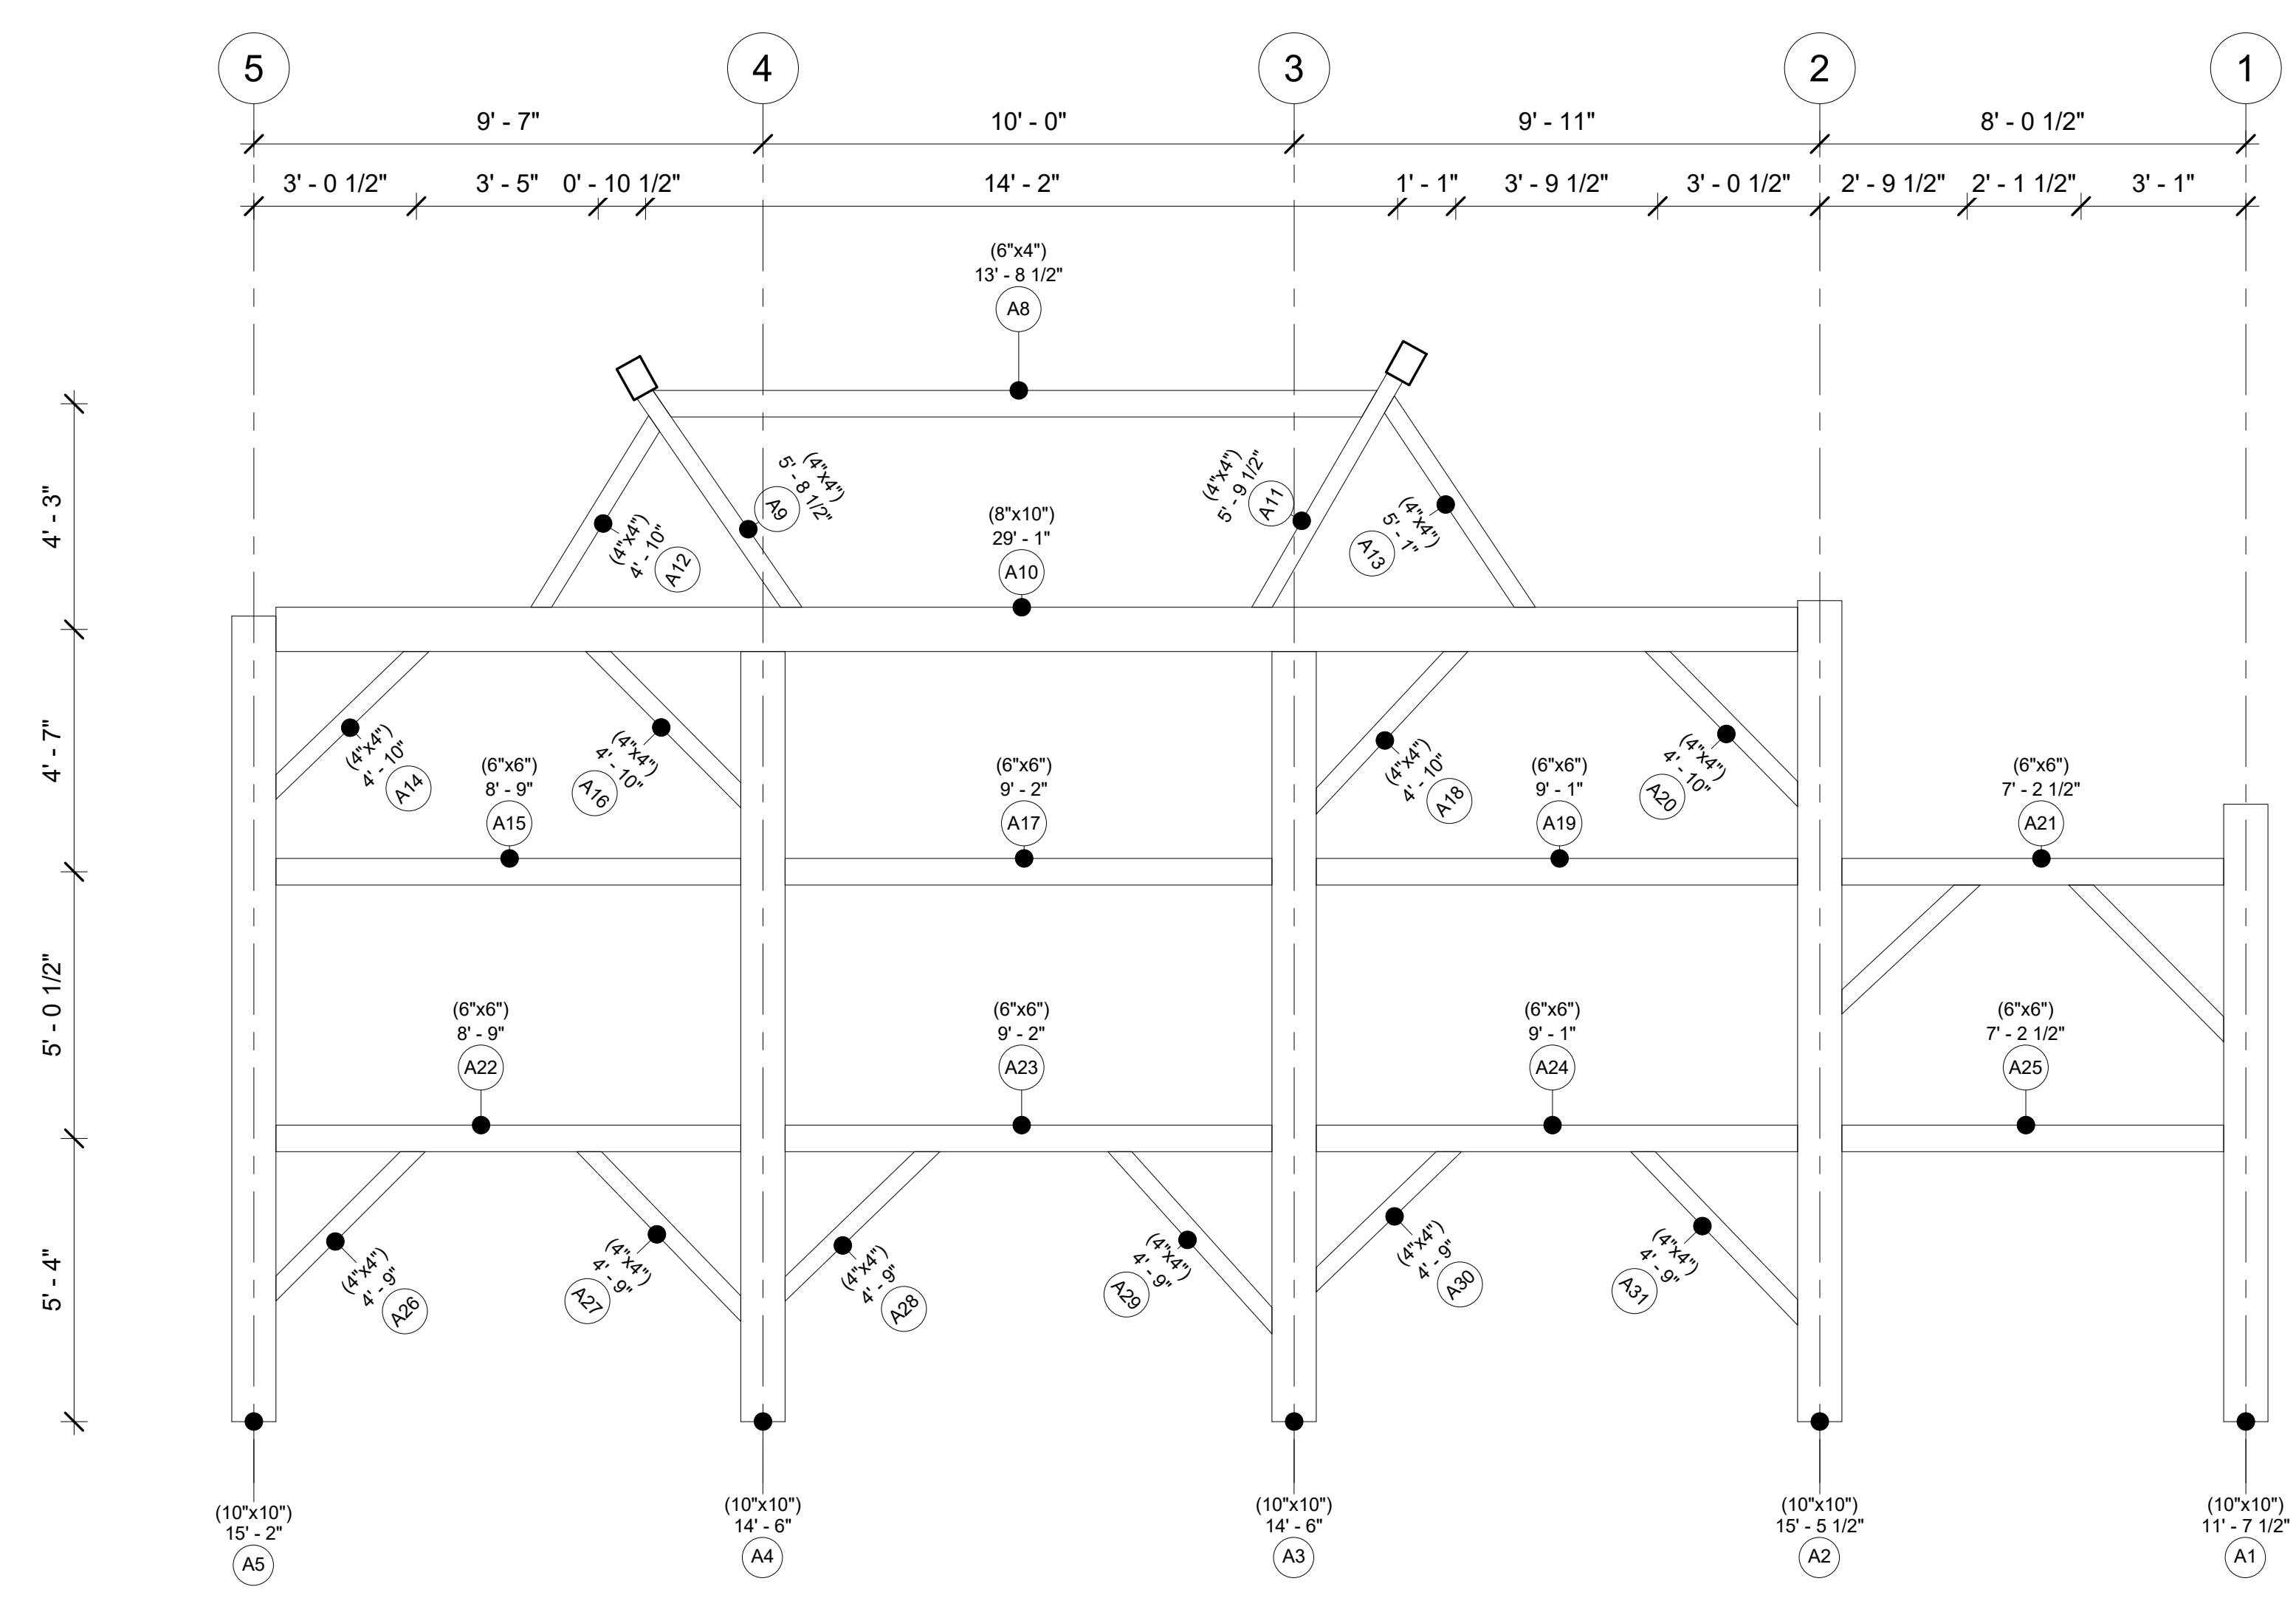


Bent A

Project Number	Project 12
Date	20250505
Drawn By	
Checked By	

A103

Scale	3/8" = 1'-0"
-------	--------------

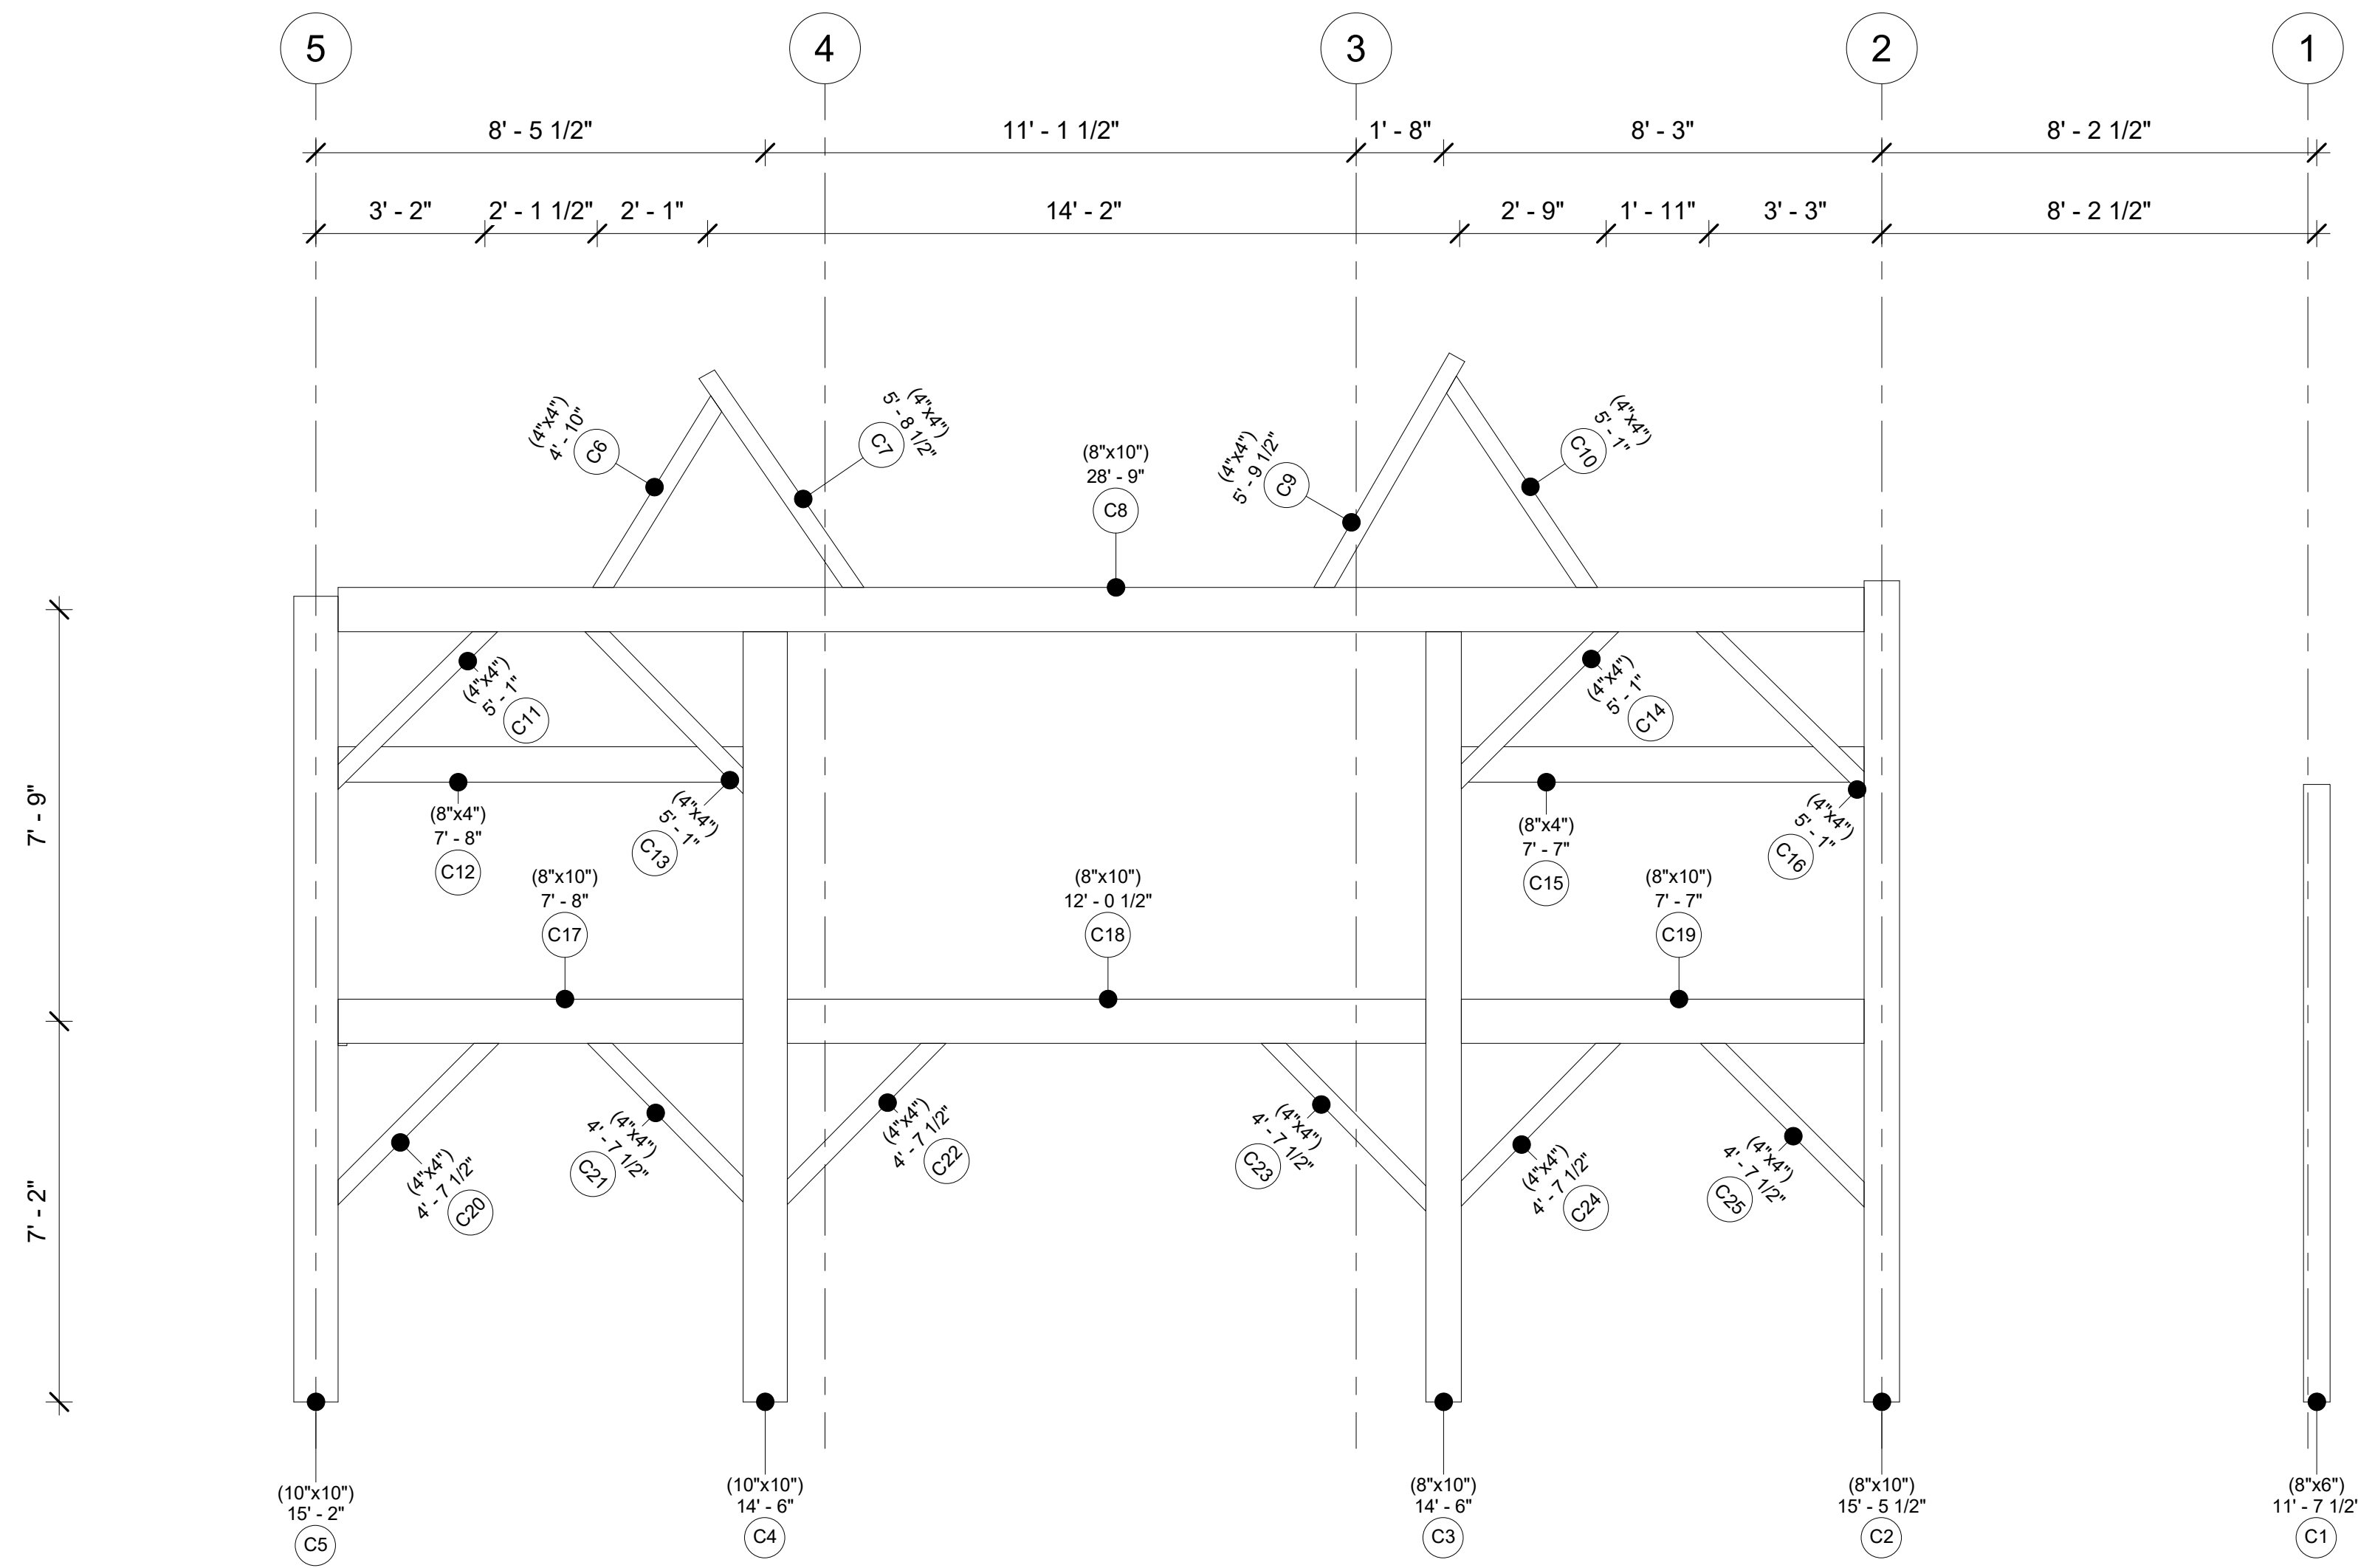

Settler's Ridge


Bent C

Project Number	Project 12
Date	20250505
Drawn By	
Checked By	

A104

Scale	3/8" = 1'-0"
-------	--------------

Settler's Ridge

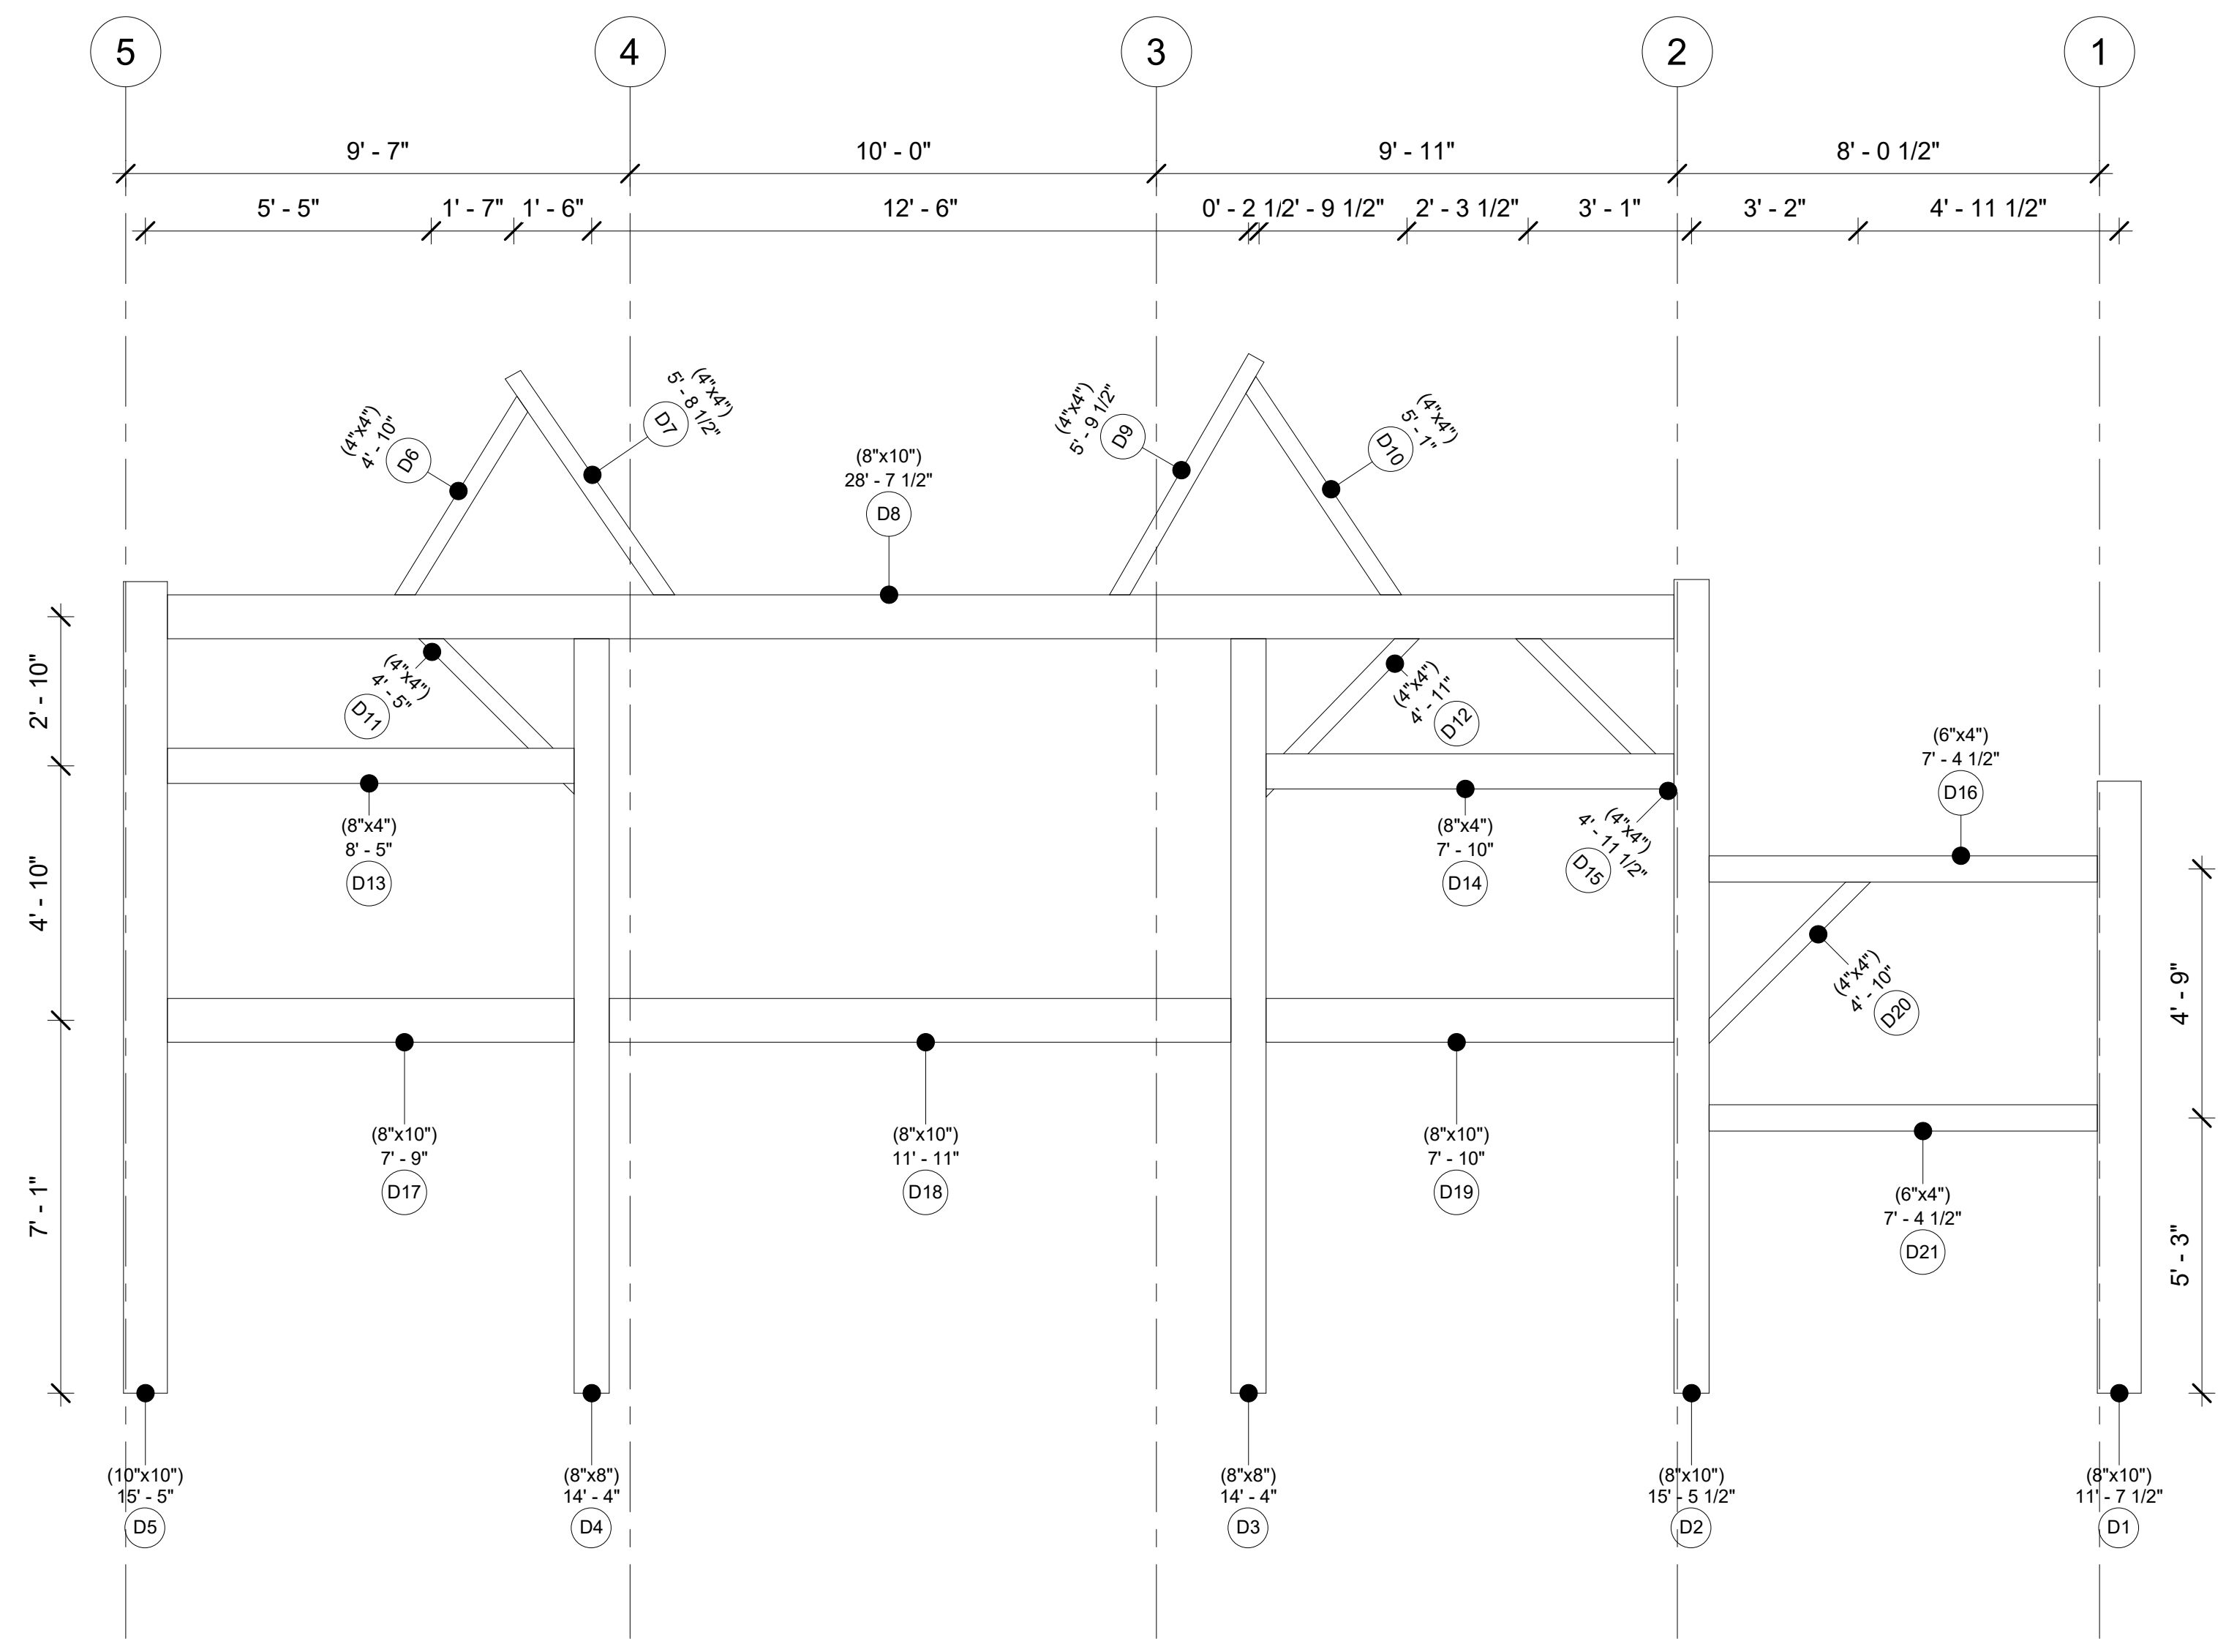


Bent D

Project Number	Project 12
Date	20250505
Drawn By	
Checked By	

A105

Scale	3/8" = 1'-0"
-------	--------------

Settler's Ridge

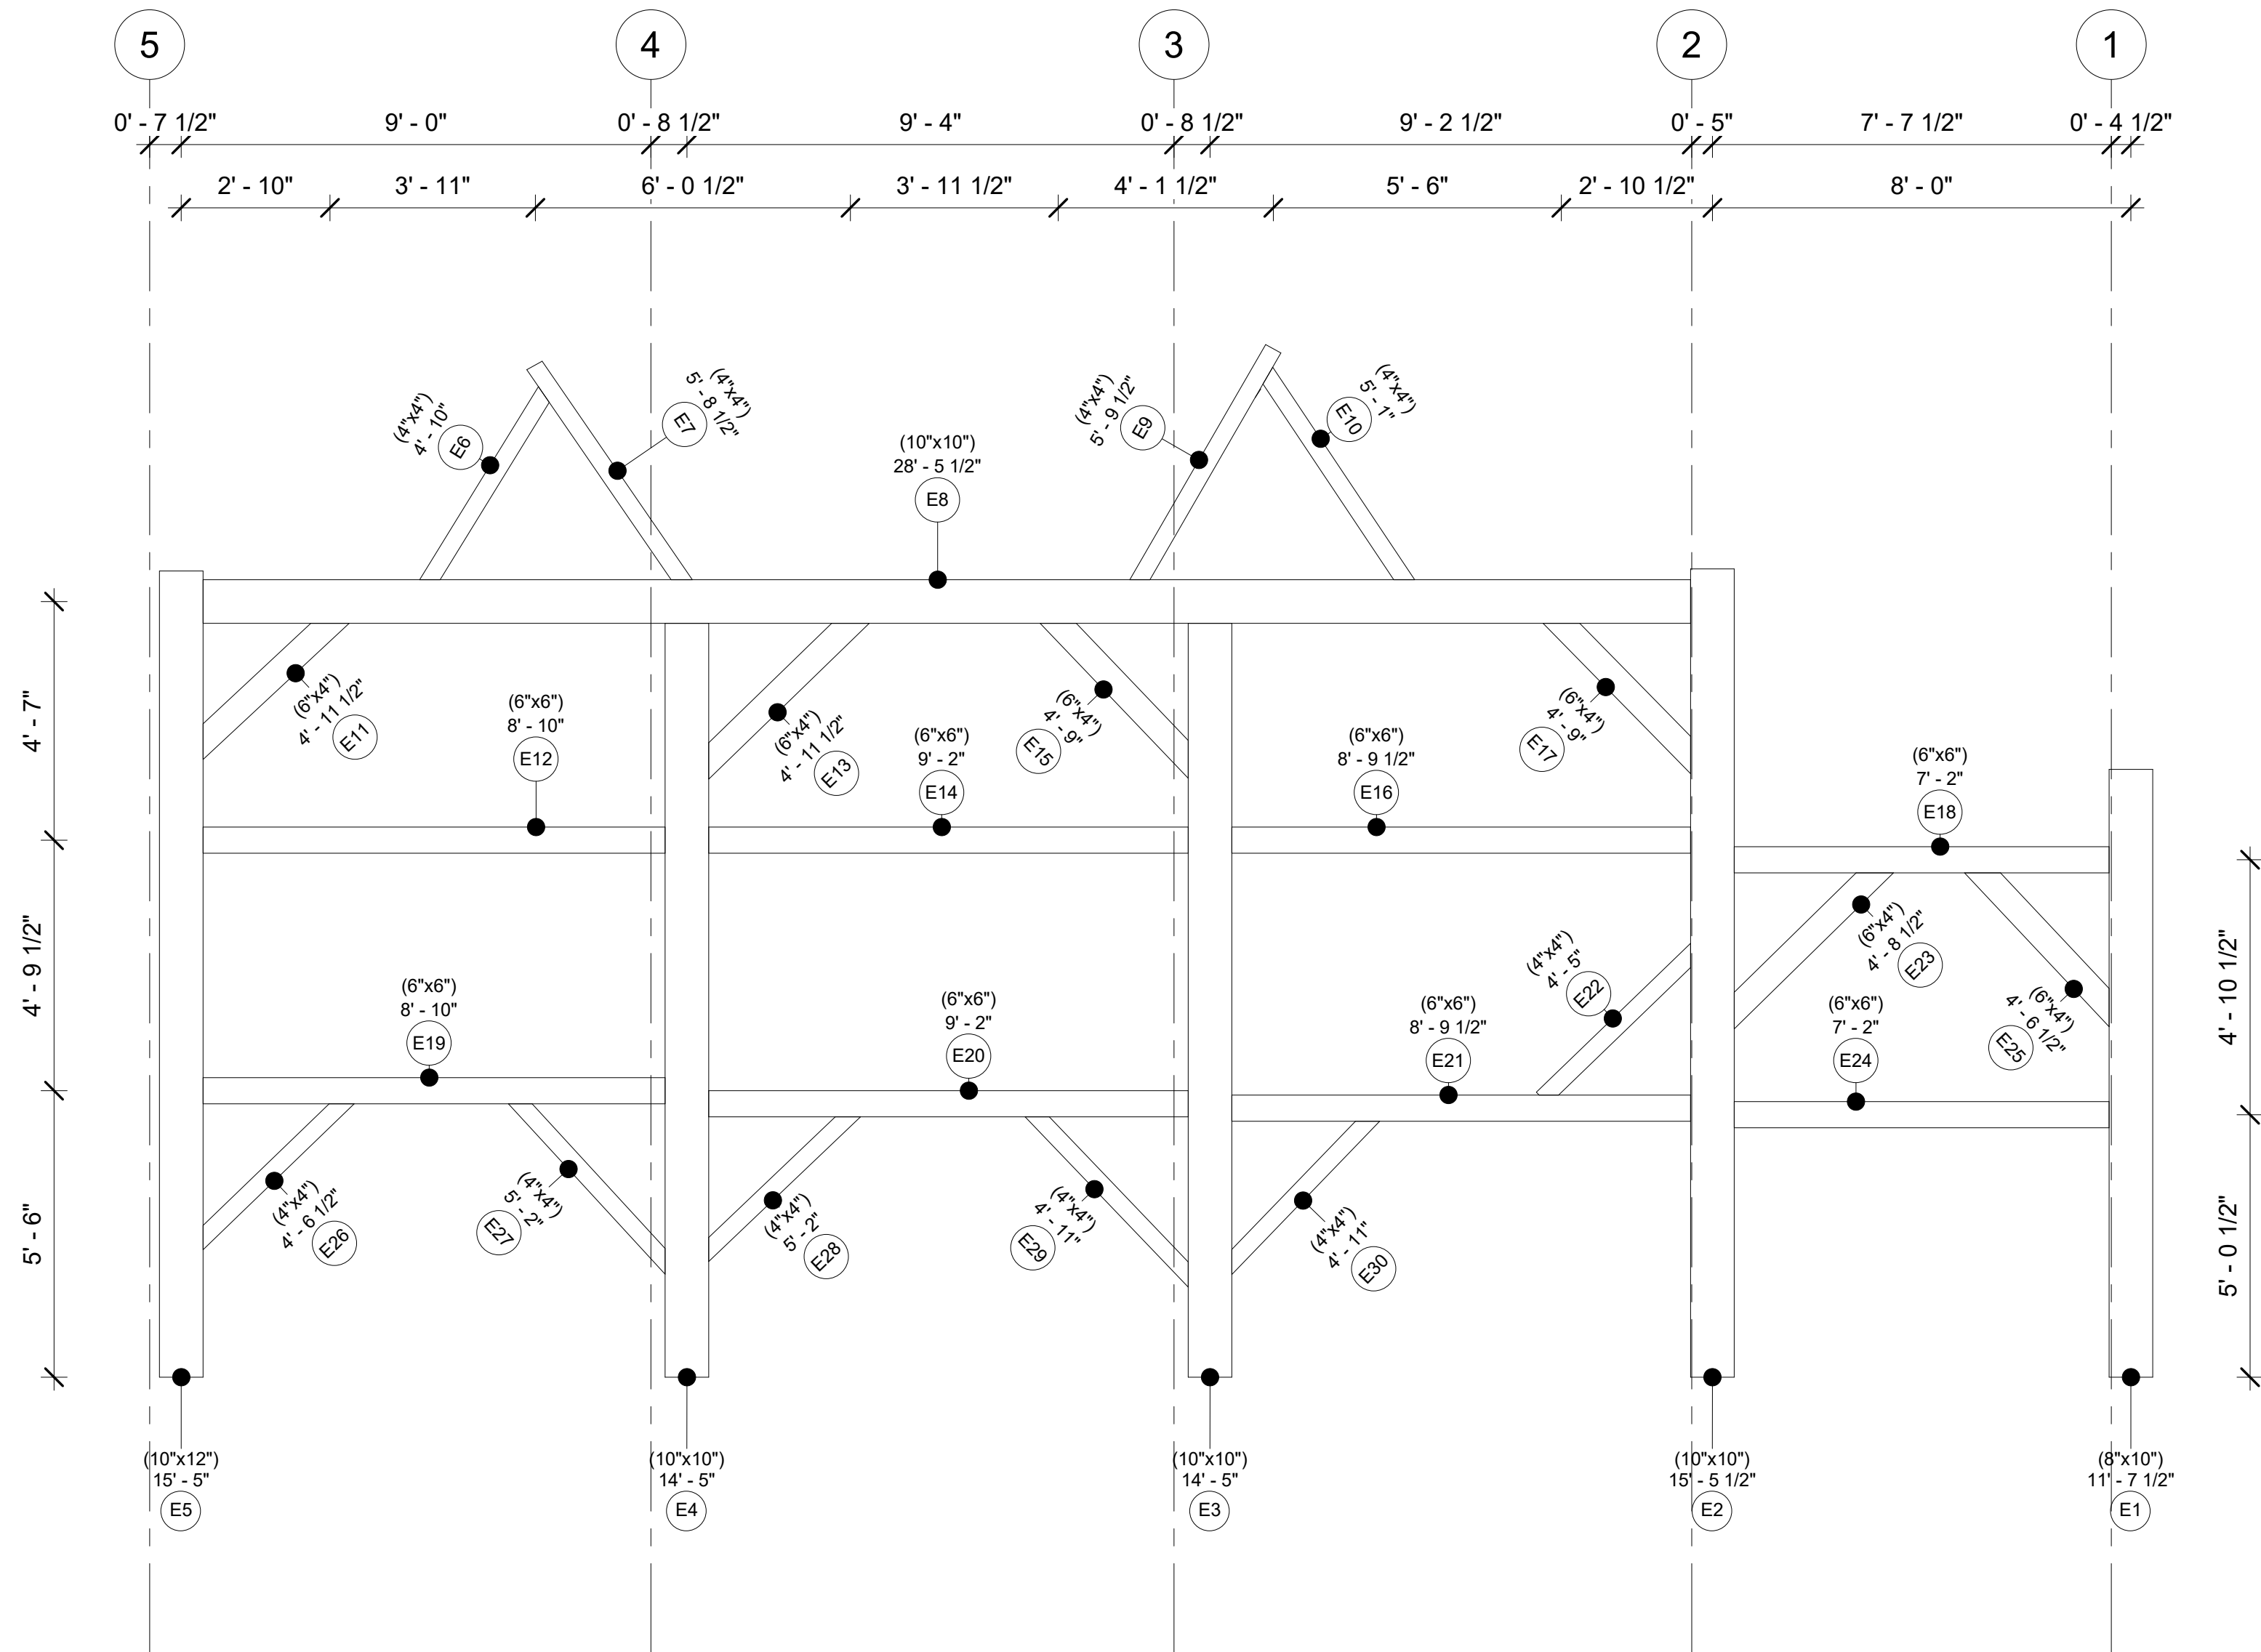


Bent E

Project Number Project 12
 Date 20250505
 Drawn By
 Checked By

A106

Scale 3/8" = 1'-0"

Settler's Ridge

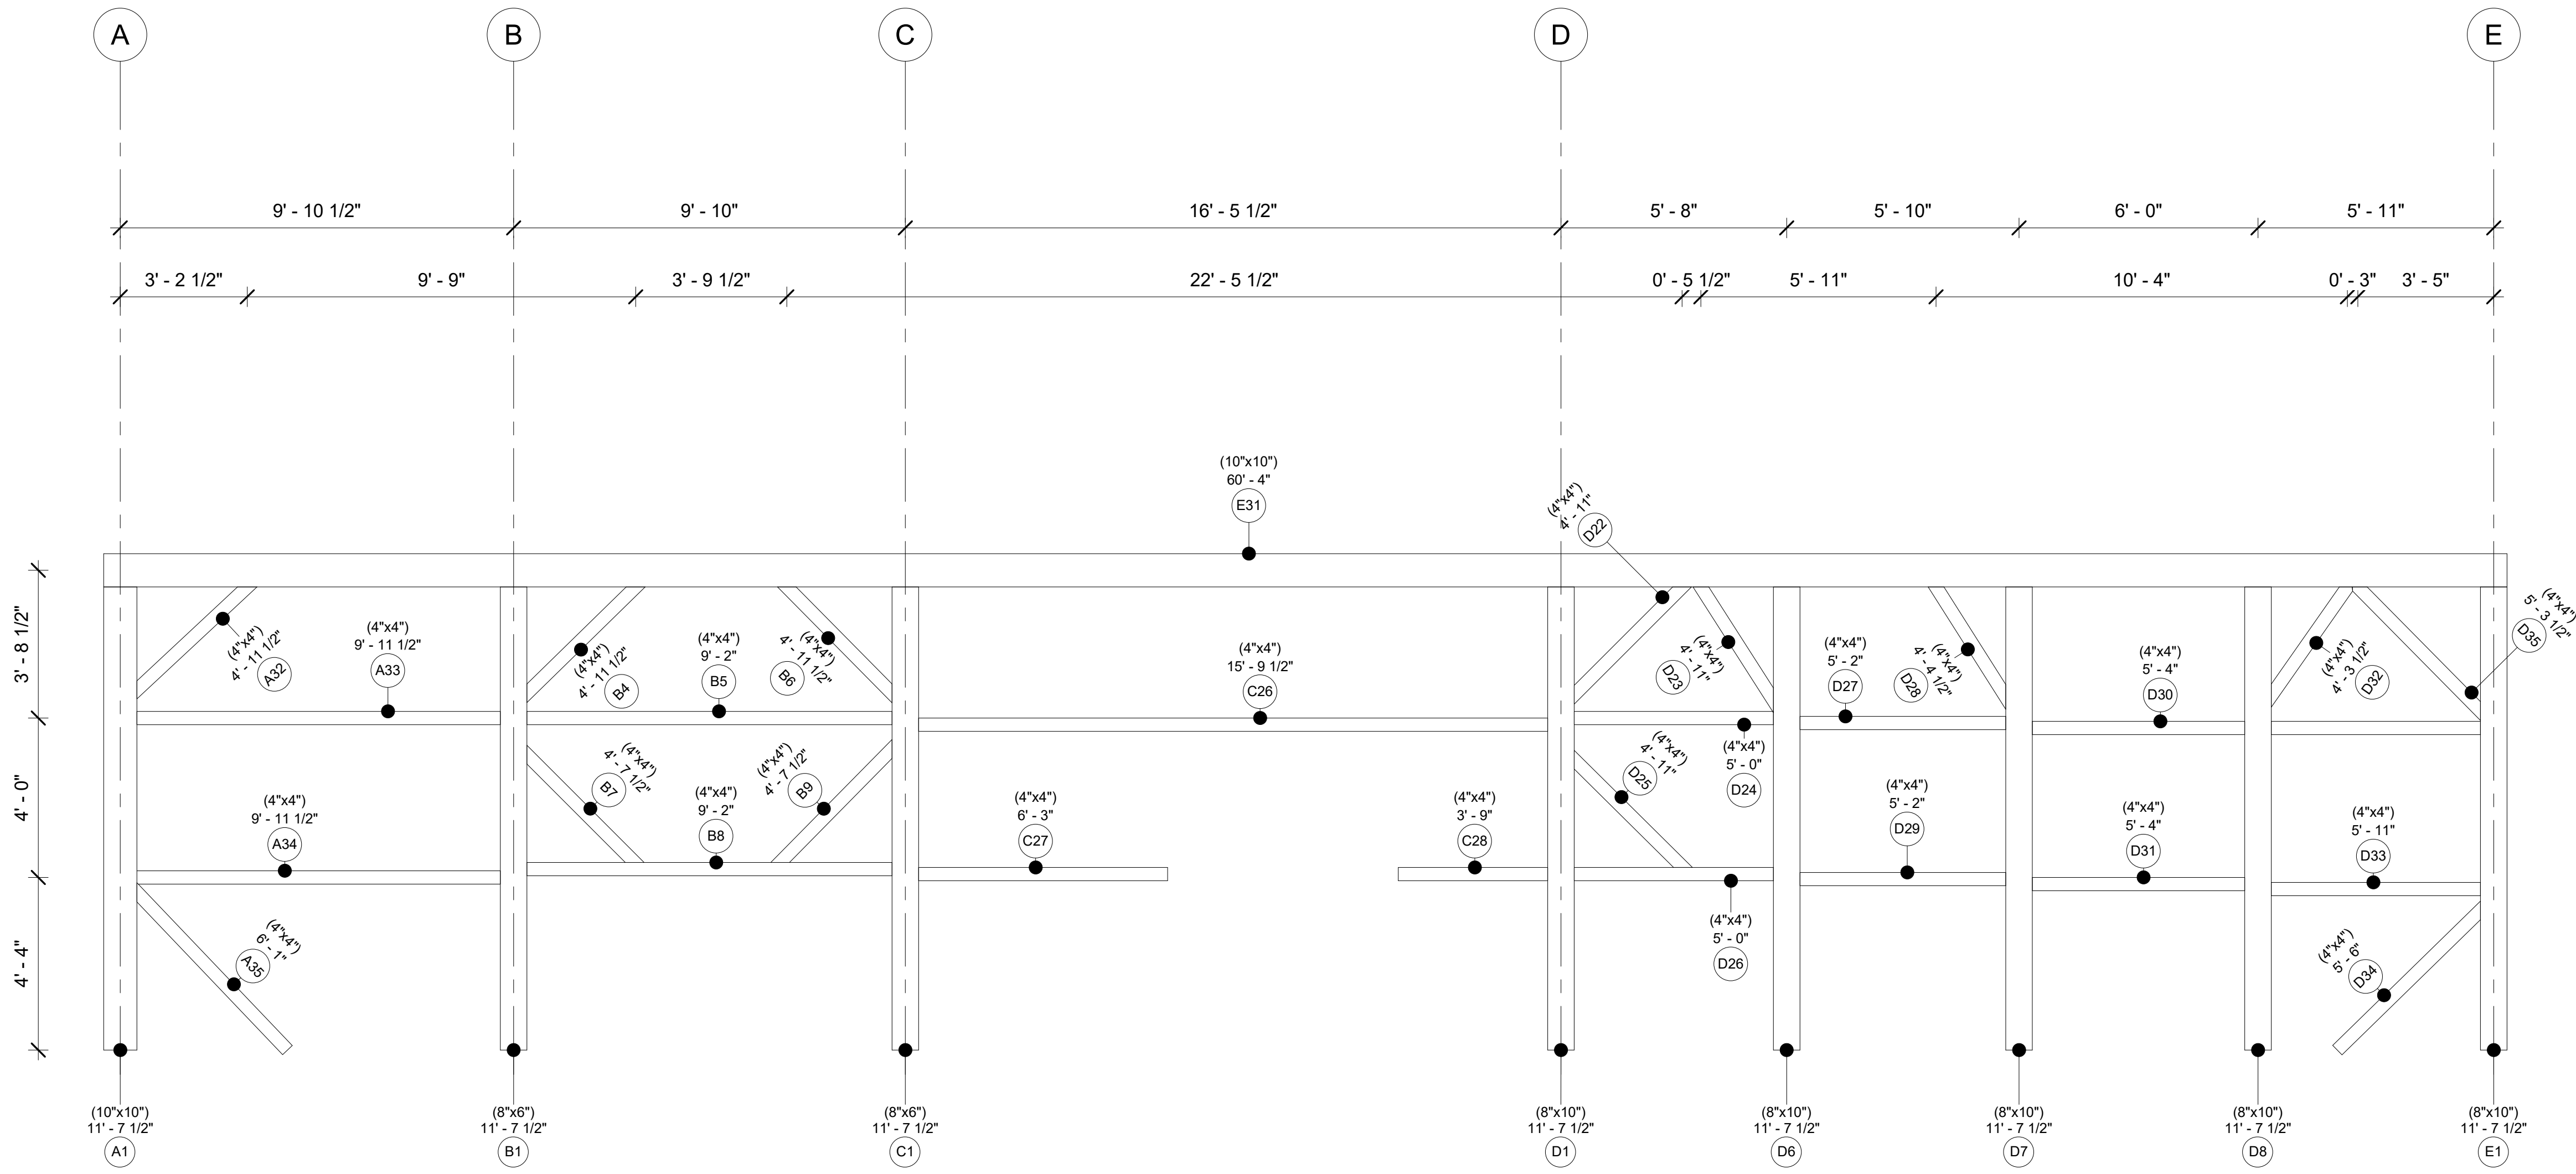


Bent 1

Project Number Project 12
 Date 20250505
 Drawn By
 Checked By

A107

Scale 3/8" = 1'-0"

Settler's Ridge

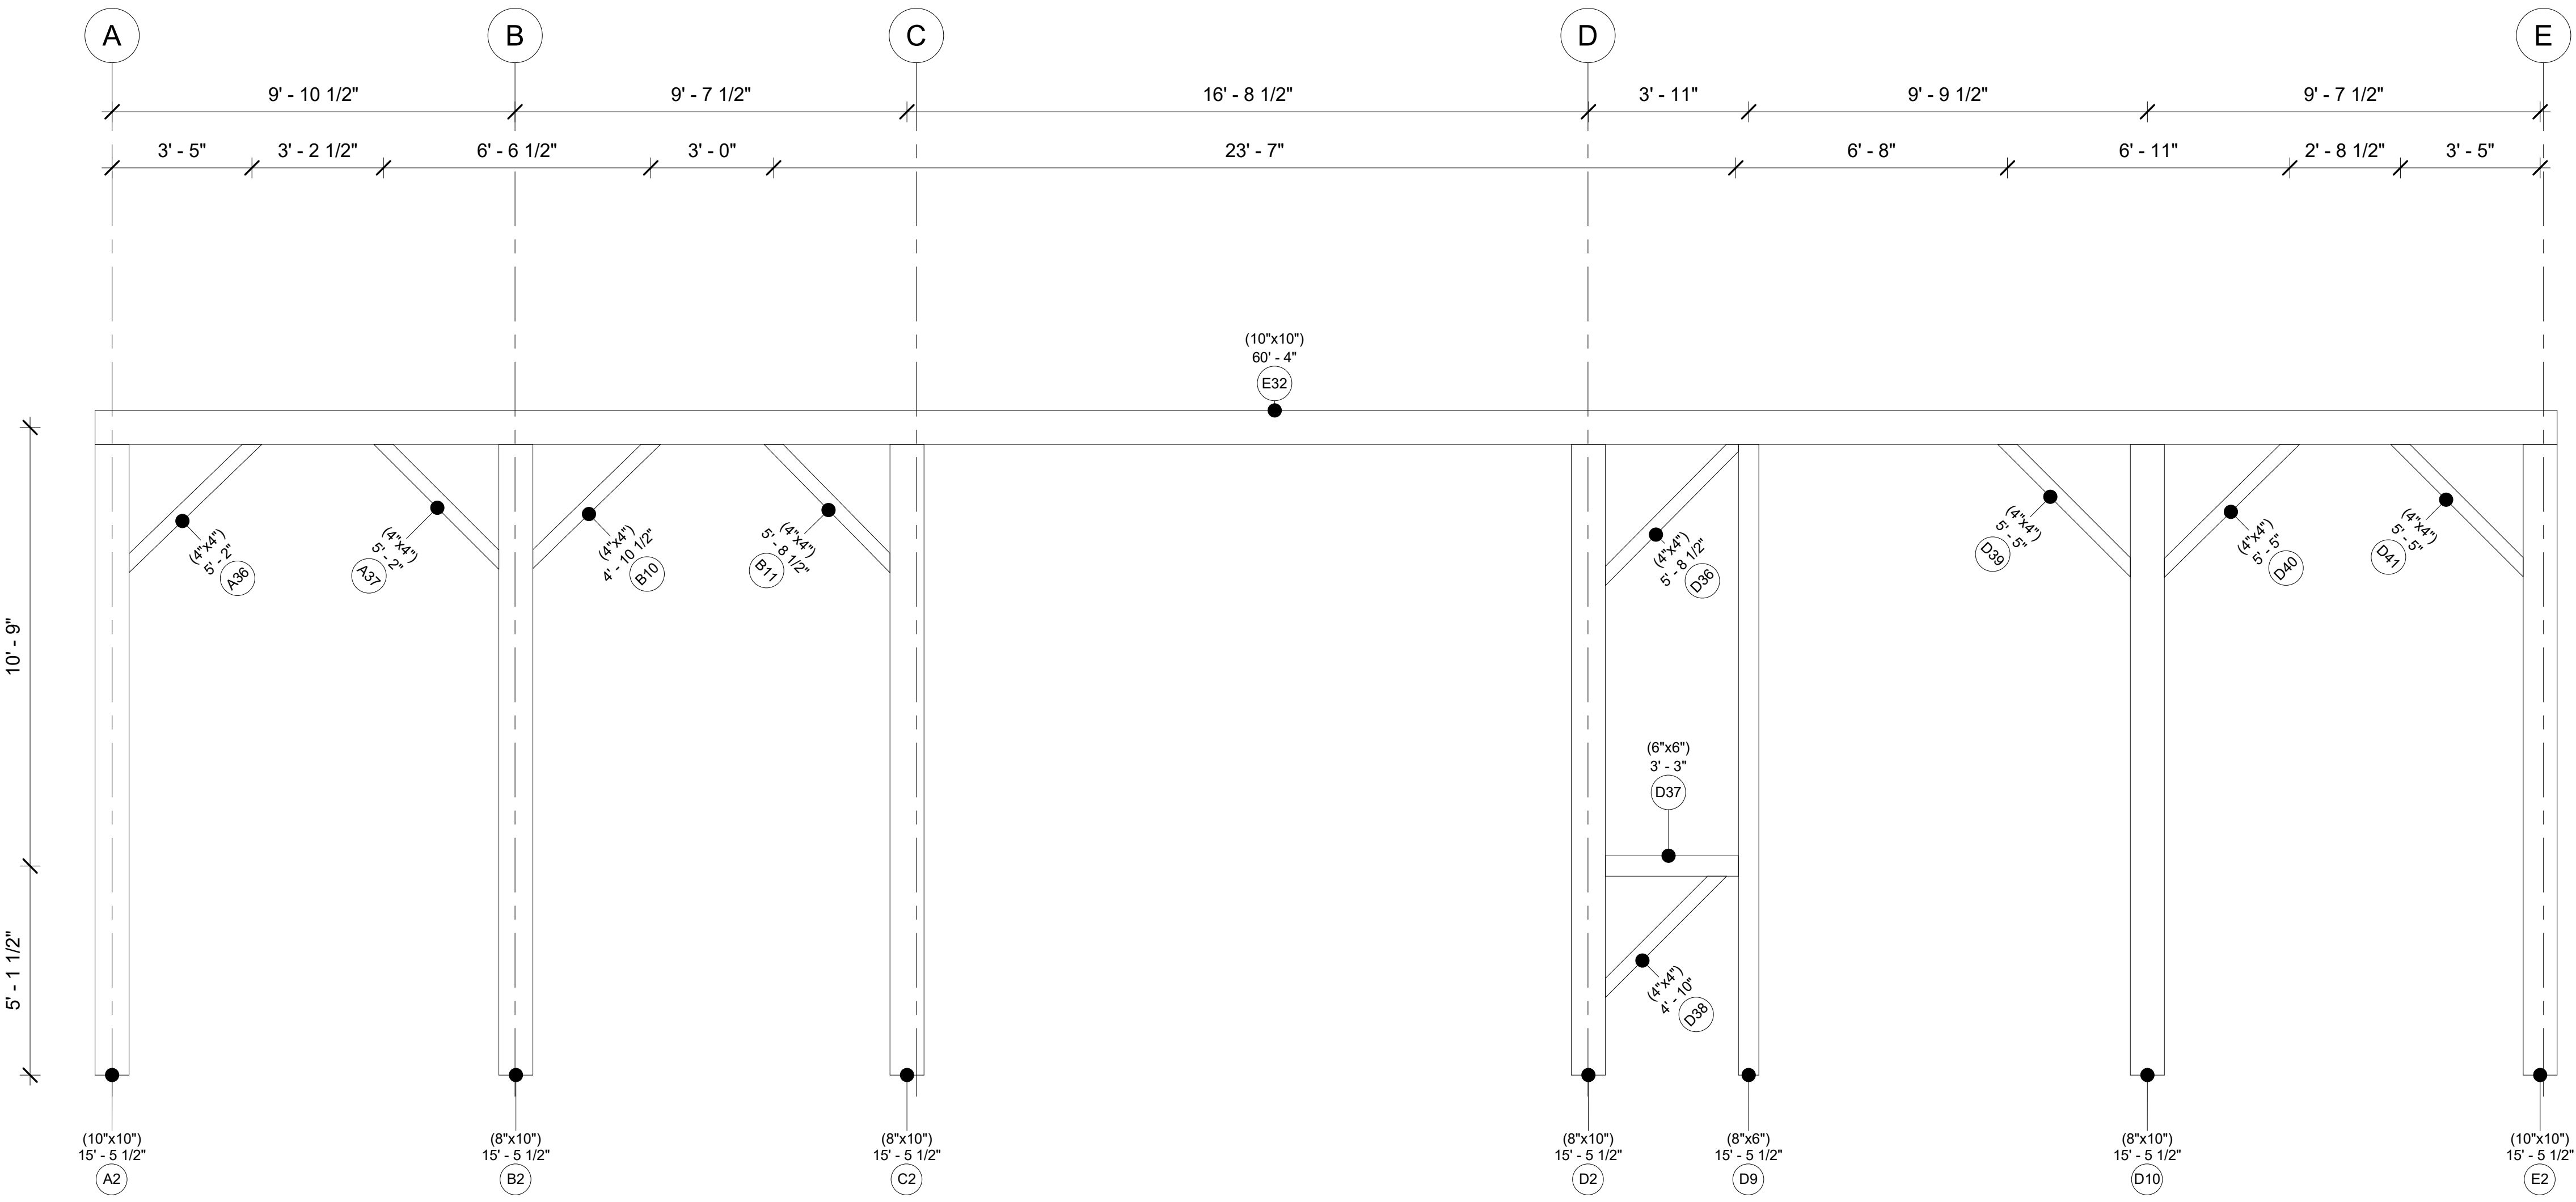


Bent 2

Project Number	Project 12
Date	20250505
Drawn By	
Checked By	

A108

Scale 3/8" = 1'-0"

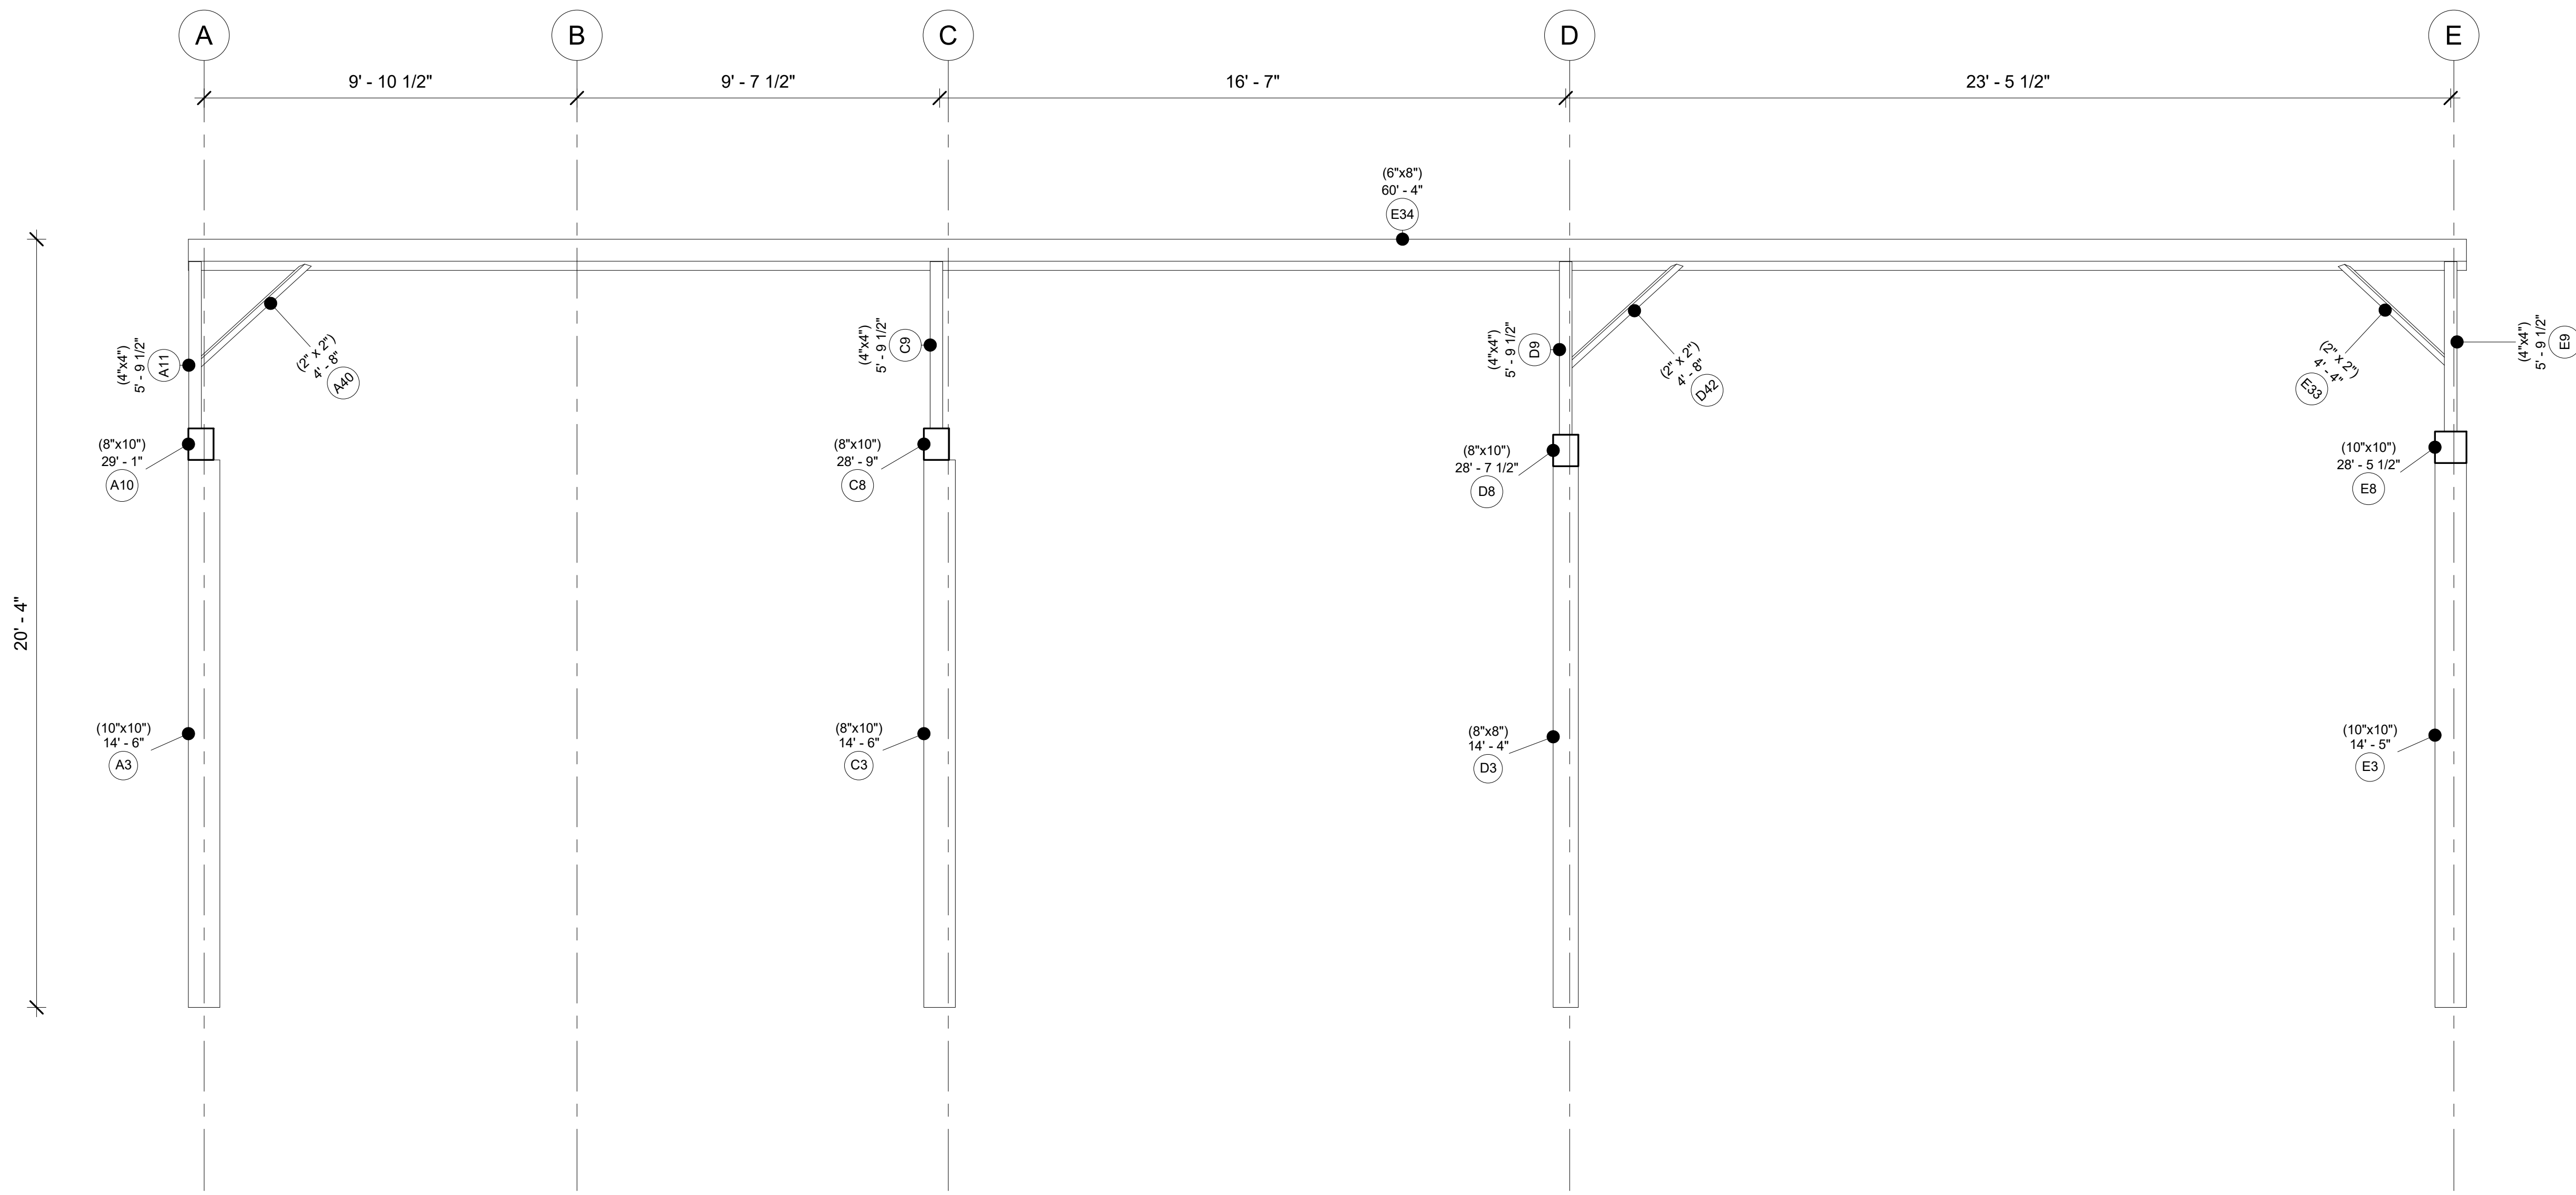

Settler's Ridge


Bent 3

Project Number	Project 12
Date	20250505
Drawn By	
Checked By	

A109

Scale	3/8" = 1'-0"
-------	--------------

19' - 5 1/2"

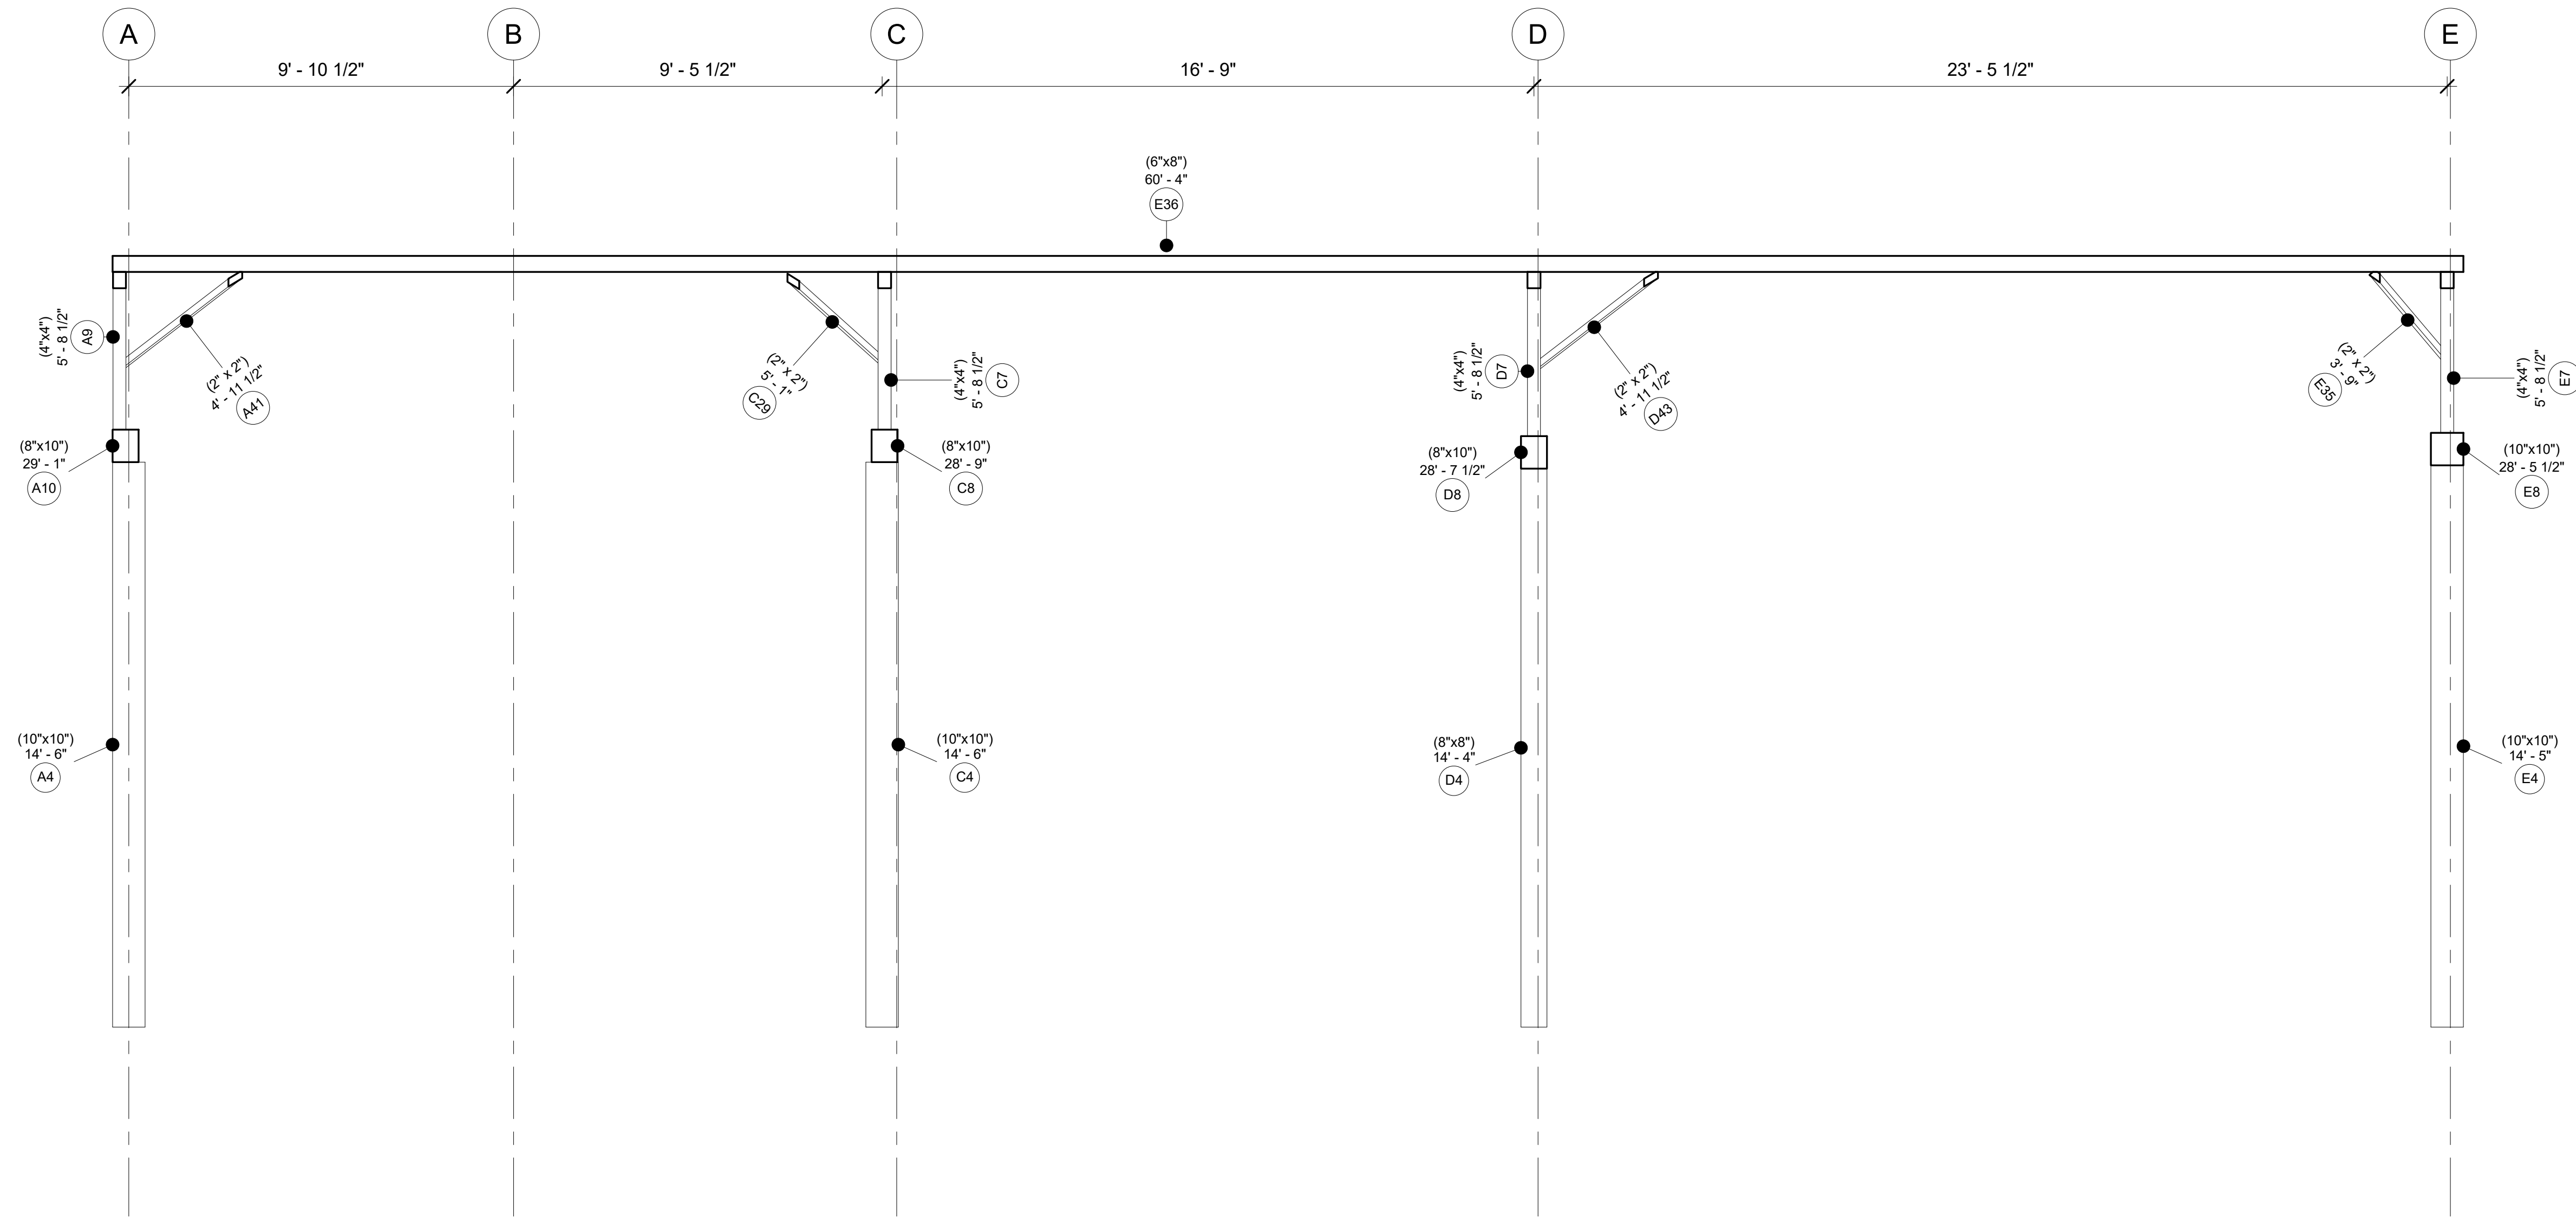


Settler's Ridge

Bent 4

Project Number	Project 12
Date	20250505
Drawn By	
Checked By	

A110

Scale 3/8" = 1'-0"

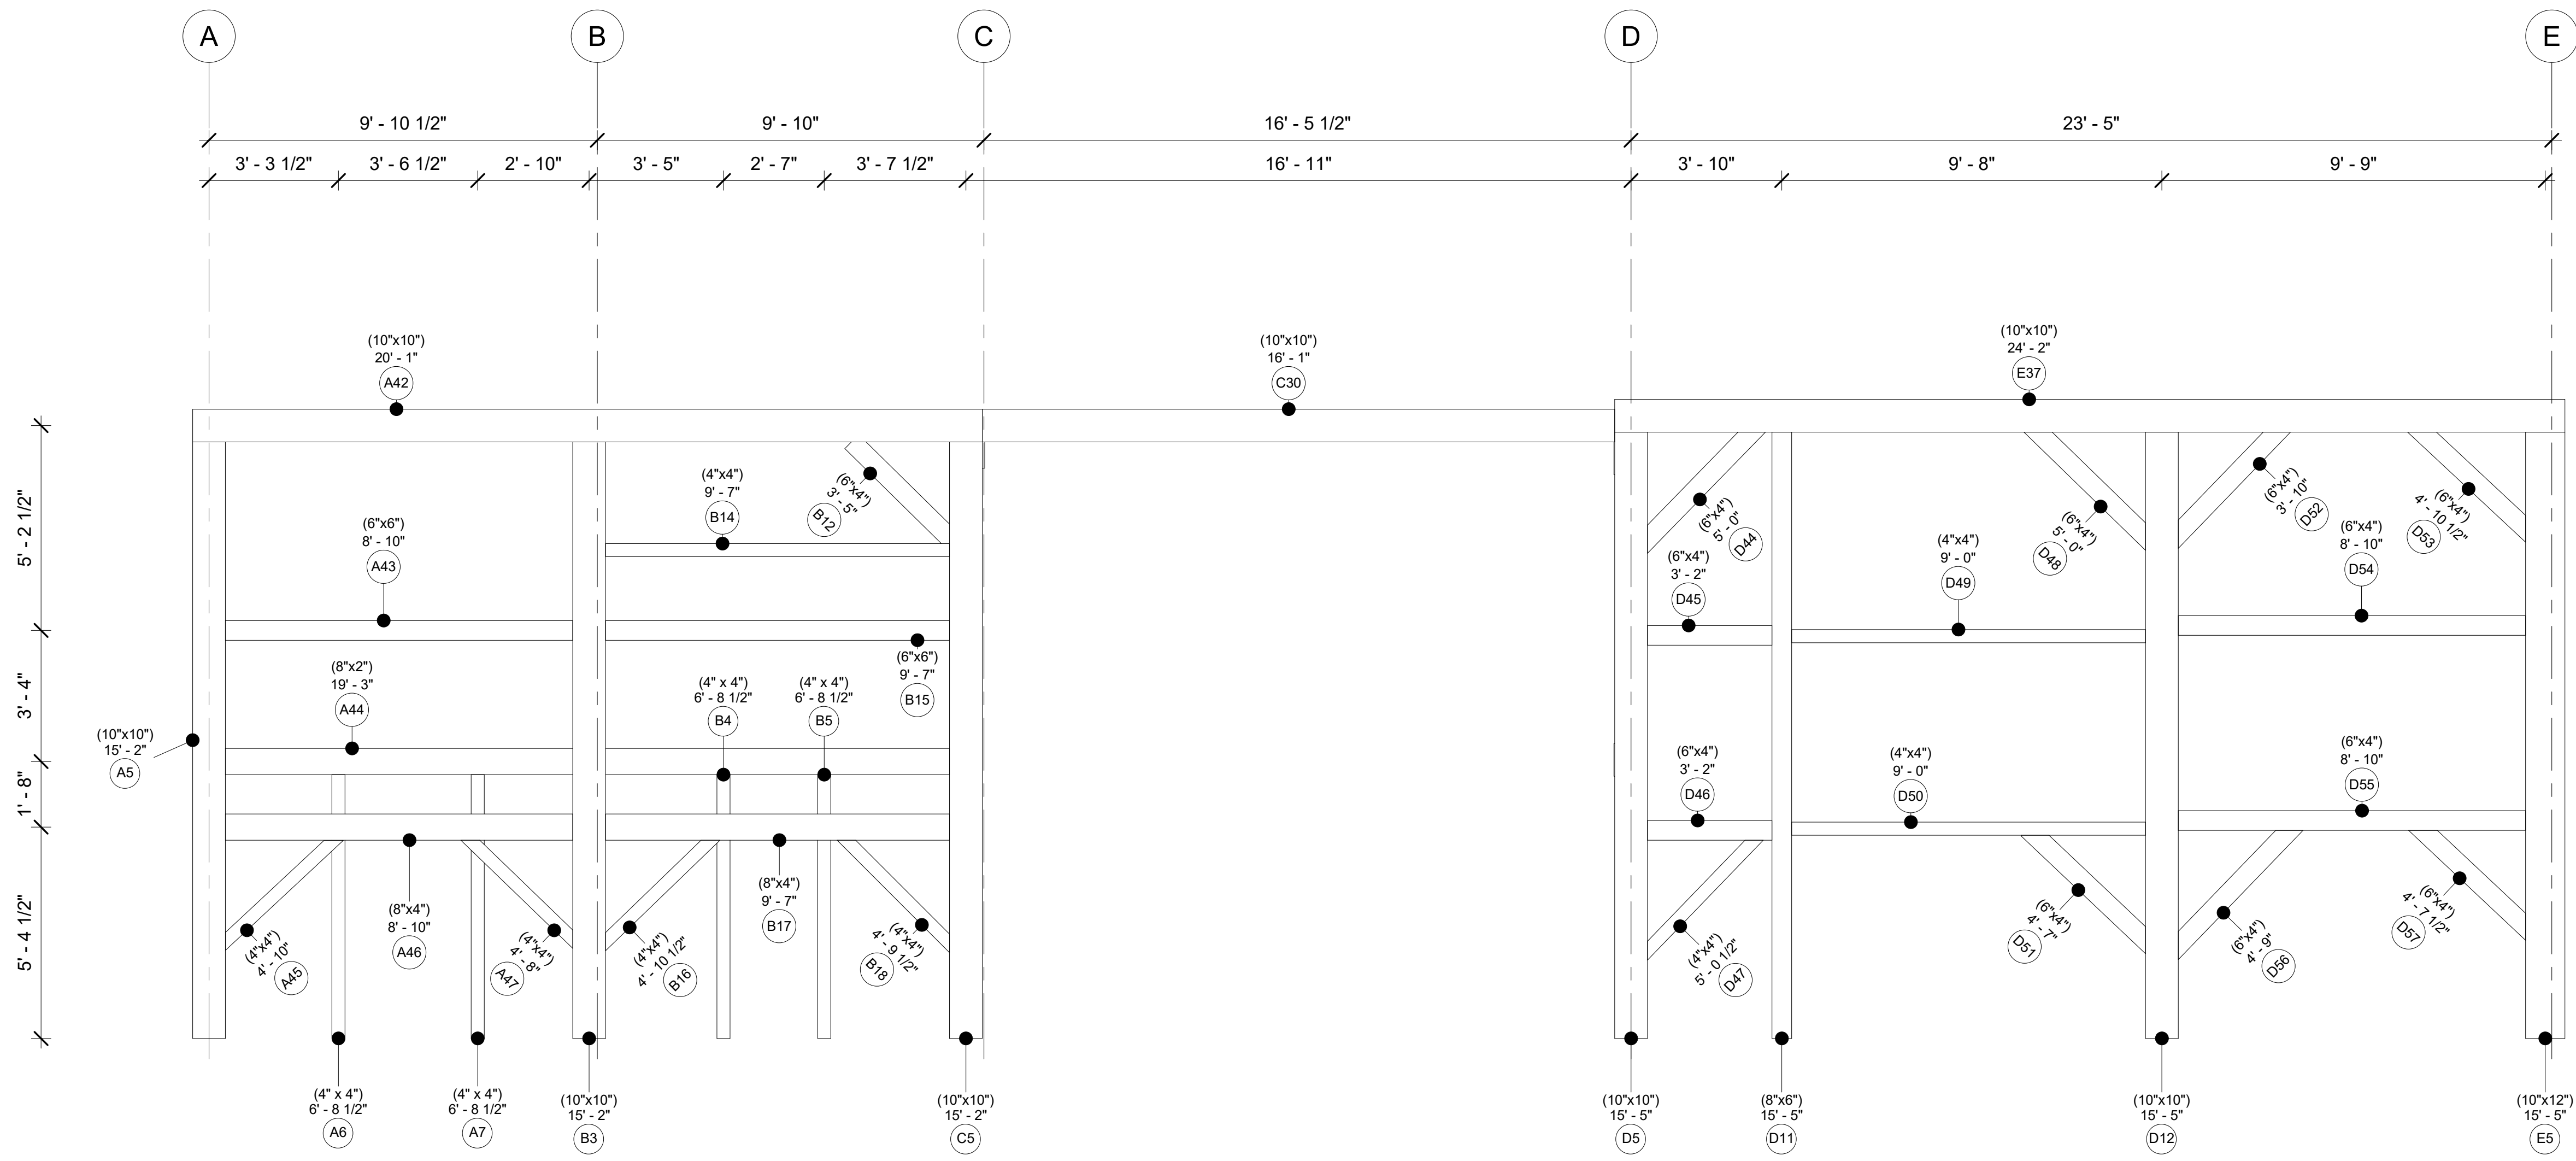

Settler's Ridge

Bent 5

Project Number	Project 12
Date	20250505
Drawn By	
Checked By	

A111

Scale 3/8" = 1'-0"