


PROJECT: Hard Roads End  
SCOPE: AS BUILT DRAWINGS

**Timber  
Home  
Services LLC**

Hard Roads end

**DAN TRIMBLE**  
AA66 / TIMBER HOME SERVICES  
CELL PHONE/TEXT - 412-309-1161

EMAIL:  
[DANTRIMBLE@TIMBERHOMESERVICES.COM](mailto:DANTRIMBLE@TIMBERHOMESERVICES.COM)

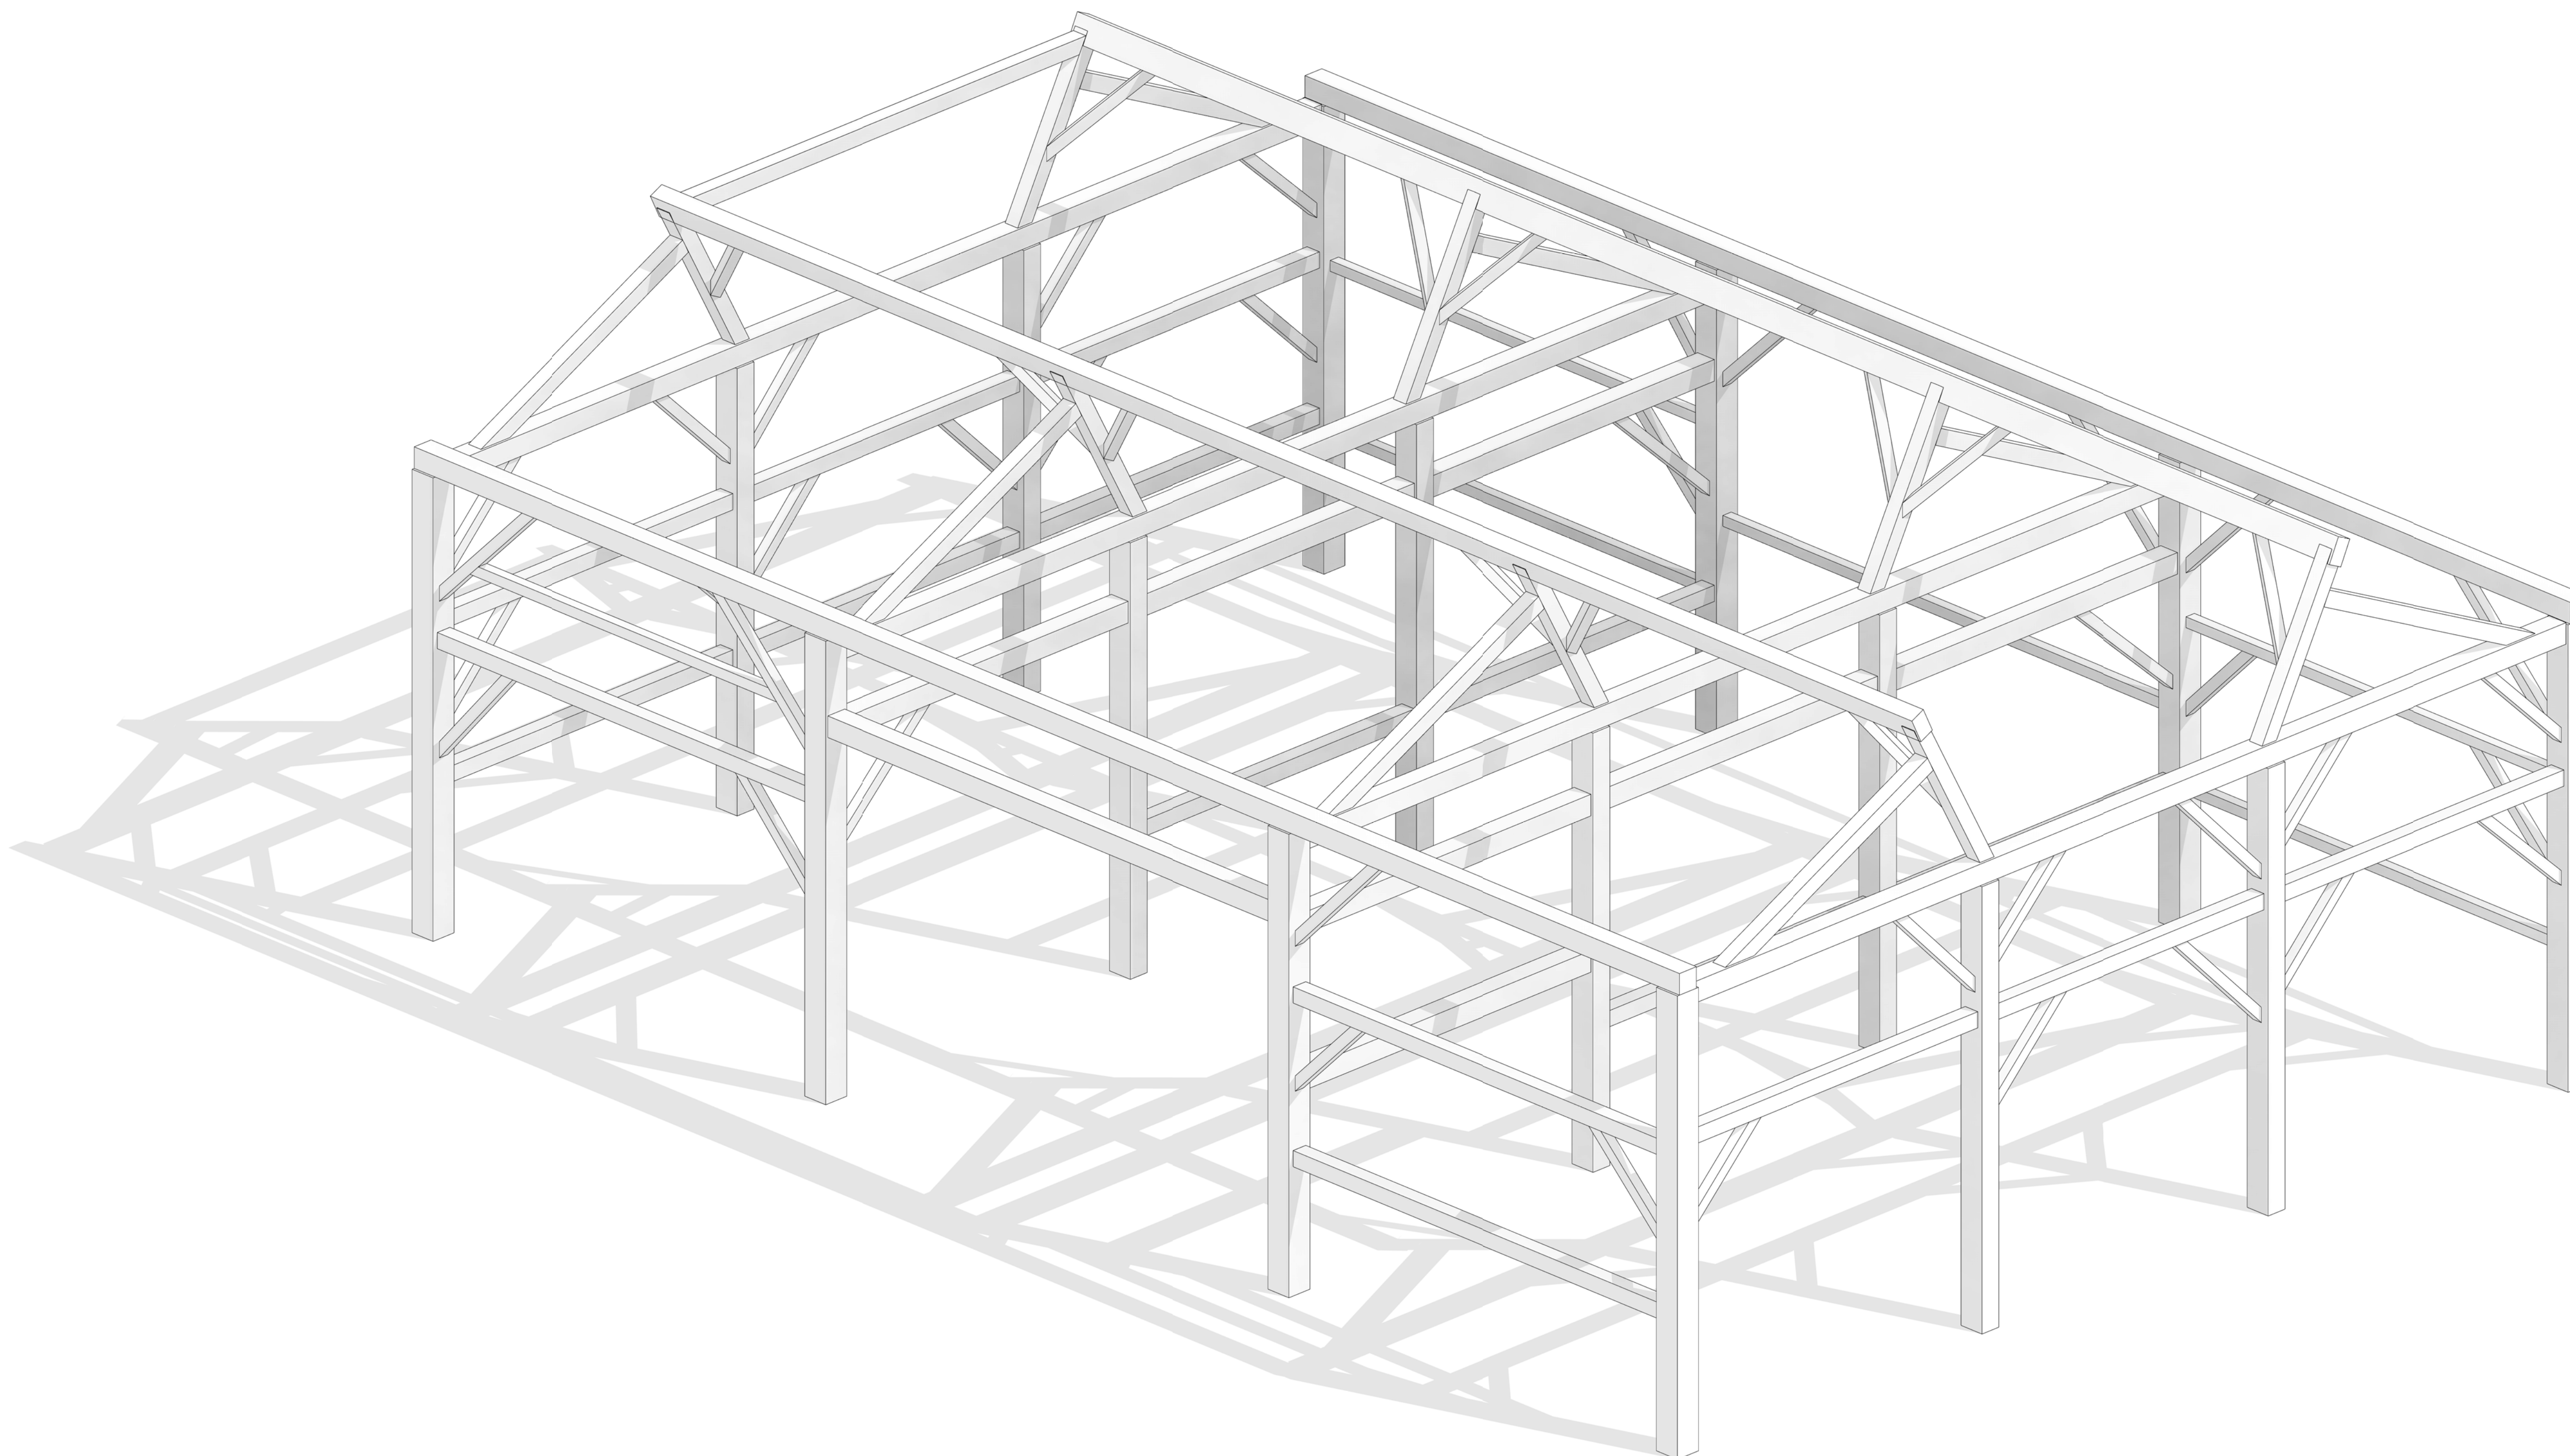

Cover Page

Project Number	Project 13
Date	20250510
Drawn By	
Checked By	

**A101**

Scale

# Timber Home Services LLC

Hard Roads end

**DAN TRIMBLE**  
AA66 / TIMBER HOME SERVICES  
CELL PHONE/TEXT - 412-309-1161


EMAIL:  
DANTRIMBLE@TIMBERHOMESERVICES.COM

## Floor Plan

Project Number	Project 13
Date	20250510
Drawn By	
Checked By	

# A102

Scale 3/8" = 1'-0"

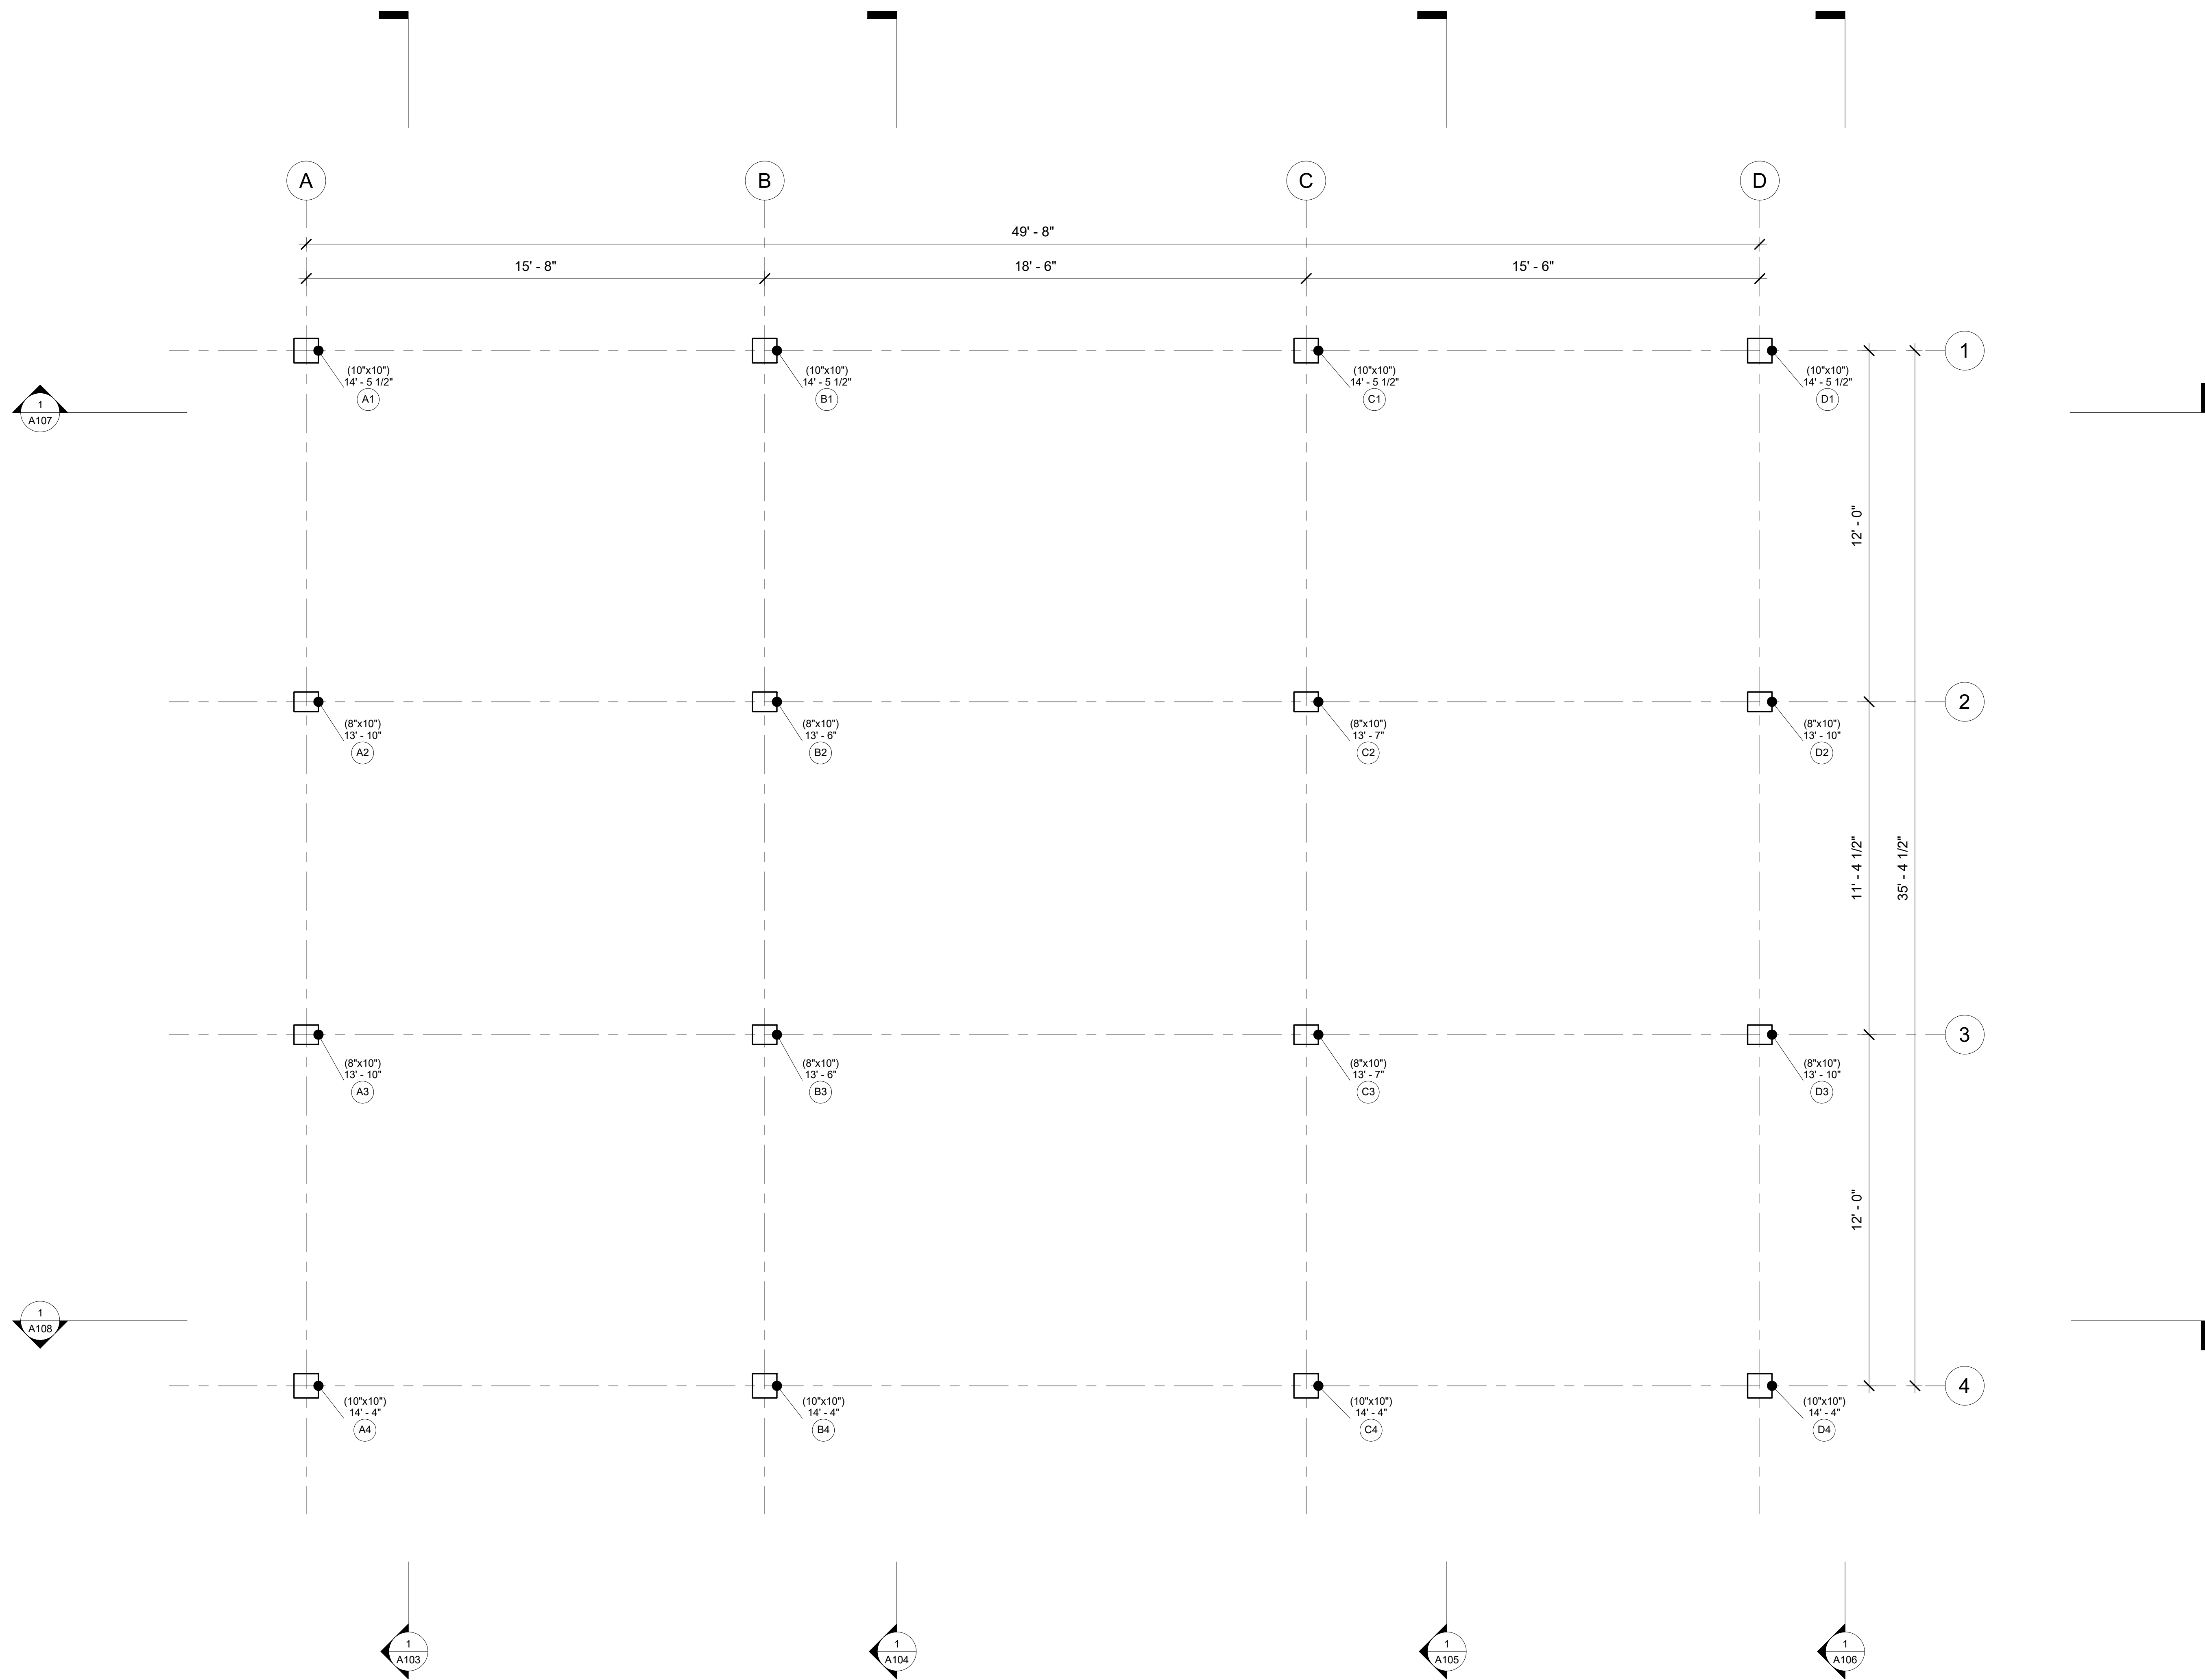


# Timber Home Services LLC

Hard Roads end

**DAN TRIMBLE**  
AA66 / TIMBER HOME SERVICES  
CELL PHONE/TEXT - 412-309-1161

EMAIL:  
DANTRIMBLE@TIMBERHOMESERVICES.COM

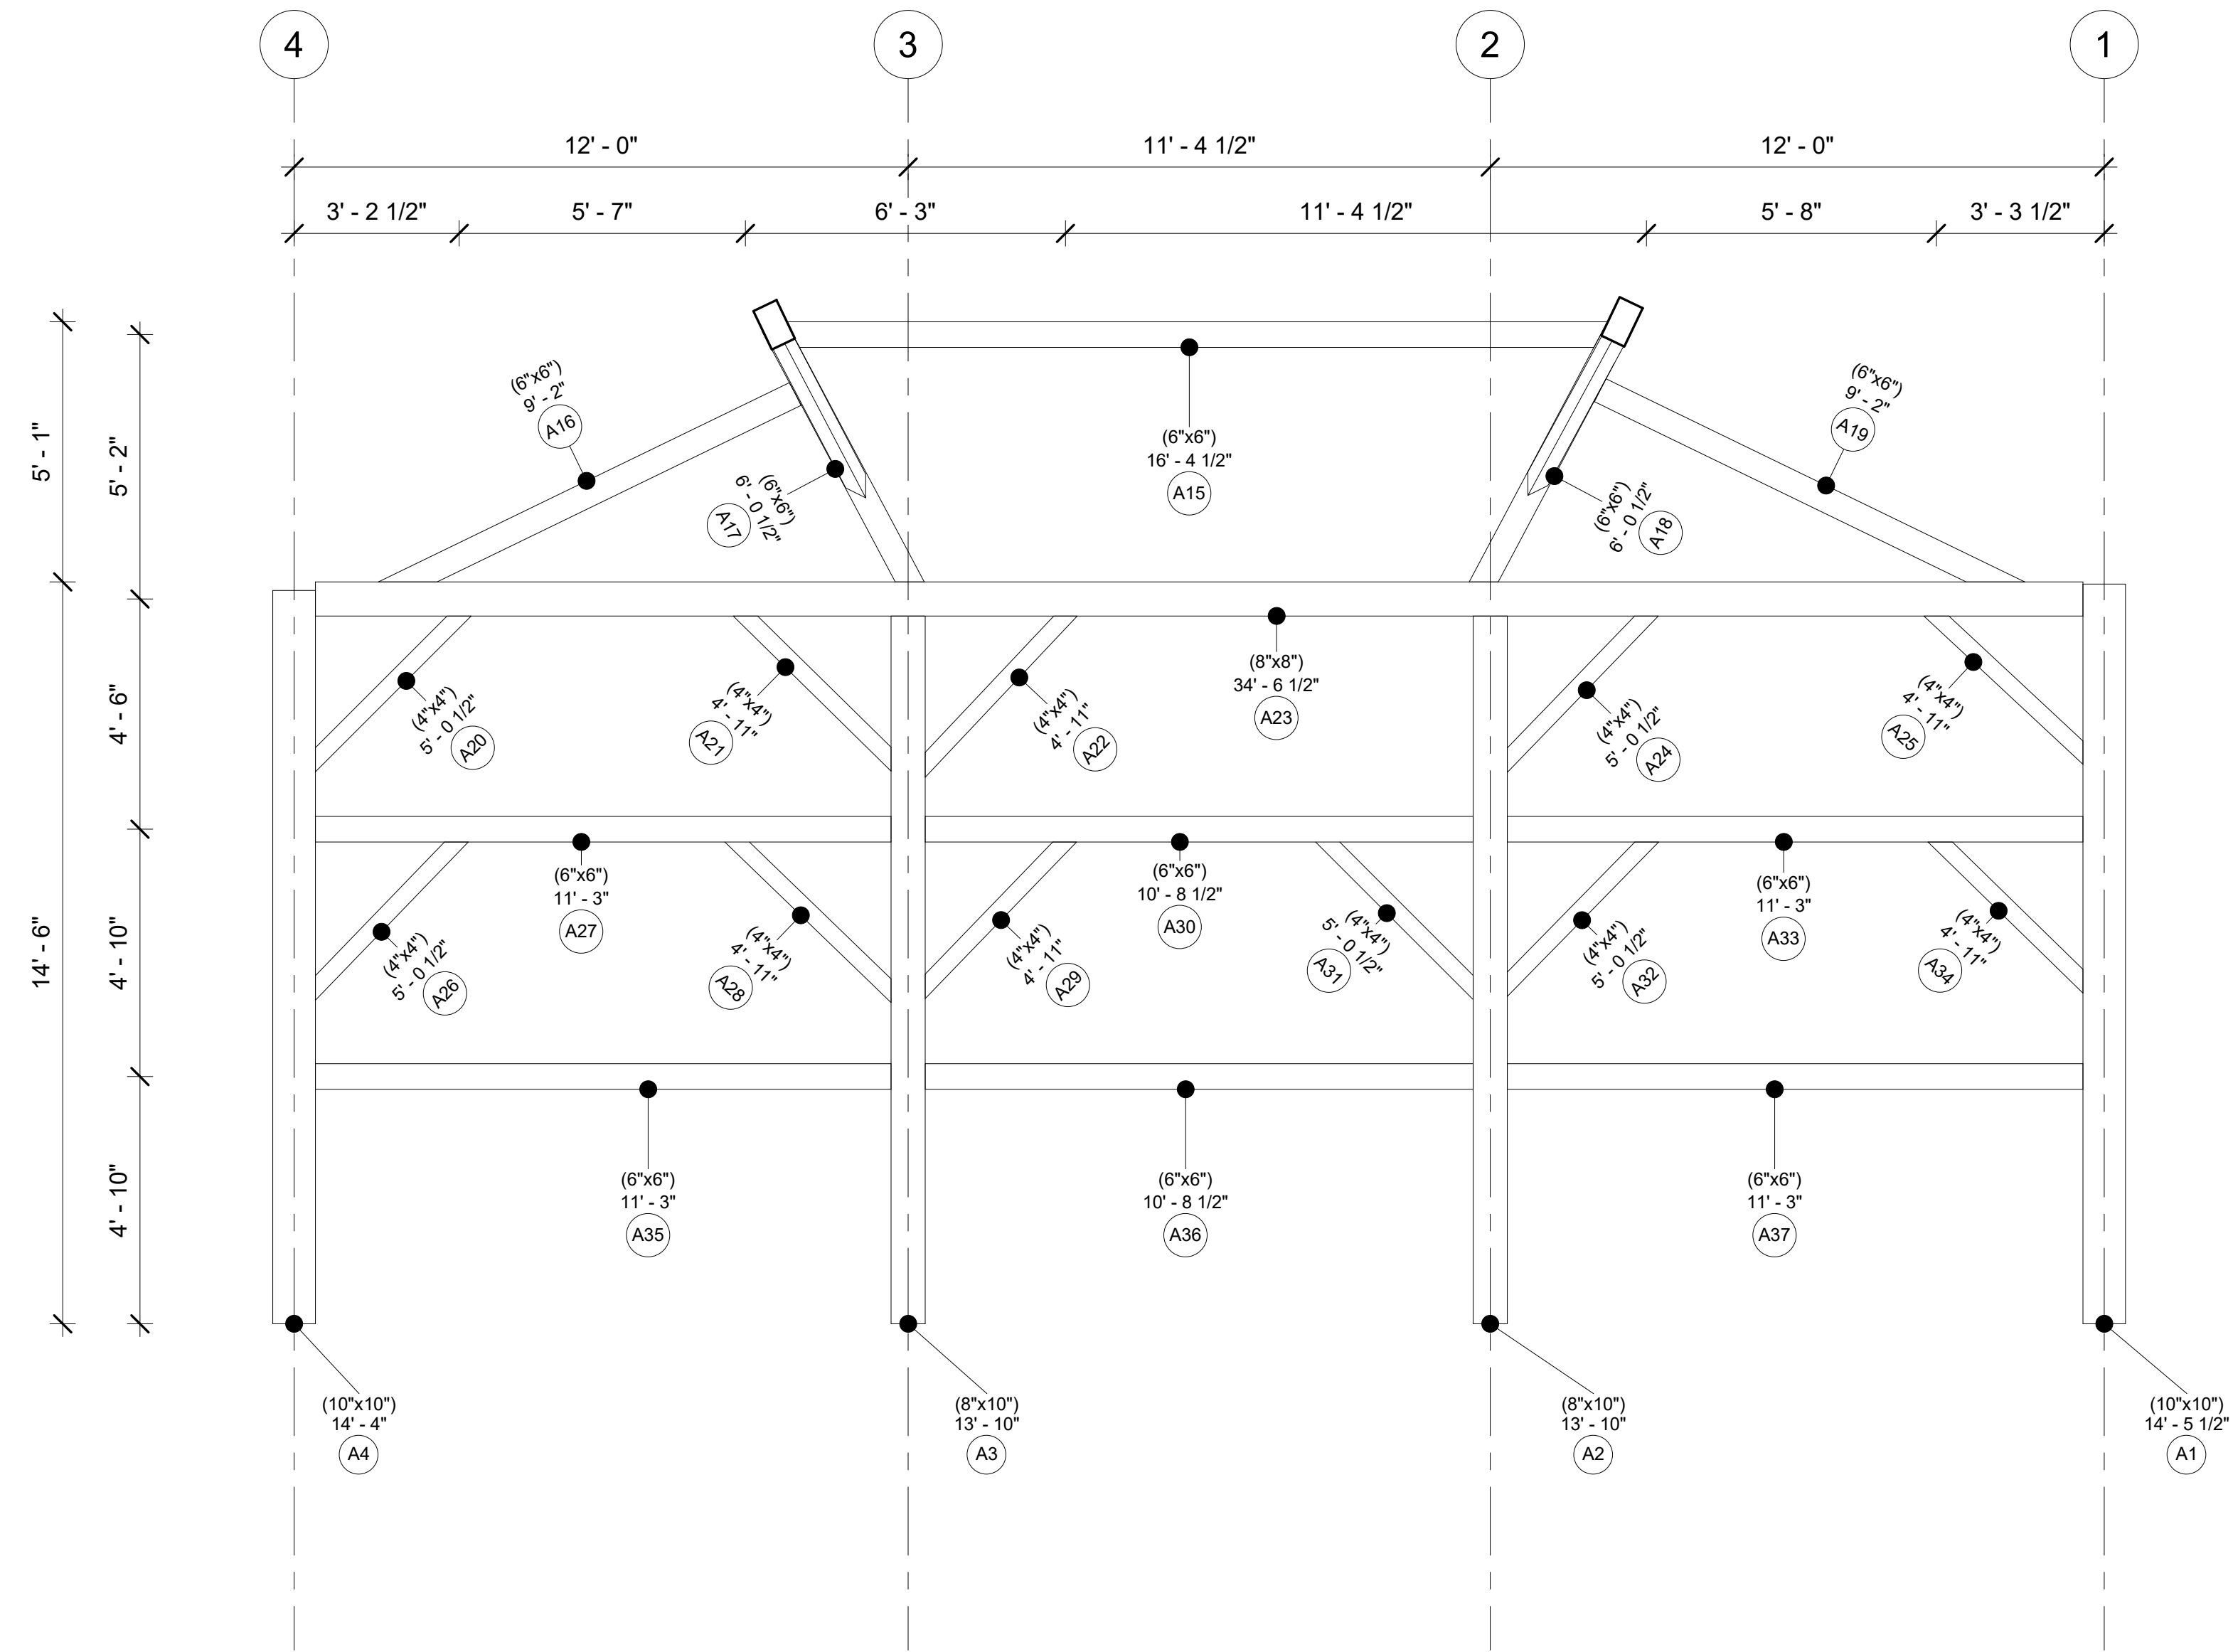

## Bent A

Project Number Project 13  
Date 20250510  
Drawn By  
Checked By

# A103


Scale 3/8" = 1'-0"

# Timber Home Services LLC

Hard Roads end

**DAN TRIMBLE**  
AA66 / TIMBER HOME SERVICES  
CELL PHONE/TEXT - 412-309-1161

EMAIL:  
DANTRIMBLE@TIMBERHOMESERVICES.COM

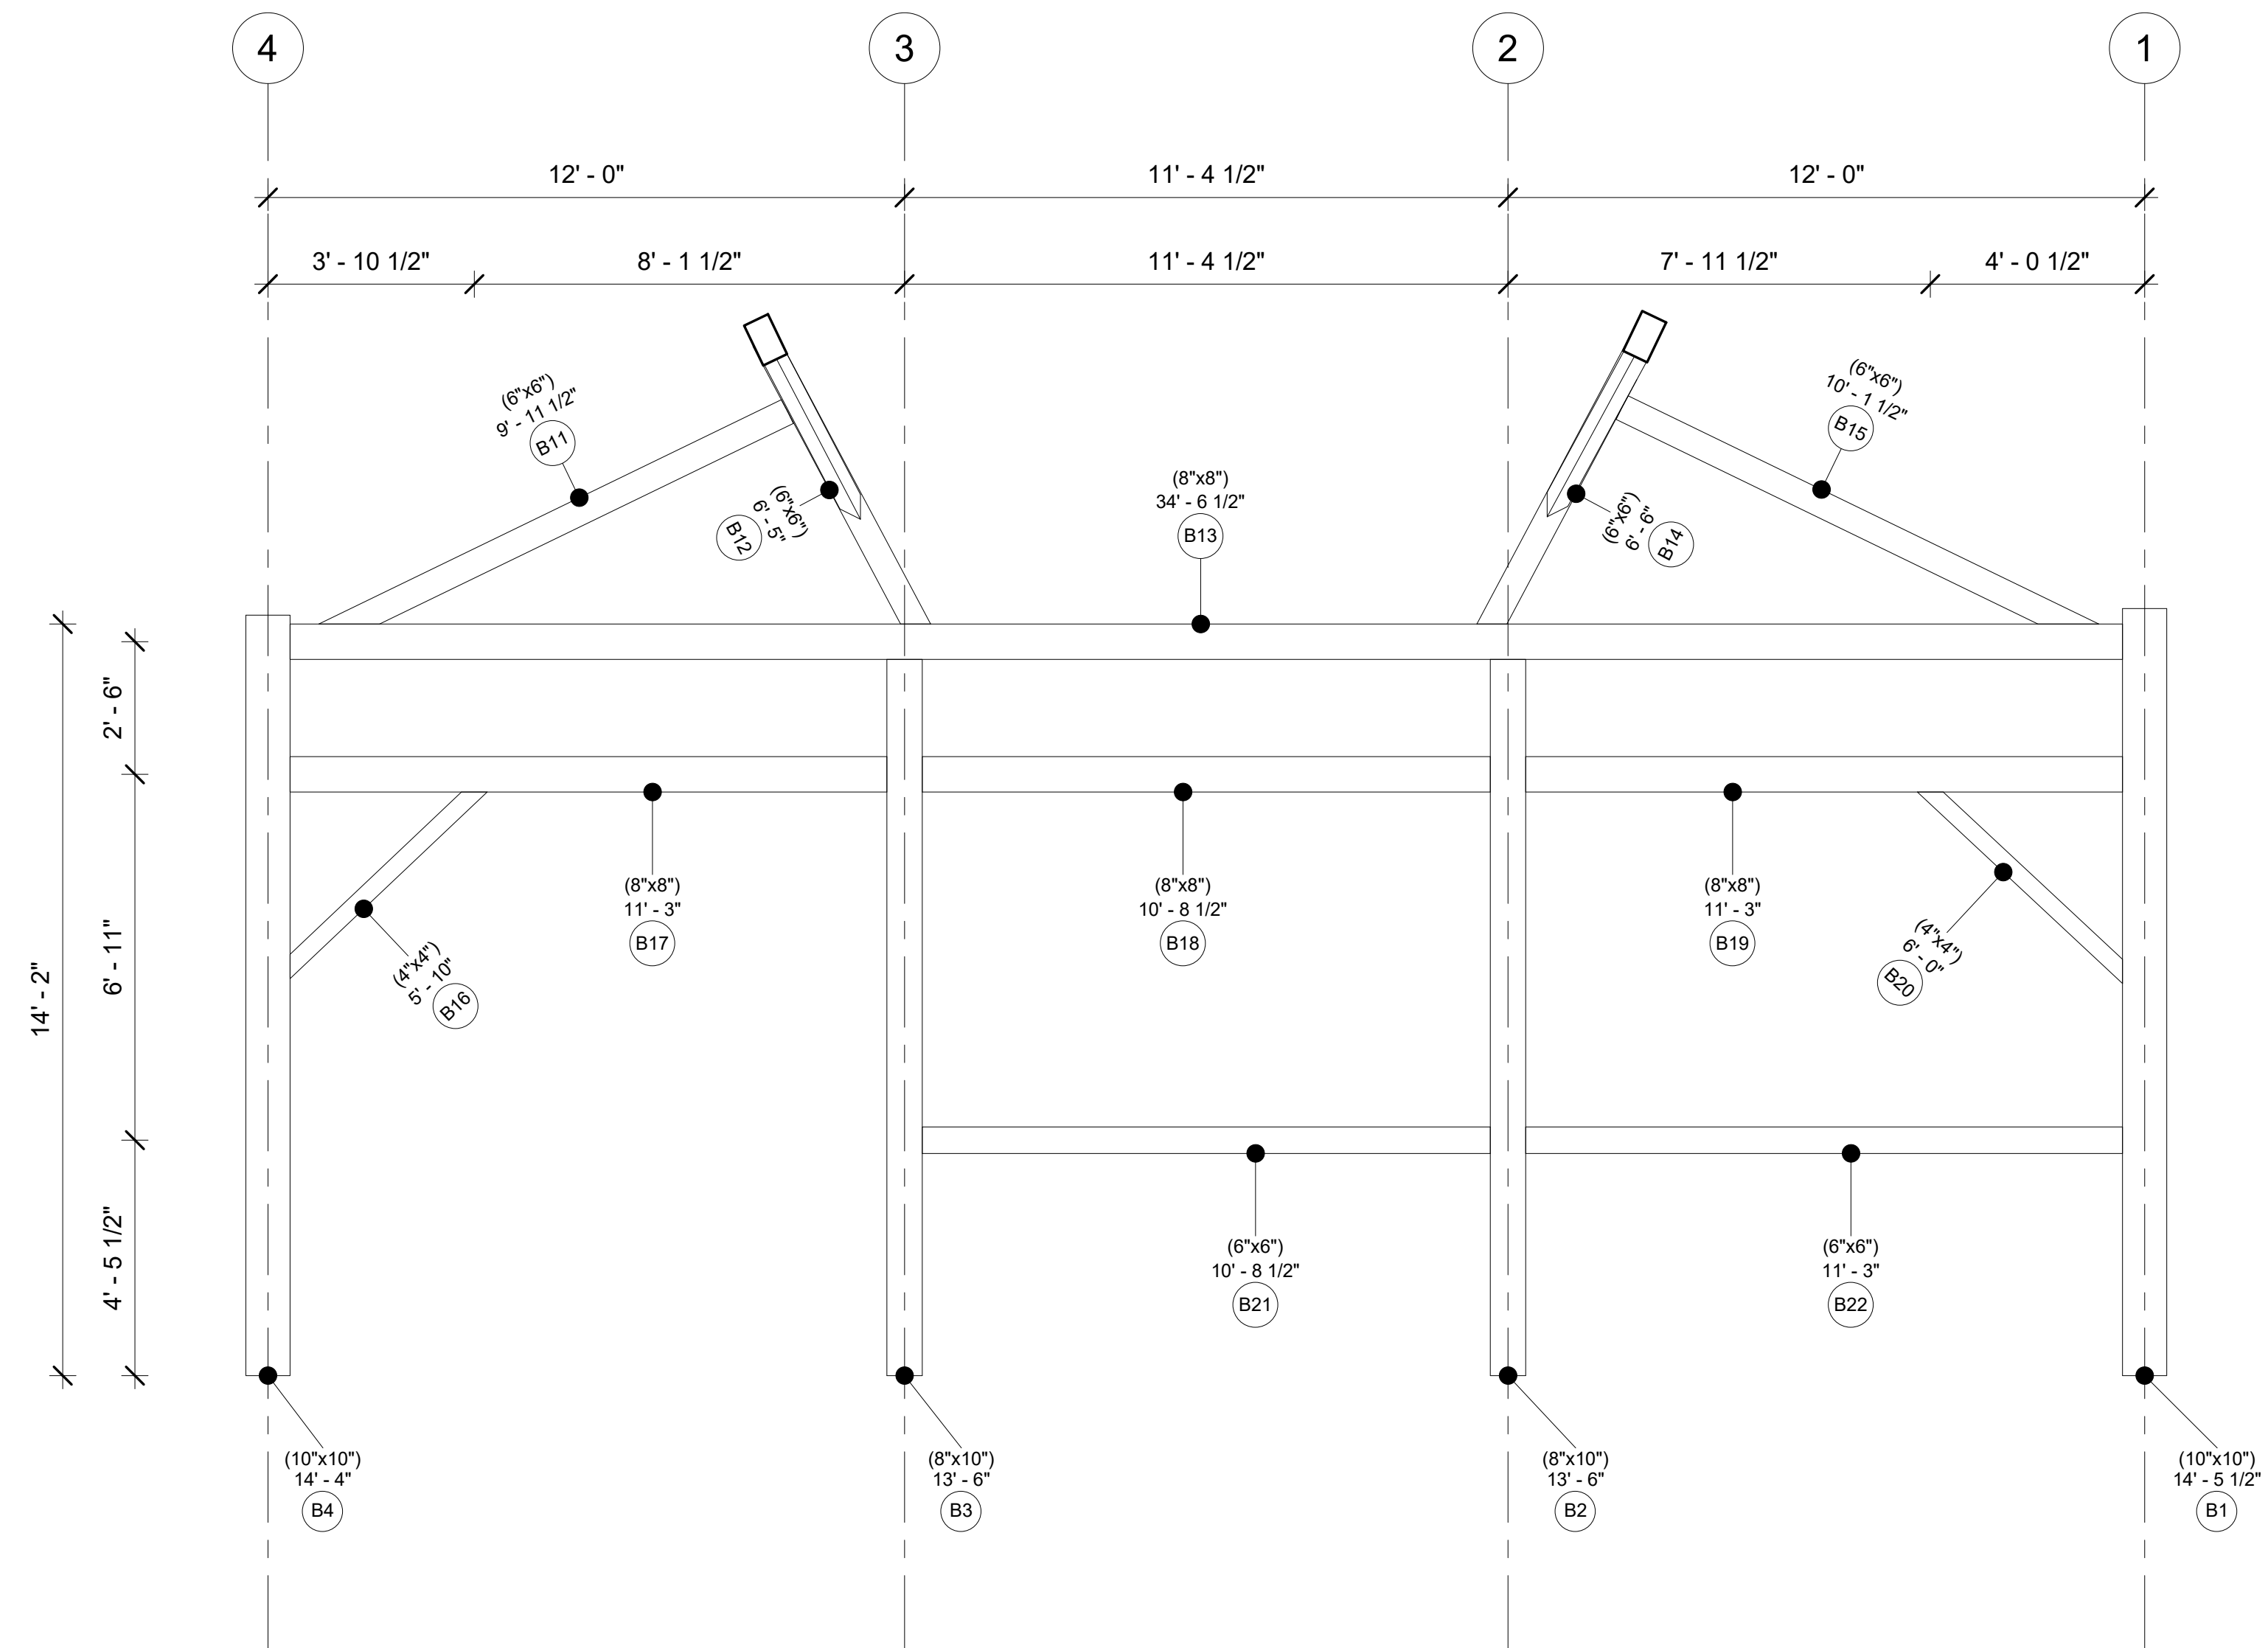

## Bent B

Project Number Project 13  
Date 20250510  
Drawn By  
Checked By

# A104


Scale 3/8" = 1'-0"

# Timber Home Services LLC

Hard Roads end

**DAN TRIMBLE**  
AA66 / TIMBER HOME SERVICES  
CELL PHONE/TEXT - 412-309-1161

EMAIL:  
DANTRIMBLE@TIMBERHOMESERVICES.COM

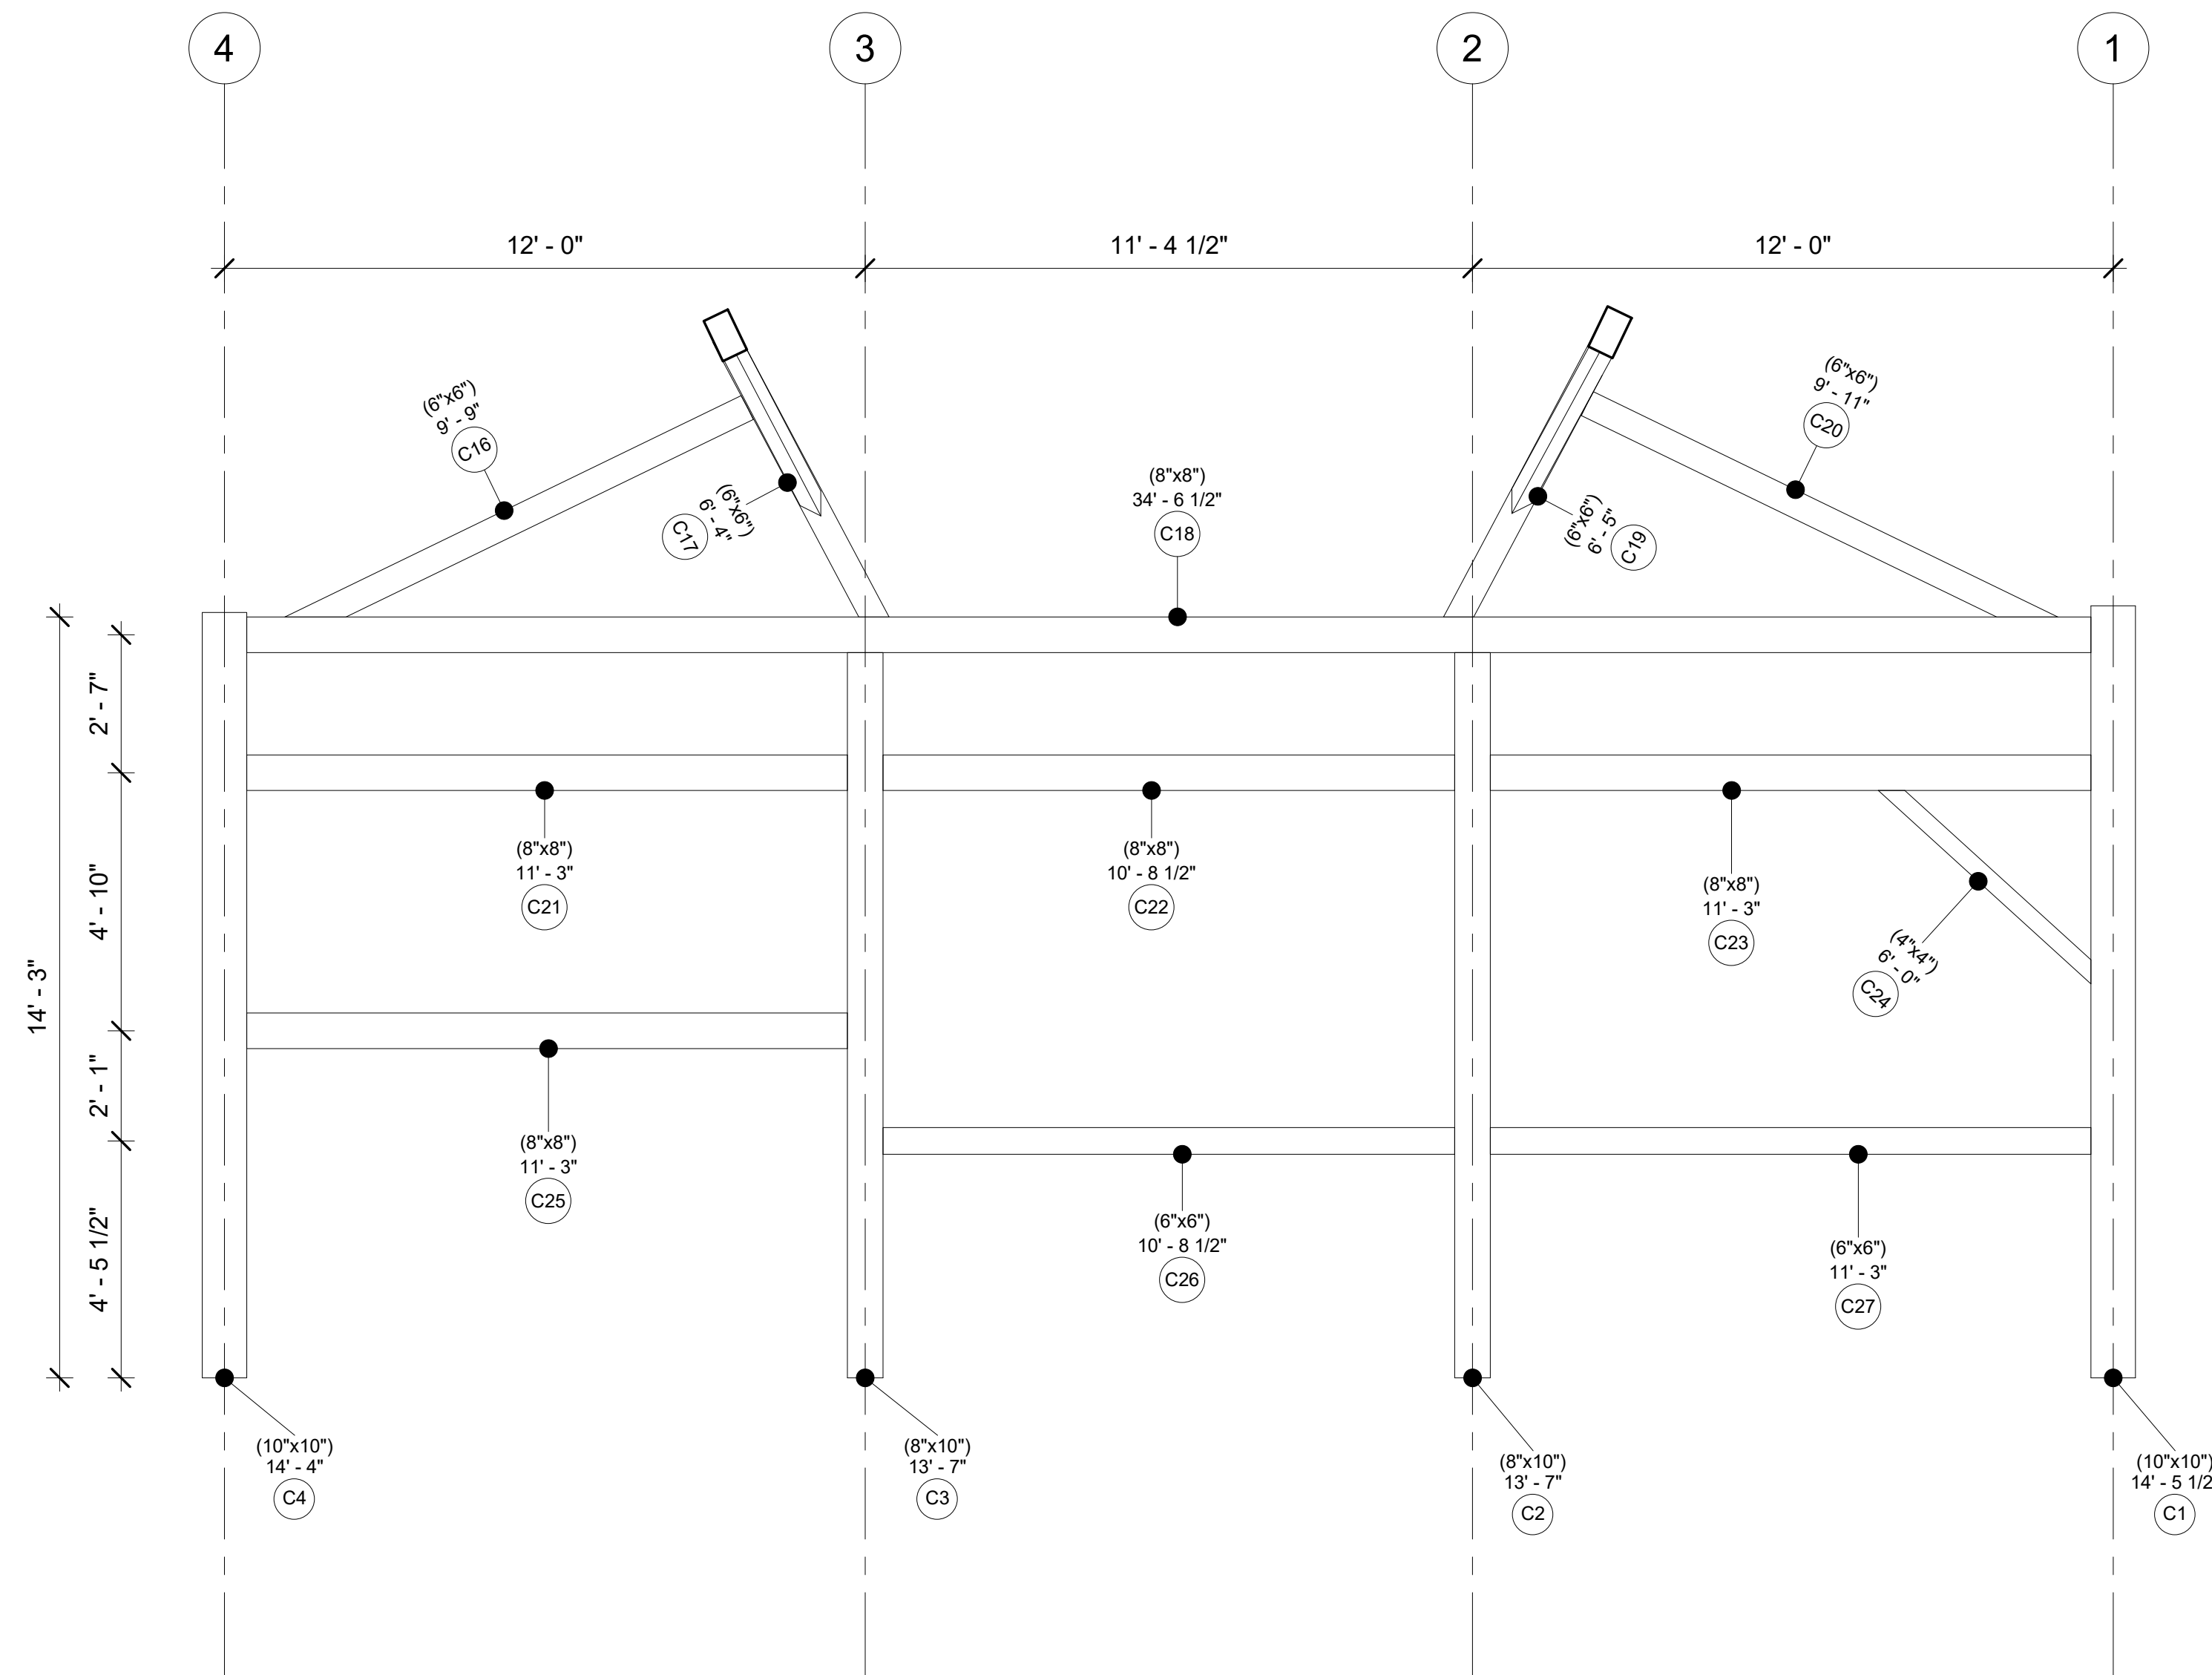

## Bent C

Project Number Project 13  
Date 20250510  
Drawn By  
Checked By

# A105


Scale 3/8" = 1'-0"

# Timber Home Services LLC

Hard Roads end

**DAN TRIMBLE**  
AA66 / TIMBER HOME SERVICES  
CELL PHONE/TEXT - 412-309-1161

EMAIL:  
DANTRIMBLE@TIMBERHOMESERVICES.COM

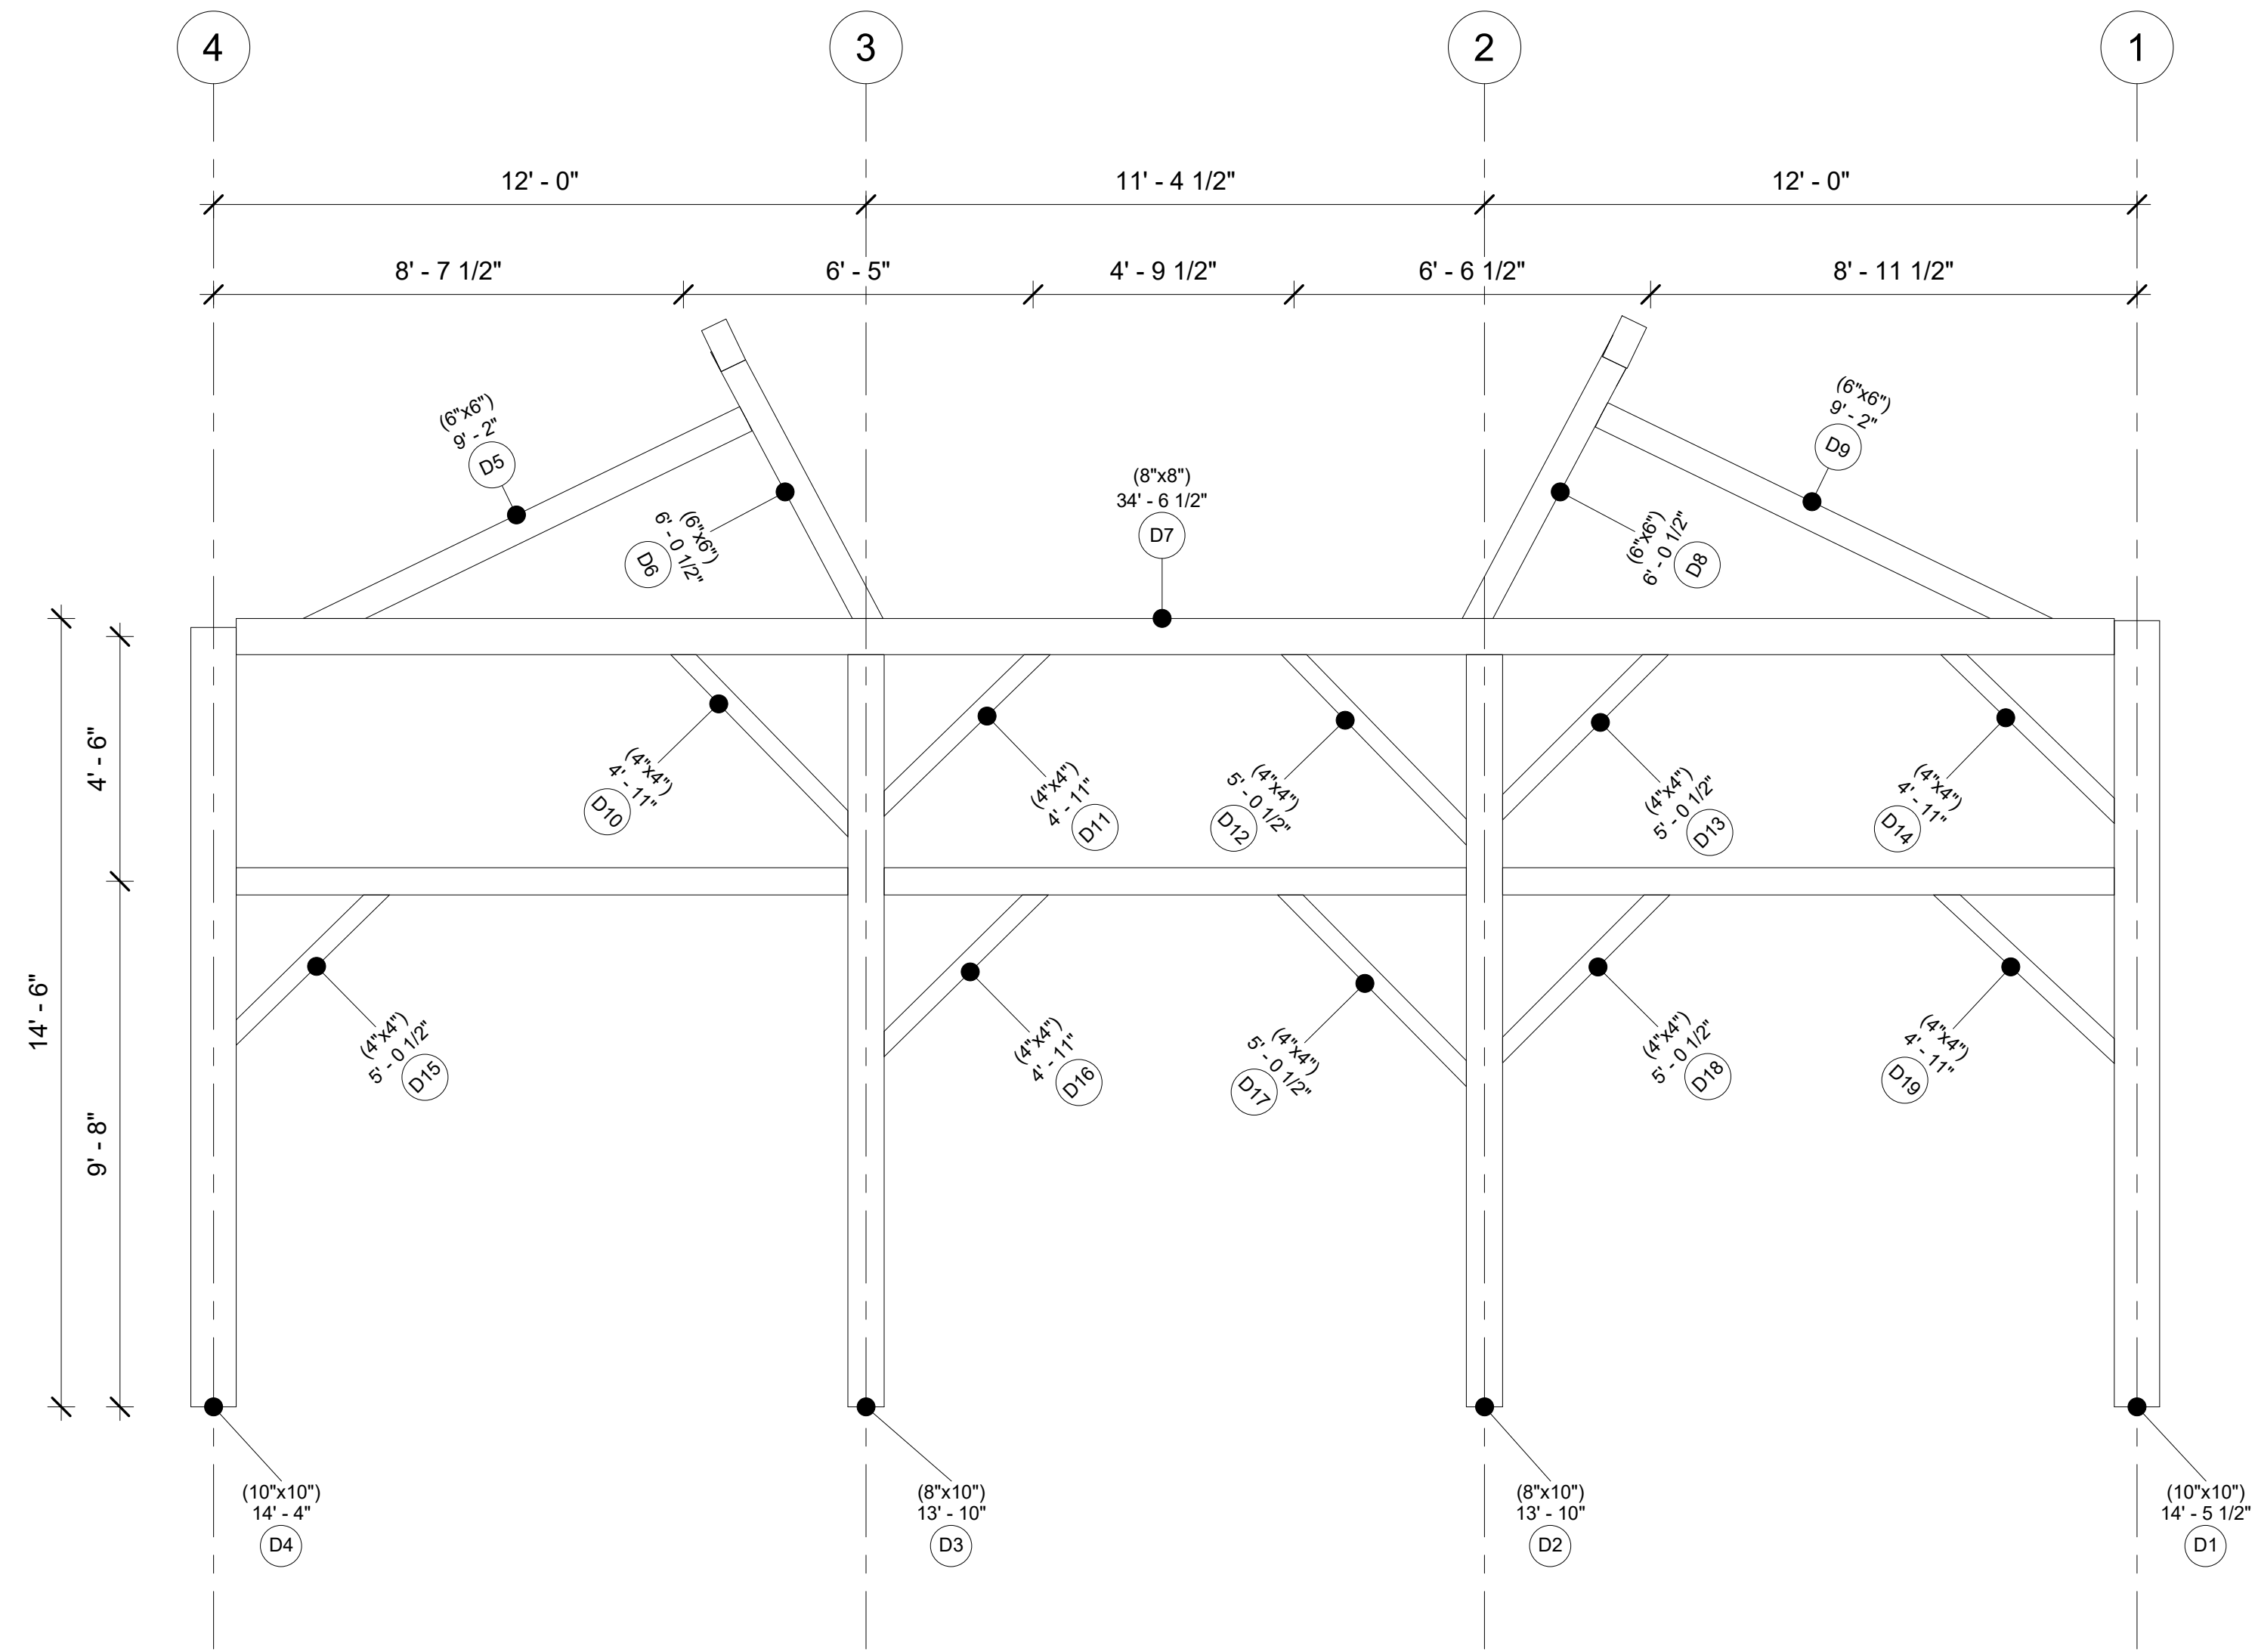

## Bent D

Project Number	Project 13
Date	20250510
Drawn By	
Checked By	

# A106


Scale 3/8" = 1'-0"

# Timber Home Services LLC

Hard Roads end

**DAN TRIMBLE**  
AA66 / TIMBER HOME SERVICES  
CELL PHONE/TEXT - 412-309-1161

EMAIL:  
DANTRIMBLE@TIMBERHOMESERVICES.COM

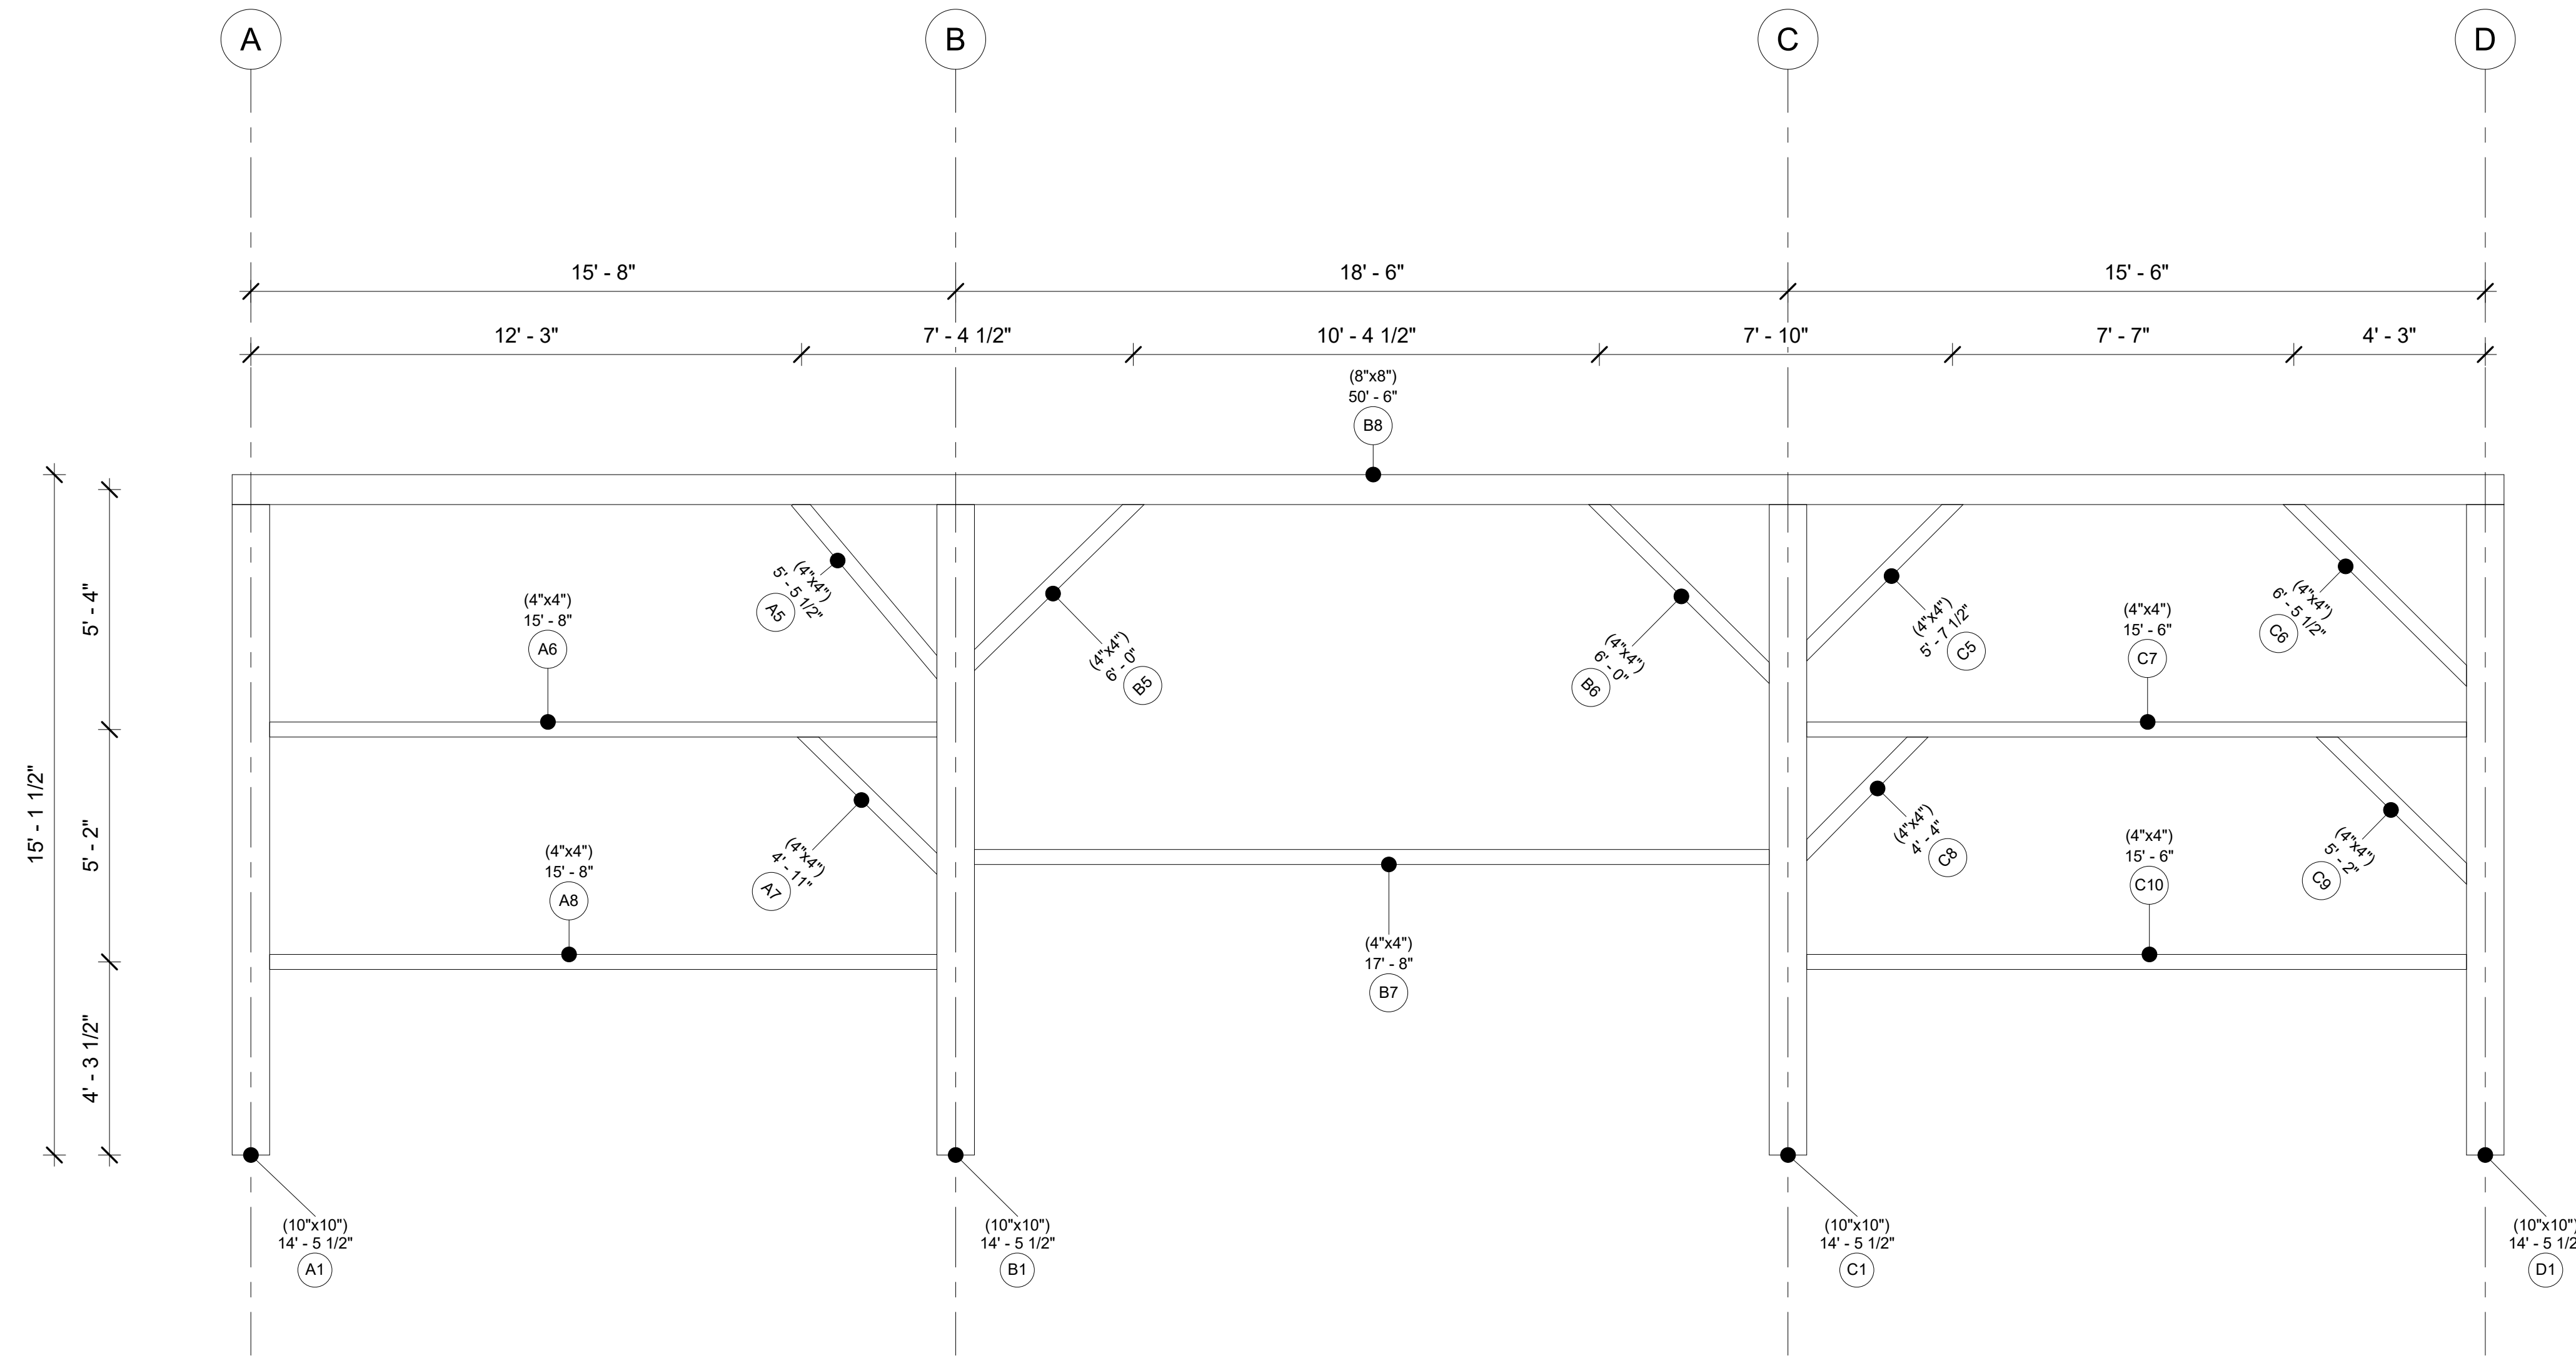

## Bent 1

Project Number Project 13  
Date 20250510  
Drawn By  
Checked By

# A107


Scale 3/8" = 1'-0"

# Timber Home Services LLC

Hard Roads end

**DAN TRIMBLE**  
AA66 / TIMBER HOME SERVICES  
CELL PHONE/TEXT - 412-309-1161

EMAIL:  
DANTRIMBLE@TIMBERHOMESERVICES.COM

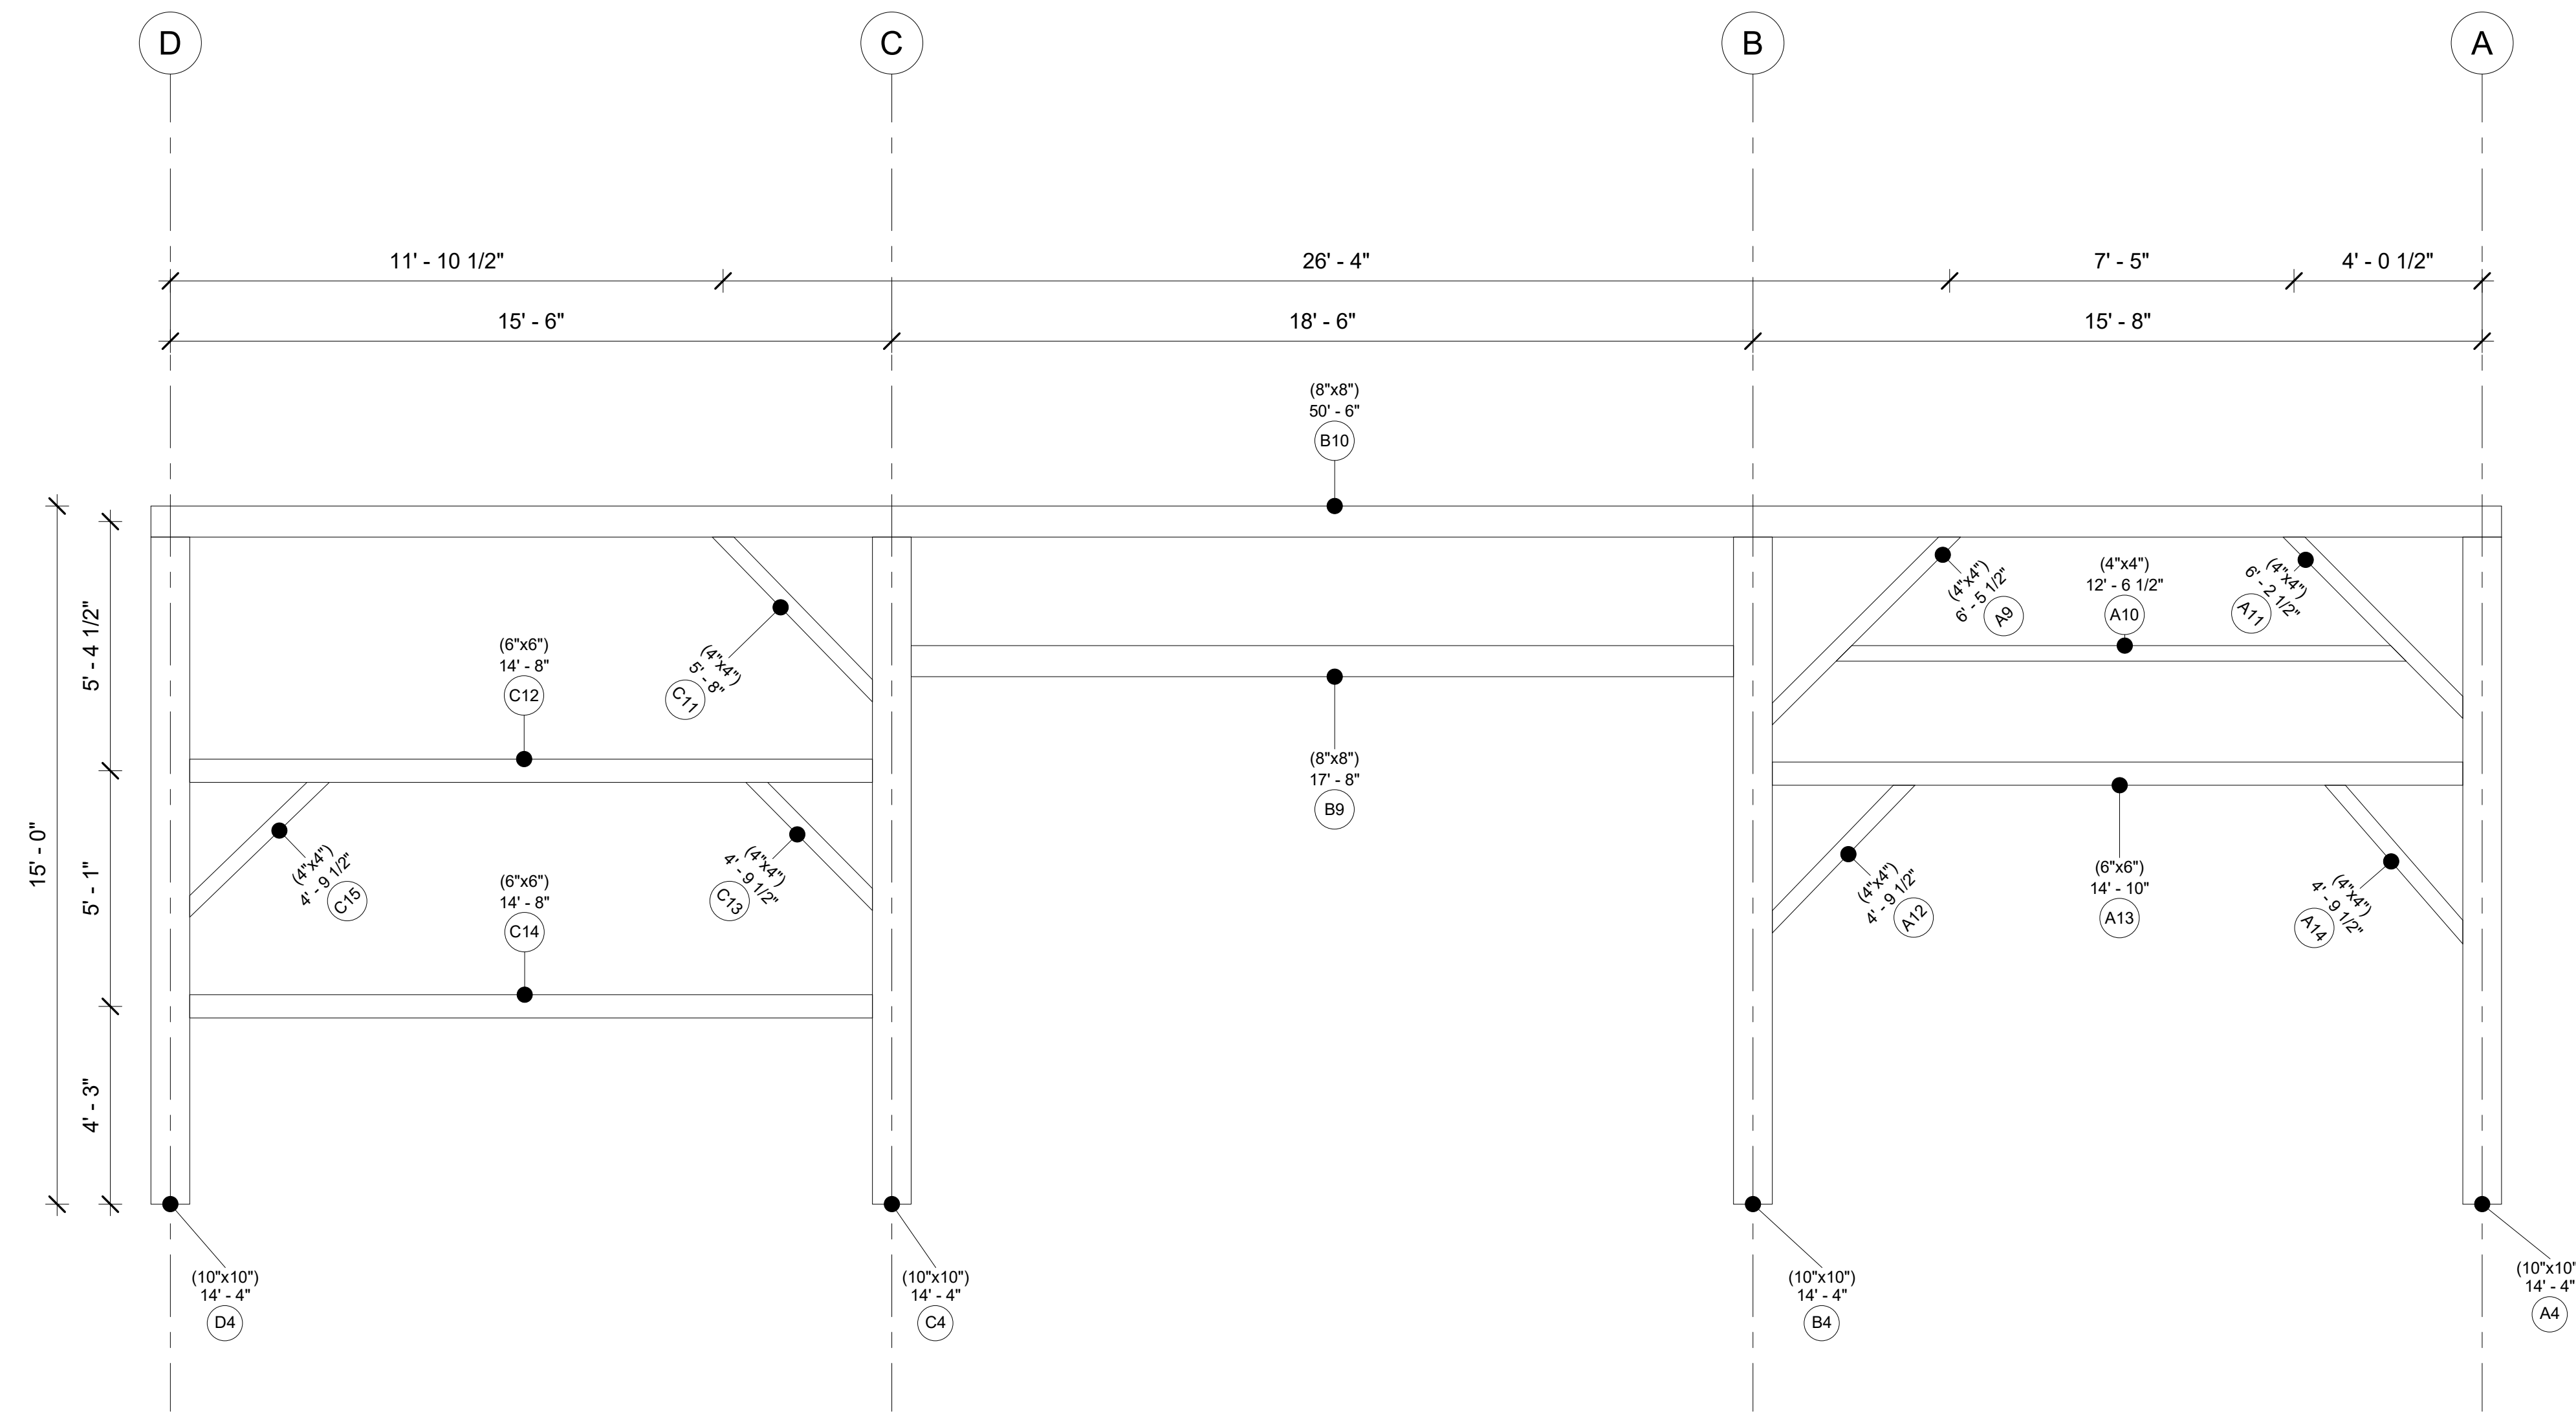

## Bent 4

Project Number Project 13  
Date 20250510  
Drawn By  
Checked By

# A108

Scale 3/8" = 1'-0"