


PROJECT: Little Gap Station  
SCOPE: AS BUILT DRAWINGS

Timber  
Home  
Services LLC

Little Gap Station

DAN TRIMBLE  
AA66 / TIMBER HOME SERVICES  
CELL PHONE/TEXT - 412-309-1161

EMAIL:  
DANTRIMBLE@TIMBERHOMESERVICES.COM

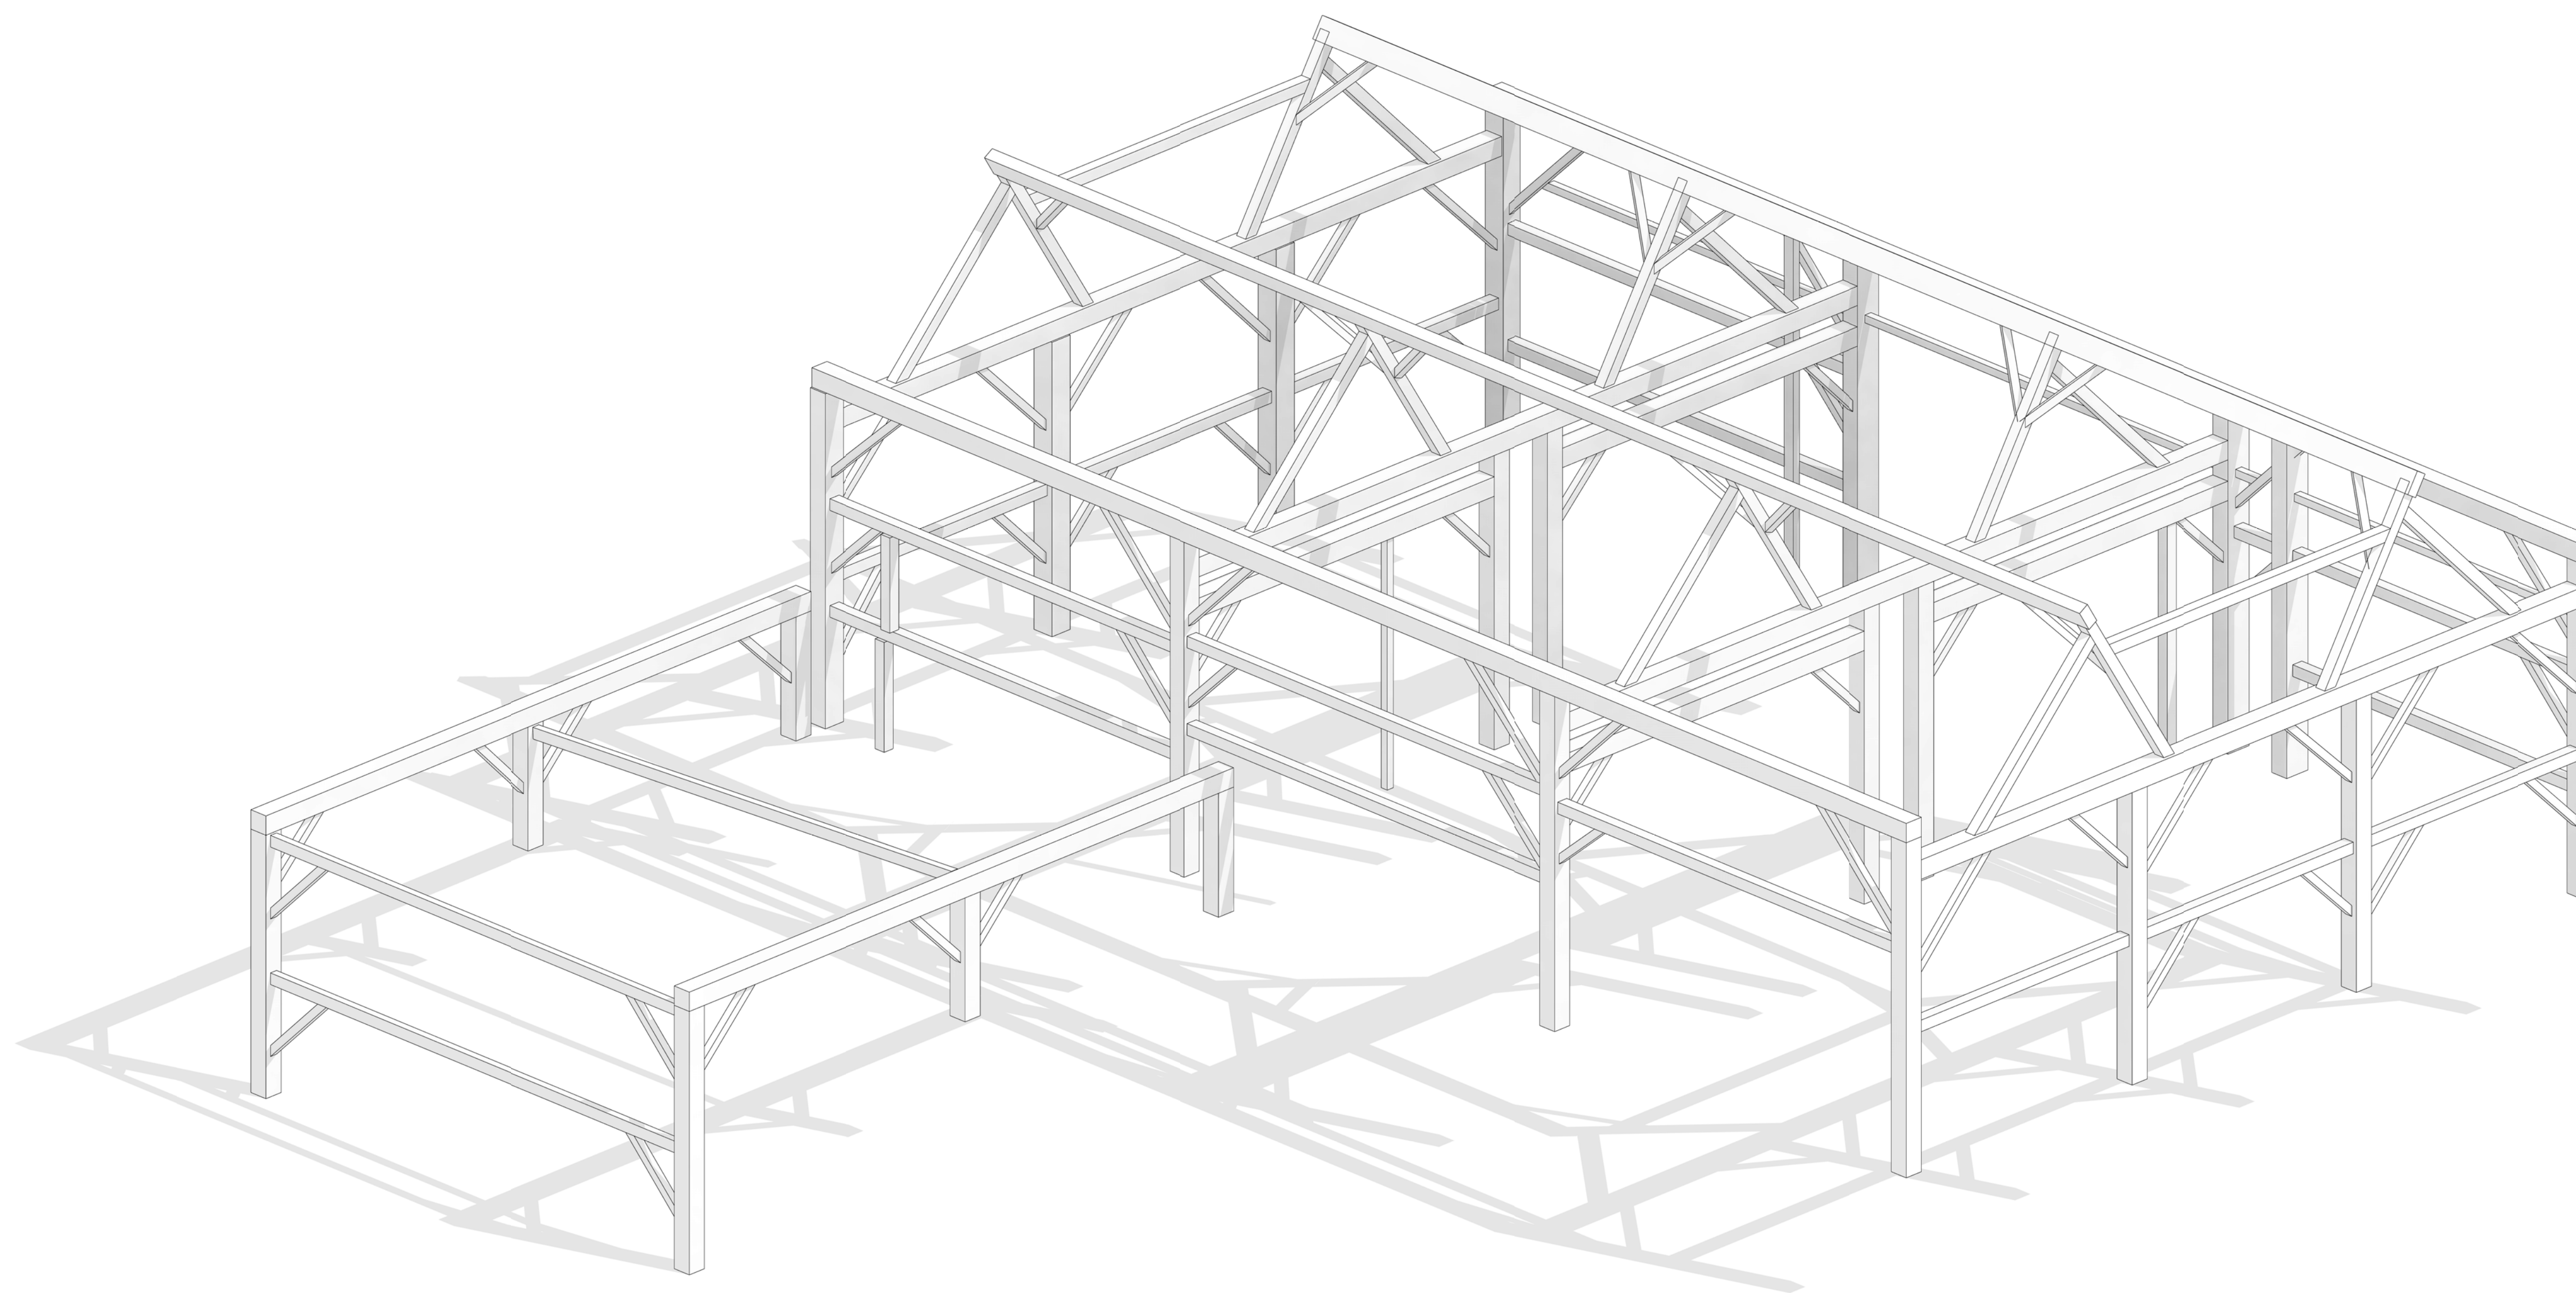

Cover Page

Project Number	Project 13
Date	20250510
Drawn By	
Checked By	

A101

Scale

# Timber Home Services LLC

Little Gap Station

DAN TRIMBLE  
AA66 / TIMBER HOME SERVICES

CELL PHONE/TEXT - 412-309-1161

EMAIL:

DANTRIMBLE@TIMBERHOMESERVICES.COM

## Floor Plan

Project Number Project 13


Date 20250510

Drawn By

Checked By

# A102

Scale 1/4" = 1'-0"

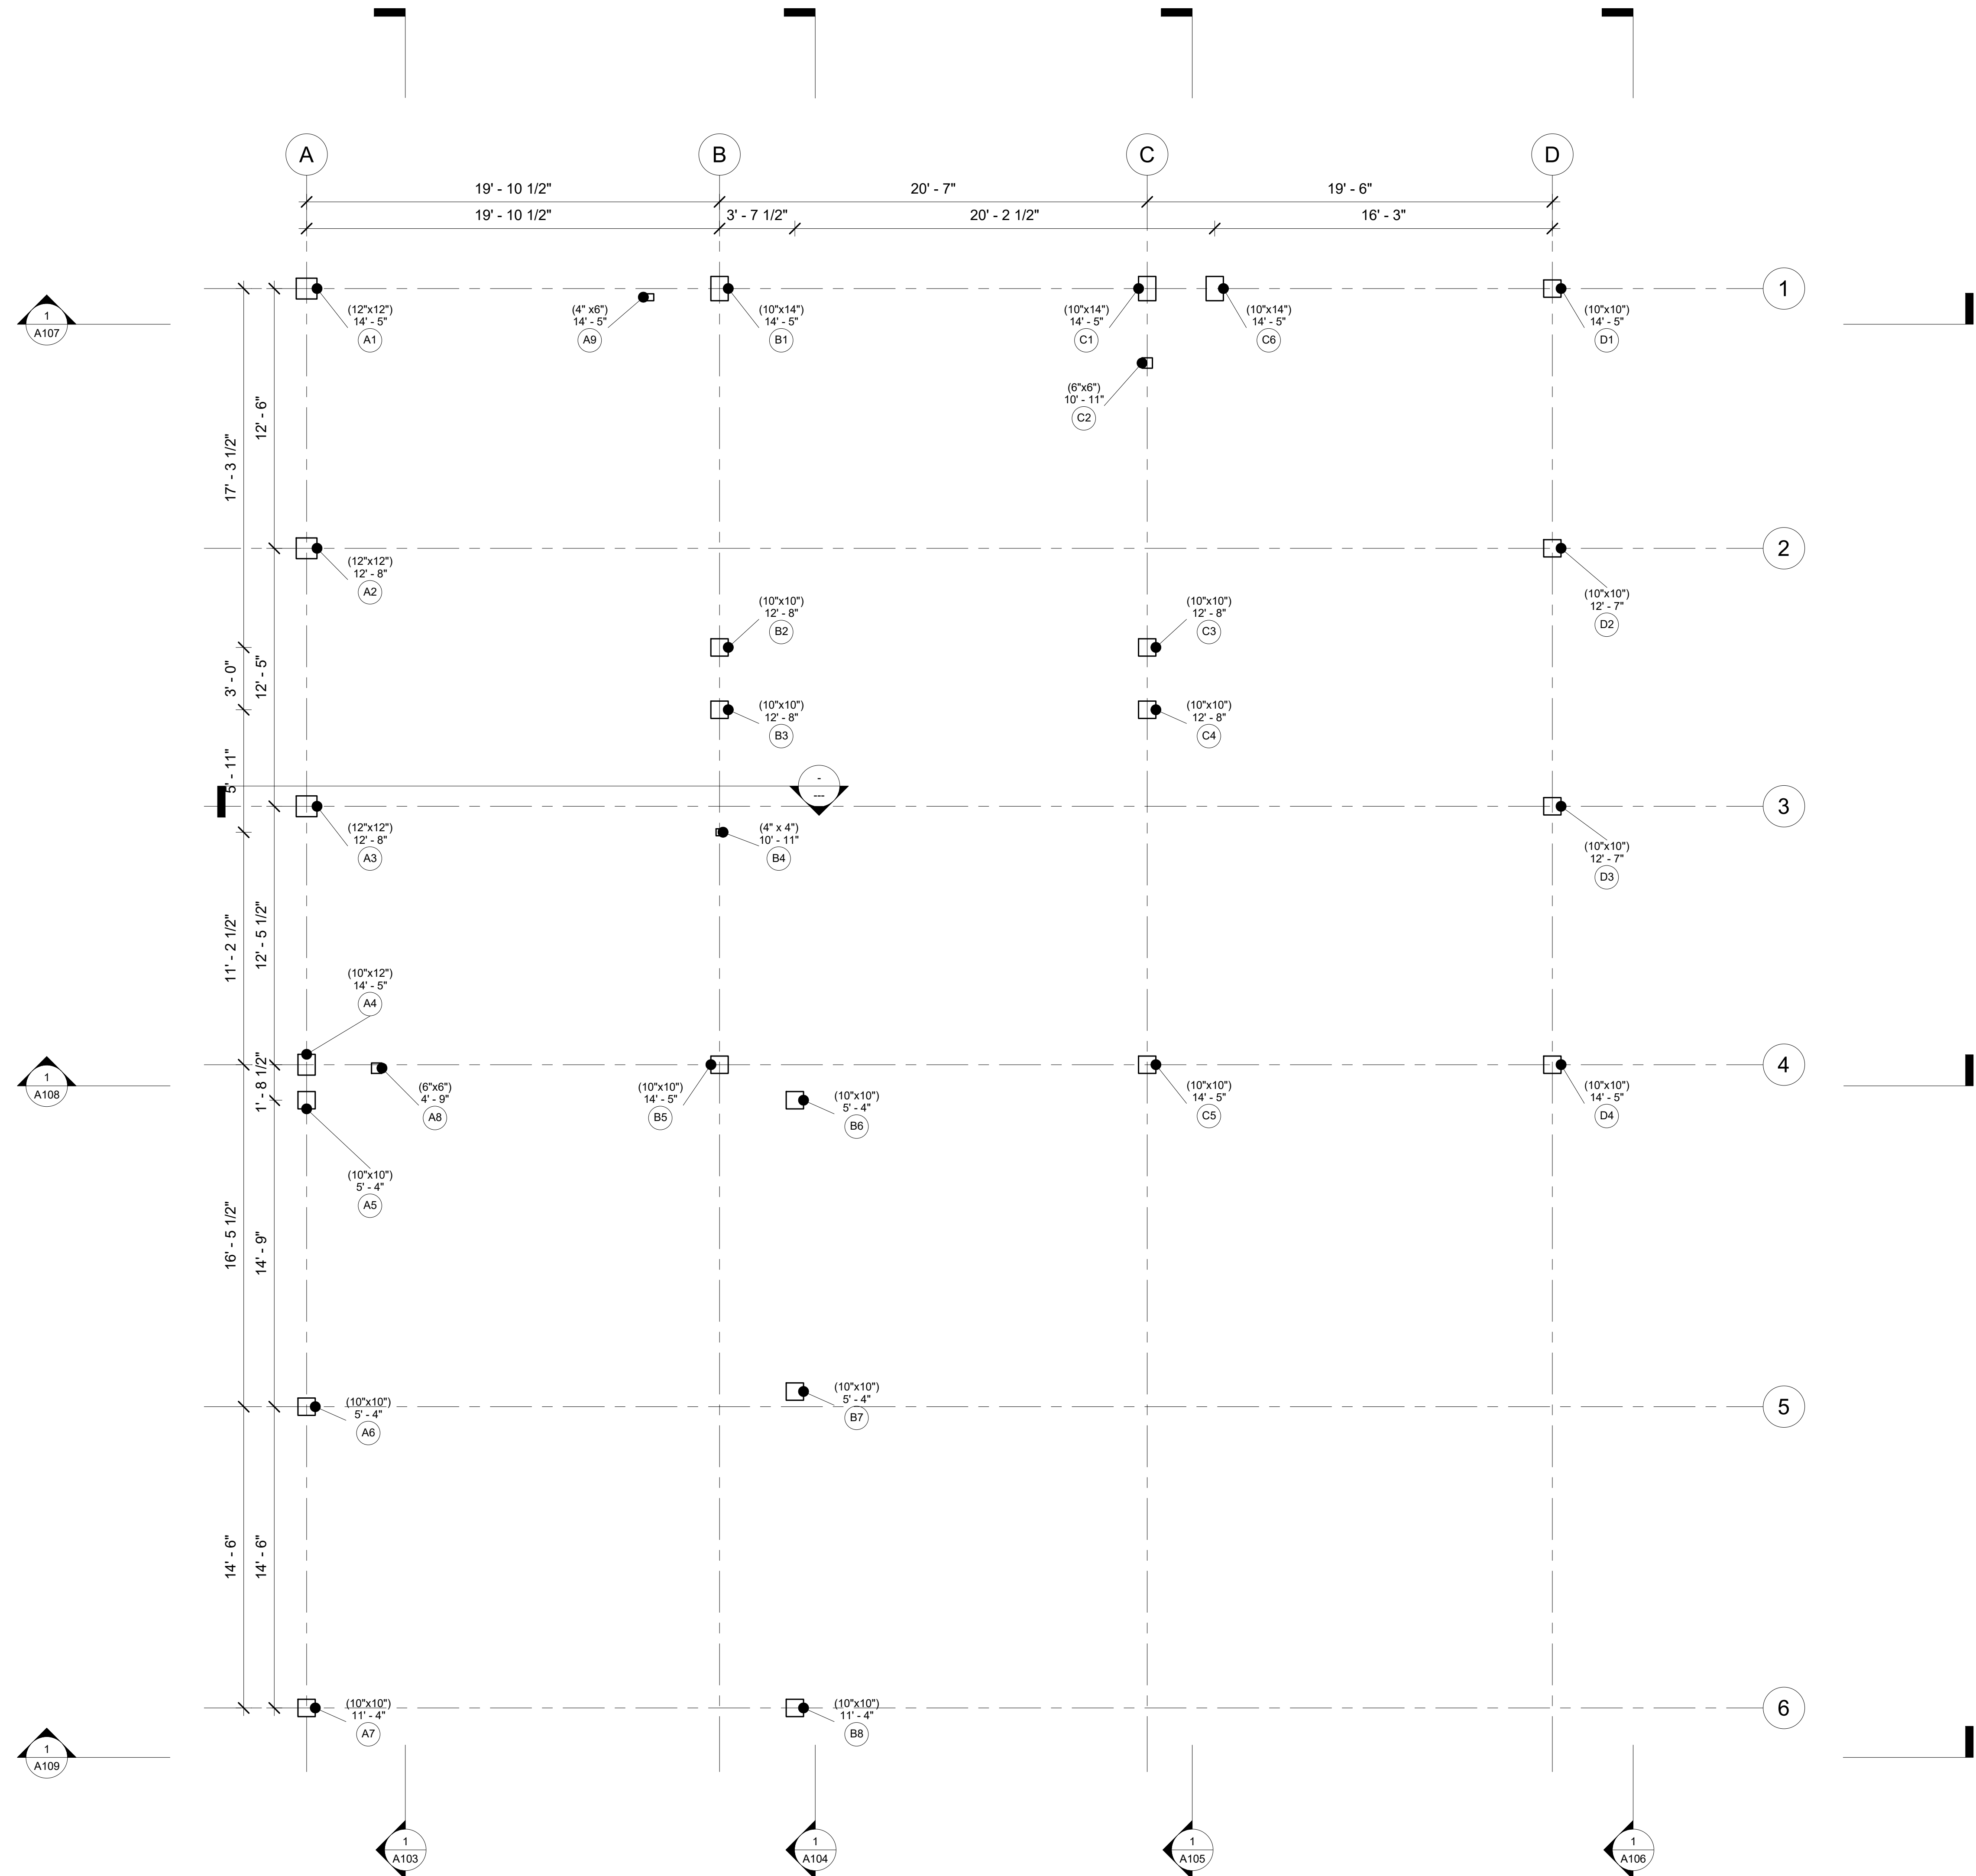

# Timber Home Services LLC


Little Gap Station

DAN TRIMBLE  
AA66 / TIMBER HOME SERVICES

CELL PHONE/TEXT - 412-309-1161

EMAIL:

DANTRIMBLE@TIMBERHOMESERVICES.COM

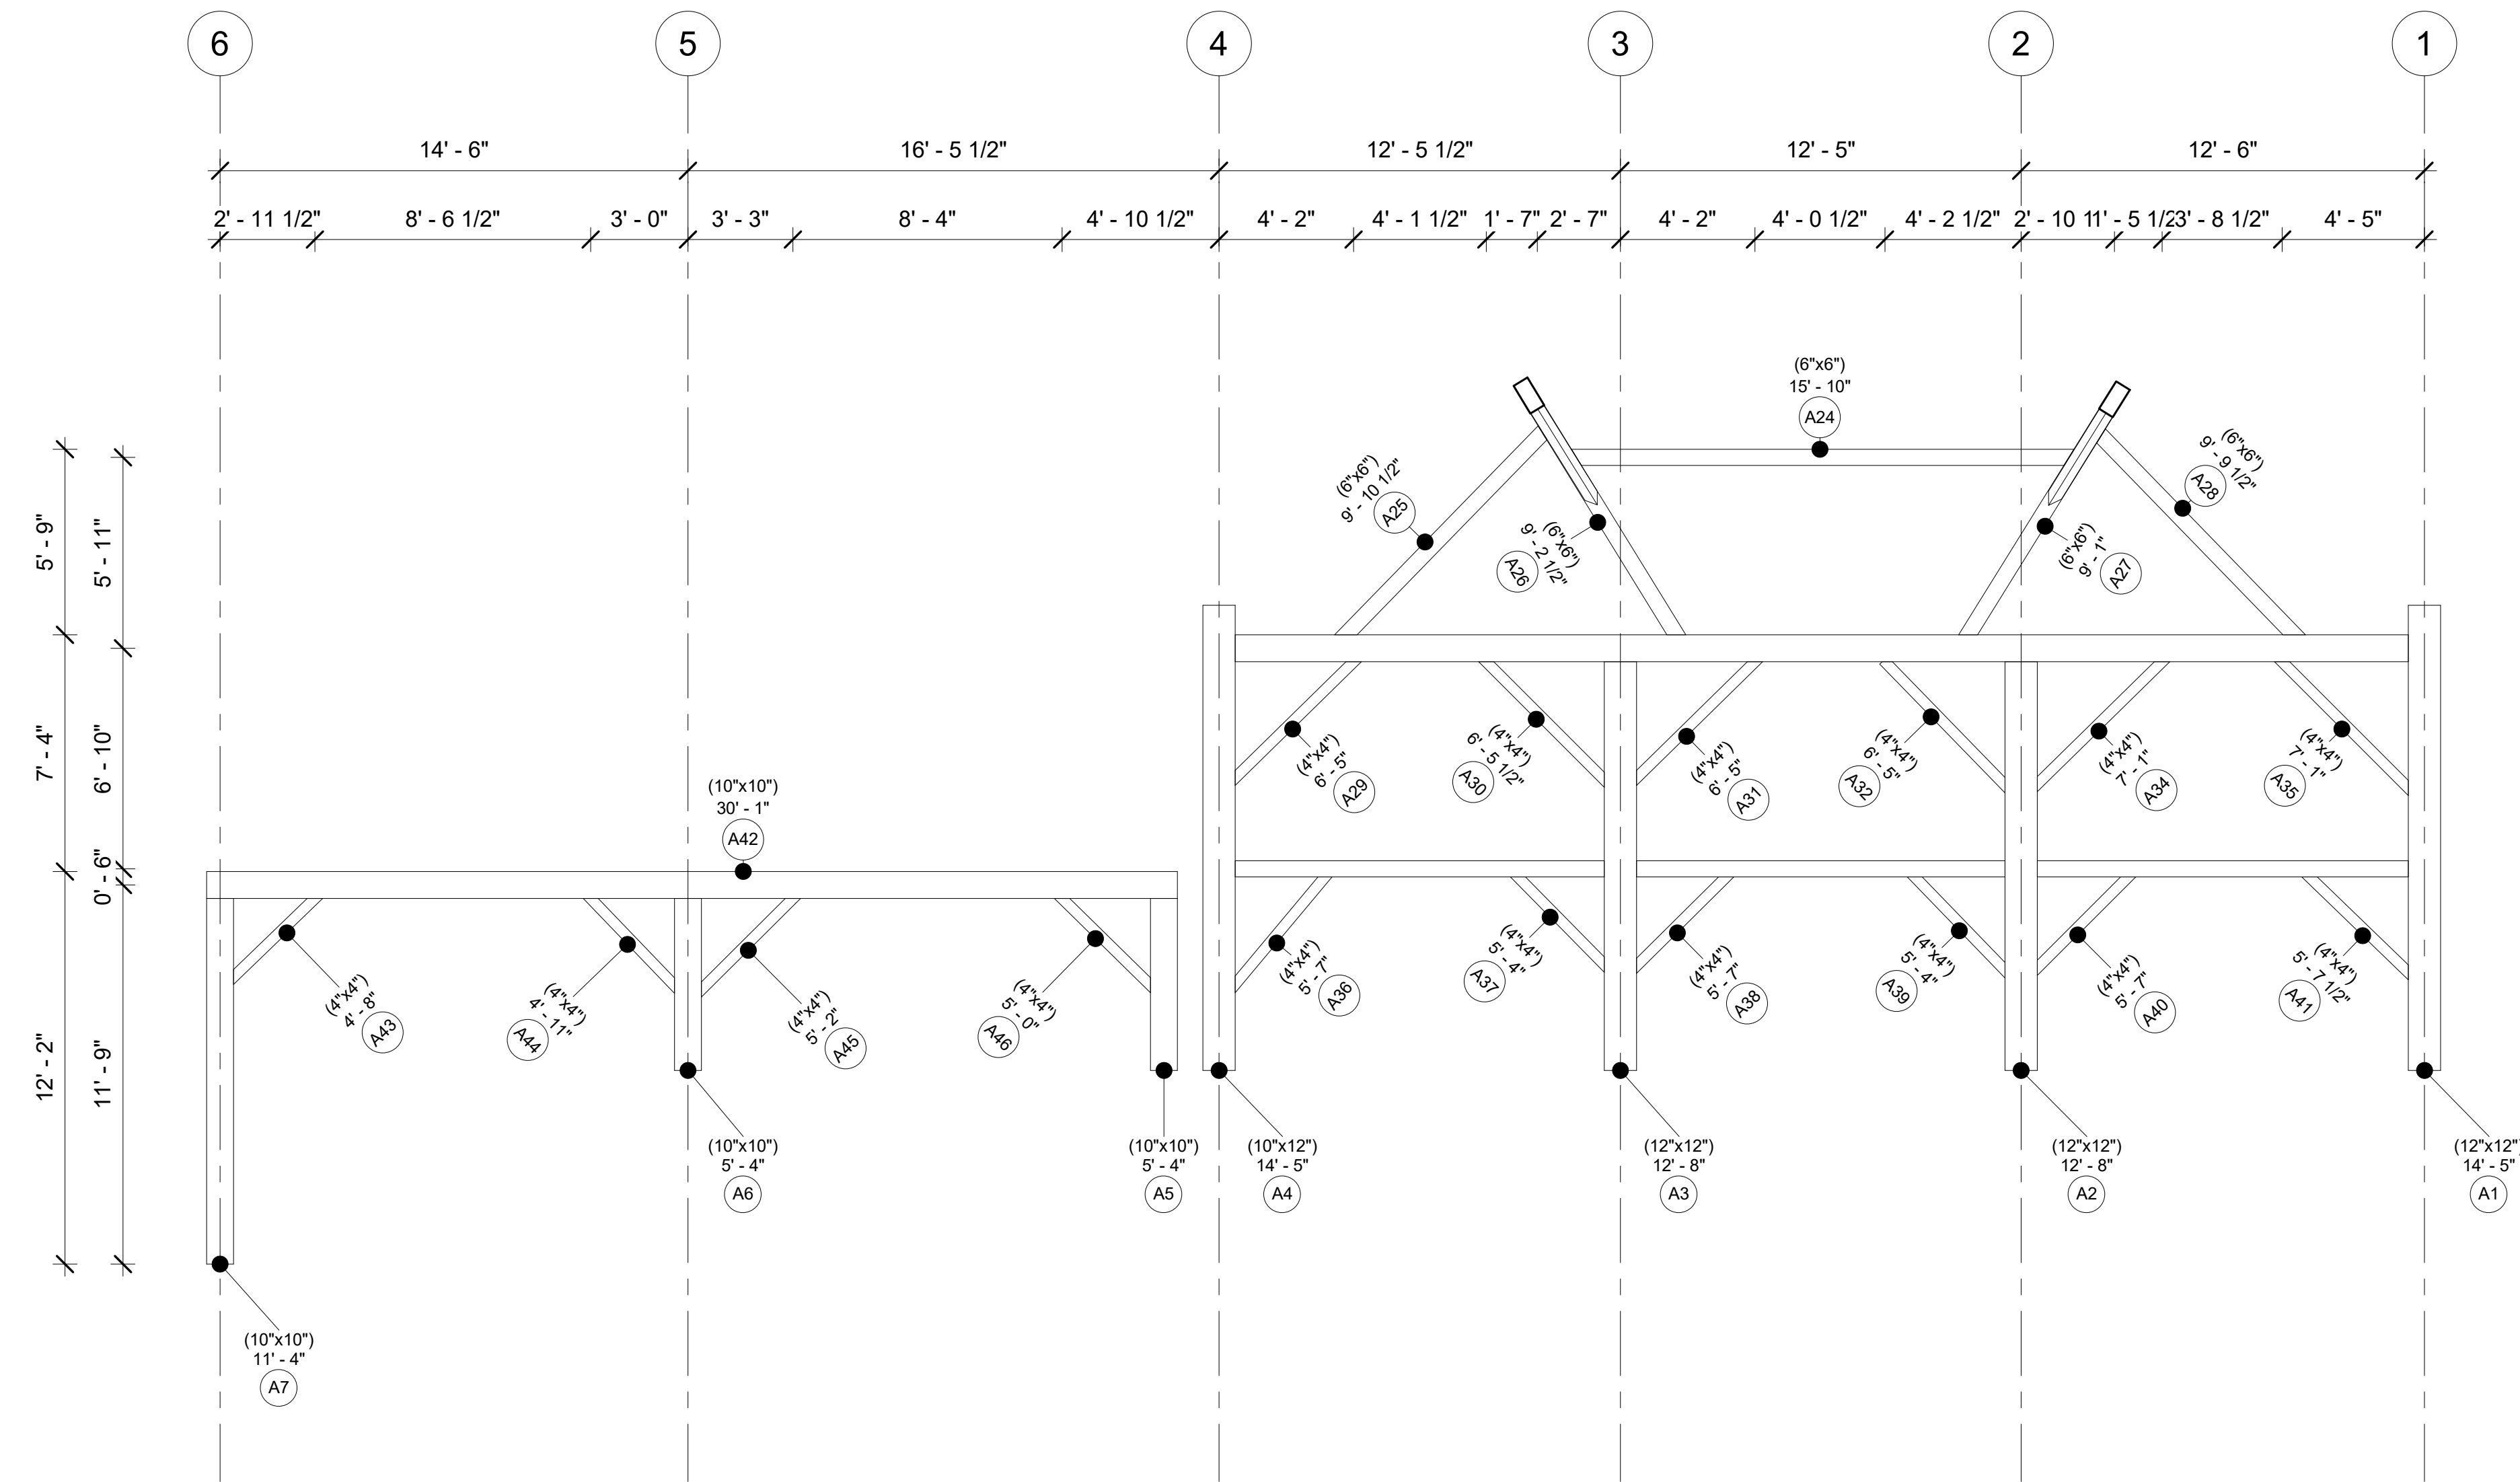

## Bent A

Project Number Project 13

Date 20250510

Drawn By

Checked By

# A103

Scale 1/4" = 1'-0"

# Timber Home Services LLC


Little Gap Station

DAN TRIMBLE  
AA66 / TIMBER HOME SERVICES

CELL PHONE/TEXT - 412-309-1161

EMAIL:

DANTRIMBLE@TIMBERHOMESERVICES.COM

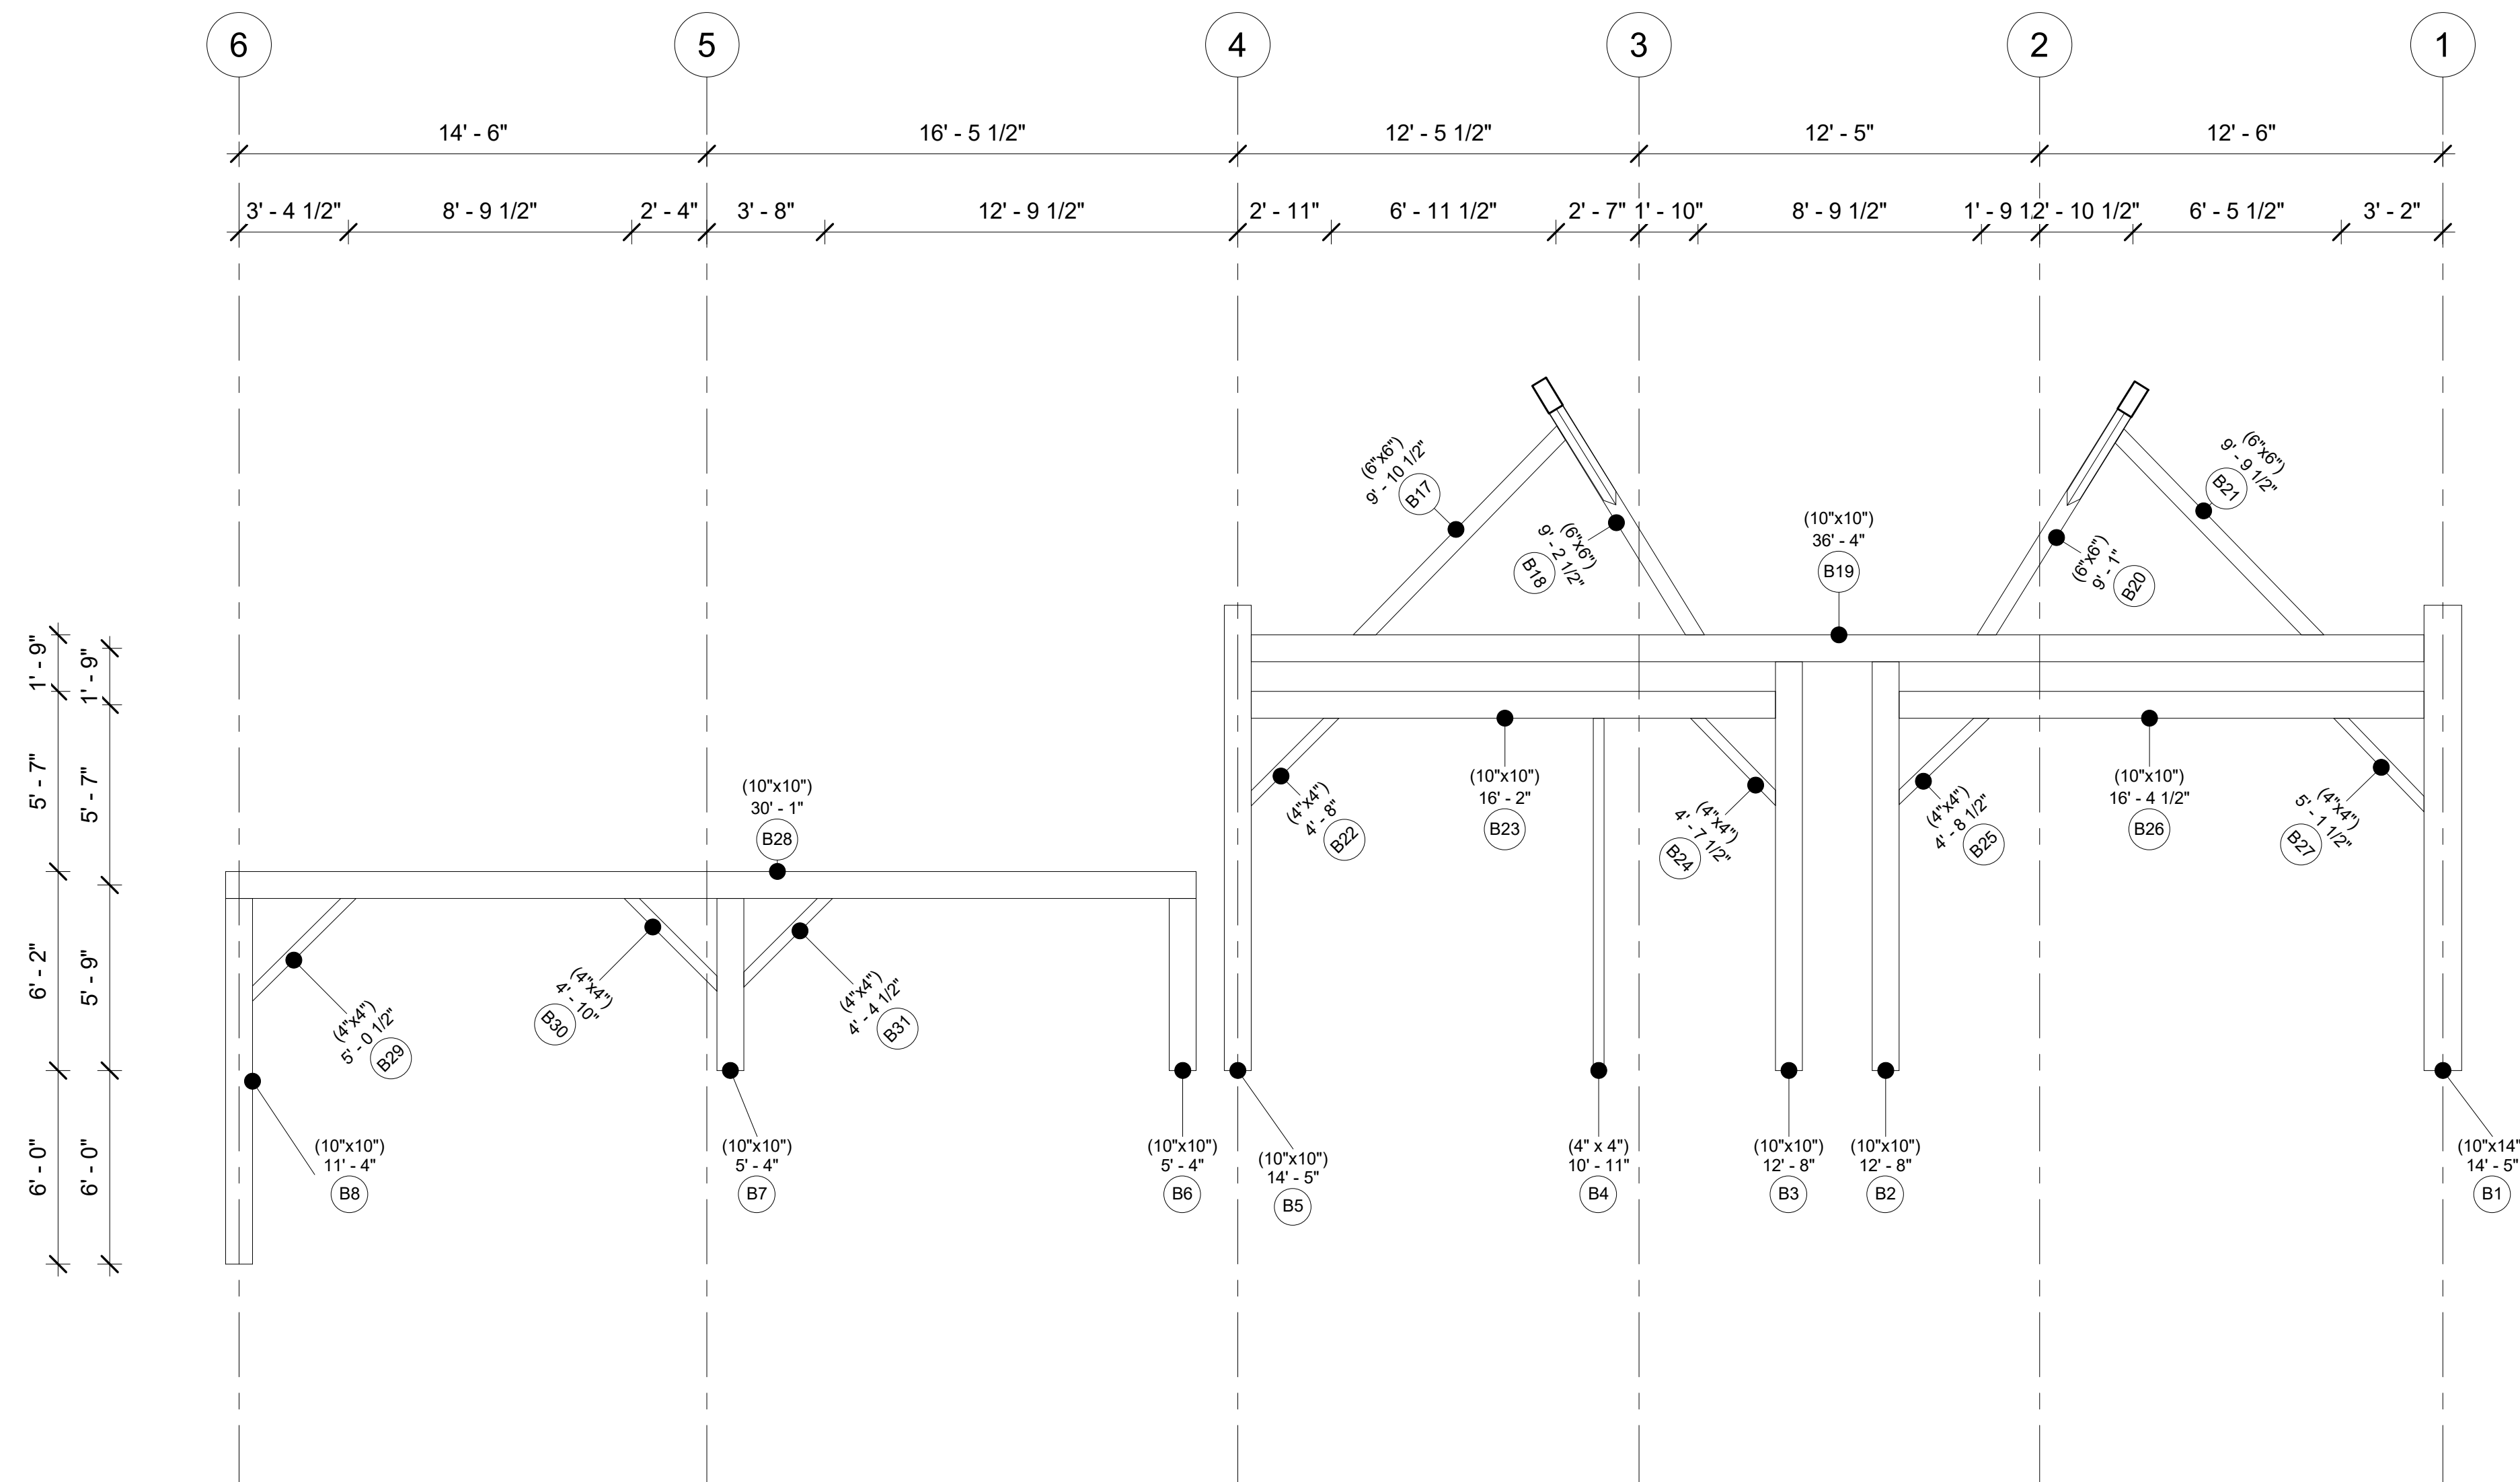

## Bent B

Project Number Project 13

Date 20250510

Drawn By

Checked By

# A104


Scale 1/4" = 1'-0"

# Timber Home Services LLC

Little Gap Station

**DAN TRIMBLE**  
AA66 / TIMBER HOME SERVICES  
CELL PHONE/TEXT - 412-309-1161

EMAIL:  
DANTRIMBLE@TIMBERHOMESERVICES.COM

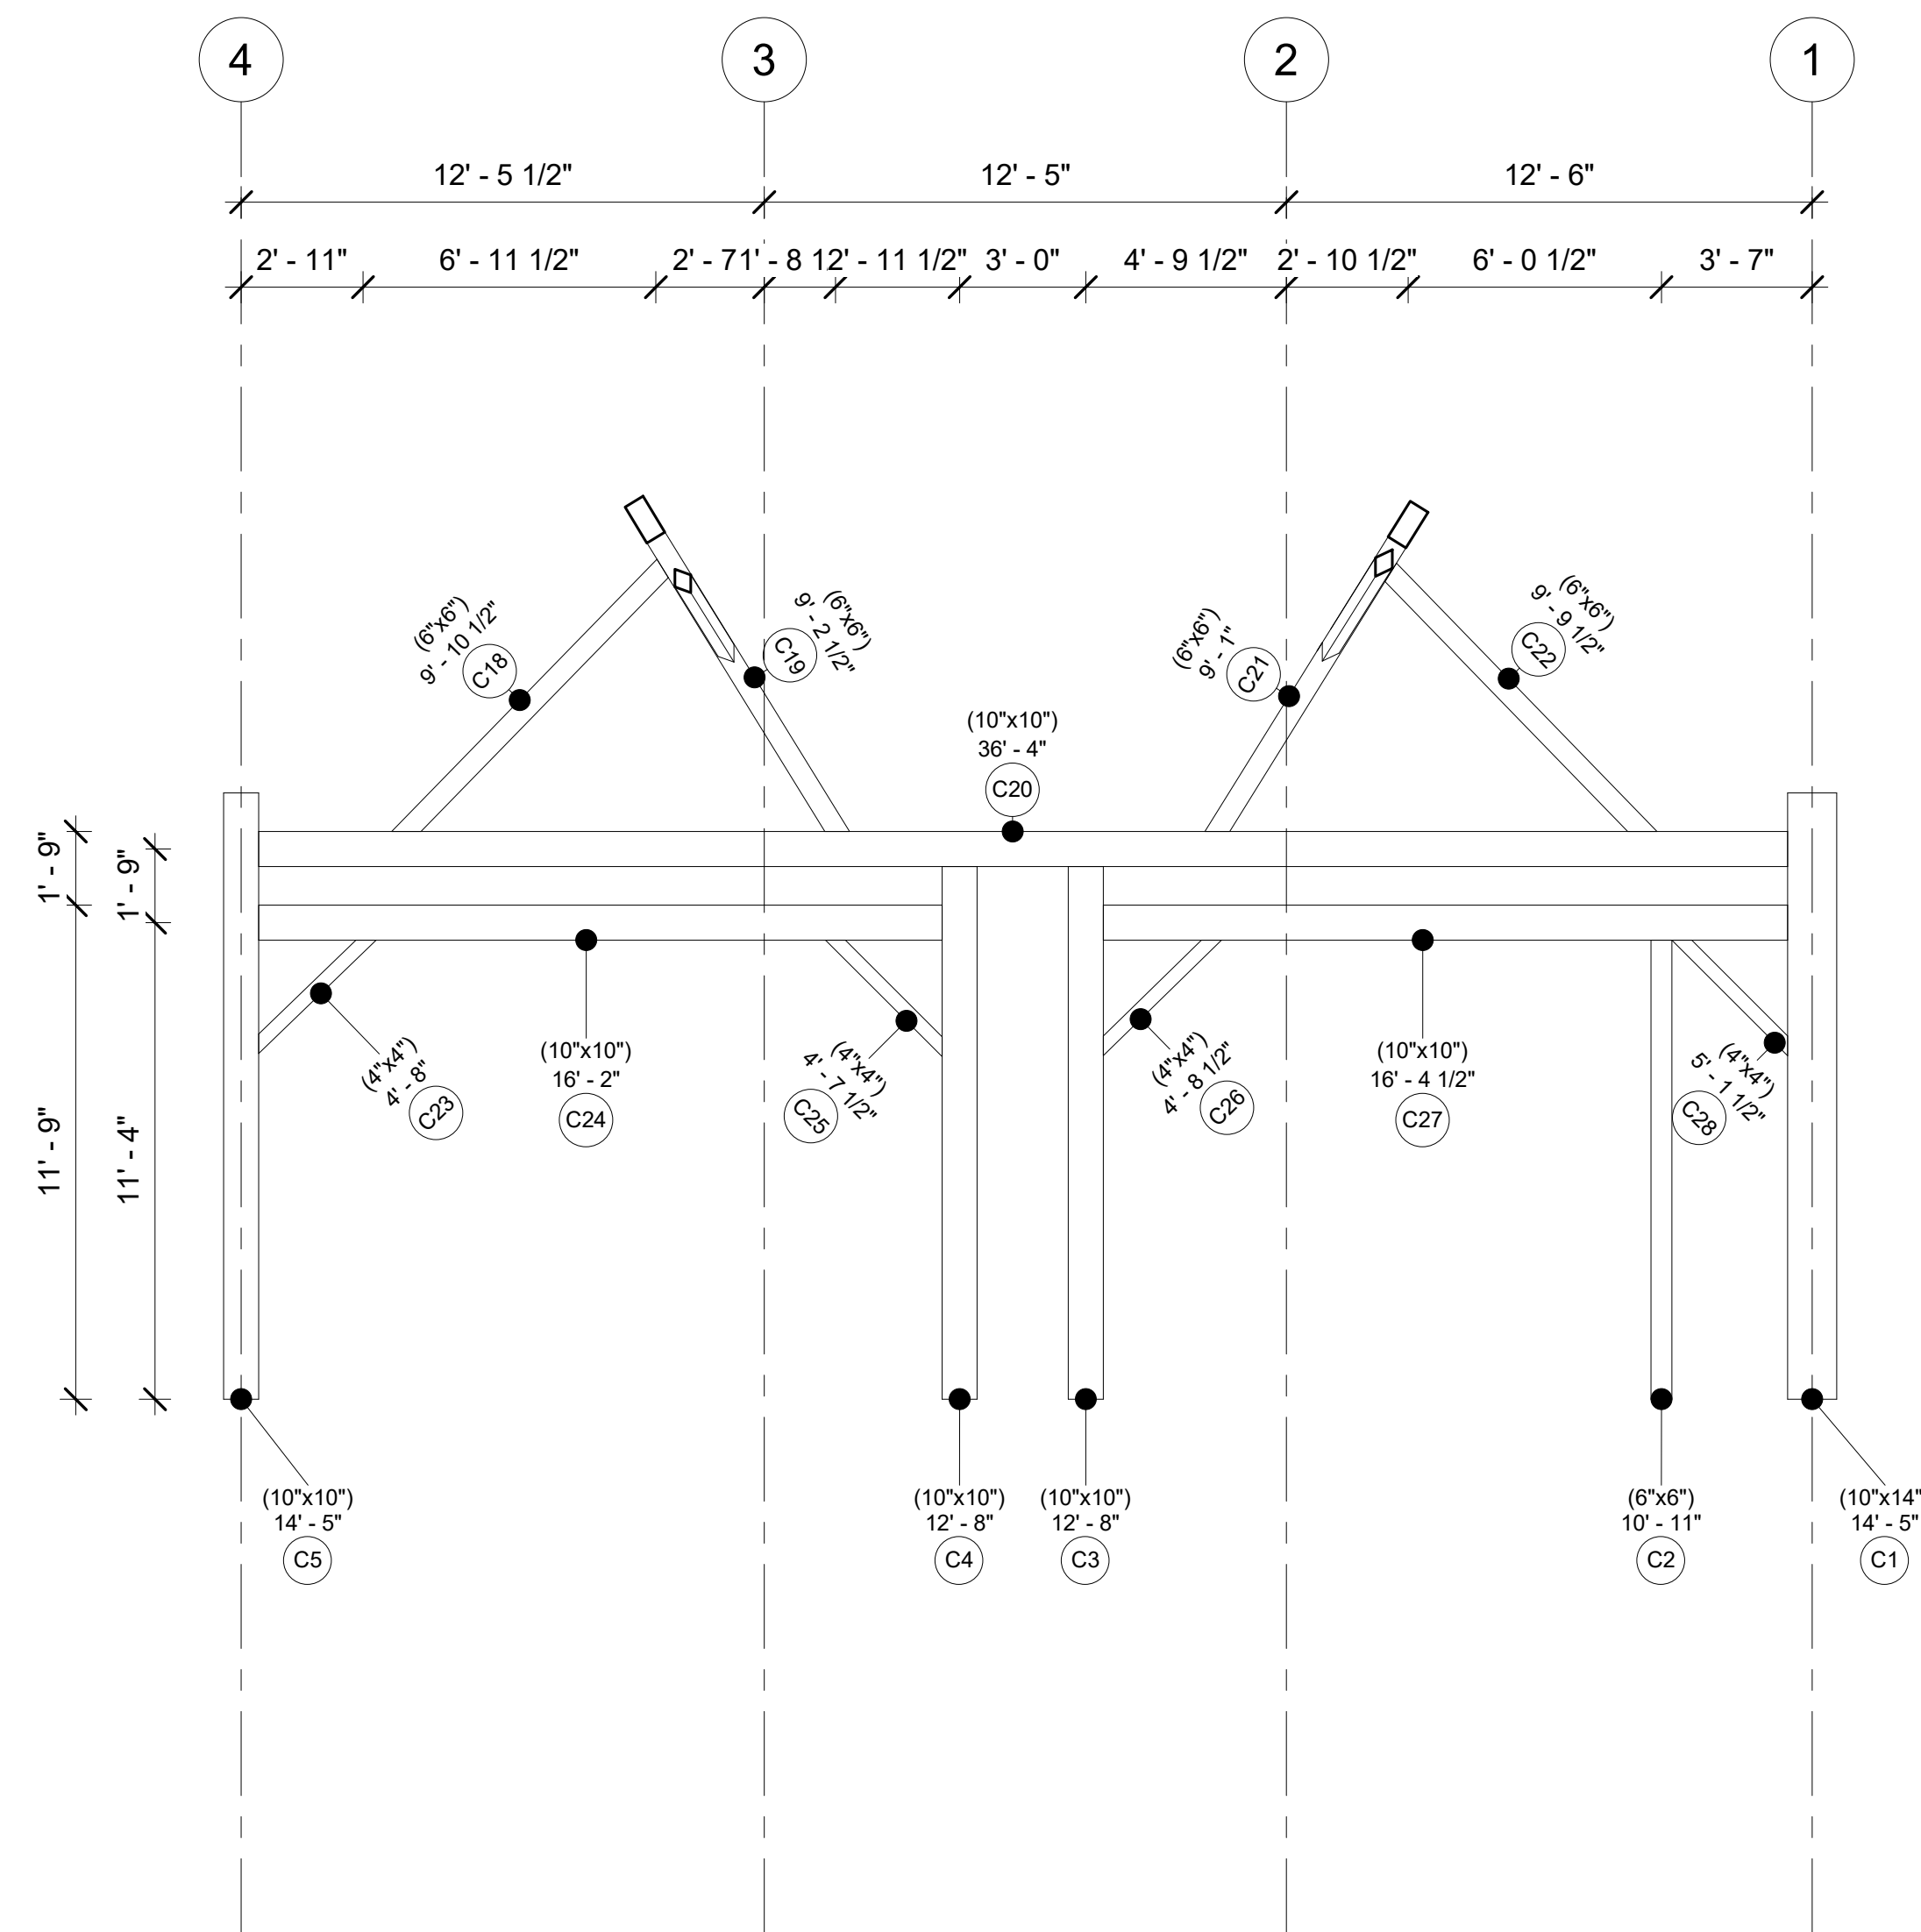

## Bent C

Project Number Project 13  
Date 20250510  
Drawn By  
Checked By

# A105


Scale 1/4" = 1'-0"

# Timber Home Services LLC

Little Gap Station

**DAN TRIMBLE**  
AA66 / TIMBER HOME SERVICES  
CELL PHONE/TEXT - 412-309-1161

EMAIL:  
DANTRIMBLE@TIMBERHOMESERVICES.COM

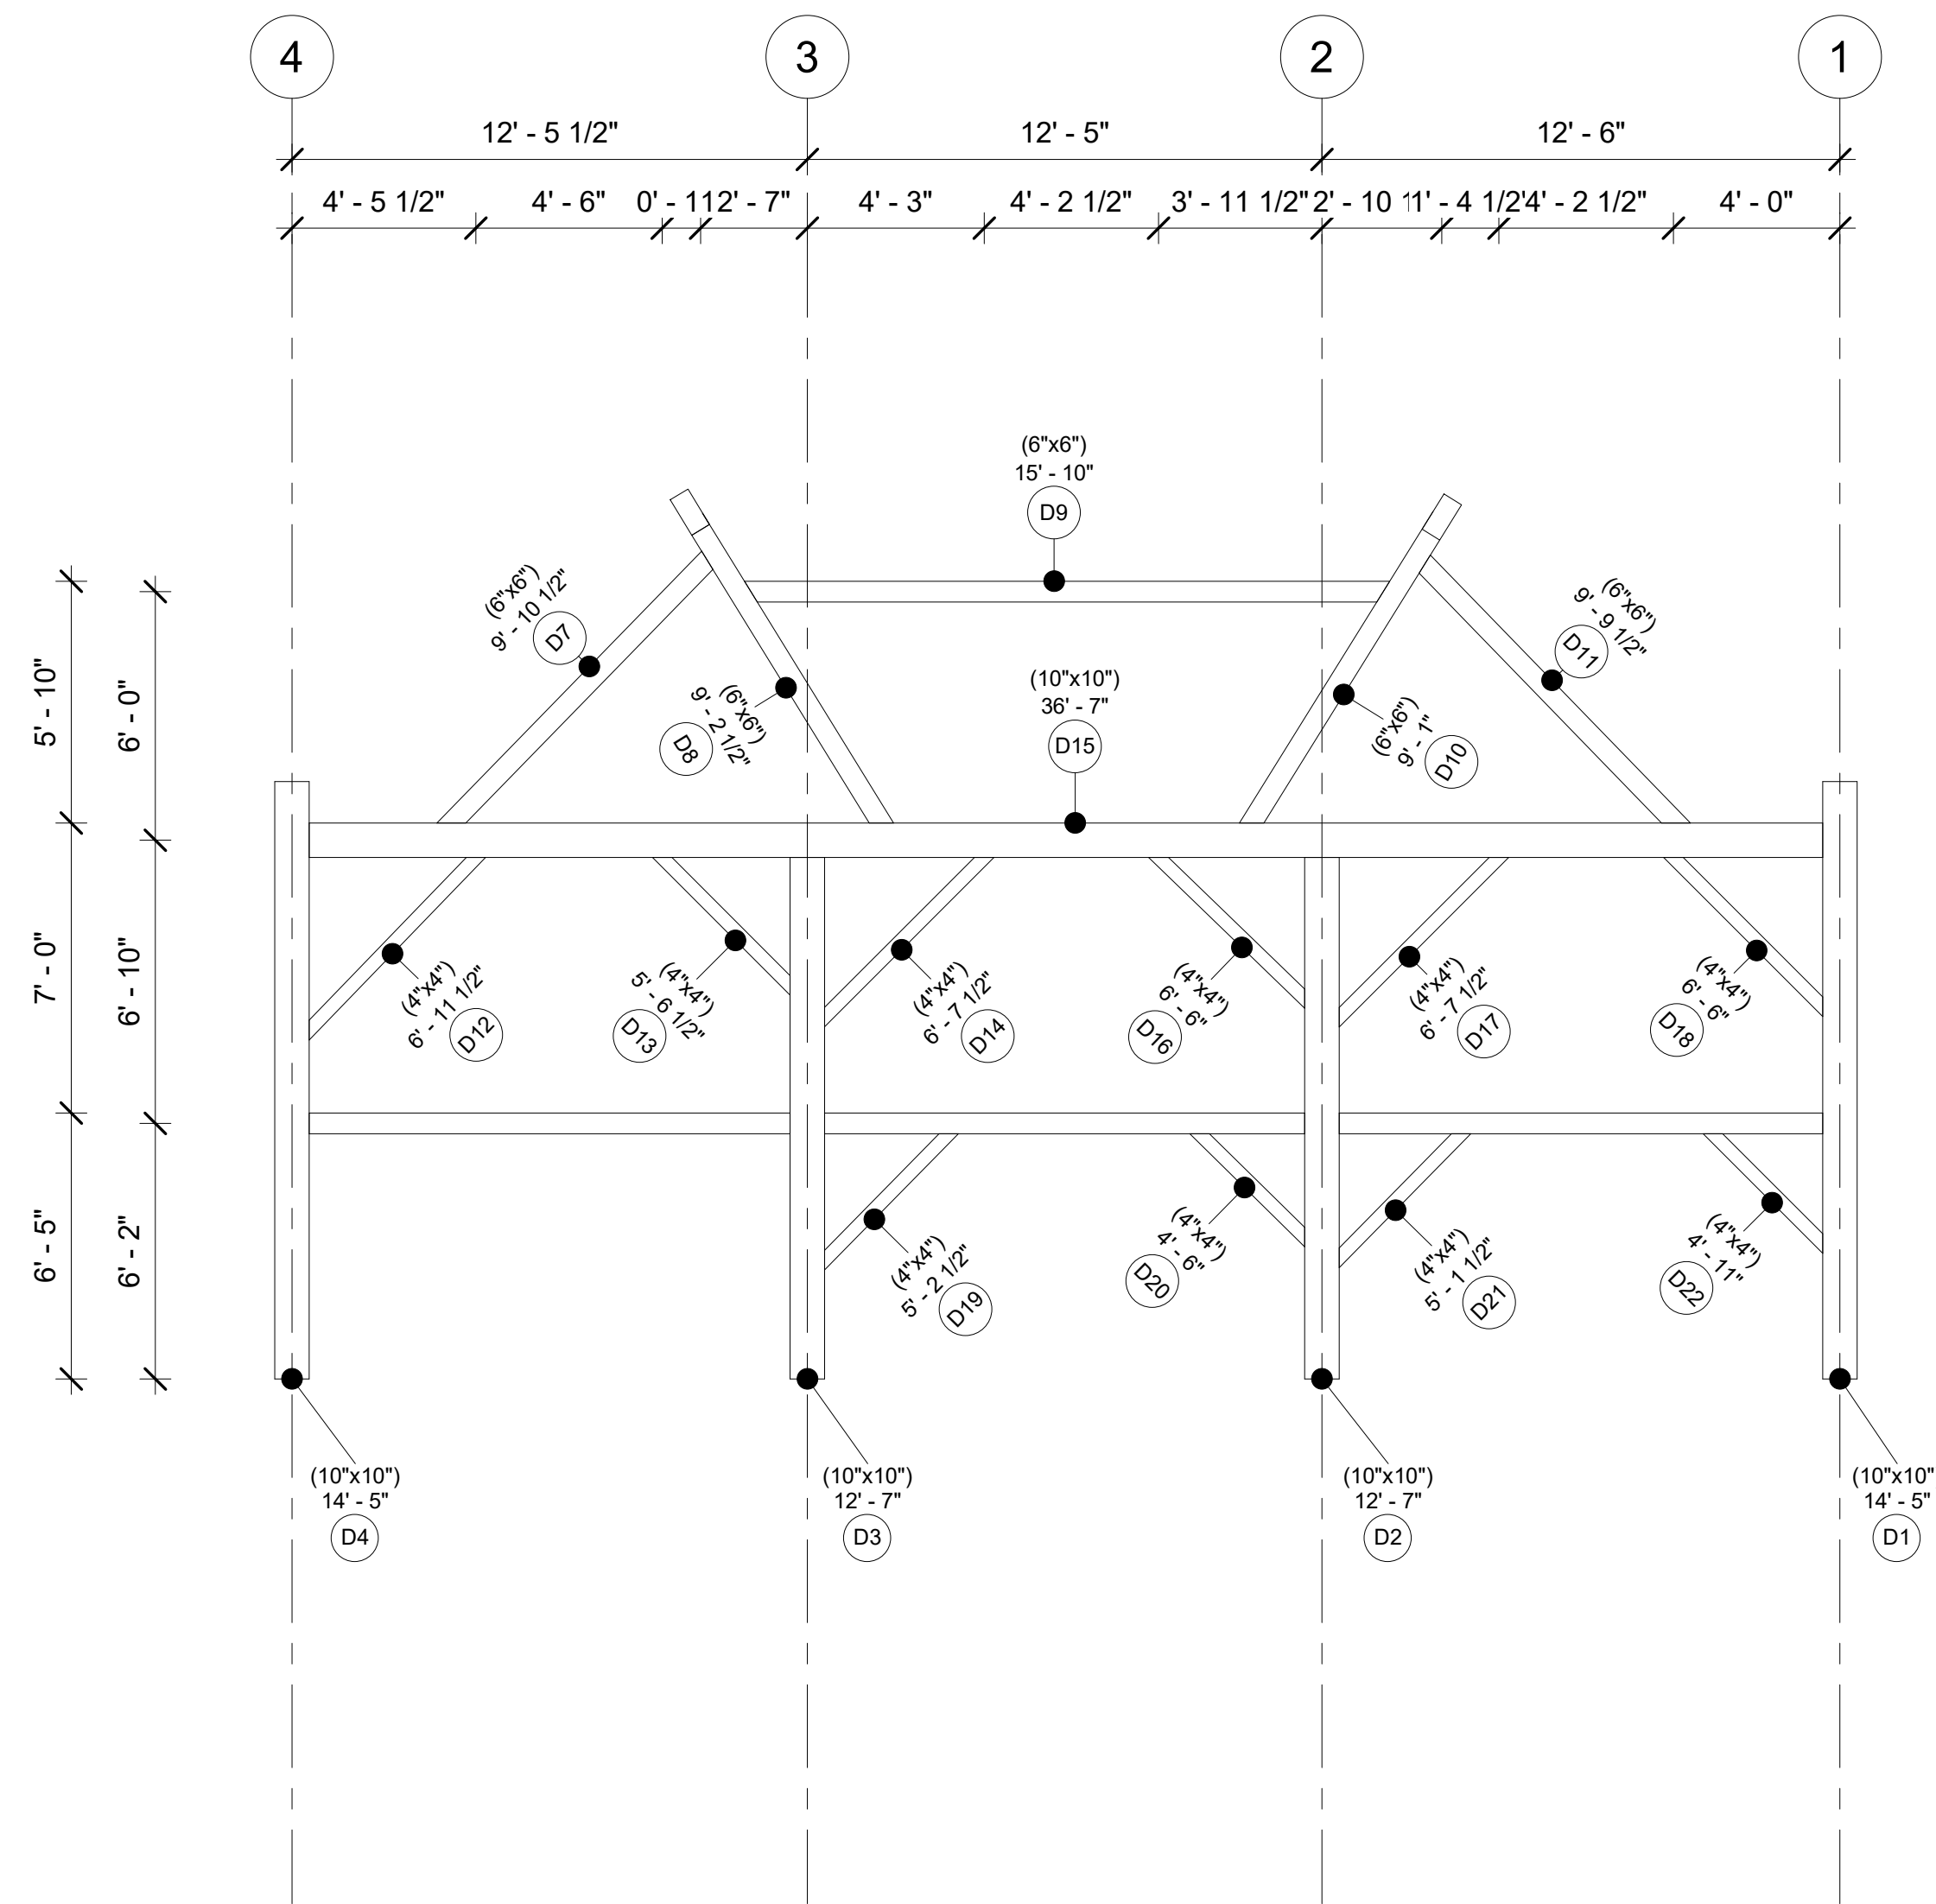

## Bent D

Project Number	Project 13
Date	20250510
Drawn By	
Checked By	

# A106


Scale 1/4" = 1'-0"

# Timber Home Services LLC

Little Gap Station

**DAN TRIMBLE**  
AA66 / TIMBER HOME SERVICES  
CELL PHONE/TEXT - 412-309-1161

EMAIL:  
DANTRIMBLE@TIMBERHOMESERVICES.COM

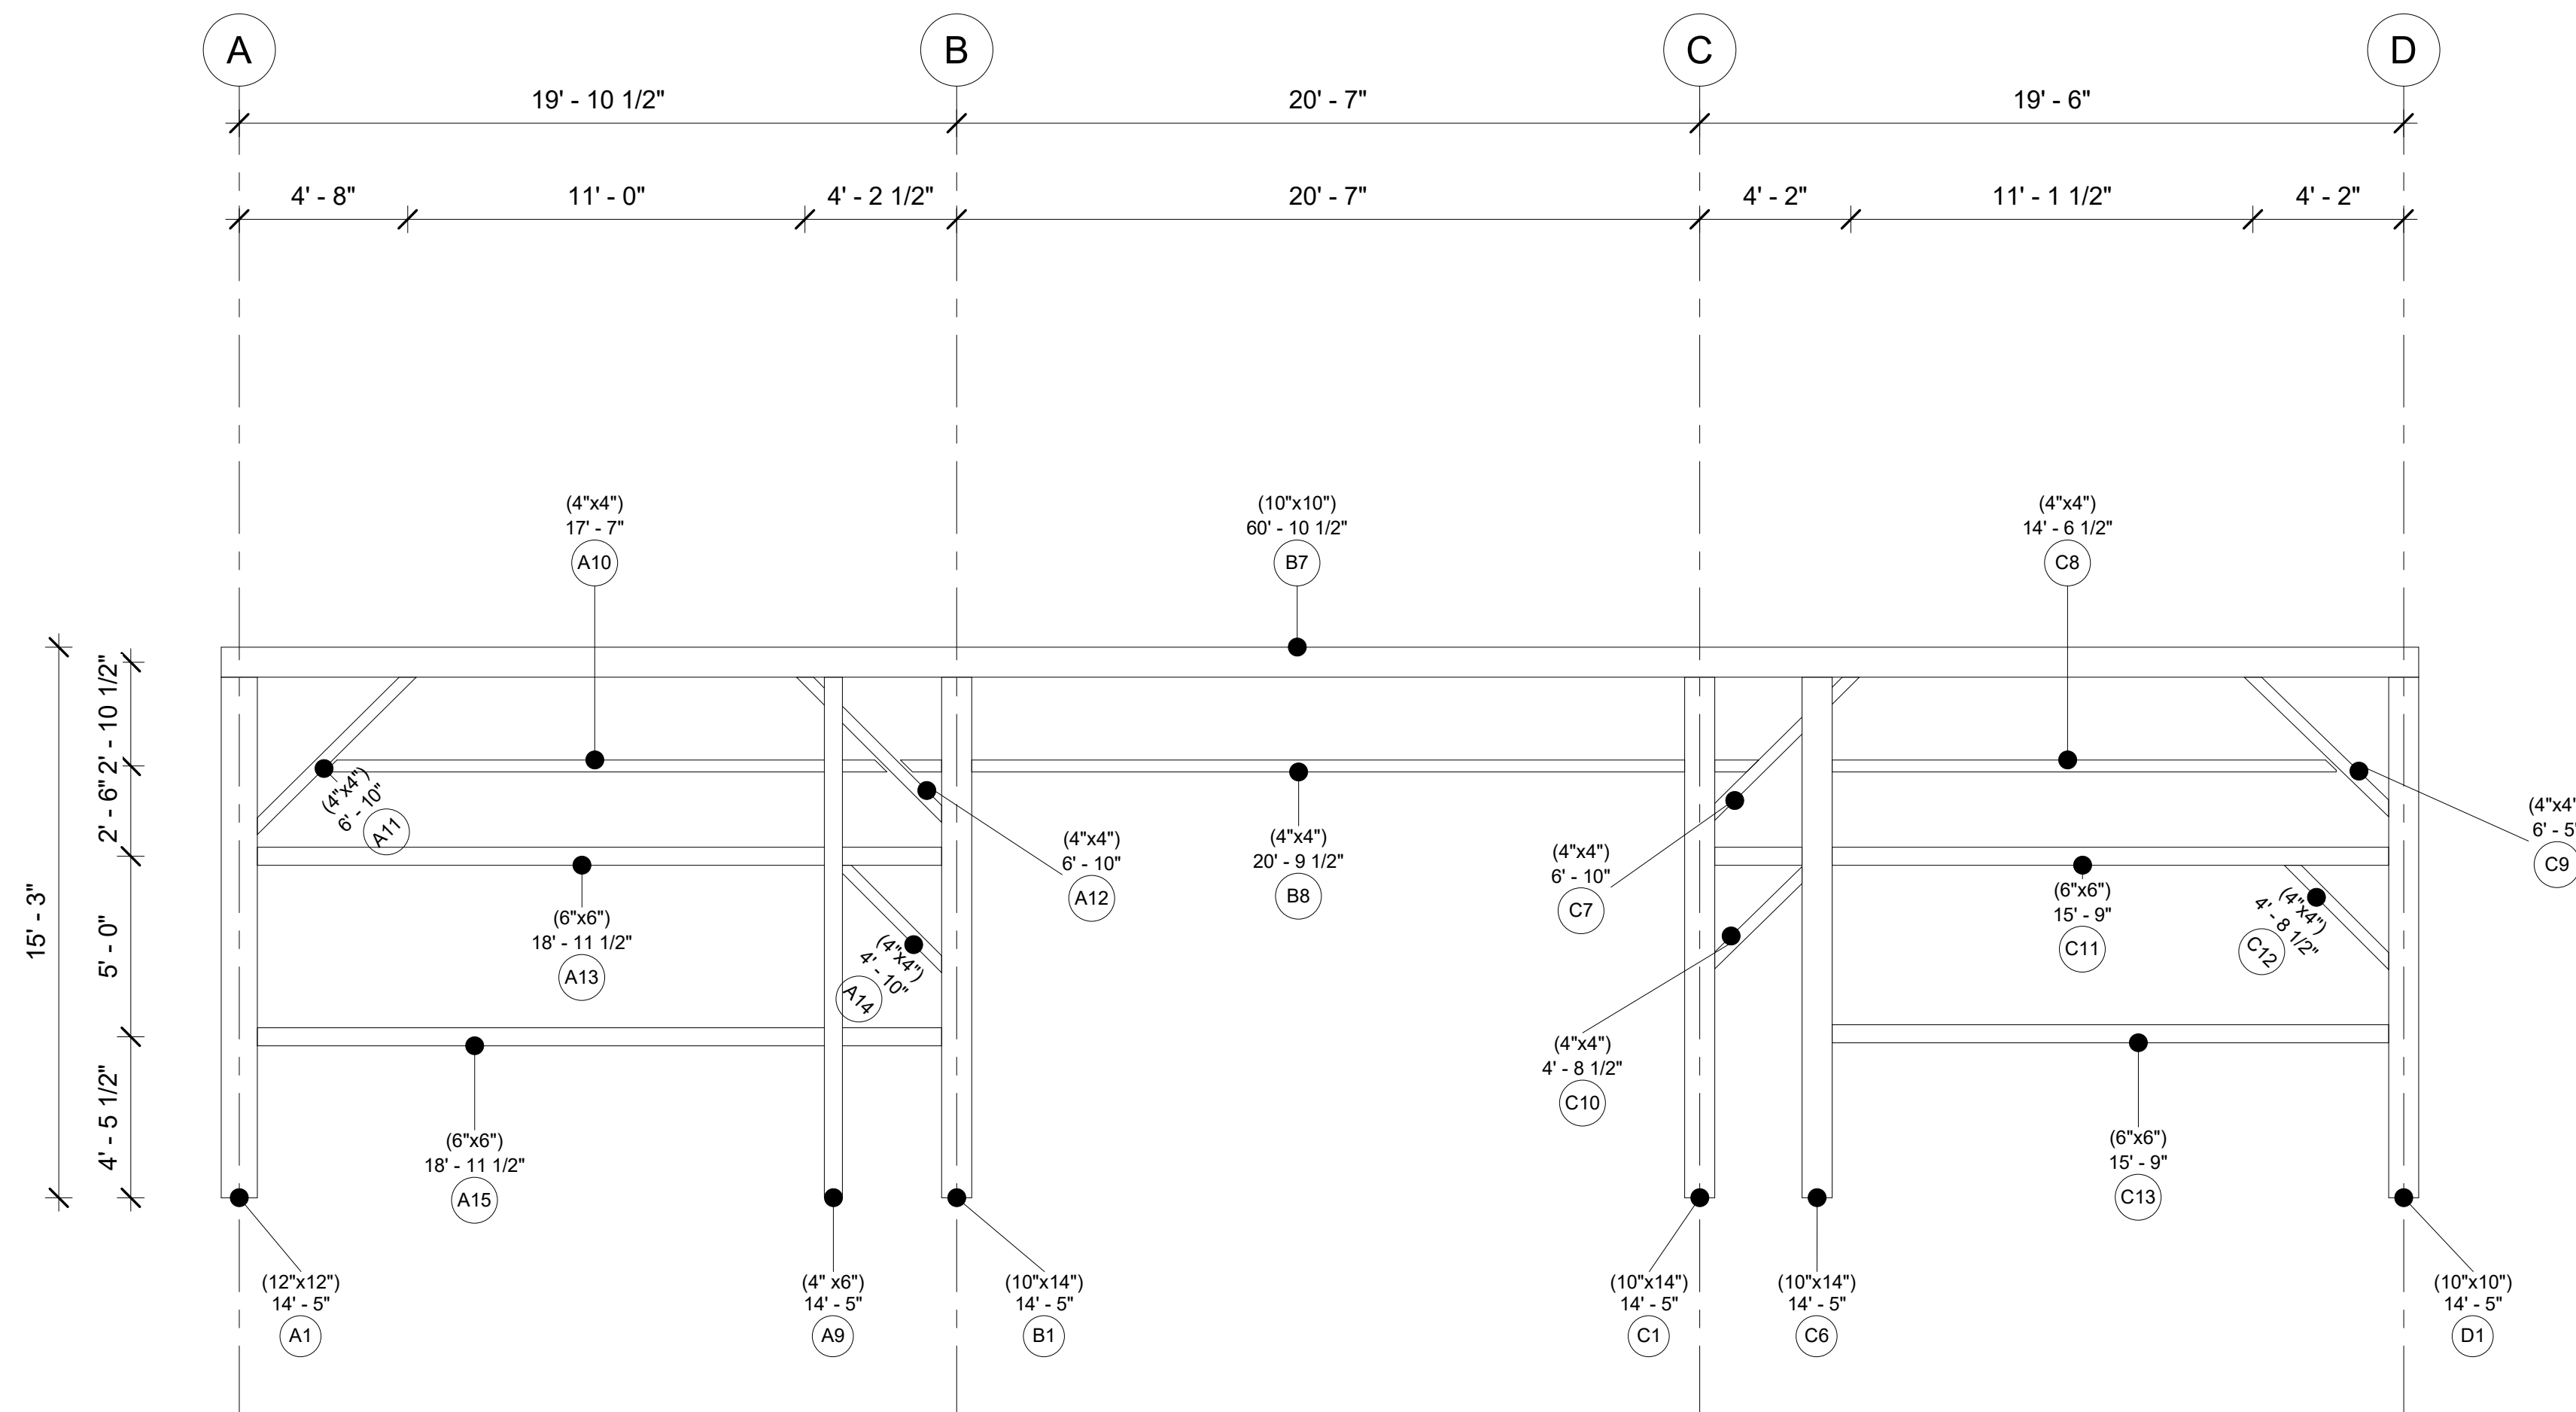

## Bent 1

Project Number Project 13  
Date 20250510  
Drawn By  
Checked By

# A107


Scale 1/4" = 1'-0"

# Timber Home Services LLC

Little Gap Station

**DAN TRIMBLE**  
AA66 / TIMBER HOME SERVICES  
CELL PHONE/TEXT - 412-309-1161

EMAIL:  
DANTRIMBLE@TIMBERHOMESERVICES.COM

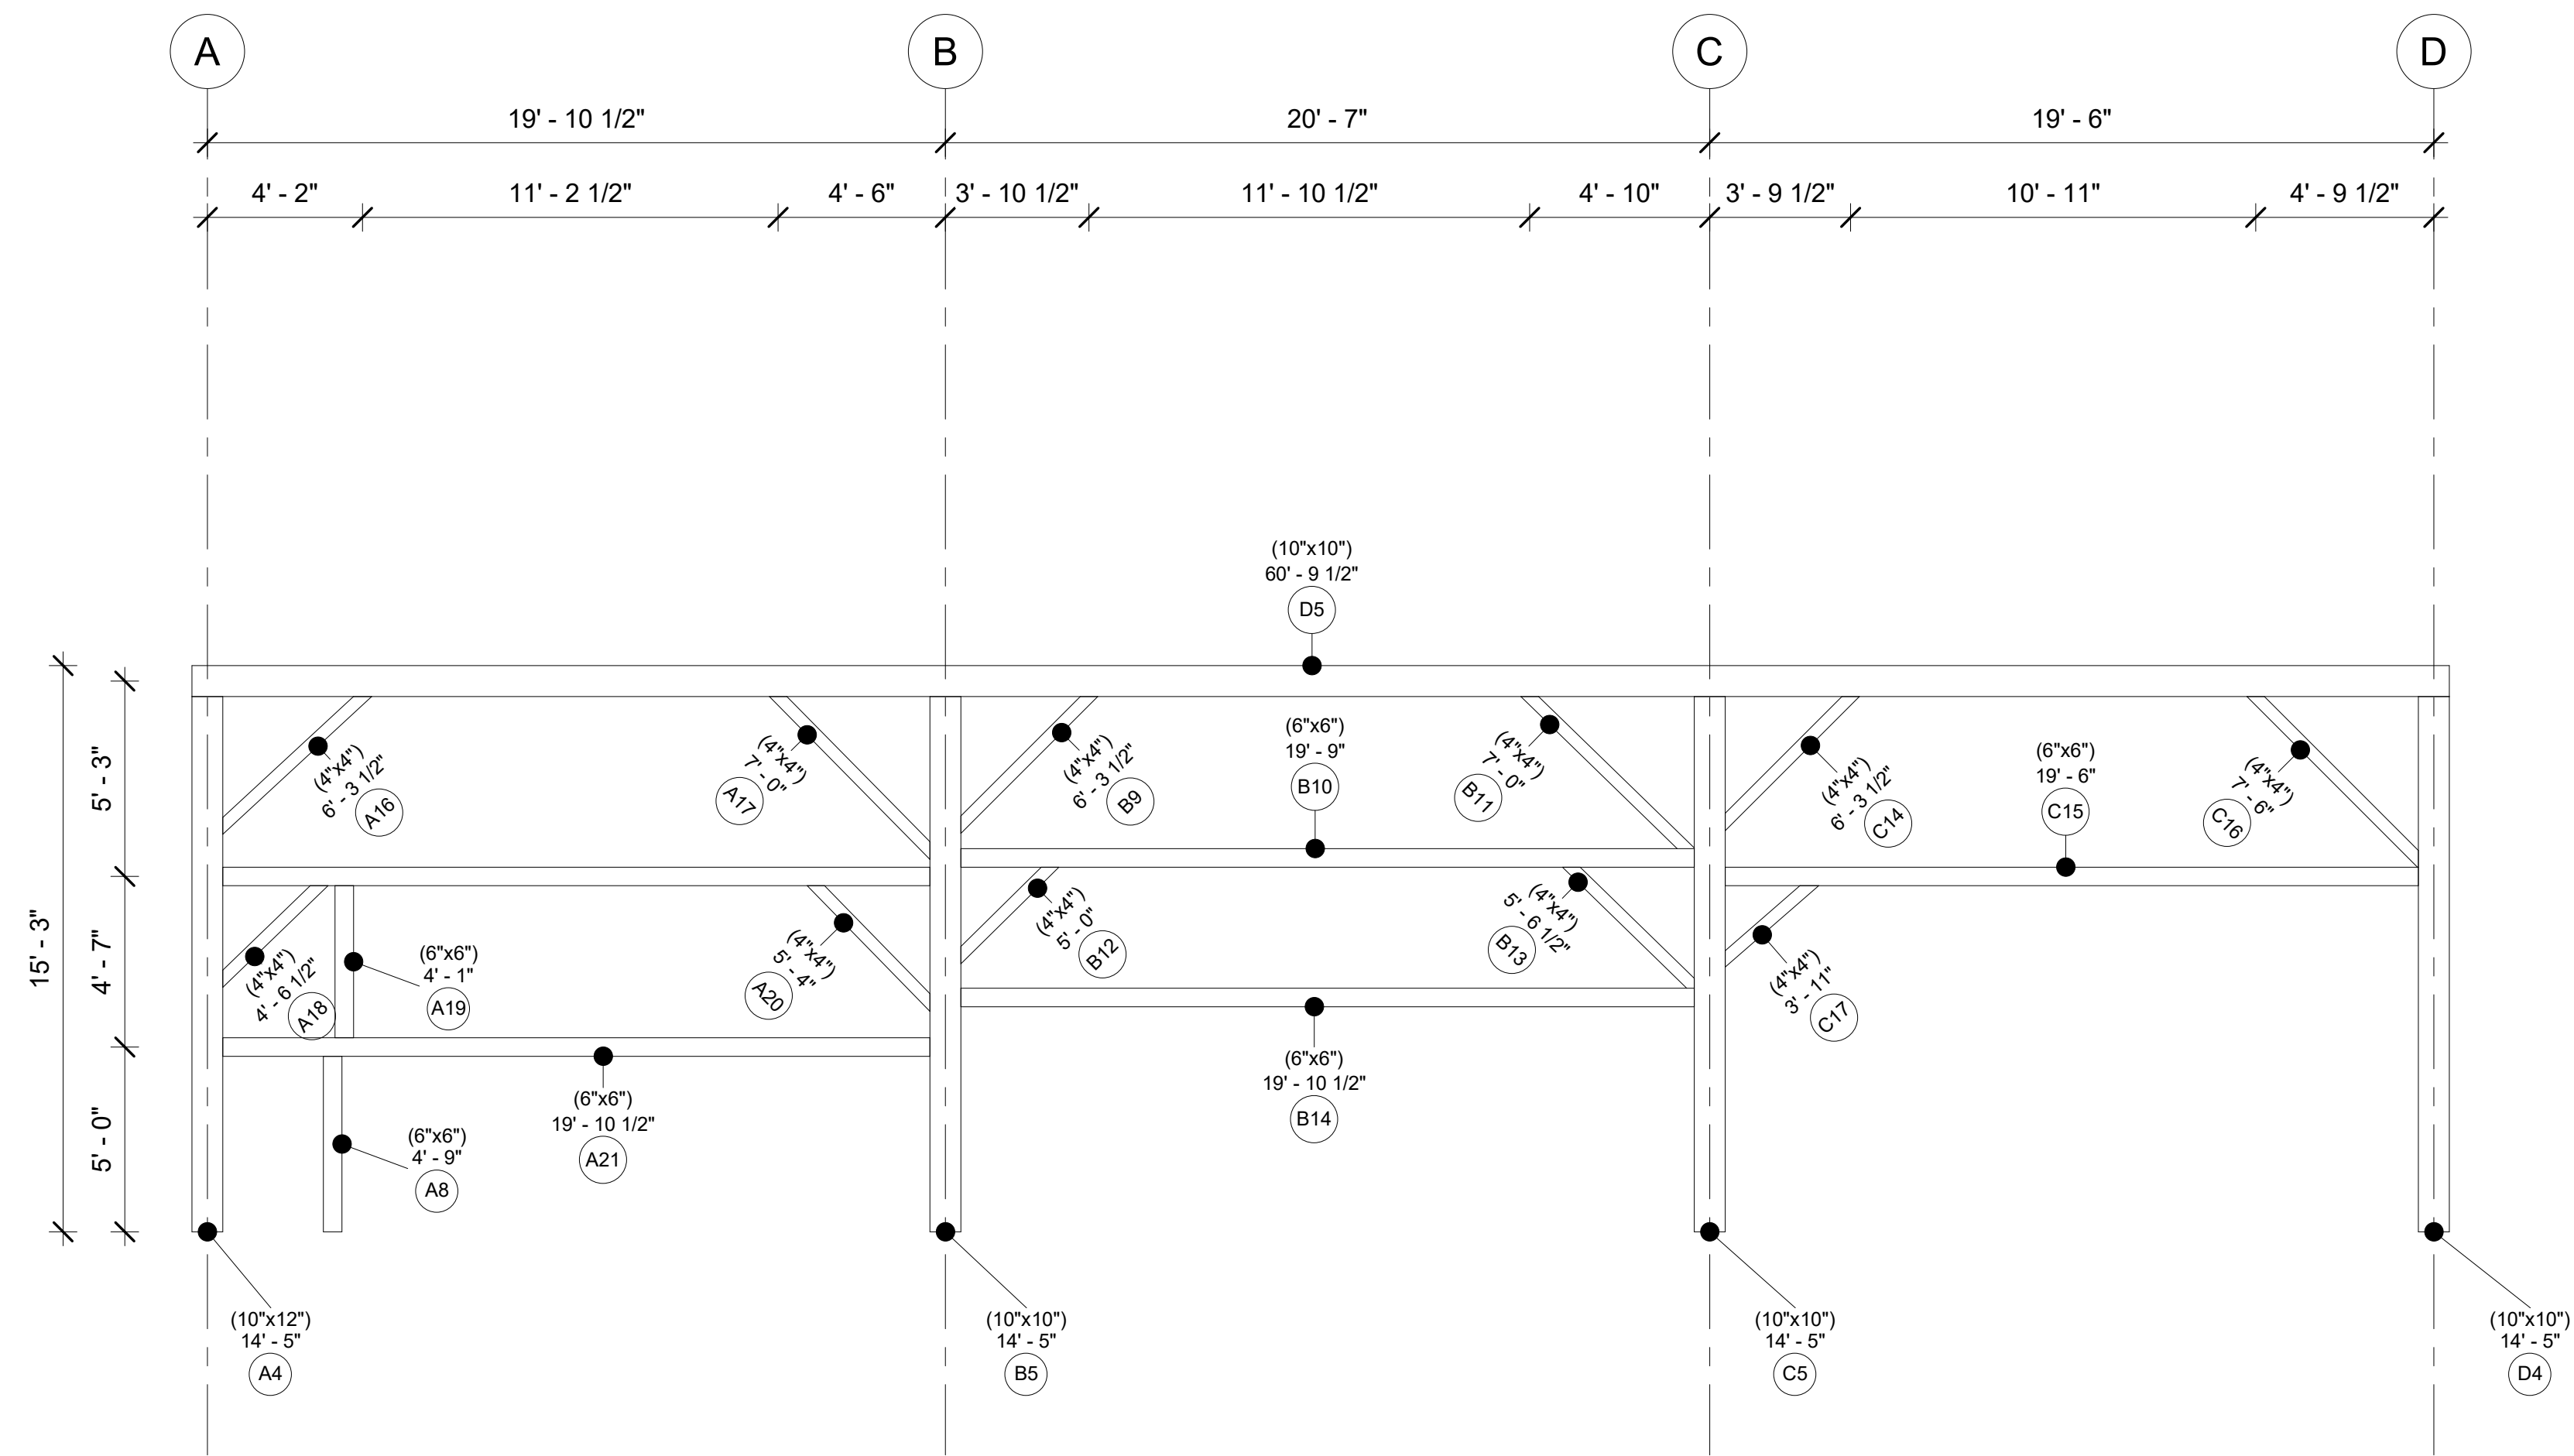

## Bent 2

Project Number: Project 13  
Date: 20250510  
Drawn By:  
Checked By:

# A108


Scale: 1/4" = 1'-0"

# Timber Home Services LLC

Little Gap Station

**DAN TRIMBLE**  
AA66 / TIMBER HOME SERVICES  
CELL PHONE/TEXT - 412-309-1161

EMAIL:  
DANTRIMBLE@TIMBERHOMESERVICES.COM

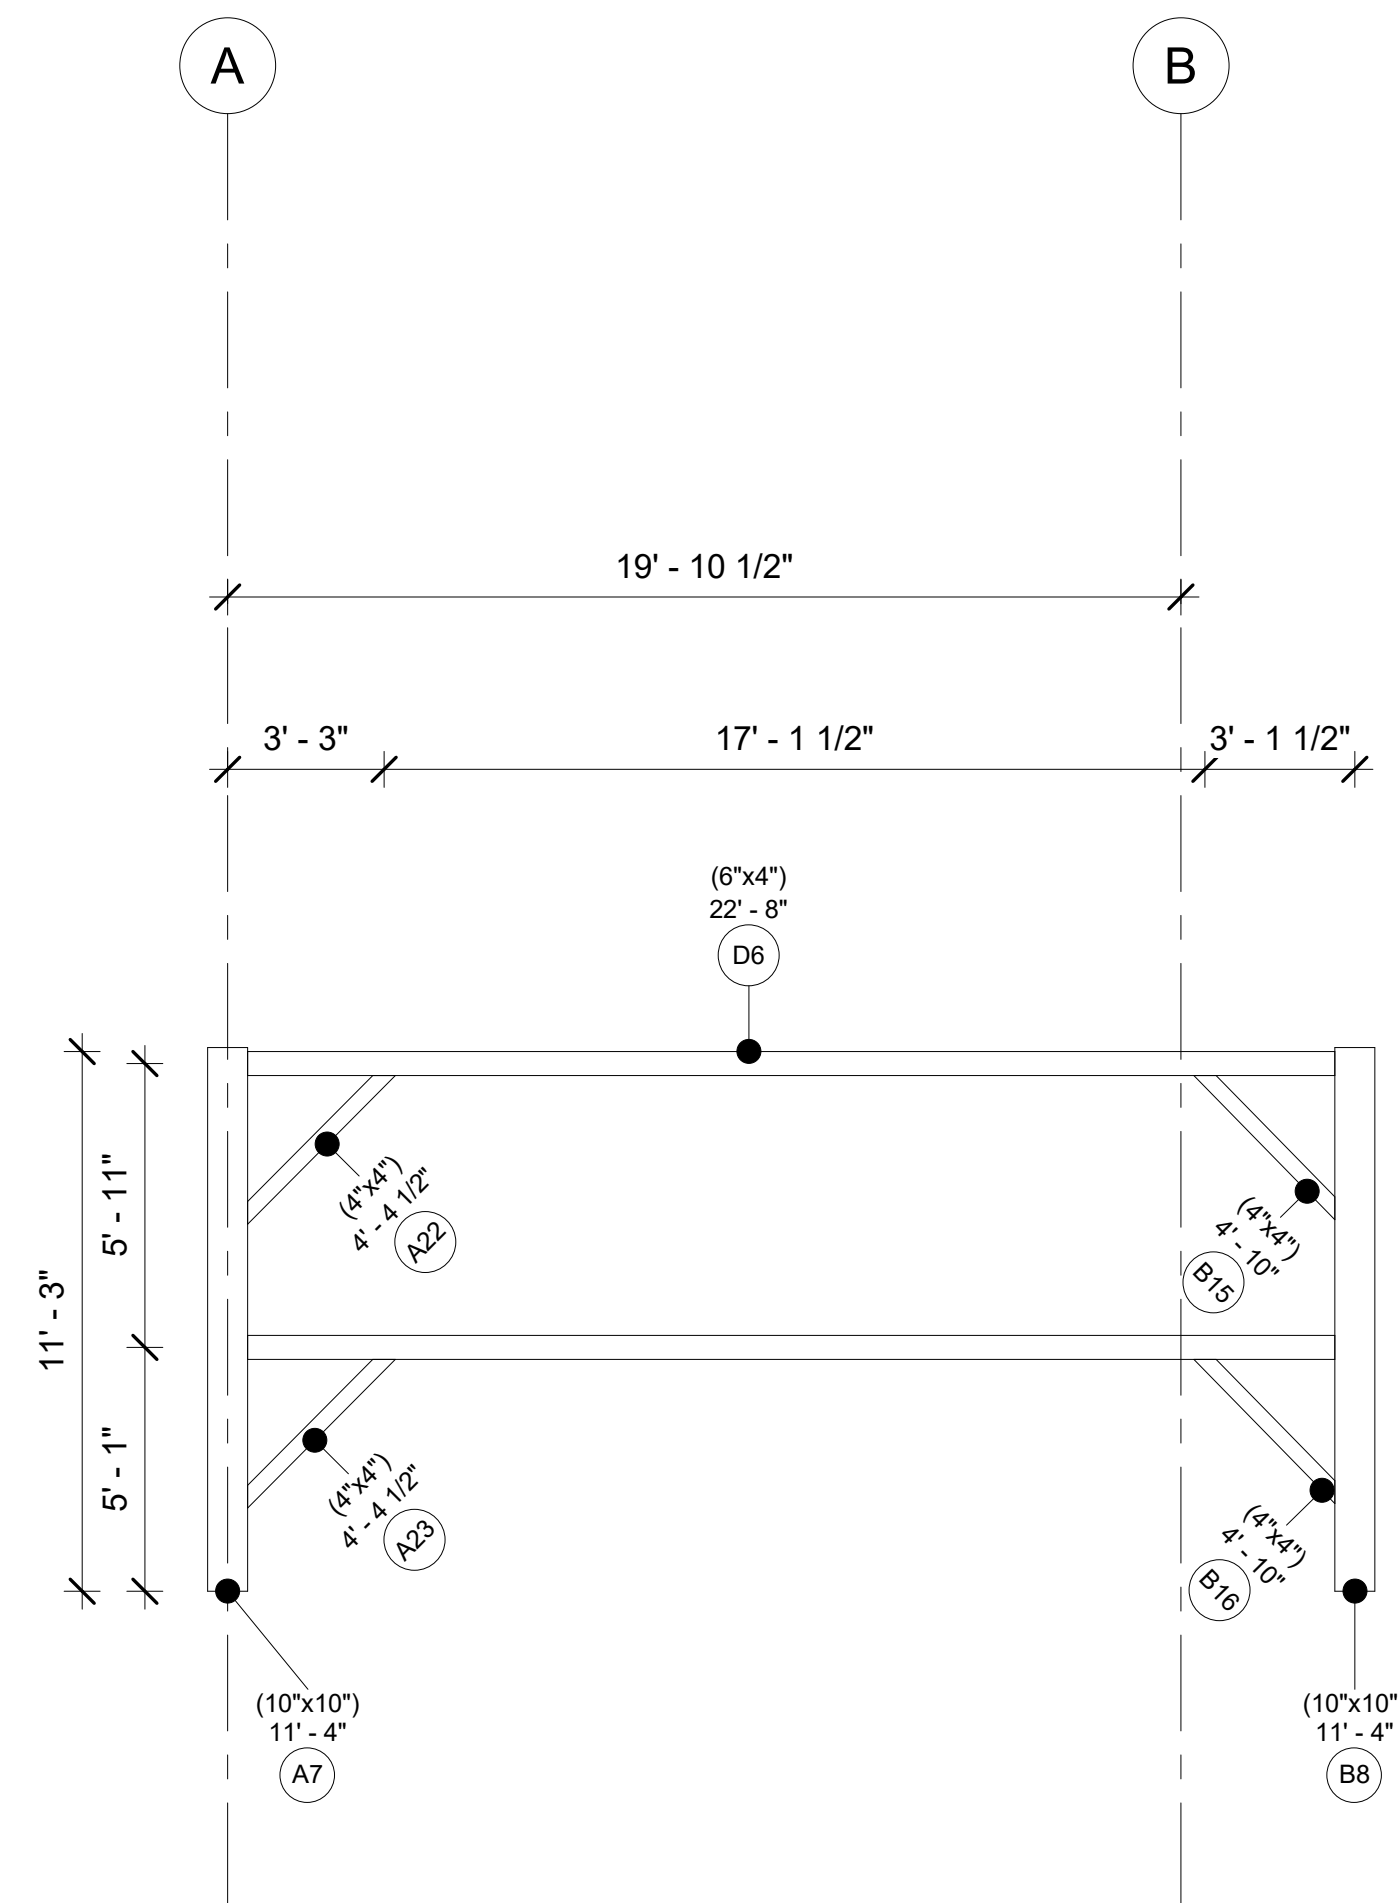

## Bent 3

Project Number	Project 13
Date	20250510
Drawn By	
Checked By	

# A109

Scale 1/4" = 1'-0"