


PROJECT: Winding Creek Barn
SCOPE: AS BUILT DRAWINGS

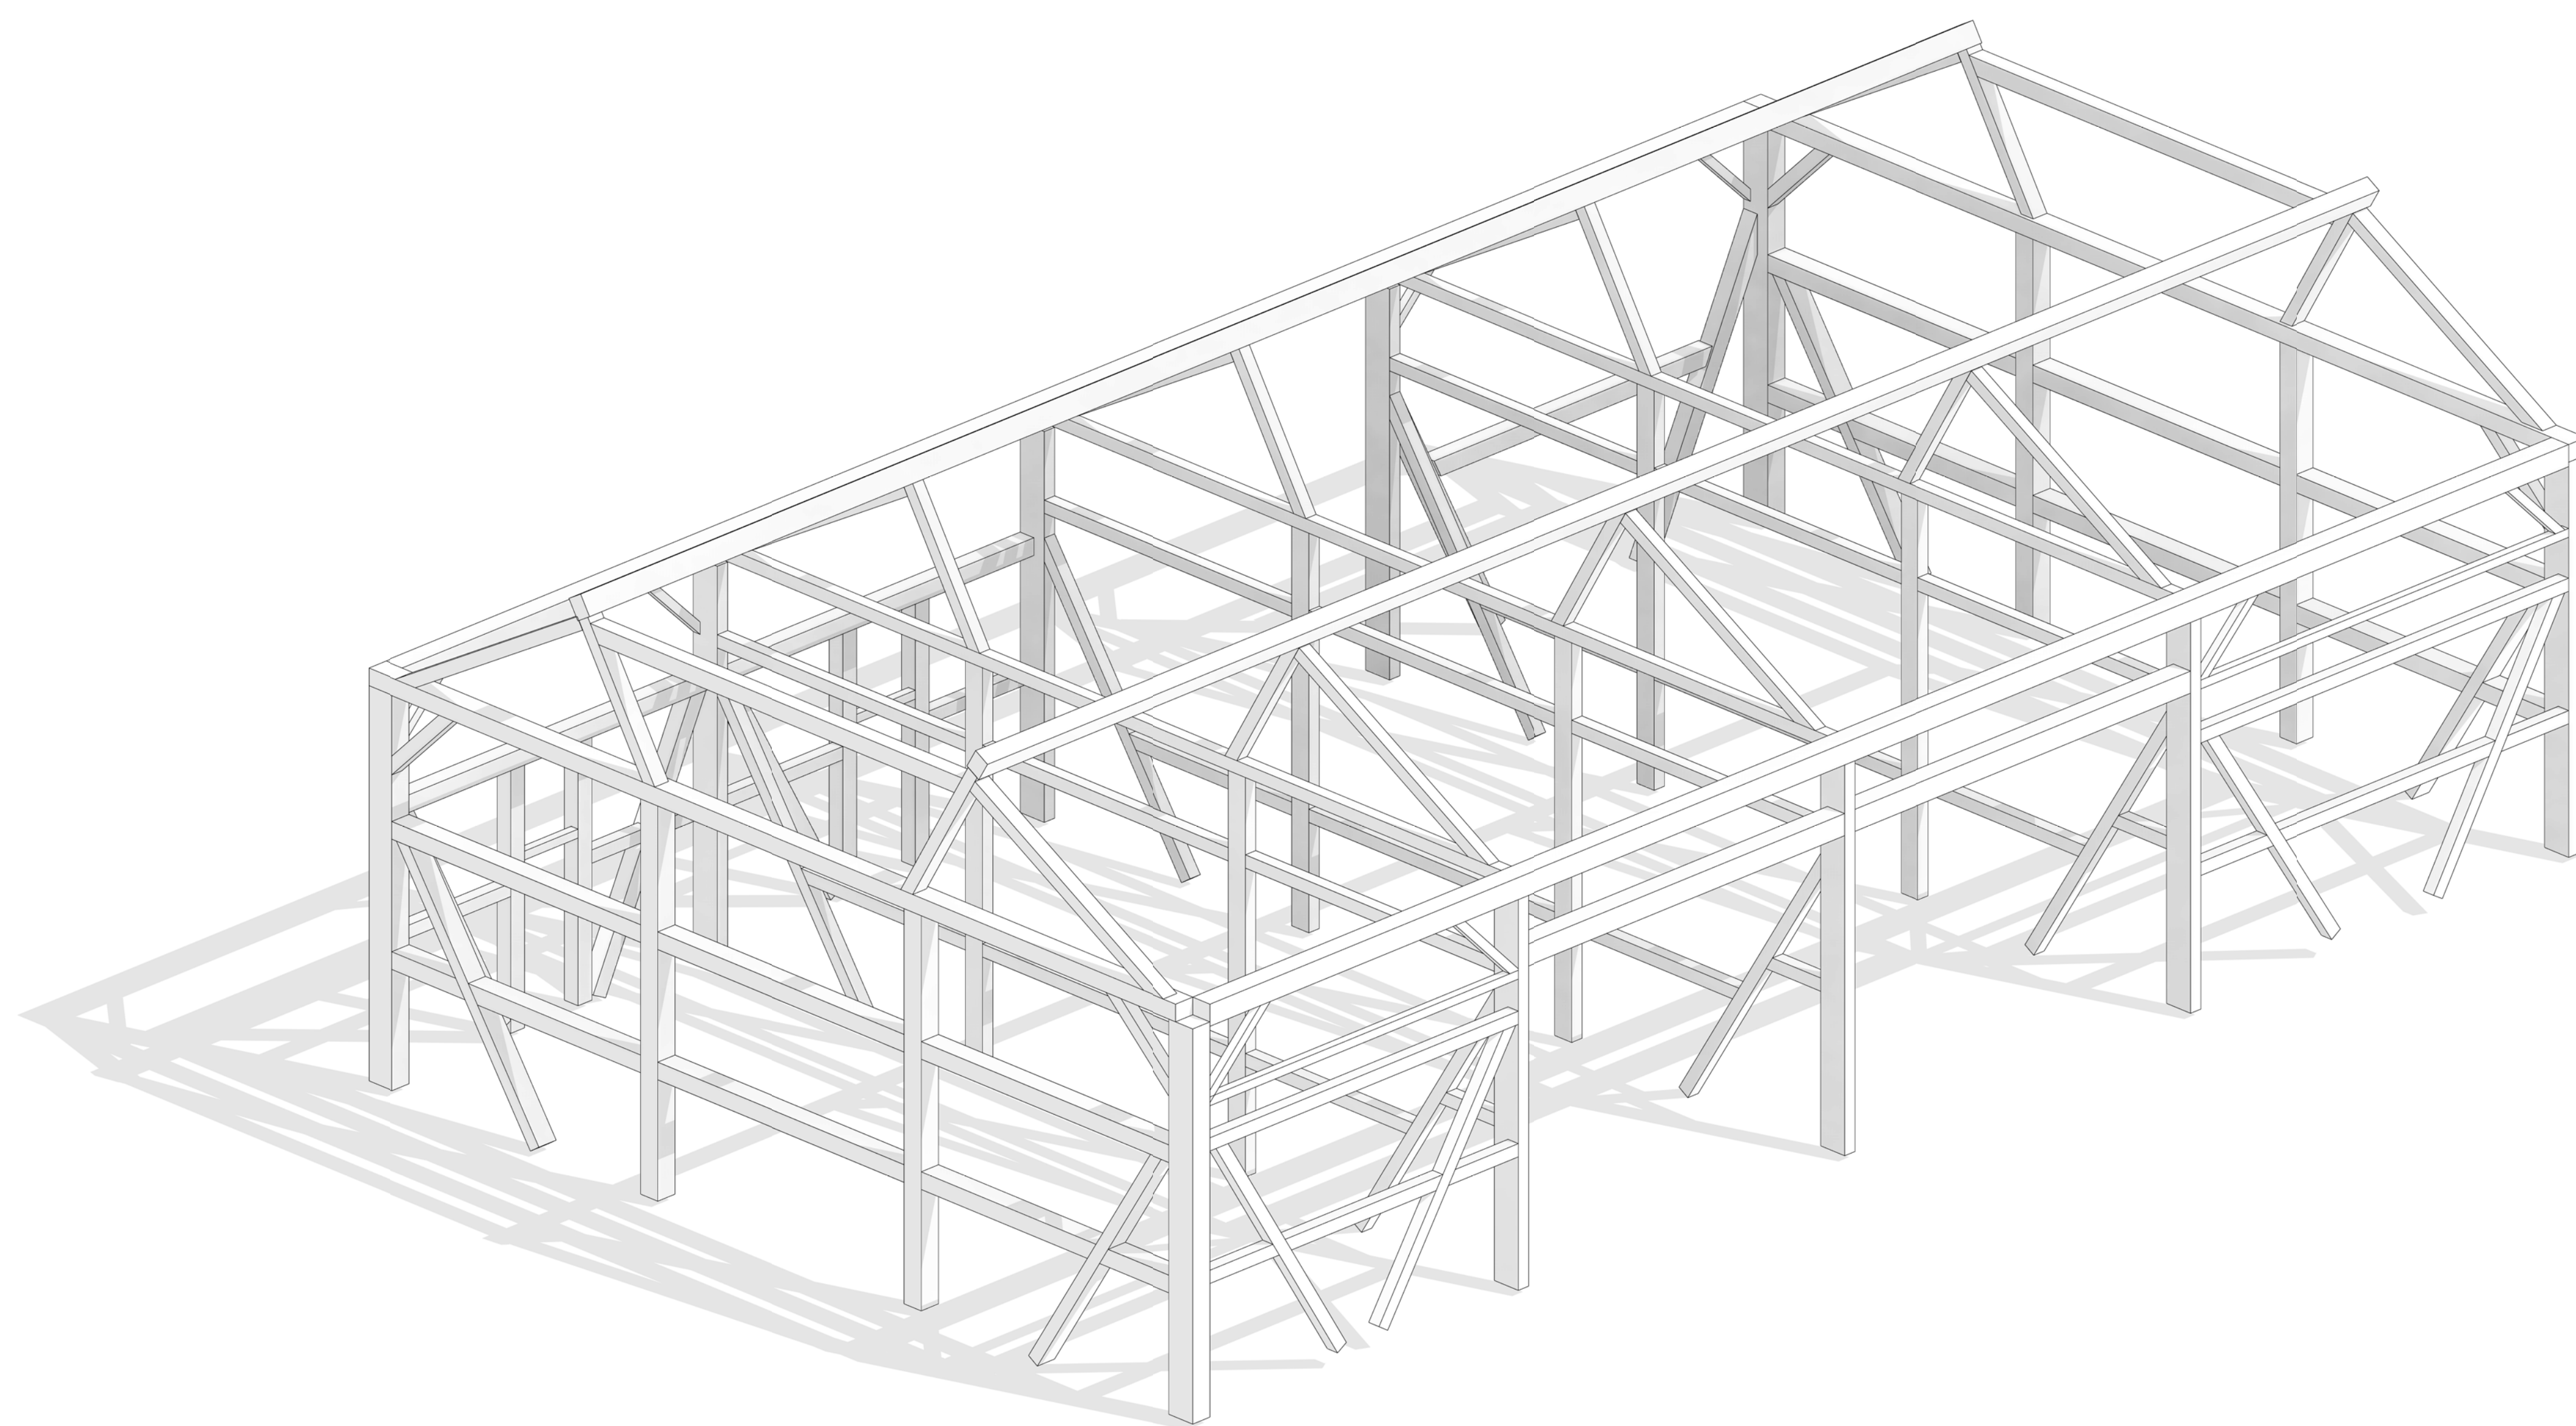

Winding Creek Barn


Cover Page

Project Number	Project 15
Date	20250524
Drawn By	
Checked By	

A101

Scale

Winding Creek Barn

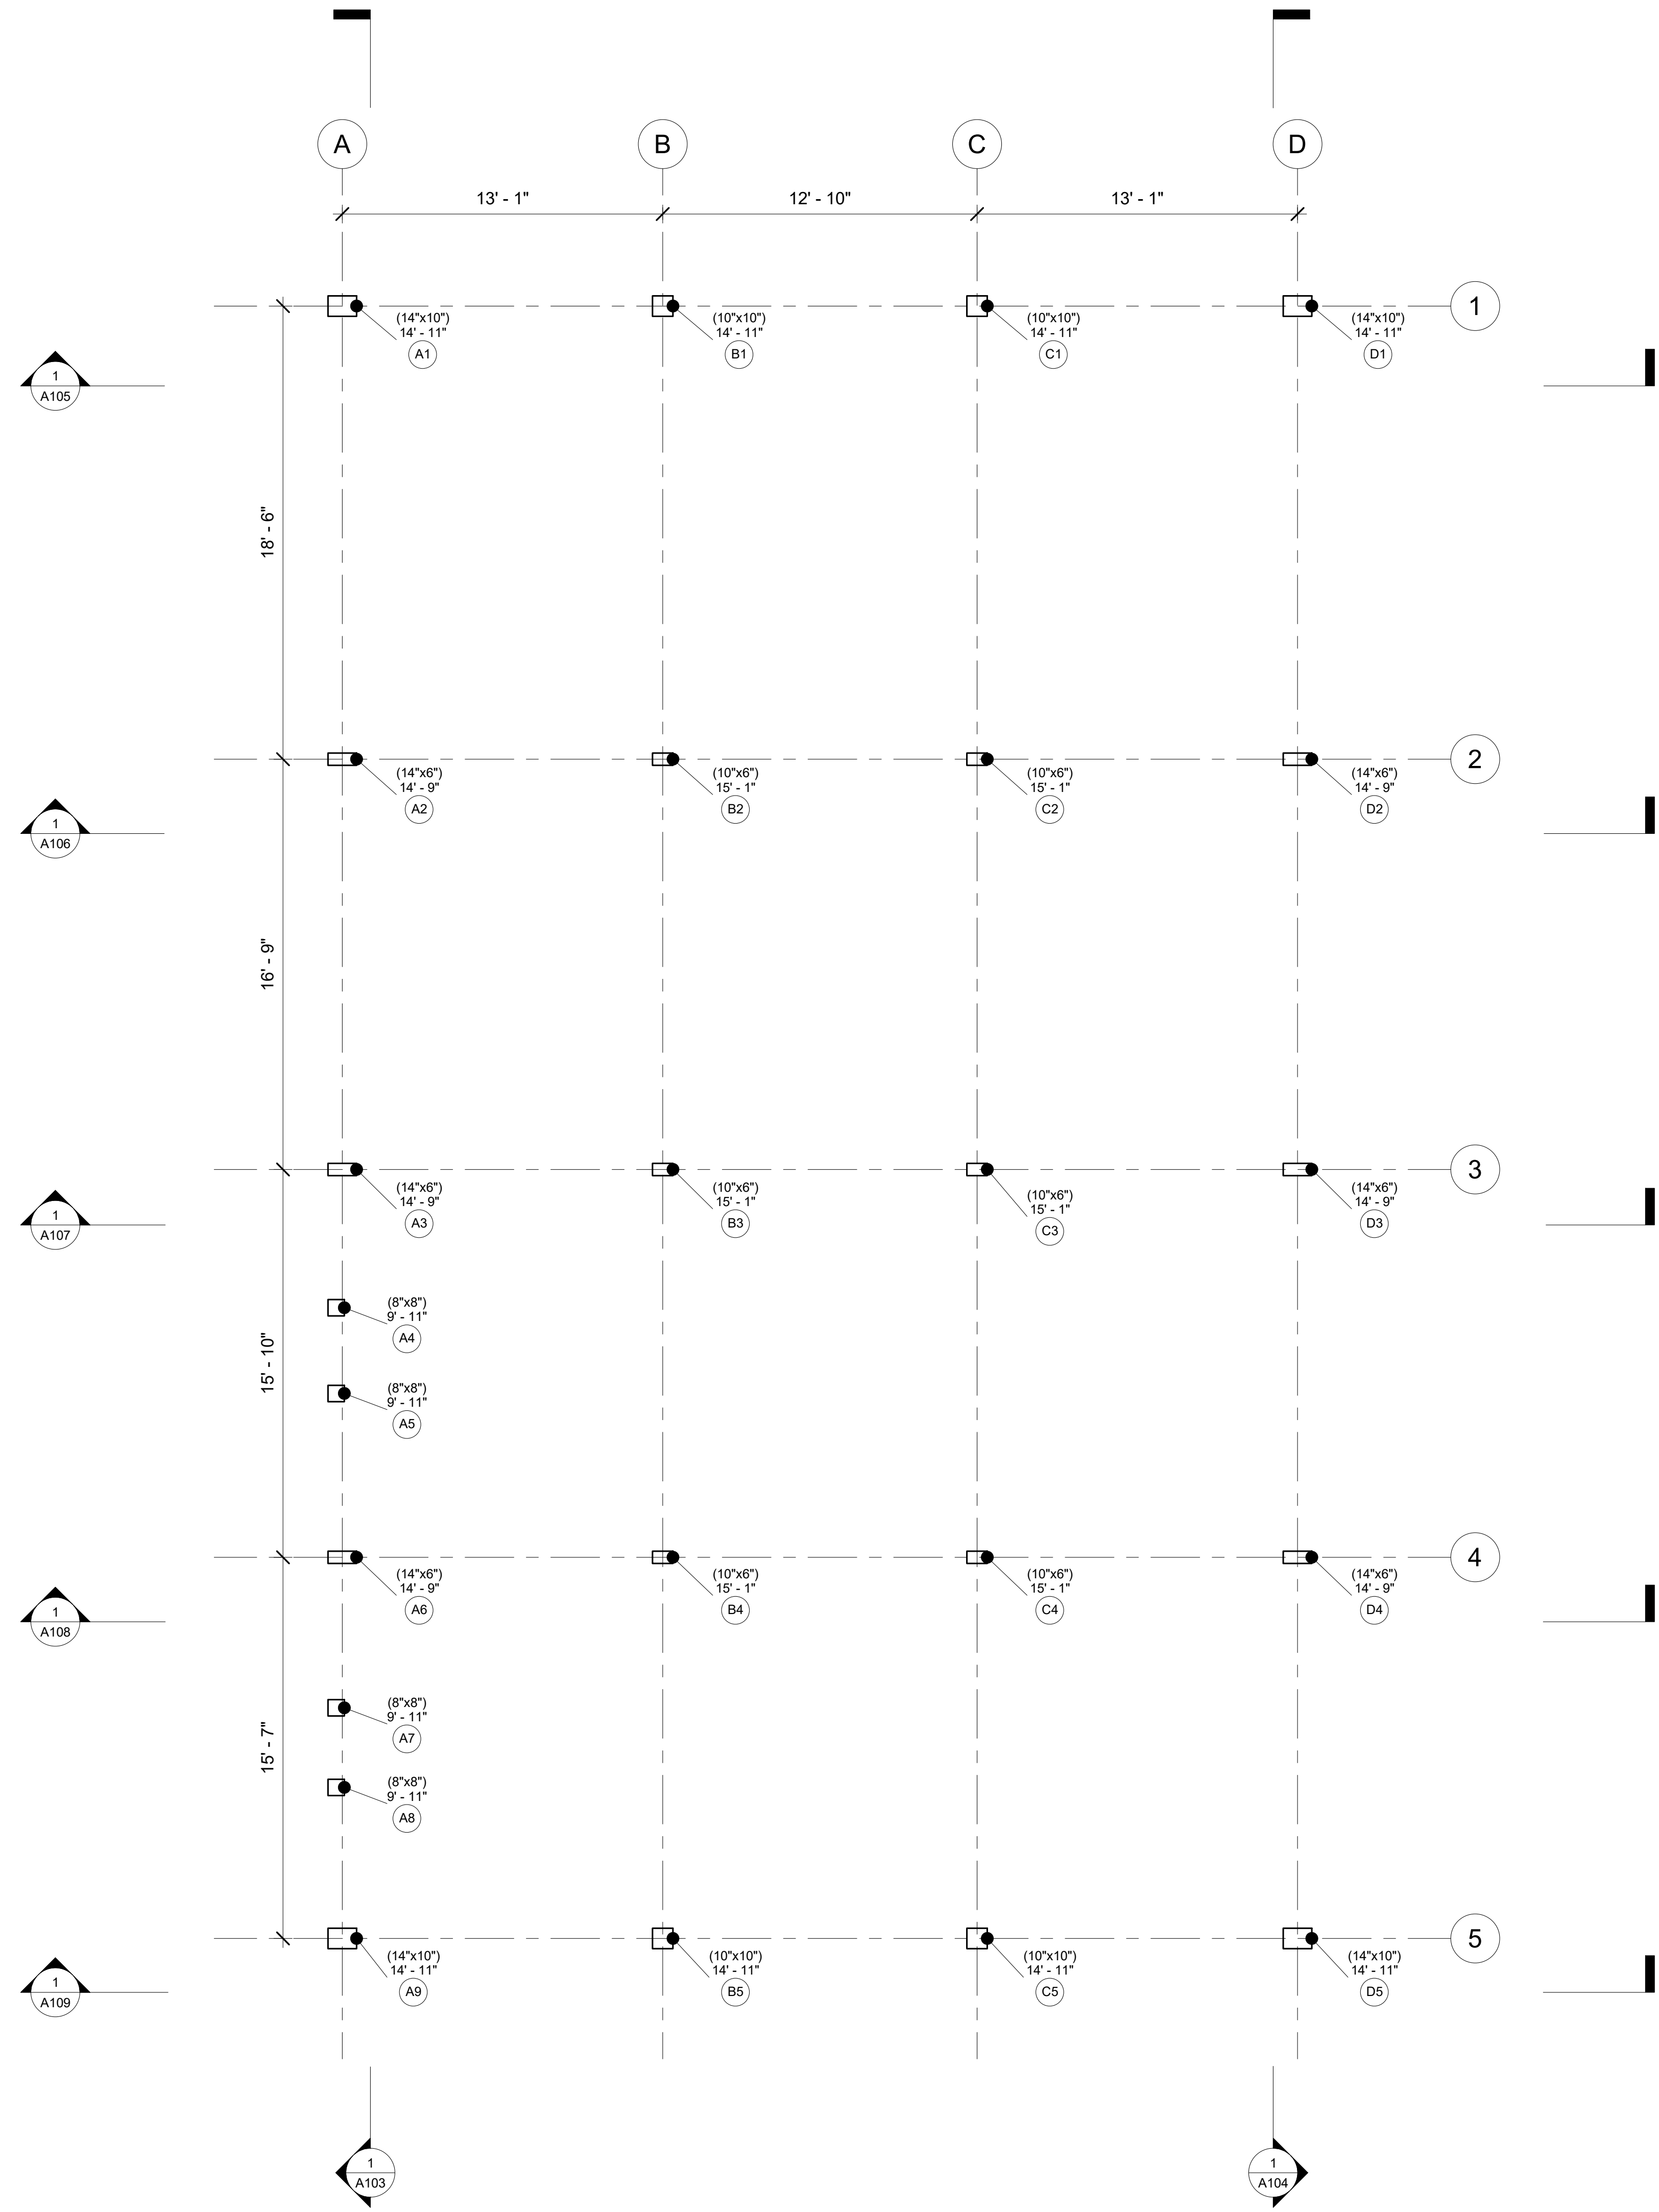


Floor Plan

Project Number	Project 15
Date	20250524
Drawn By	
Checked By	

A102

Scale 1/4" = 1'-0"

Winding Creek Barn

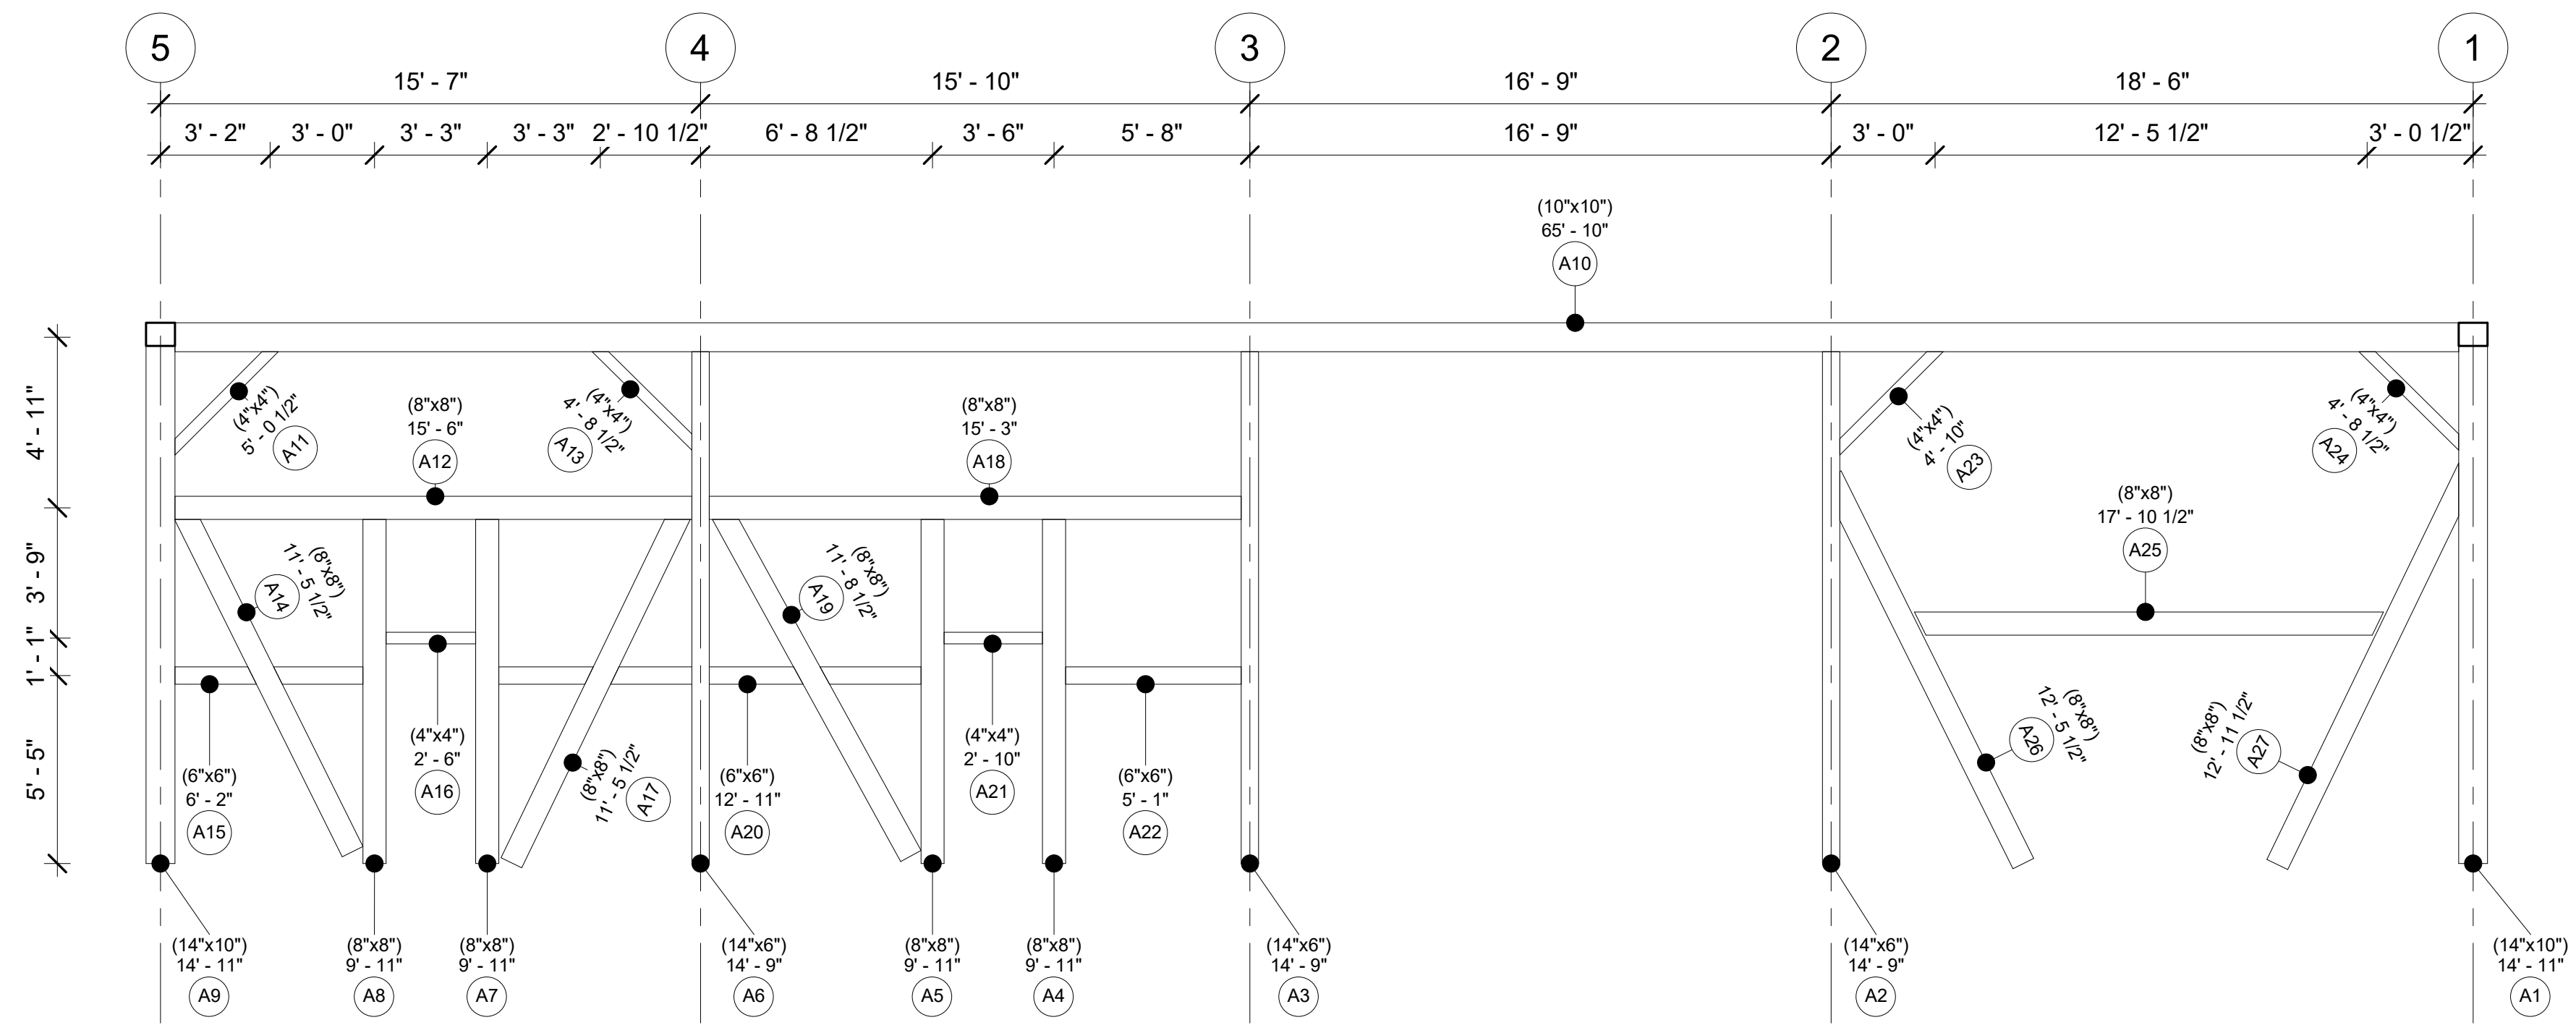


Bent A

Project Number	Project 15
Date	20250524
Drawn By	
Checked By	

A103

Scale	1/4" = 1'-0"
-------	--------------

Winding Creek Barn

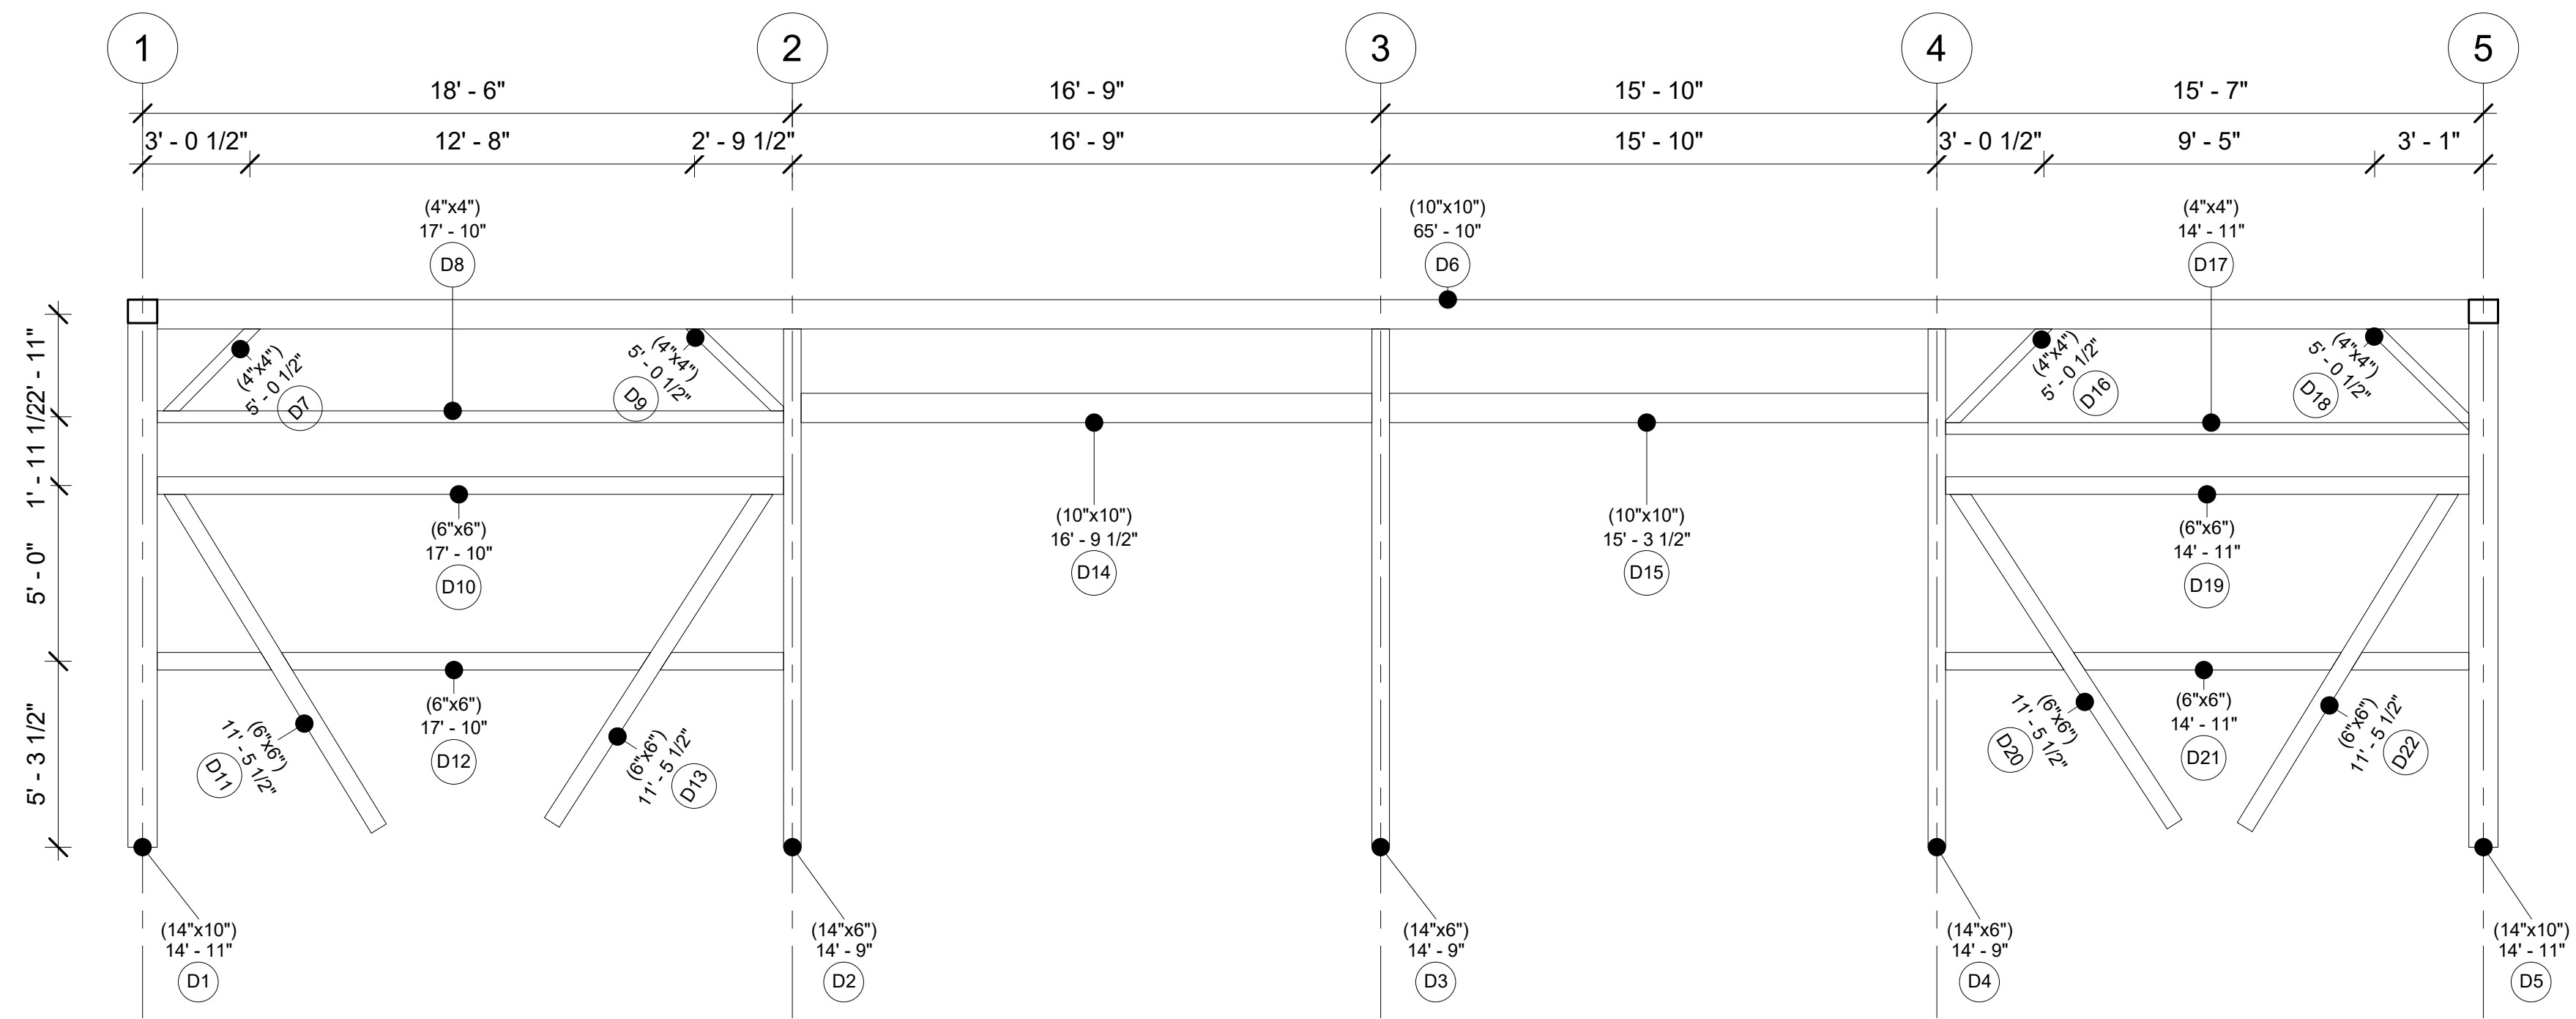


Bent D

Project Number	Project 15
Date	20250524
Drawn By	
Checked By	

A104

Scale	1/4" = 1'-0"
-------	--------------

Winding Creek Barn

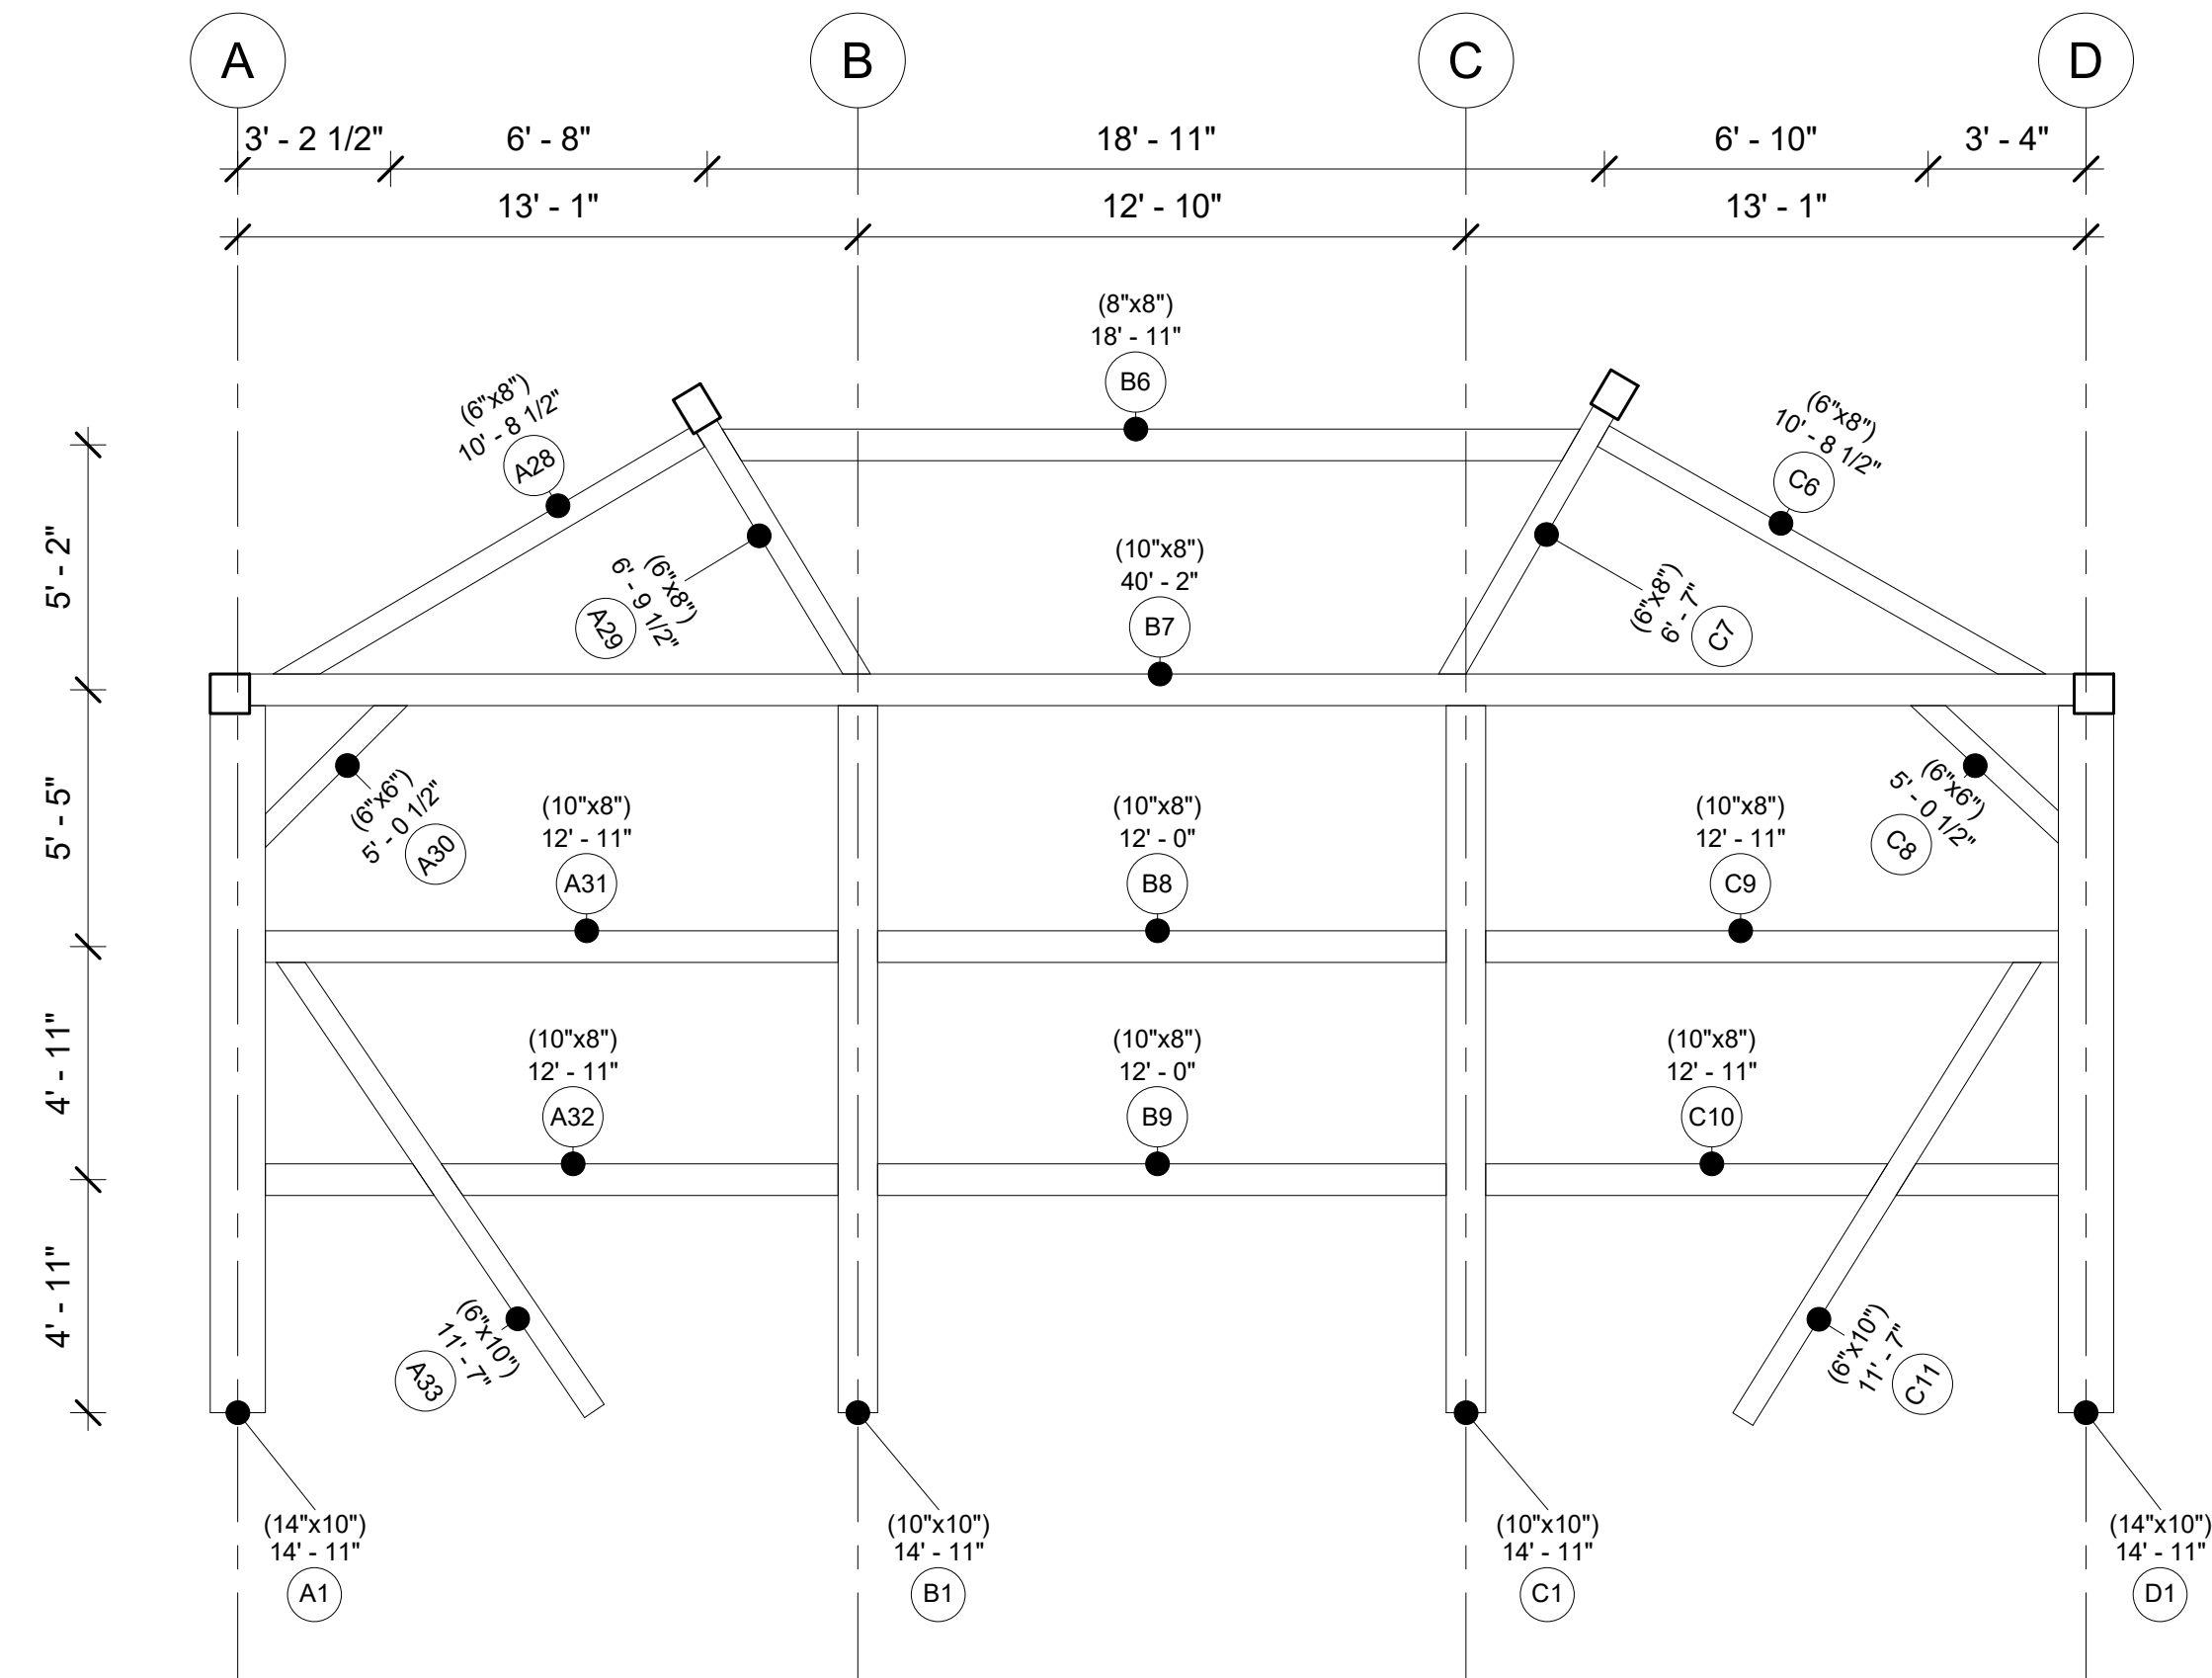


Bent 1

Project Number	Project 15
Date	20250524
Drawn By	
Checked By	

A105

Scale	1/4" = 1'-0"
-------	--------------

Winding Creek Barn

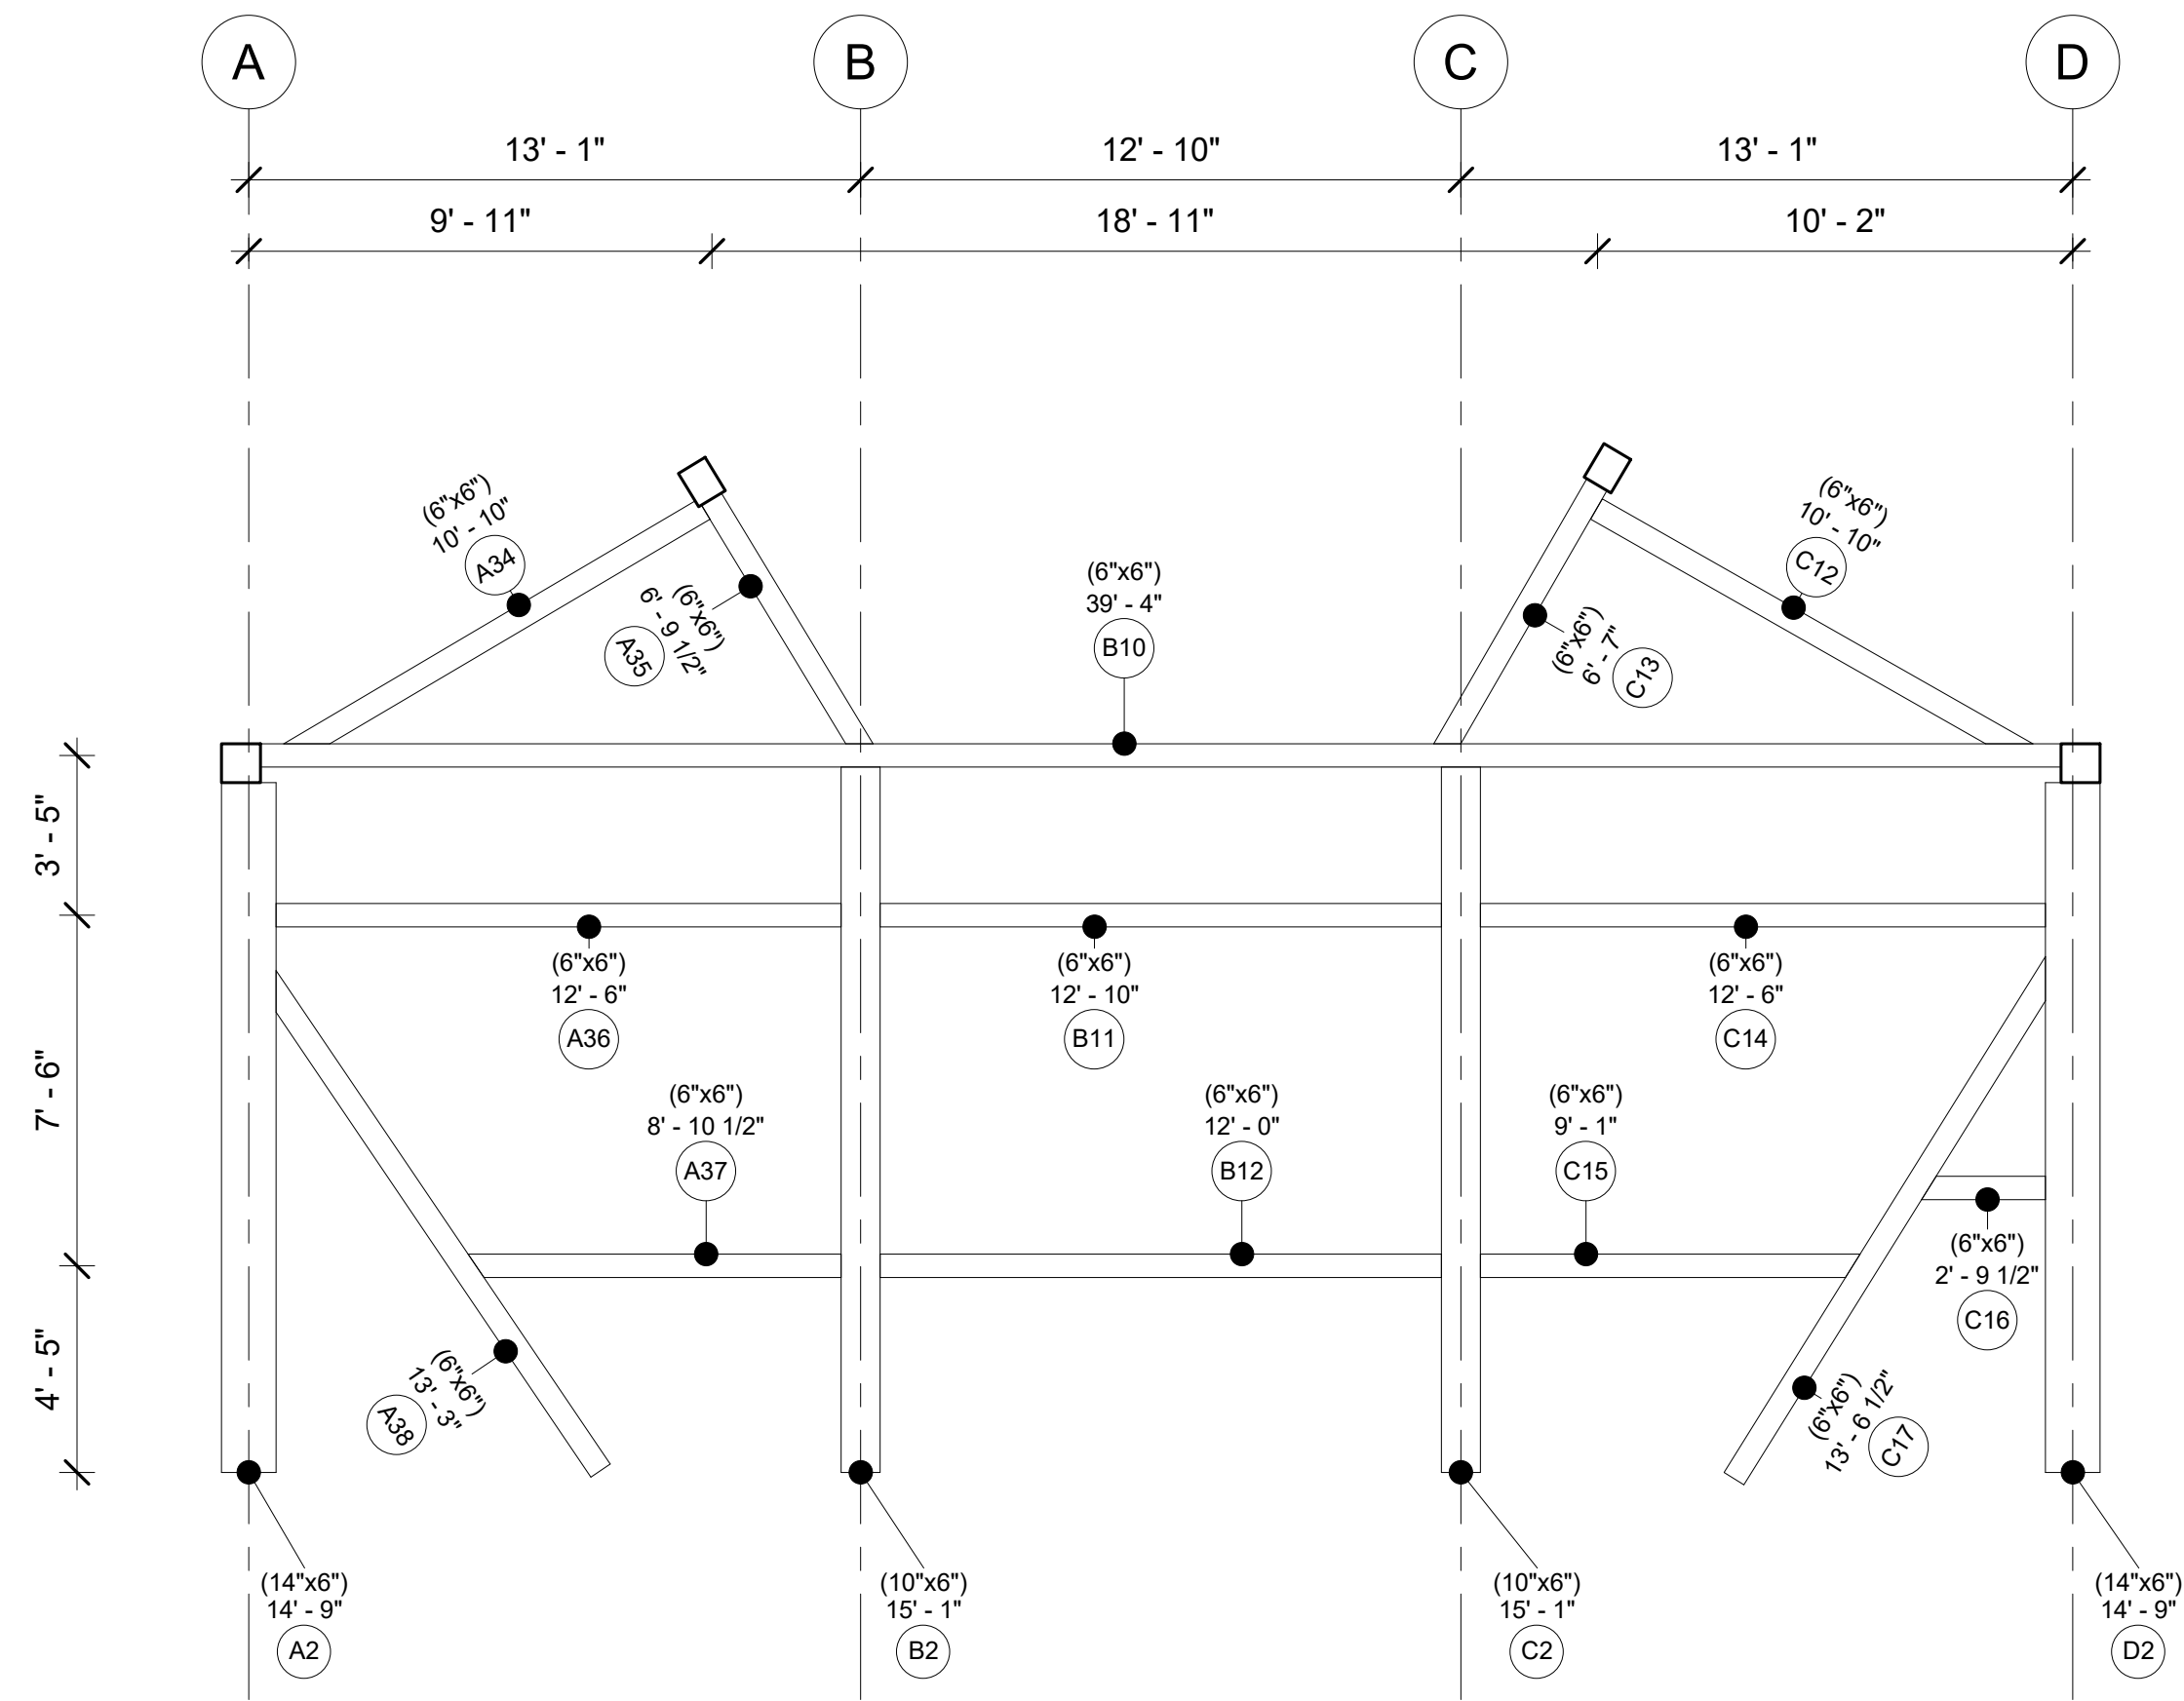


Bent 2

Project Number	Project 15
Date	20250524
Drawn By	
Checked By	

A106

Scale	1/4" = 1'-0"
-------	--------------

Winding Creek Barn

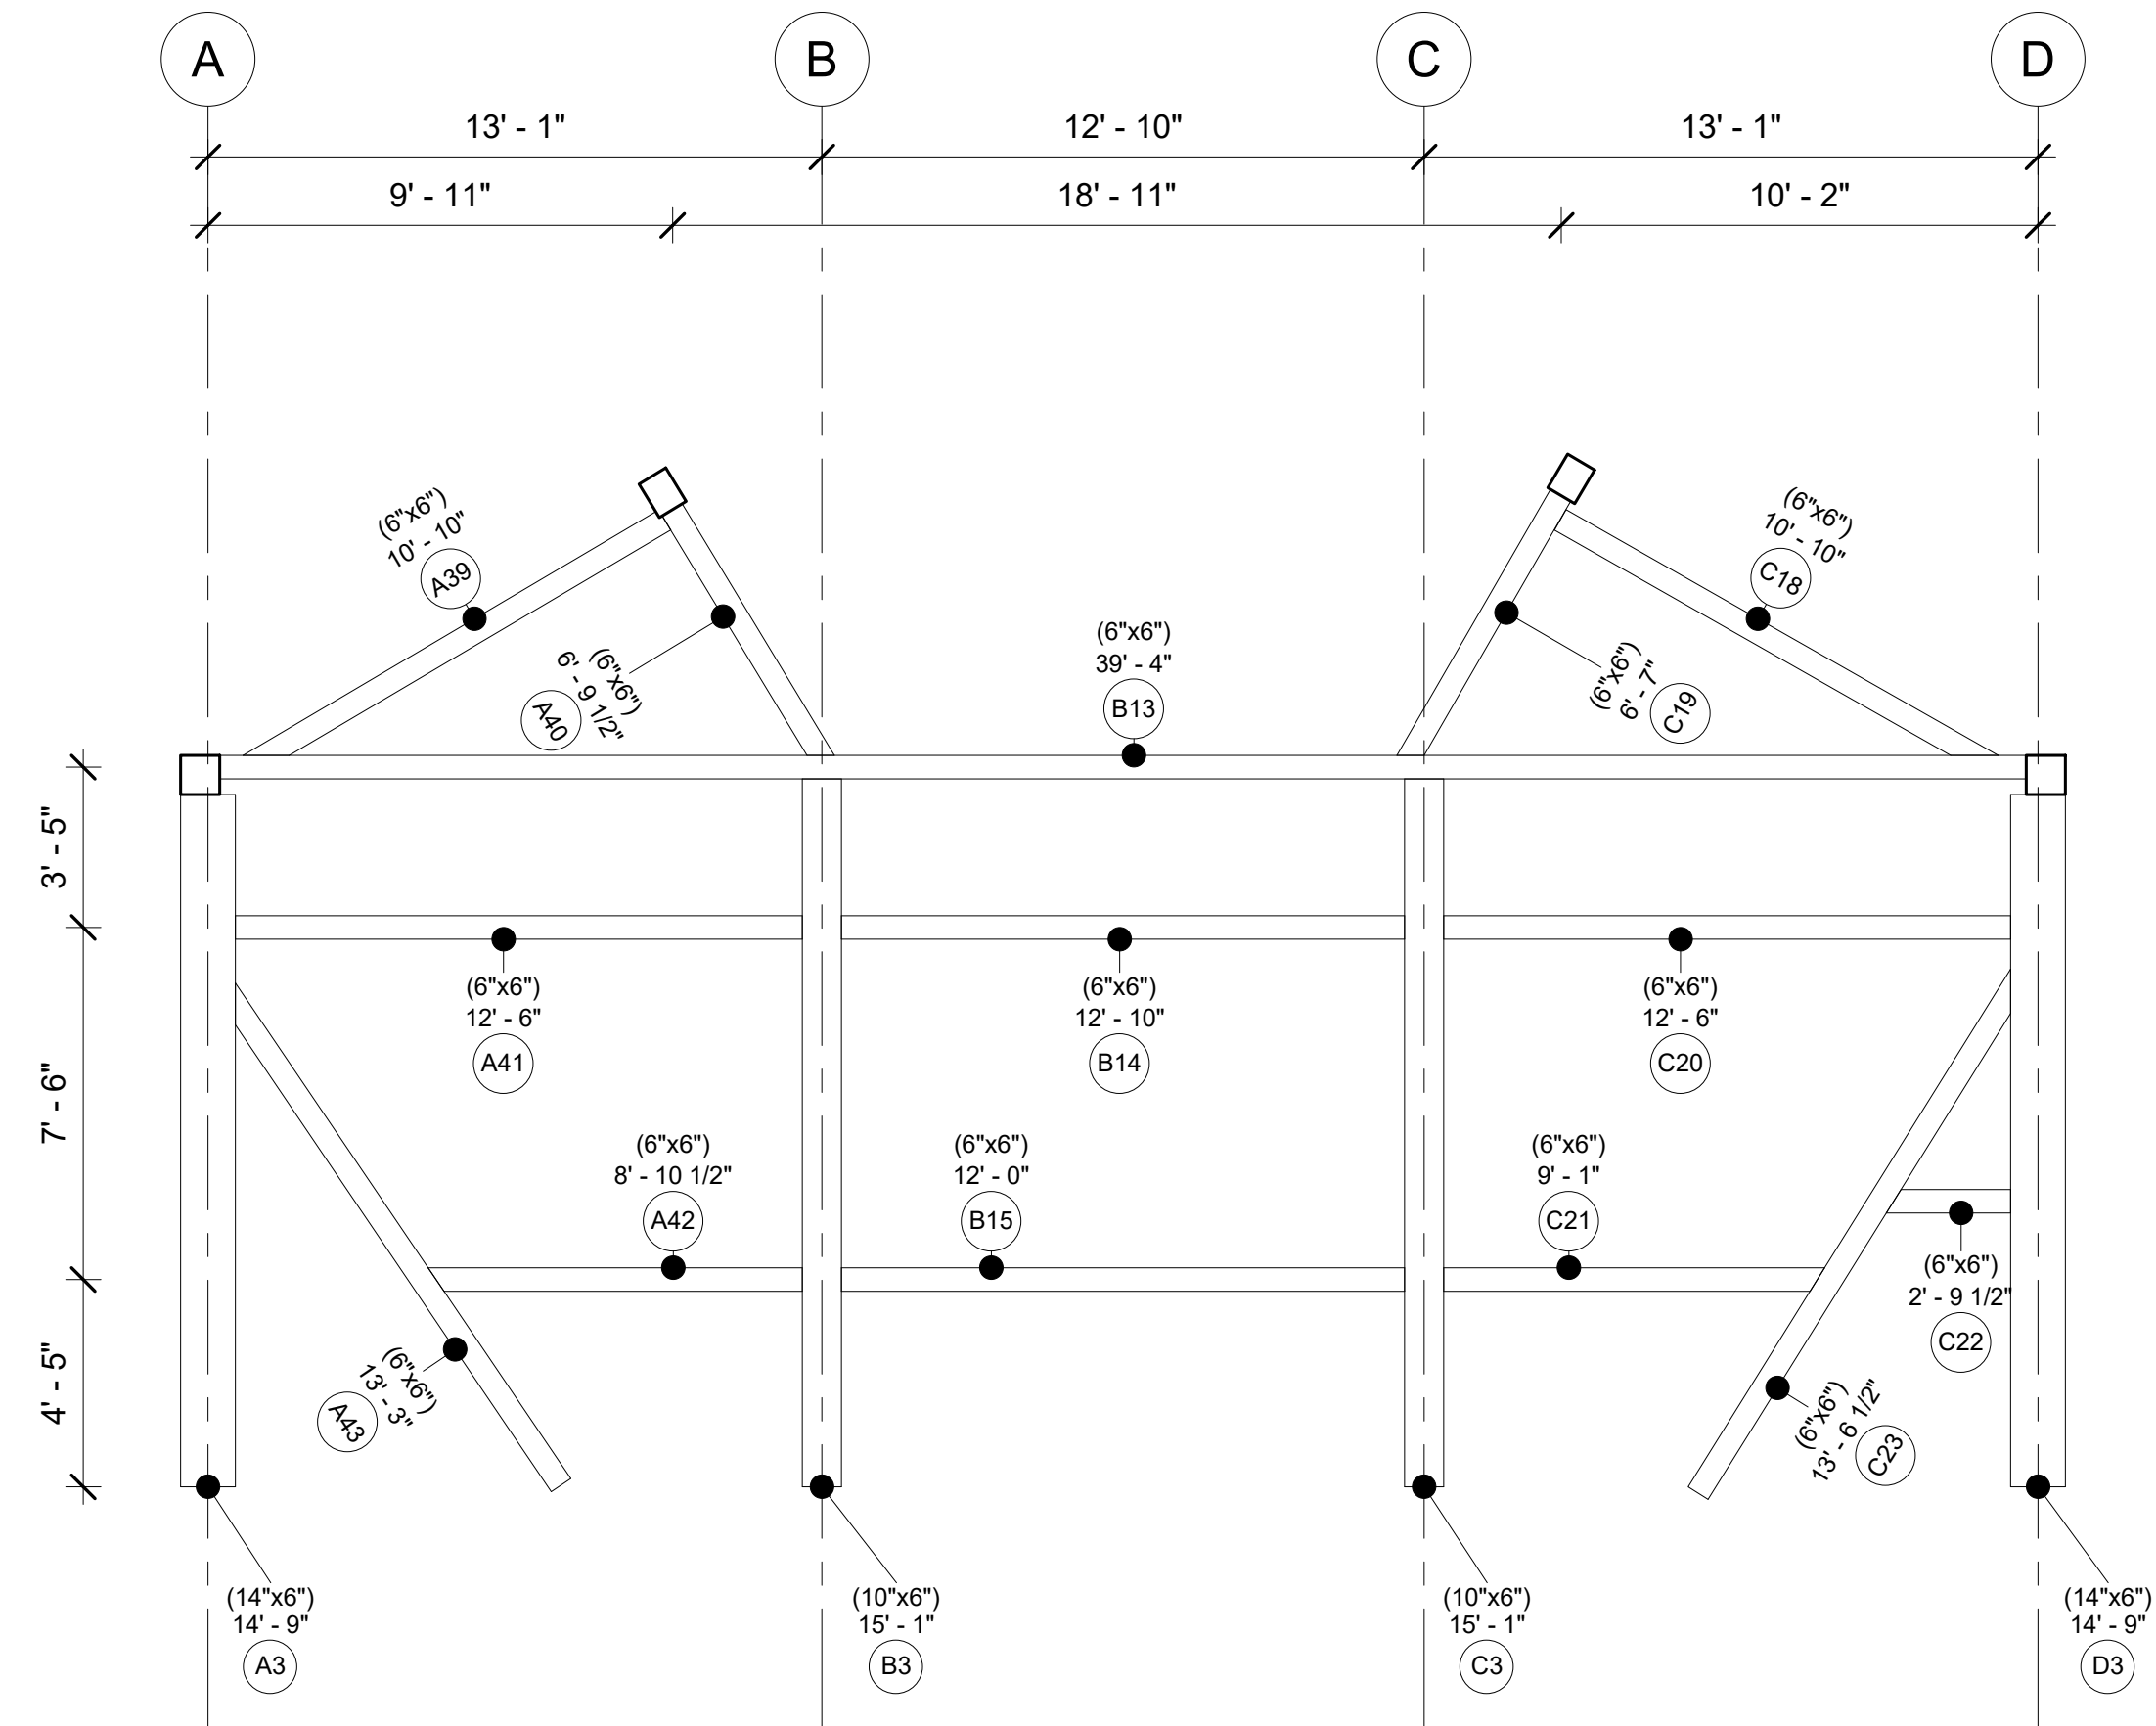


Bent 3

Project Number	Project 15
Date	20250524
Drawn By	
Checked By	

A107

Scale	1/4" = 1'-0"
-------	--------------

Winding Creek Barn

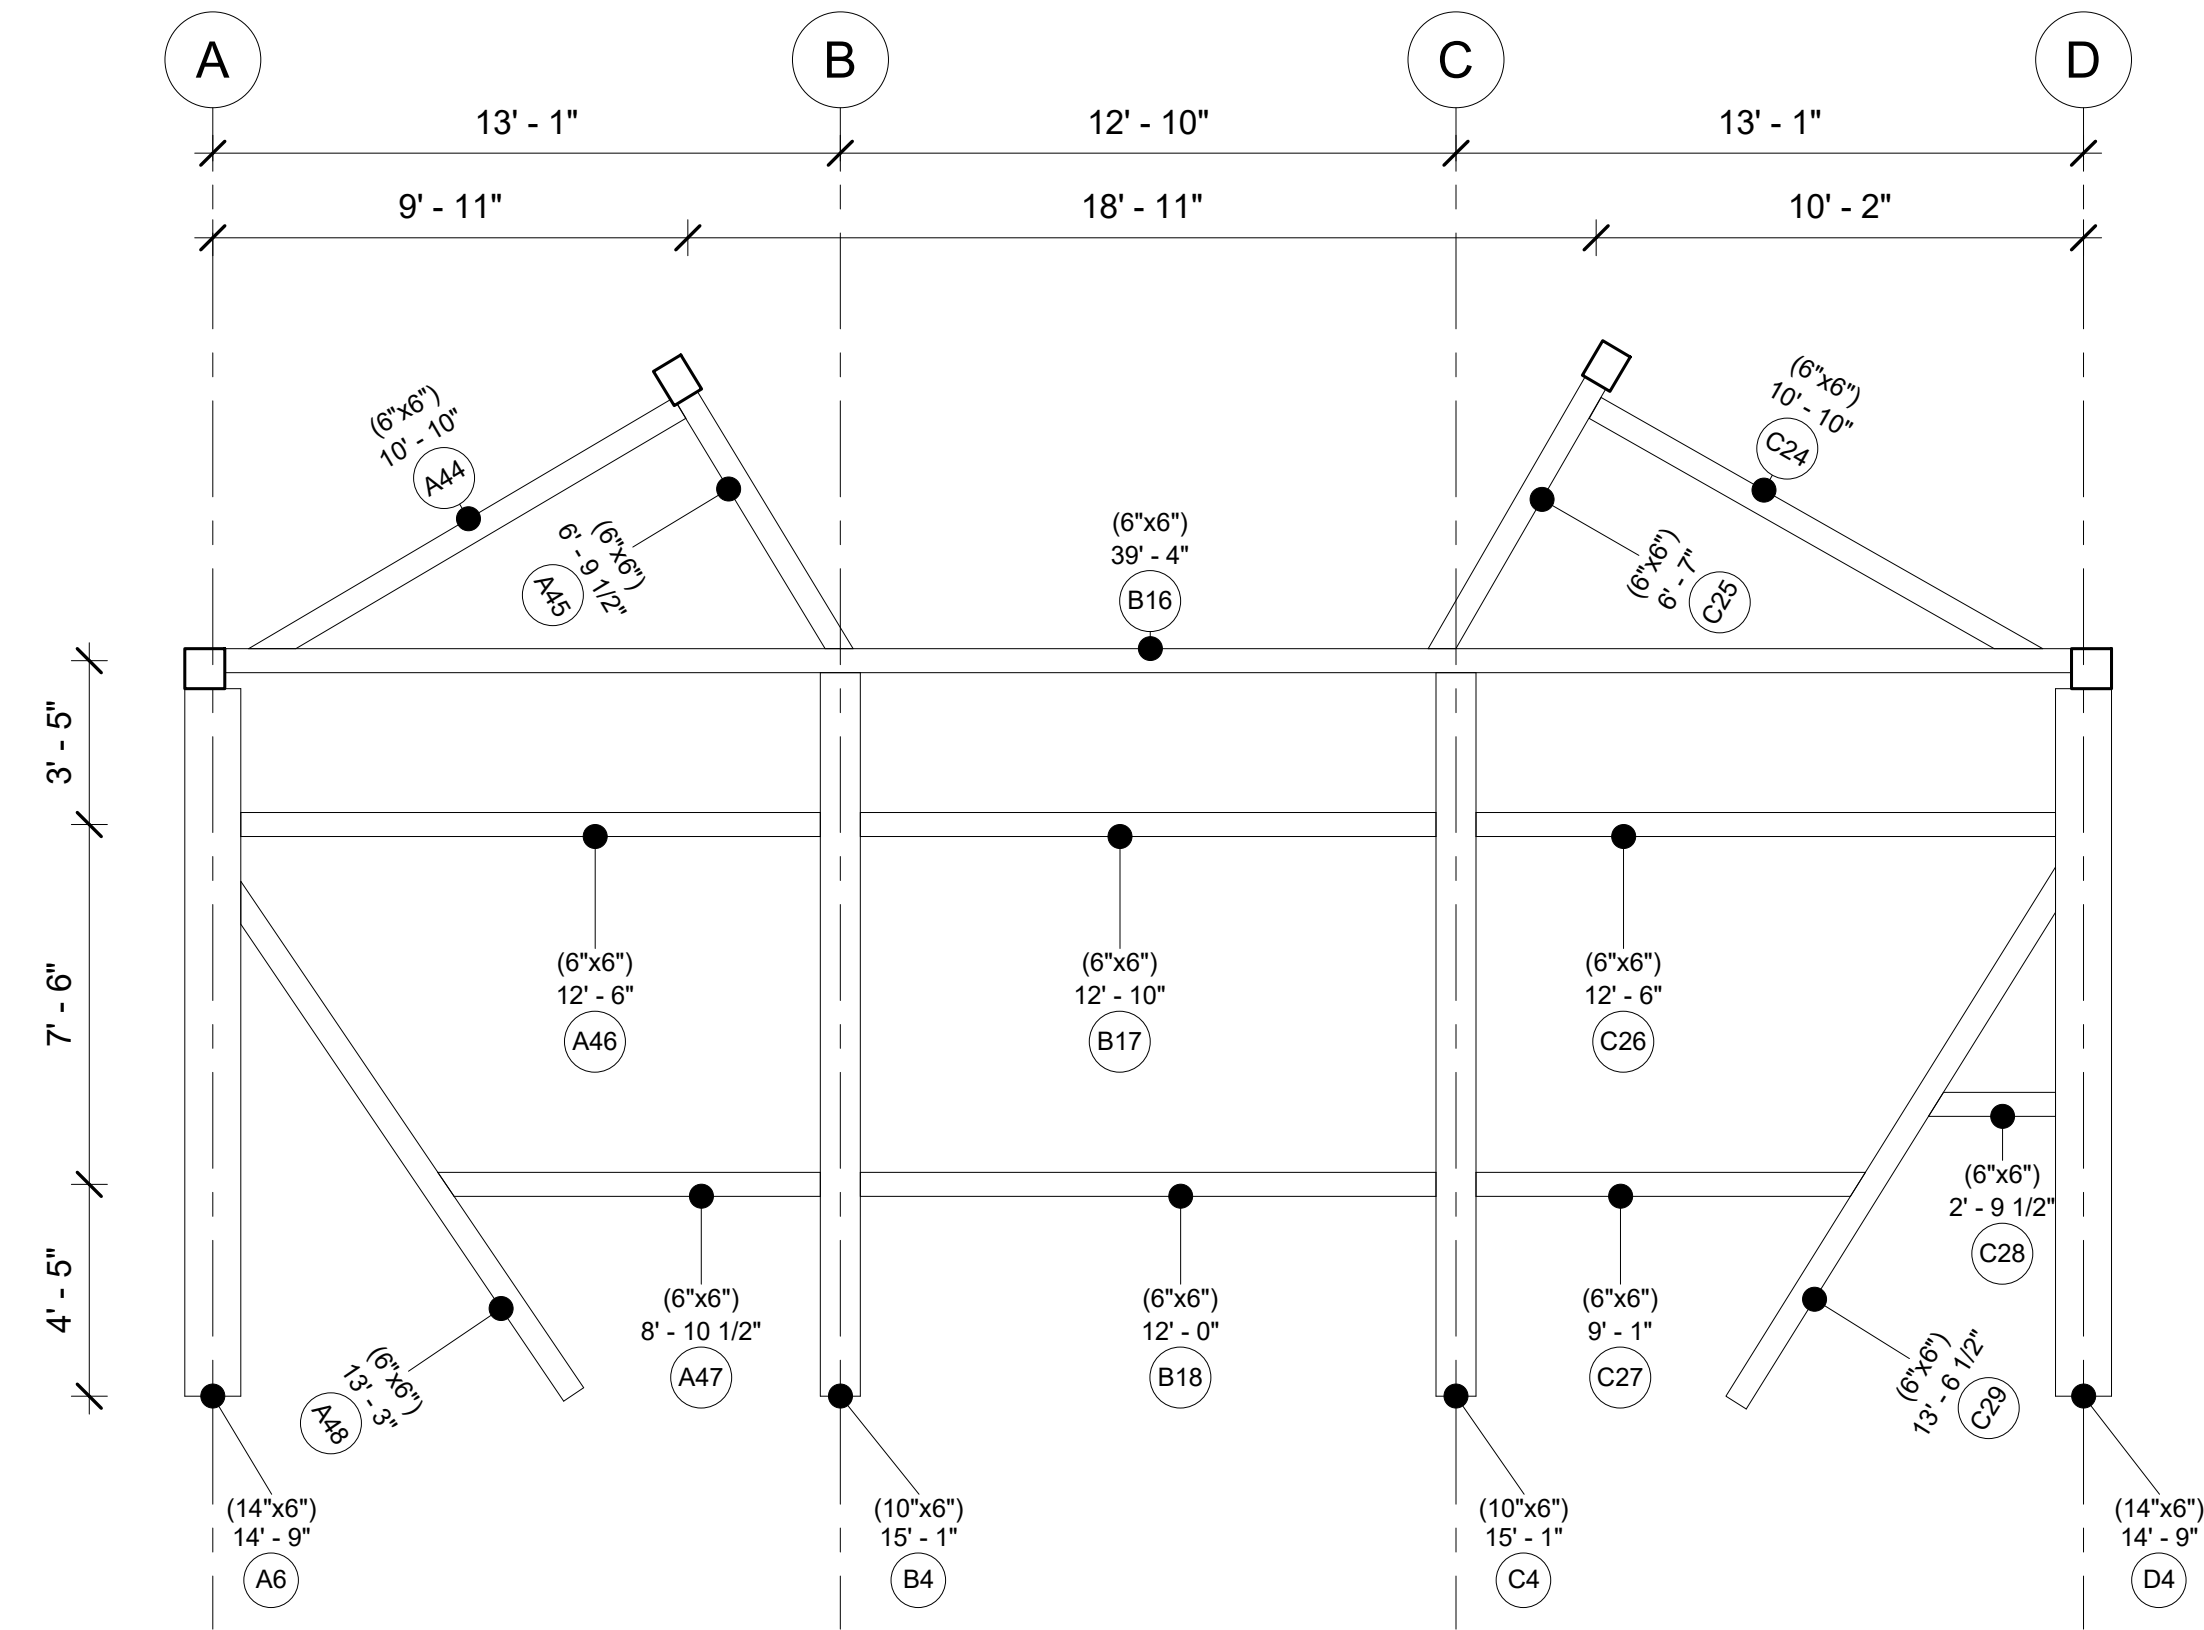


Bent 4

Project Number	Project 15
Date	20250524
Drawn By	
Checked By	

A108

Scale	1/4" = 1'-0"
-------	--------------

Winding Creek Barn

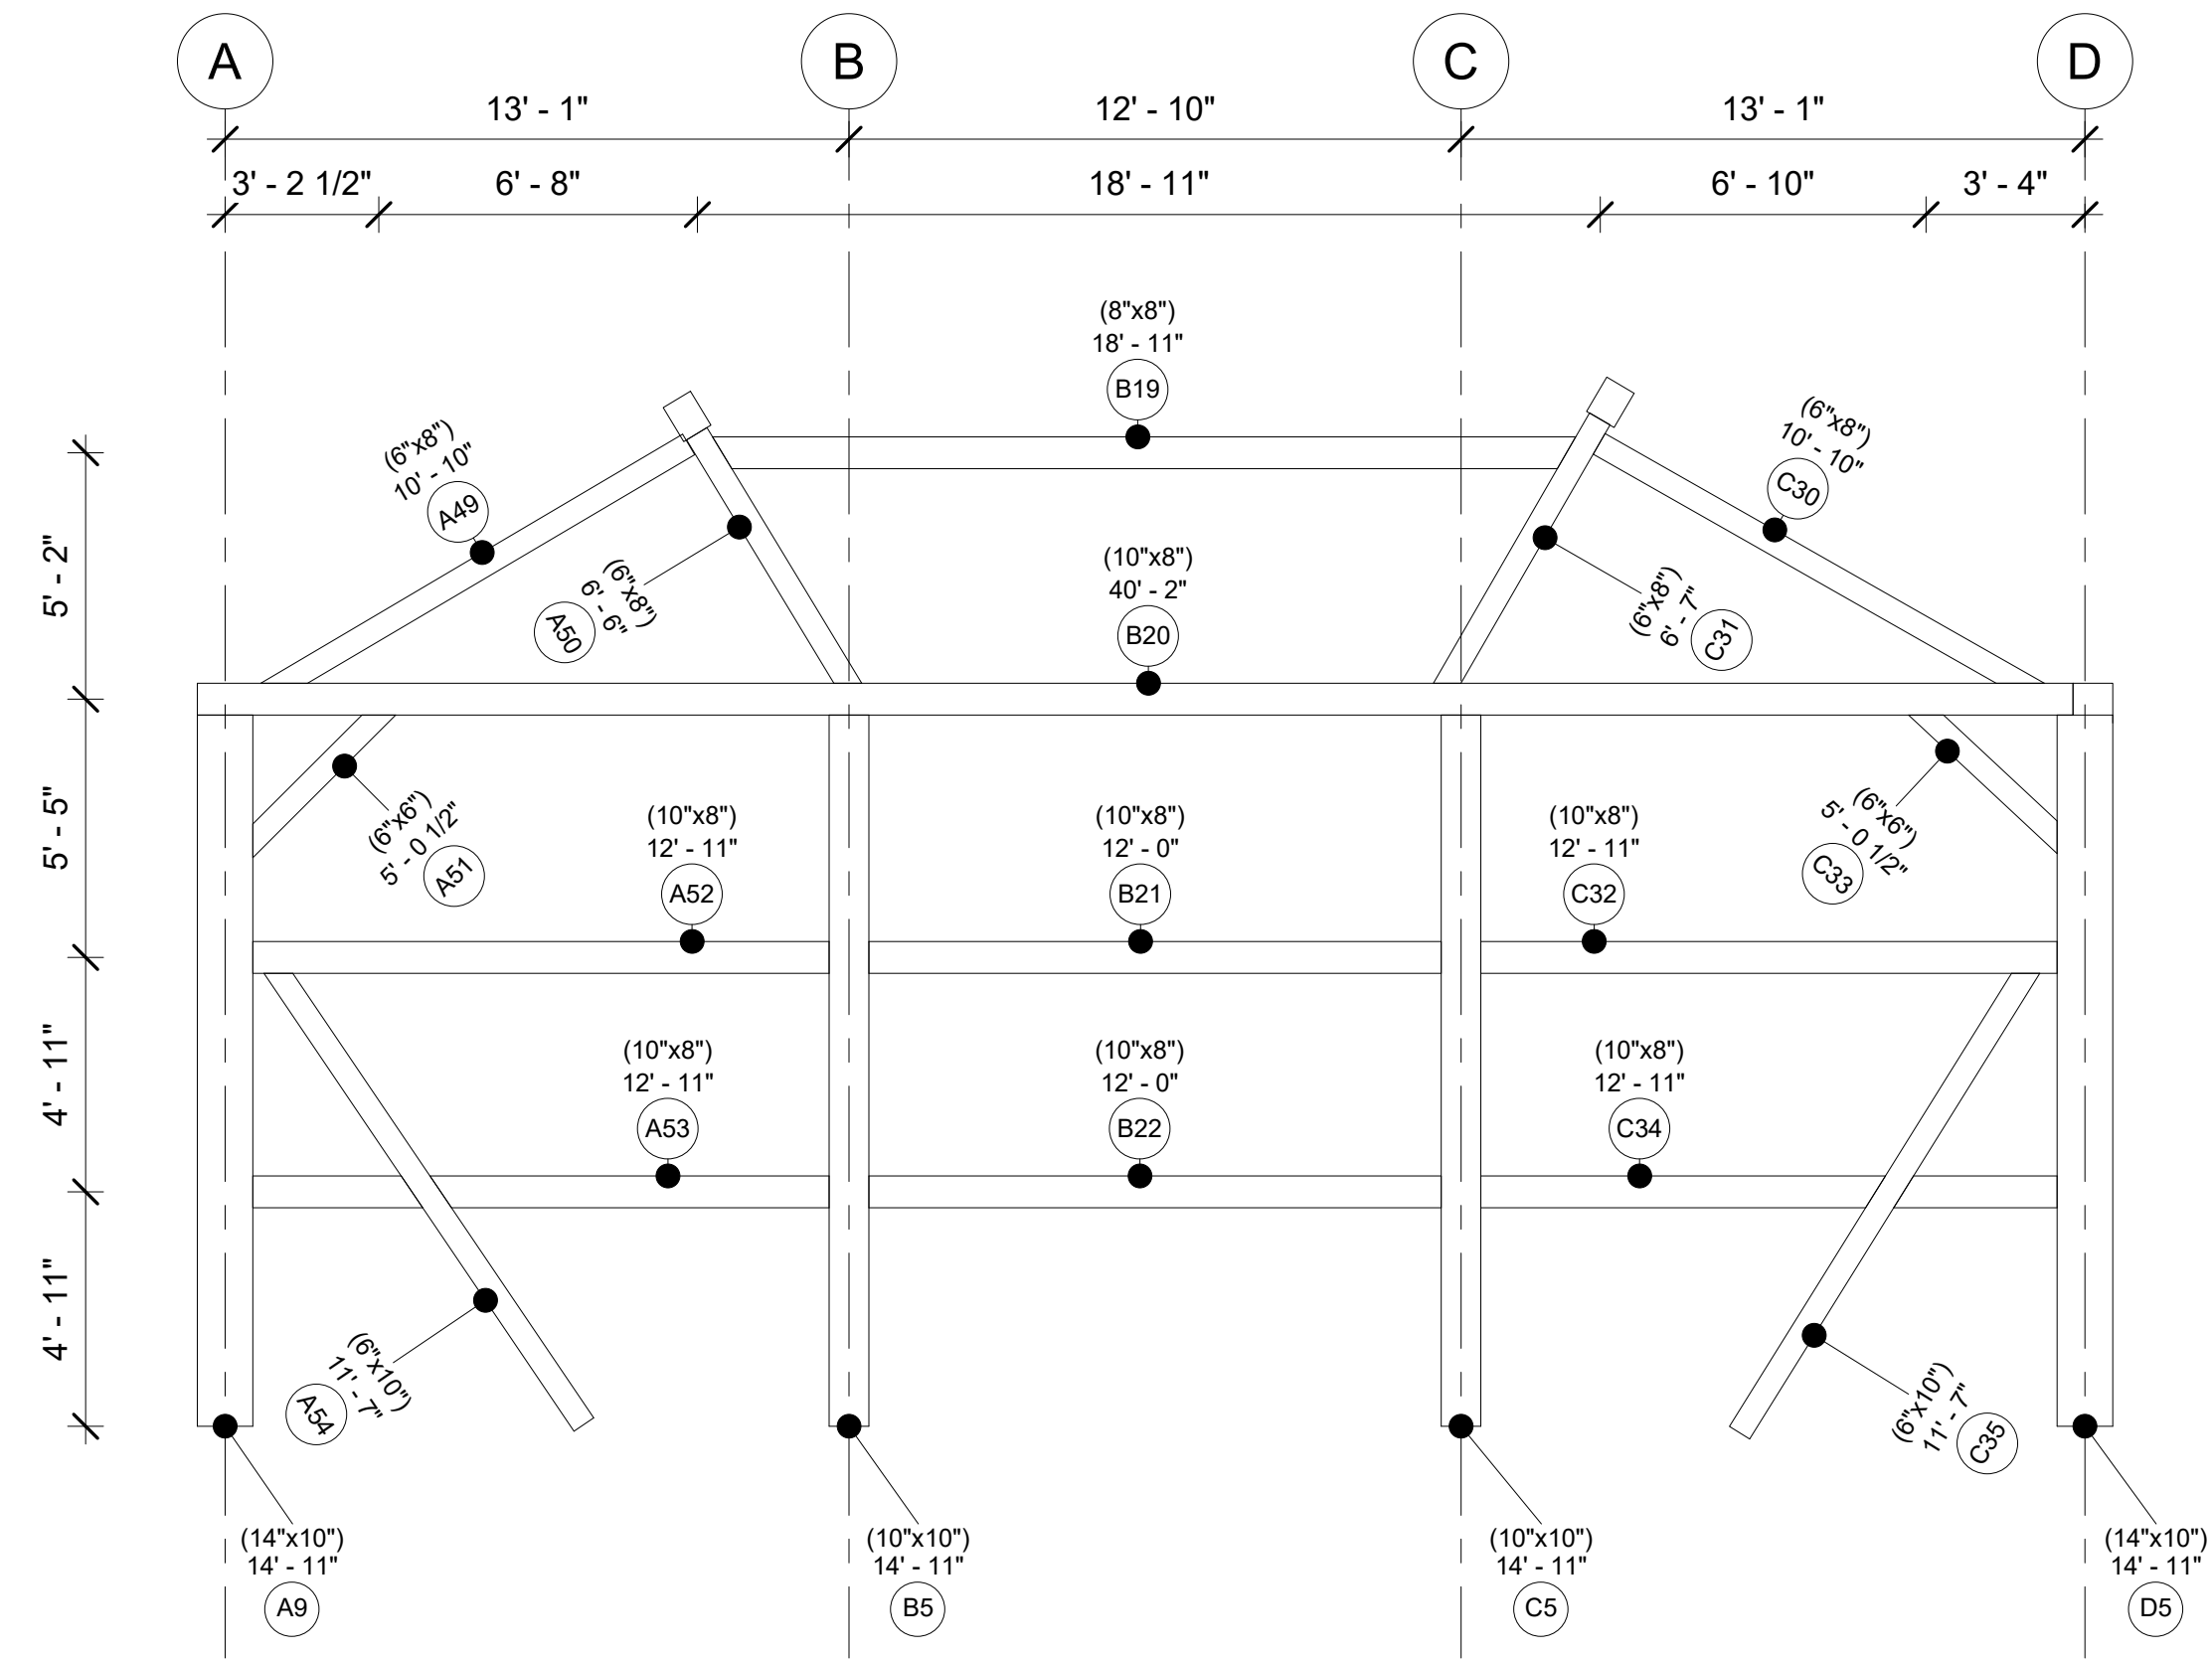

Bent 5

Project Number	Project 15
Date	20250524
Drawn By	
Checked By	

A109

Scale	1/4" = 1'-0"
-------	--------------