


PROJECT: 111-Whimsy-Creek
SCOPE: AS BUILT DRAWINGS

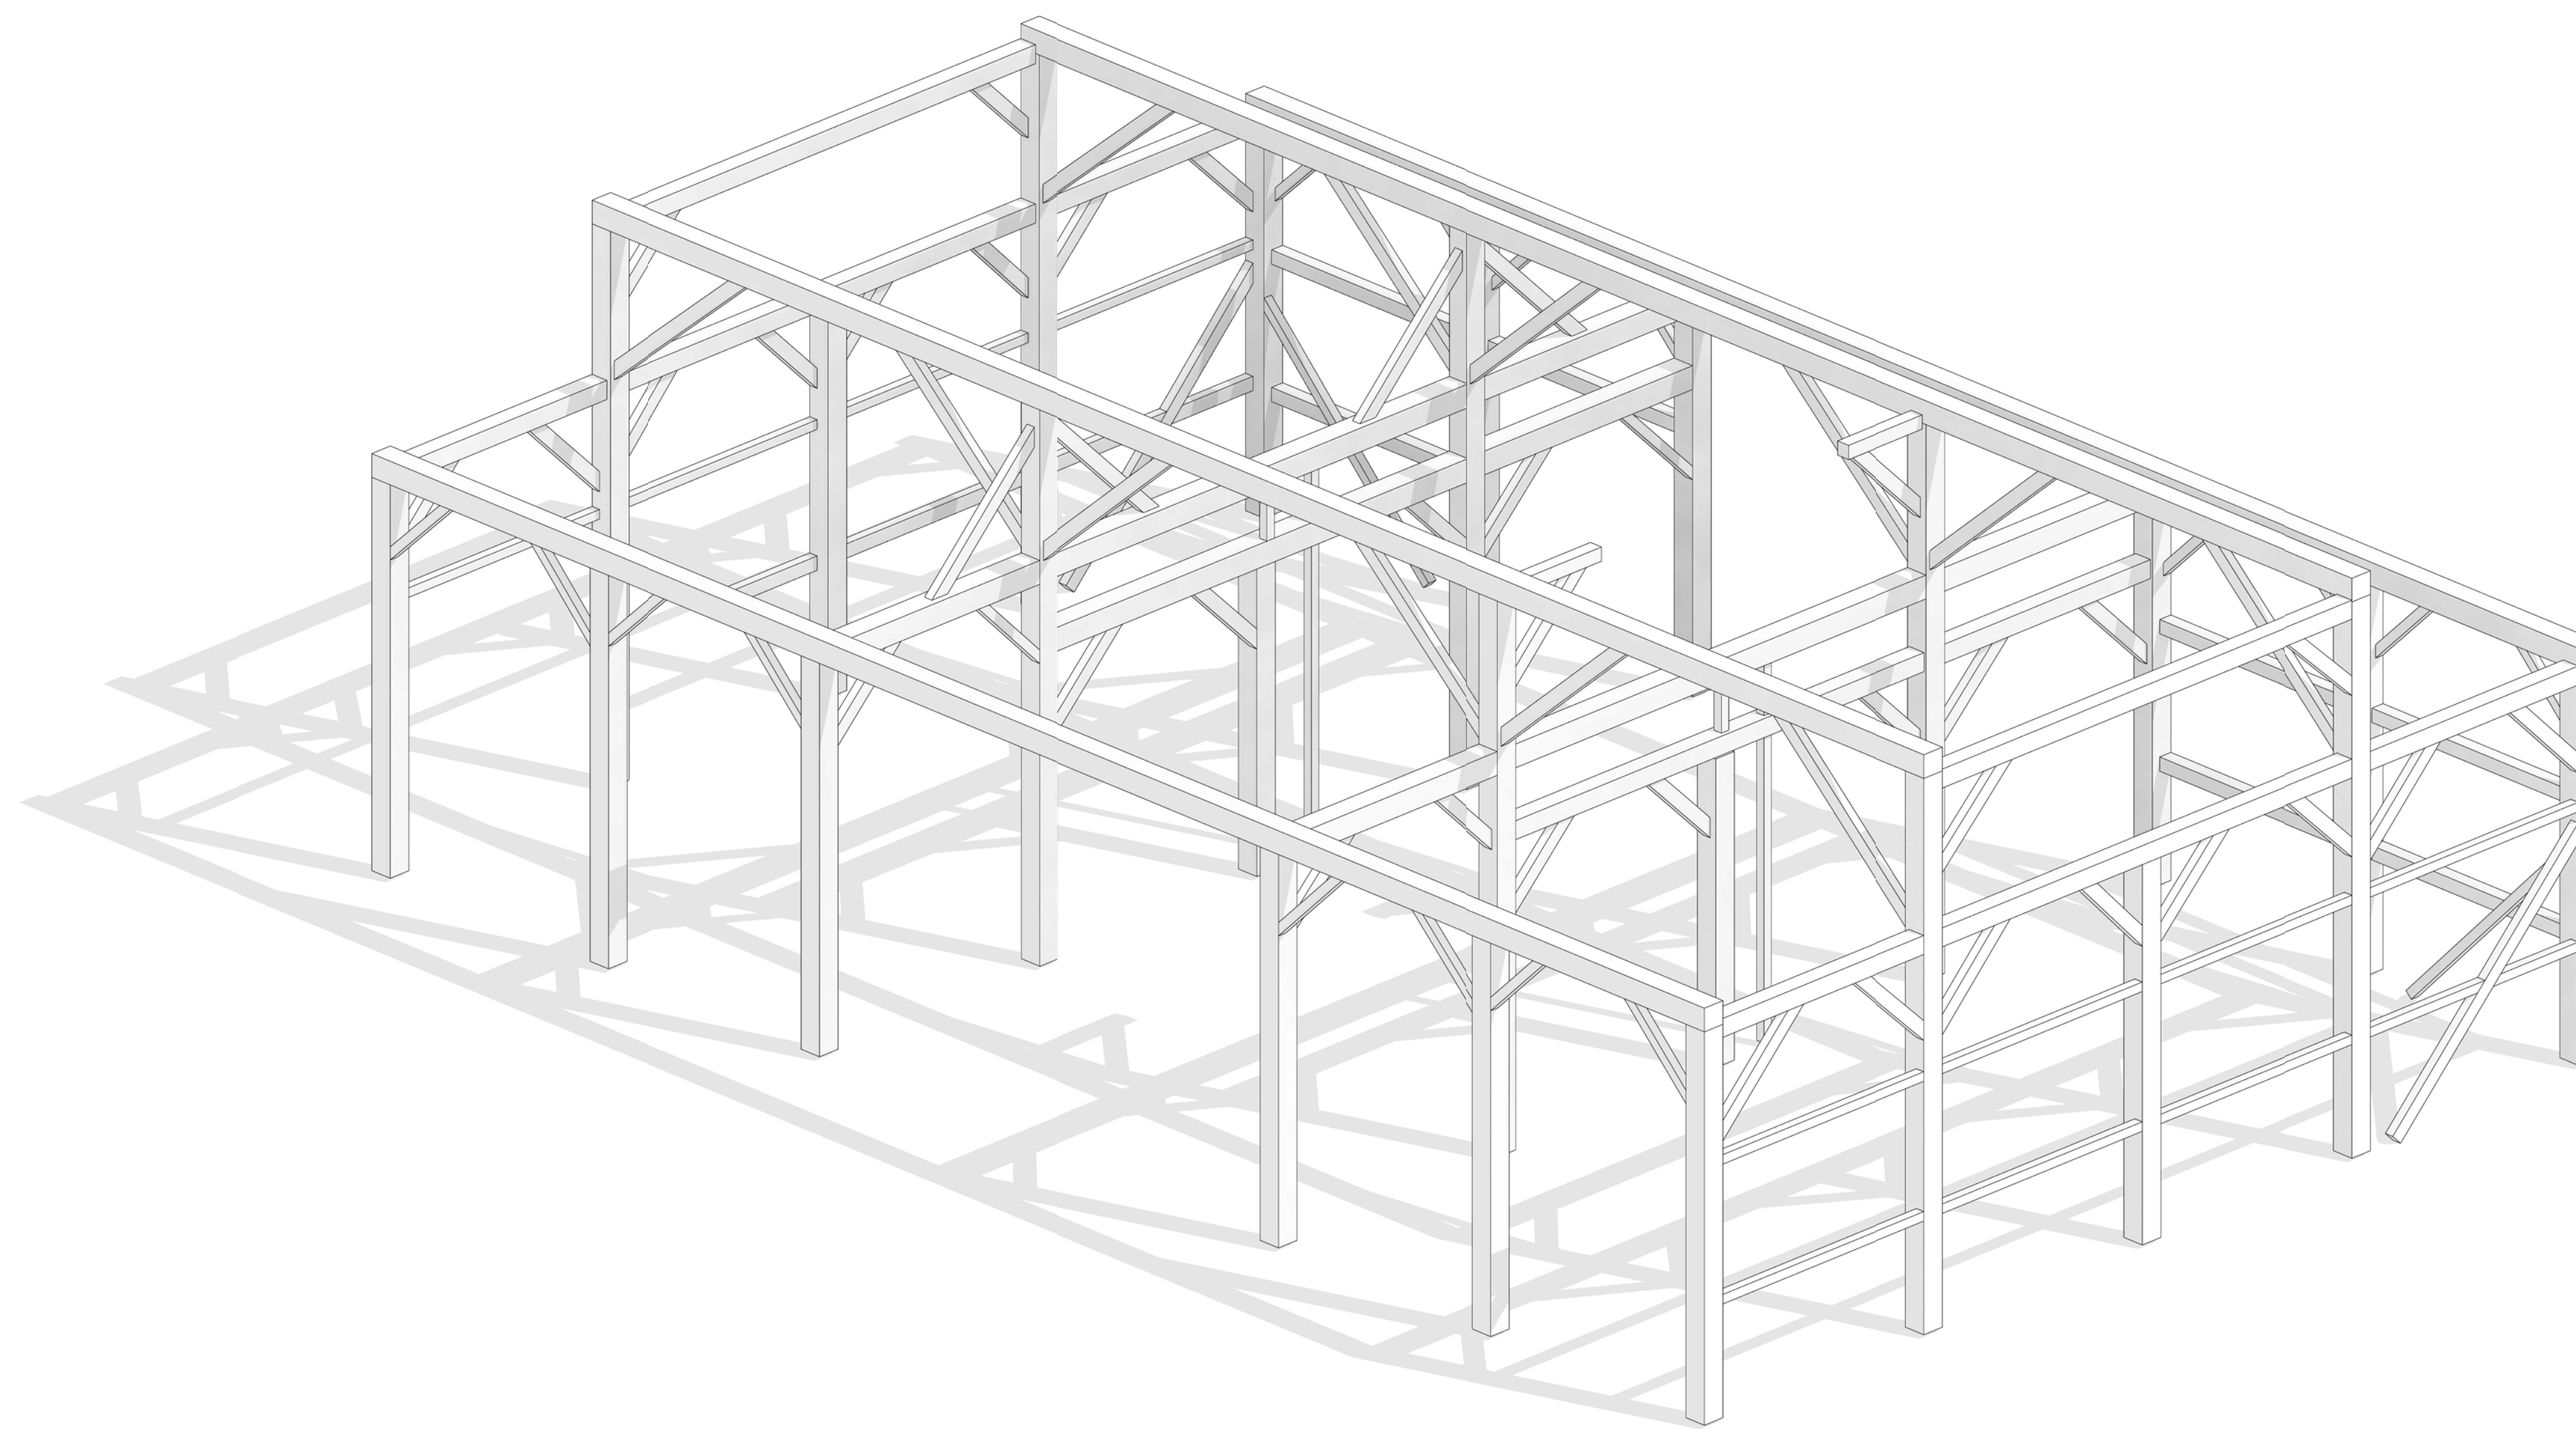

**Timber
Home
Services LLC**

111-Whimsy-Creek

DAN TRIMBLE
AA66 / TIMBER HOME SERVICES
CELL PHONE/TEXT - 412-309-1161

EMAIL:
DANTRIMBLE@TIMBERHOMESERVICES.COM

Cover Page

Project Number	Project 1
Date	20251112
Drawn By	
Checked By	

A101


Scale

Timber Home Services LLC

111-Whimsy-Creek

DAN TRIMBLE
AA66 / TIMBER HOME SERVICES
CELL PHONE/TEXT - 412-309-1161

EMAIL:
DANTRIMBLE@TIMBERHOMESERVICES.COM

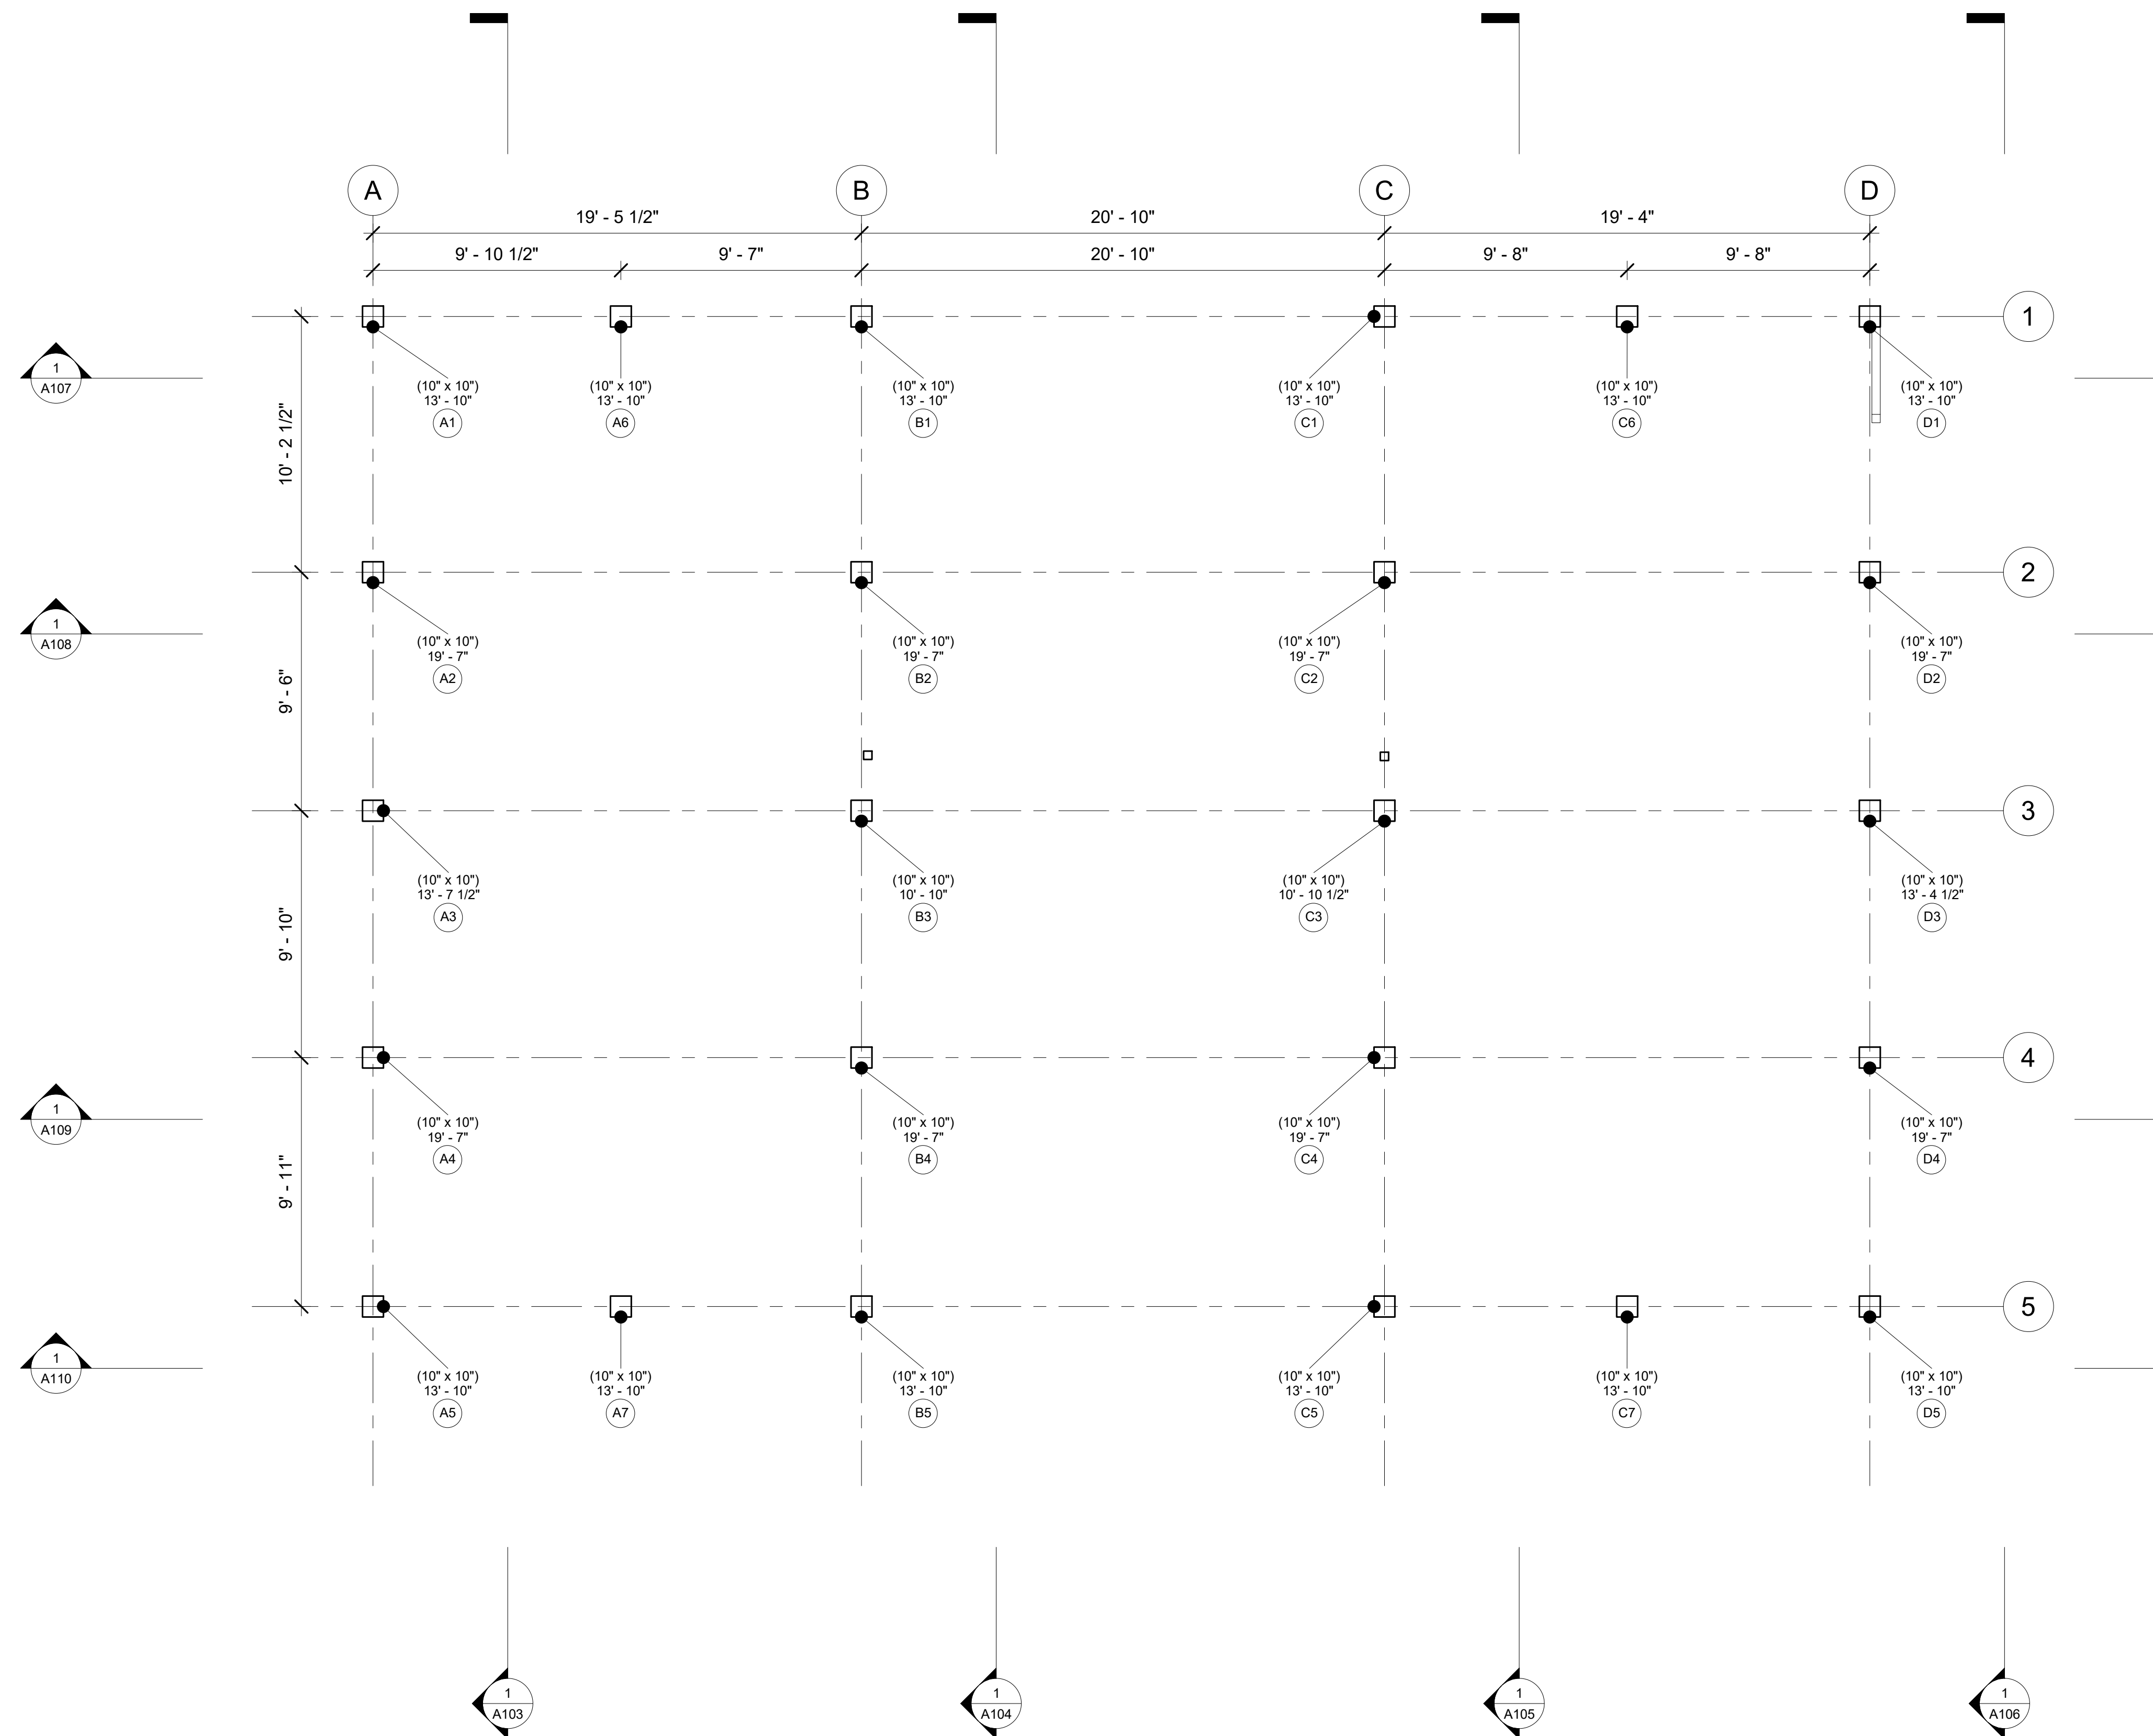

Ground

Project Number Project 1
Date 20251112
Drawn By
Checked By

A102


Scale 1/4" = 1'-0"

Timber Home Services LLC

111-Whimsy-Creek

DAN TRIMBLE
AA66 / TIMBER HOME SERVICES
CELL PHONE/TEXT - 412-309-1161

EMAIL:
DANTRIMBLE@TIMBERHOMESERVICES.COM

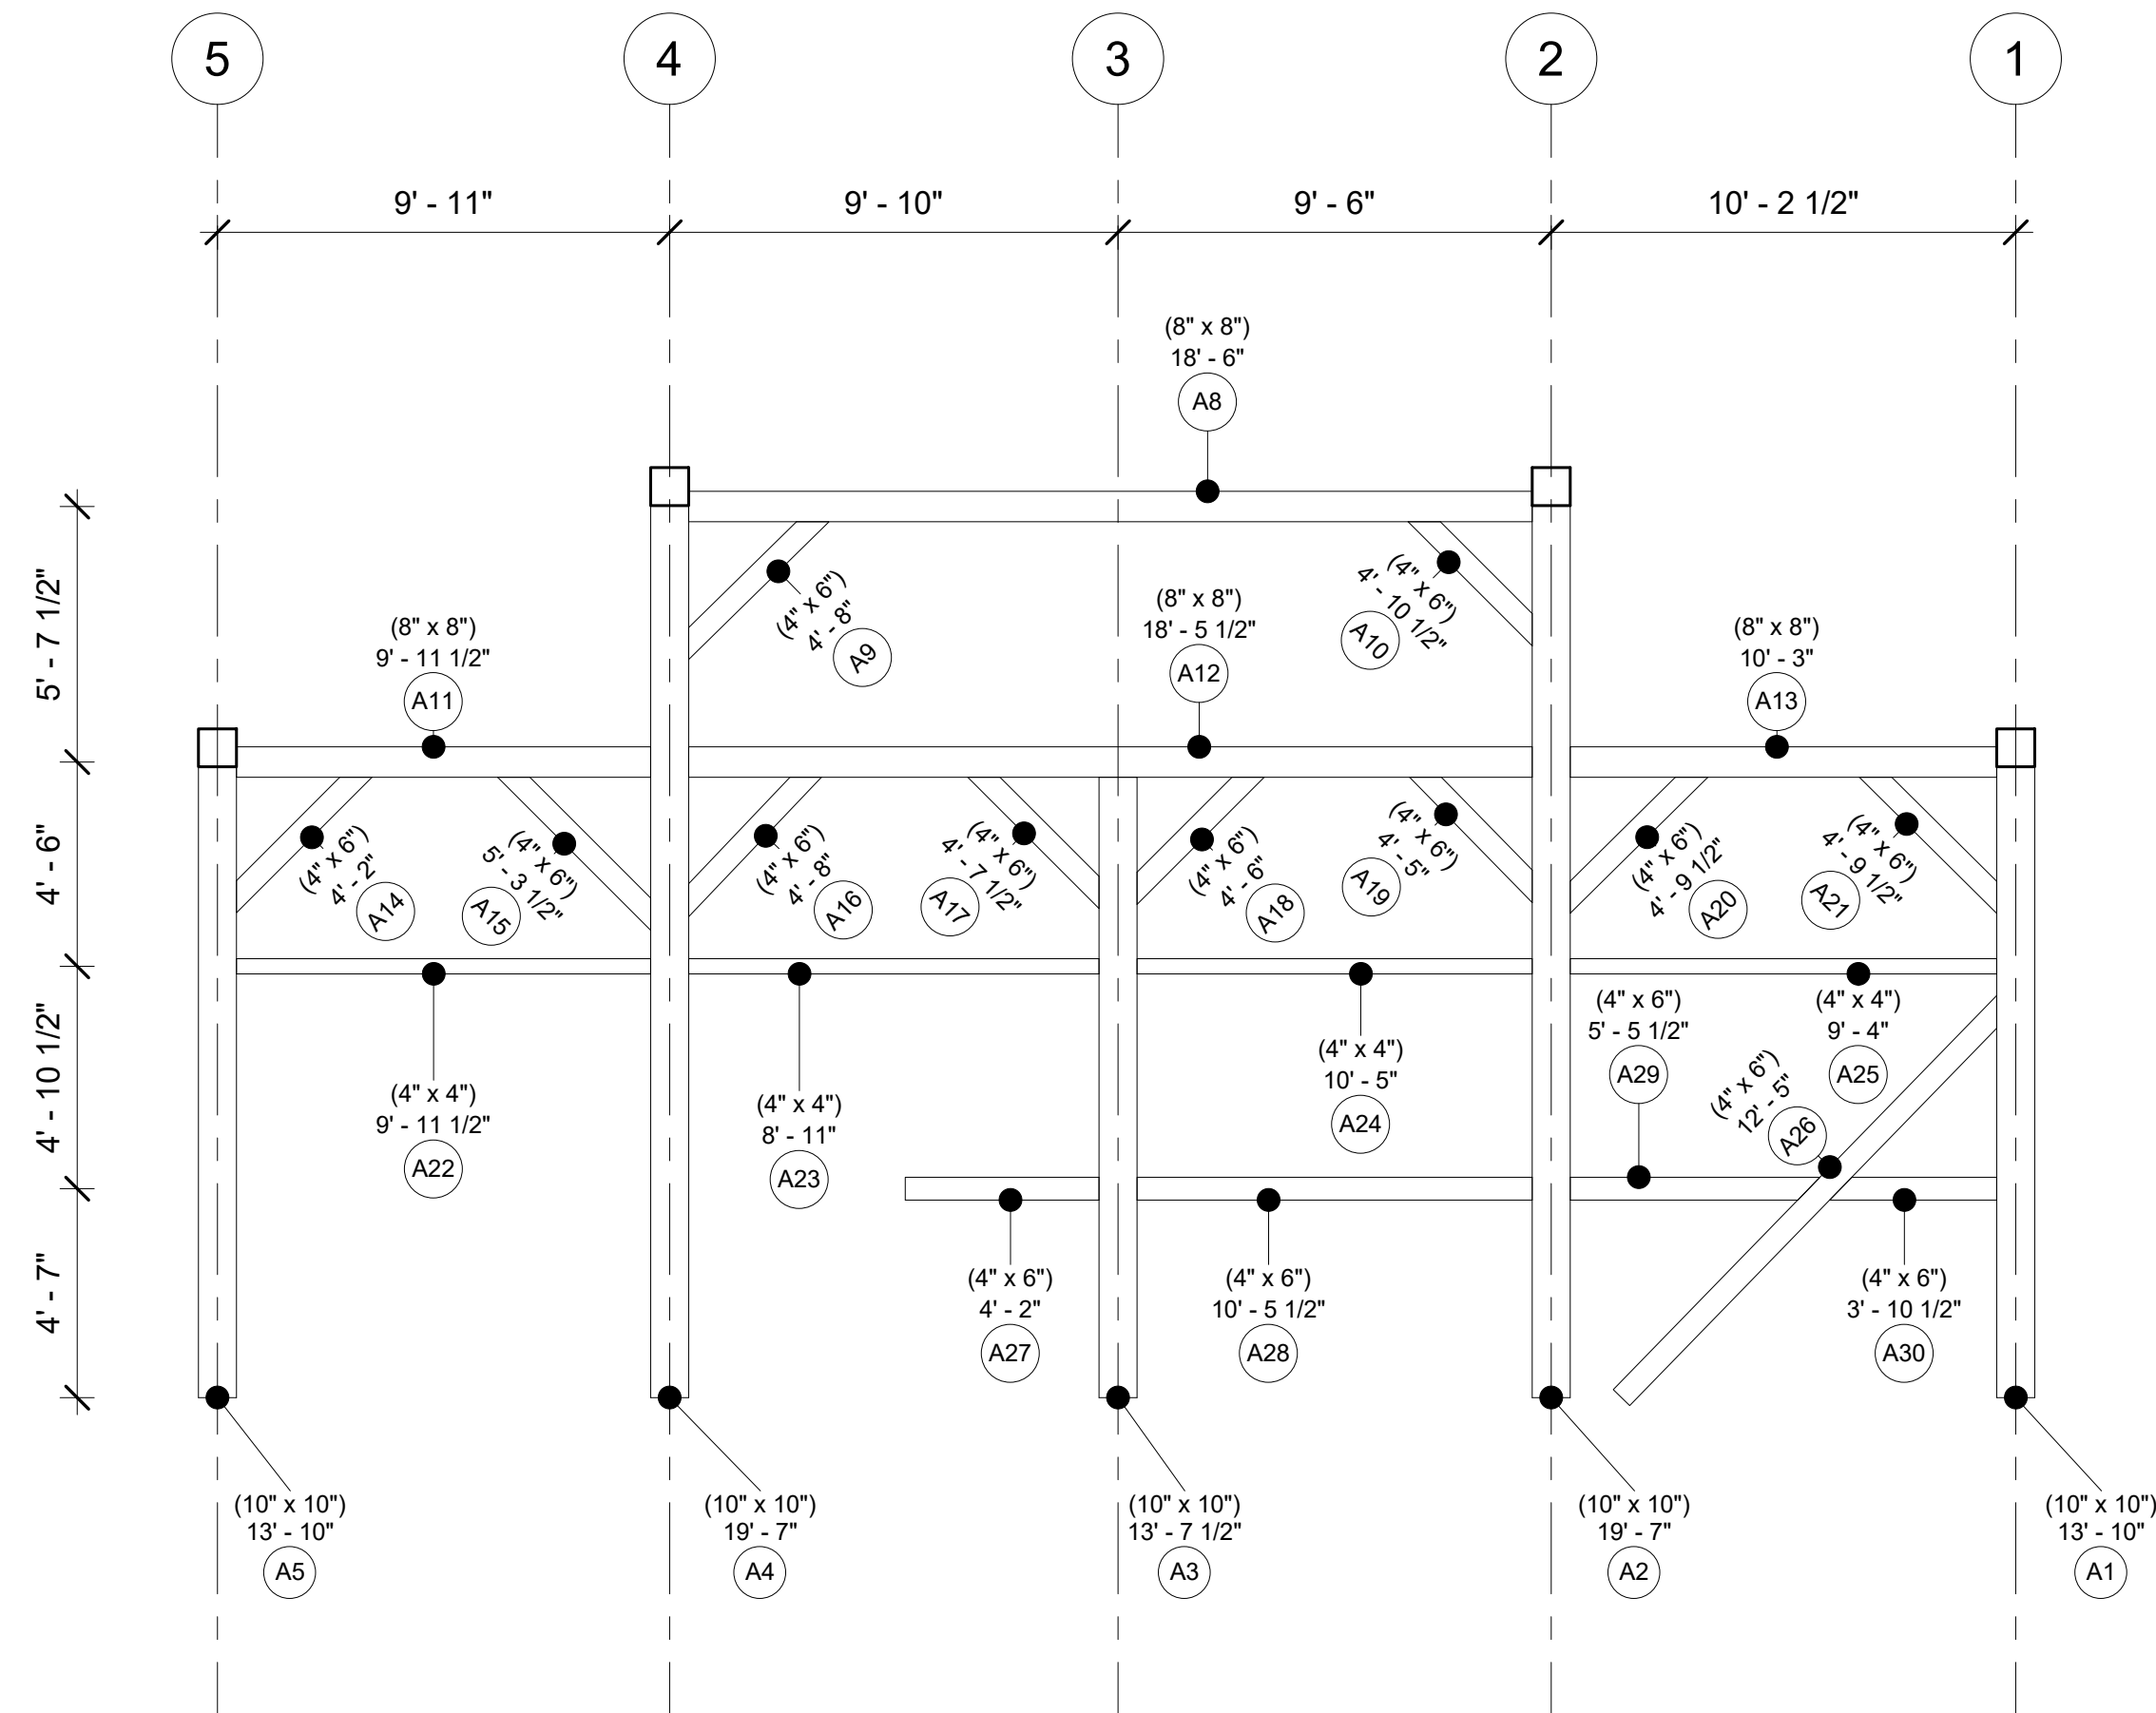

Bent A

Project Number Project 1
Date 20251112
Drawn By
Checked By

A103


Scale 1/4" = 1'-0"

Timber Home Services LLC

111-Whimsy-Creek

DAN TRIMBLE
AA66 / TIMBER HOME SERVICES
CELL PHONE/TEXT - 412-309-1161

EMAIL:
DANTRIMBLE@TIMBERHOMESERVICES.COM

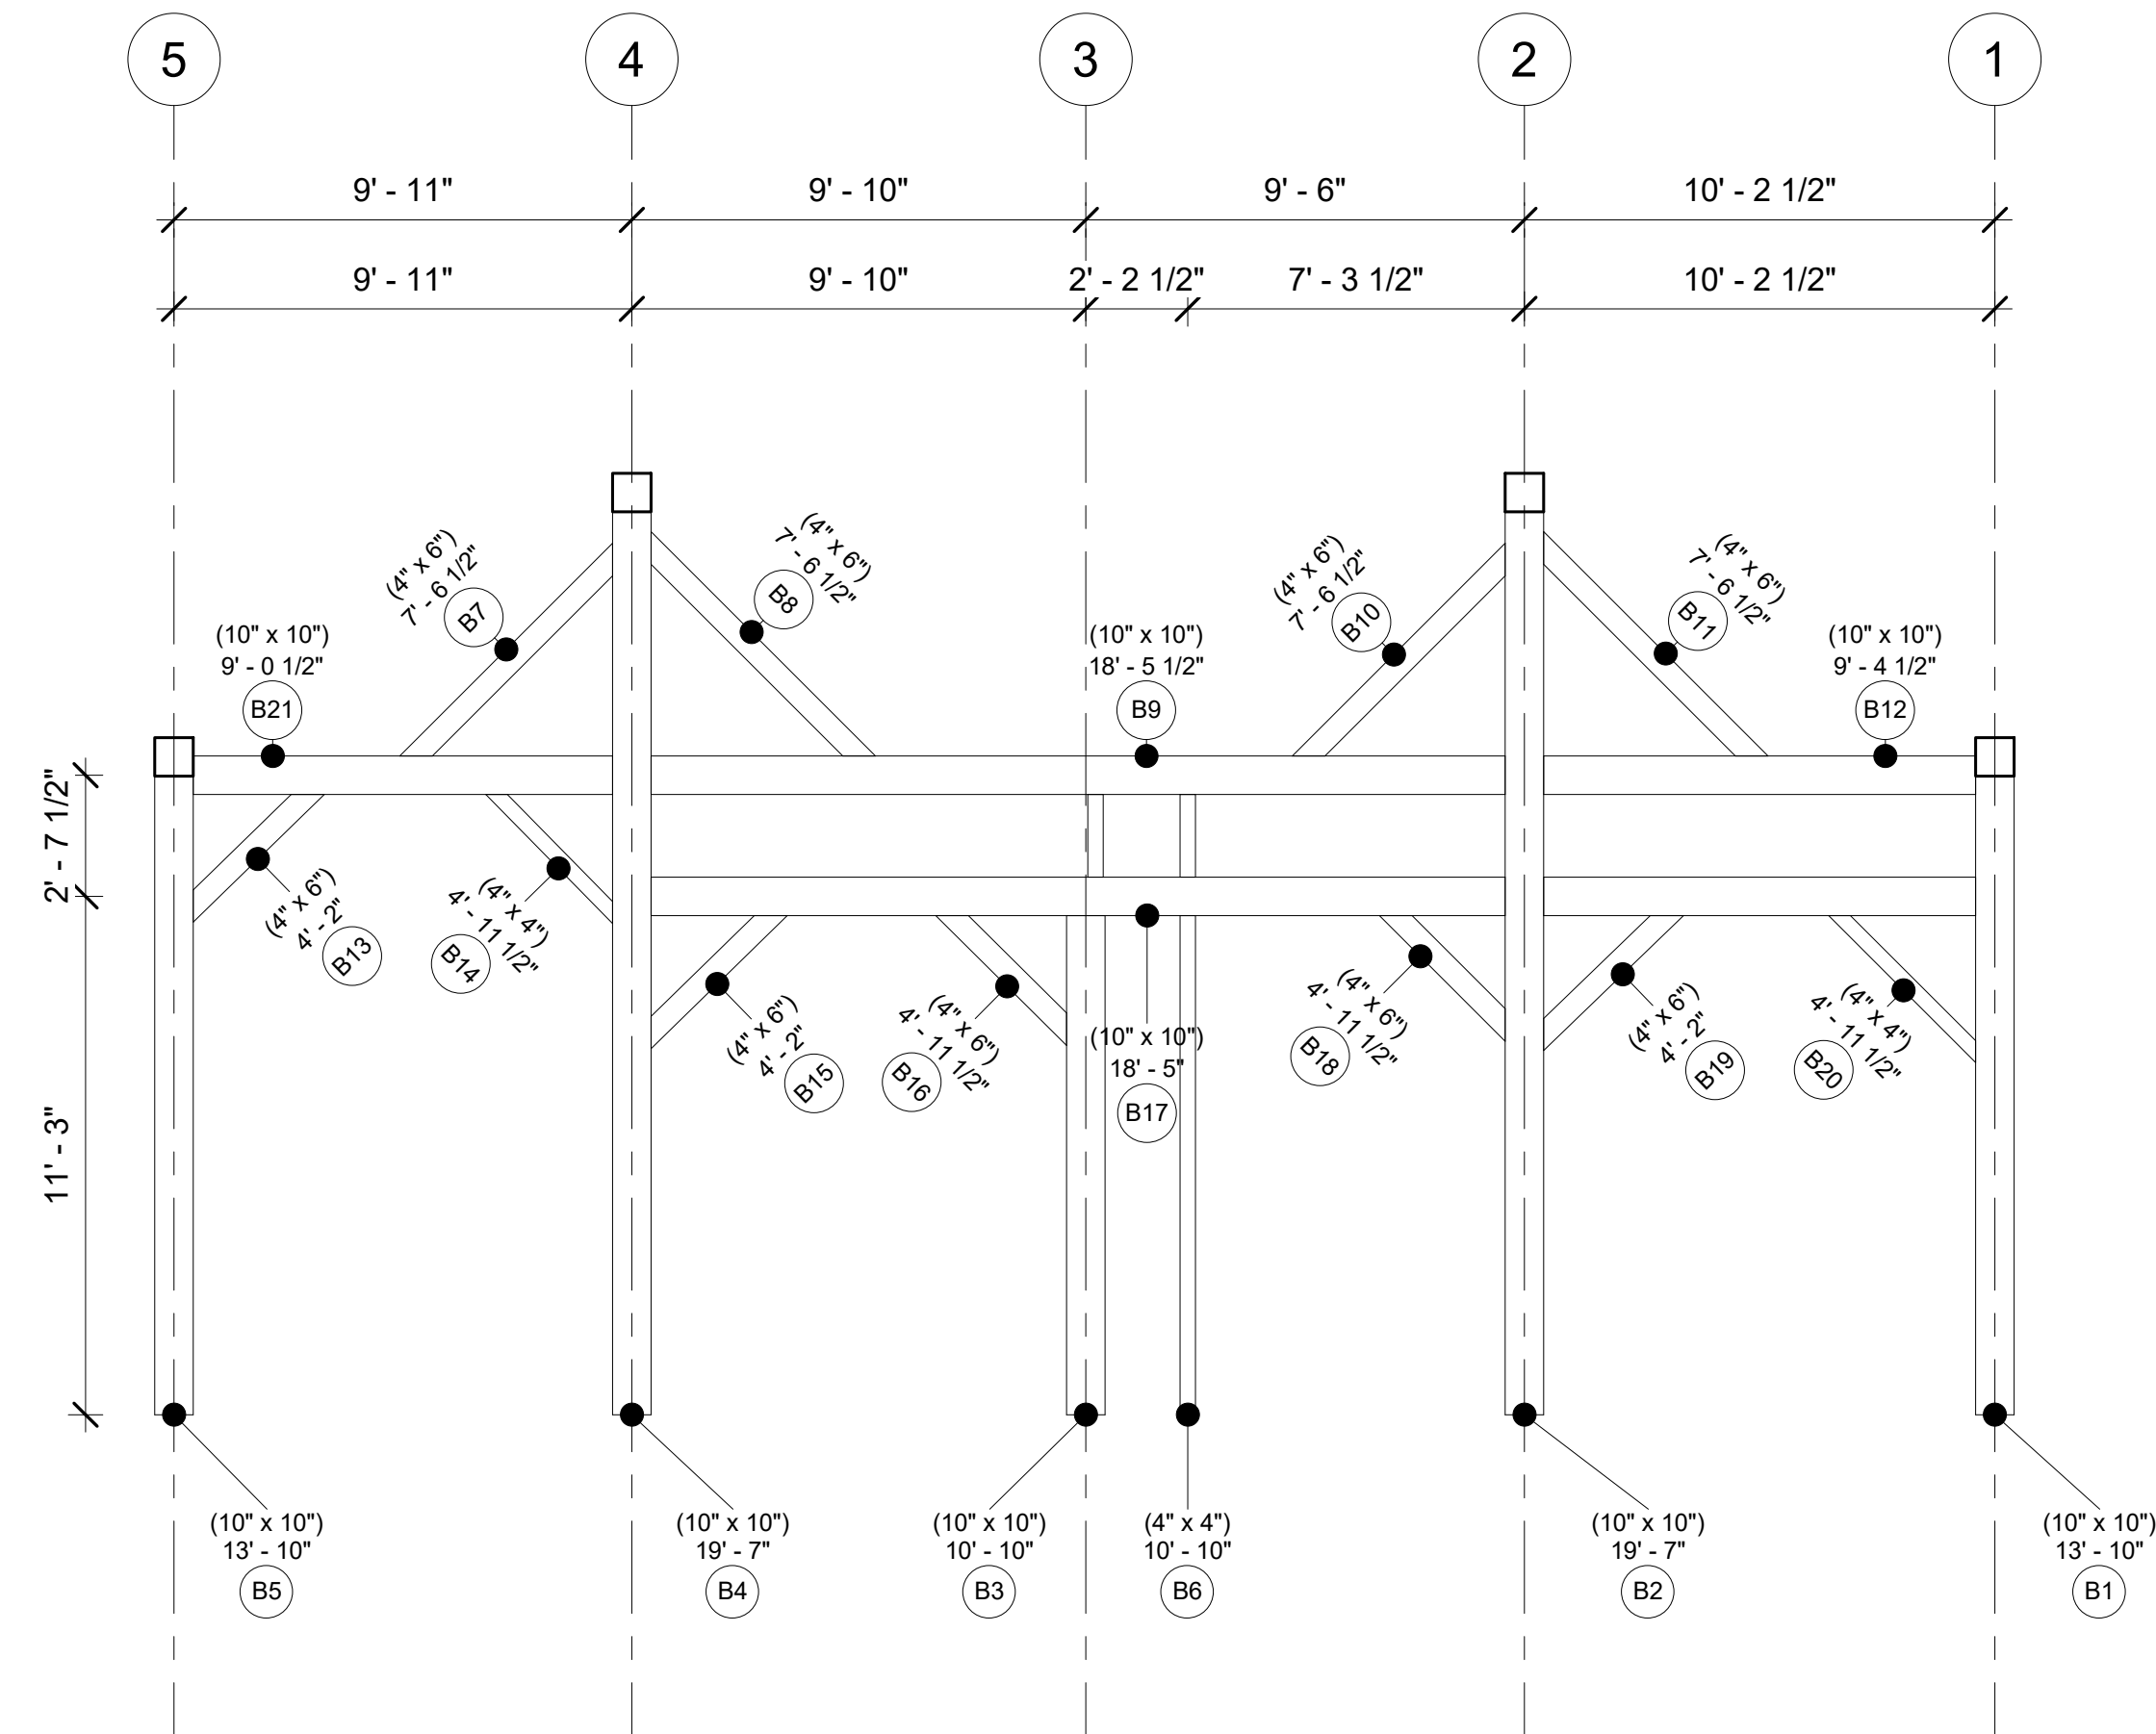

Bent B

Project Number **Project 1**
Date **20251112**
Drawn By
Checked By

A104


Scale **1/4" = 1'-0"**

Timber Home Services LLC

111-Whimsy-Creek

DAN TRIMBLE
AA66 / TIMBER HOME SERVICES
CELL PHONE/TEXT - 412-309-1161

EMAIL:
DANTRIMBLE@TIMBERHOMESERVICES.COM

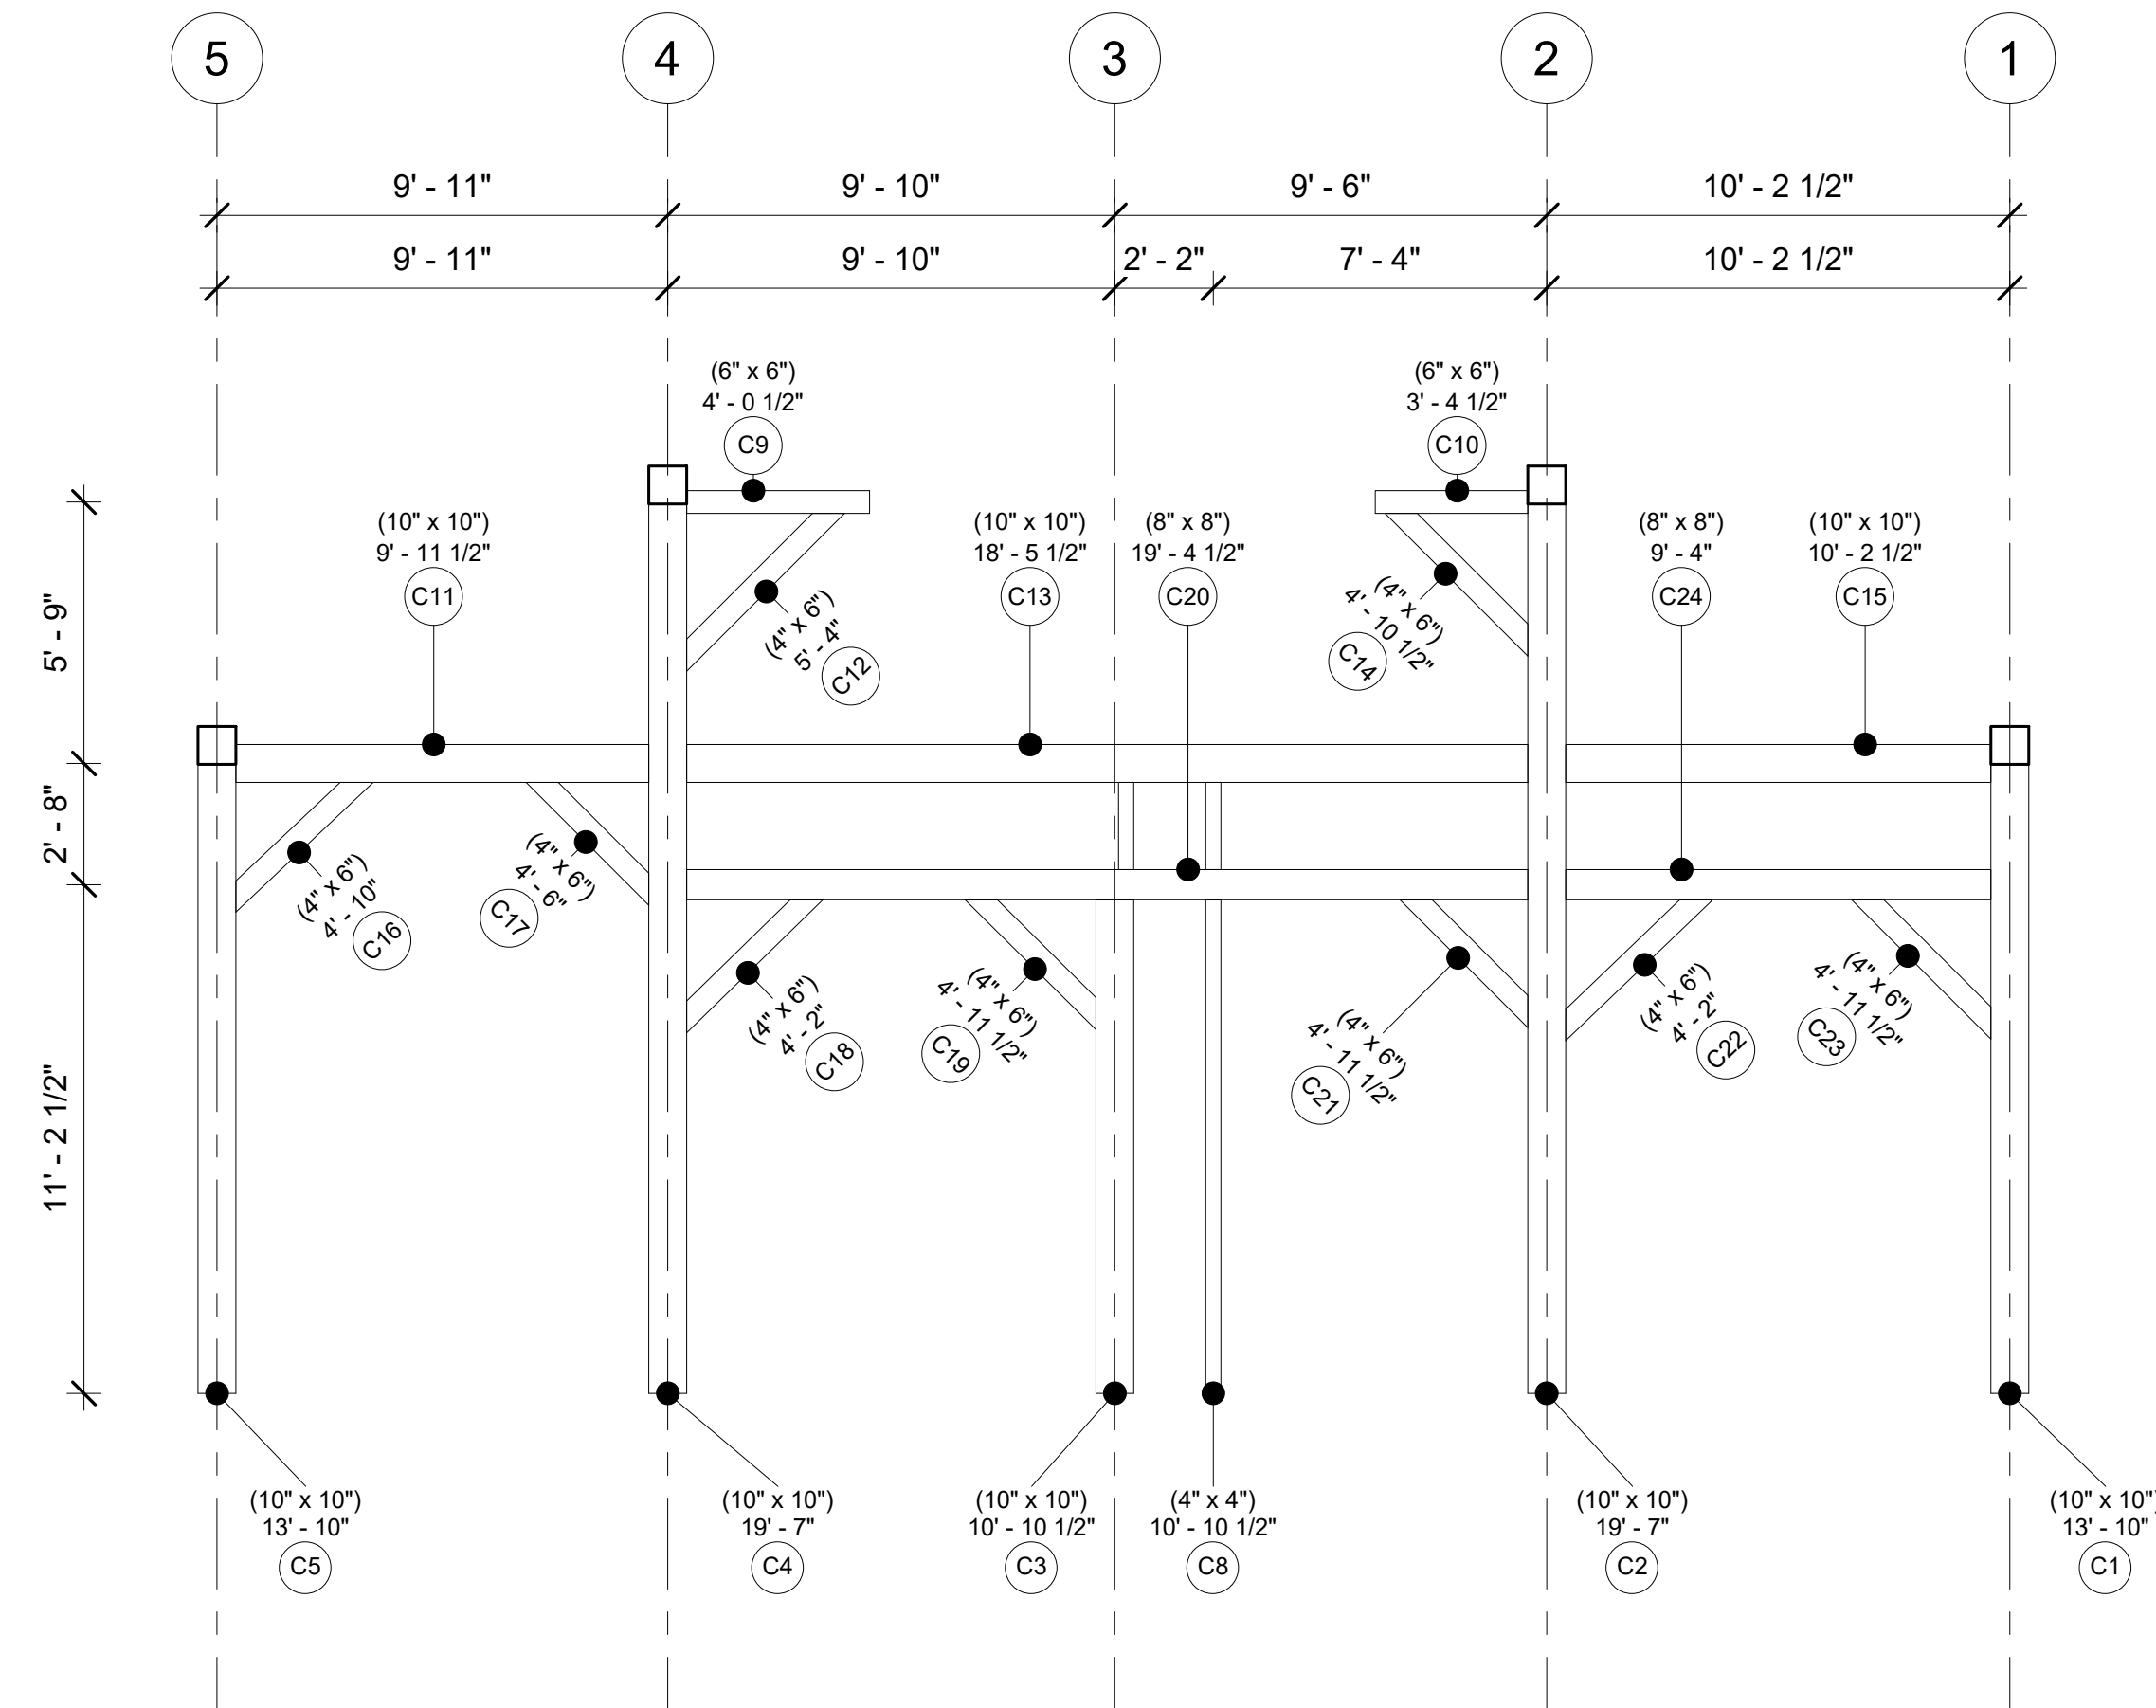

Bent C

Project Number Project 1
Date 20251112
Drawn By
Checked By

A105


Scale 1/4" = 1'-0"

Timber Home Services LLC

111-Whimsy-Creek

DAN TRIMBLE
AA66 / TIMBER HOME SERVICES
CELL PHONE/TEXT - 412-309-1161

EMAIL:
DANTRIMBLE@TIMBERHOMESERVICES.COM

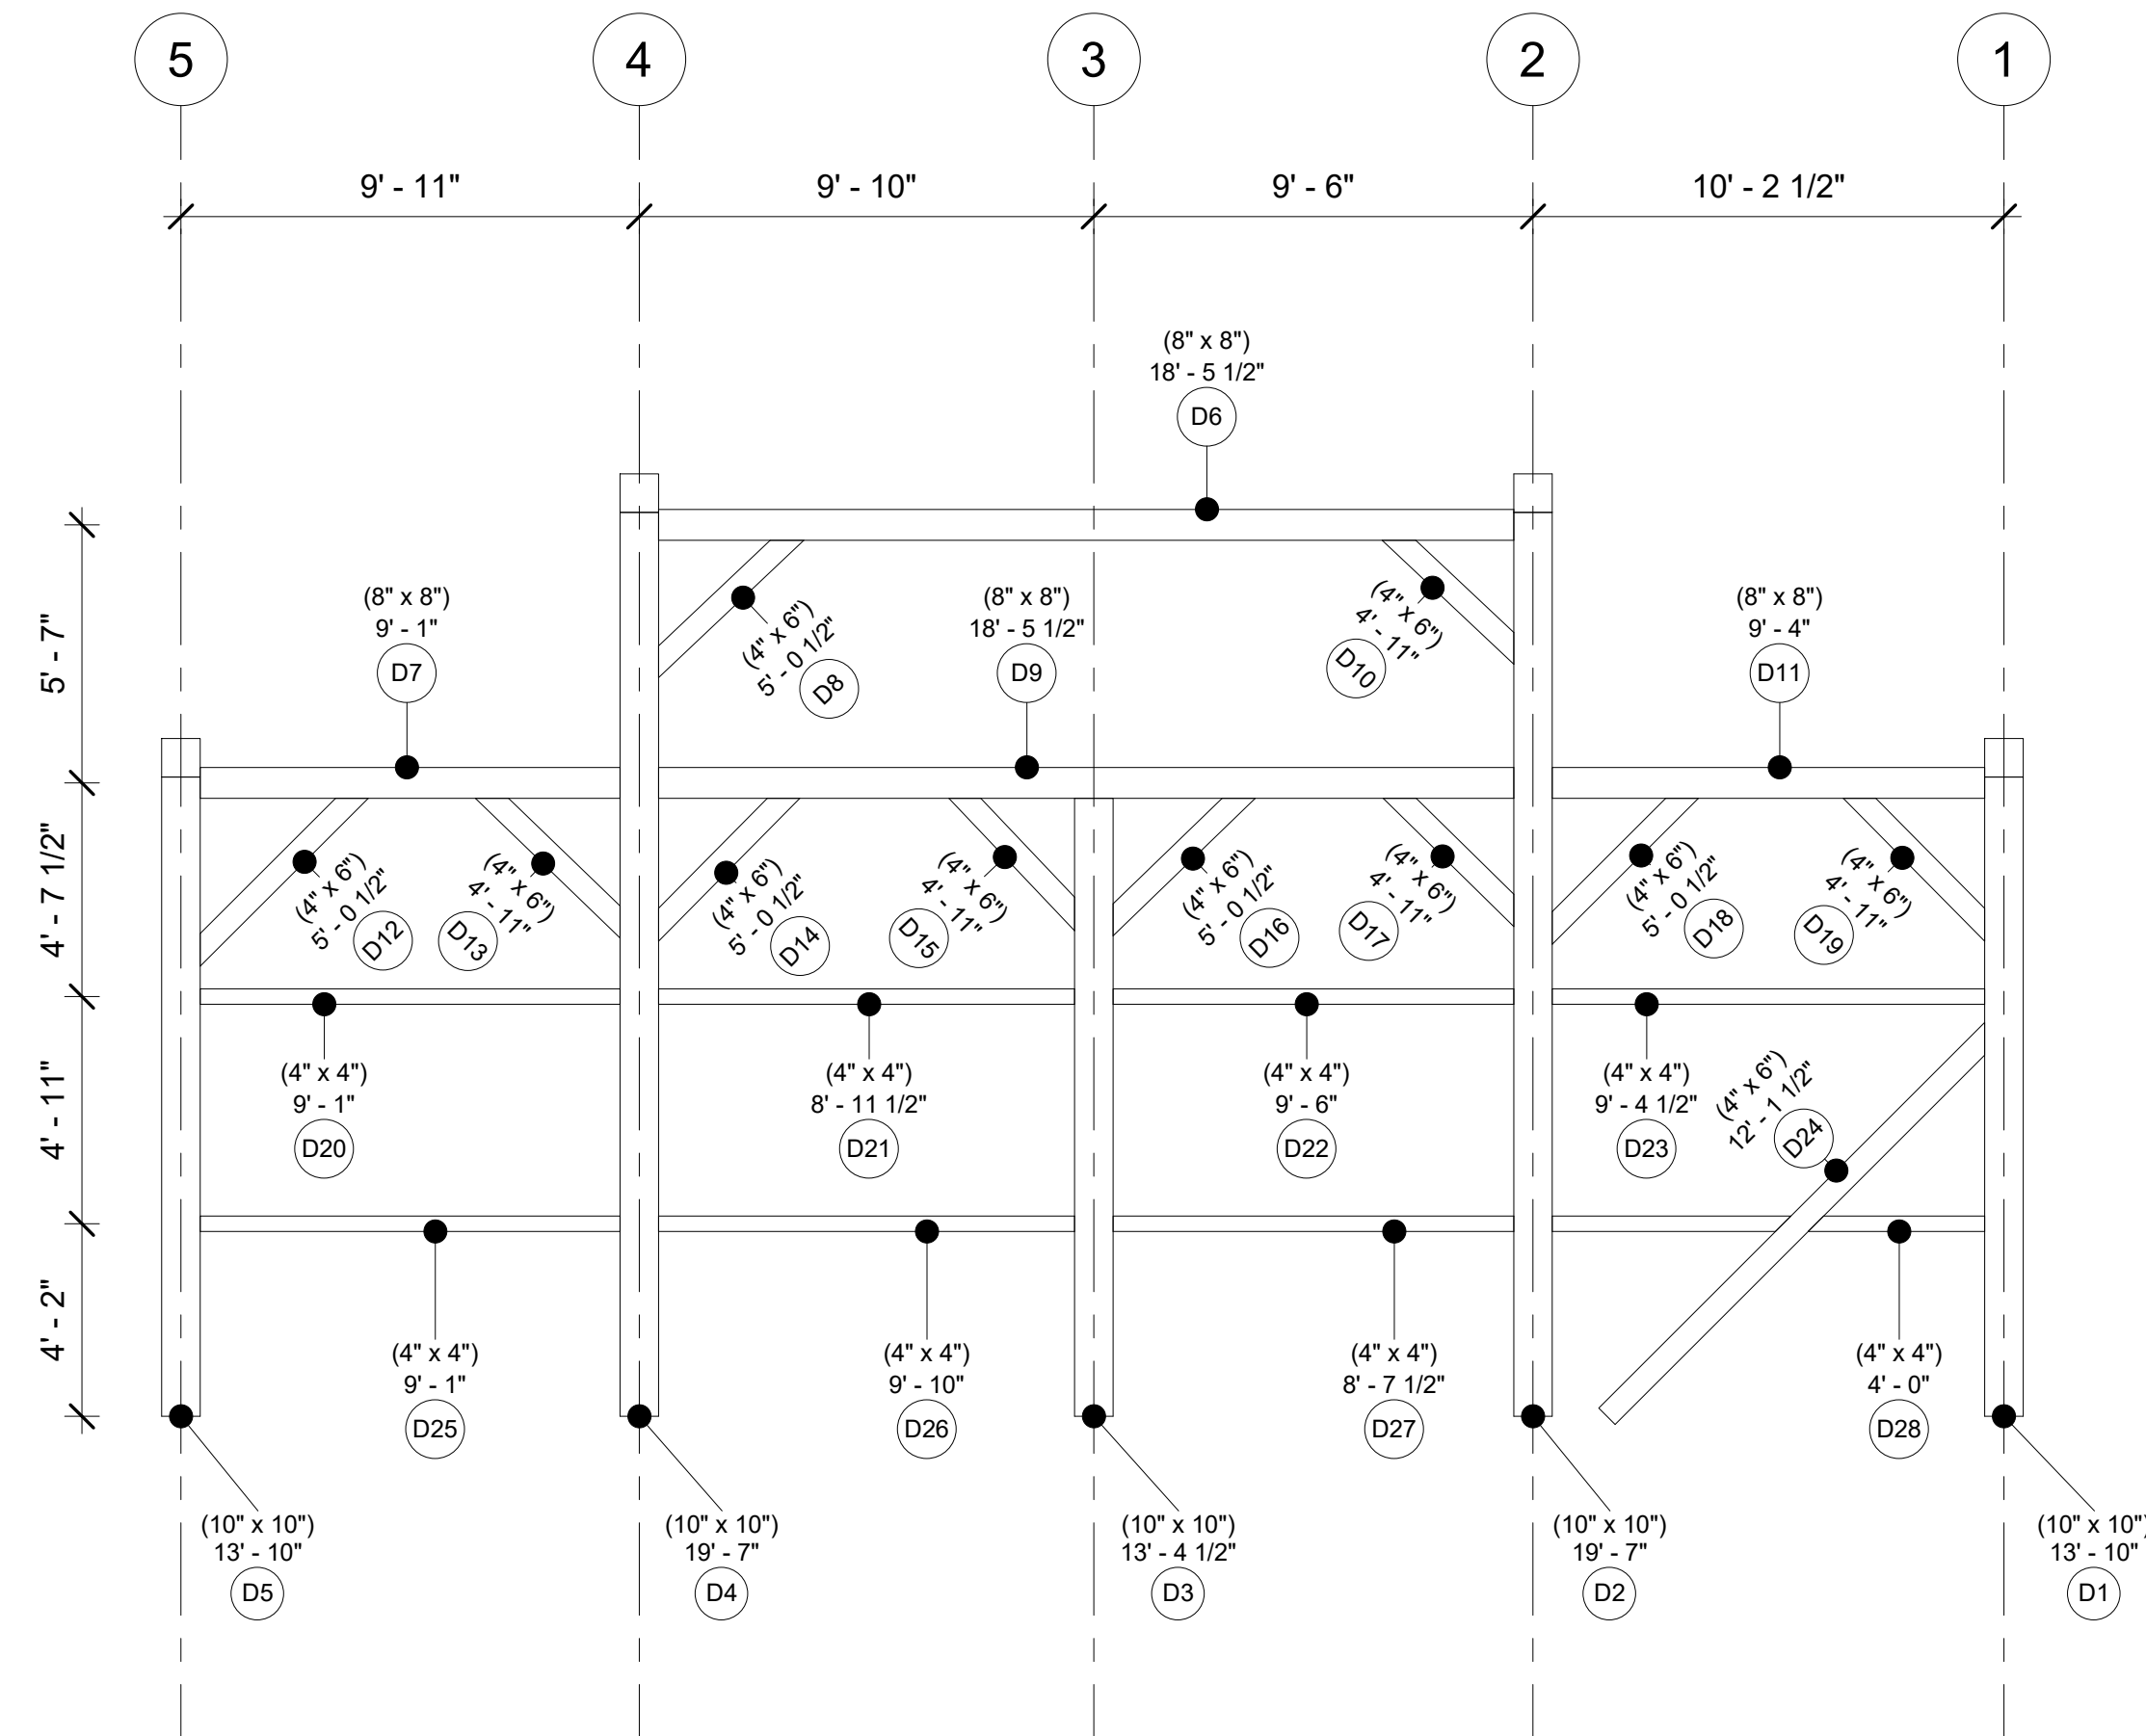

Bent D

Project Number Project 1
Date 20251112
Drawn By
Checked By

A106


Scale 1/4" = 1'-0"

Timber Home Services LLC

111-Whimsy-Creek

DAN TRIMBLE
AA66 / TIMBER HOME SERVICES
CELL PHONE/TEXT - 412-309-1161

EMAIL:
DANTRIMBLE@TIMBERHOMESERVICES.COM

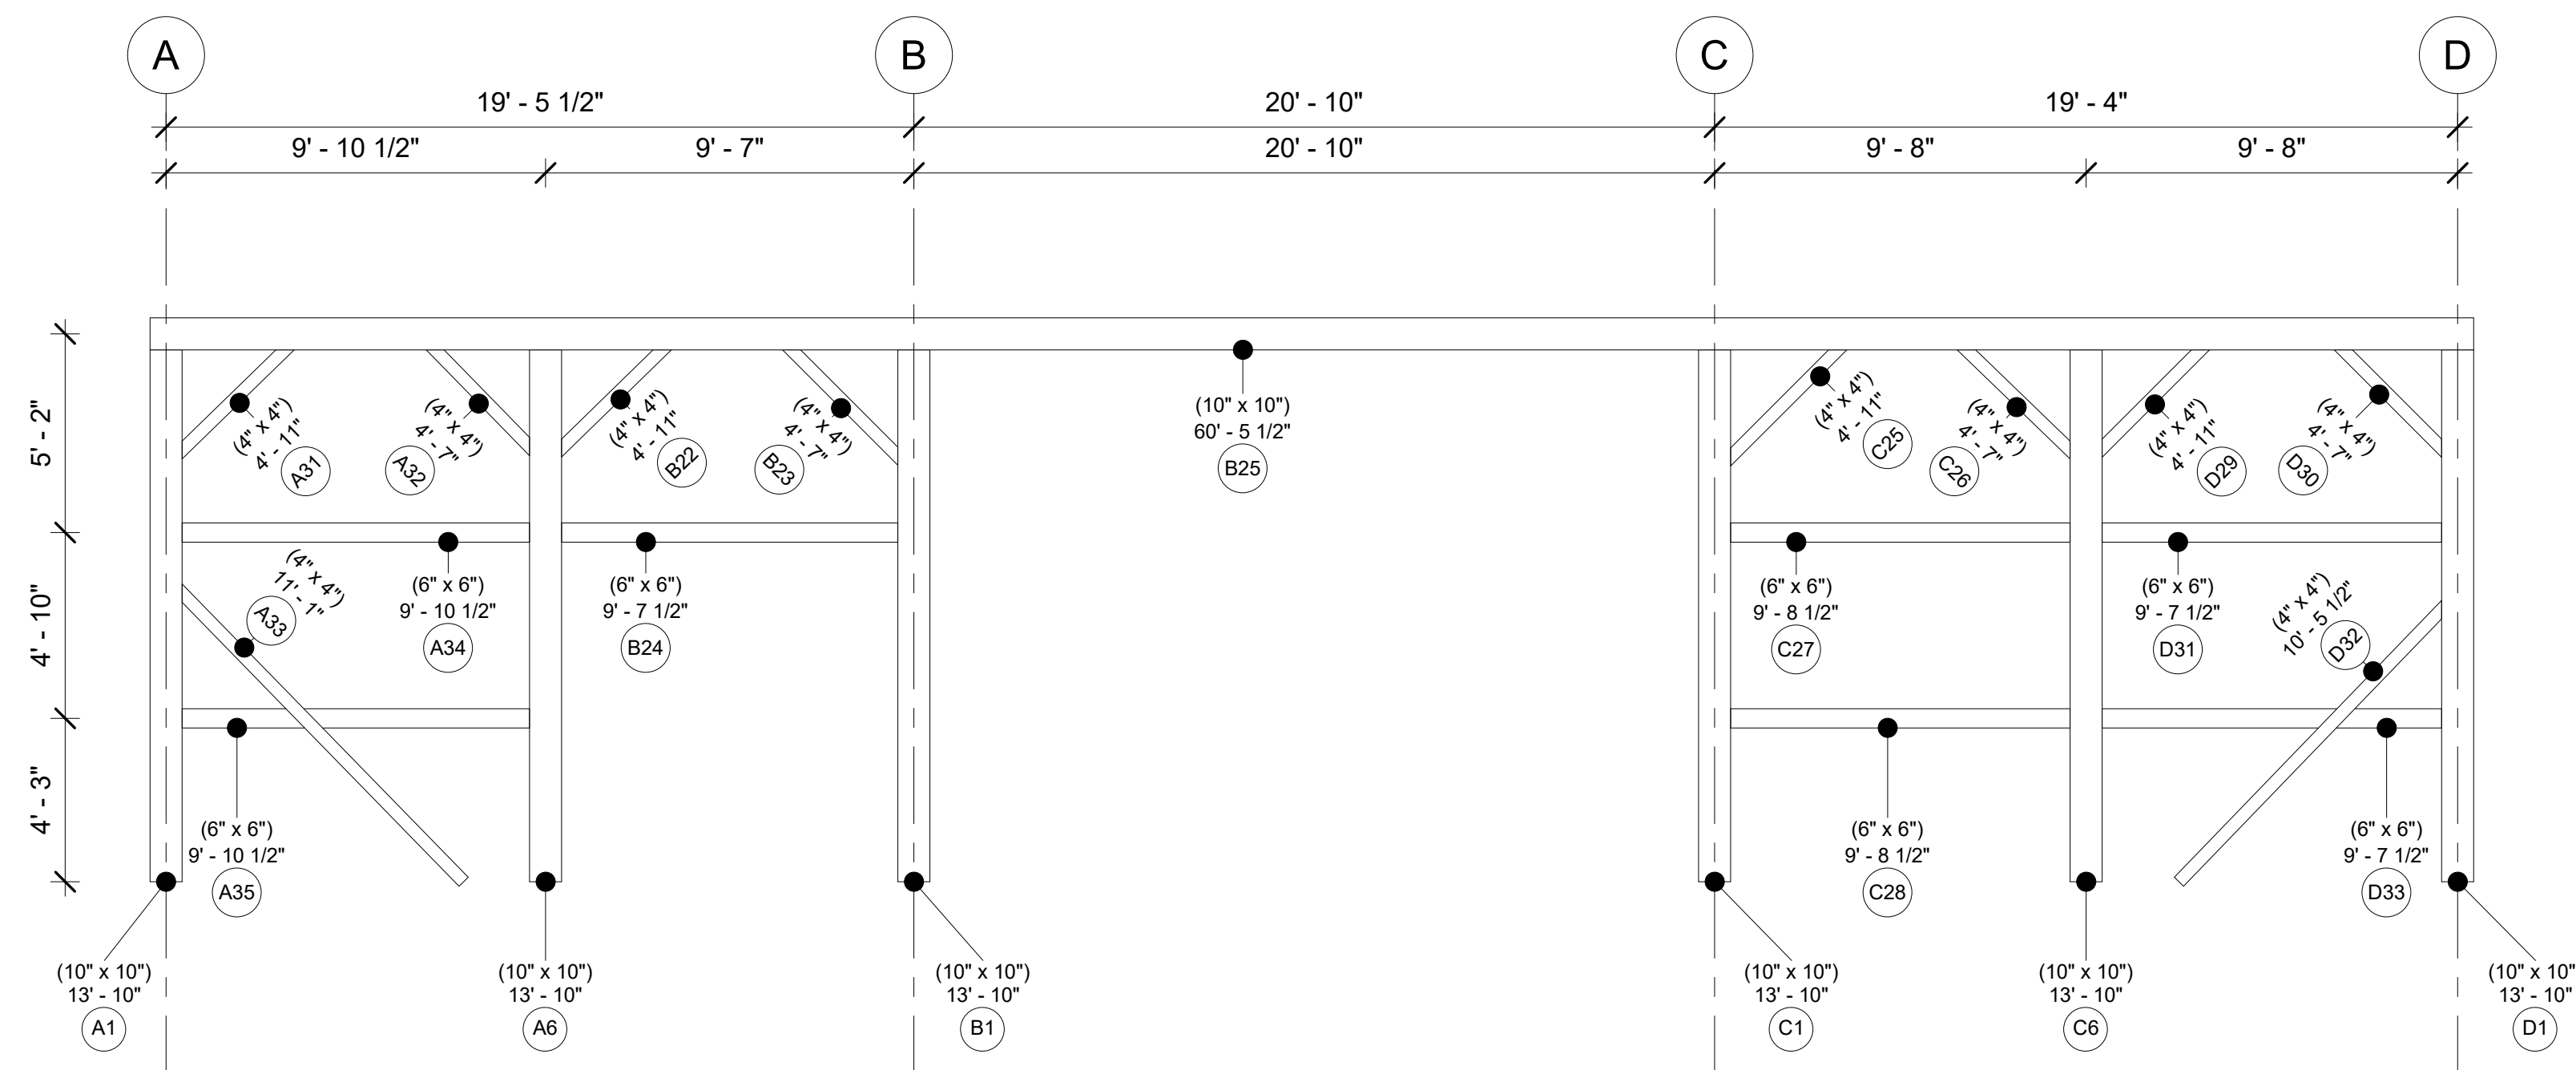

Bent 1

Project Number	Project 1
Date	20251112
Drawn By	
Checked By	

A107


Scale 1/4" = 1'-0"

Timber Home Services LLC

111-Whimsy-Creek

DAN TRIMBLE
AA66 / TIMBER HOME SERVICES
CELL PHONE/TEXT - 412-309-1161

EMAIL:
DANTRIMBLE@TIMBERHOMESERVICES.COM

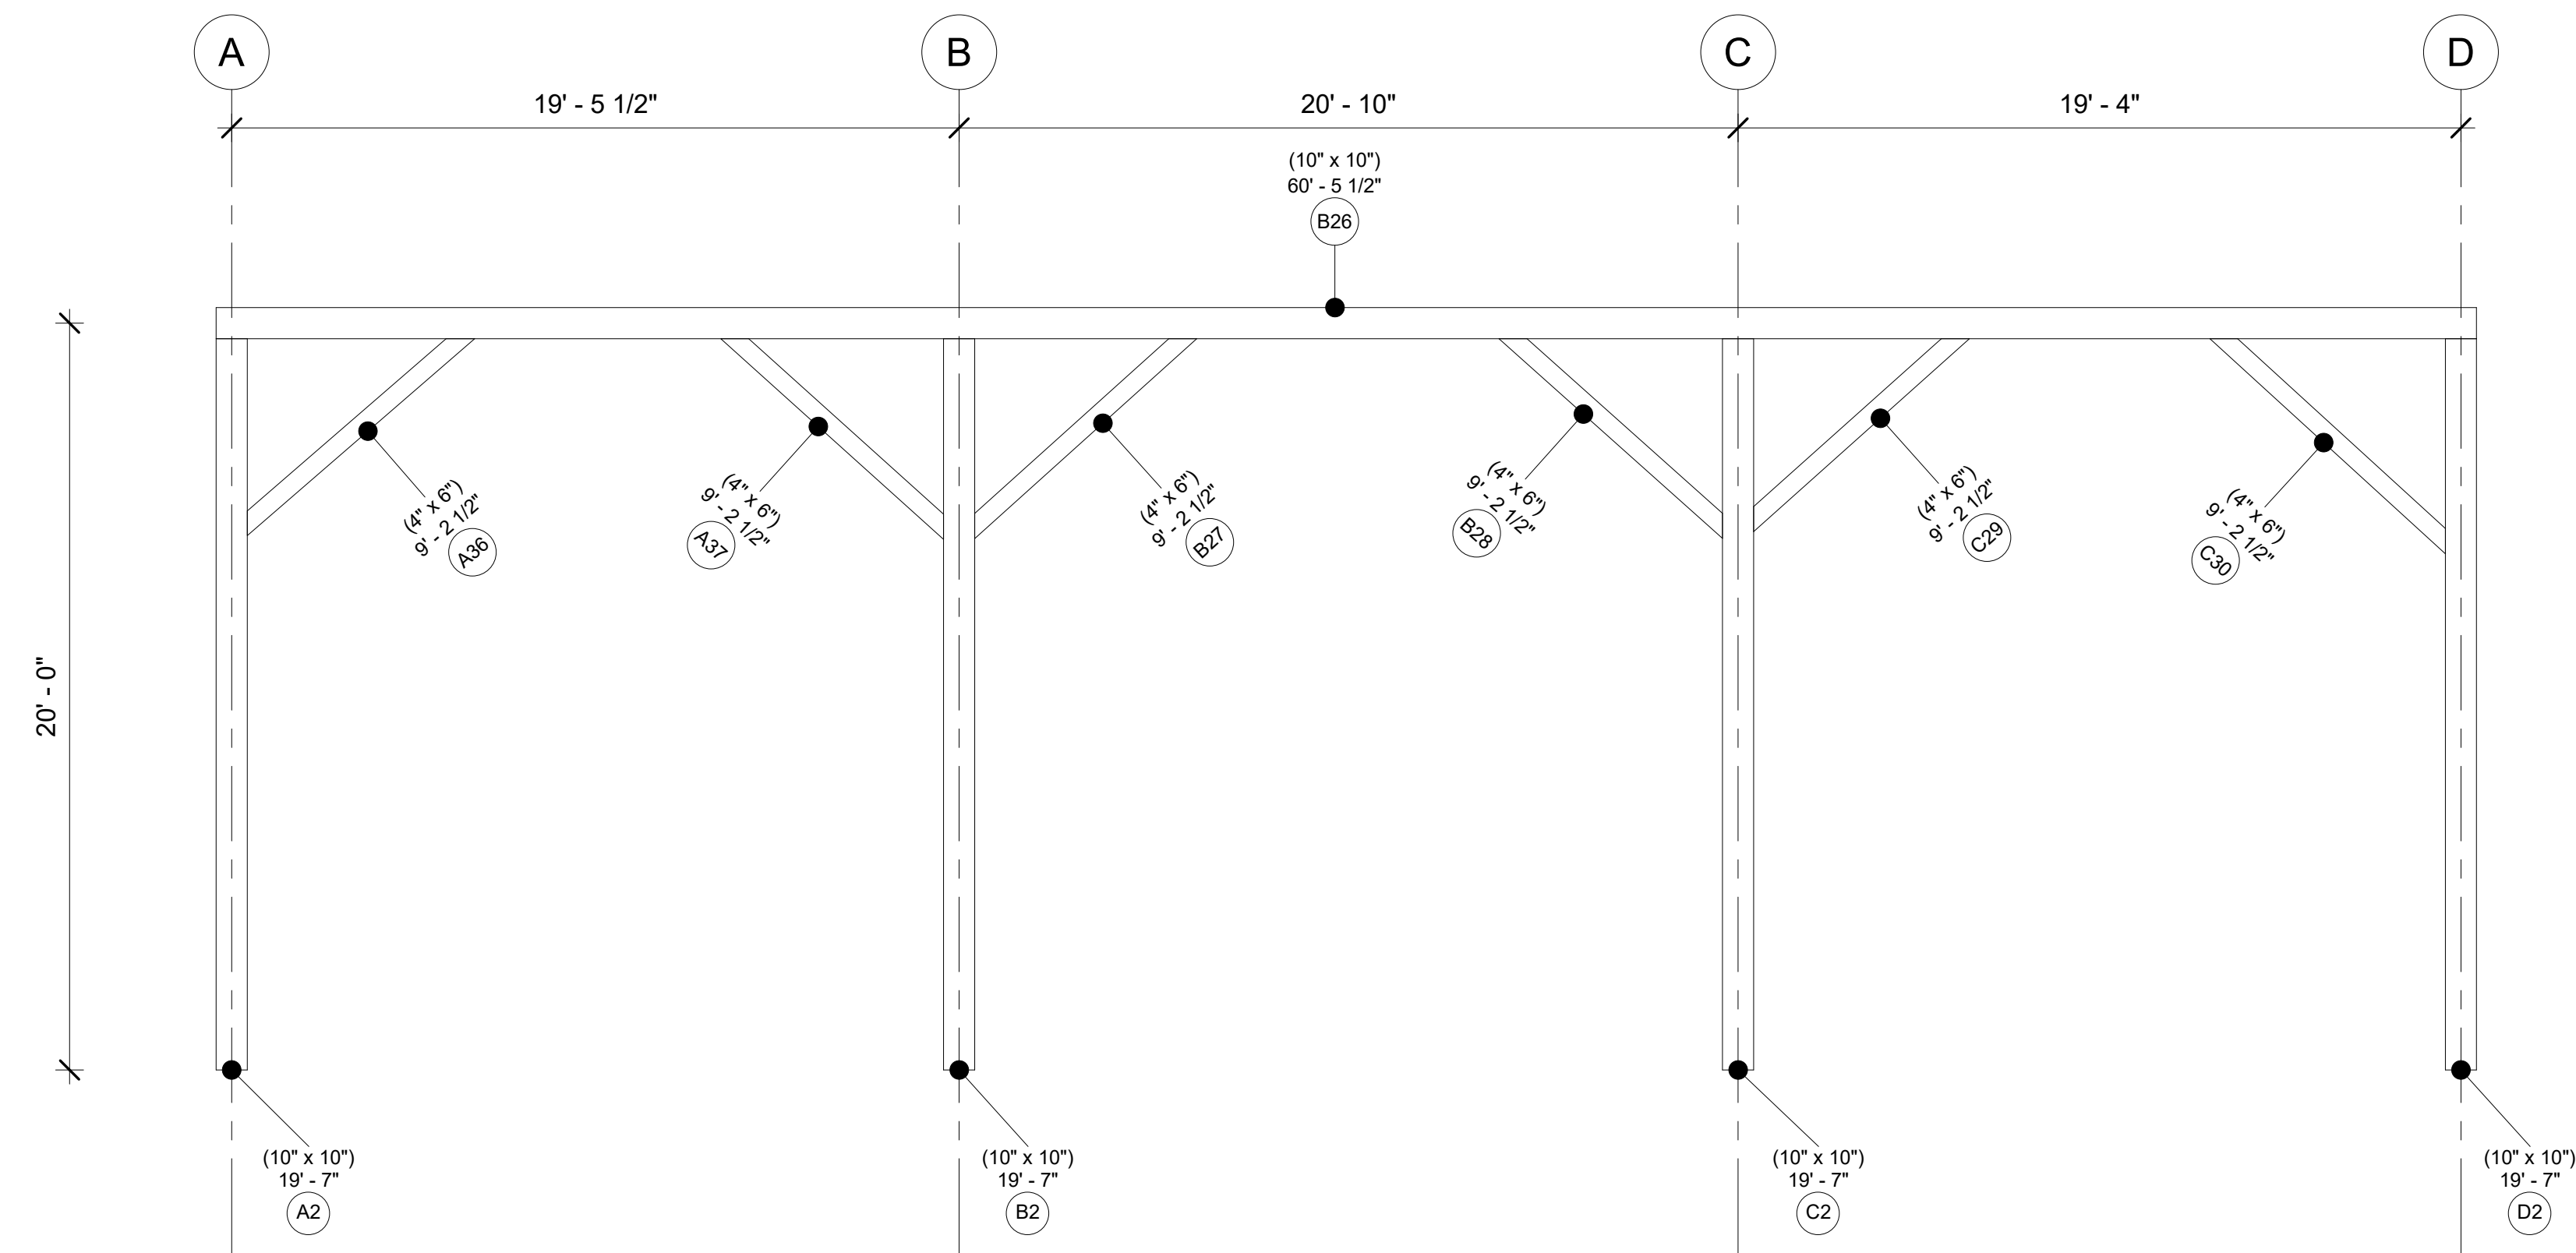

Bent 2

Project Number	Project 1
Date	20251112
Drawn By	
Checked By	

A108


Scale 1/4" = 1'-0"

Timber Home Services LLC

111-Whimsy-Creek

DAN TRIMBLE
AA66 / TIMBER HOME SERVICES
CELL PHONE/TEXT - 412-309-1161

EMAIL:
DANTRIMBLE@TIMBERHOMESERVICES.COM

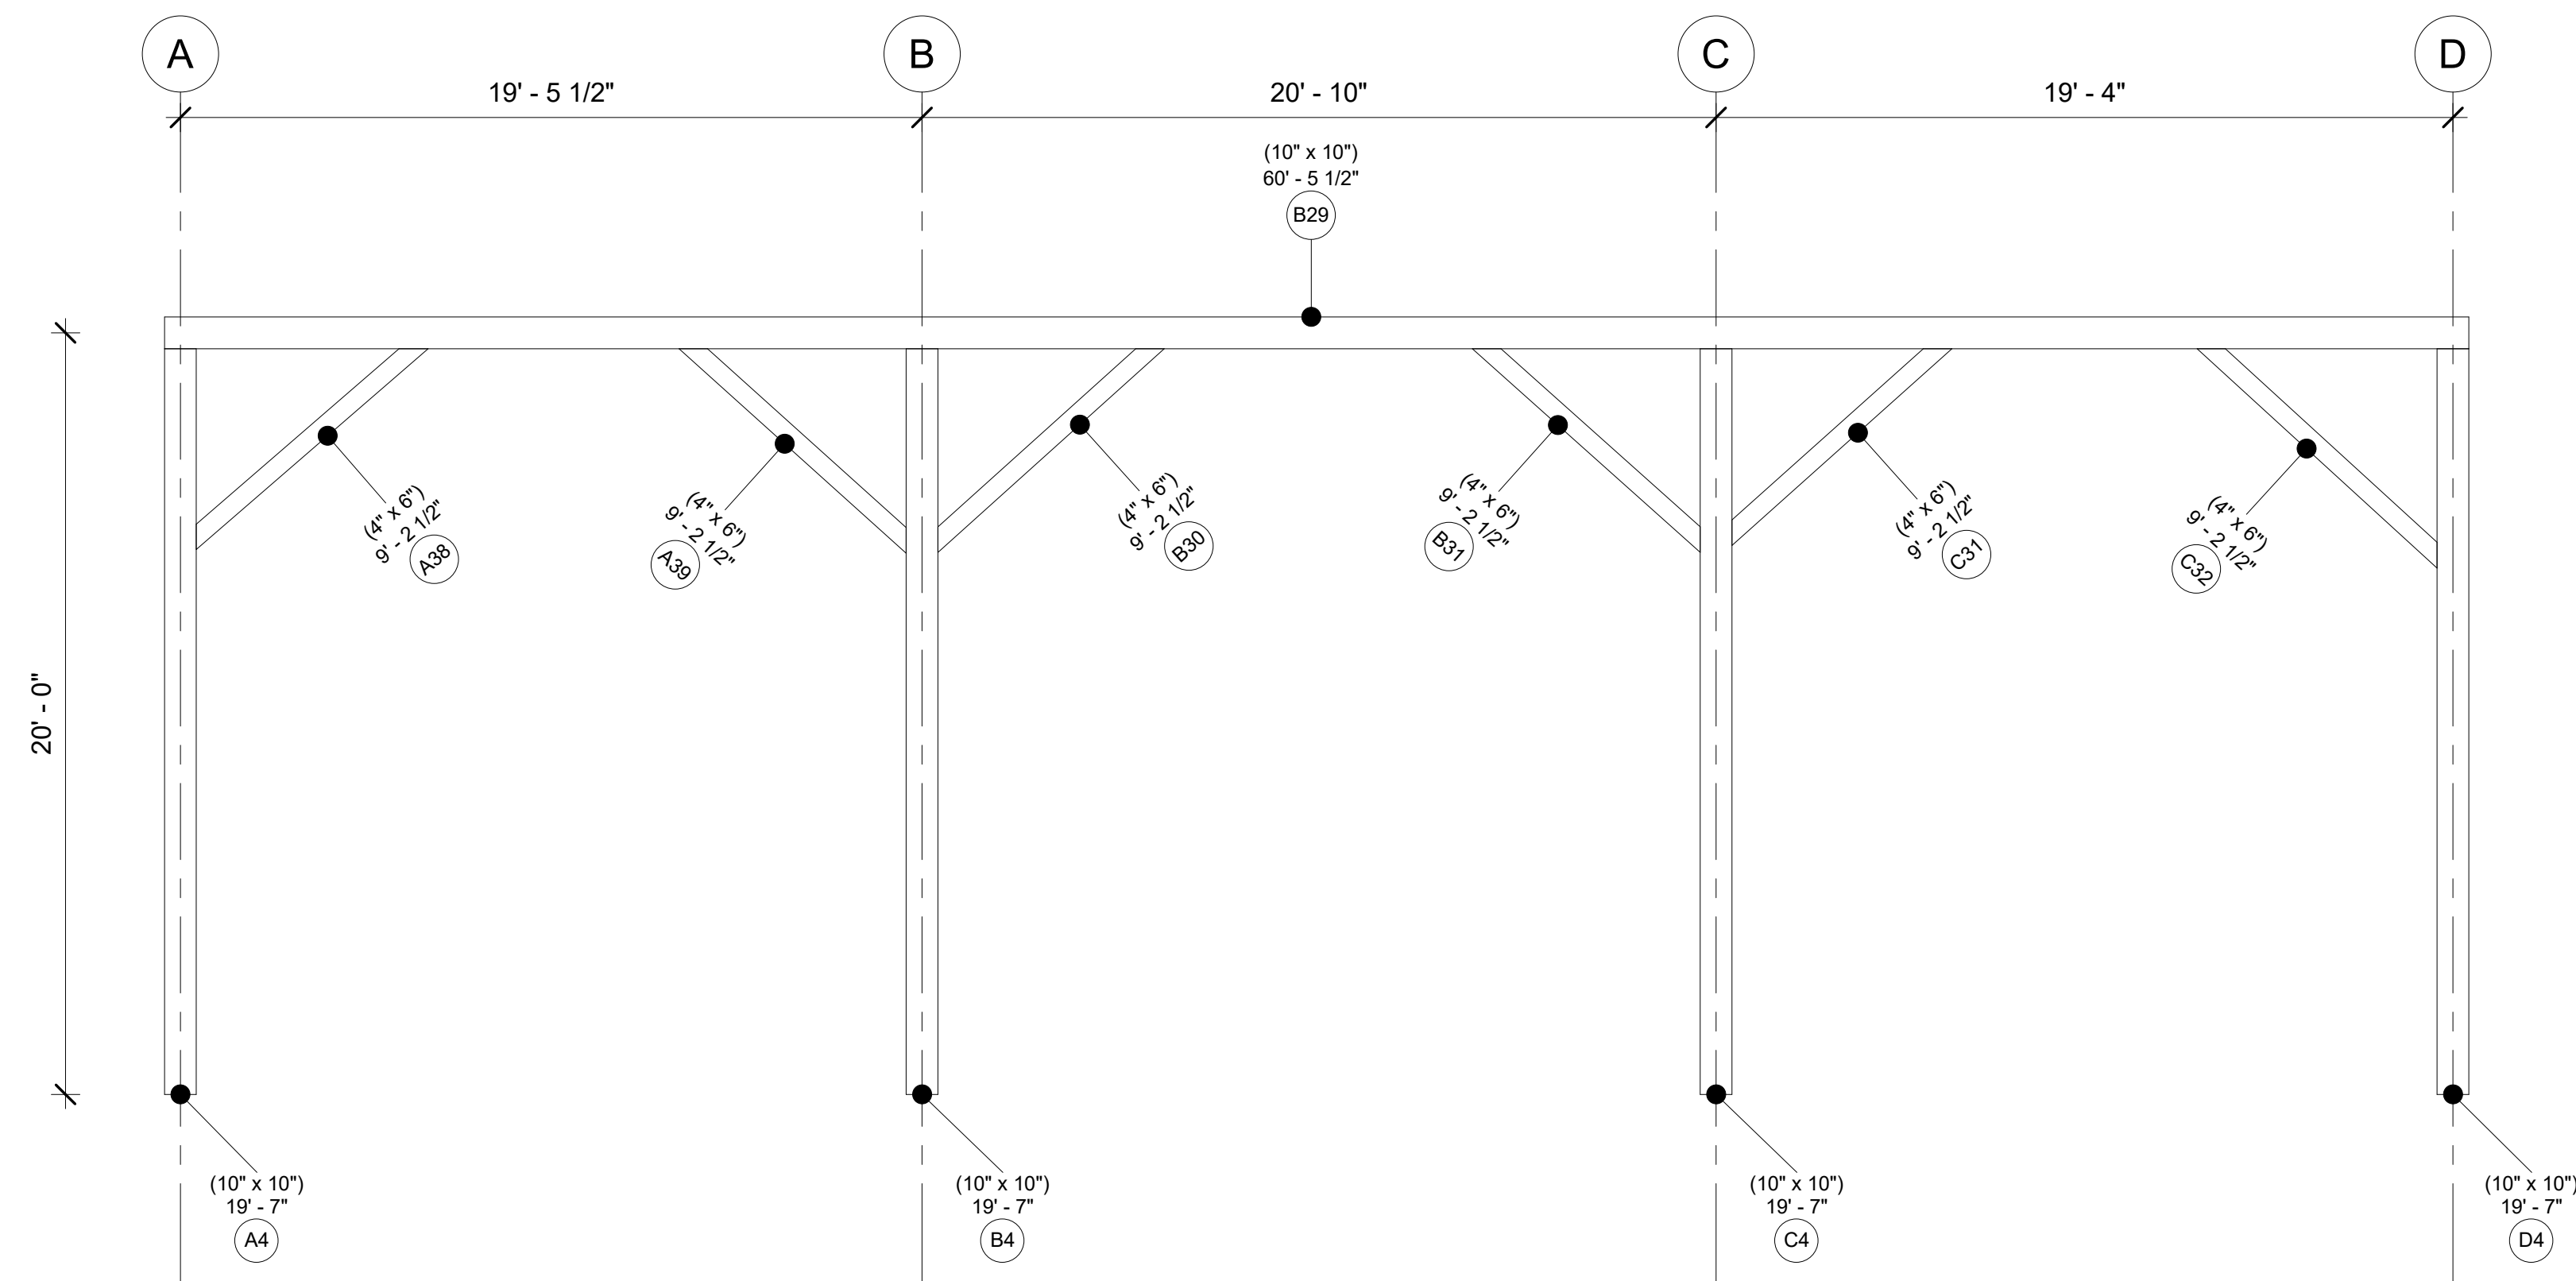

Bent 4

Project Number	Project 1
Date	20251112
Drawn By	
Checked By	

A109


Scale 1/4" = 1'-0"

Timber Home Services LLC

111-Whimsy-Creek

DAN TRIMBLE
AA66 / TIMBER HOME SERVICES
CELL PHONE/TEXT - 412-309-1161

EMAIL:
DANTRIMBLE@TIMBERHOMESERVICES.COM

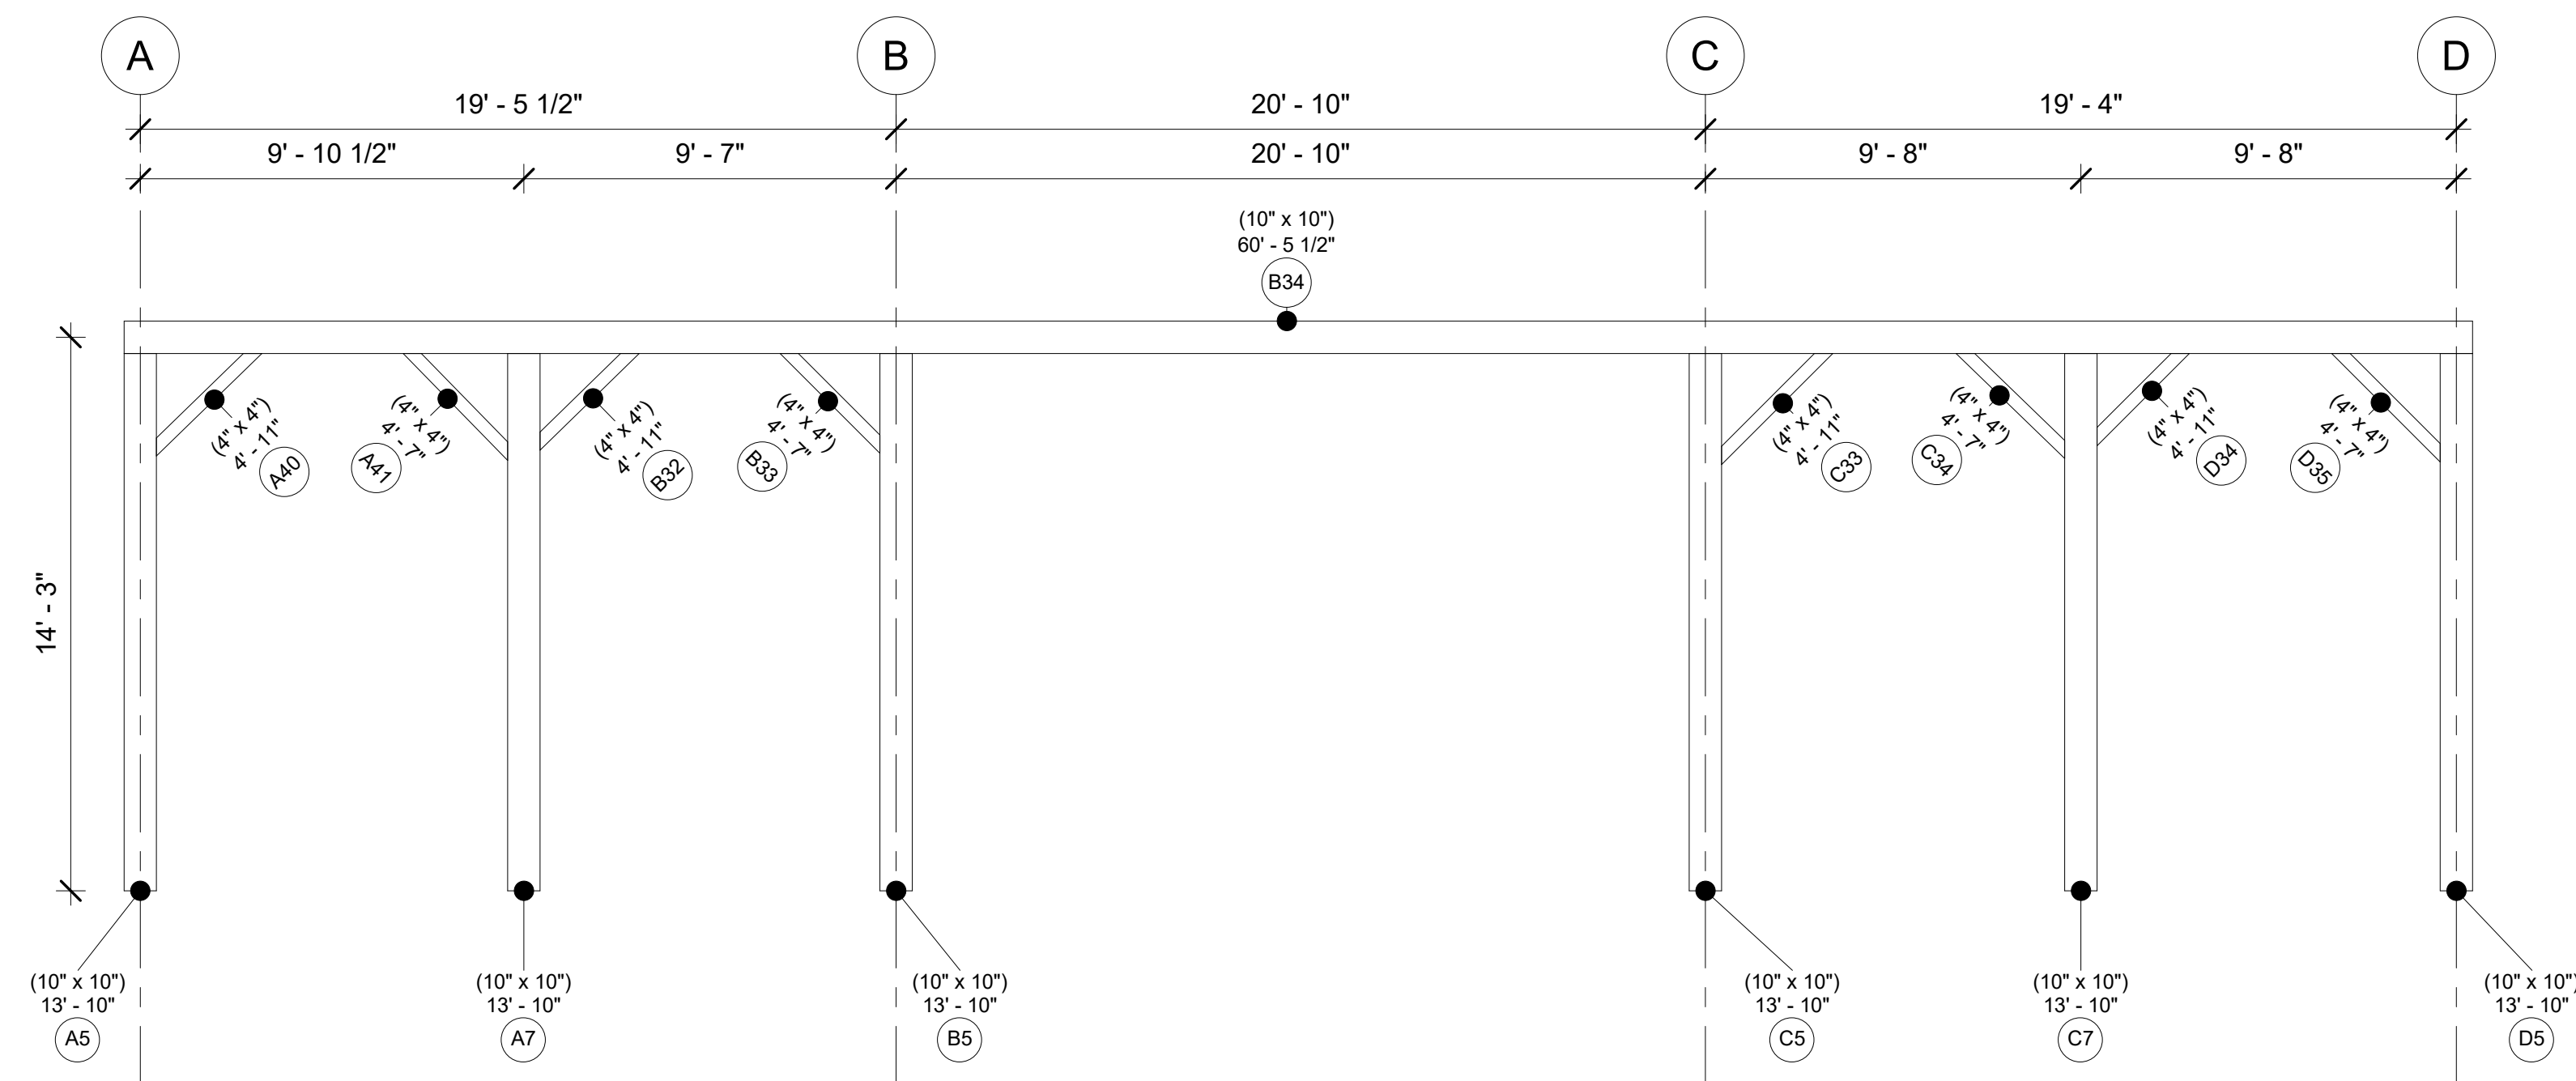

Bent 5

Project Number Project 1
Date 20251112
Drawn By
Checked By

A110

Scale 1/4" = 1'-0"