


PROJECT: 107-1852
SCOPE: AS BUILT DRAWINGS

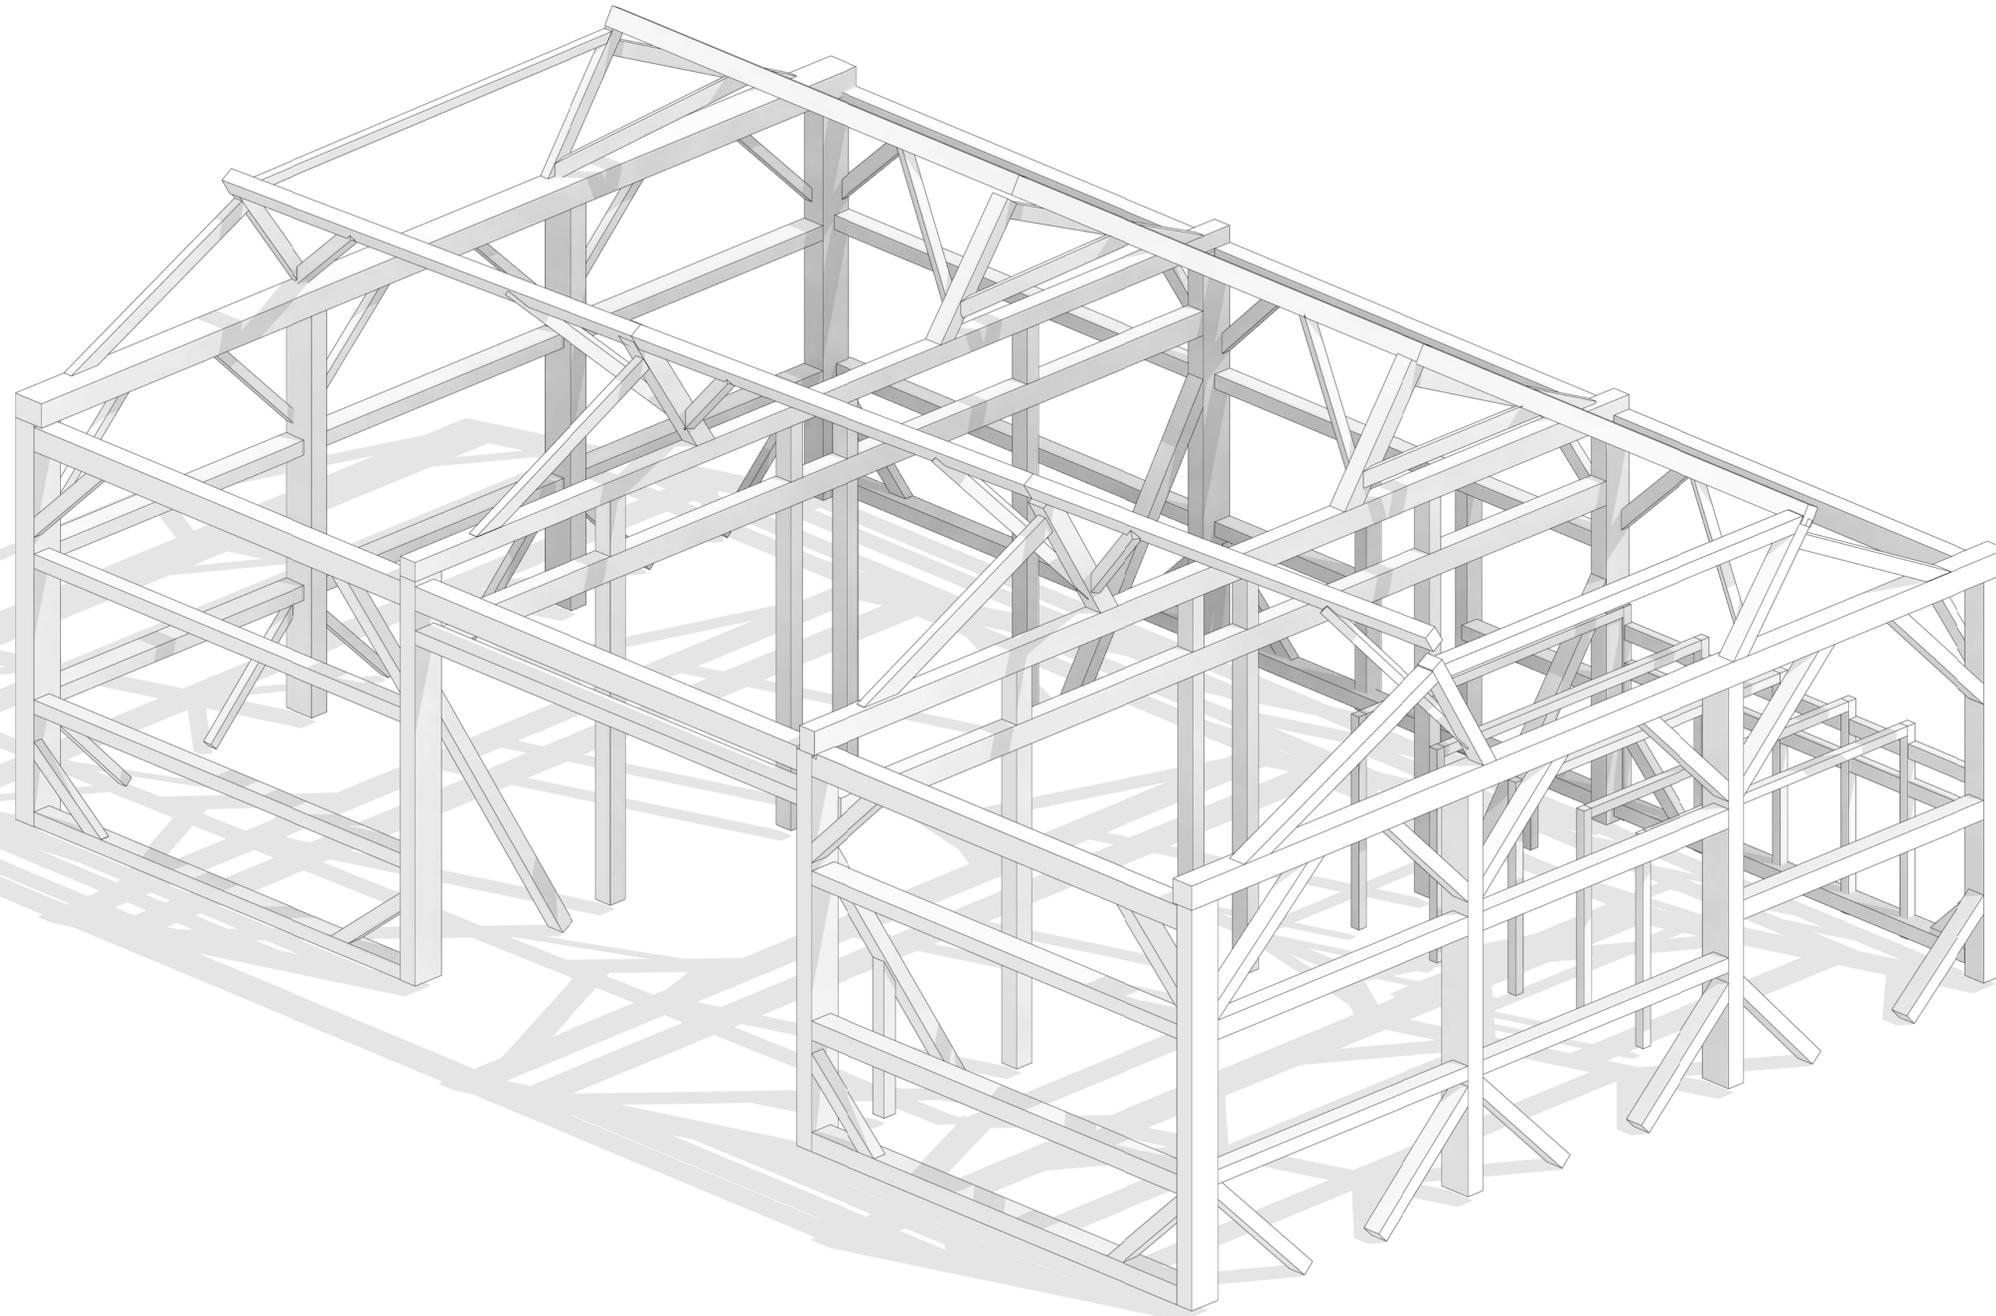

107-1852


Cover Page

Project Number	107-1852
Date	20260209
Drawn By	
Checked By	

A101

Scale

107-1852

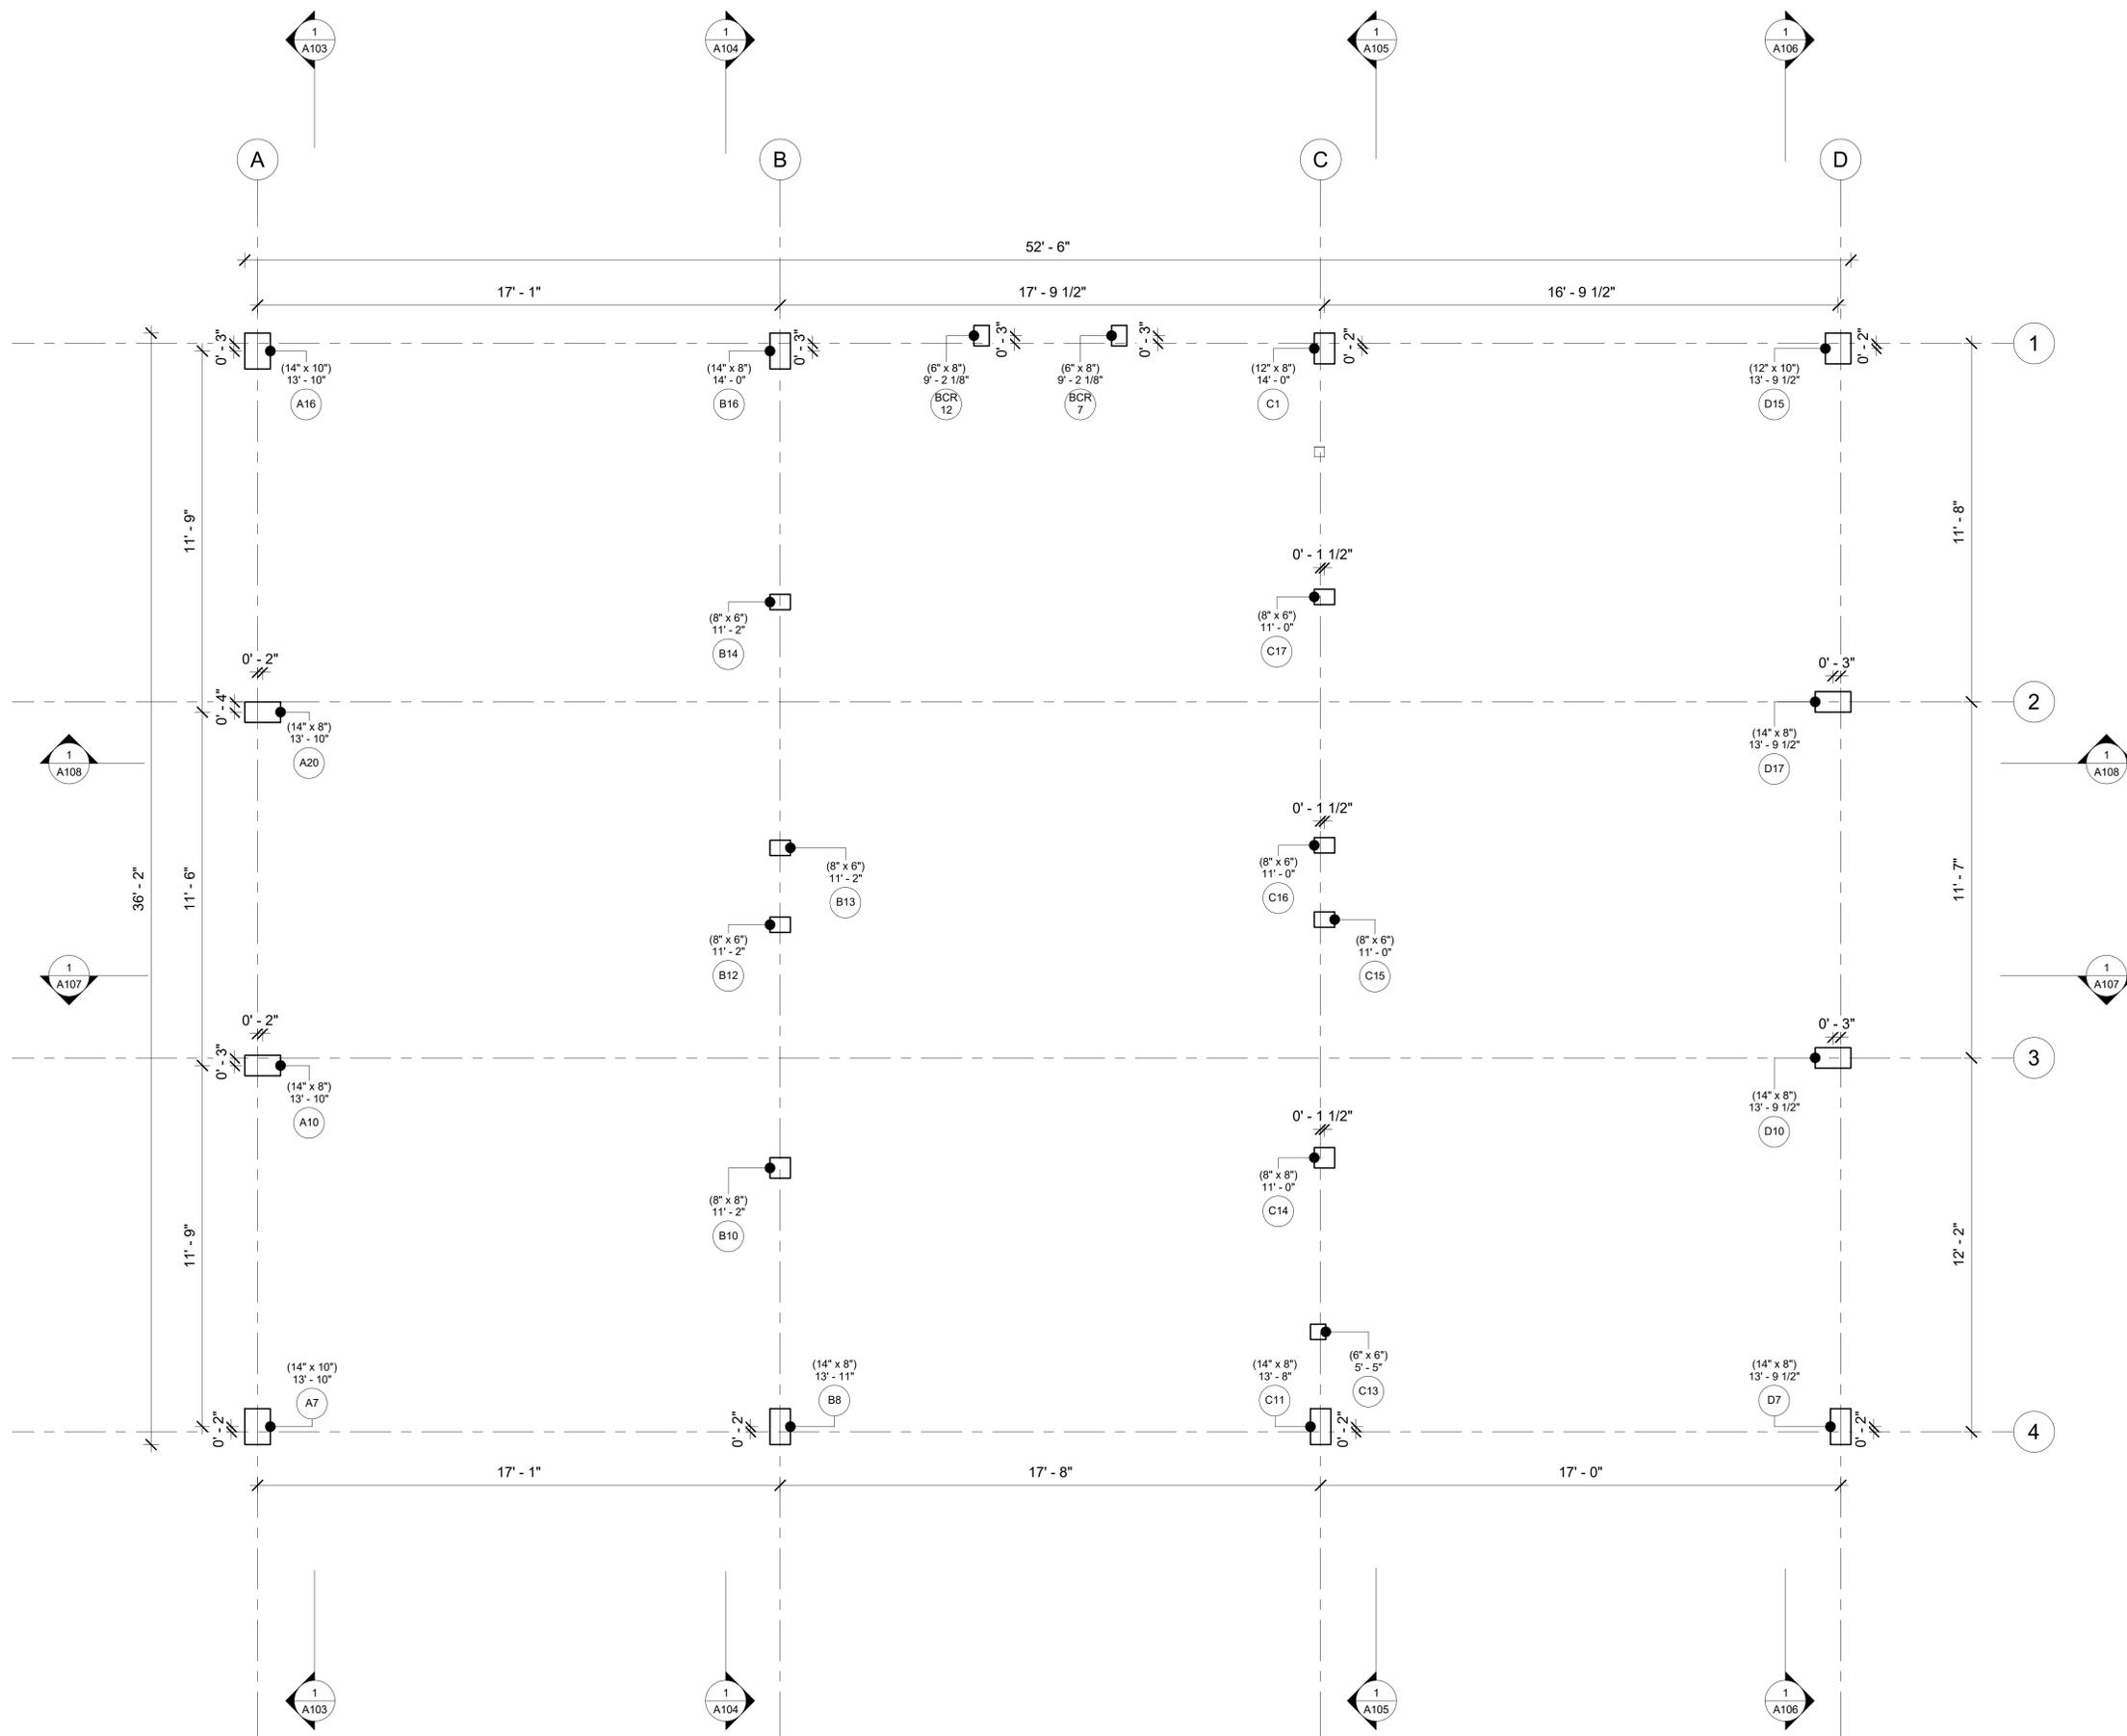


Ground

Project Number	107-1852
Date	20260209
Drawn By	
Checked By	

A102

Scale 3/8" = 1'-0"

107-1852

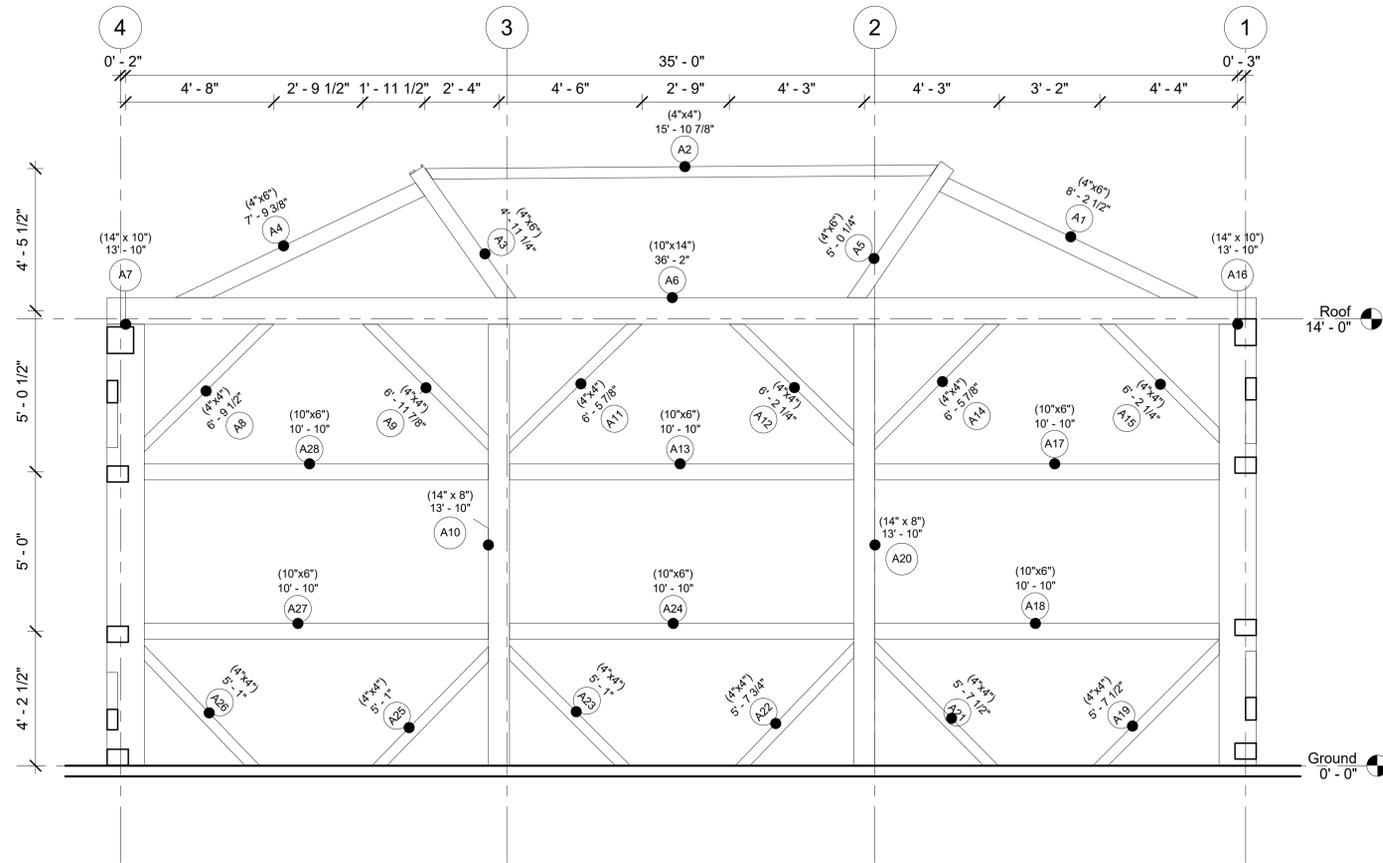

Bent A

Project Number 107-1852


Date 20260209

Drawn By

Checked By

A103

Scale 3/8" = 1'-0"

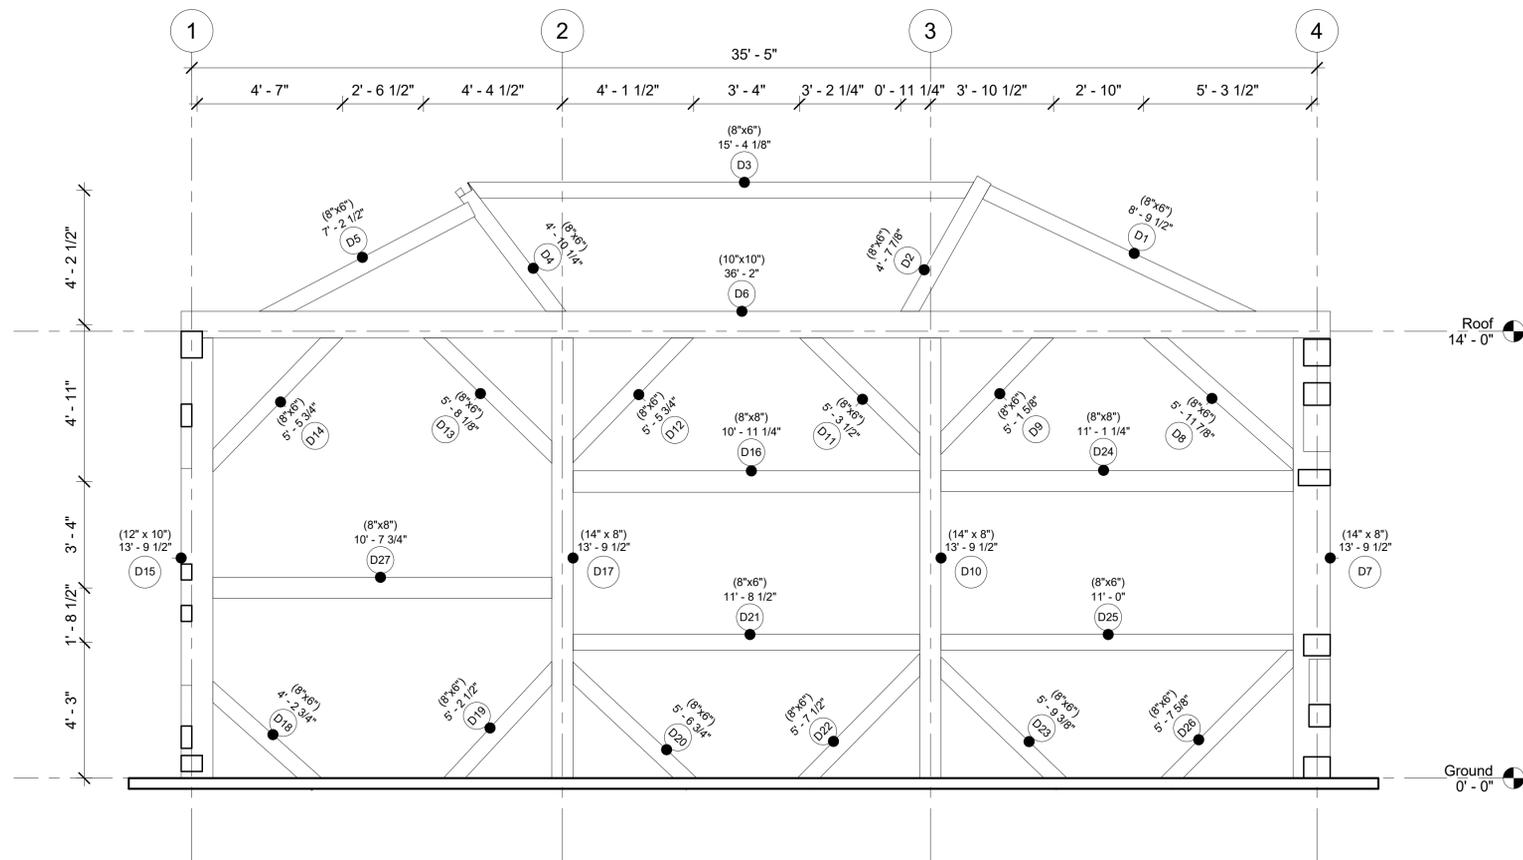


107-1852

Bent D

Project Number	107-1852
Date	20260209
Drawn By	
Checked By	

A106

Scale	3/8" = 1'-0"
-------	--------------

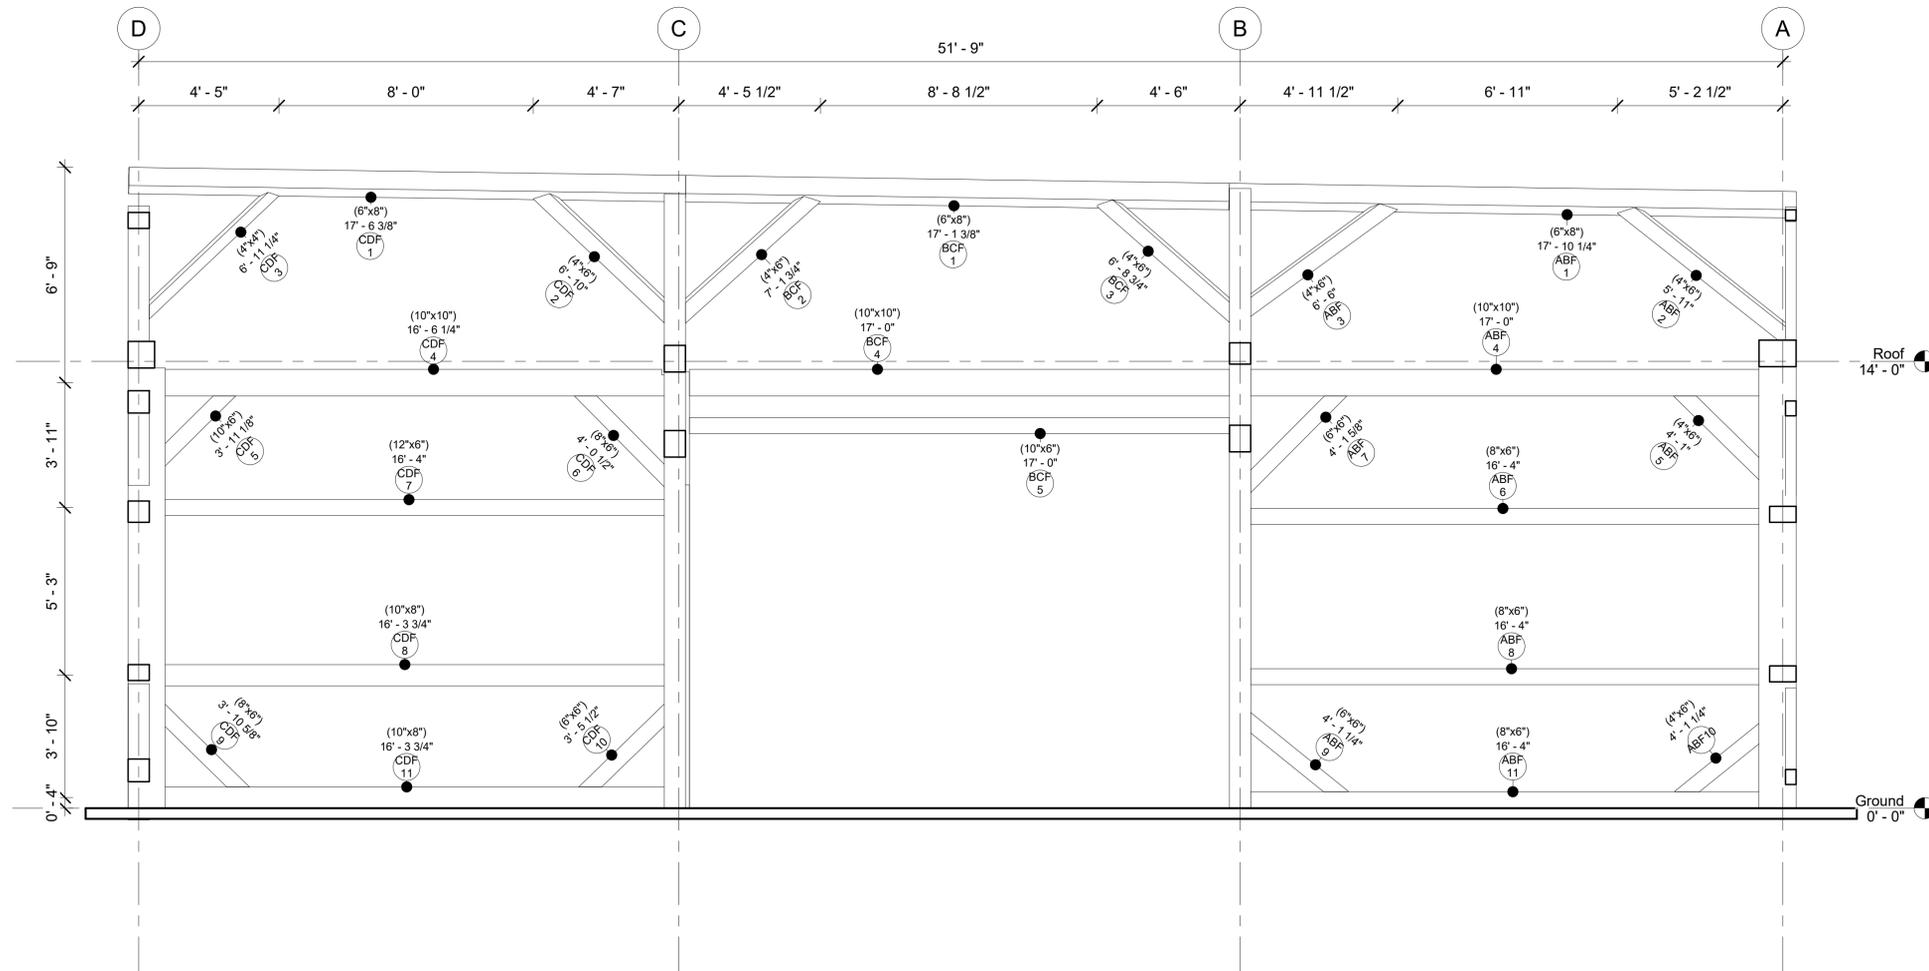

107-1852

Bent 1

Project Number	107-1852
Date	20260209
Drawn By	
Checked By	

A107

Scale	3/8" = 1'-0"
-------	--------------

