


PROJECT: Piney Hollow
SCOPE: AS BUILT DRAWINGS

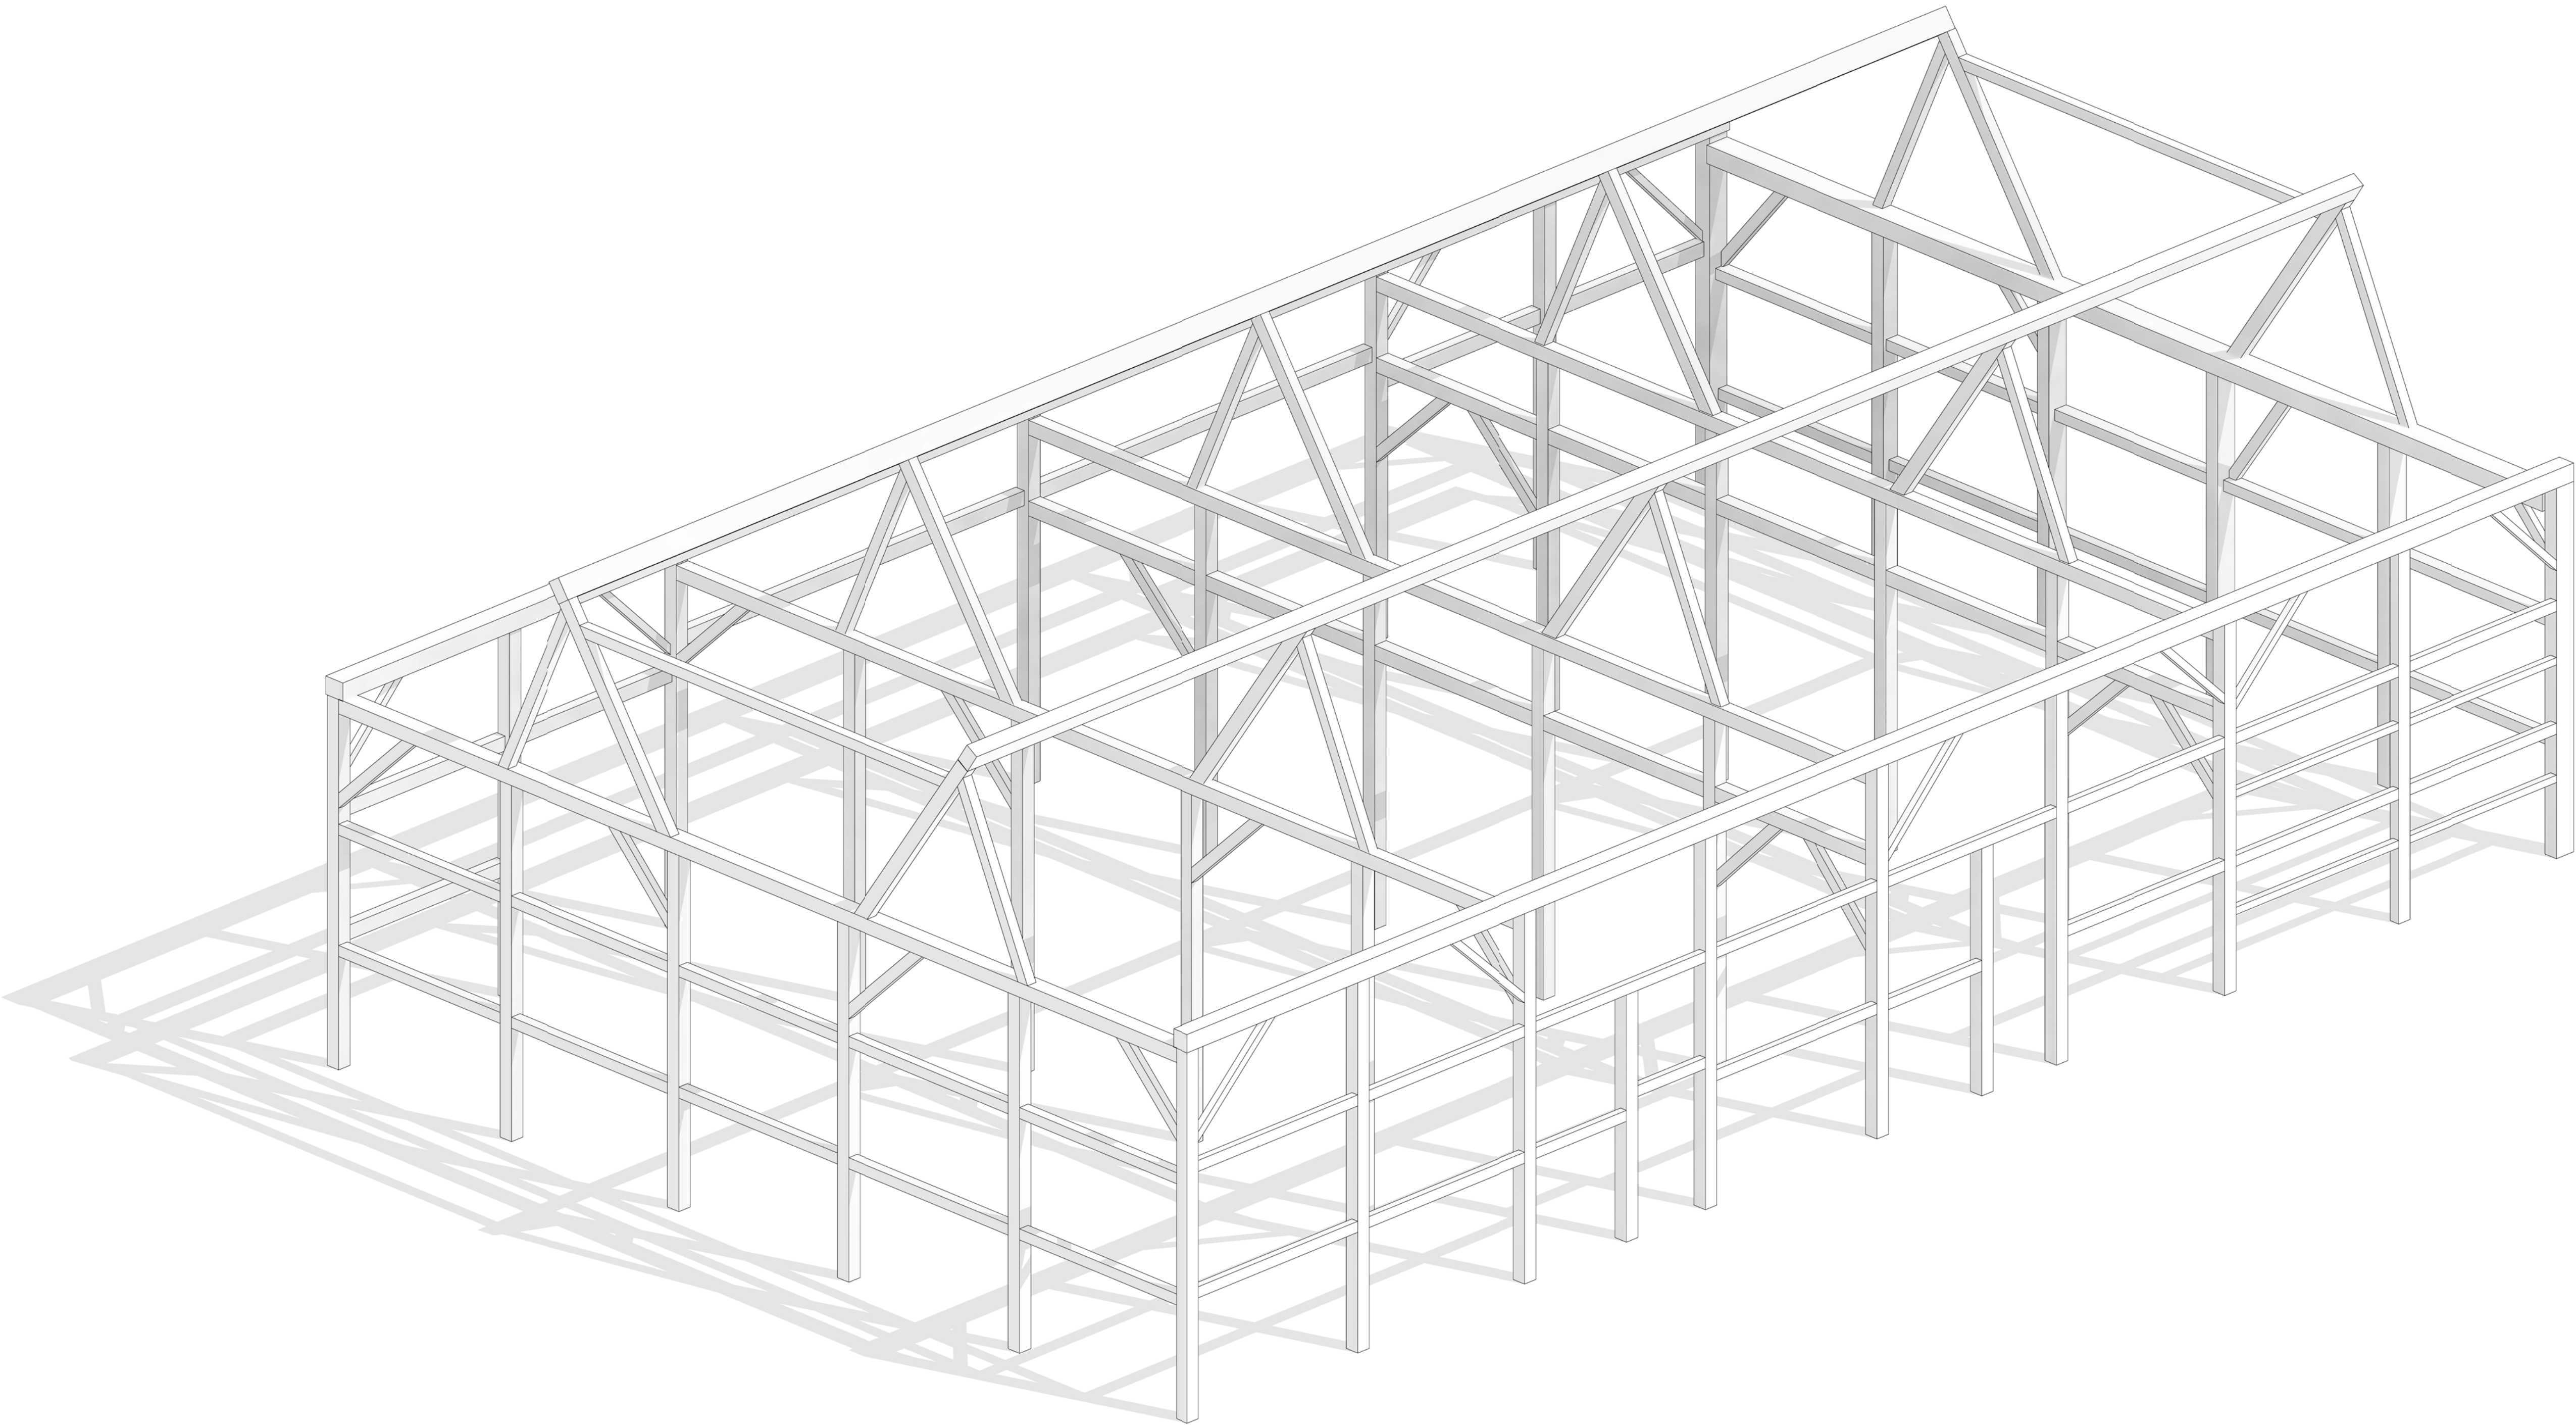

Piney Hollow

Cover Page

Project Number	Project 16
Date	20250605
Drawn By	
Checked By	
A101	
Scale	

Piney Hollow

Floor Plan


Project Number	Project 16
Date	20250605
Drawn By	
Checked By	
A102	
Scale	1/4" = 1'-0"



Piney Hollow

Bent A

Project Number	Project 16
Date	20250605
Drawn By	
Checked By	
A103	
Scale	1/4" = 1'-0"

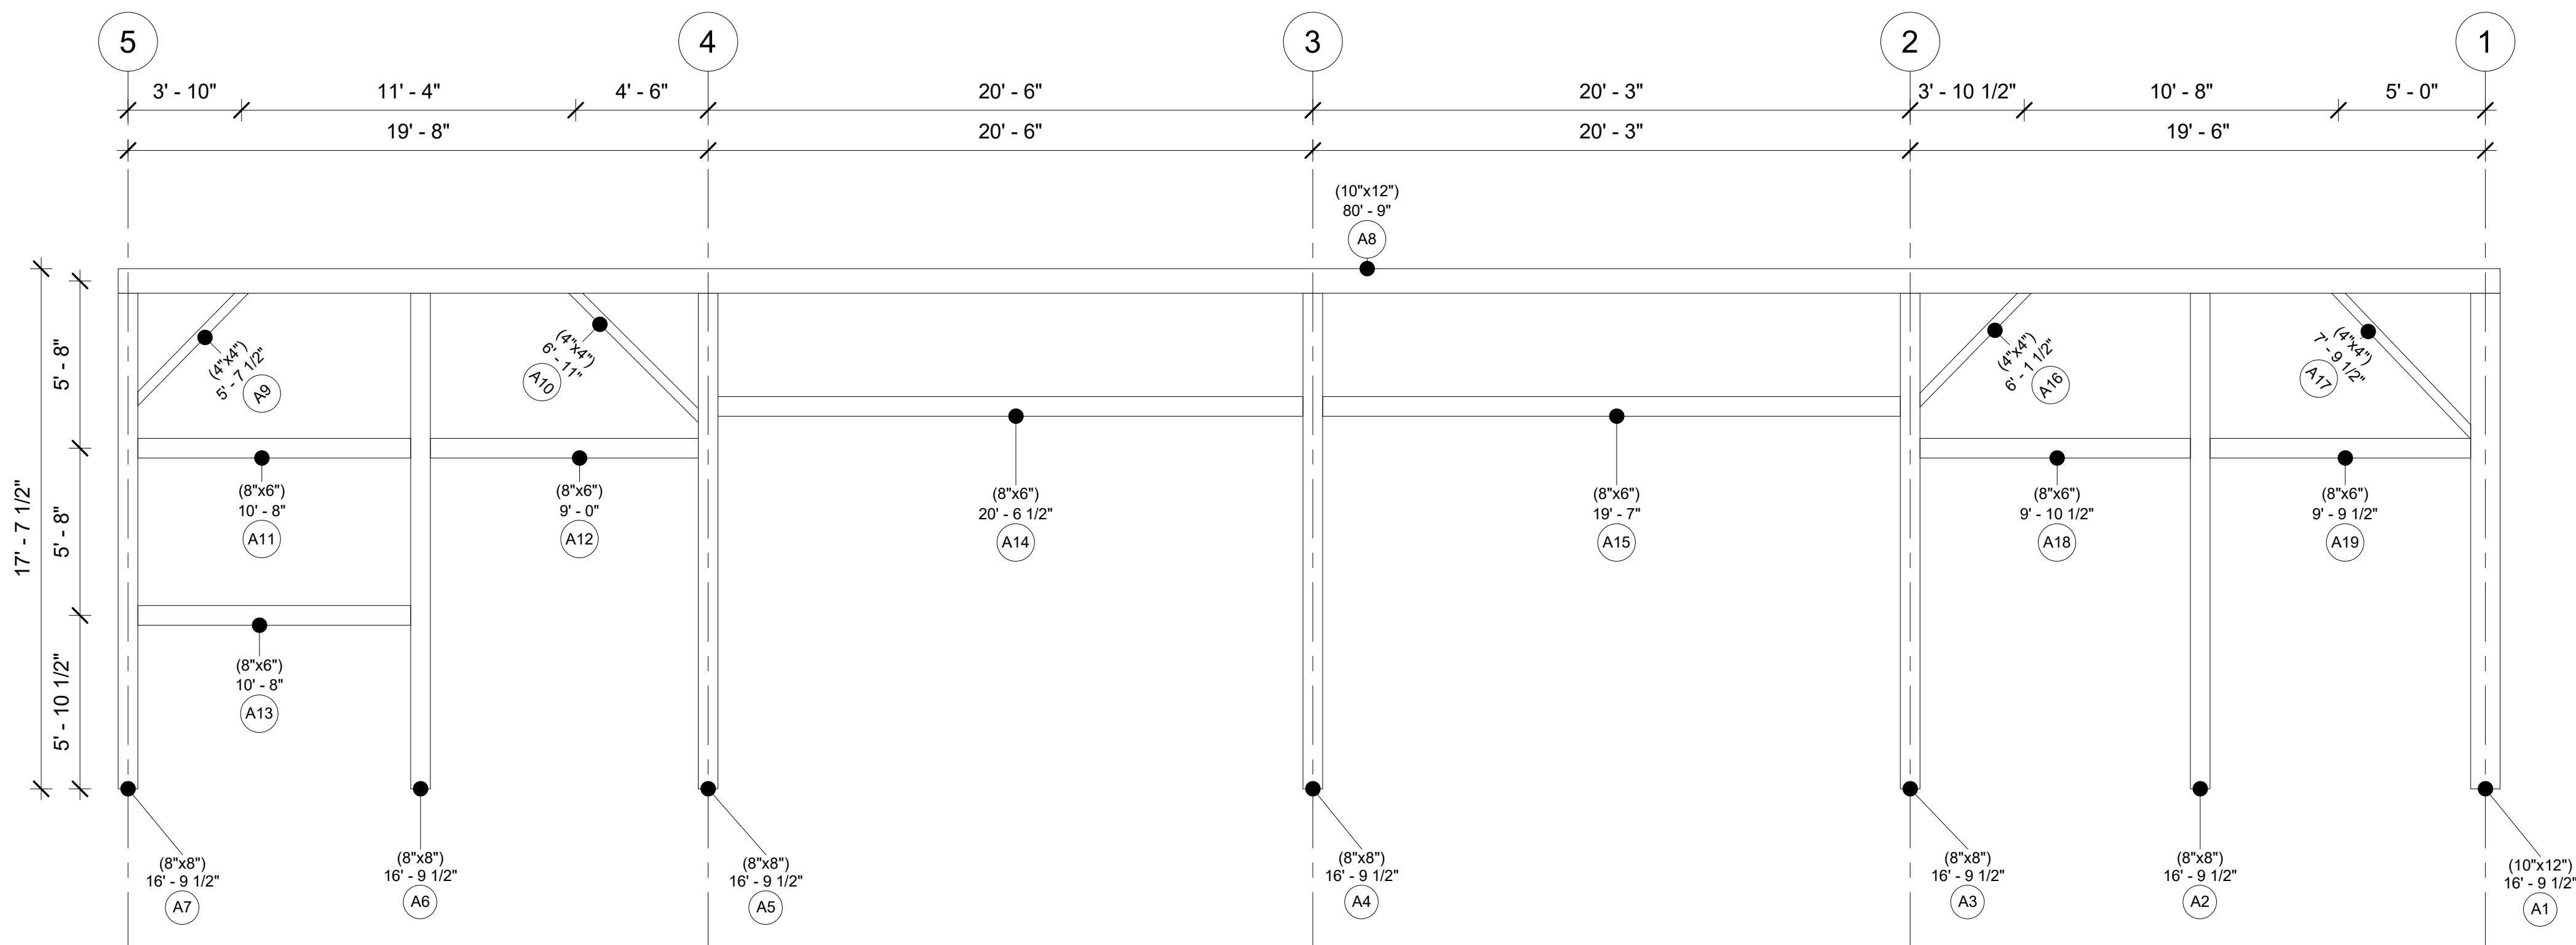

Piney Hollow

Bent F

Project Number Project 16


Date 20250605


Drawn By _____

Checked By _____

A104

Scale $1/4" = 1'-0"$

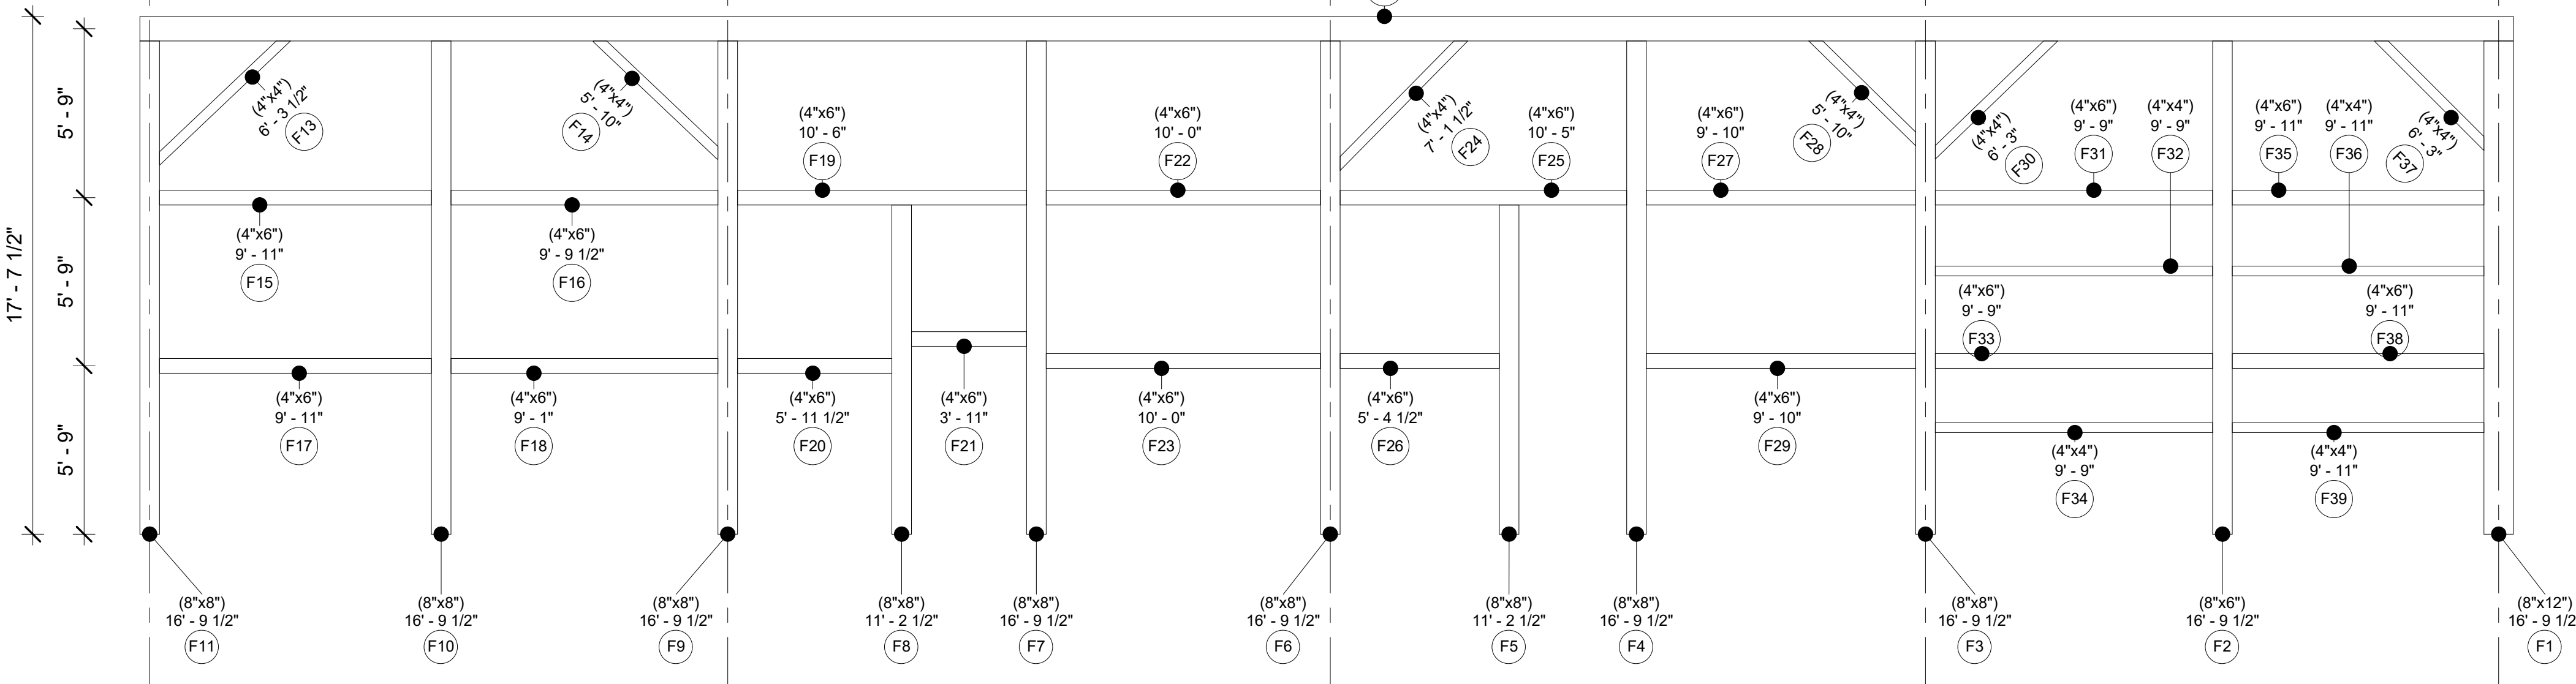


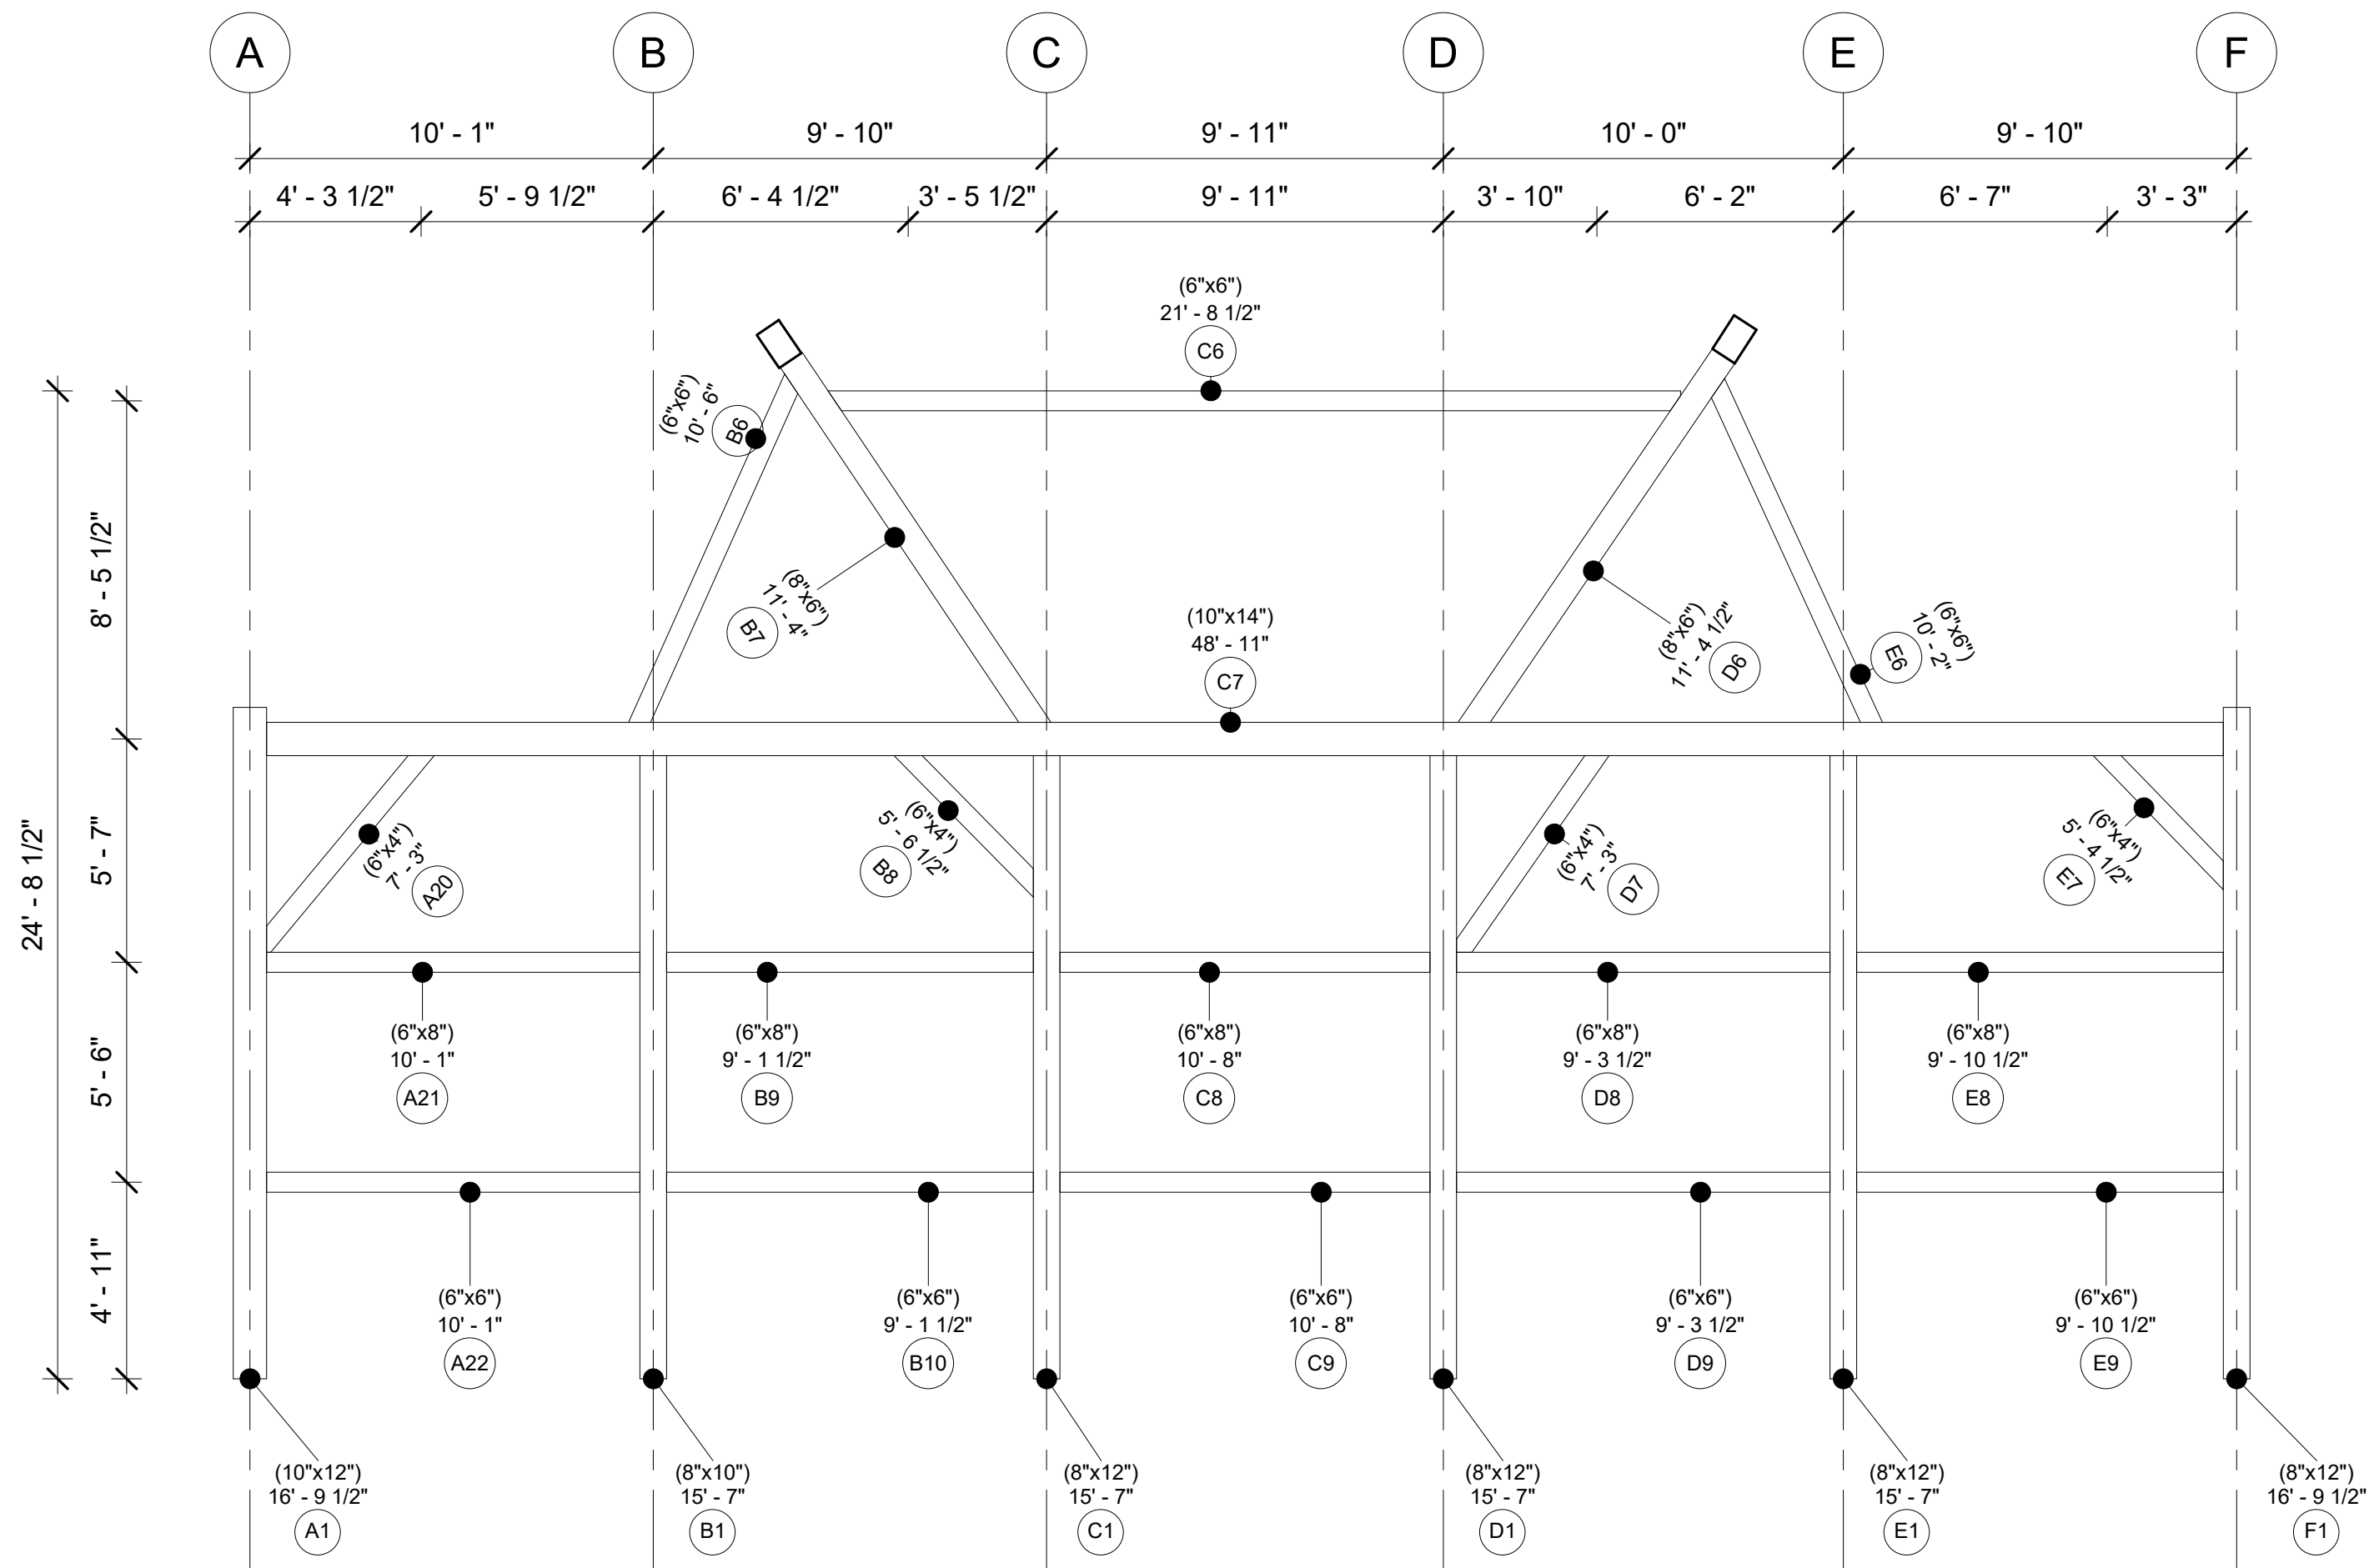

Piney Hollow

Bent 1


Project Number	Project 16
Date	20250605
Drawn By	
Checked By	
A105	
Scale	1/4" = 1'-0"

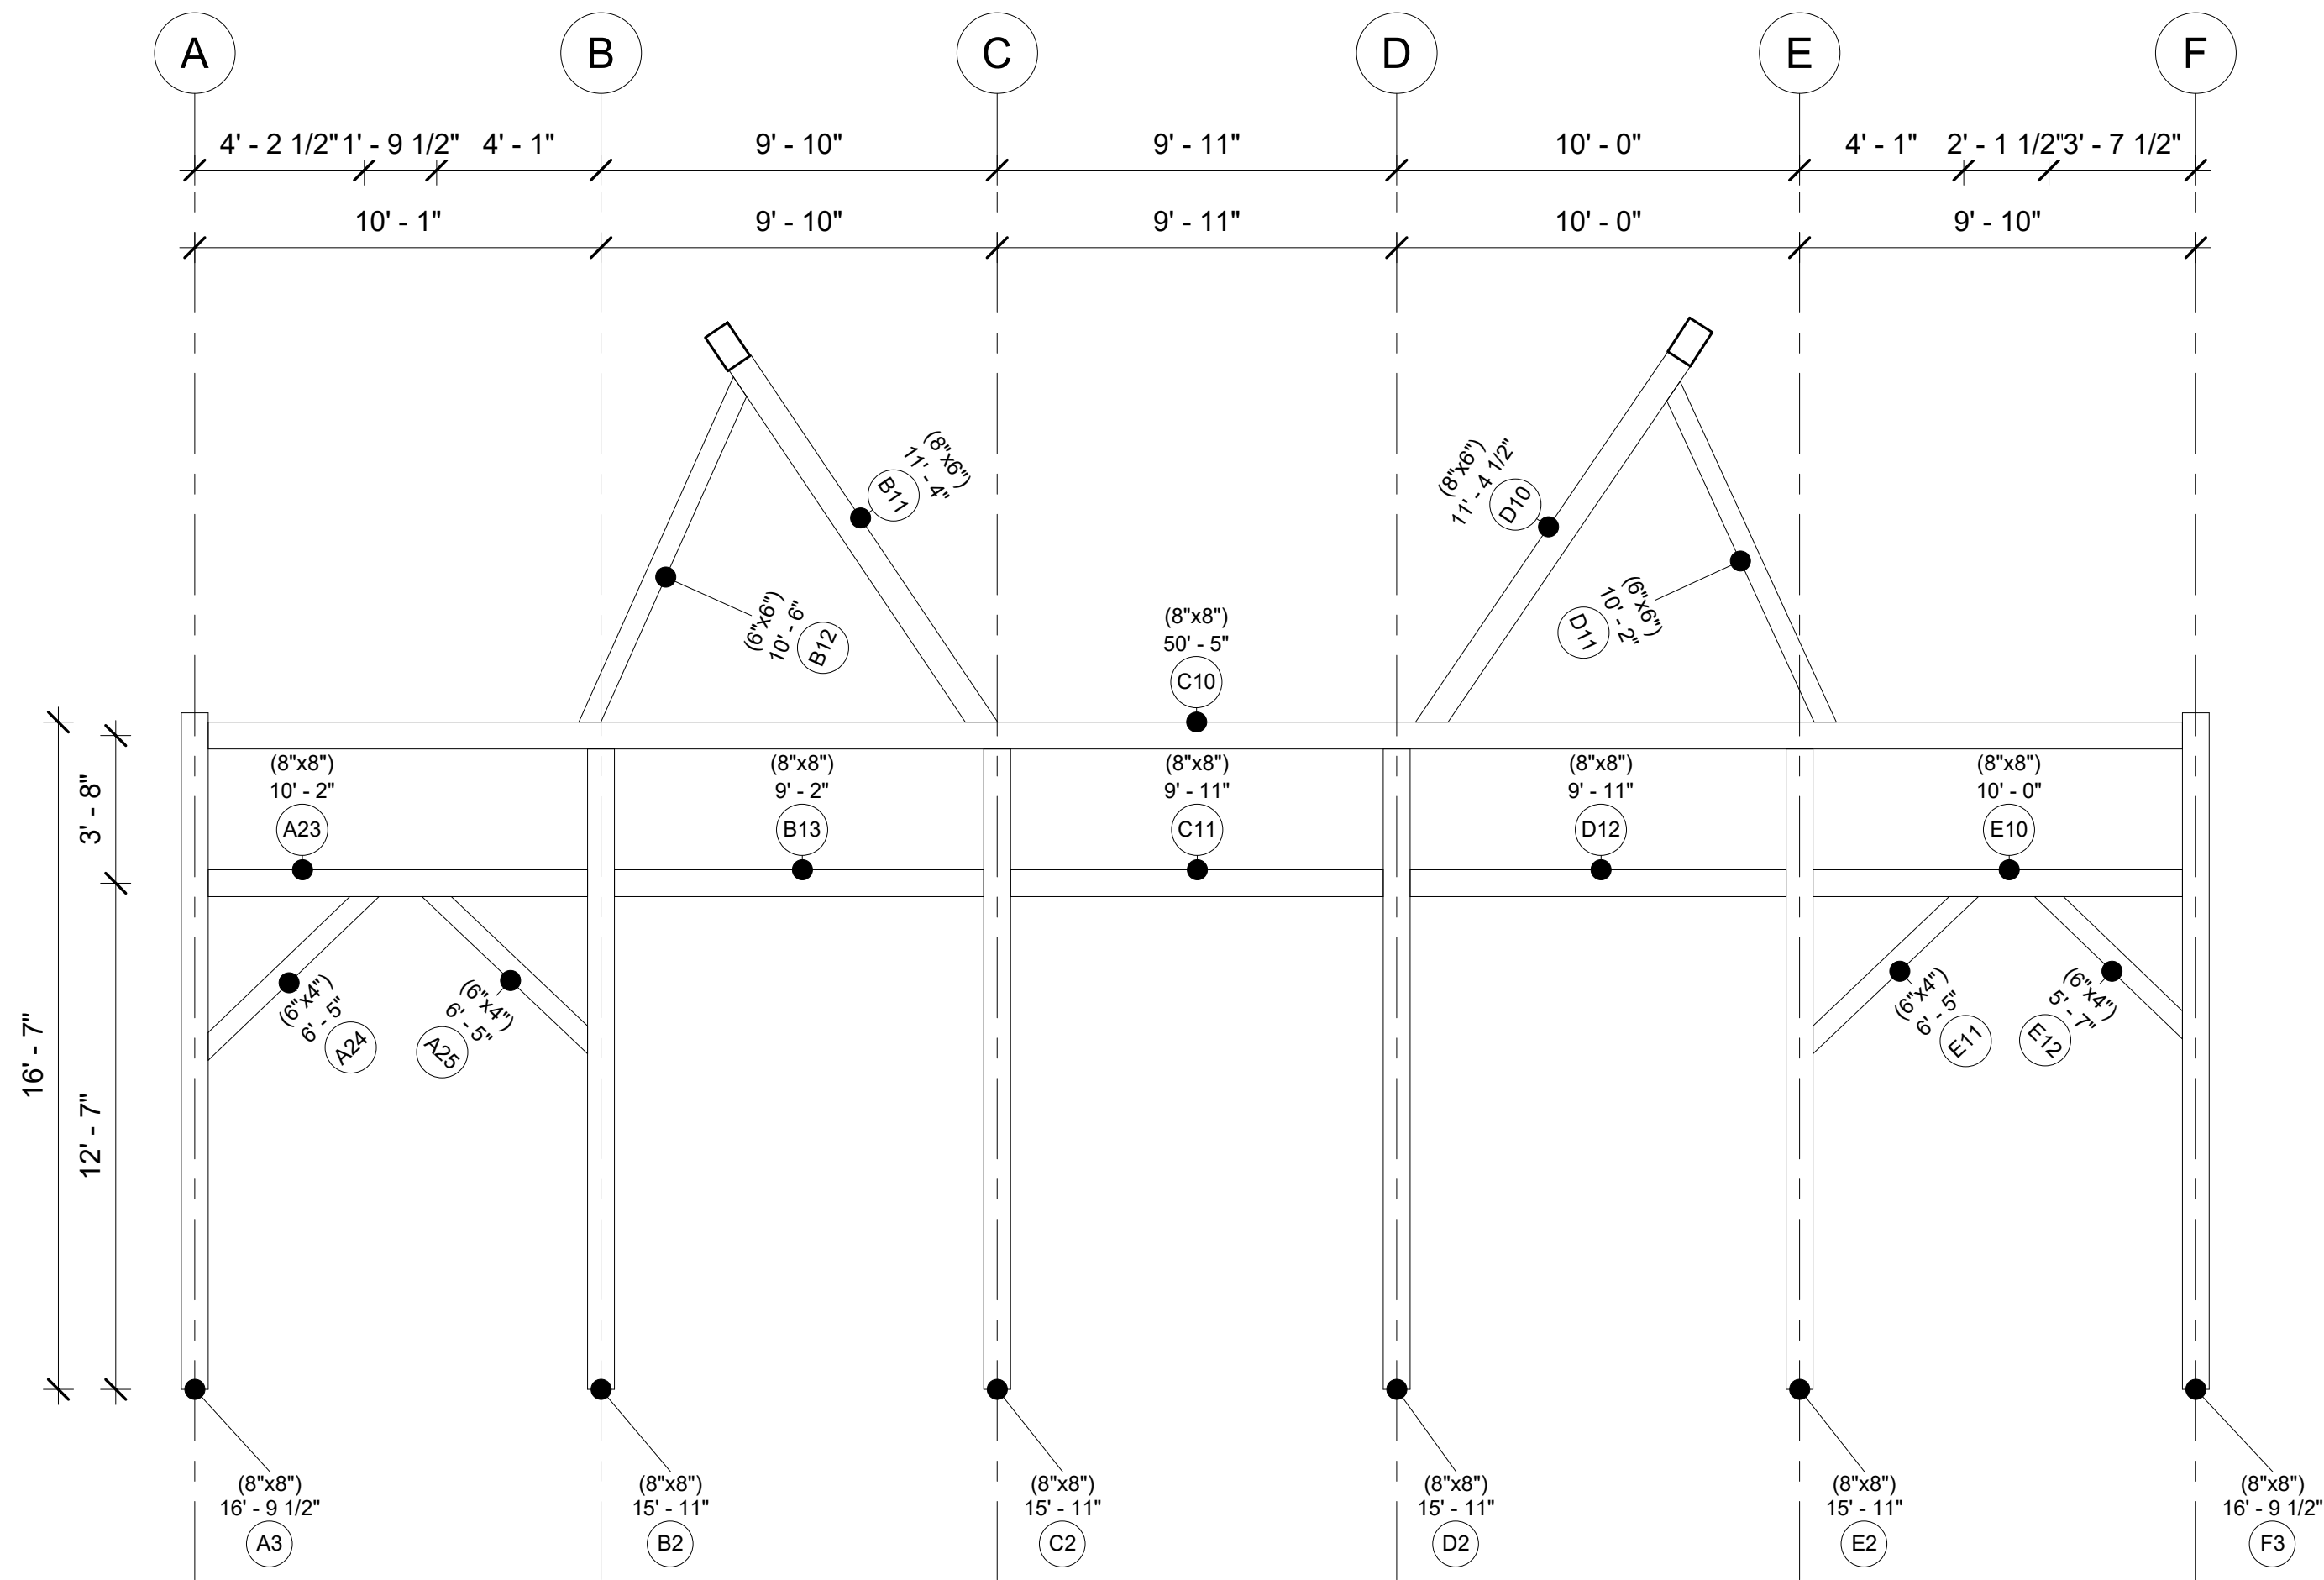

Piney Hollow

Bent 2


Project Number	Project 16
Date	20250605
Drawn By	
Checked By	
A106	
Scale	1/4" = 1'-0"

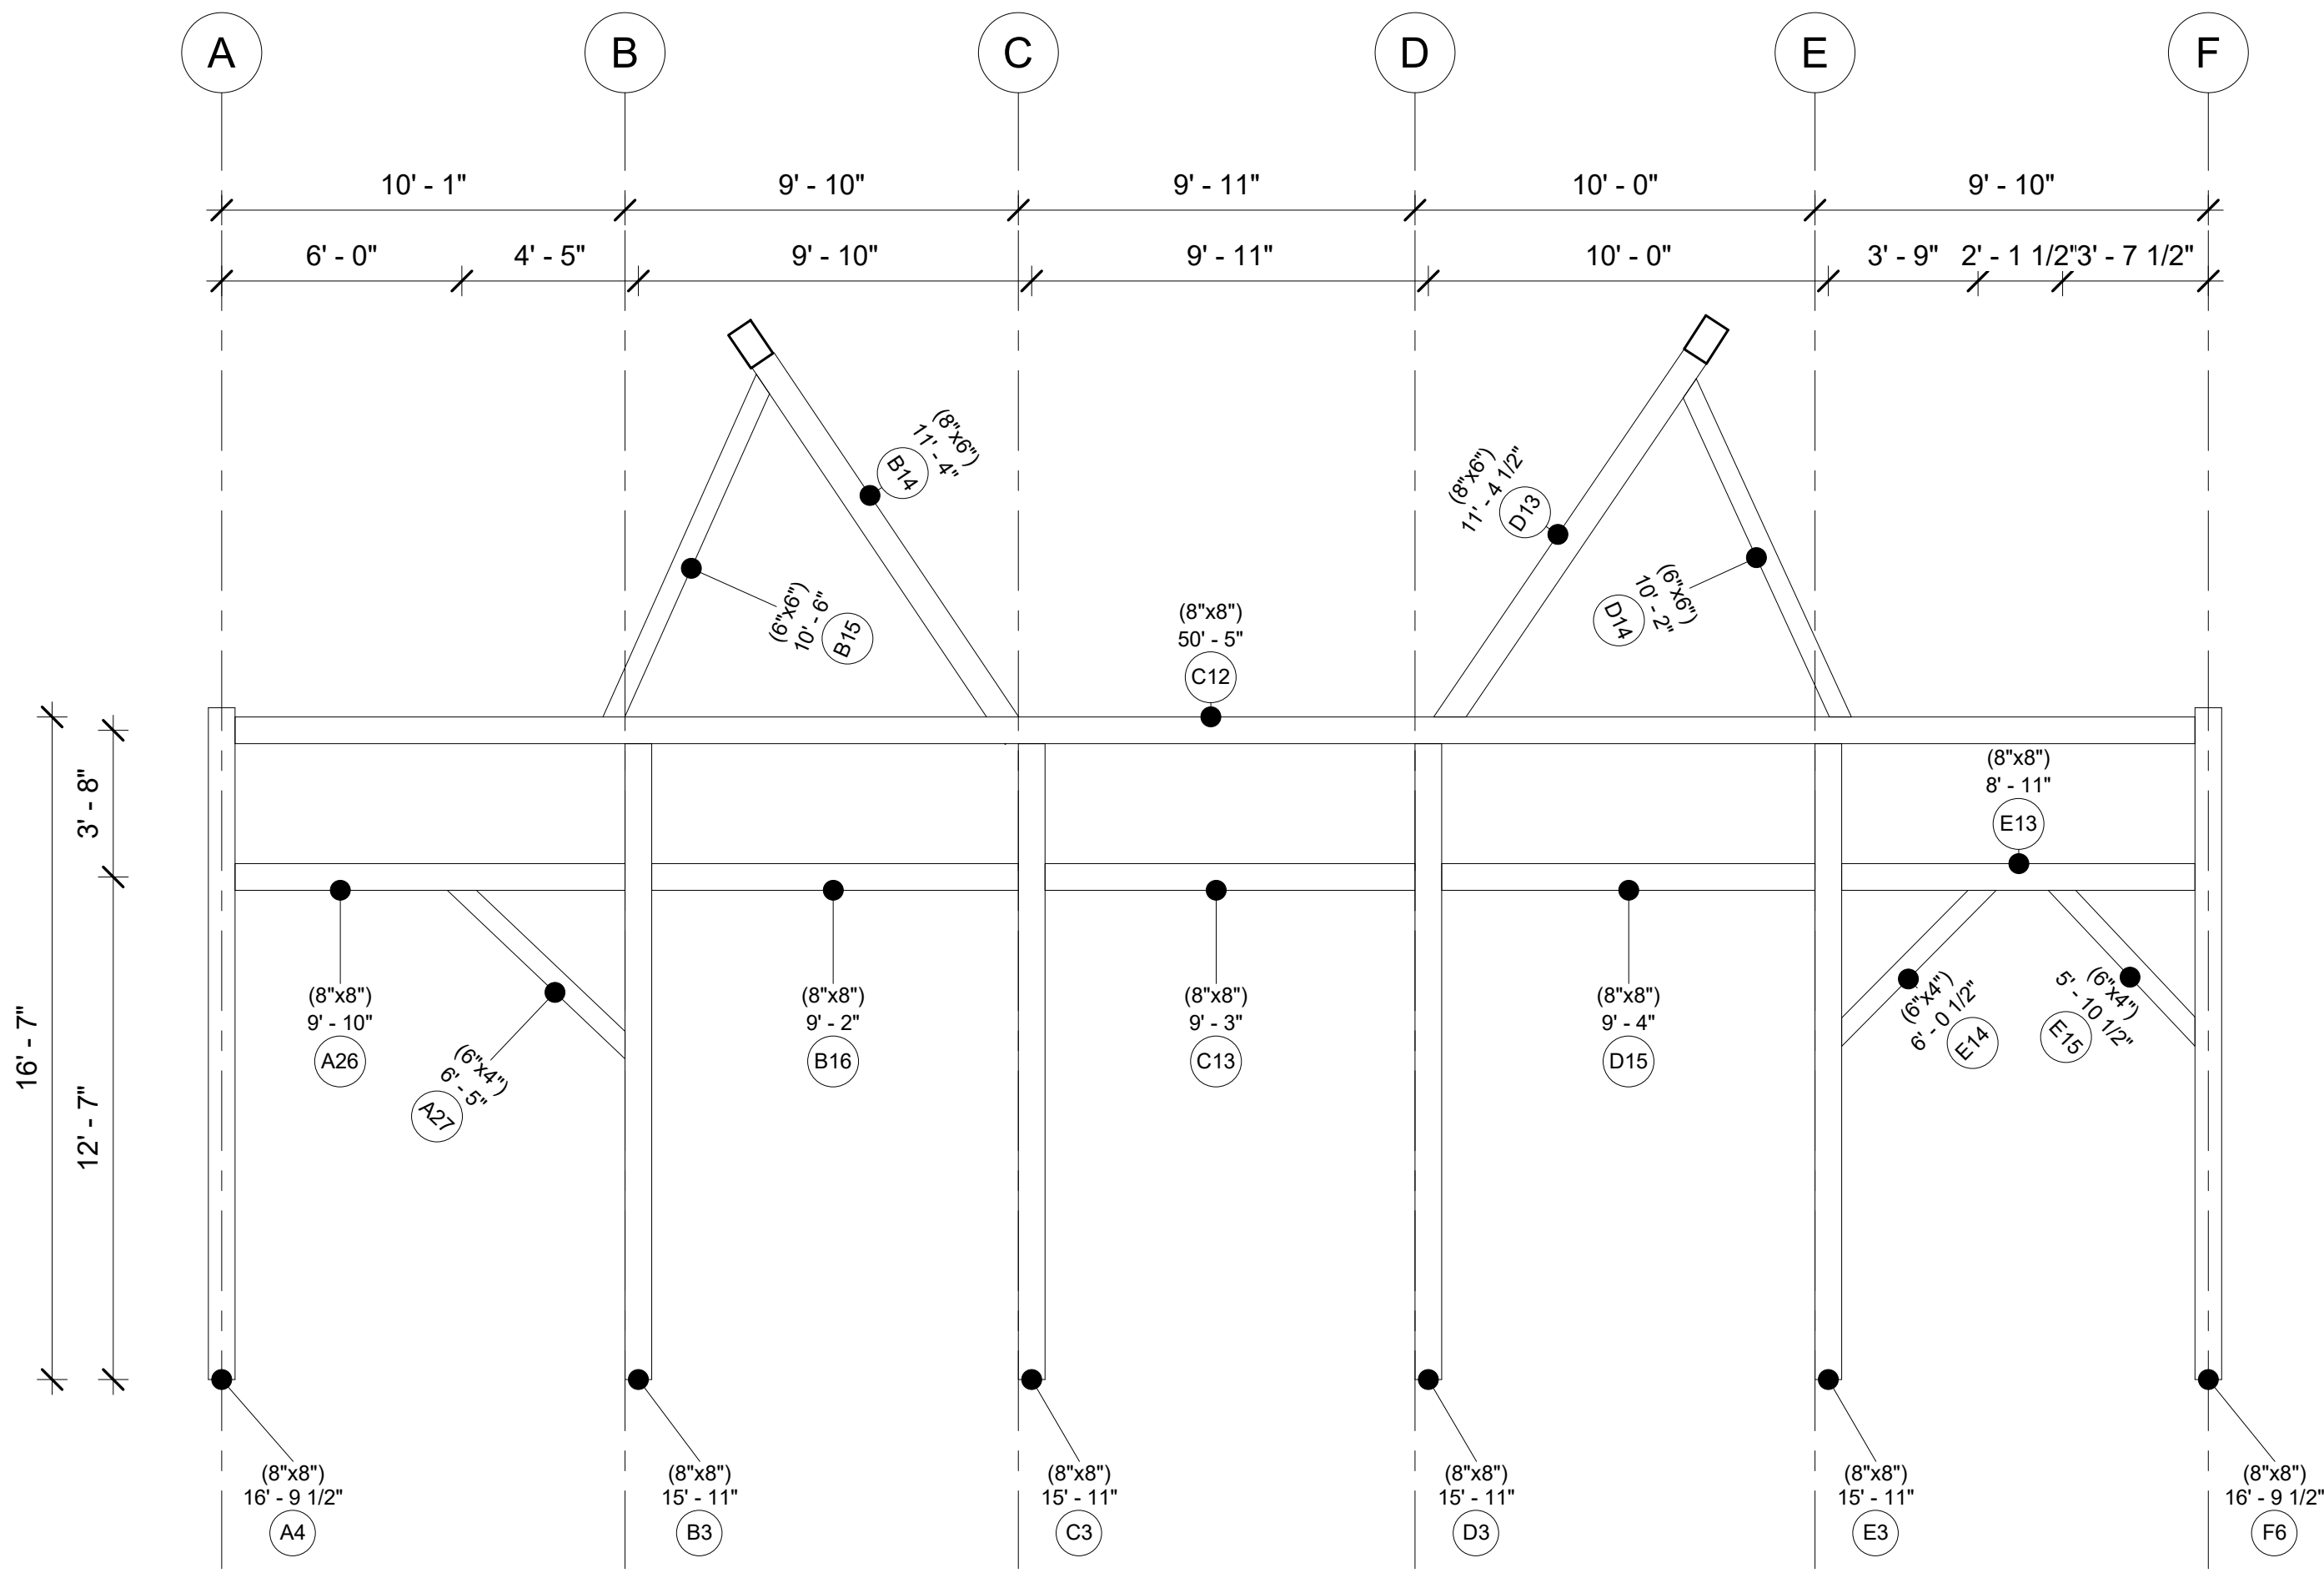

Piney Hollow

Bent 3


Project Number	Project 16
Date	20250605
Drawn By	
Checked By	
A107	
Scale	1/4" = 1'-0"

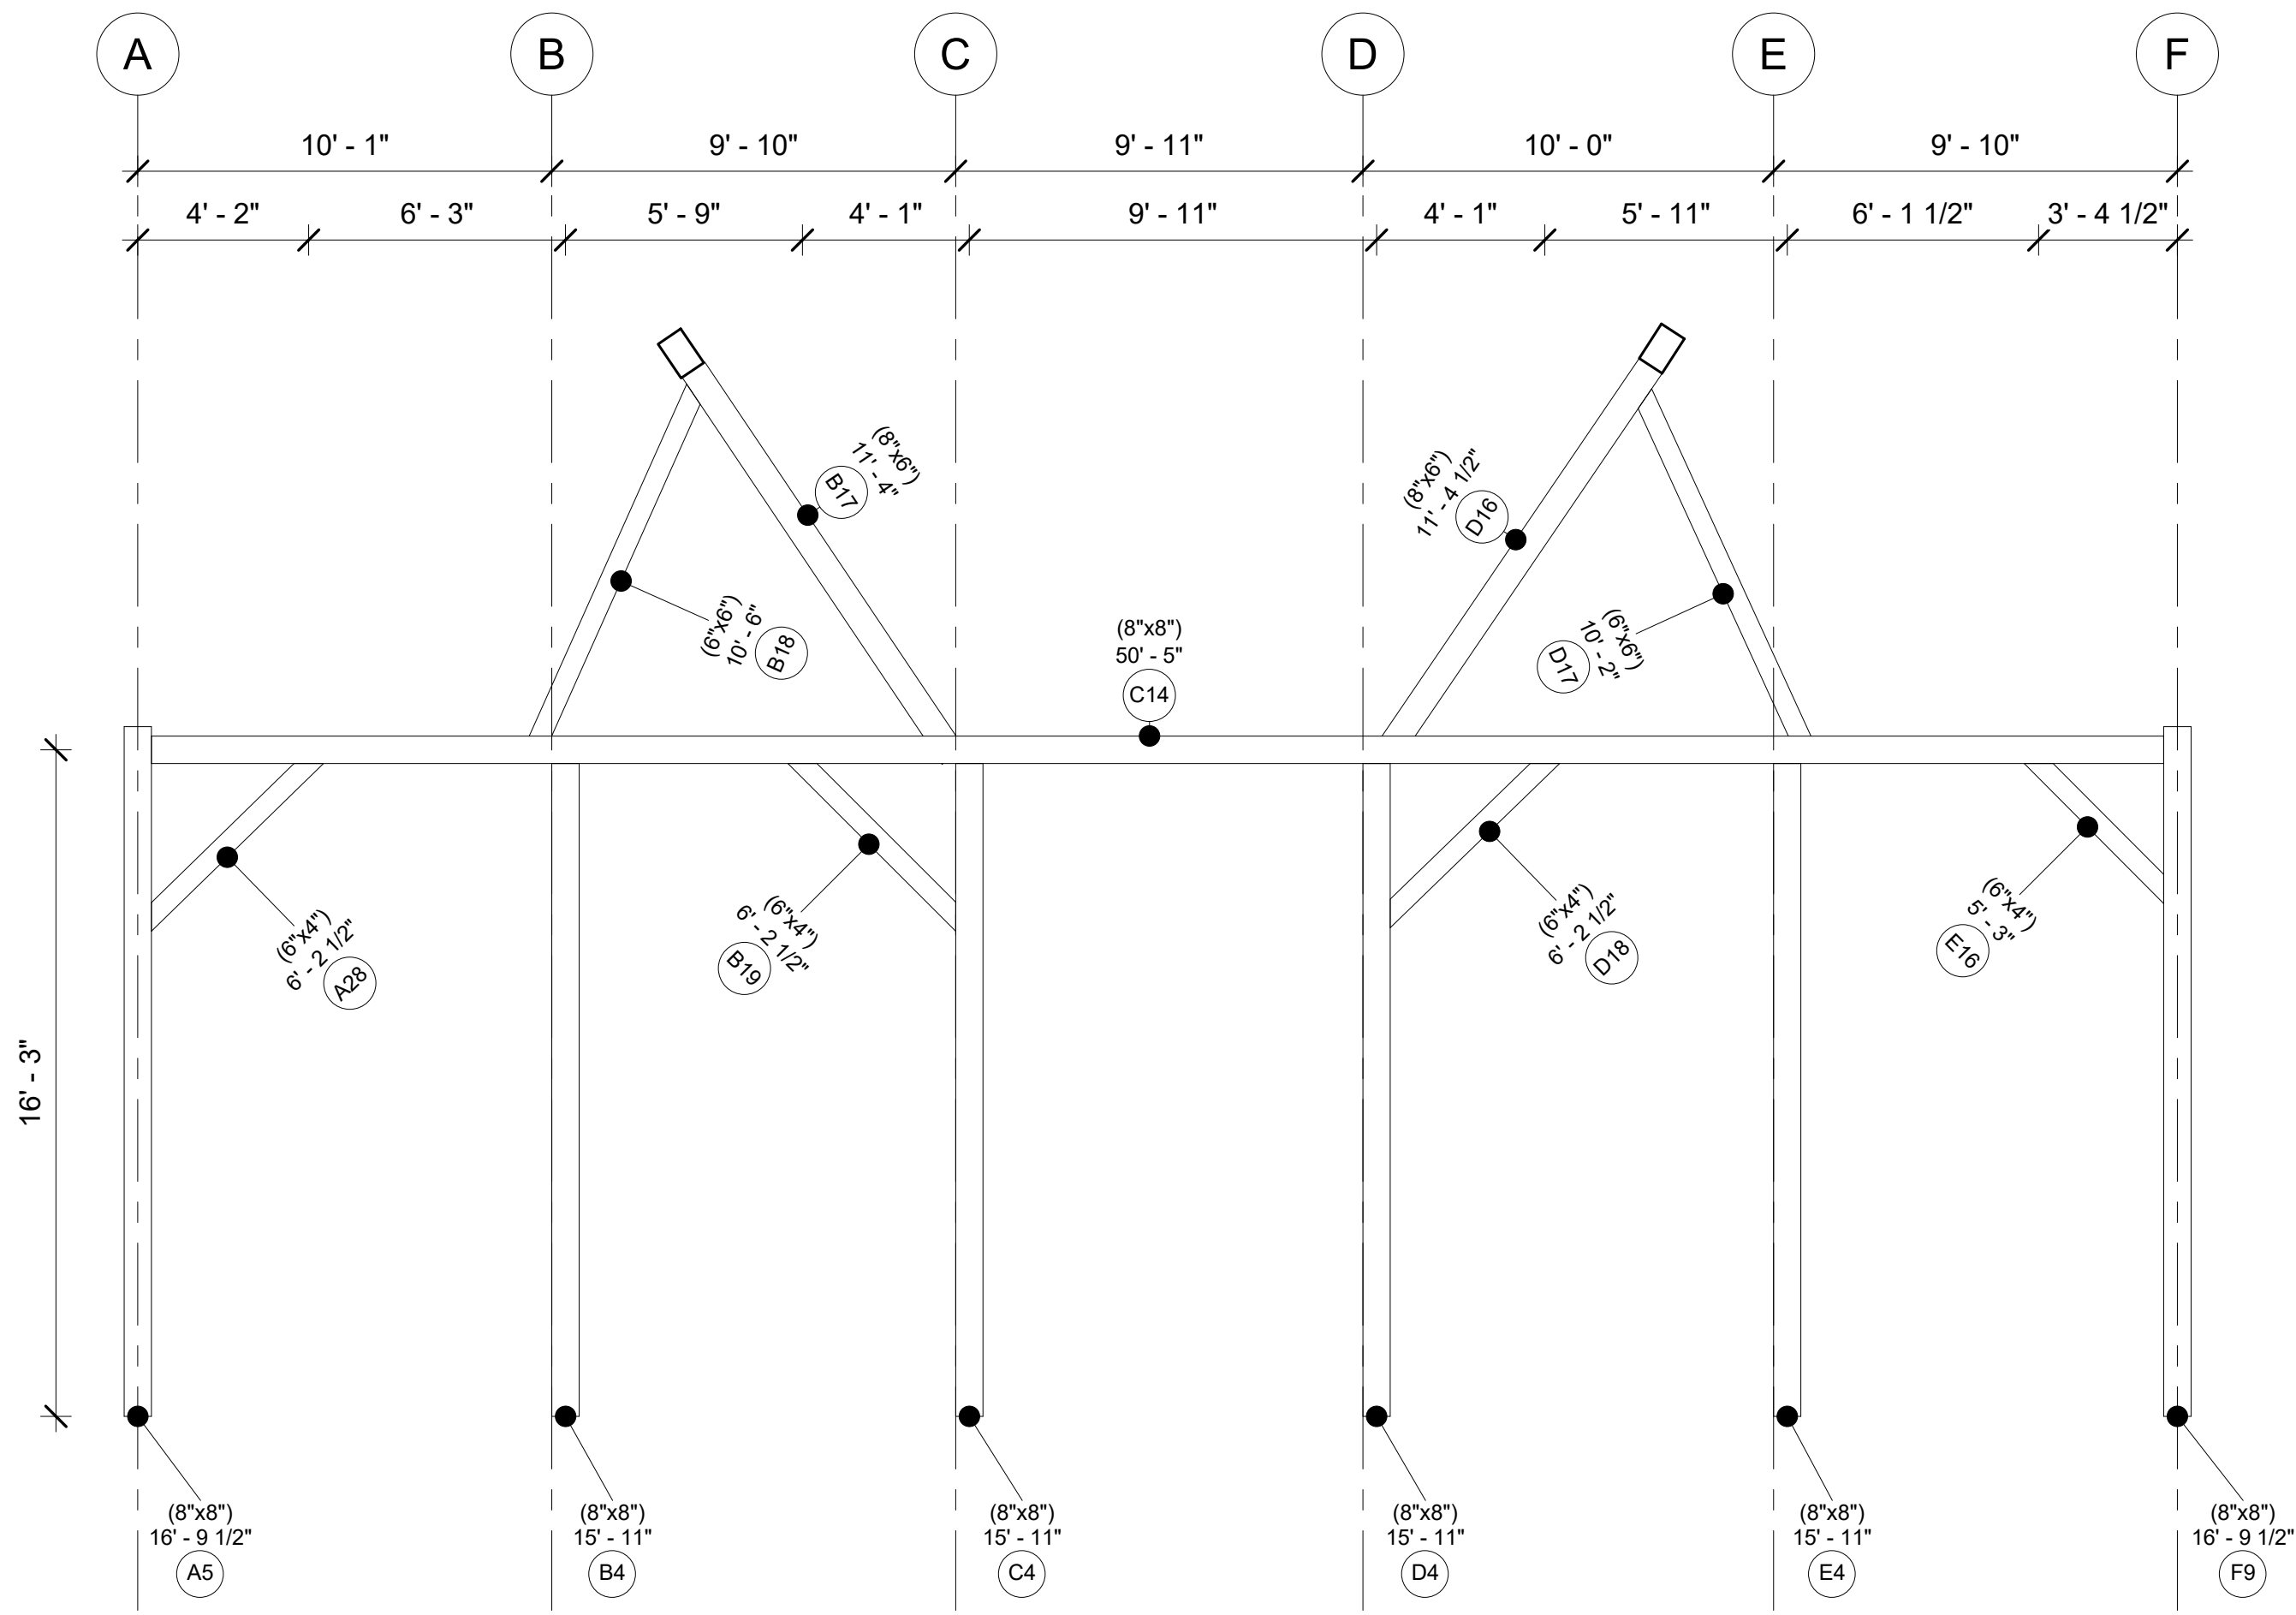

Piney Hollow

Bent 4

Project Number	Project 16
Date	20250605
Drawn By	
Checked By	
A108	
Scale	1/4" = 1'-0"

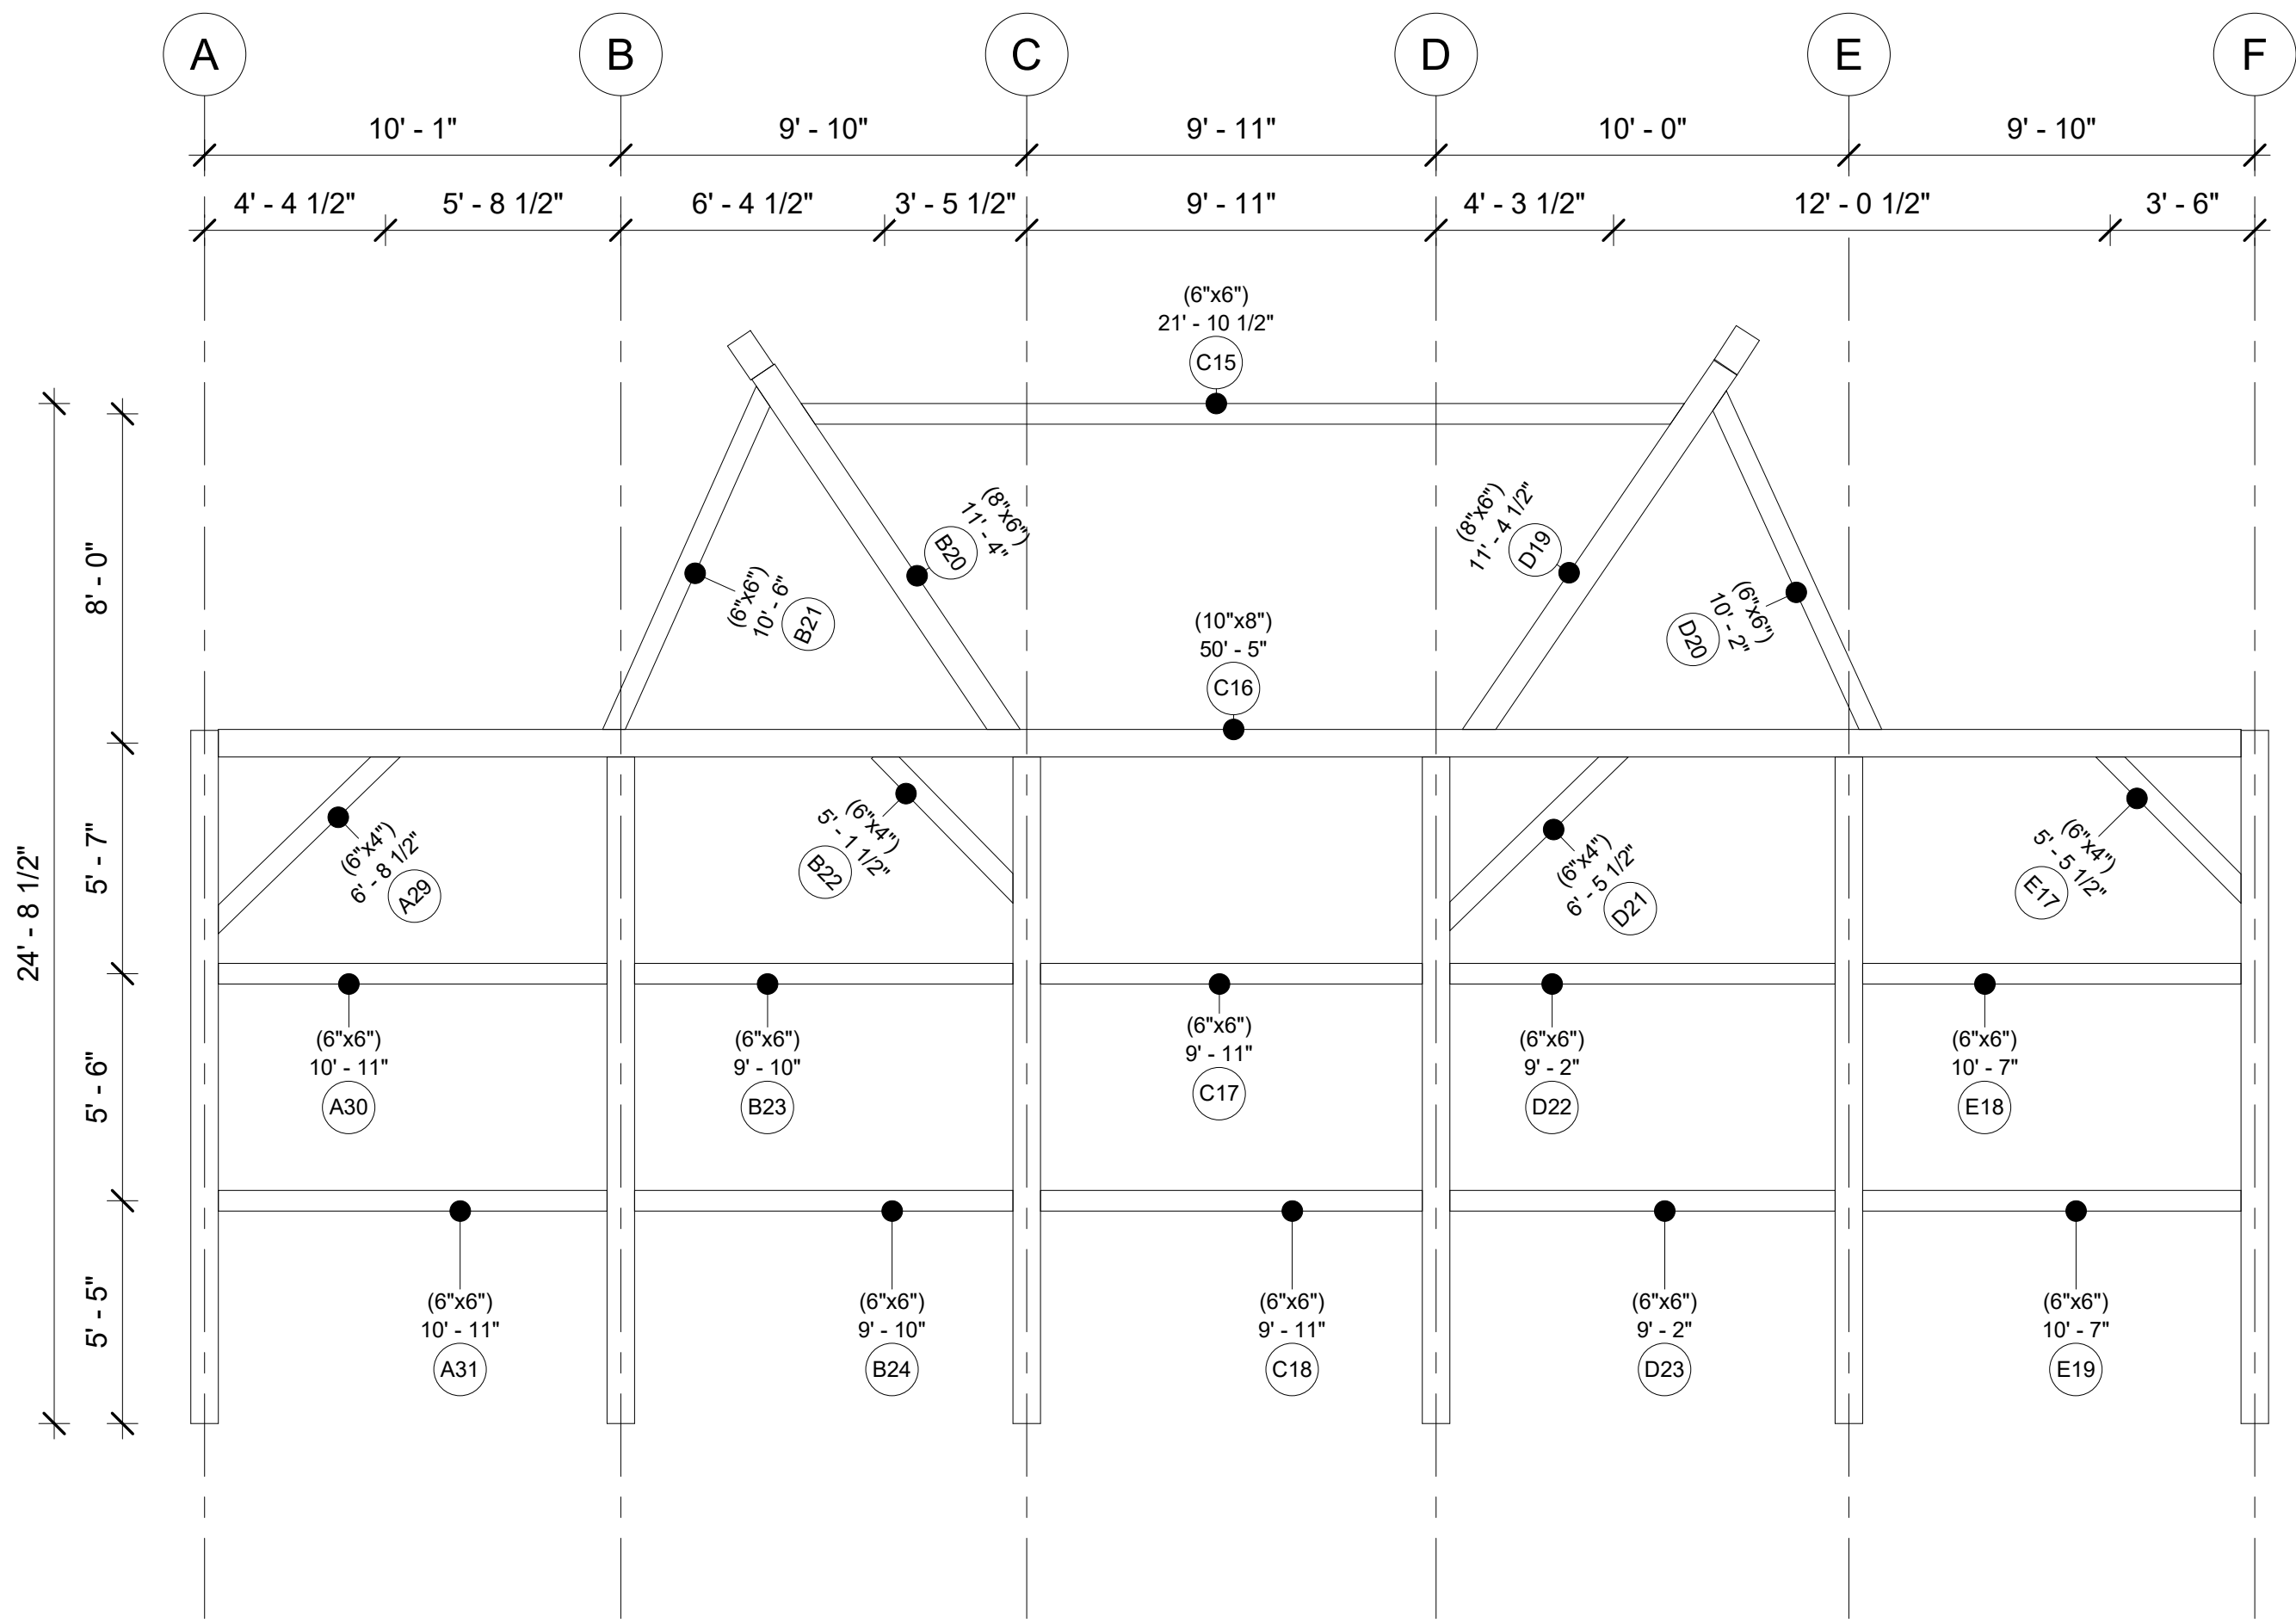

Piney Hollow

Bent 5

Project Number	Project 16
Date	20250605
Drawn By	
Checked By	
A109	
Scale	1/4" = 1'-0"