


PROJECT: Mossy Creek

SCOPE: AS BUILT DRAWINGS

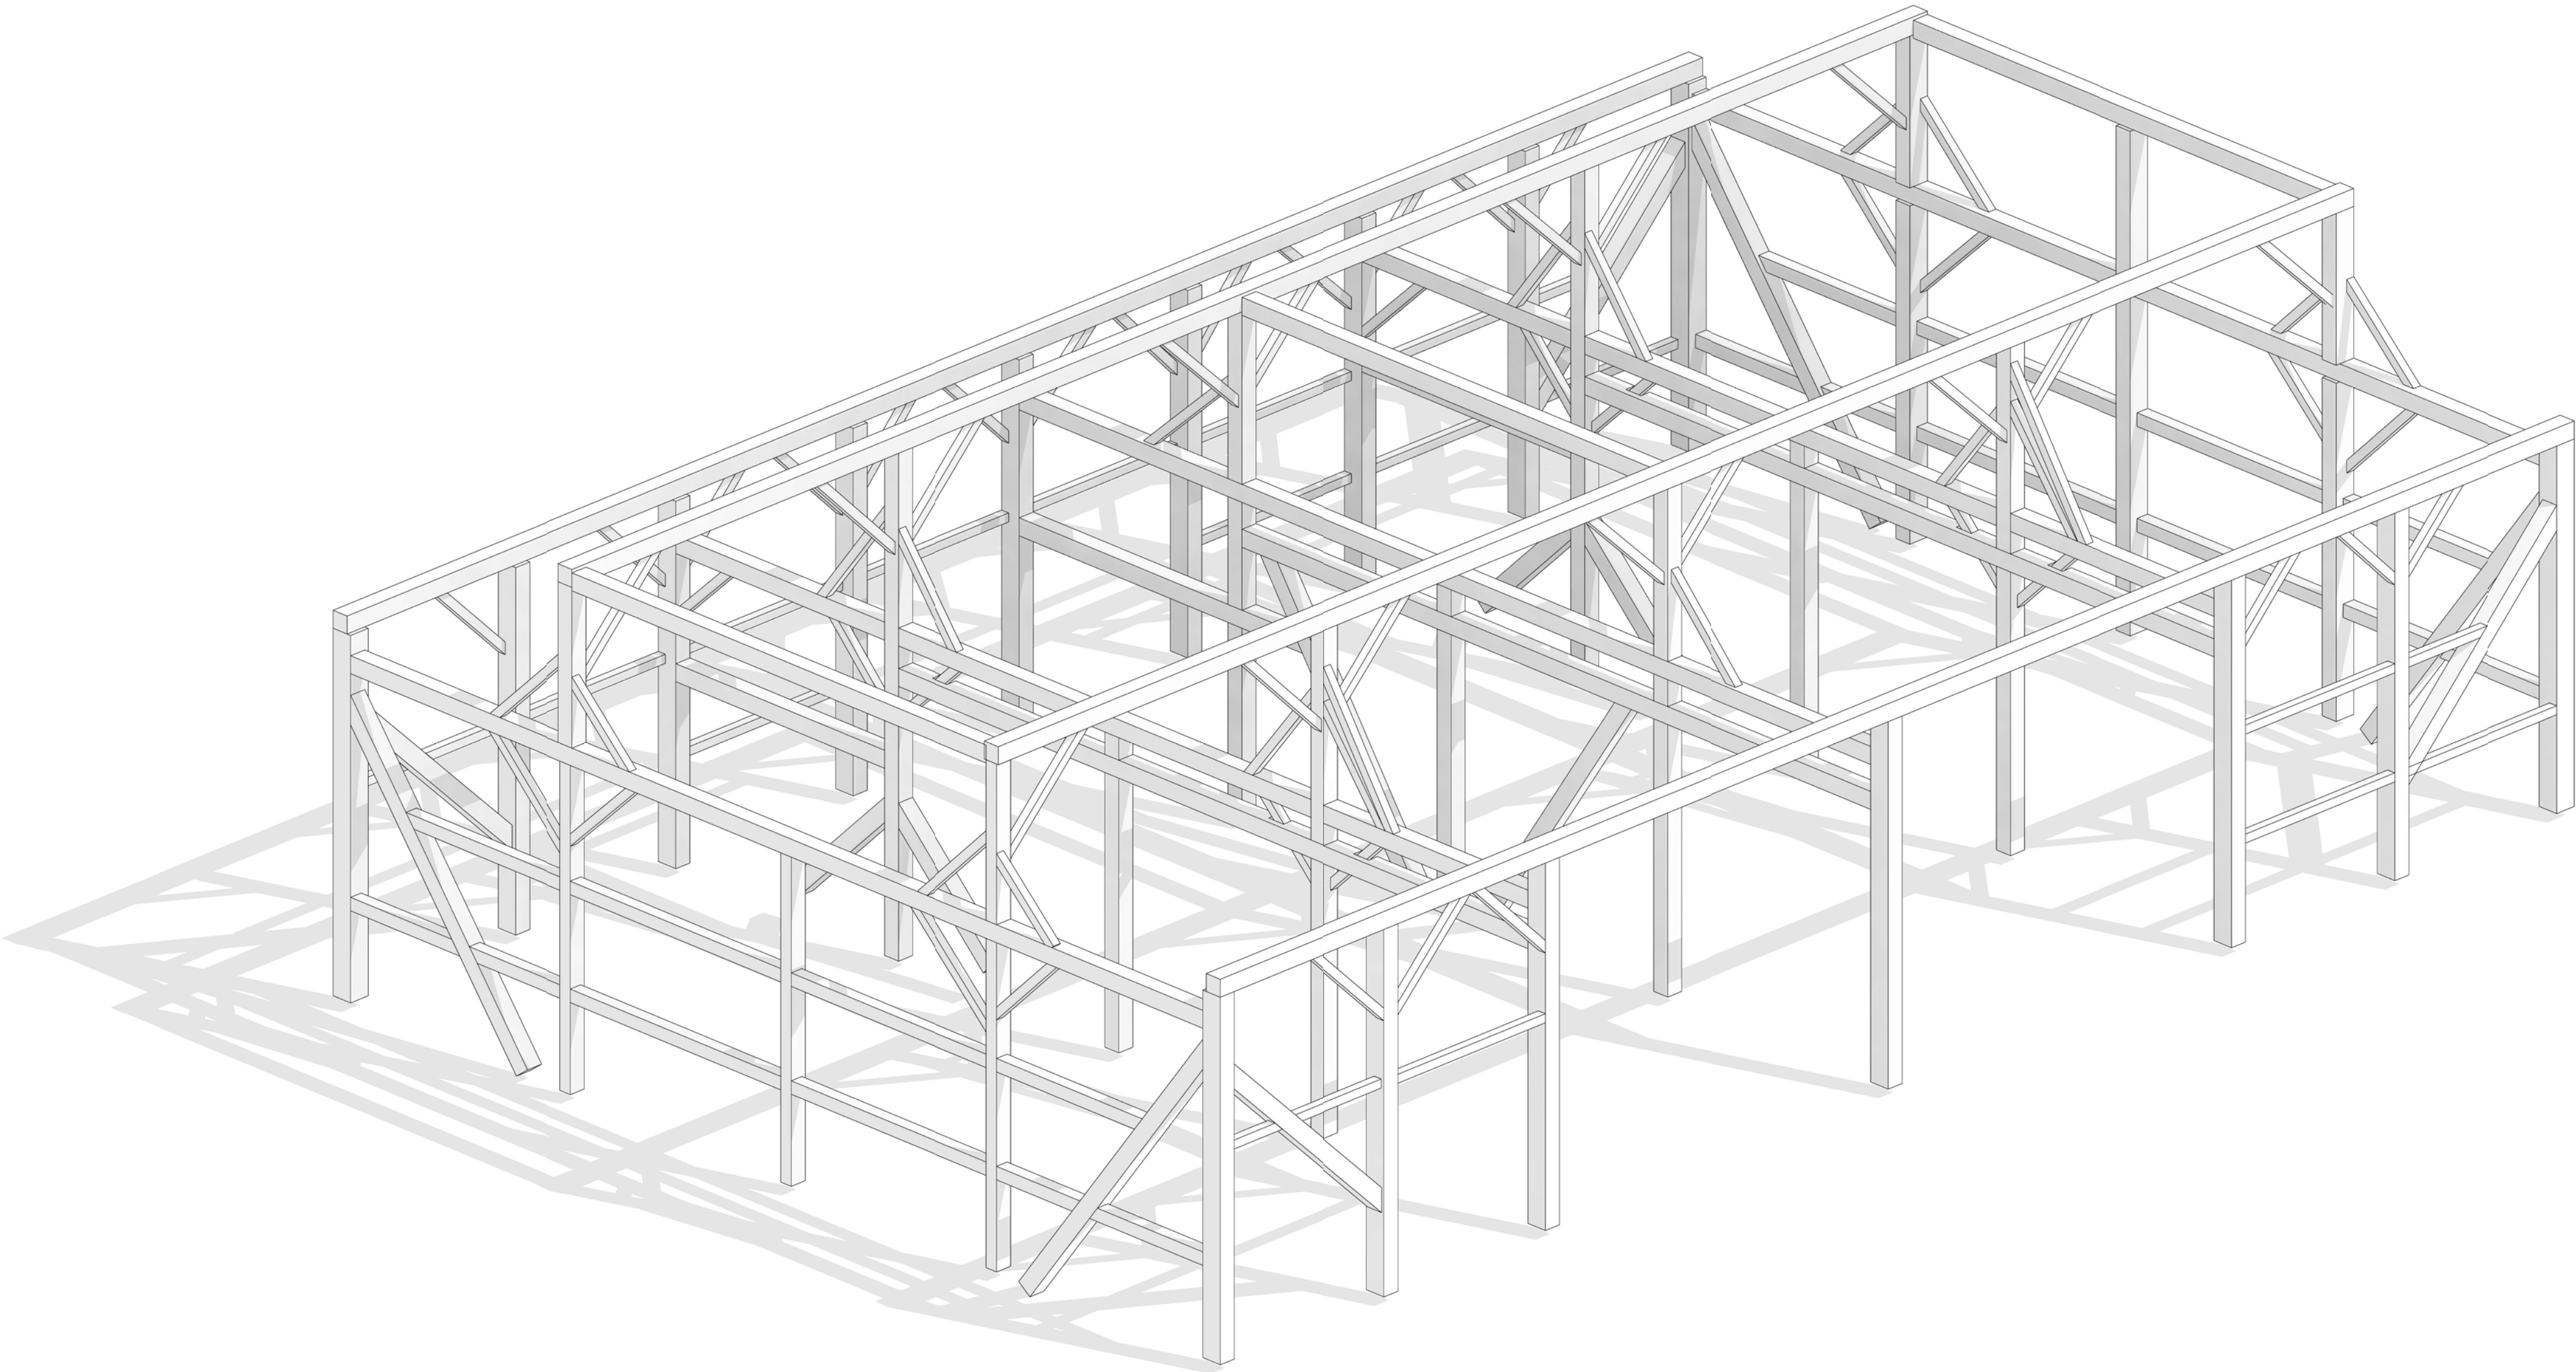

Mossy Creek


Cover Page


Project Number	Project 17
Date	20250618
Drawn By	
Checked By	
A101	
Scale	

Mossy Creek


Floor Plan

Project Number	Project 17
Date	20250618
Drawn By	
Checked By	
A102	
Scale	1/4" = 1'-0"

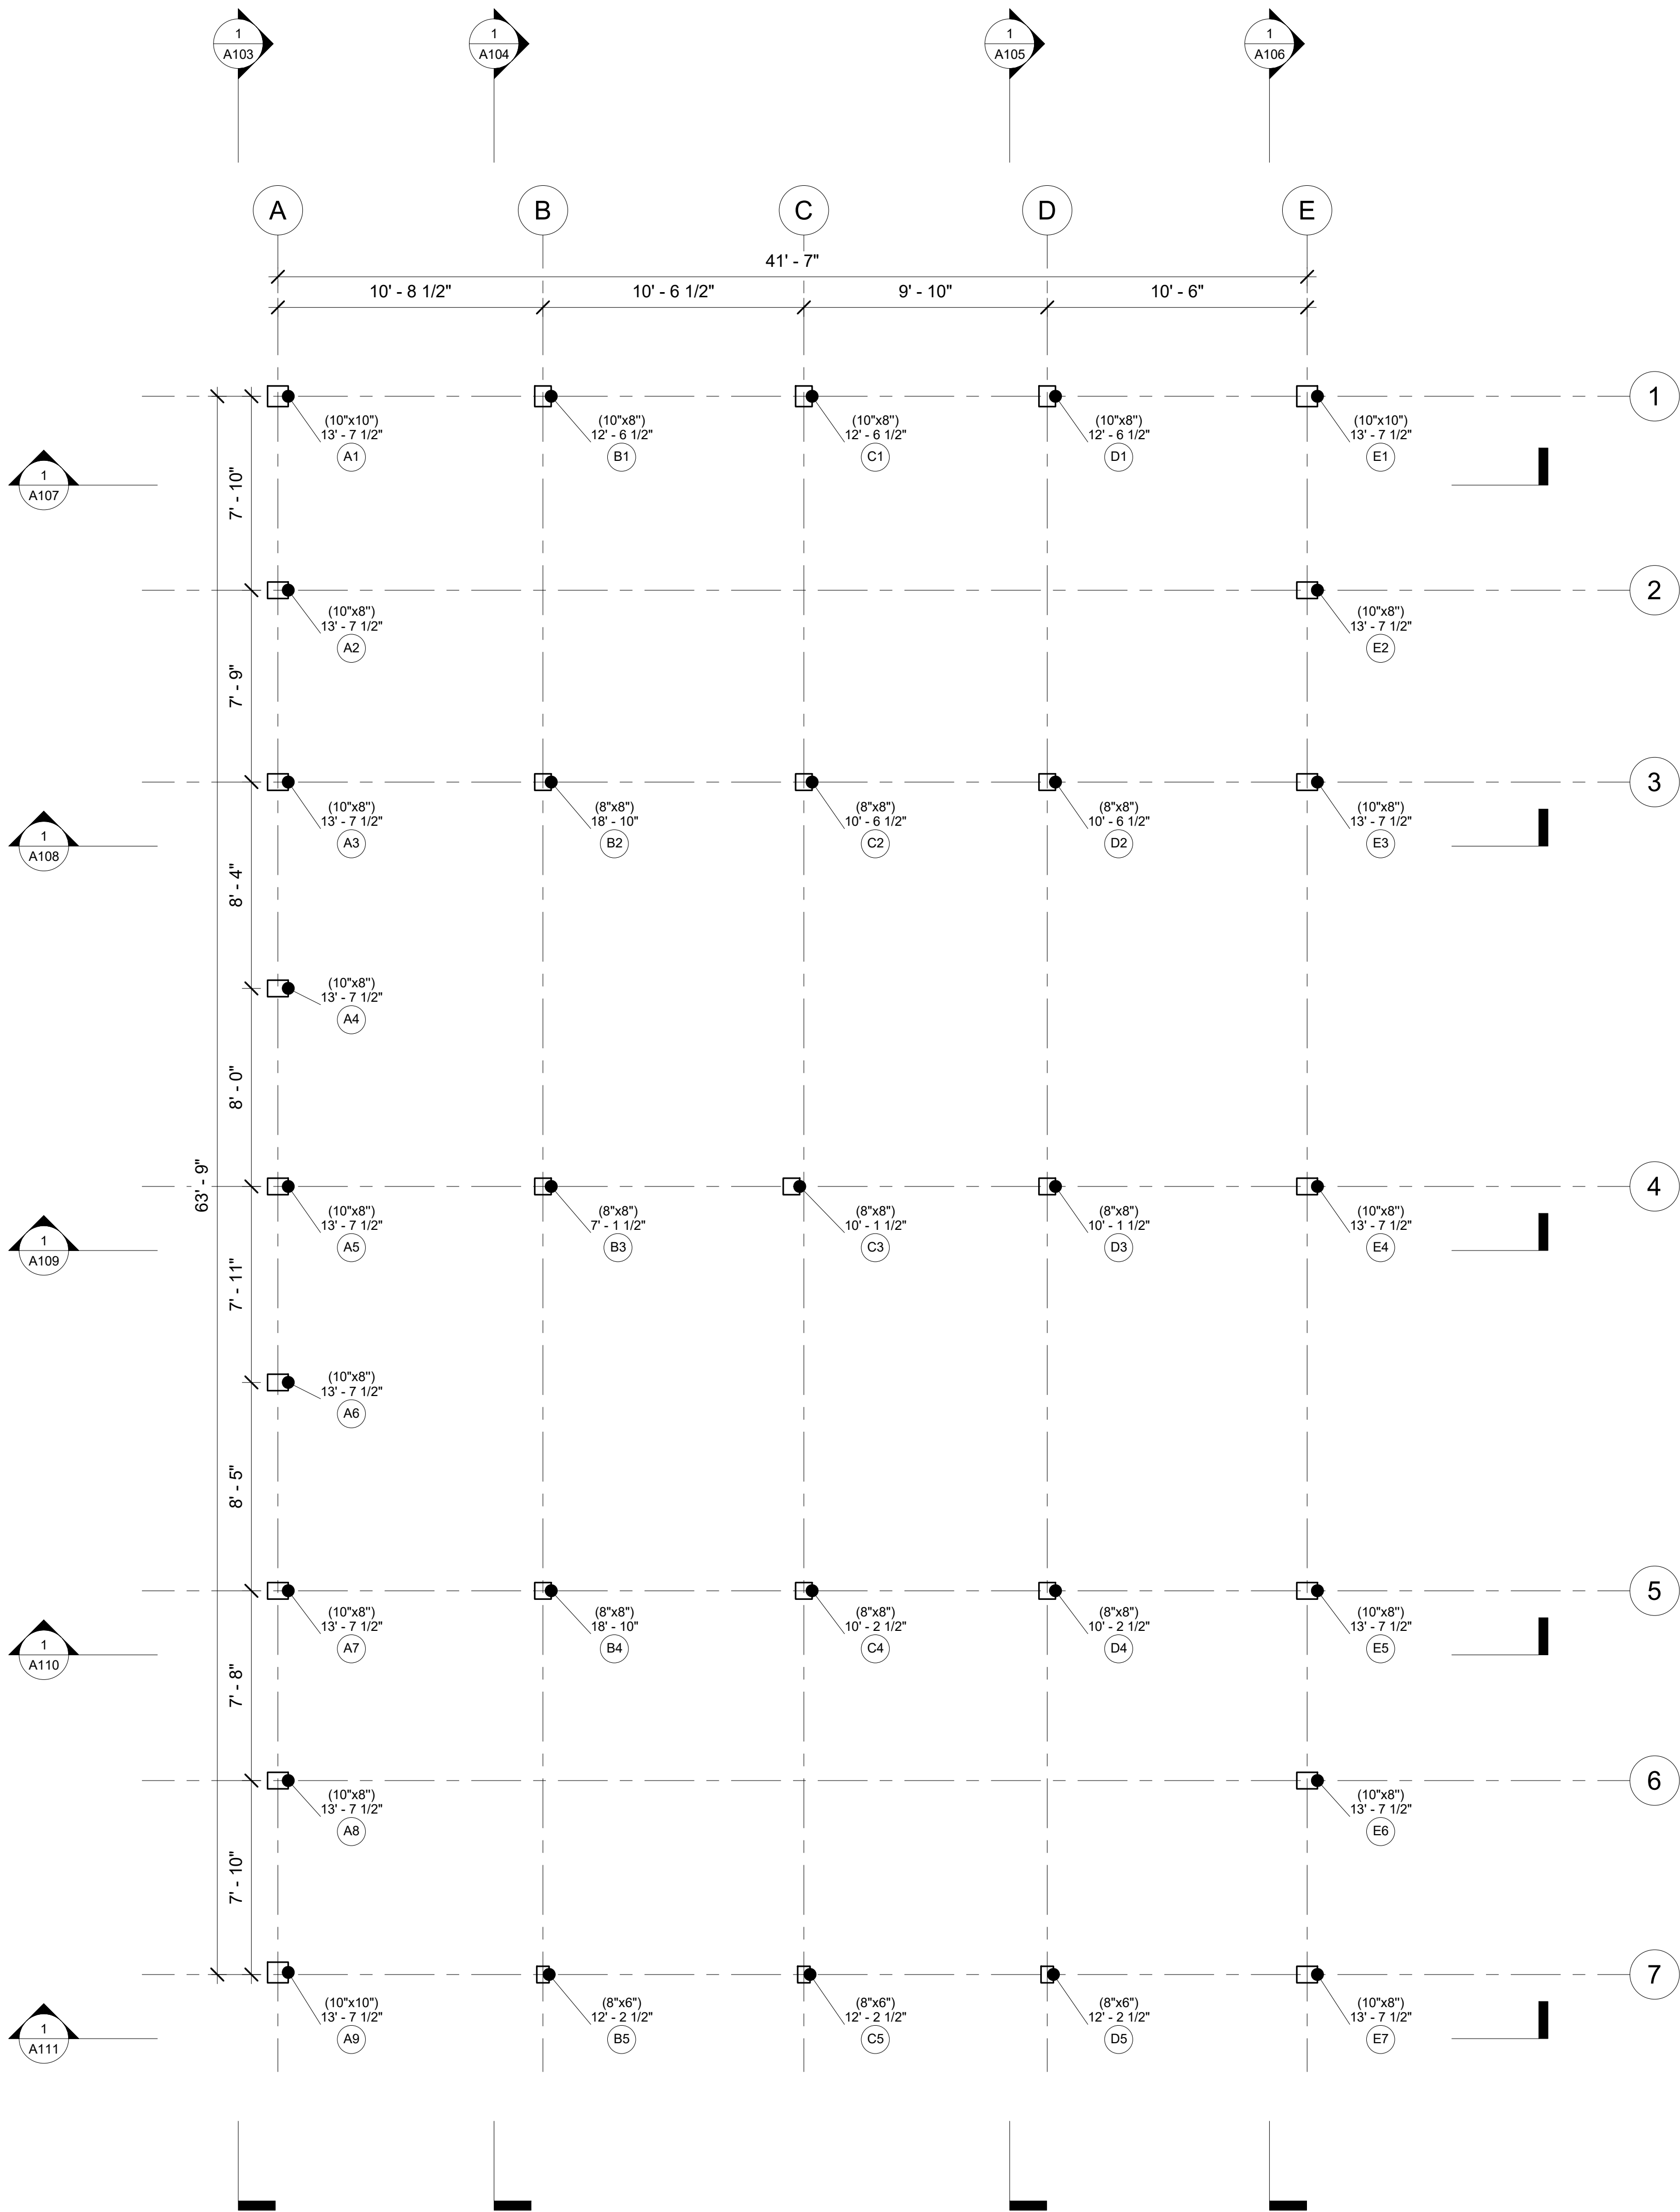

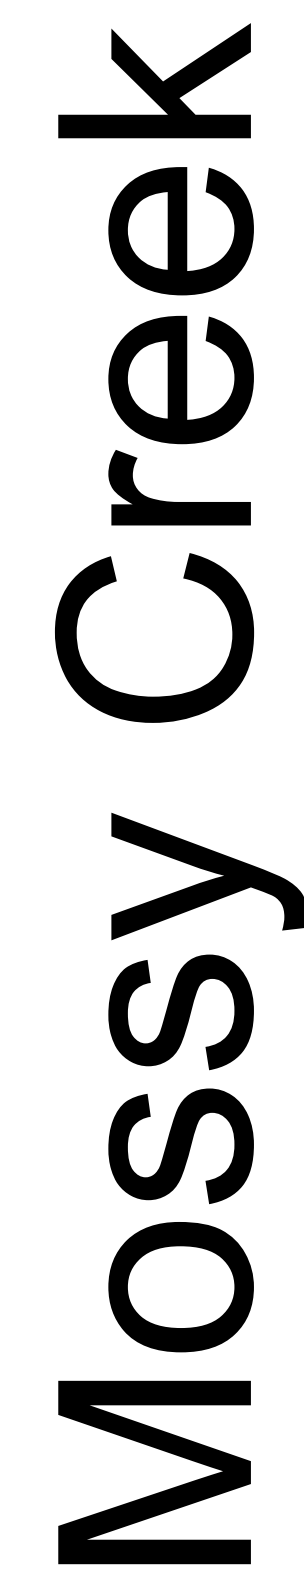


Project Number	Project 17
Date	20250618
Drawn By	
Checked By	
A103	
Scale	1/4" = 1'-0"

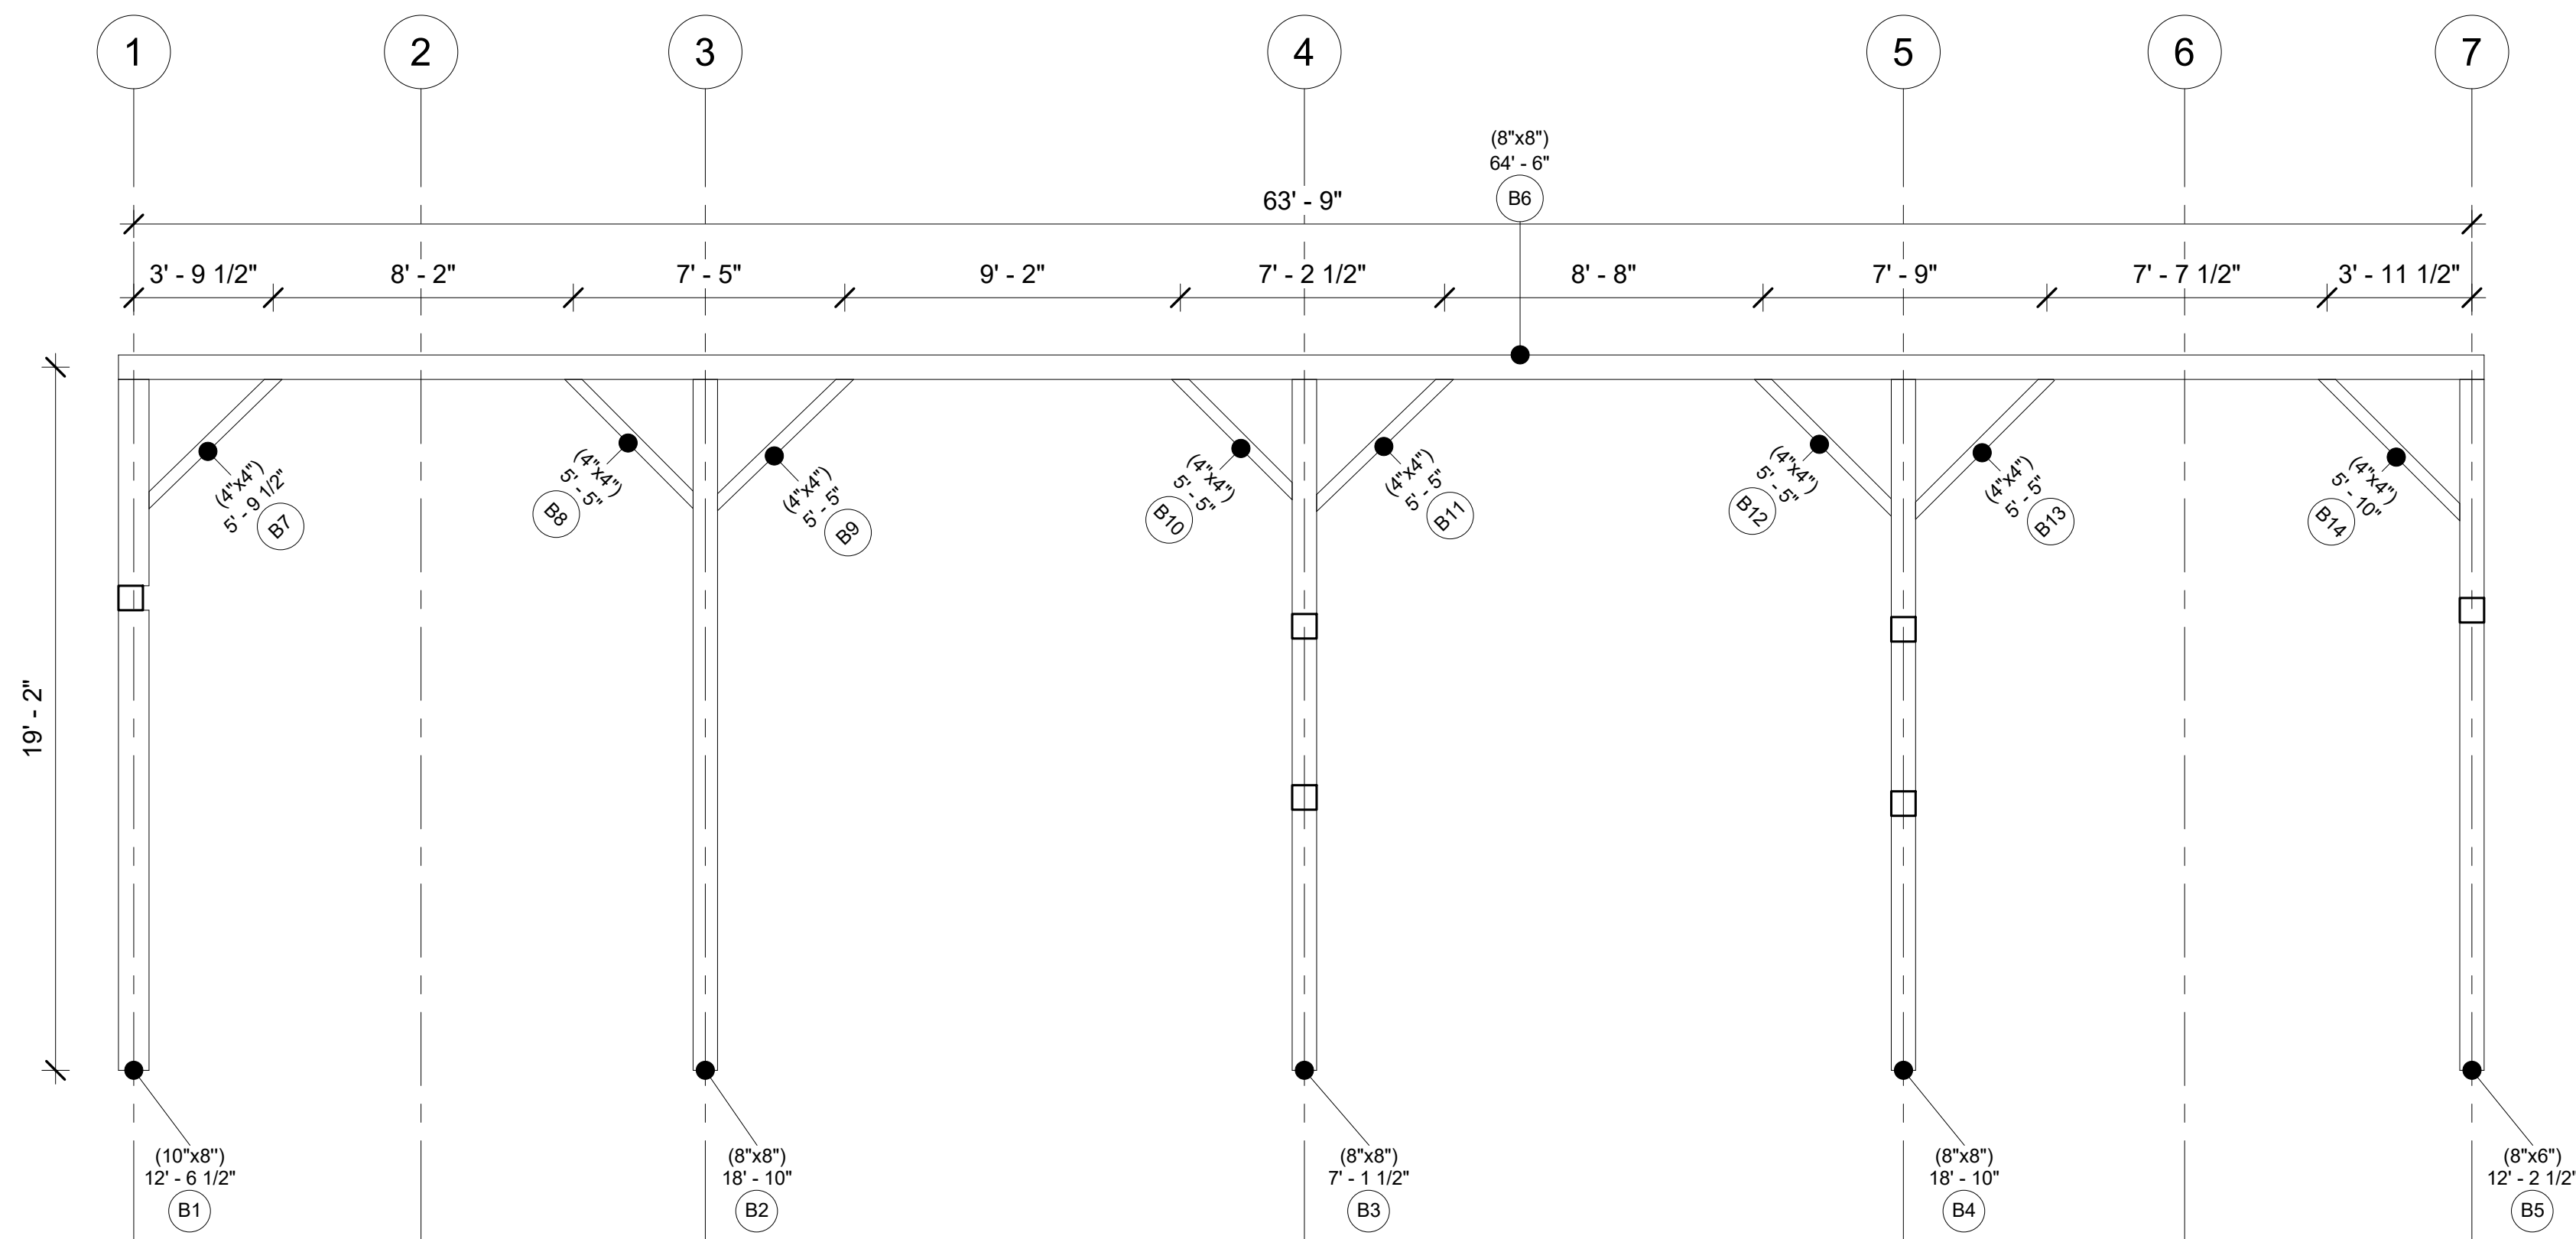

Mossy Creek

Bent B


Project Number	Project 17
Date	20250618
Drawn By	
Checked By	
A104	
Scale	1/4" = 1'-0"

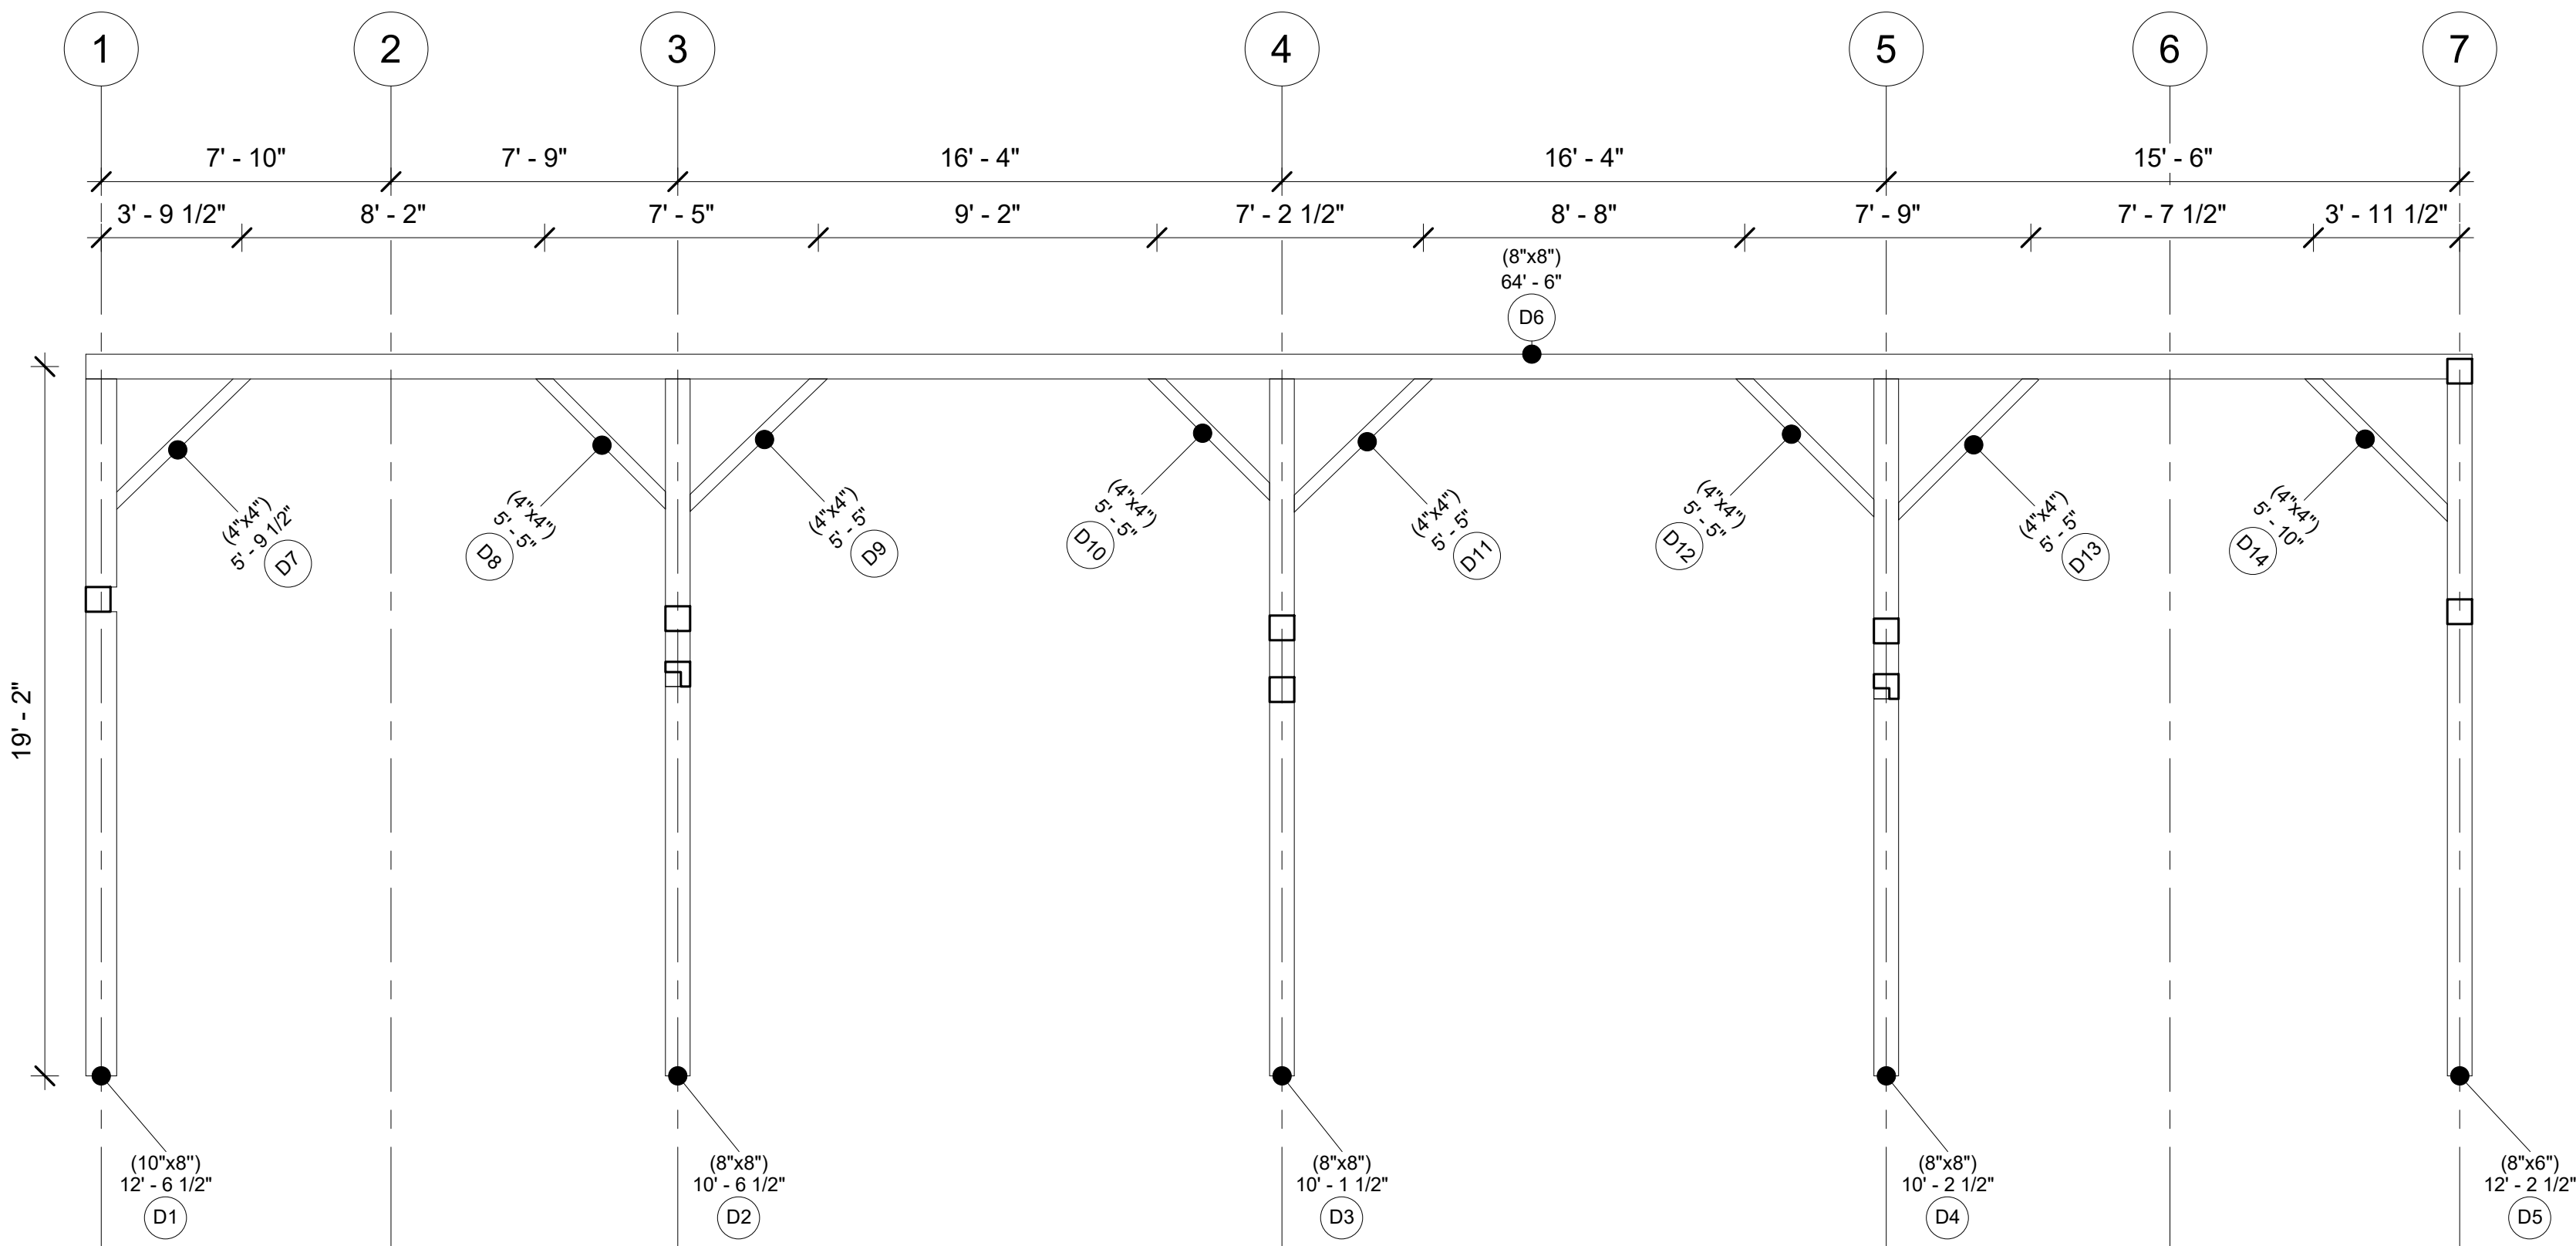

Mossy Creek

Bent D


Project Number	Project 17
Date	20250618
Drawn By	
Checked By	
A105	
Scale	1/4" = 1'-0"

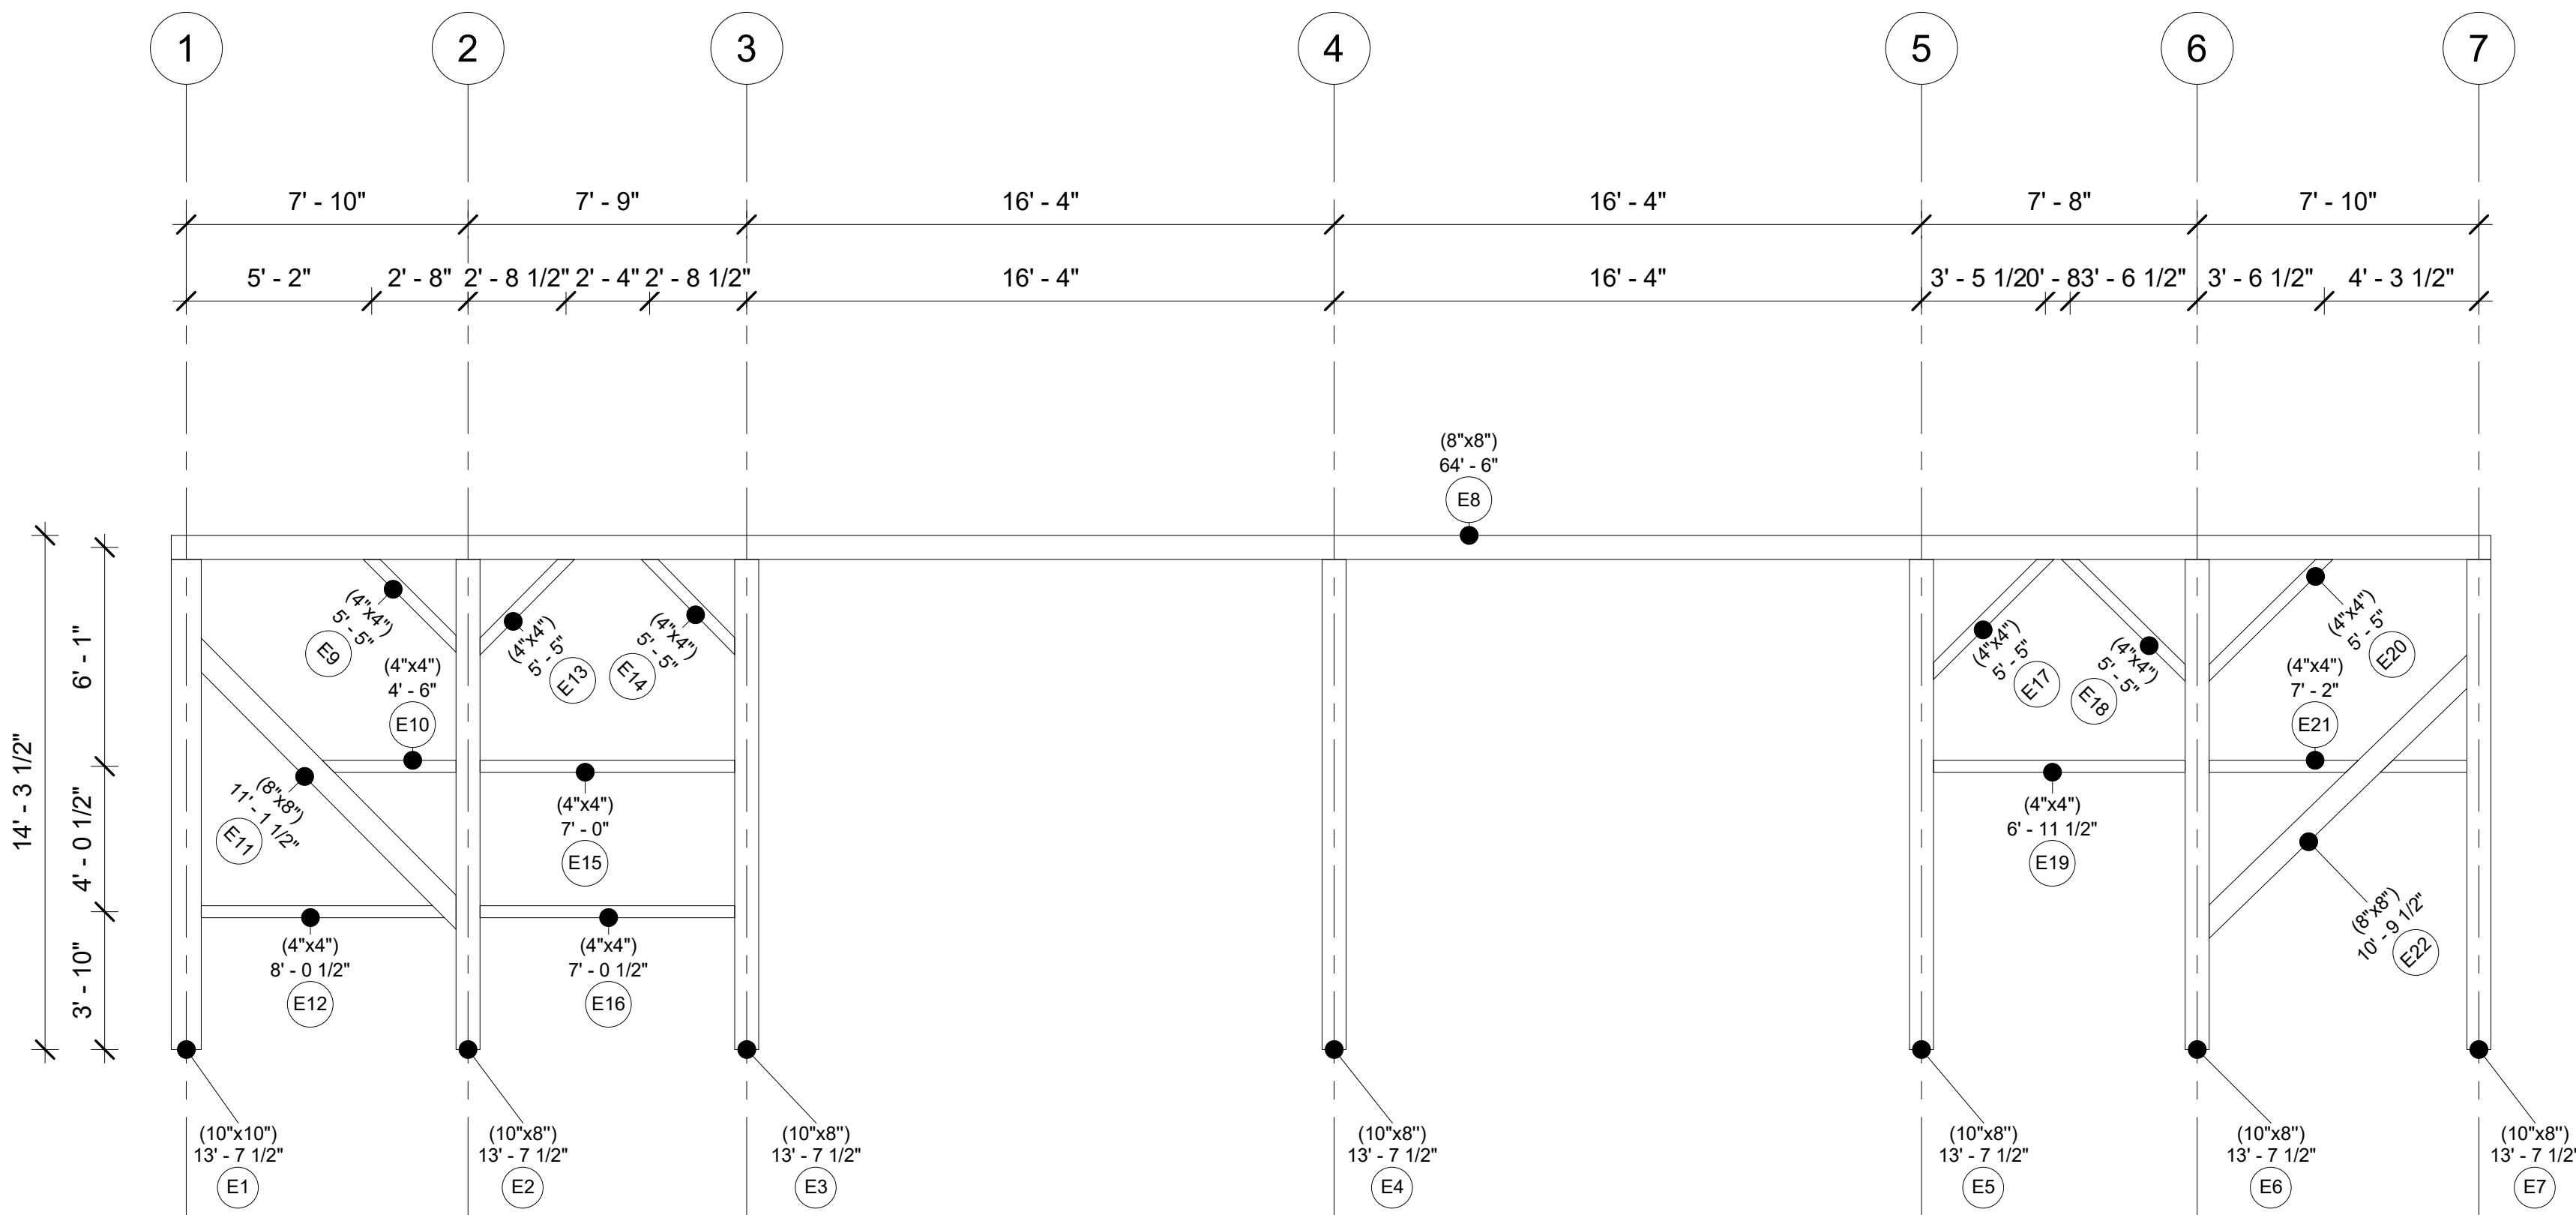

Mossy Creek

Bent E


Project Number	Project 17
Date	20250618
Drawn By	
Checked By	
A106	
Scale	1/4" = 1'-0"

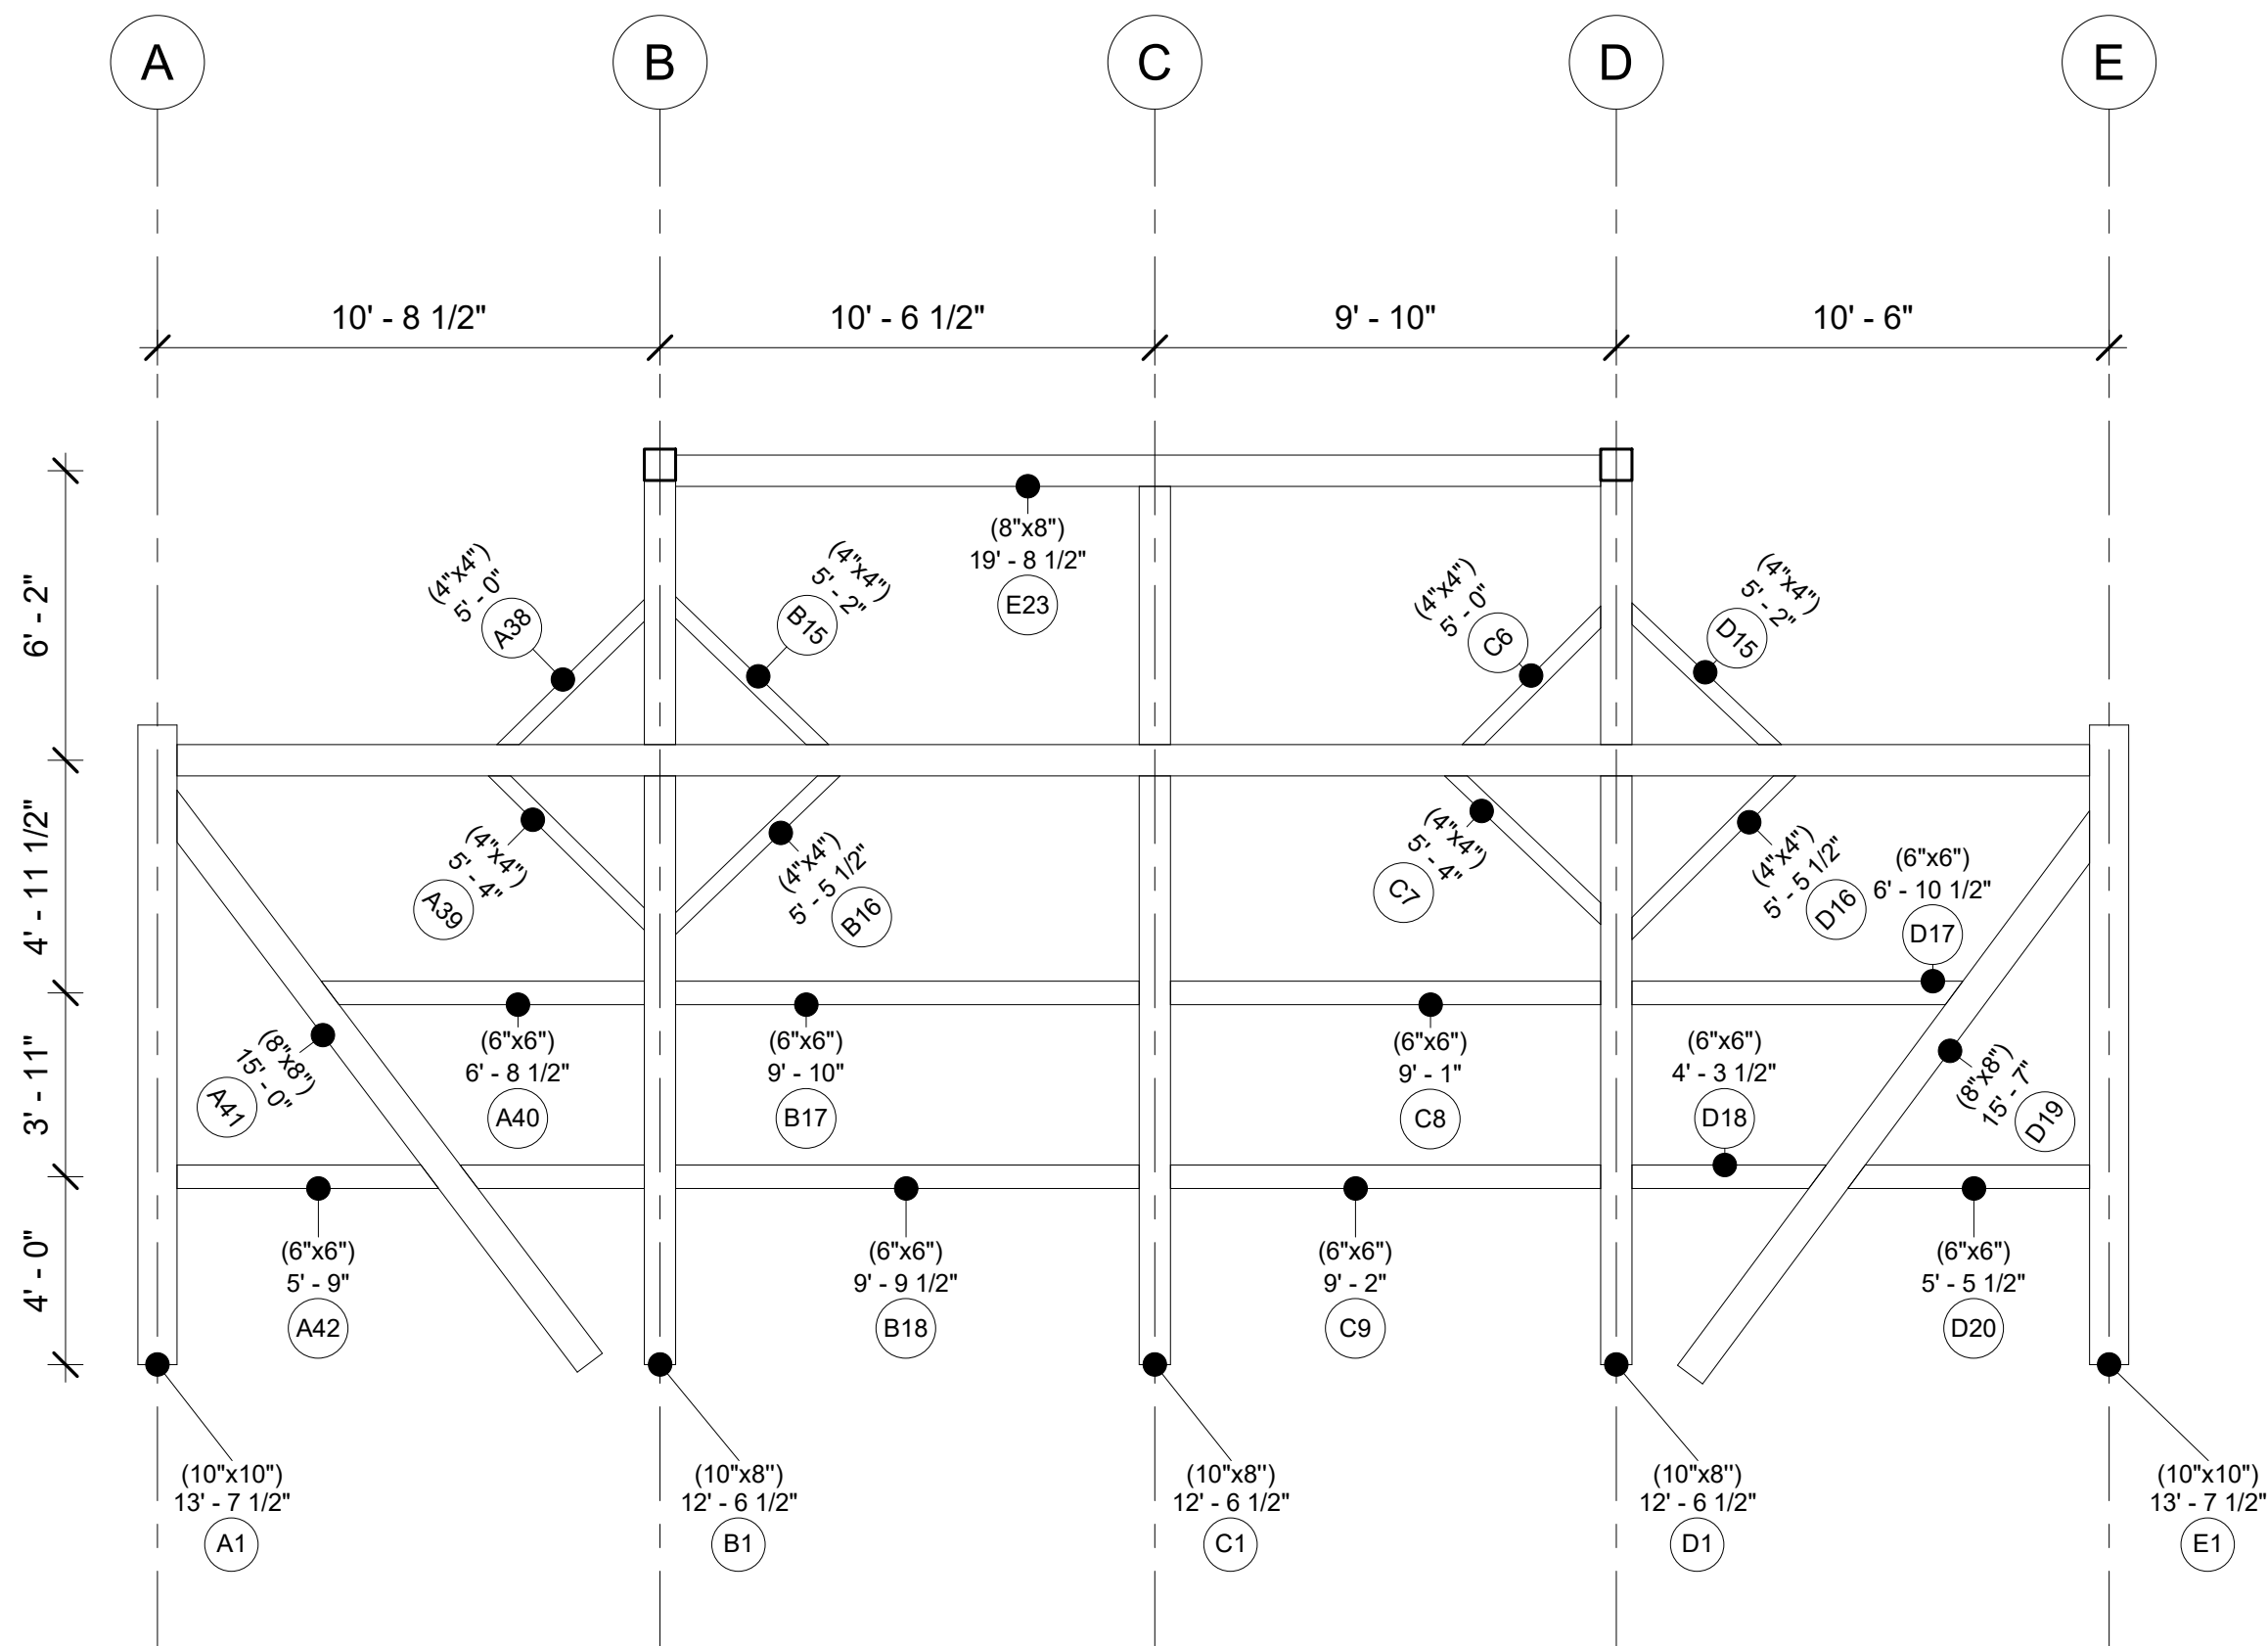


Mossy Creek

Bent 1

Project Number	Project 17
Date	20250618
Drawn By	
Checked By	
A107	
Scale	1/4" = 1'-0"

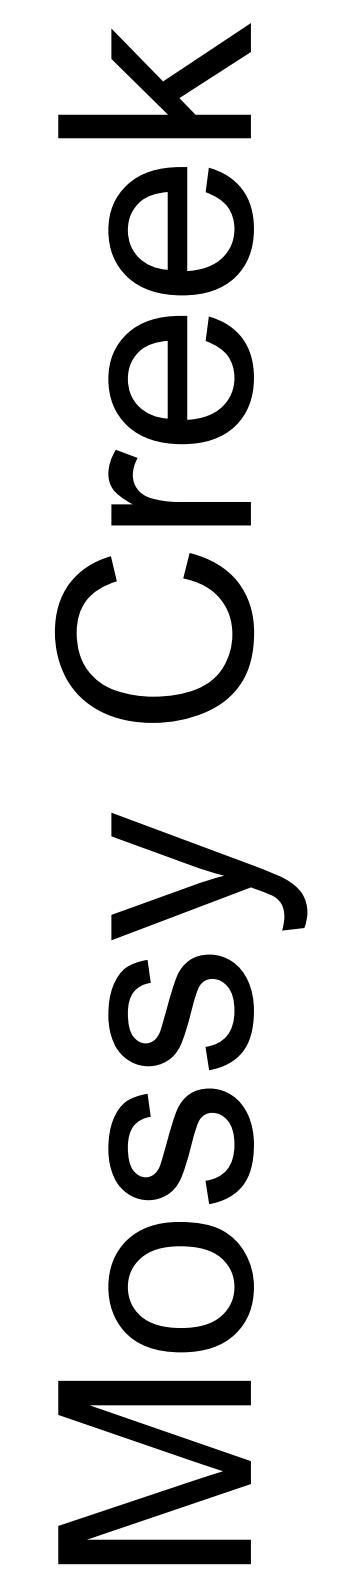


Project Number	Project 17
Date	20250618
Drawn By	
Checked By	
A108	
Scale	1/4" = 1'-0"

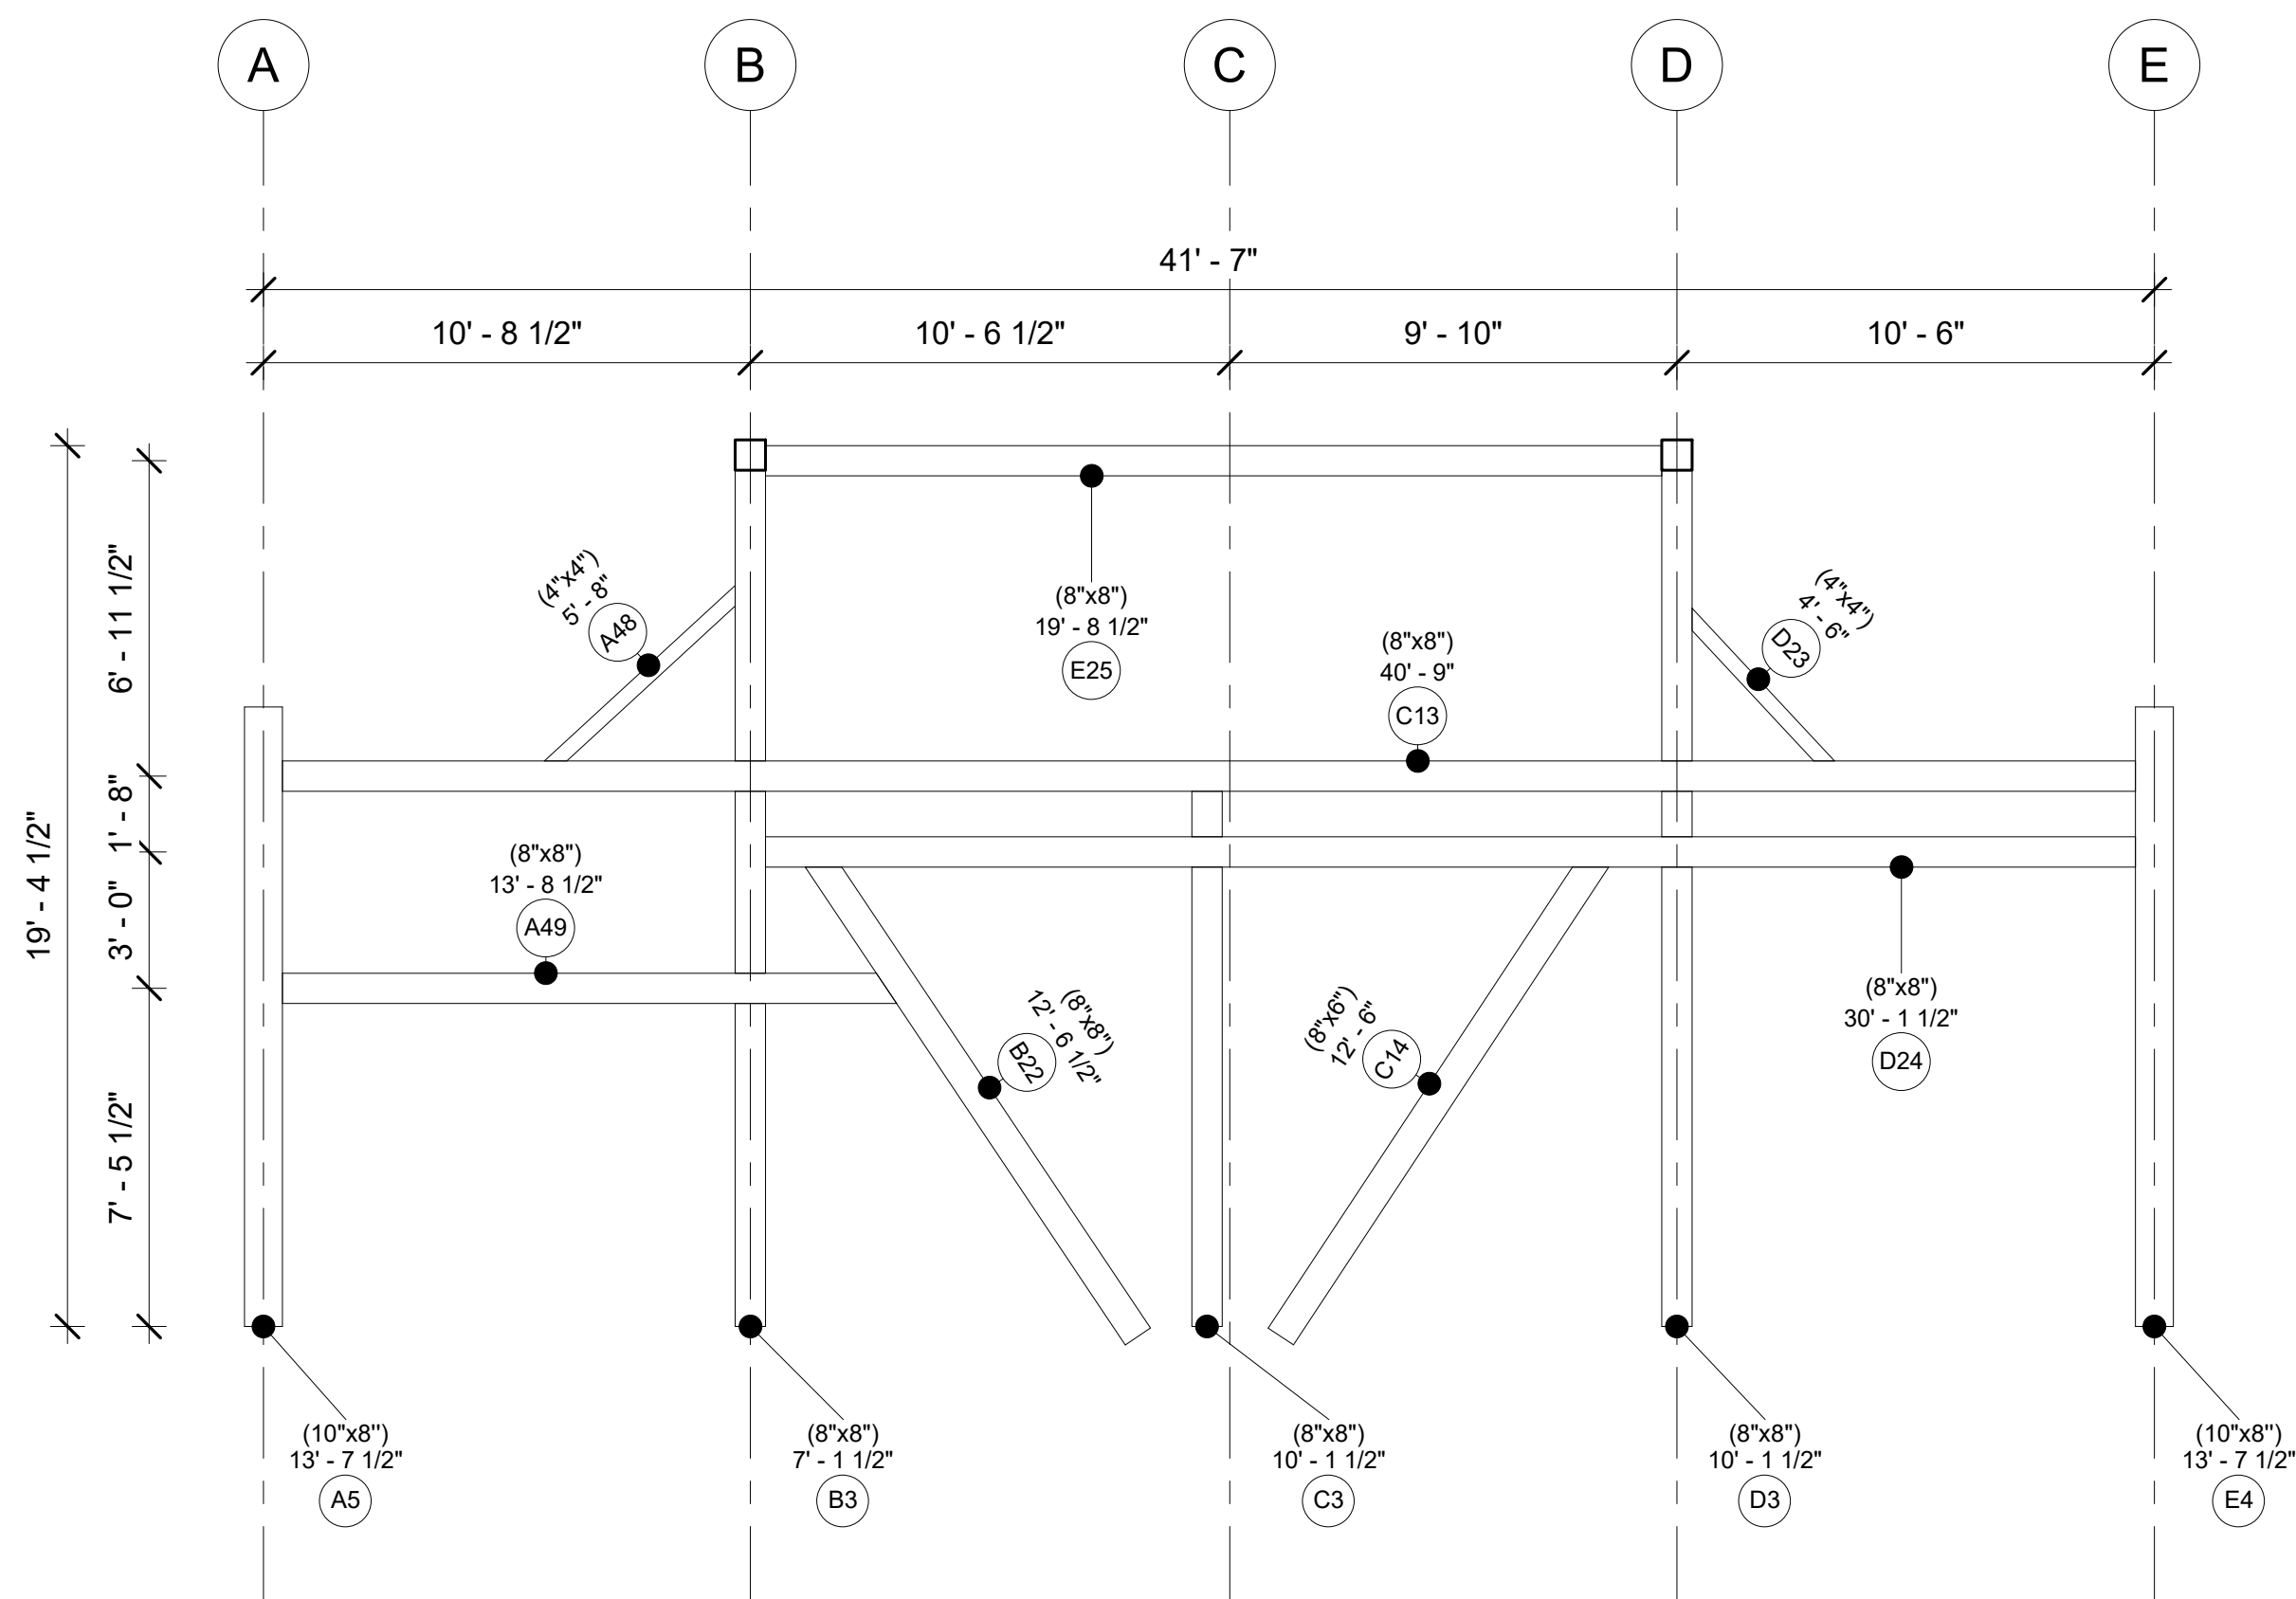

Mossy Creek

Bent 4


Project Number	Project 17
Date	20250618
Drawn By	
Checked By	
A109	
Scale	1/4" = 1'-0"

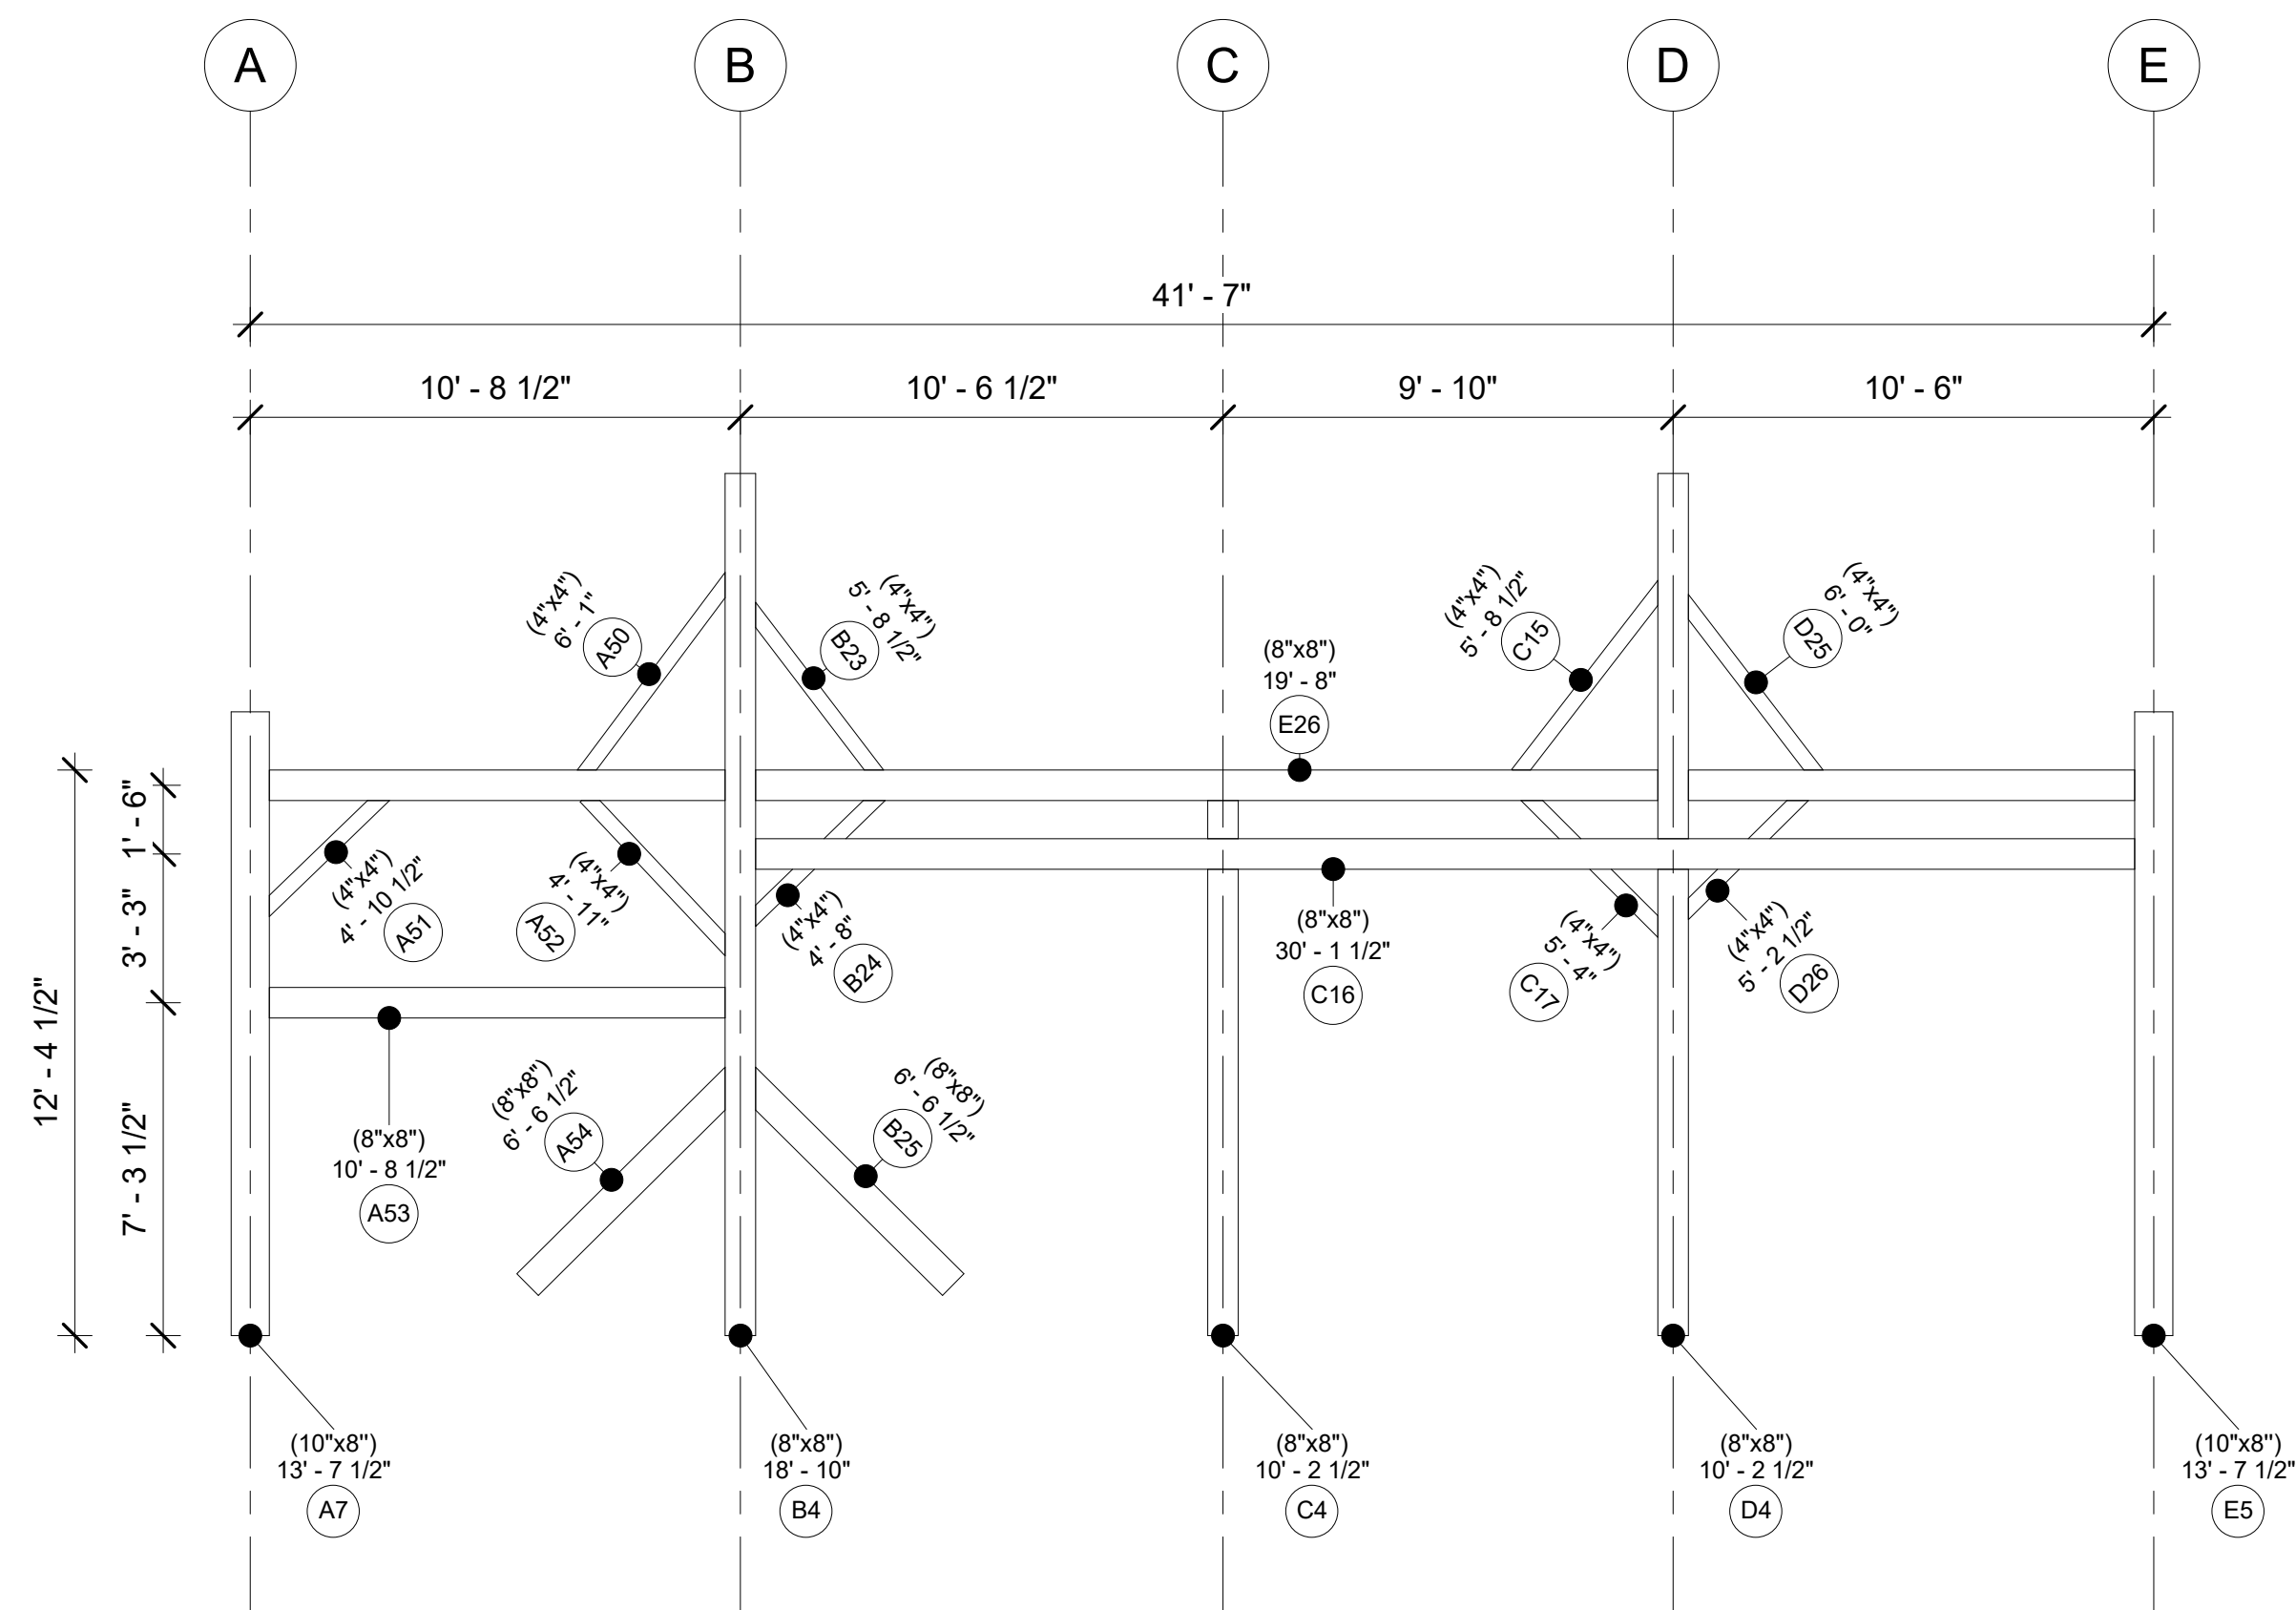

Mossy Creek

Bent 5

Project Number	Project 17
Date	20250618
Drawn By	
Checked By	
A110	
Scale	1/4" = 1'-0"

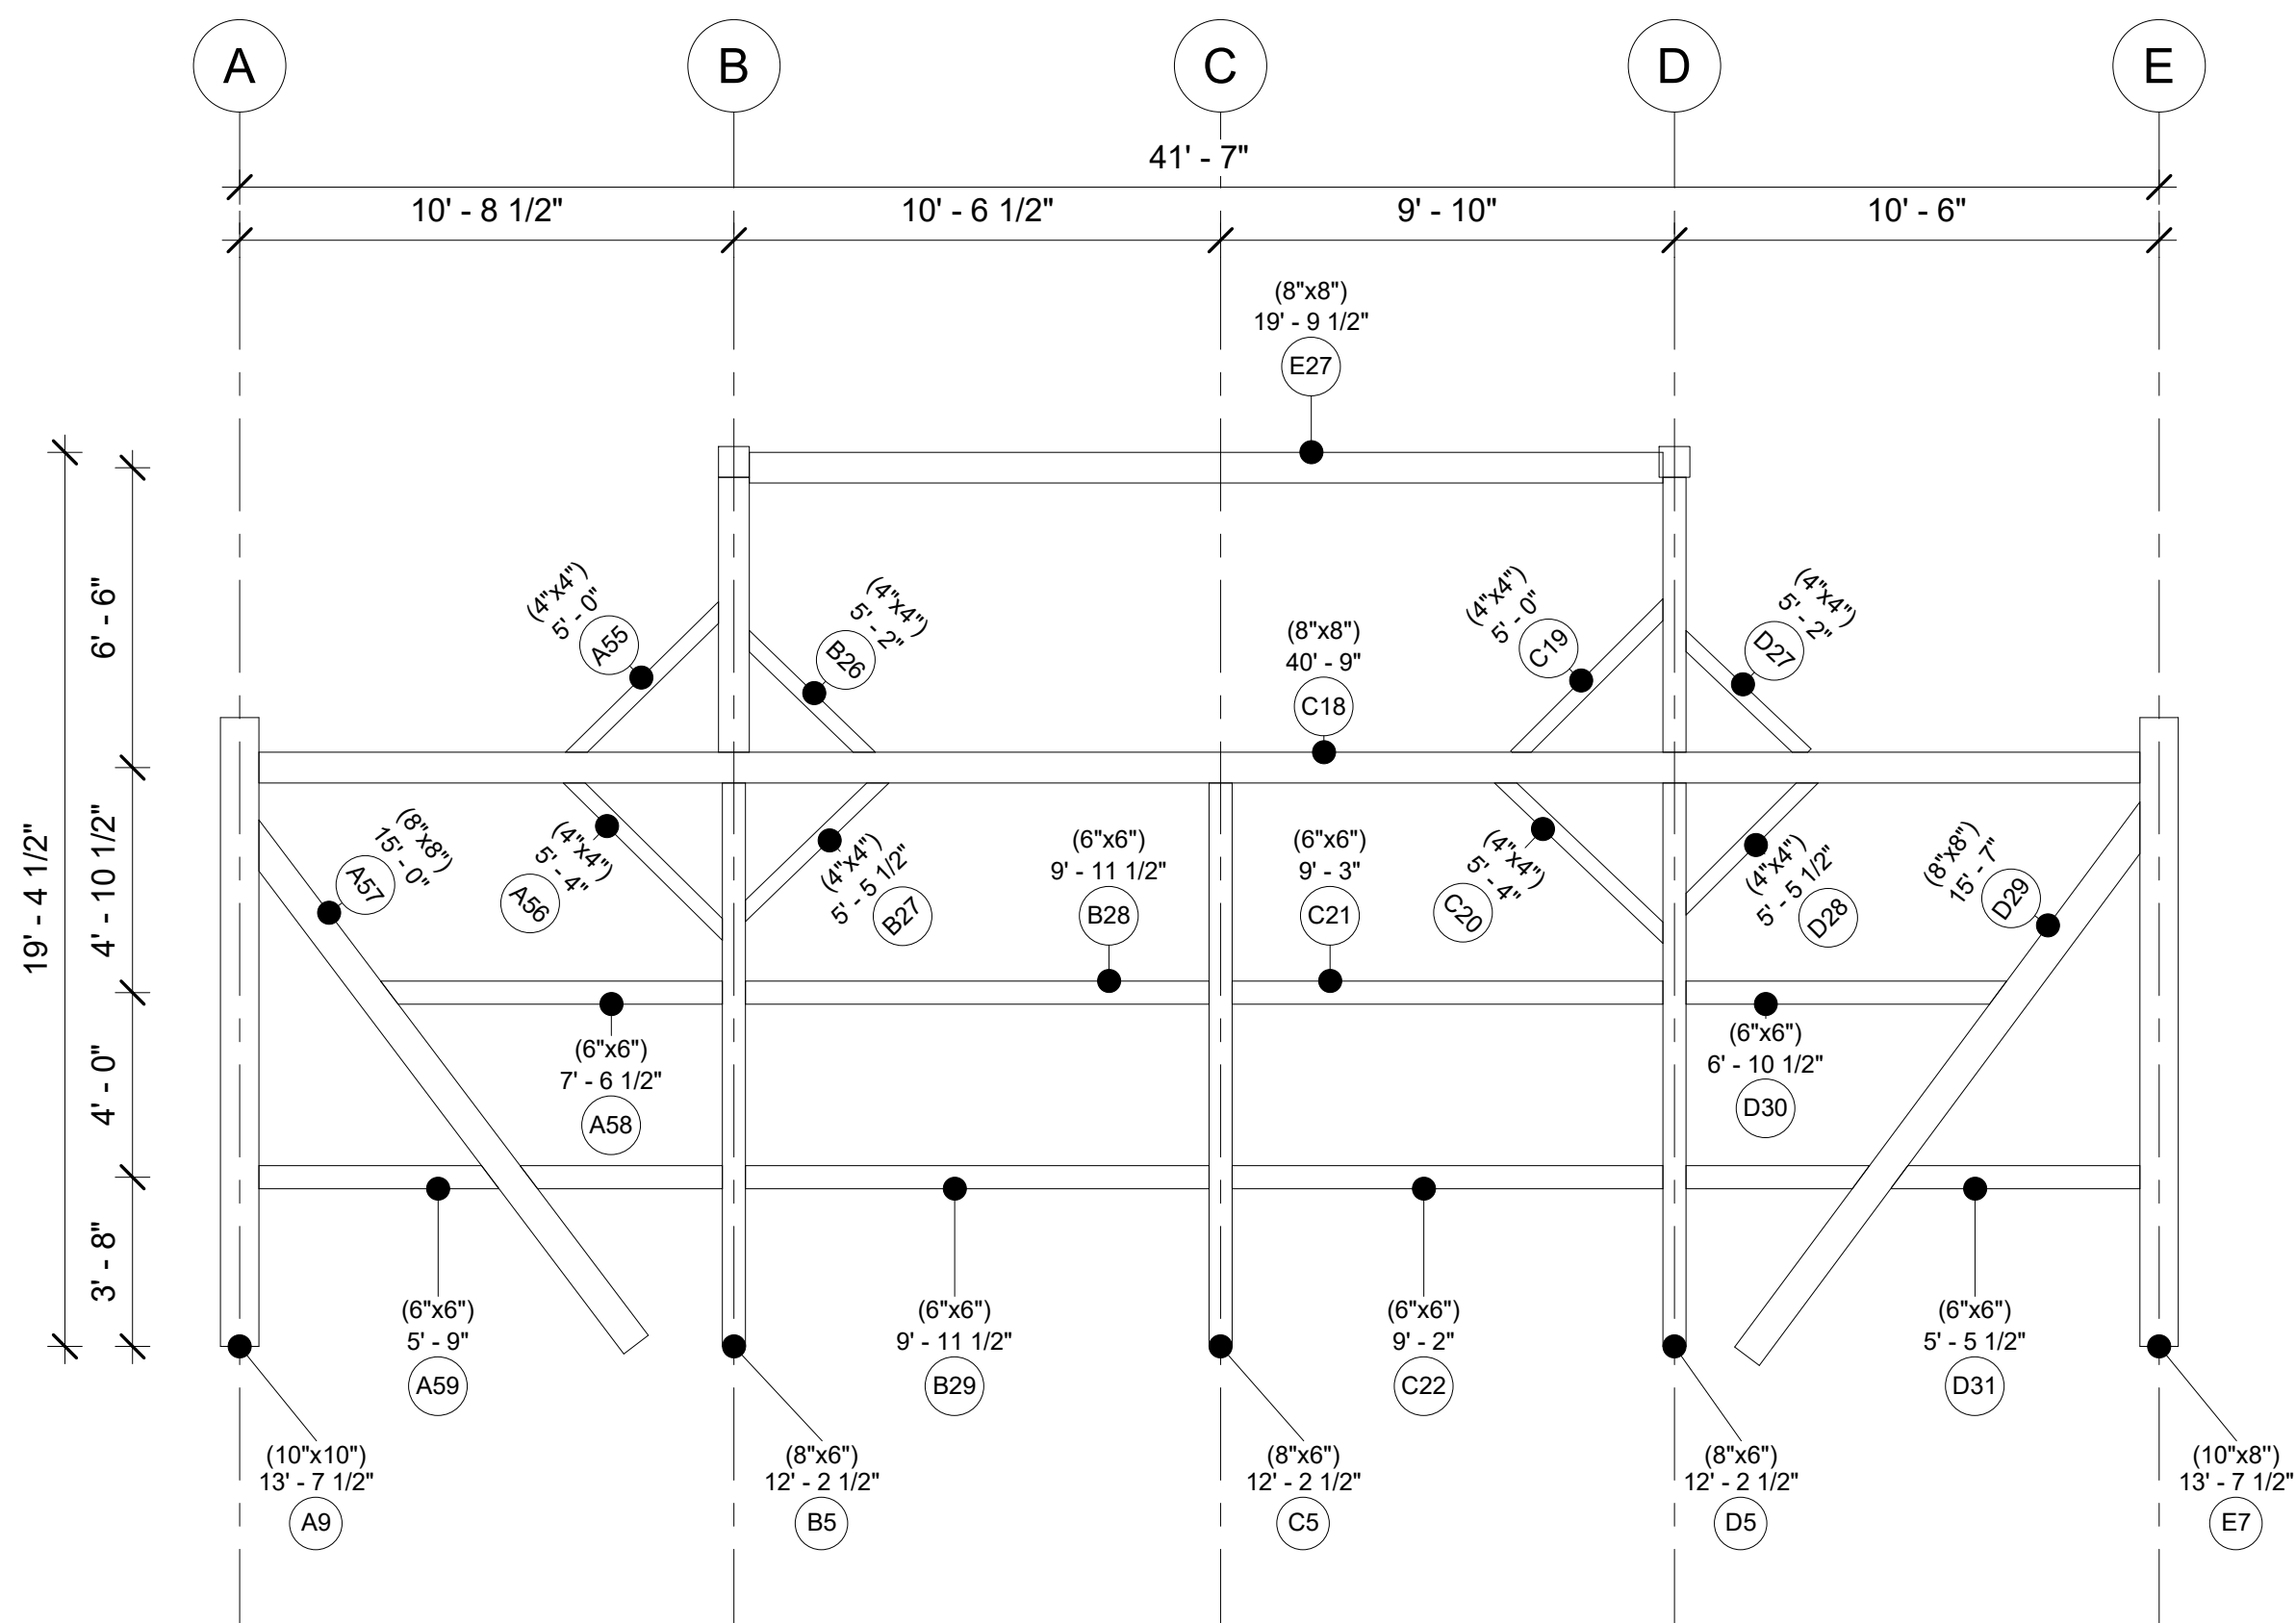

Mossy Creek

Bent 7

Project Number	Project 17
Date	20250618
Drawn By	
Checked By	
A111	
Scale	1/4" = 1'-0"