


PROJECT: Whitetail Hollow
SCOPE: AS BUILT DRAWINGS

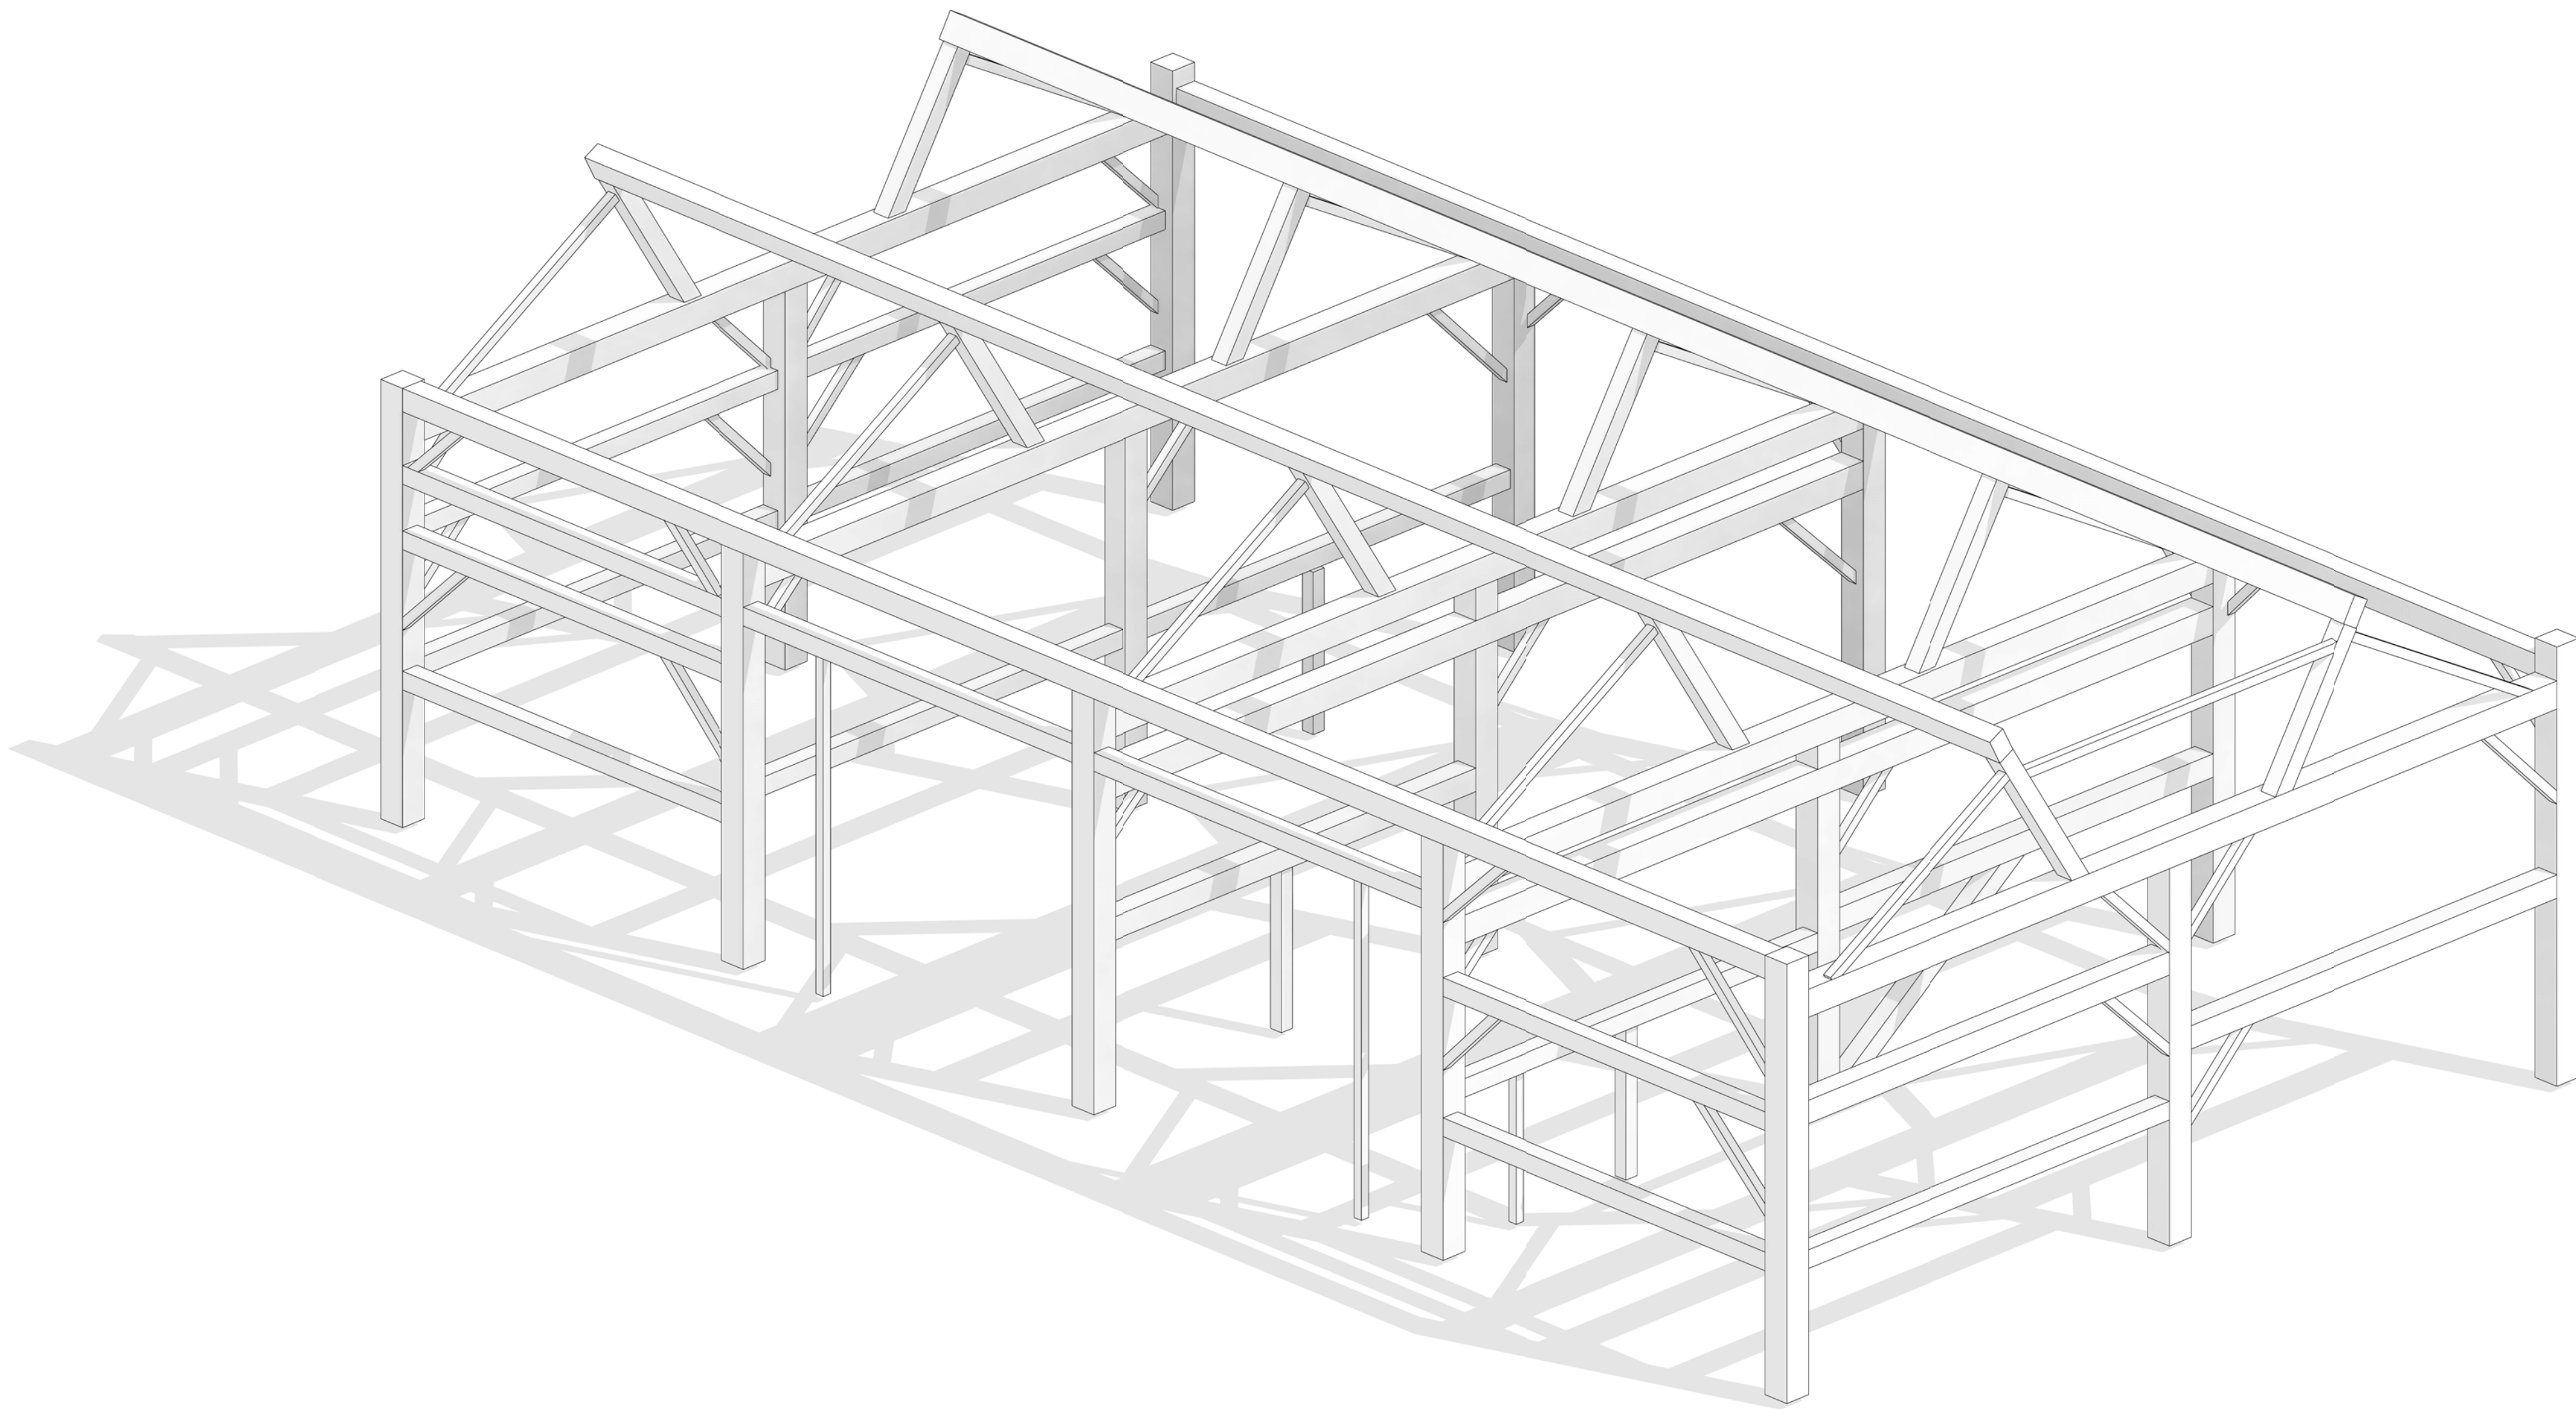

Whitetail Hollow


Cover Page


Project Number	Project 16
Date	20250623
Drawn By	
Checked By	
A101	
Scale	

Whitetail Hollow

Floor Plan

Project Number	Project 16
Date	20250623
Drawn By	
Checked By	
A102	
Scale	1/4" = 1'-0"

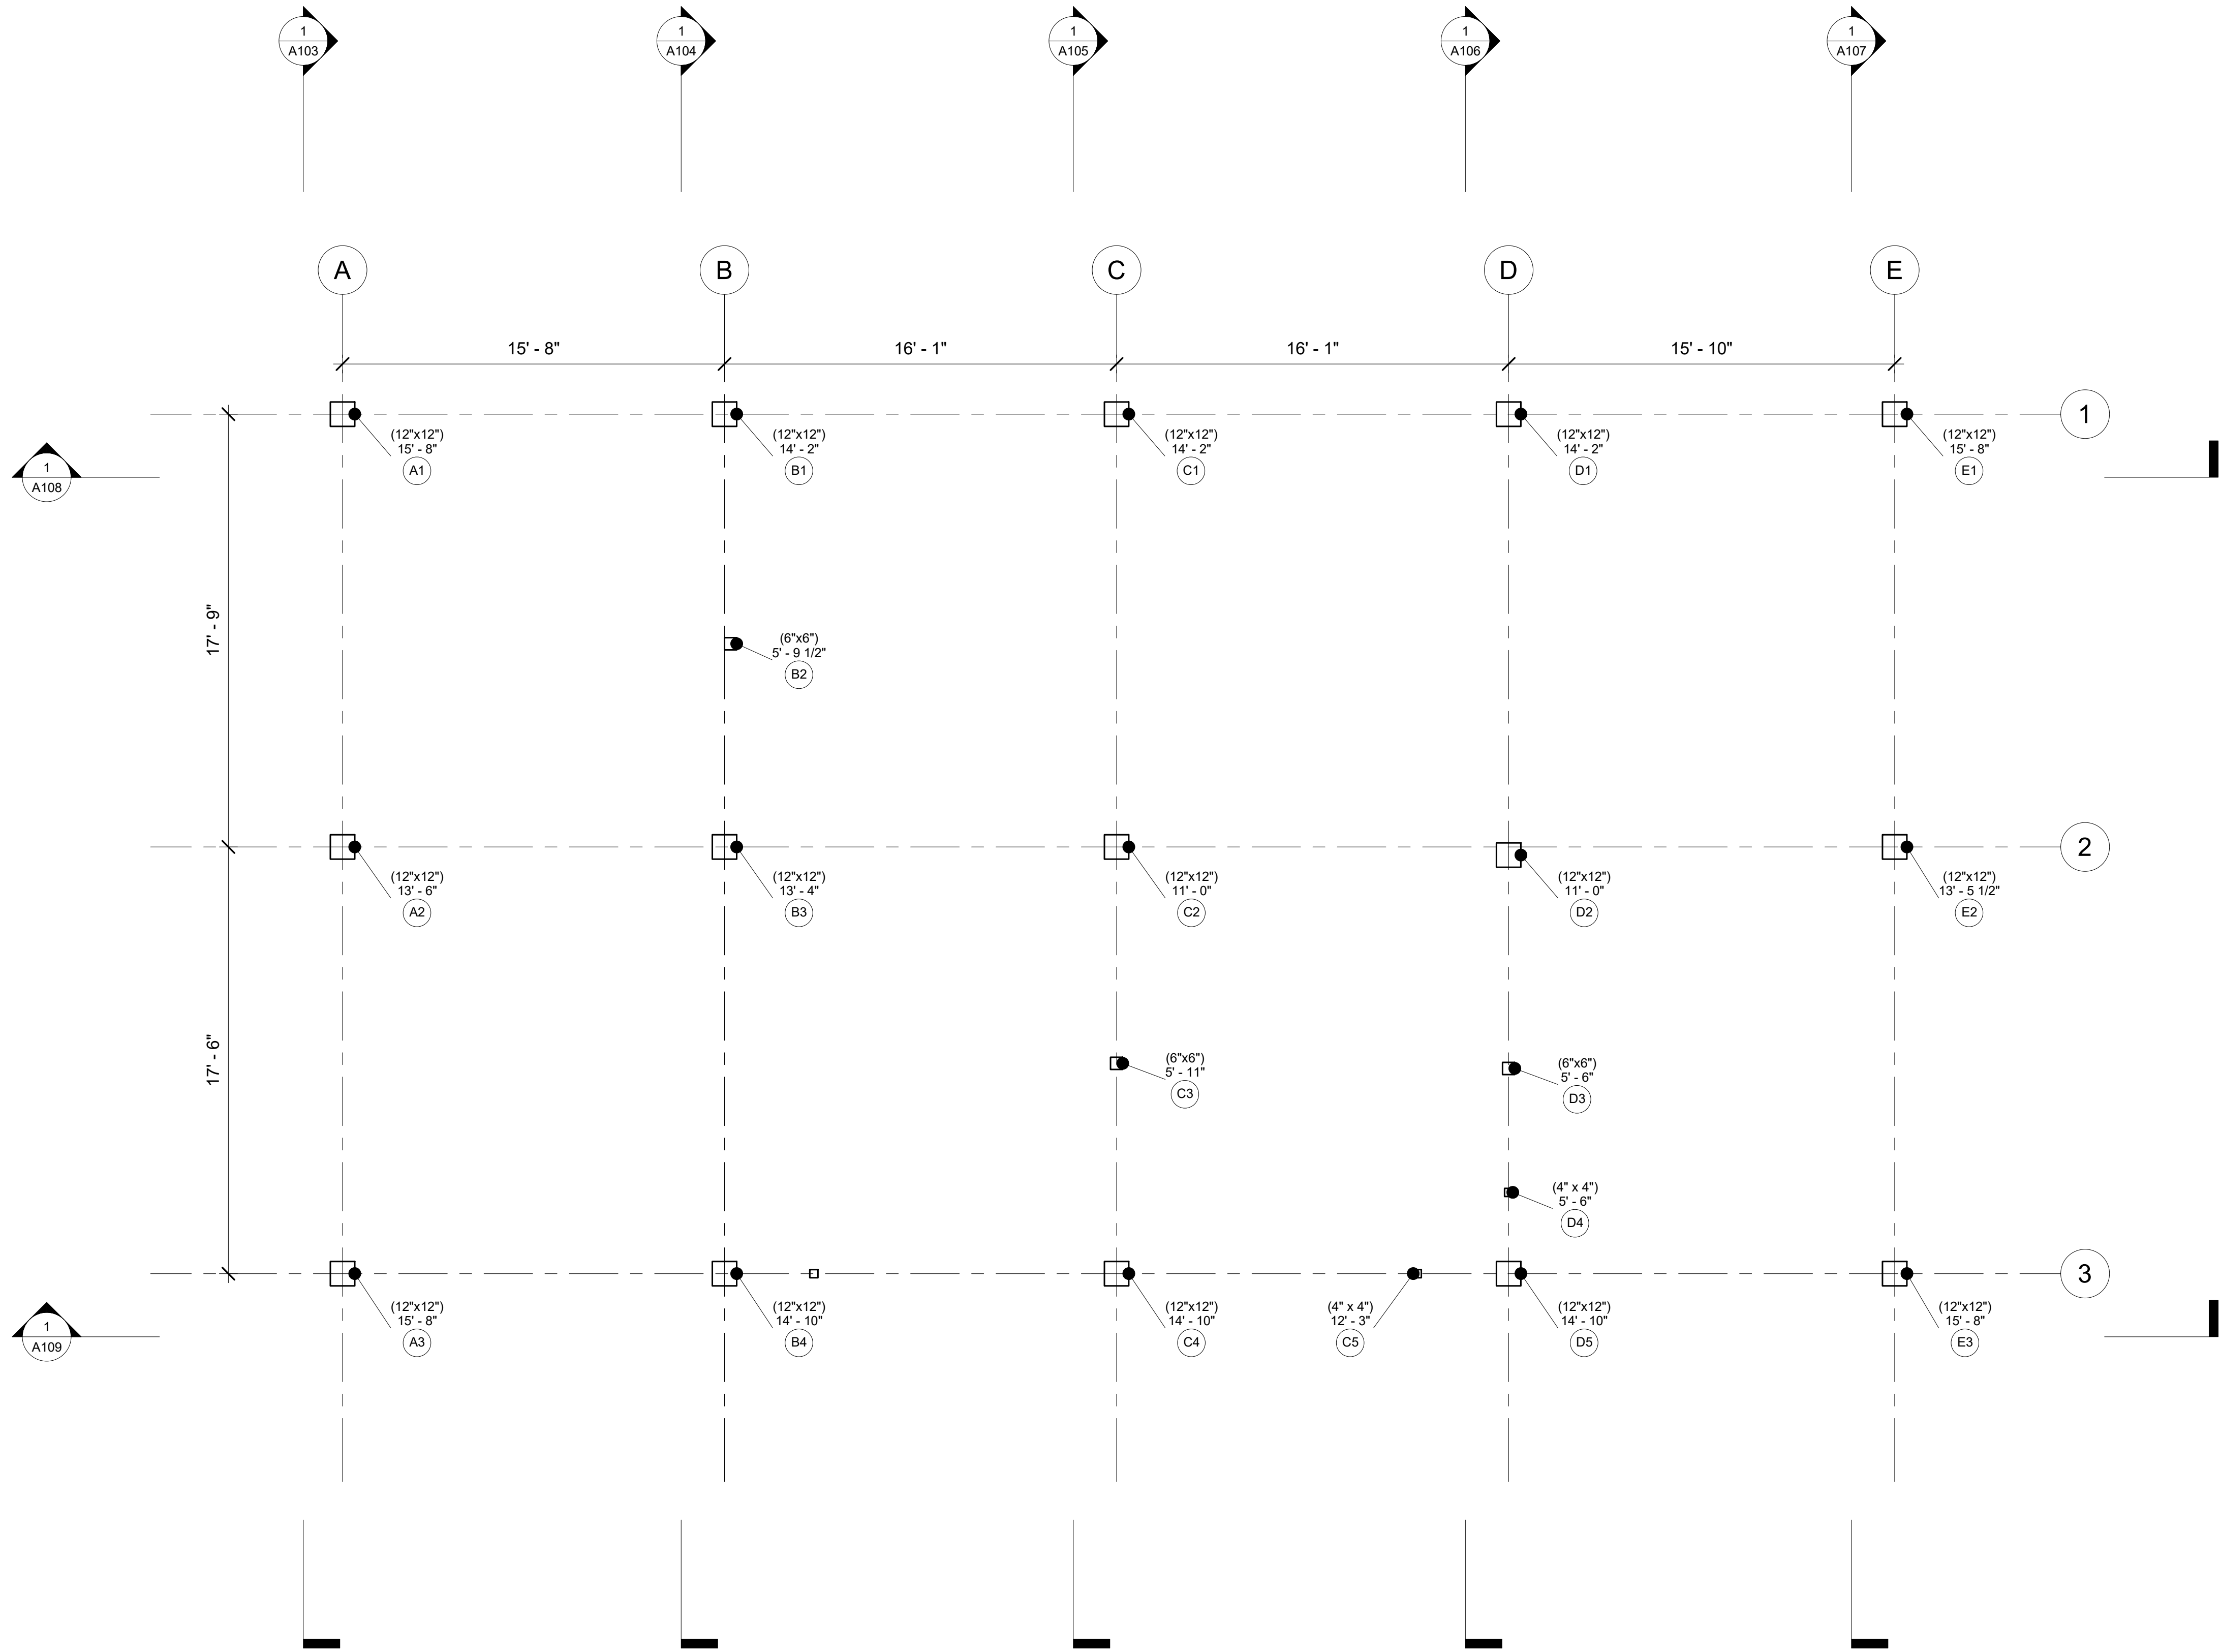


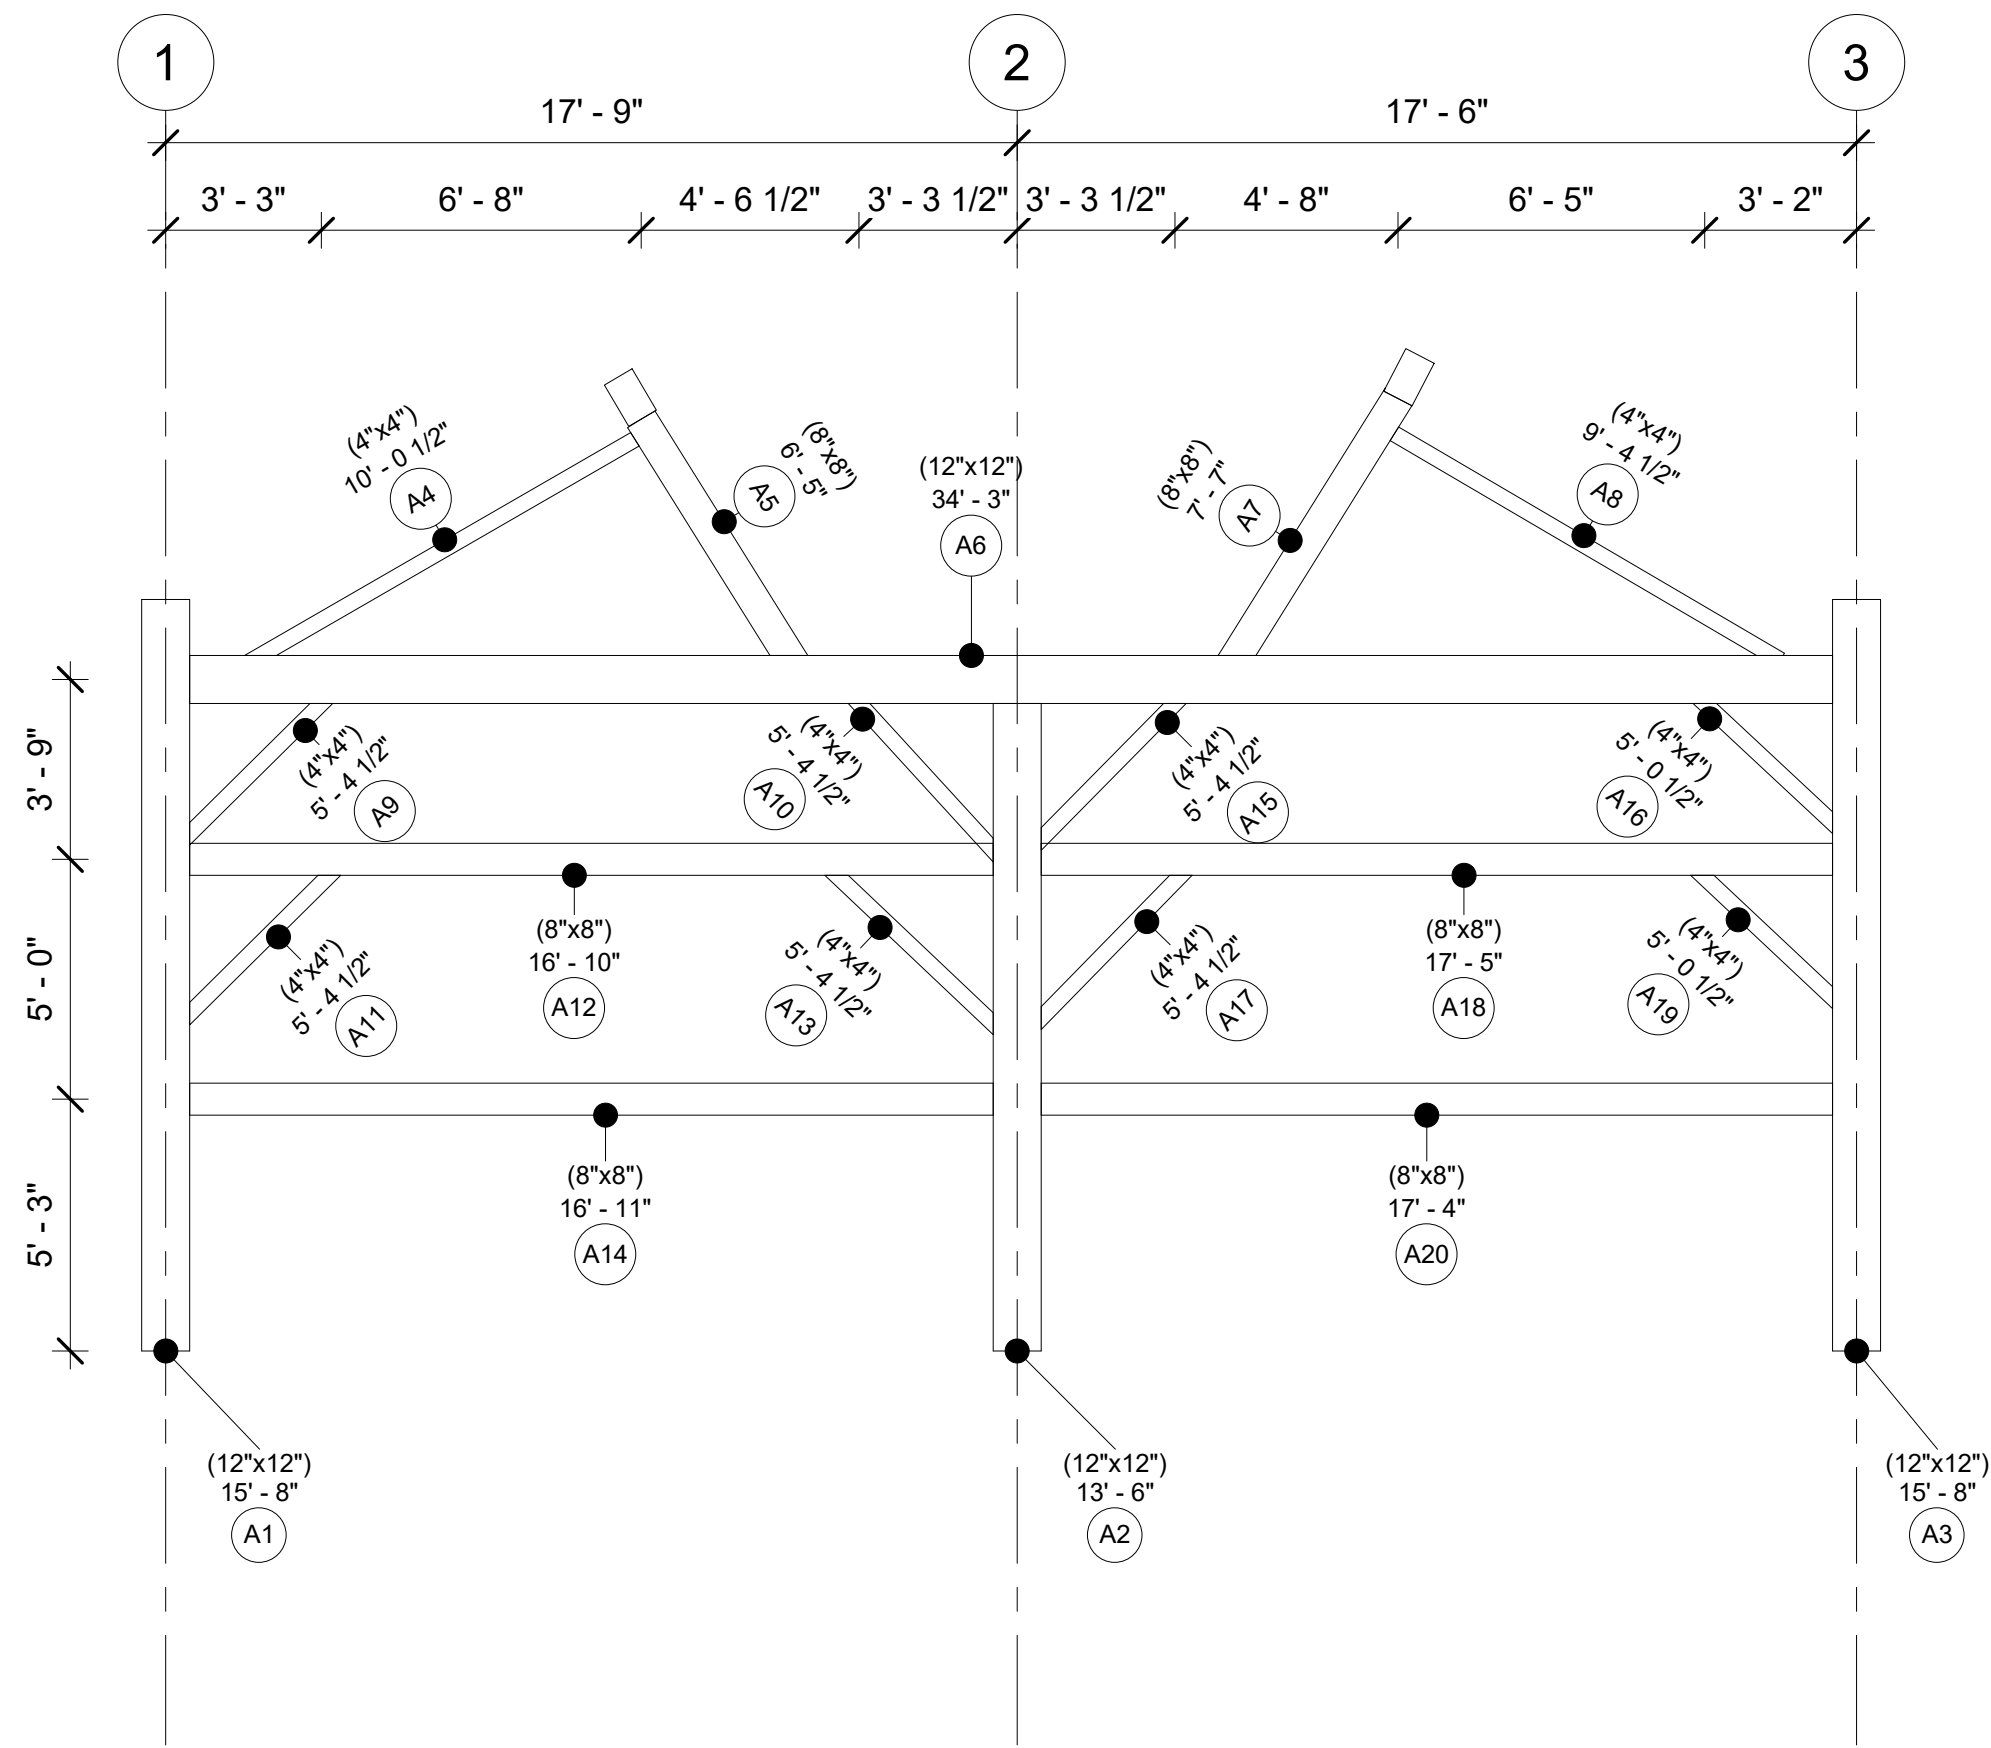

Whitetail Hollow

Bent A


Project Number	Project 16
Date	20250623
Drawn By	
Checked By	
A103	
Scale	1/4" = 1'-0"

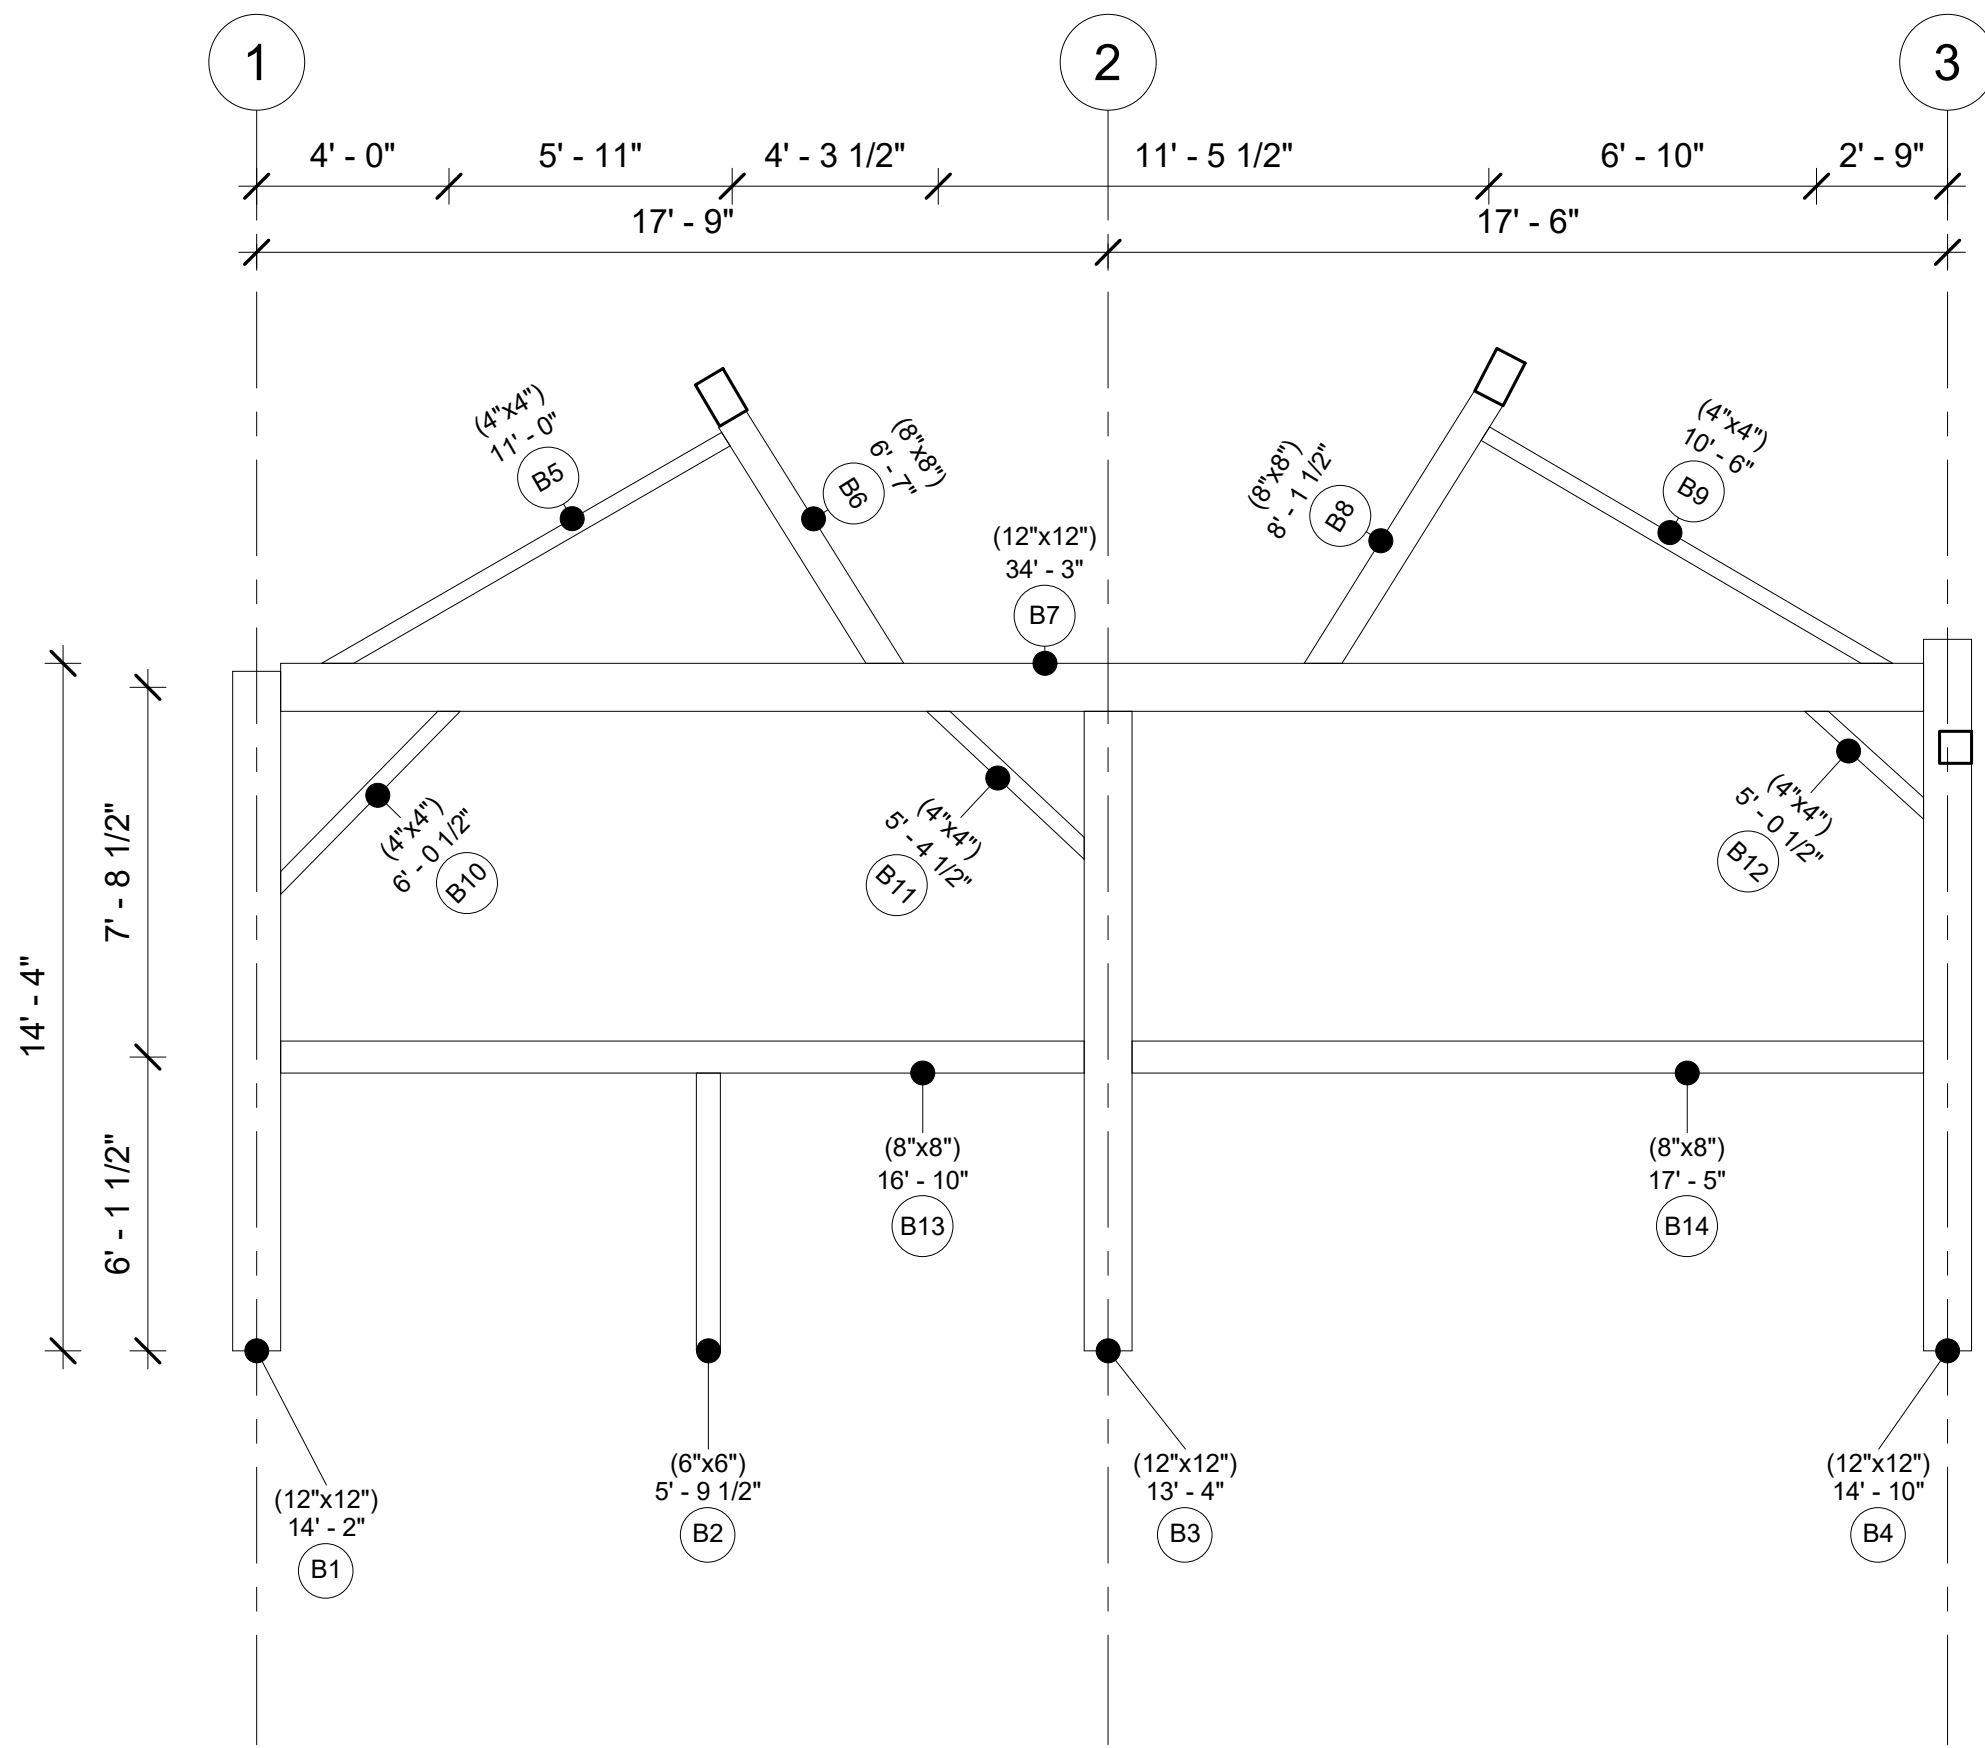

Whitetail Hollow

Bent B


Project Number	Project 16
Date	20250623
Drawn By	
Checked By	
A104	
Scale	1/4" = 1'-0"

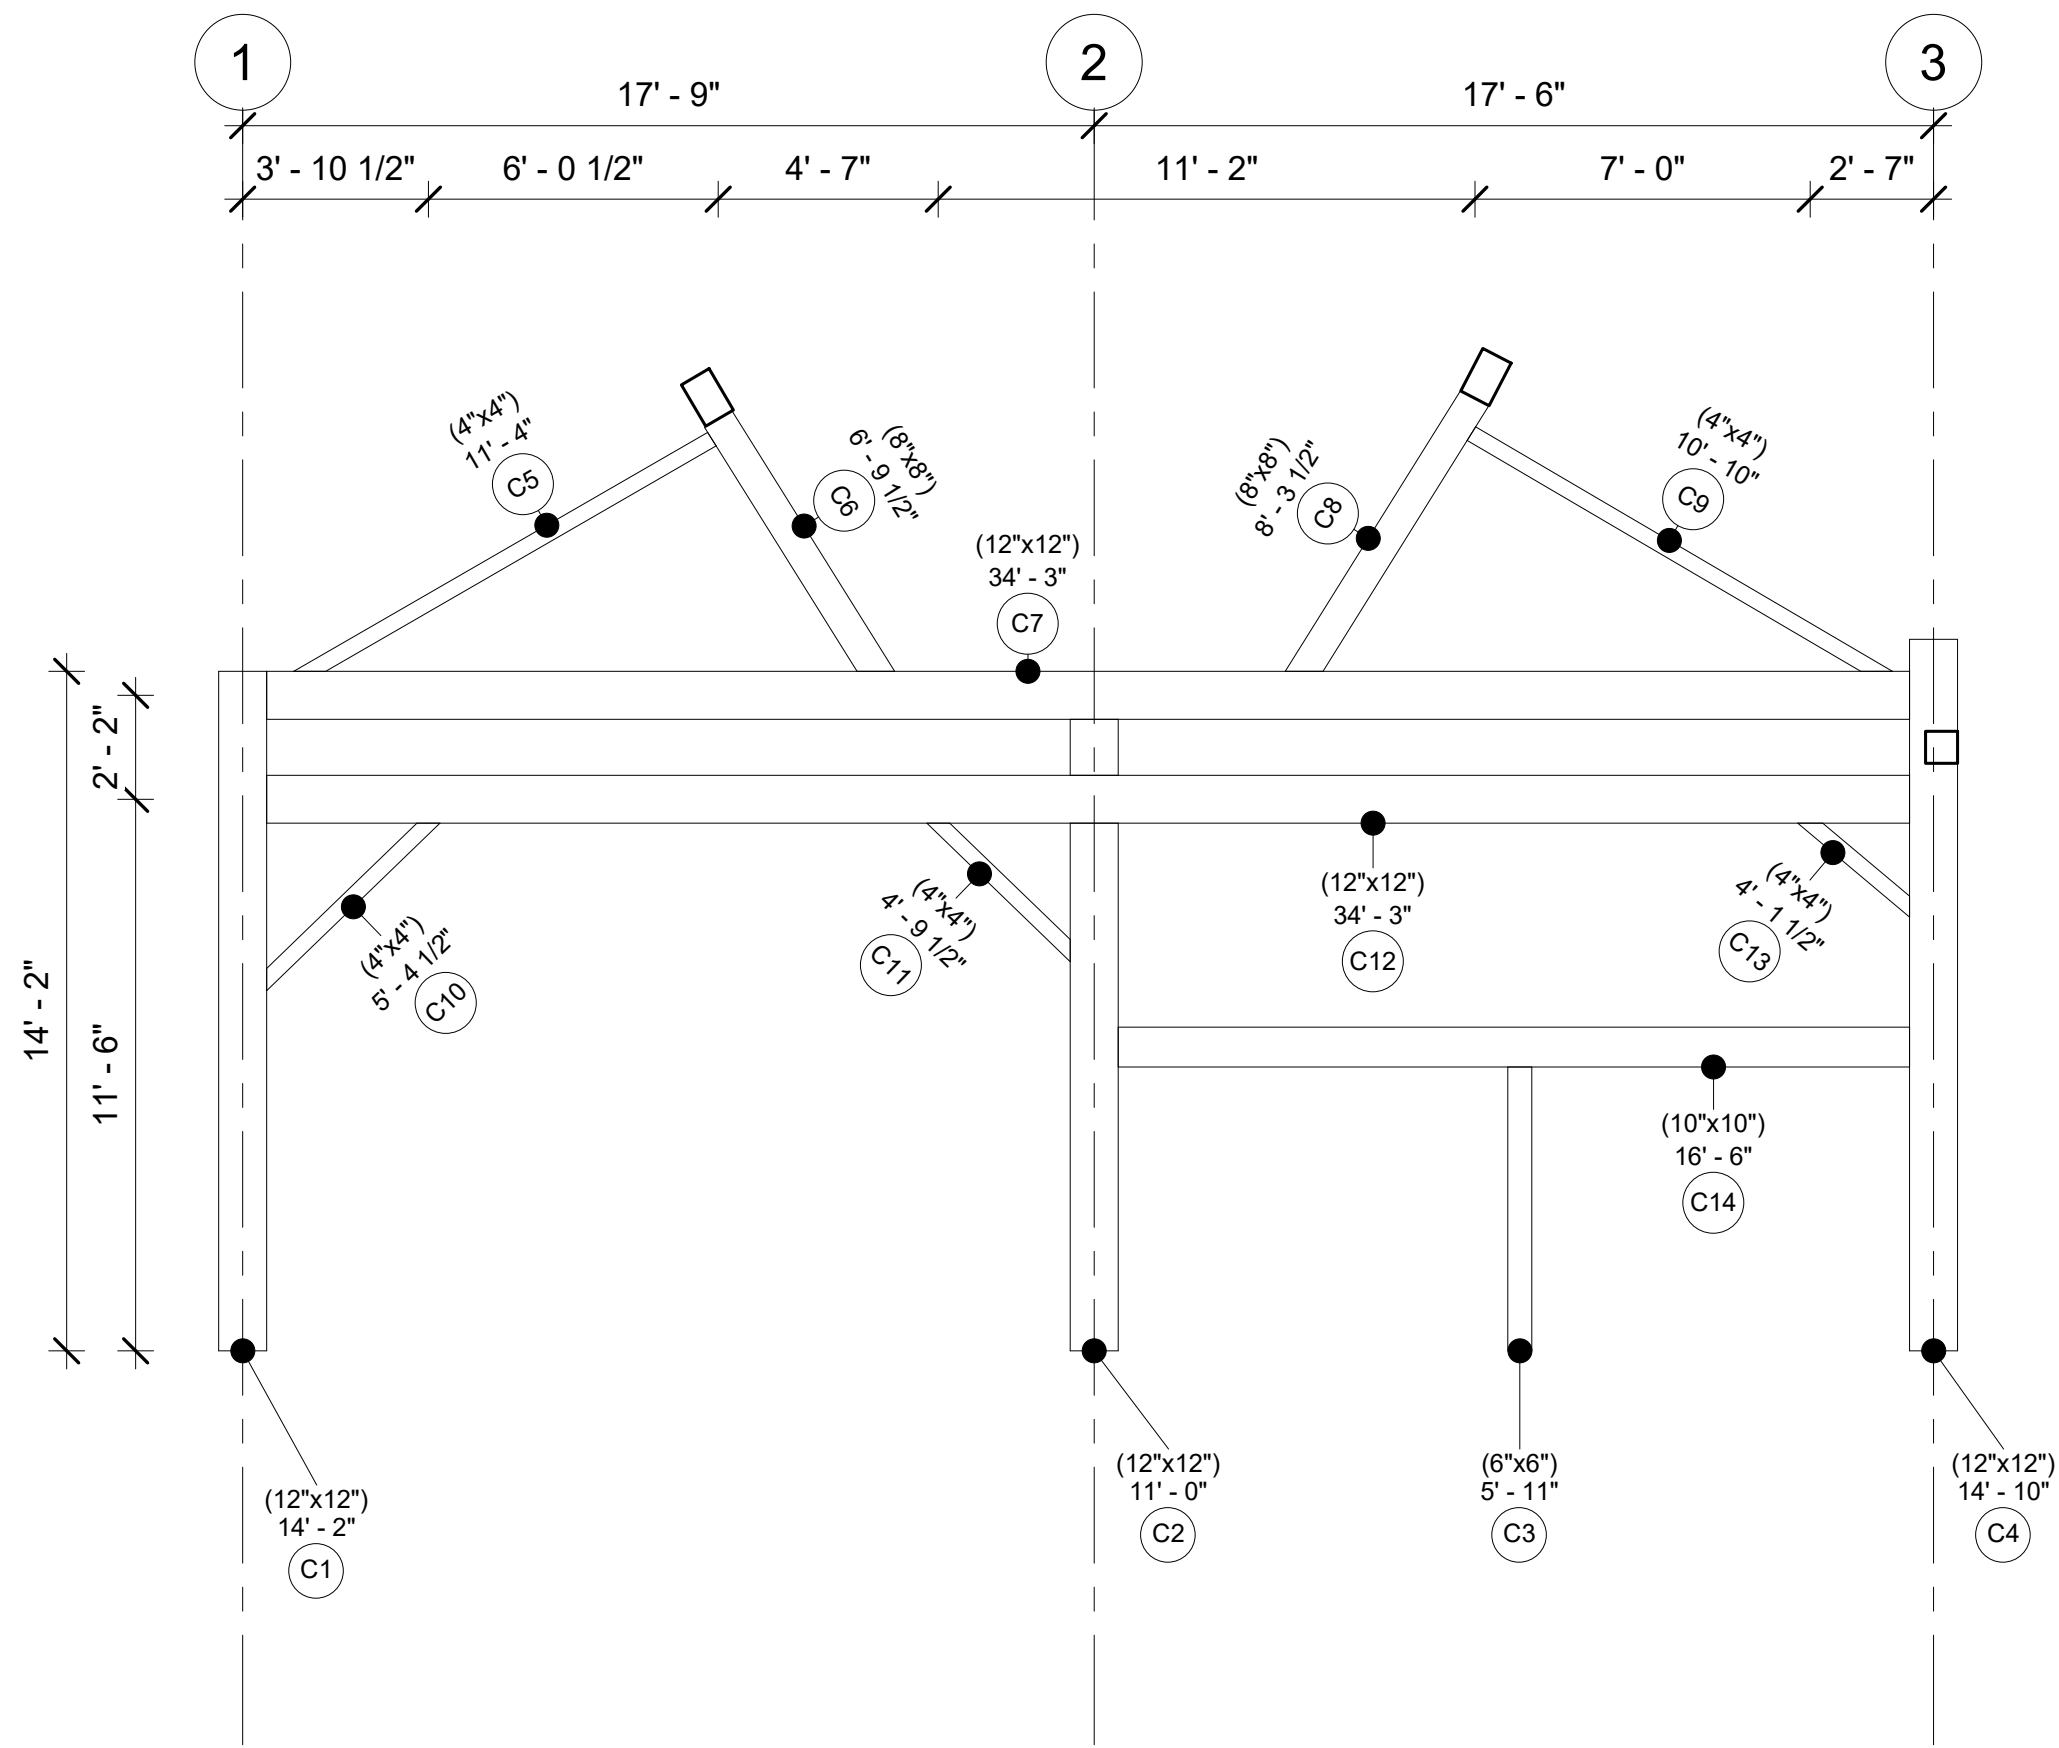


Whitetail Hollow

Bent C

Project Number	Project 16
Date	20250623
Drawn By	
Checked By	
A105	
Scale	1/4" = 1'-0"

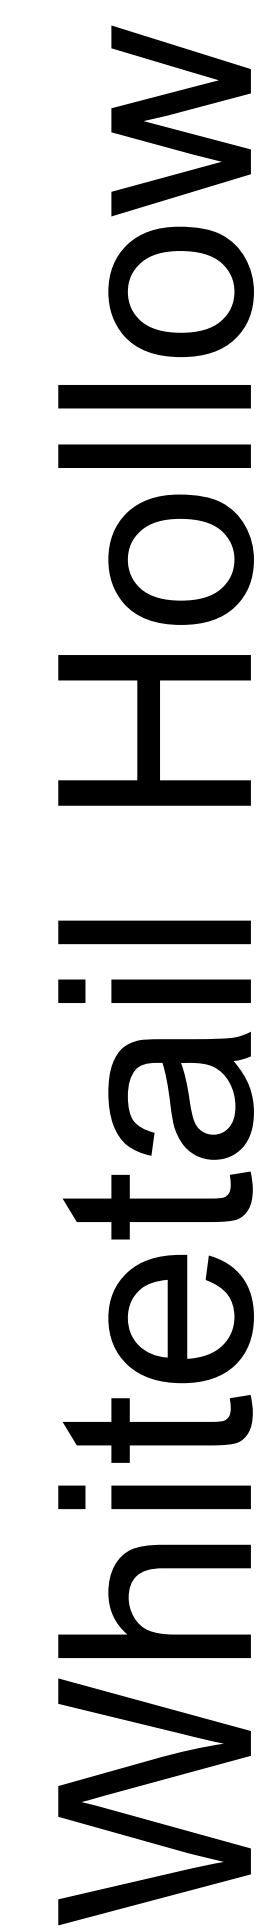


Project Number	Project 16
Date	20250623
Drawn By	
Checked By	
A106	
Scale	1/4" = 1'-0"

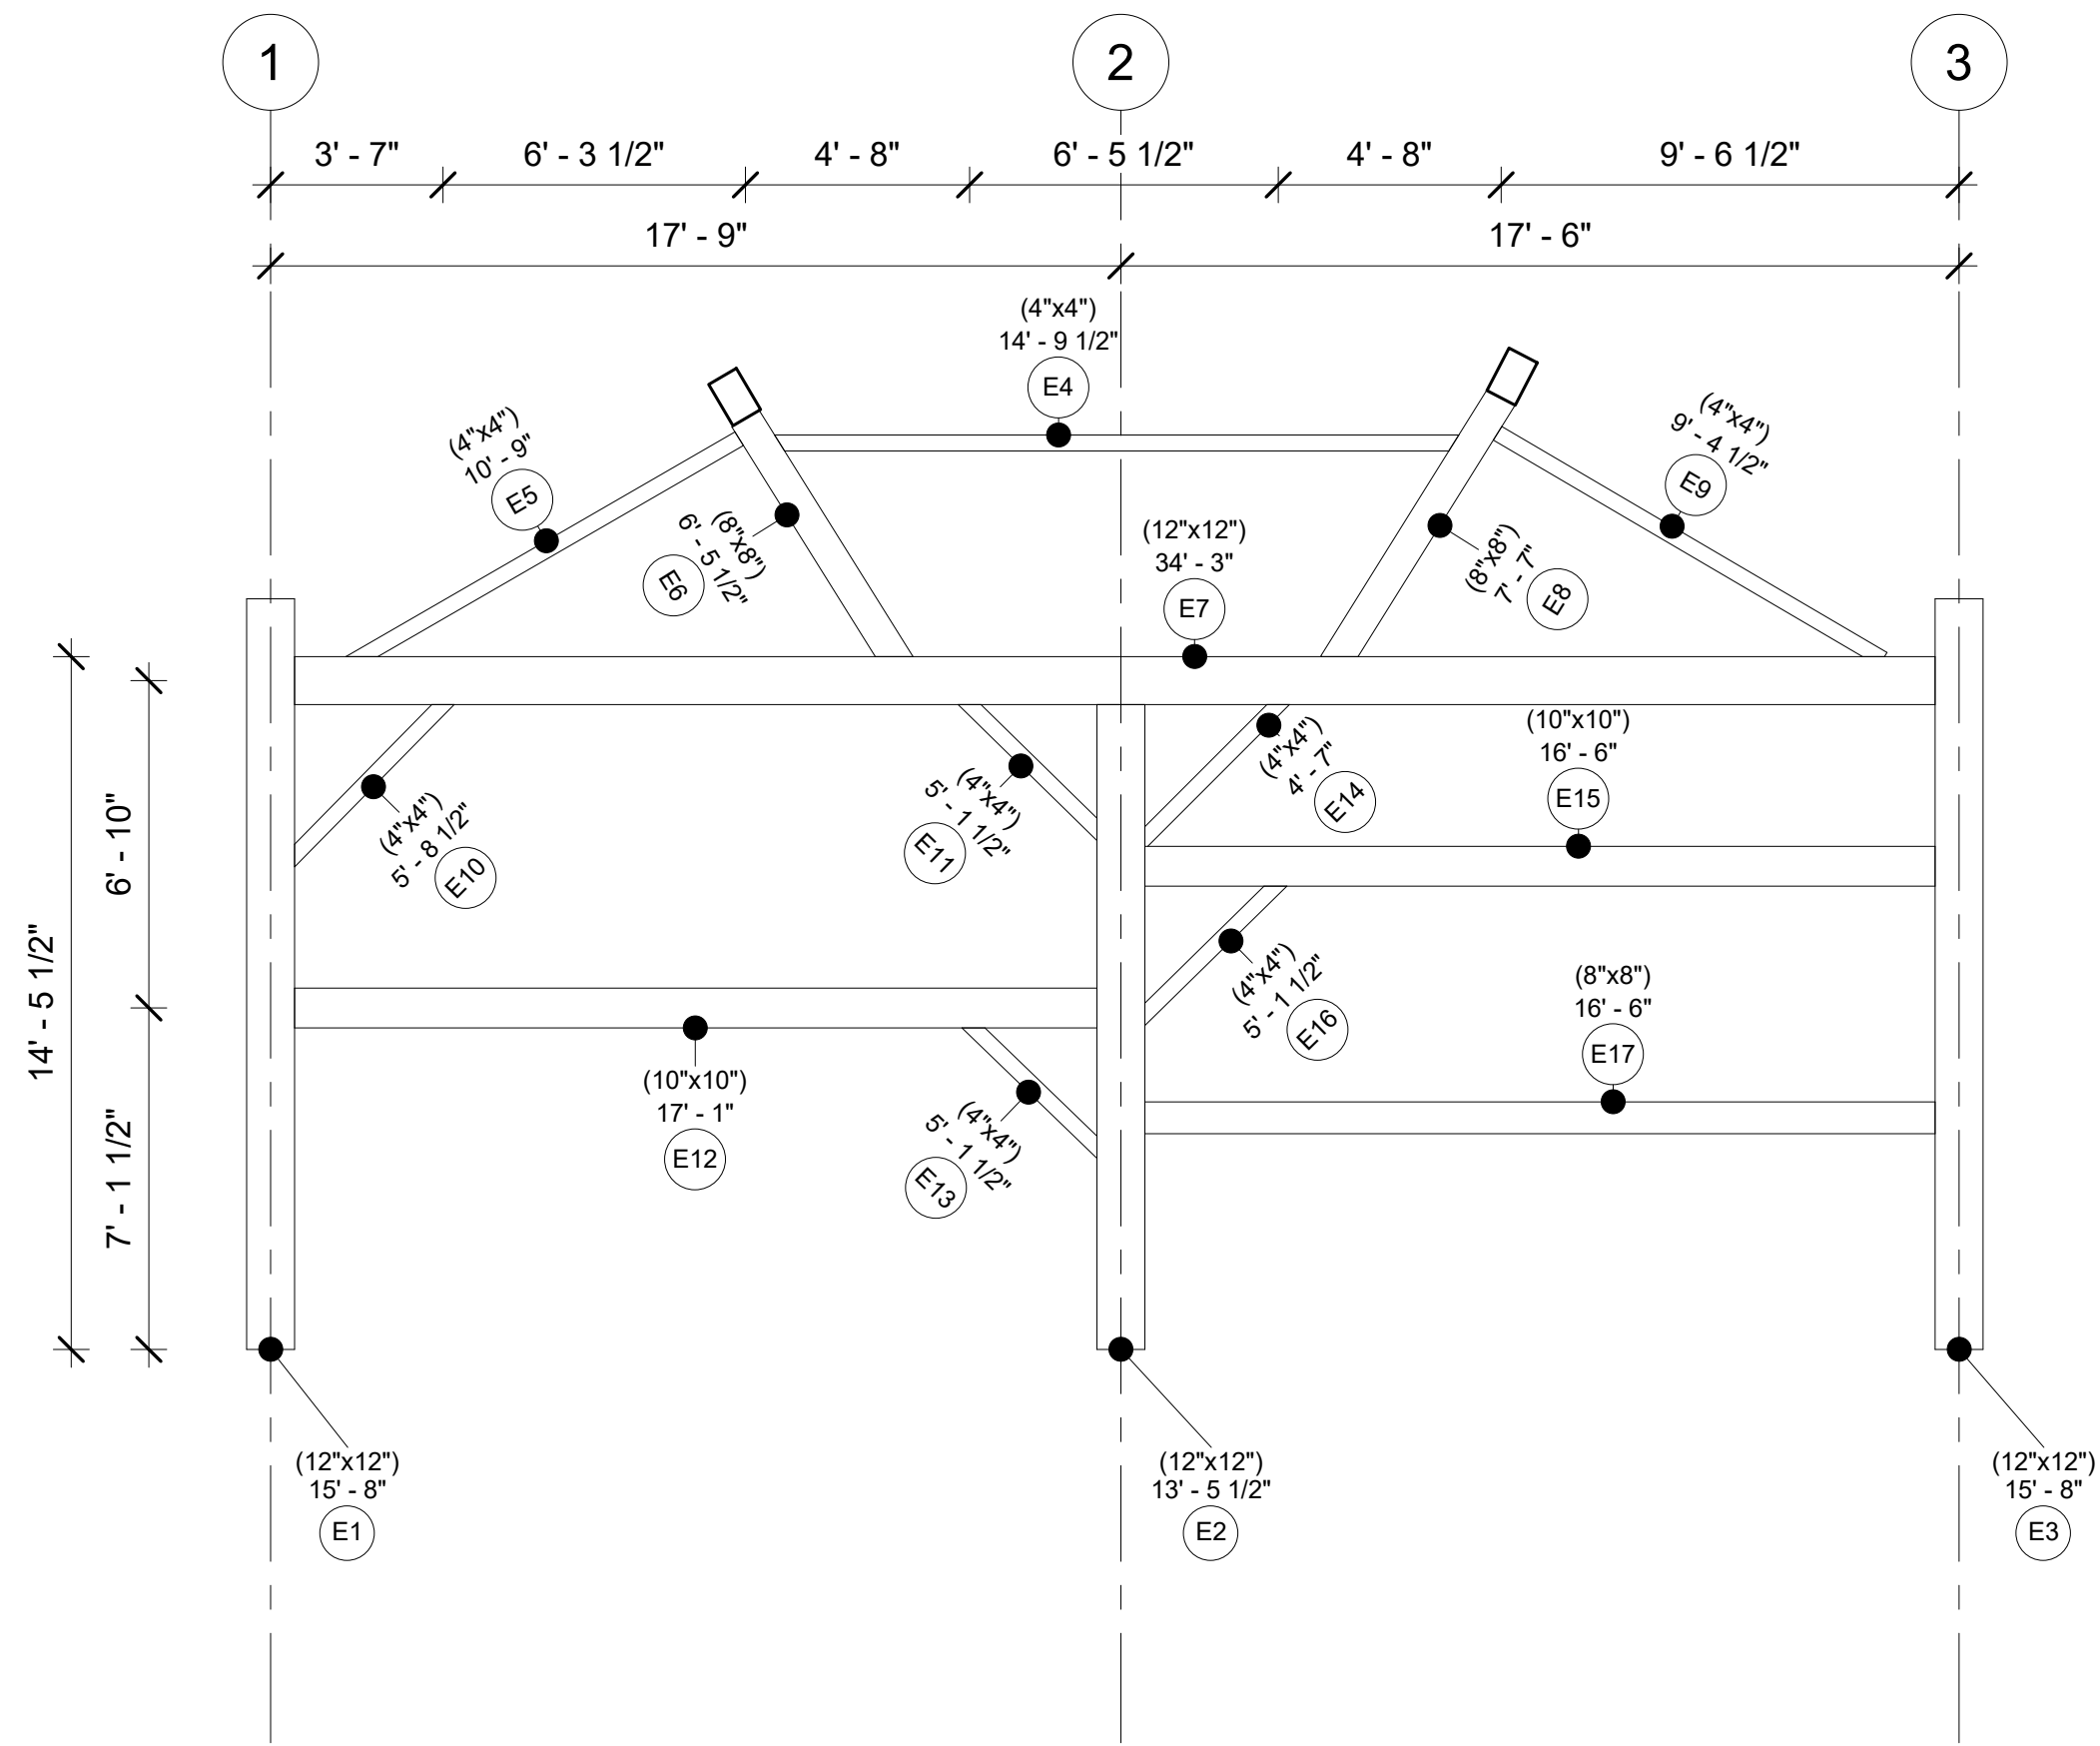

Whitetail Hollow

Bent E


Project Number	Project 16
Date	20250623
Drawn By	
Checked By	
A107	
Scale	1/4" = 1'-0"

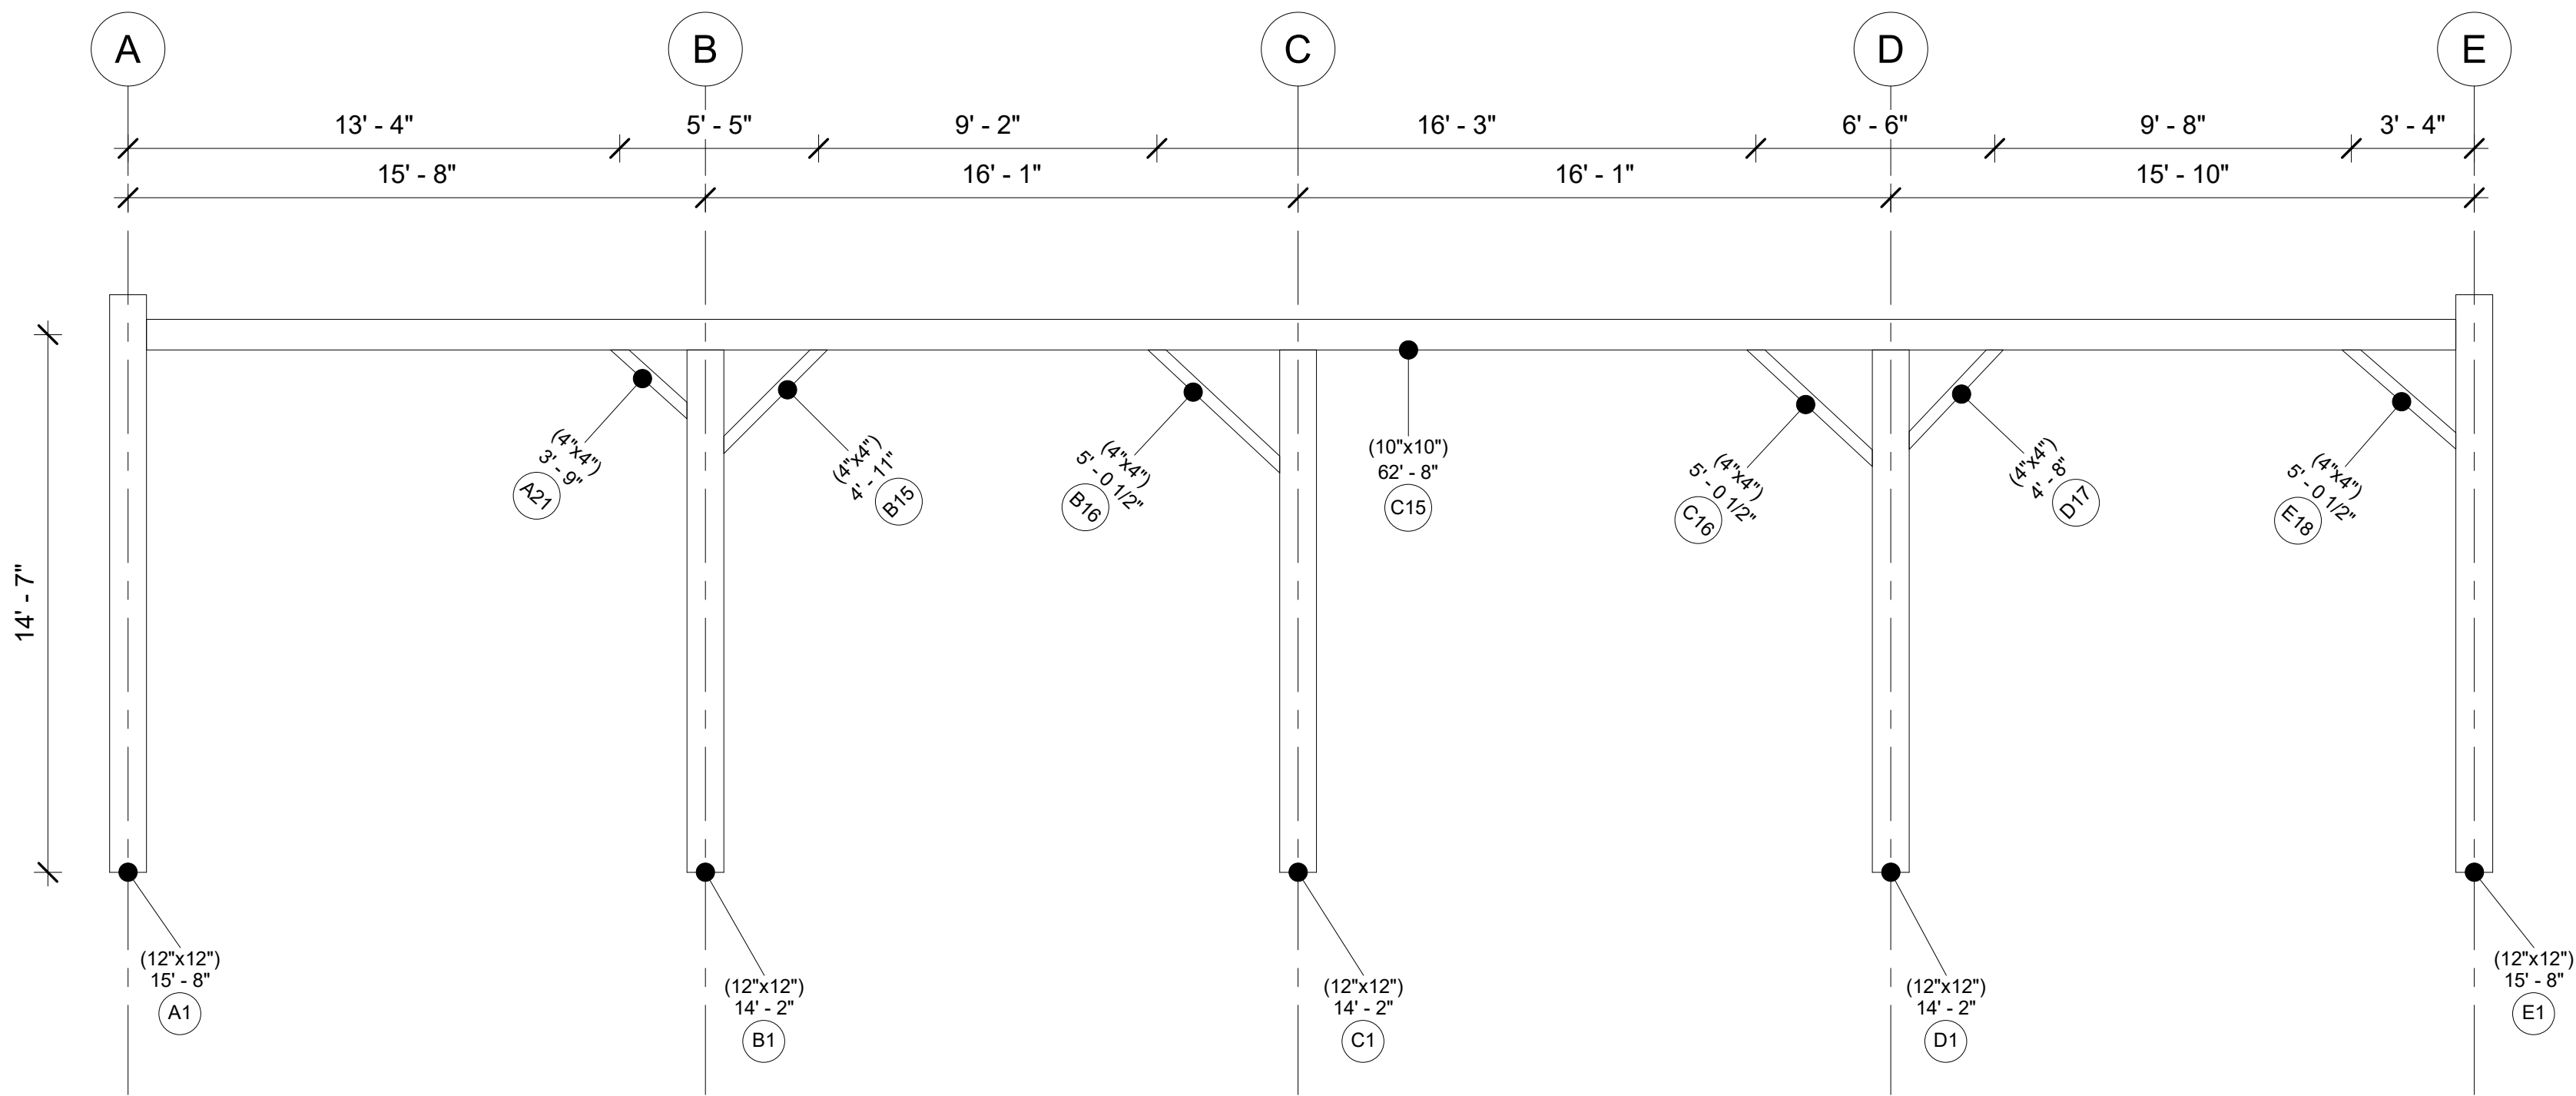

Whitetail Hollow

Bent 1

Project Number	Project 16
Date	20250623
Drawn By	
Checked By	
A108	
Scale	1/4" = 1'-0"

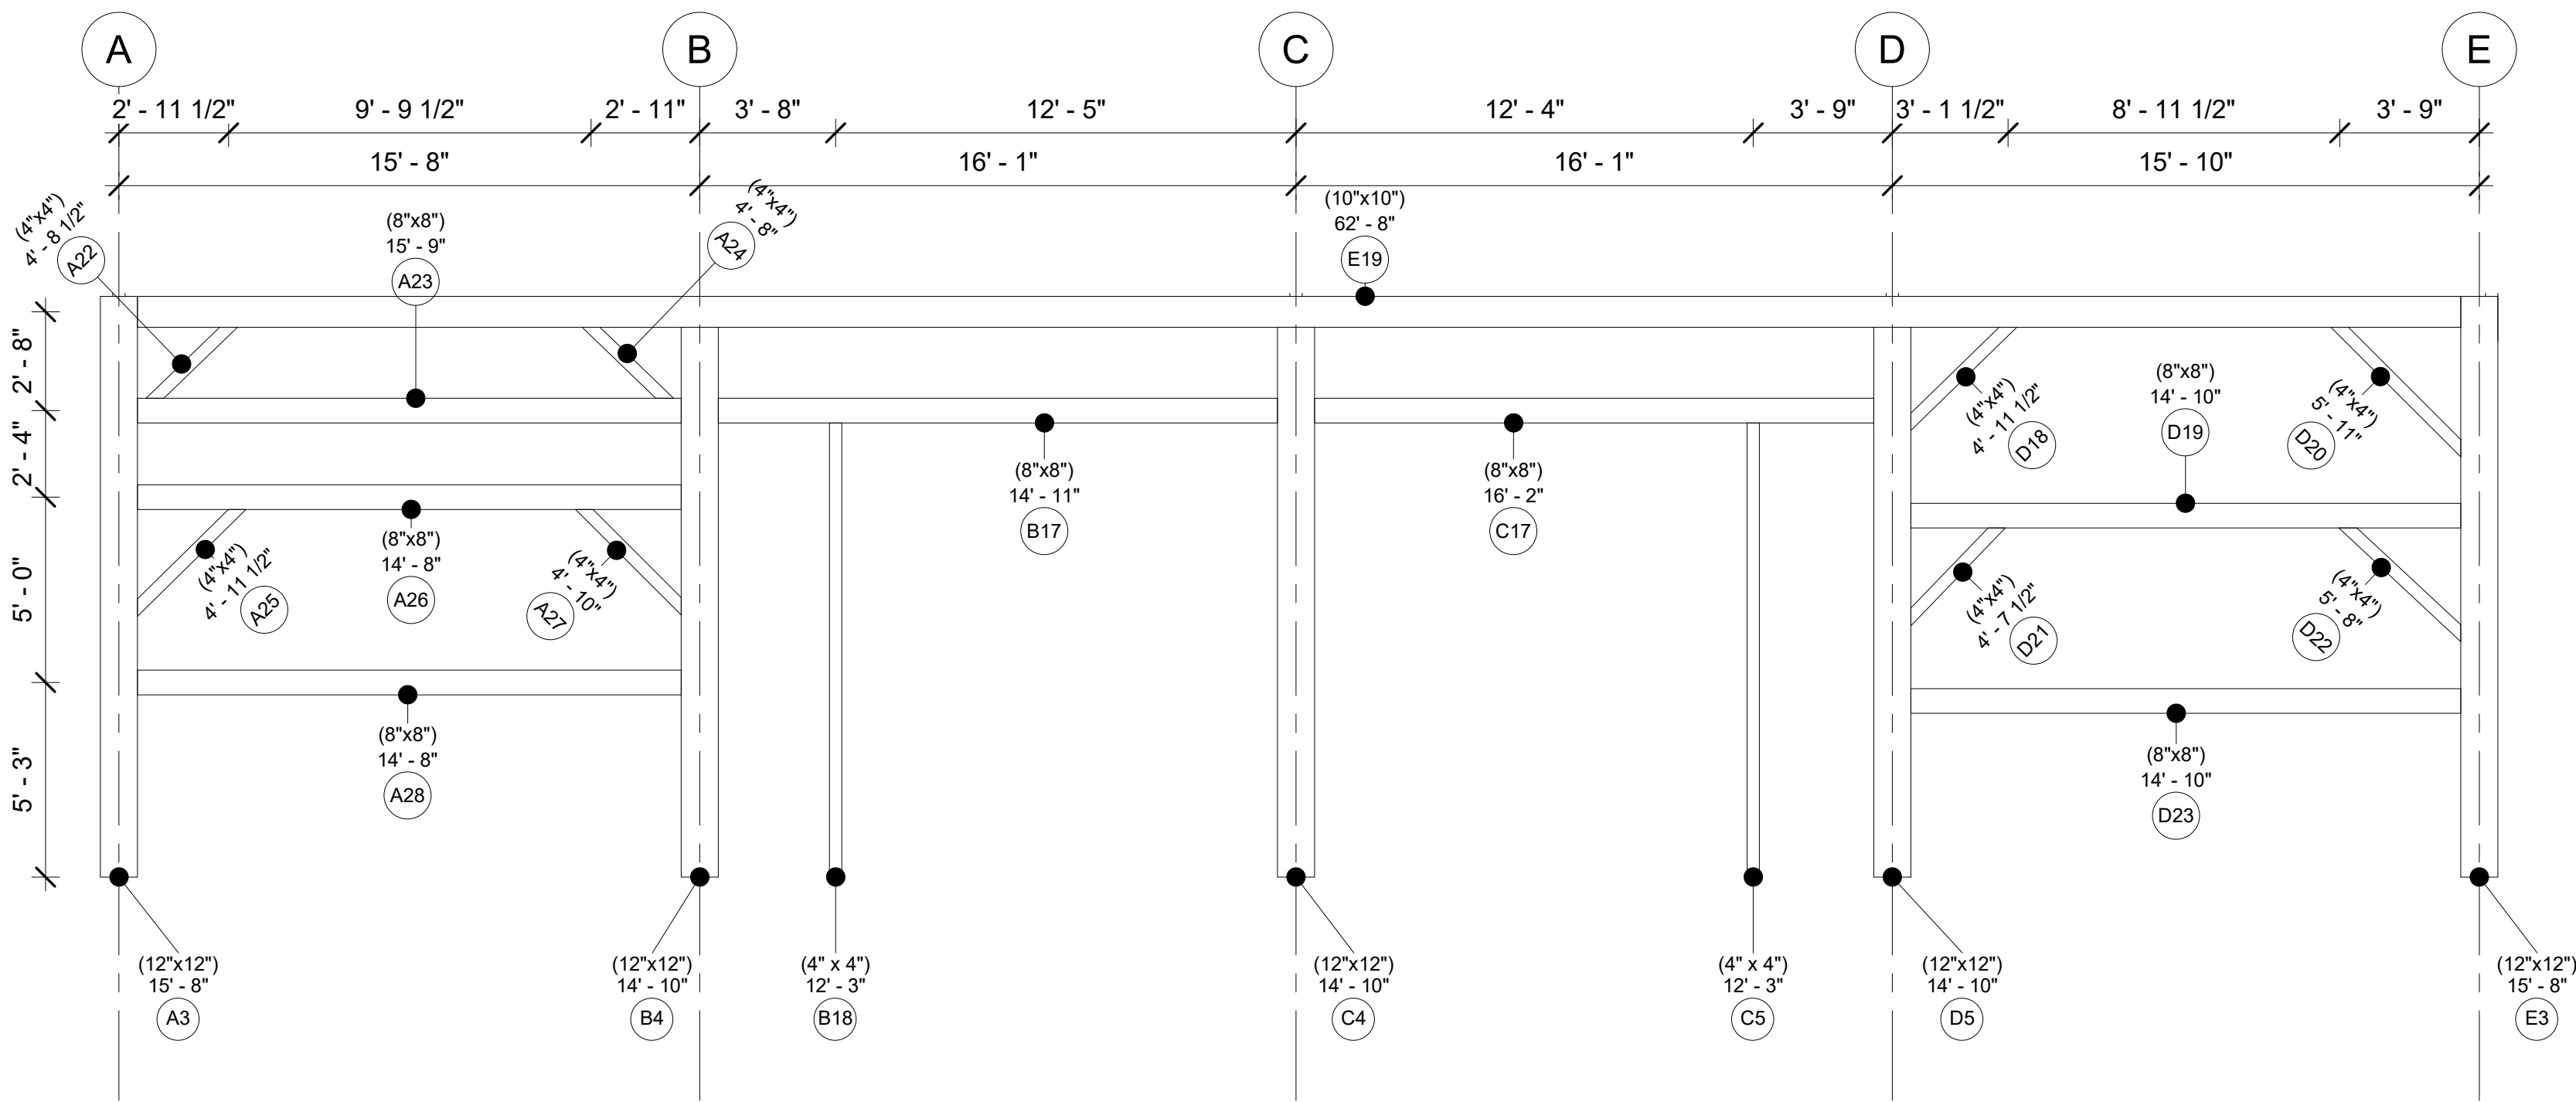

Whitetail Hollow

Bent 3

Project Number	Project 16
Date	20250623
Drawn By	
Checked By	
A109	
Scale	1/4" = 1'-0"