


PROJECT: Heritage Haven
SCOPE: AS BUILT DRAWINGS

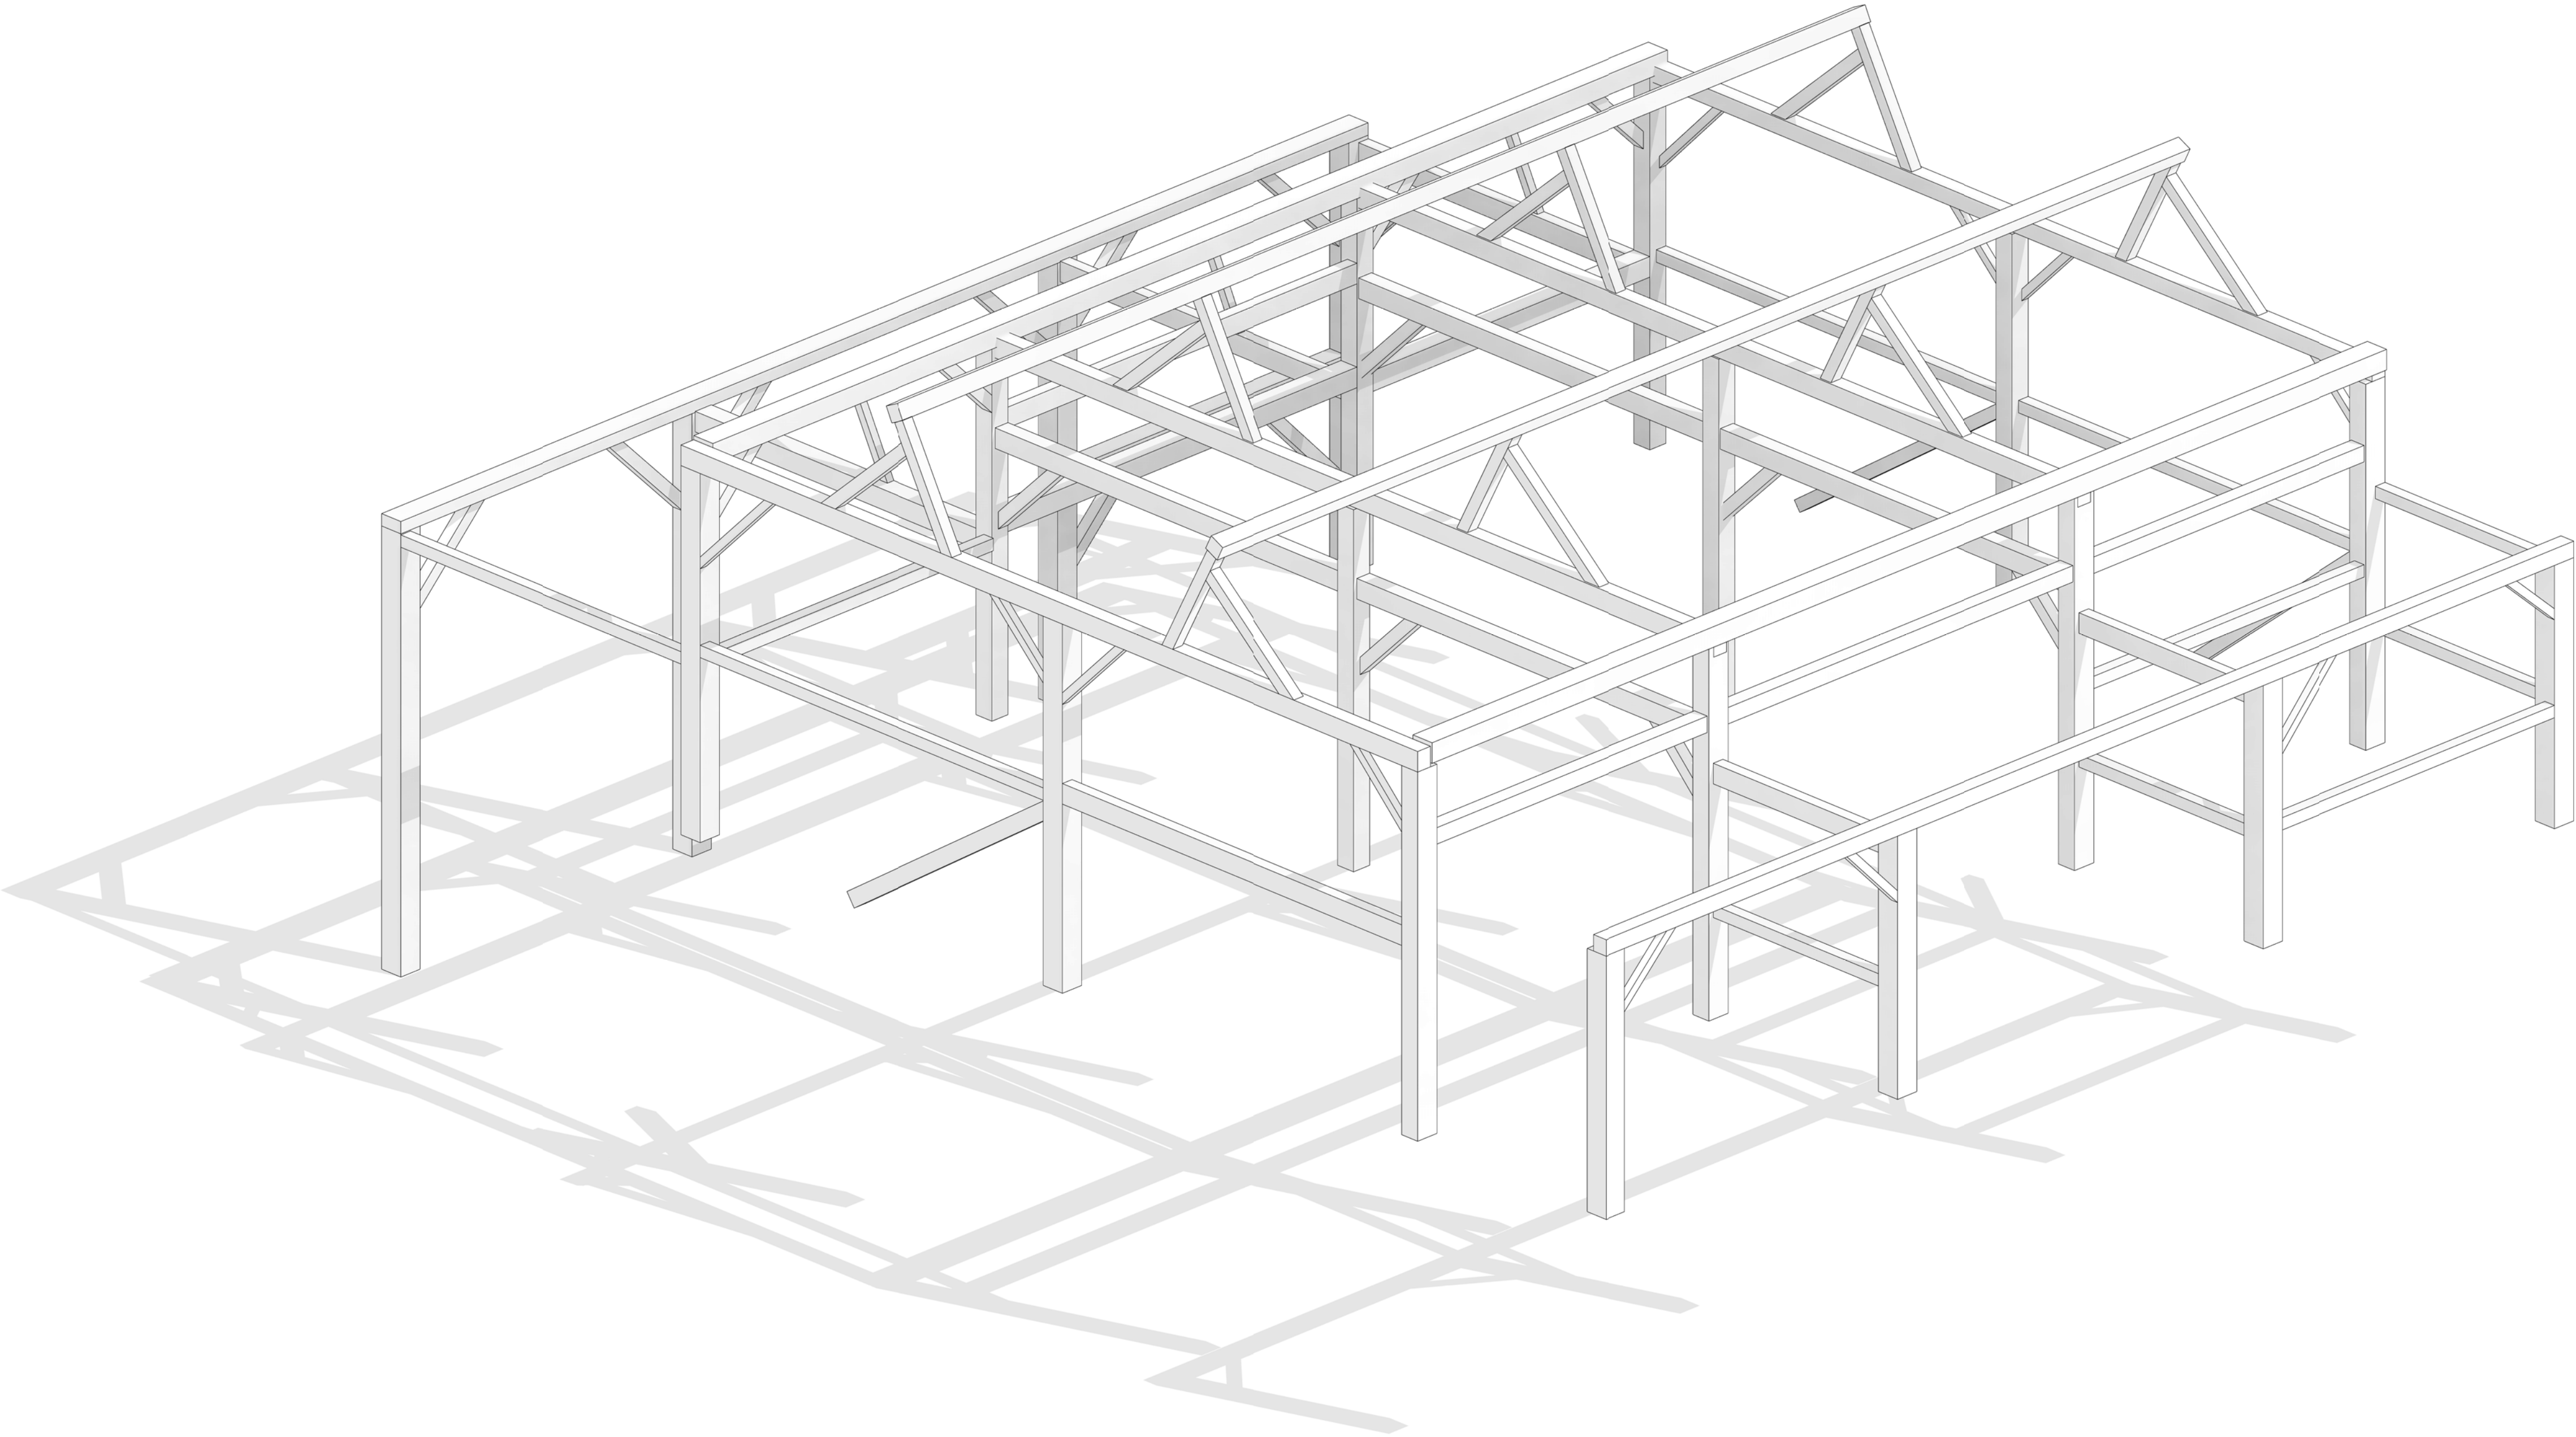

Heritage Haven


Cover Page

Project Number	Project 18
Date	20250724
Drawn By	
Checked By	
A101	
Scale	

Heritage Haven

Floor Plan

Project Number	Project 18
Date	20250724
Drawn By	
Checked By	
A102	
Scale	1/4" = 1'-0"

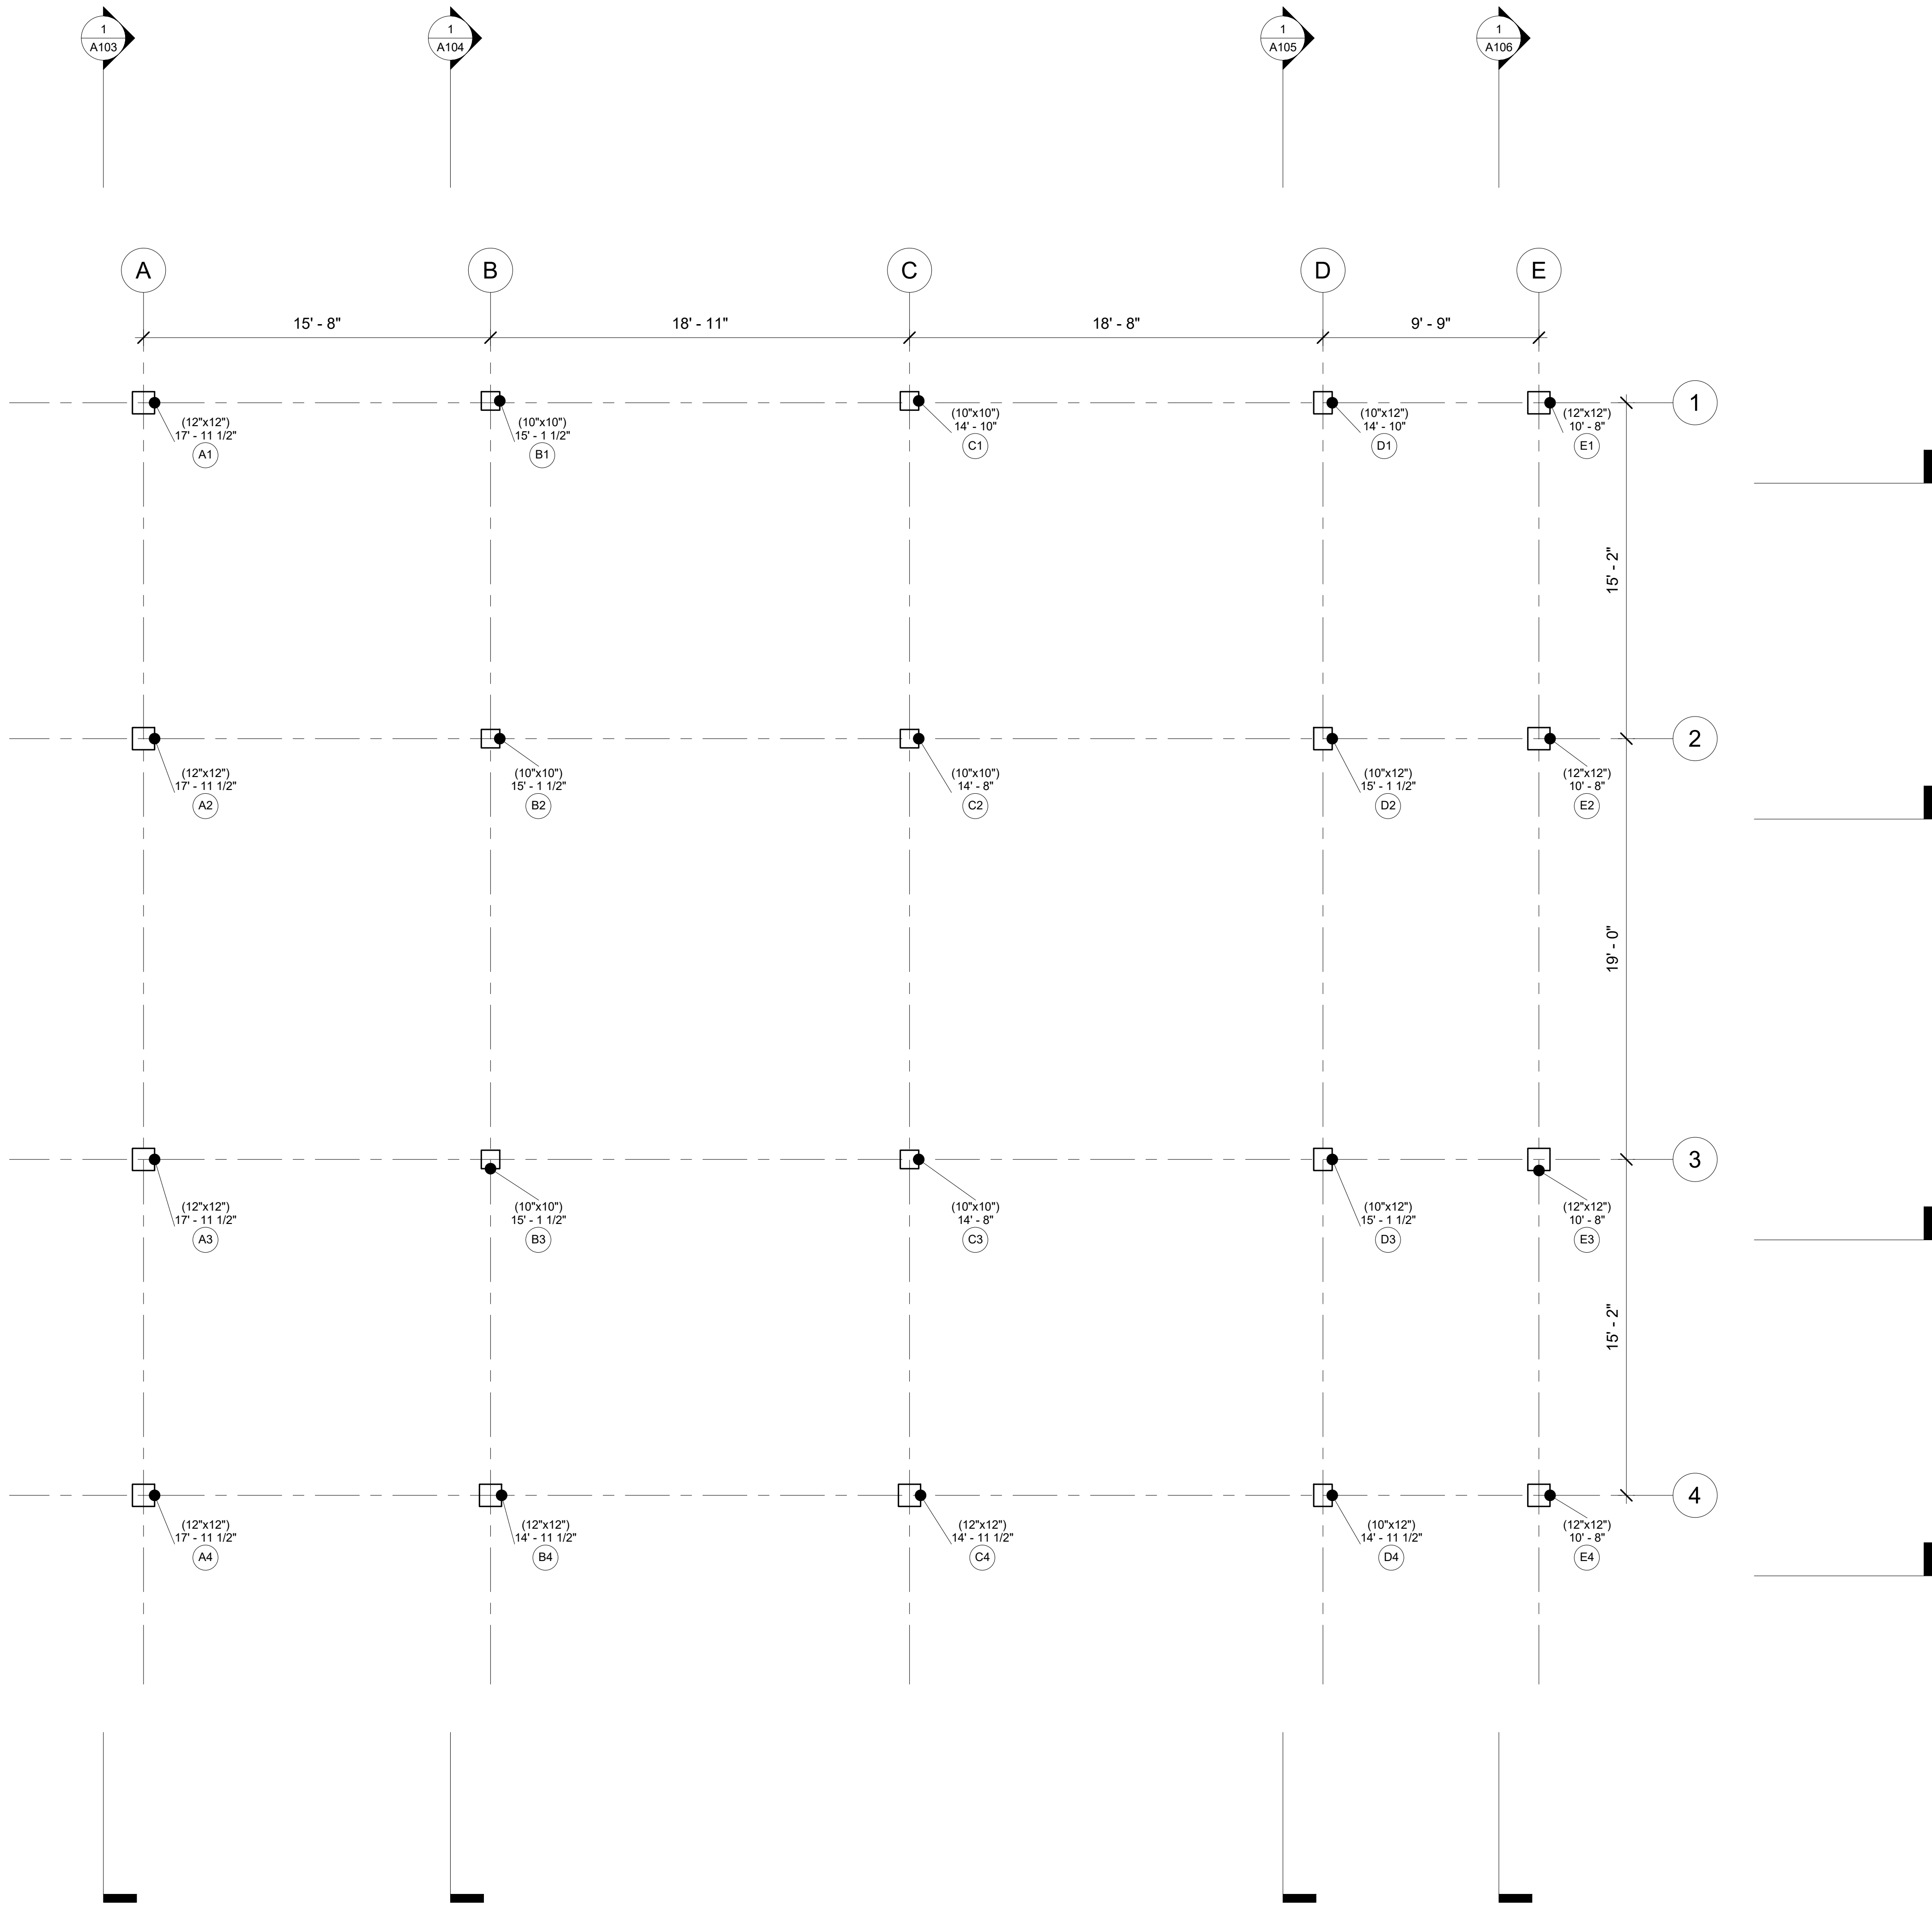


Bent A


Date	20250724
------	----------

Checked By

A103

Scale	1/4" = 1'-0"
-------	--------------

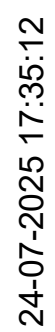


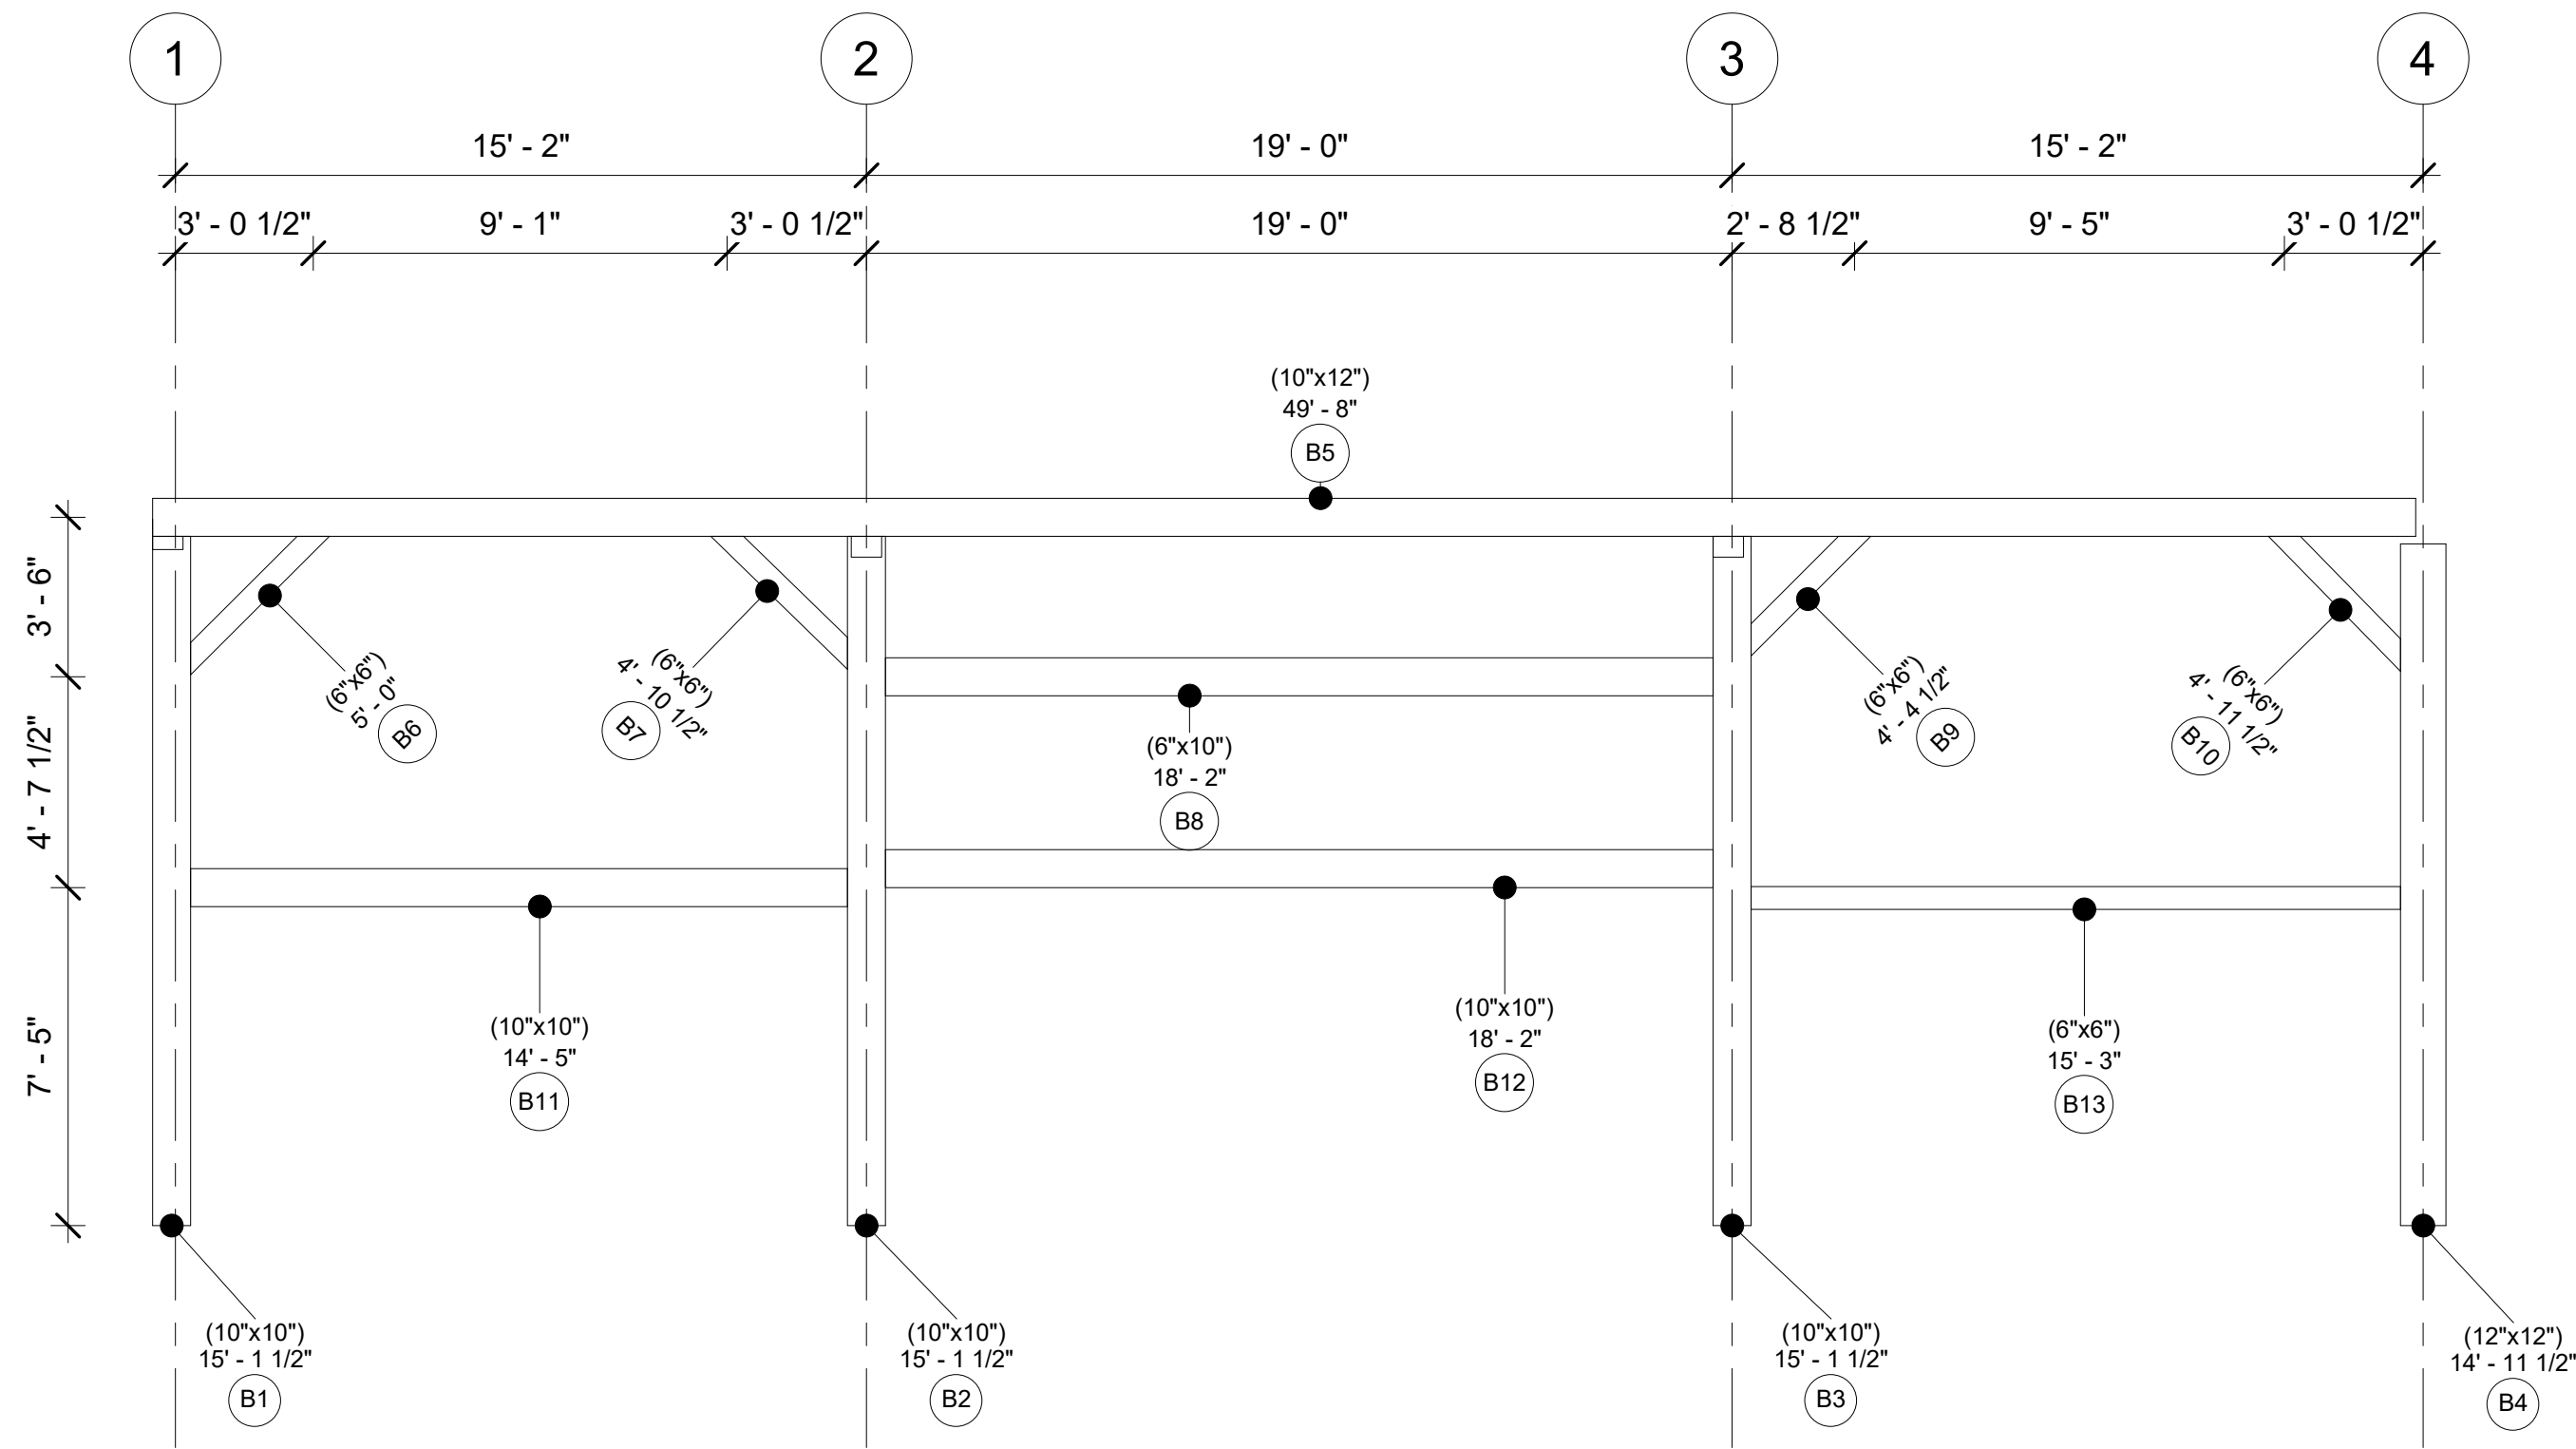

Heritage Haven

Bent B


Project Number	Project 18
Date	20250724
Drawn By	
Checked By	
A104	
Scale	1/4" = 1'-0"

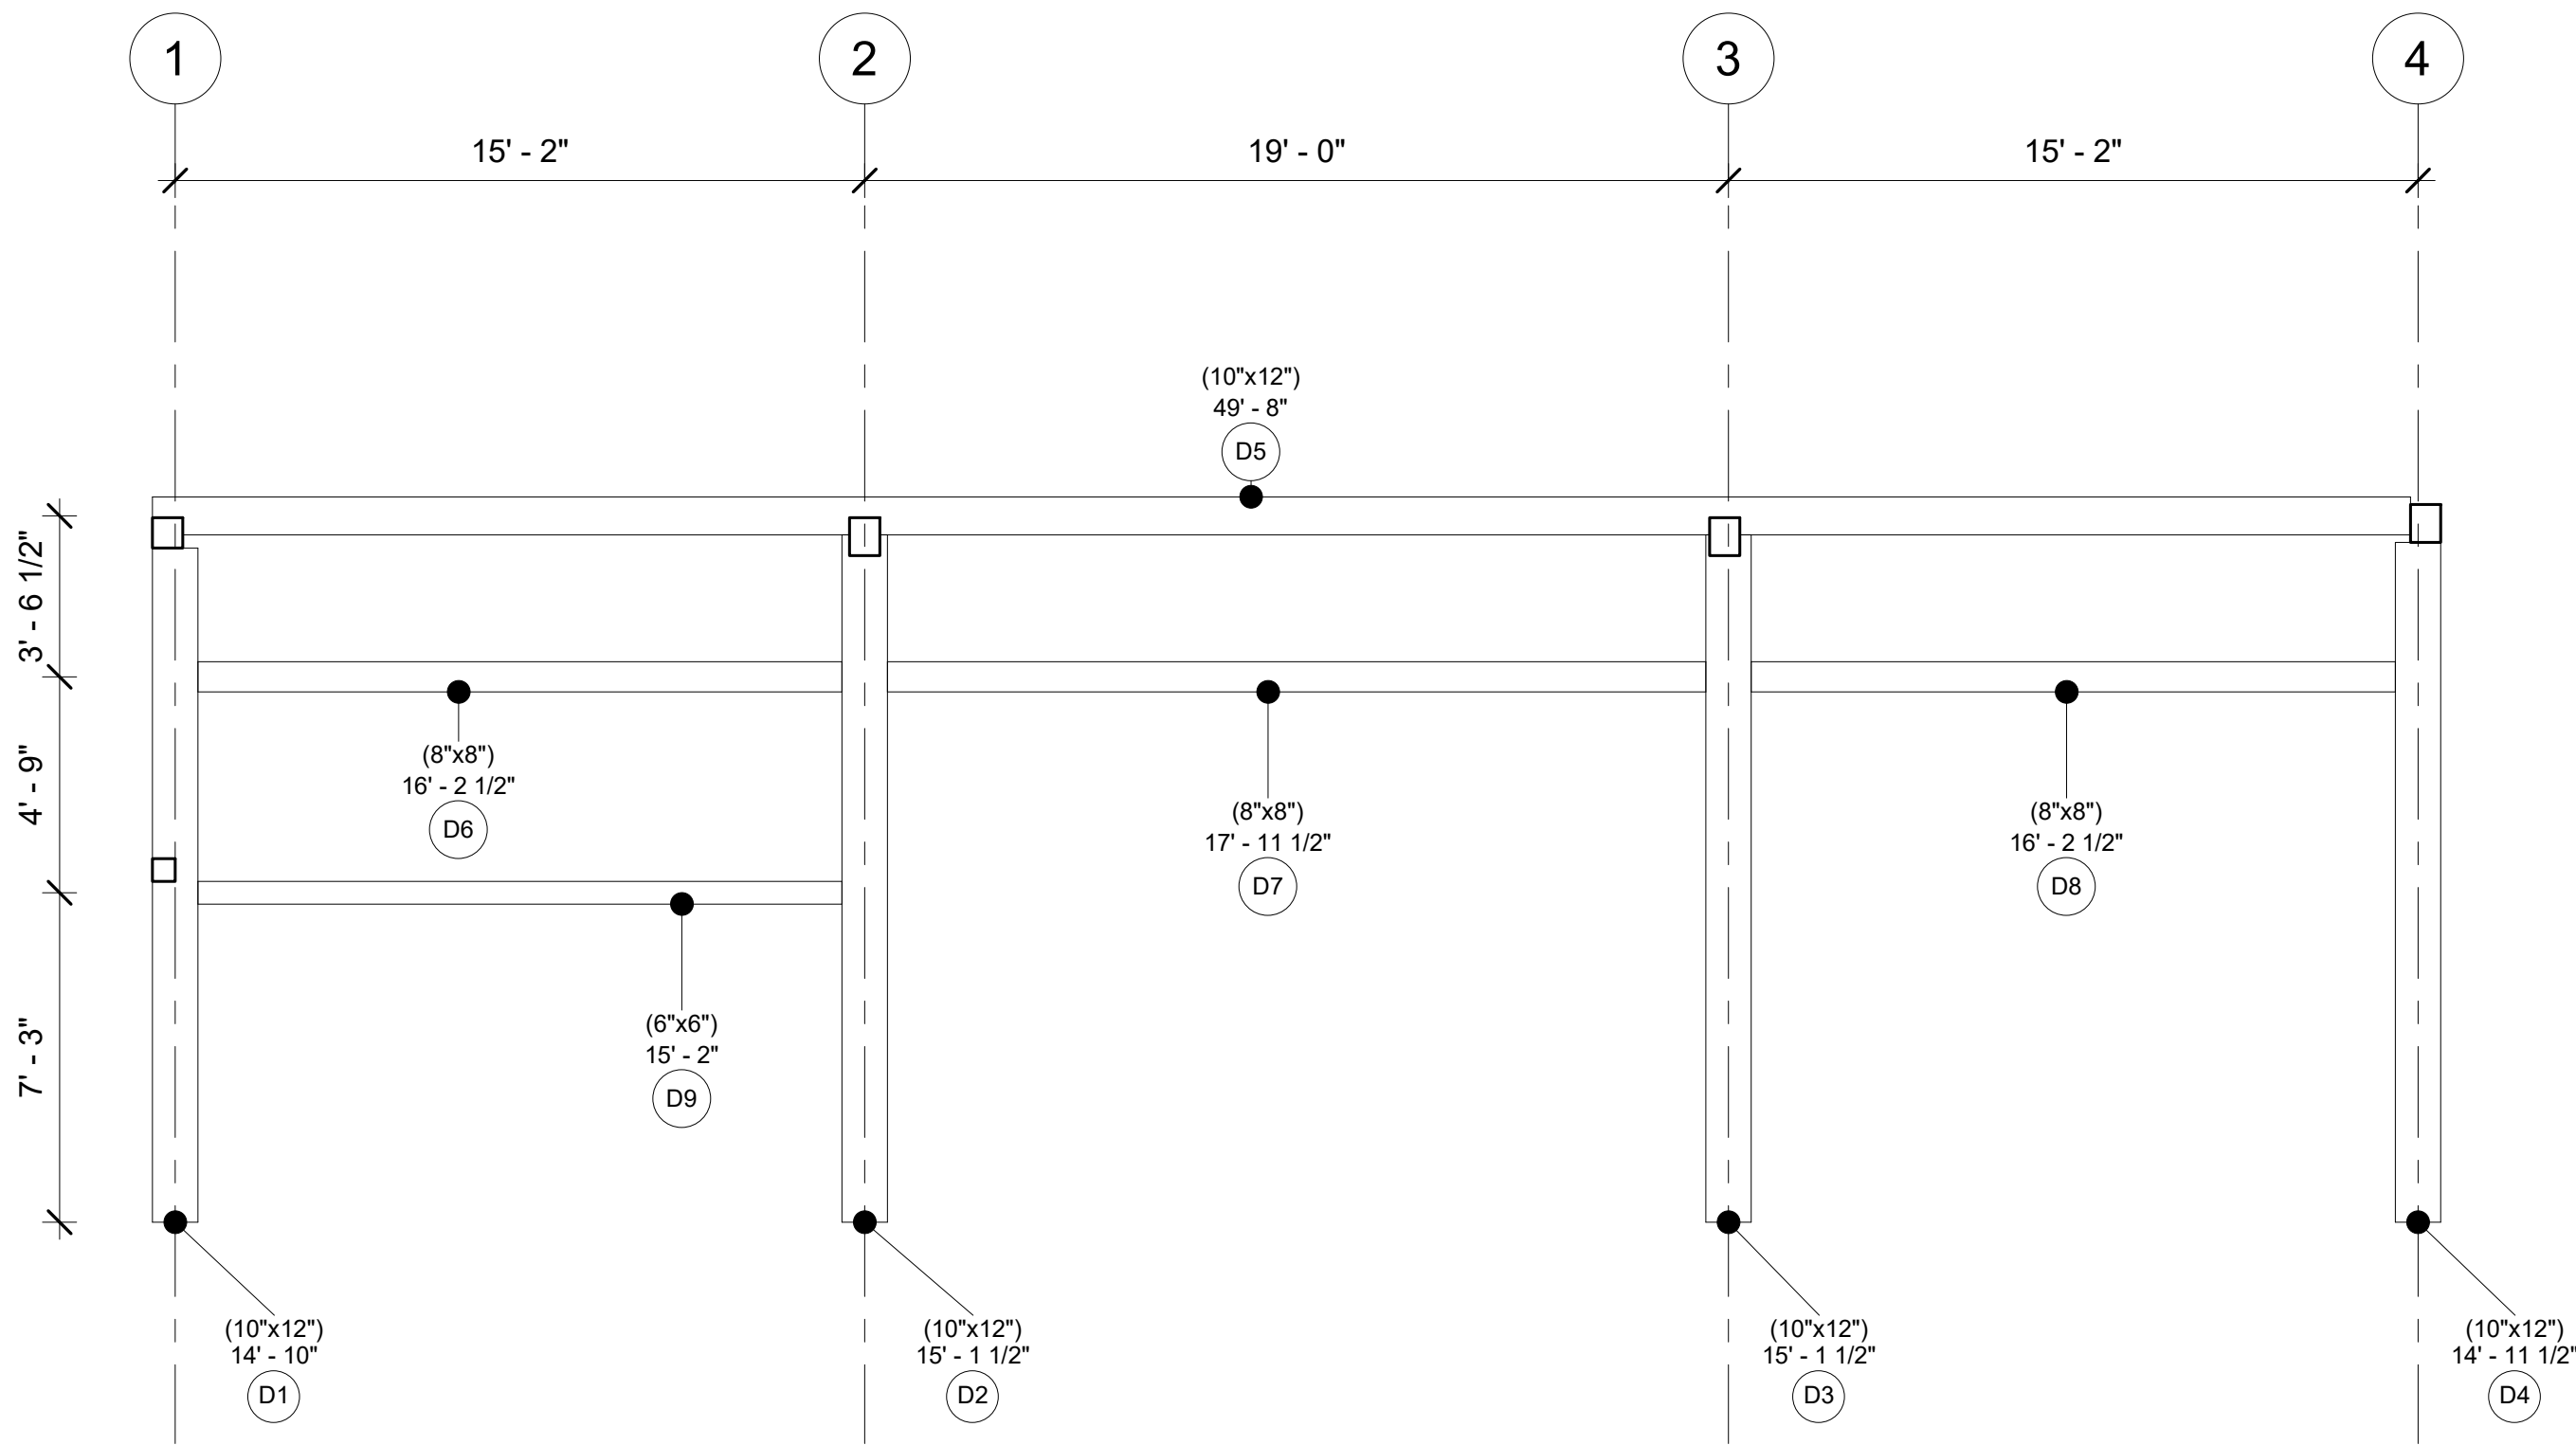

Heritage Haven

Bent D


Project Number	Project 18
Date	20250724
Drawn By	
Checked By	
A105	
Scale	1/4" = 1'-0"

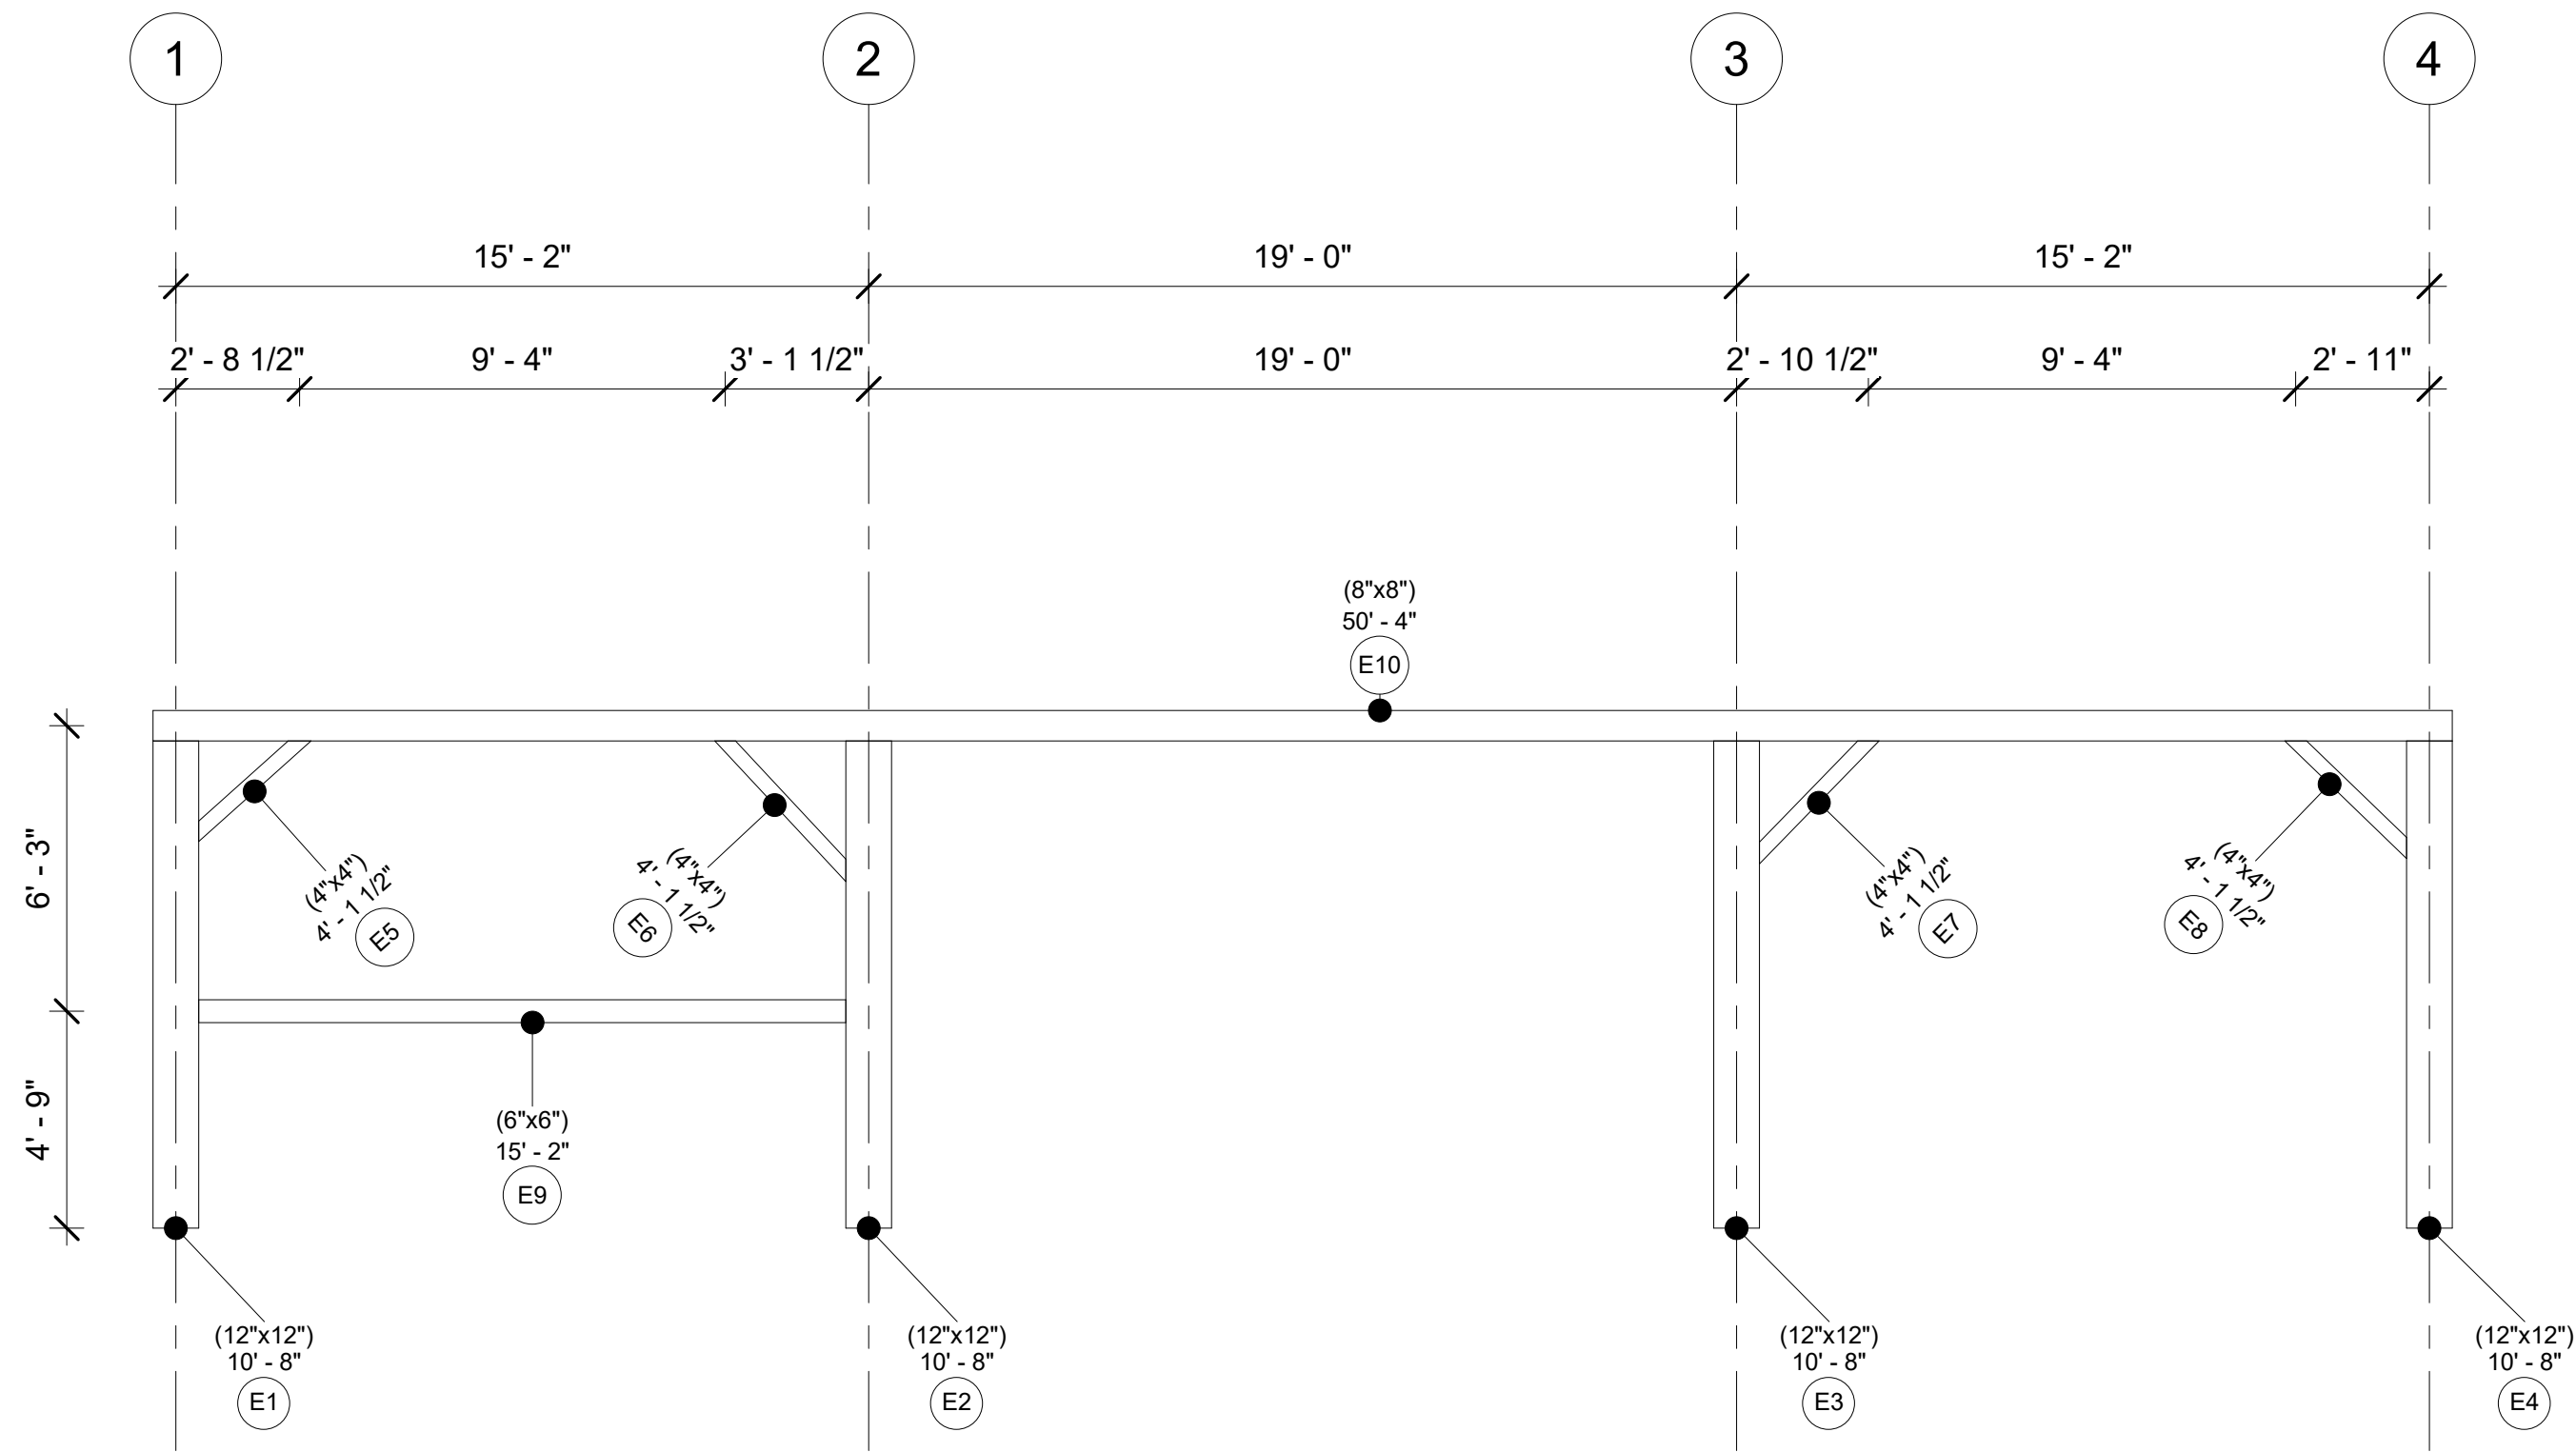

Heritage Haven

Bent E


Project Number	Project 18
Date	20250724
Drawn By	
Checked By	
A106	
Scale	1/4" = 1'-0"

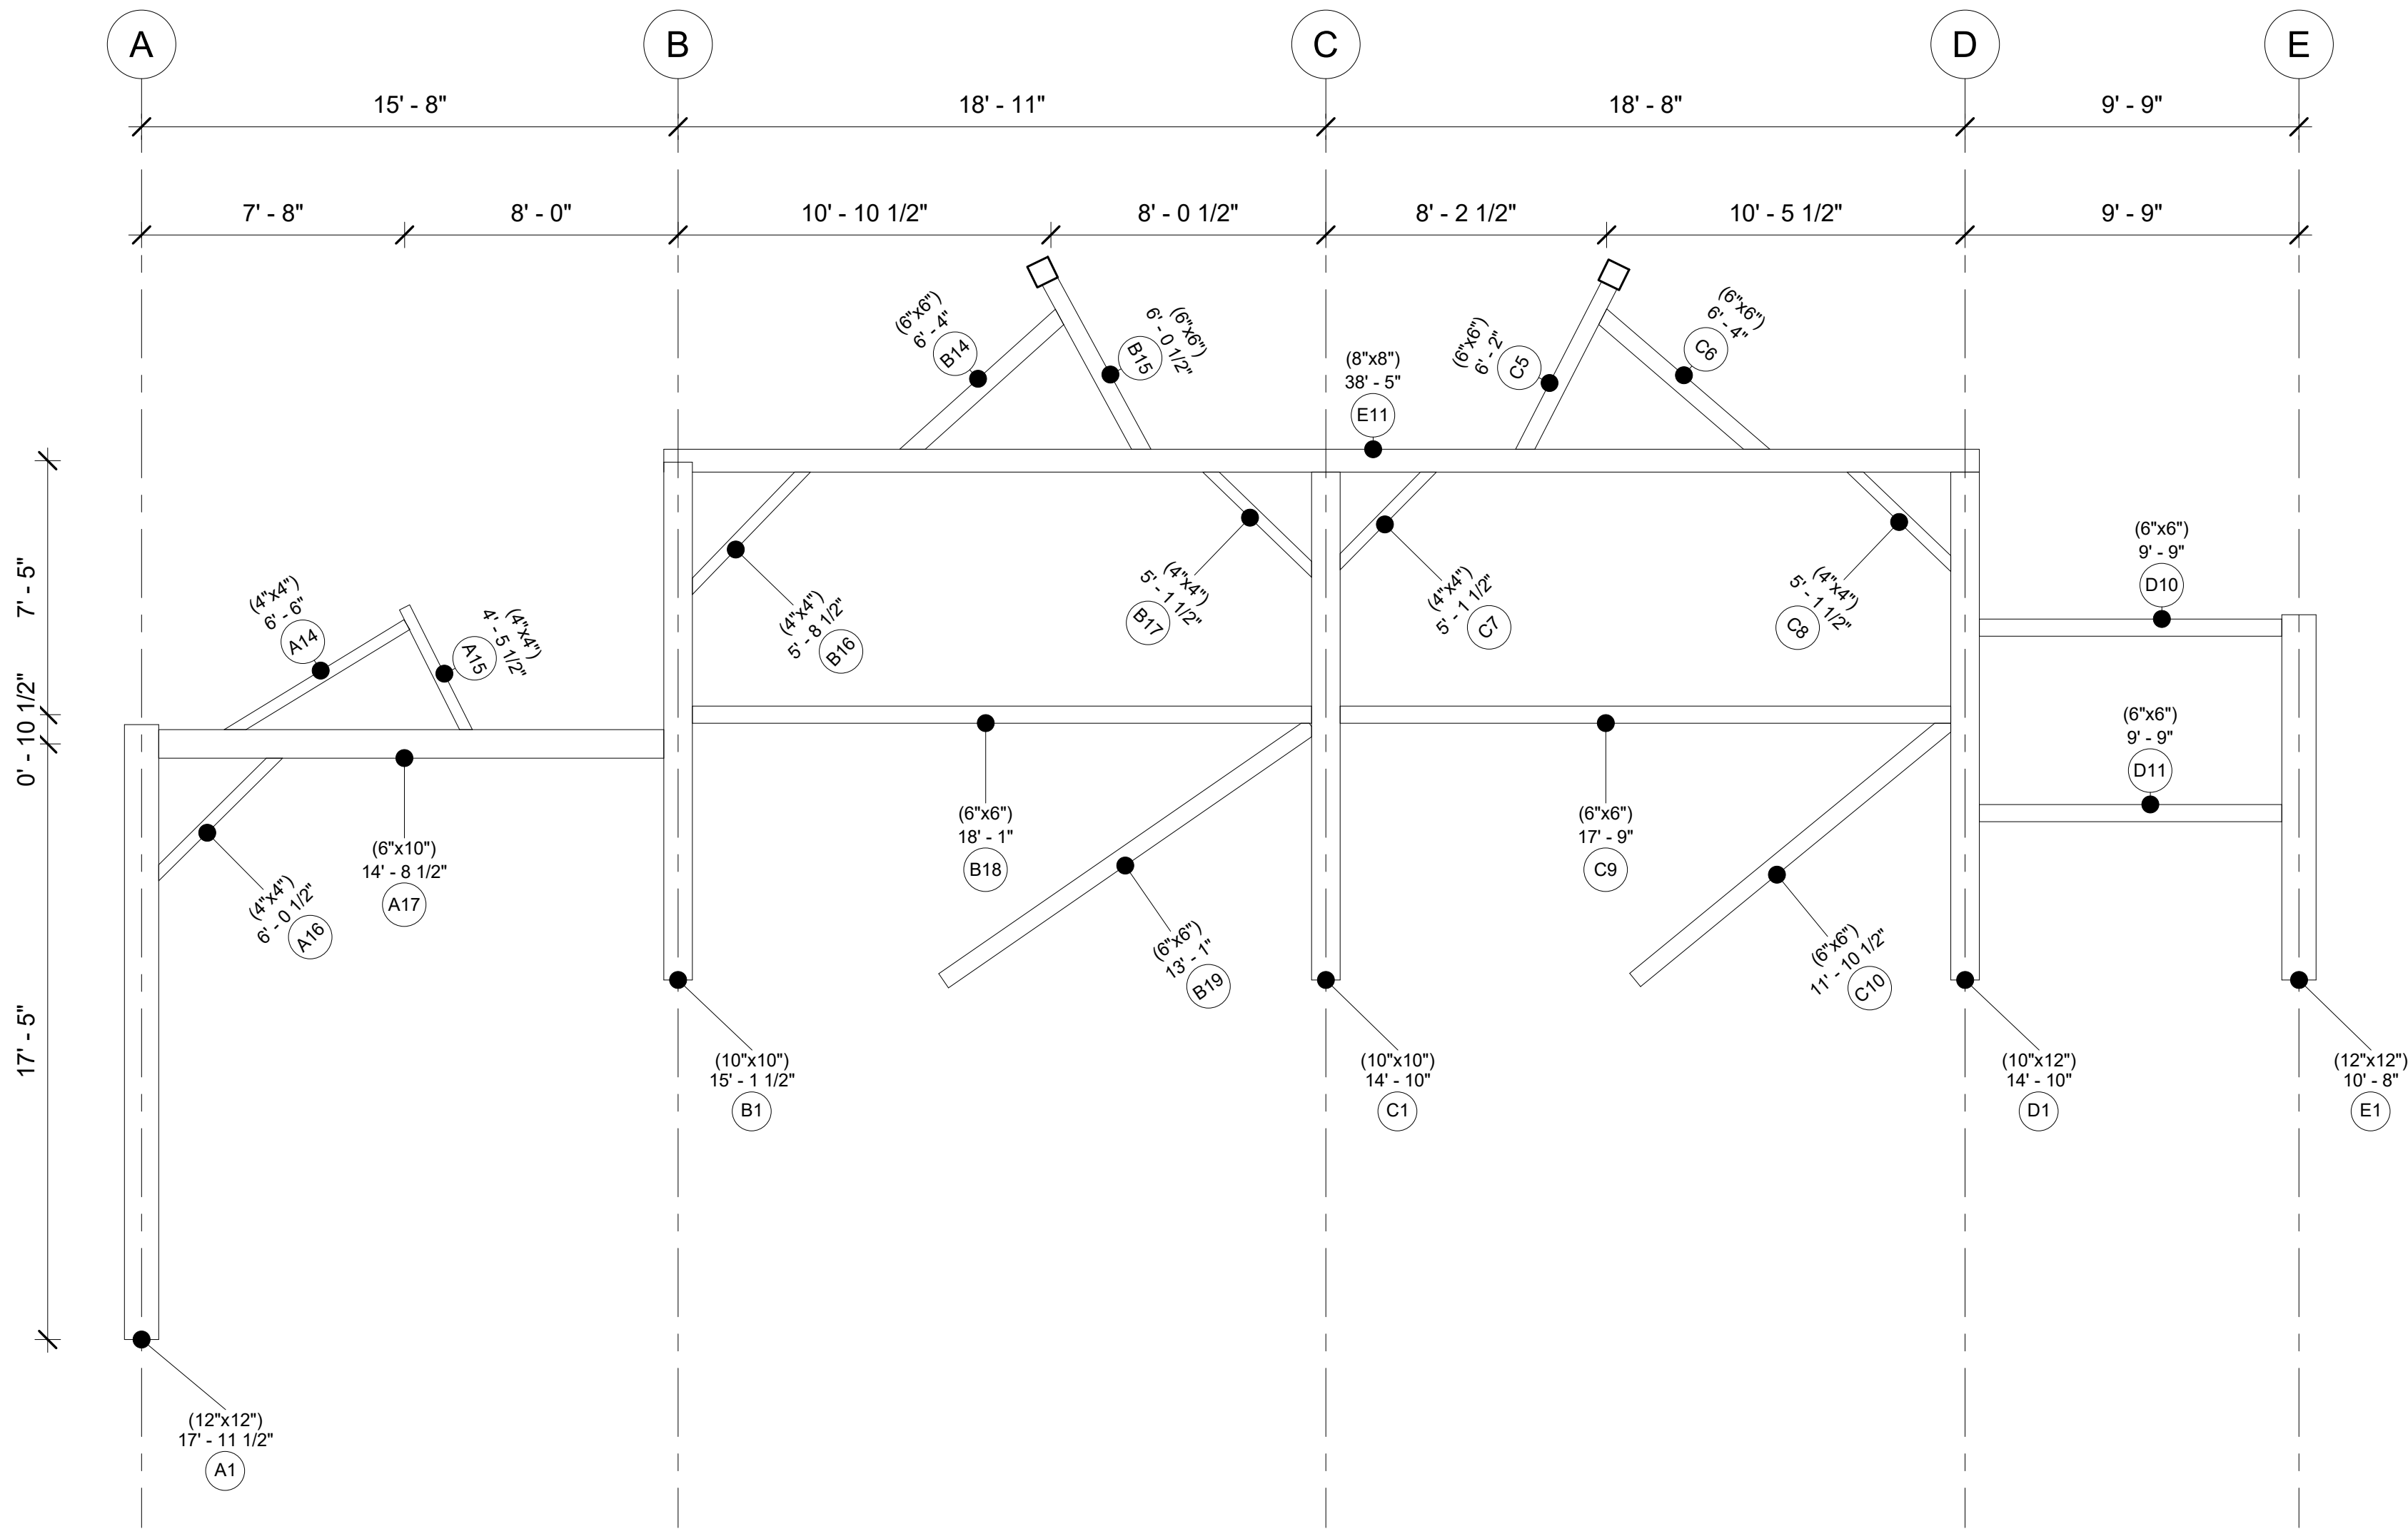

Heritage Haven

Bent 1


Project Number	Project 18
Date	20250724
Drawn By	
Checked By	
A107	
Scale	1/4" = 1'-0"

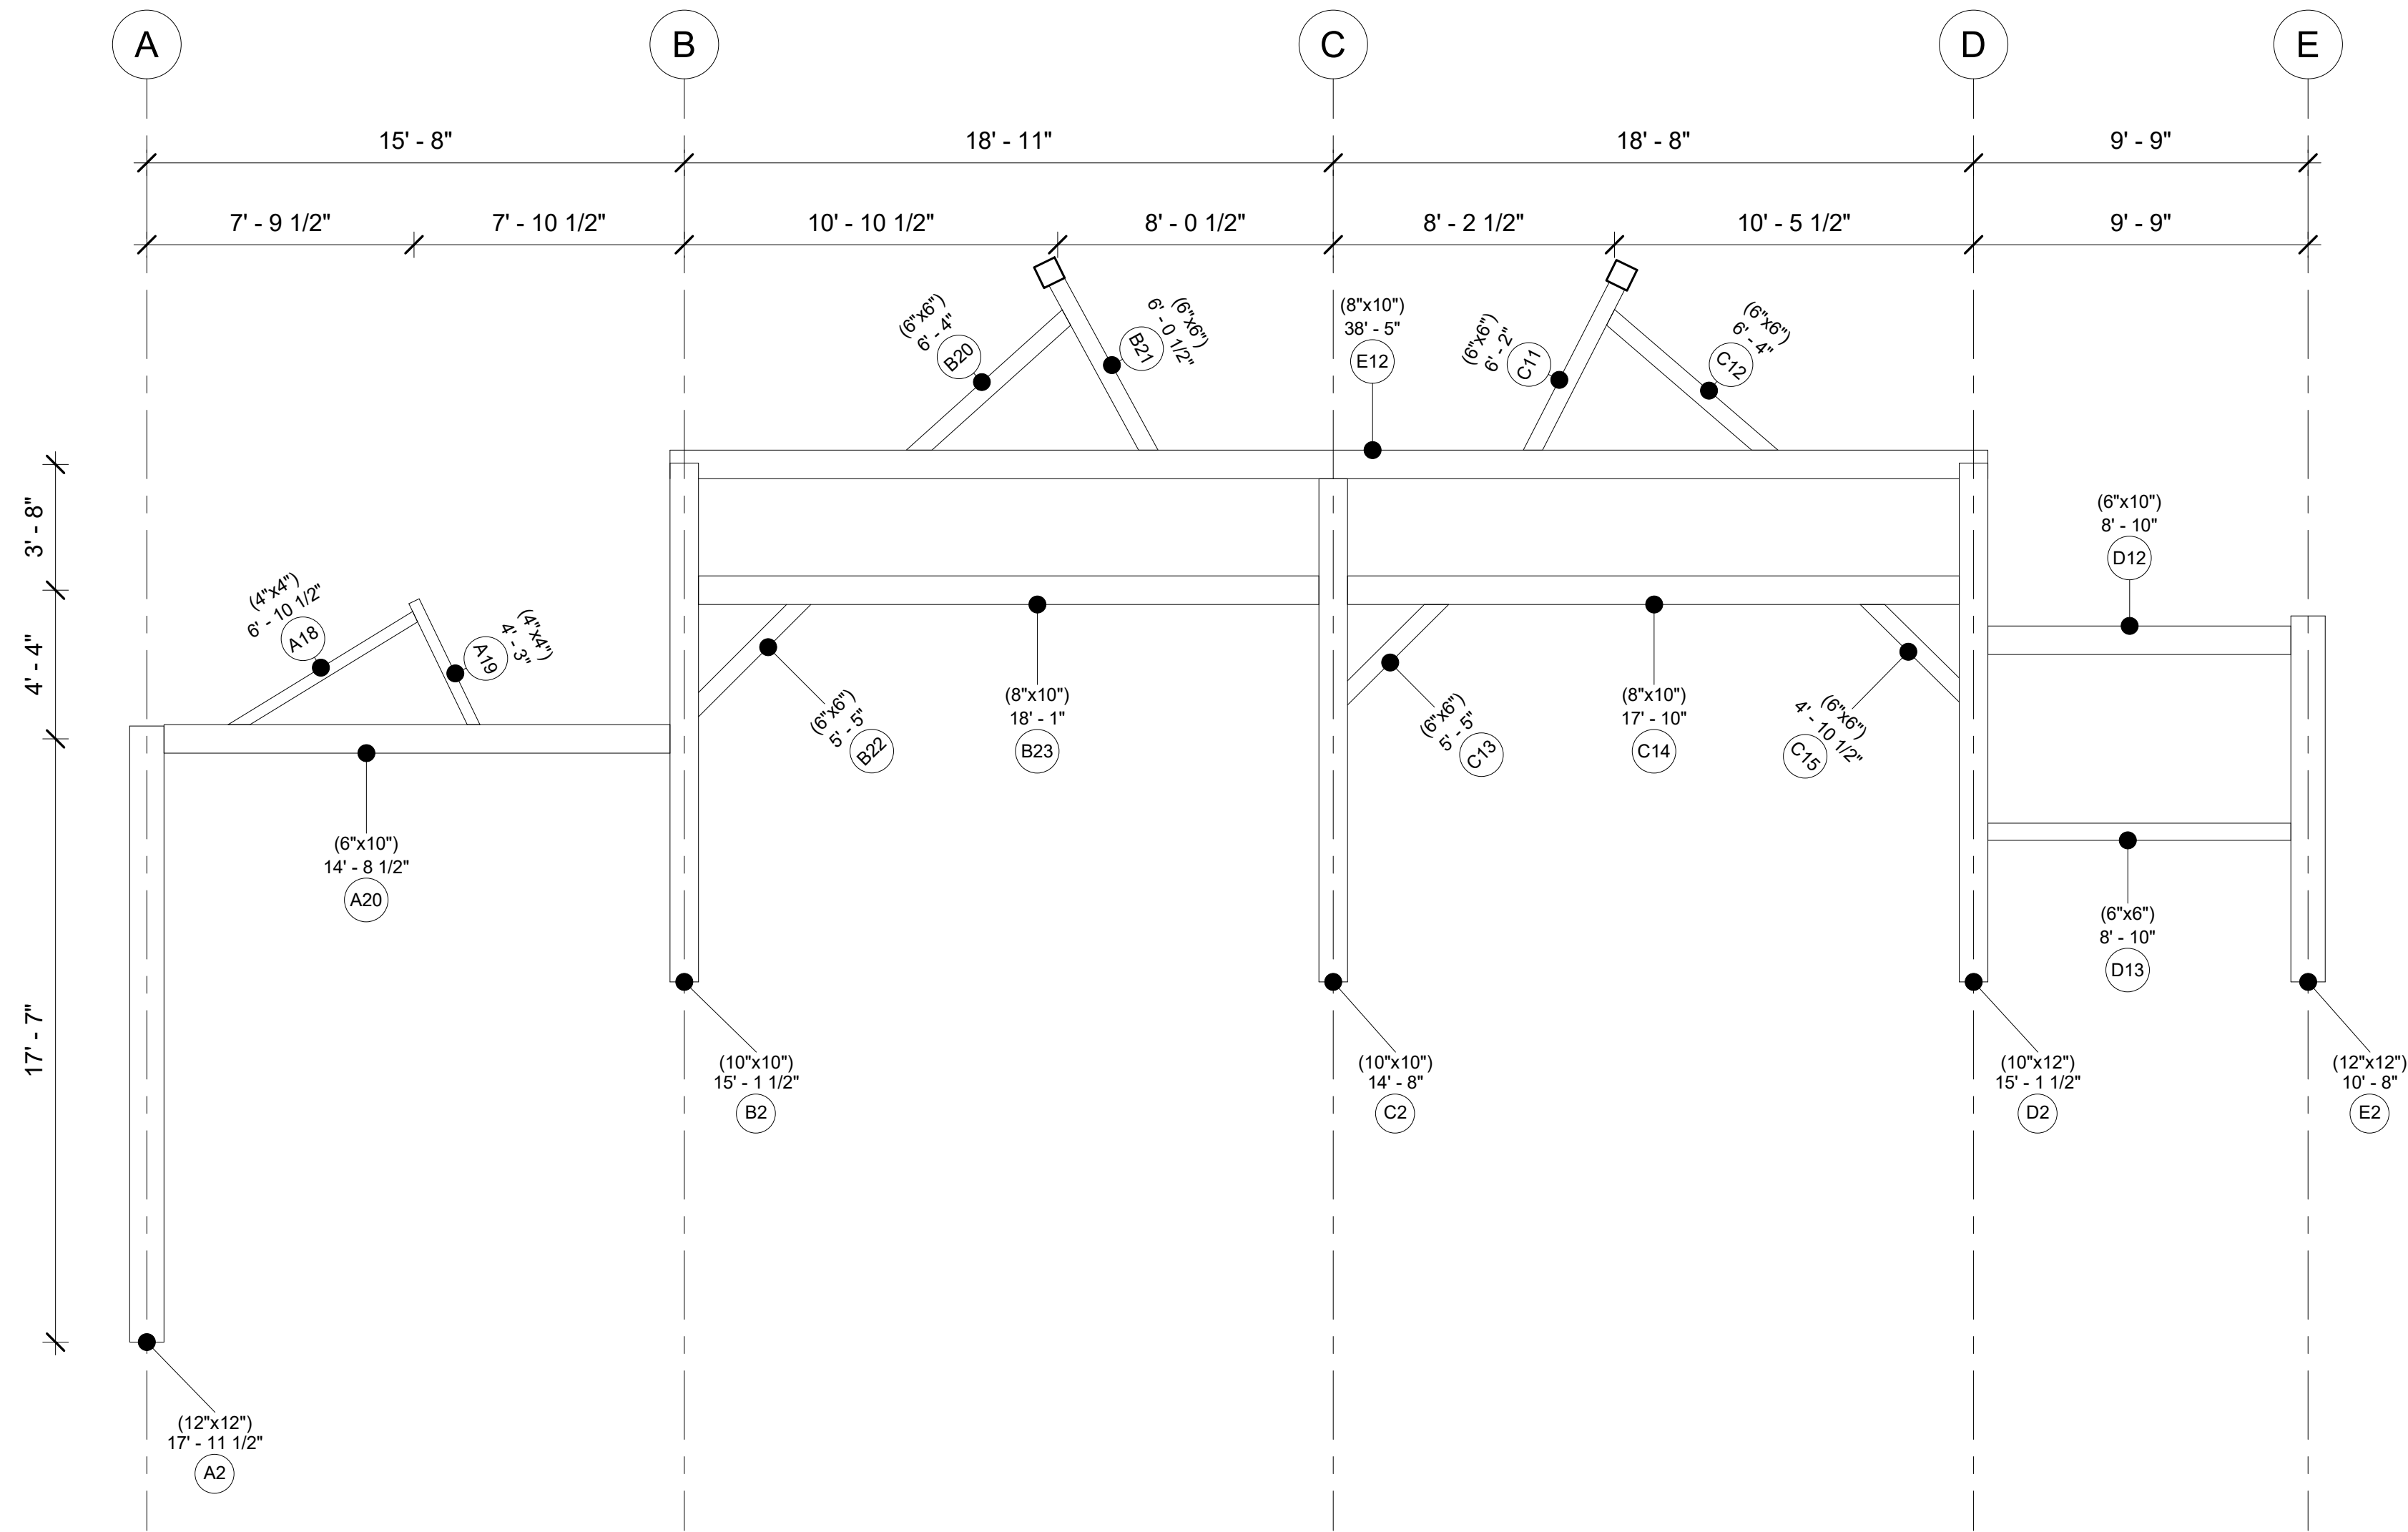

Heritage Haven

Bent 2


Project Number	Project 18
Date	20250724
Drawn By	
Checked By	
A108	
Scale	1/4" = 1'-0"

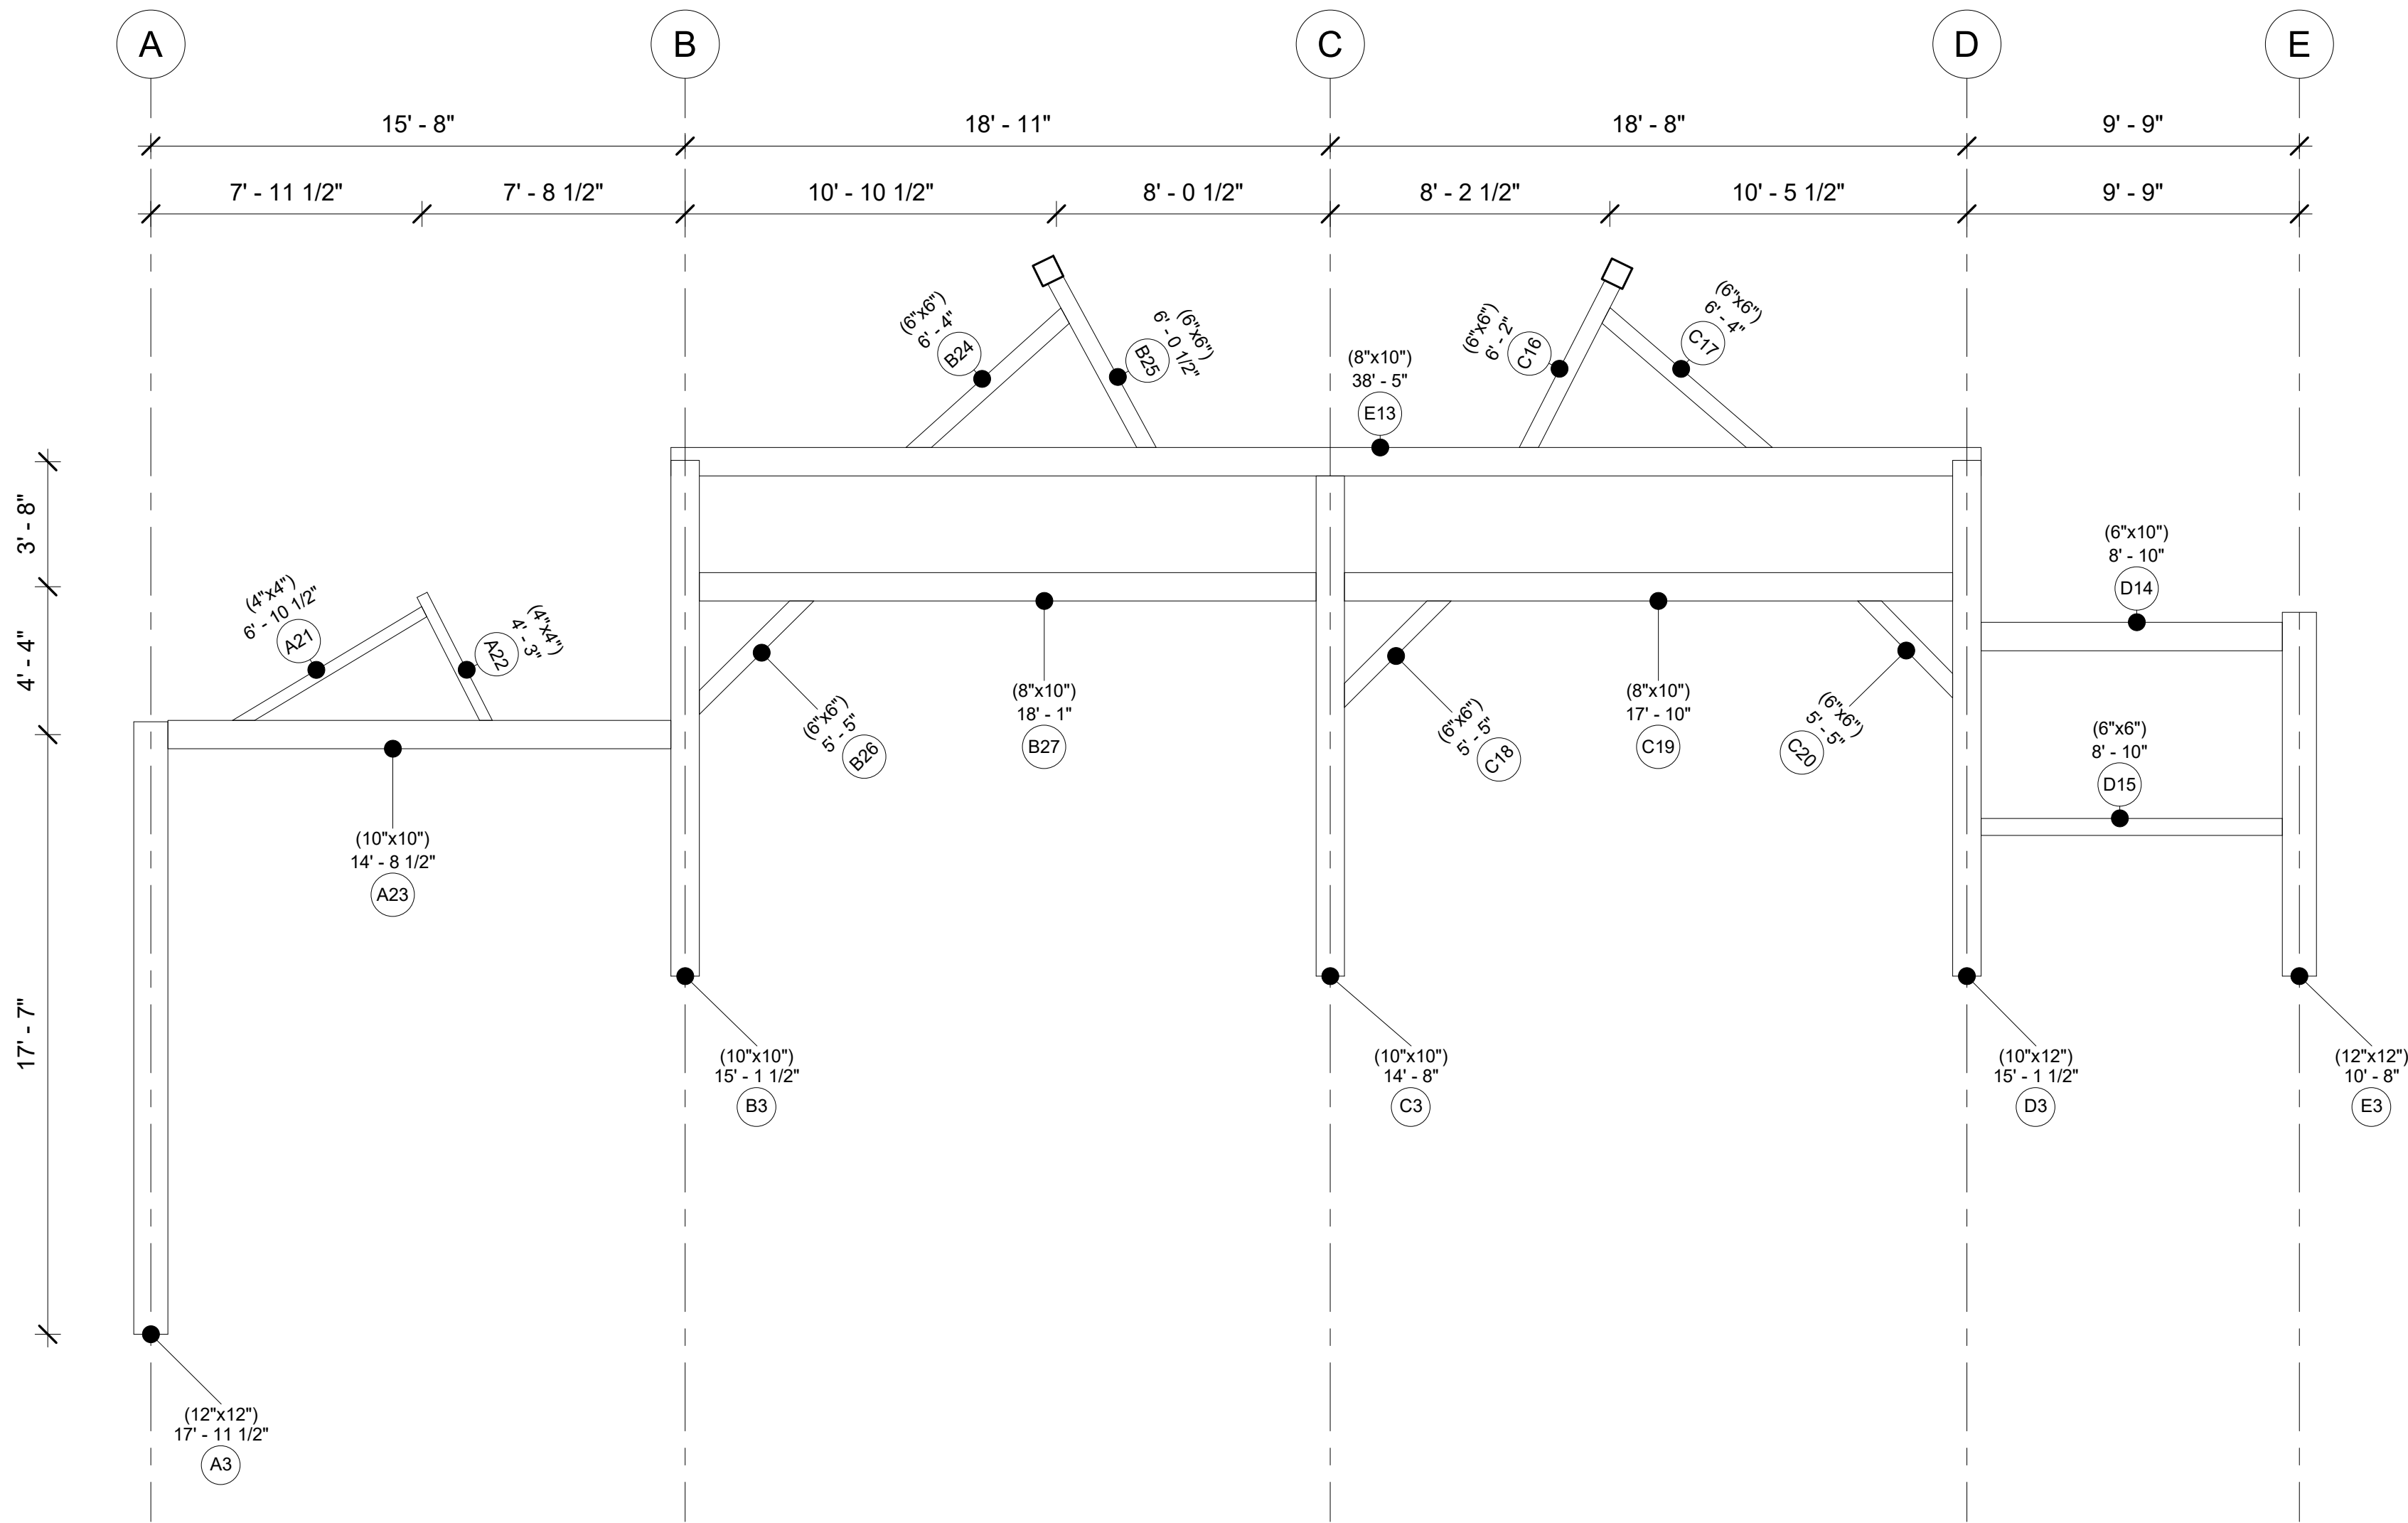

Heritage Haven

Bent 3

Project Number	Project 18
Date	20250724
Drawn By	
Checked By	
A109	
Scale	1/4" = 1'-0"

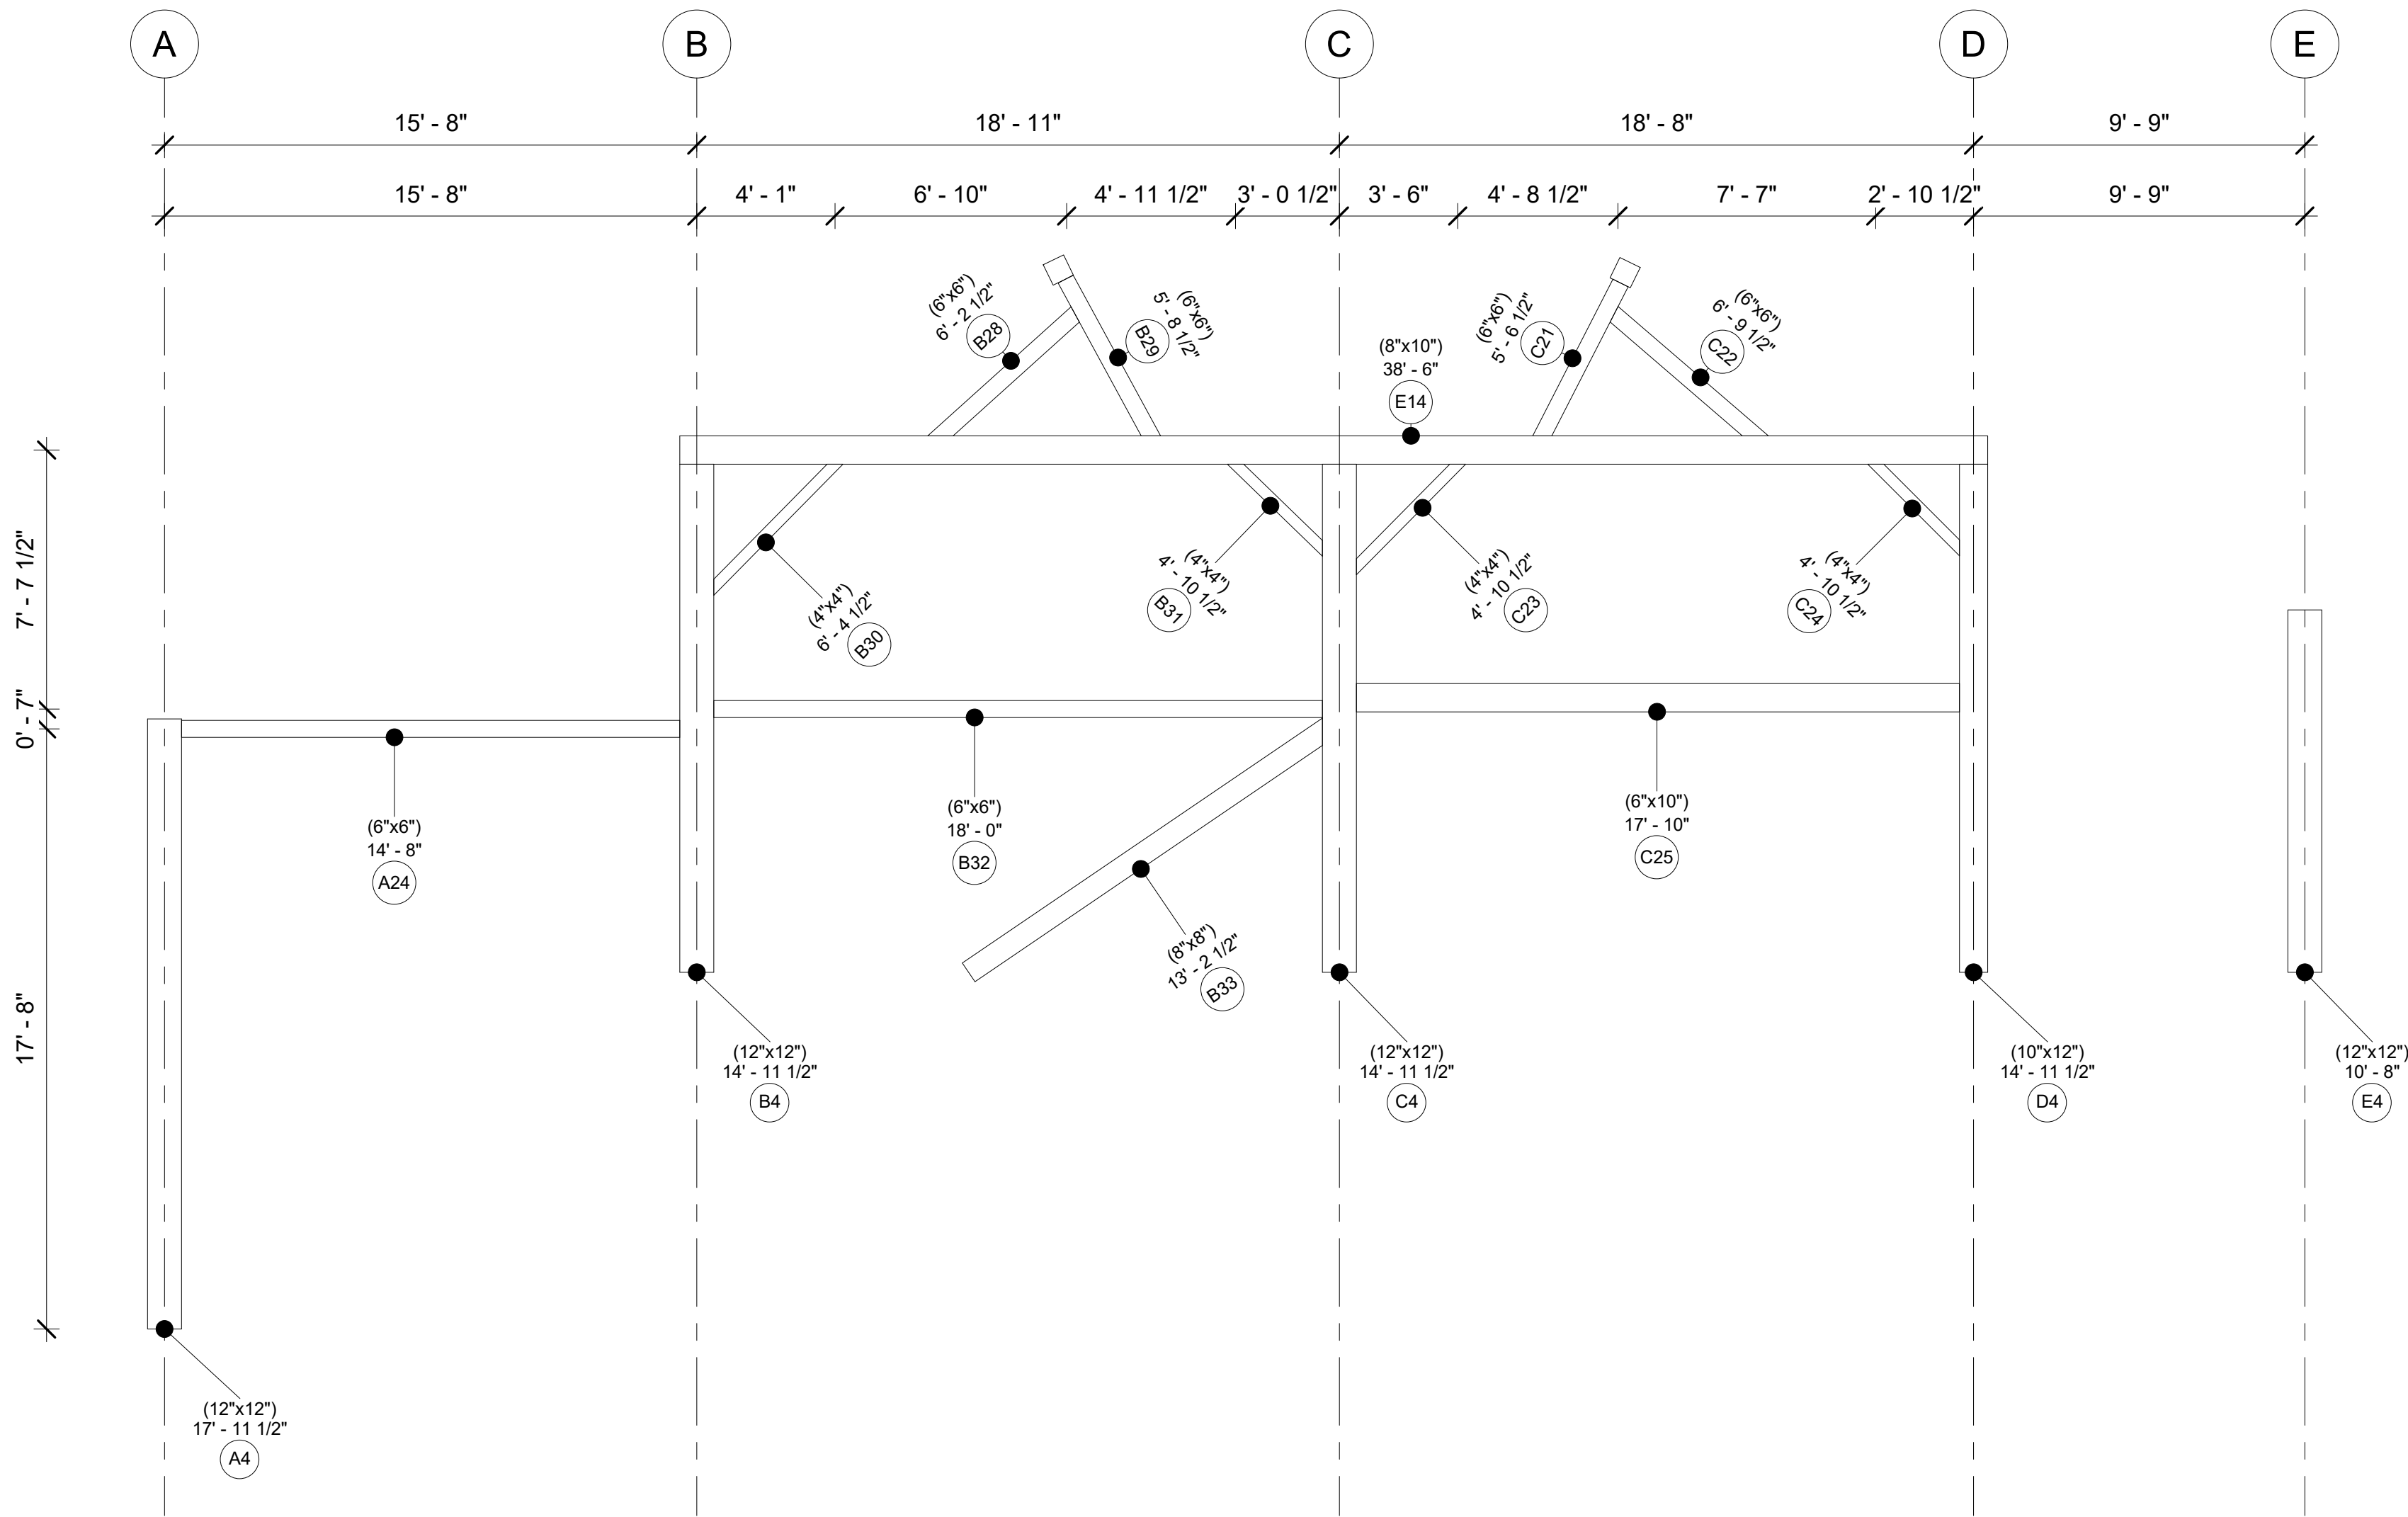

Heritage Haven

Bent 4

Project Number	Project 18
Date	20250724
Drawn By	
Checked By	
A110	
Scale	1/4" = 1'-0"