


PROJECT: Sawmill Run
SCOPE: AS BUILT DRAWINGS

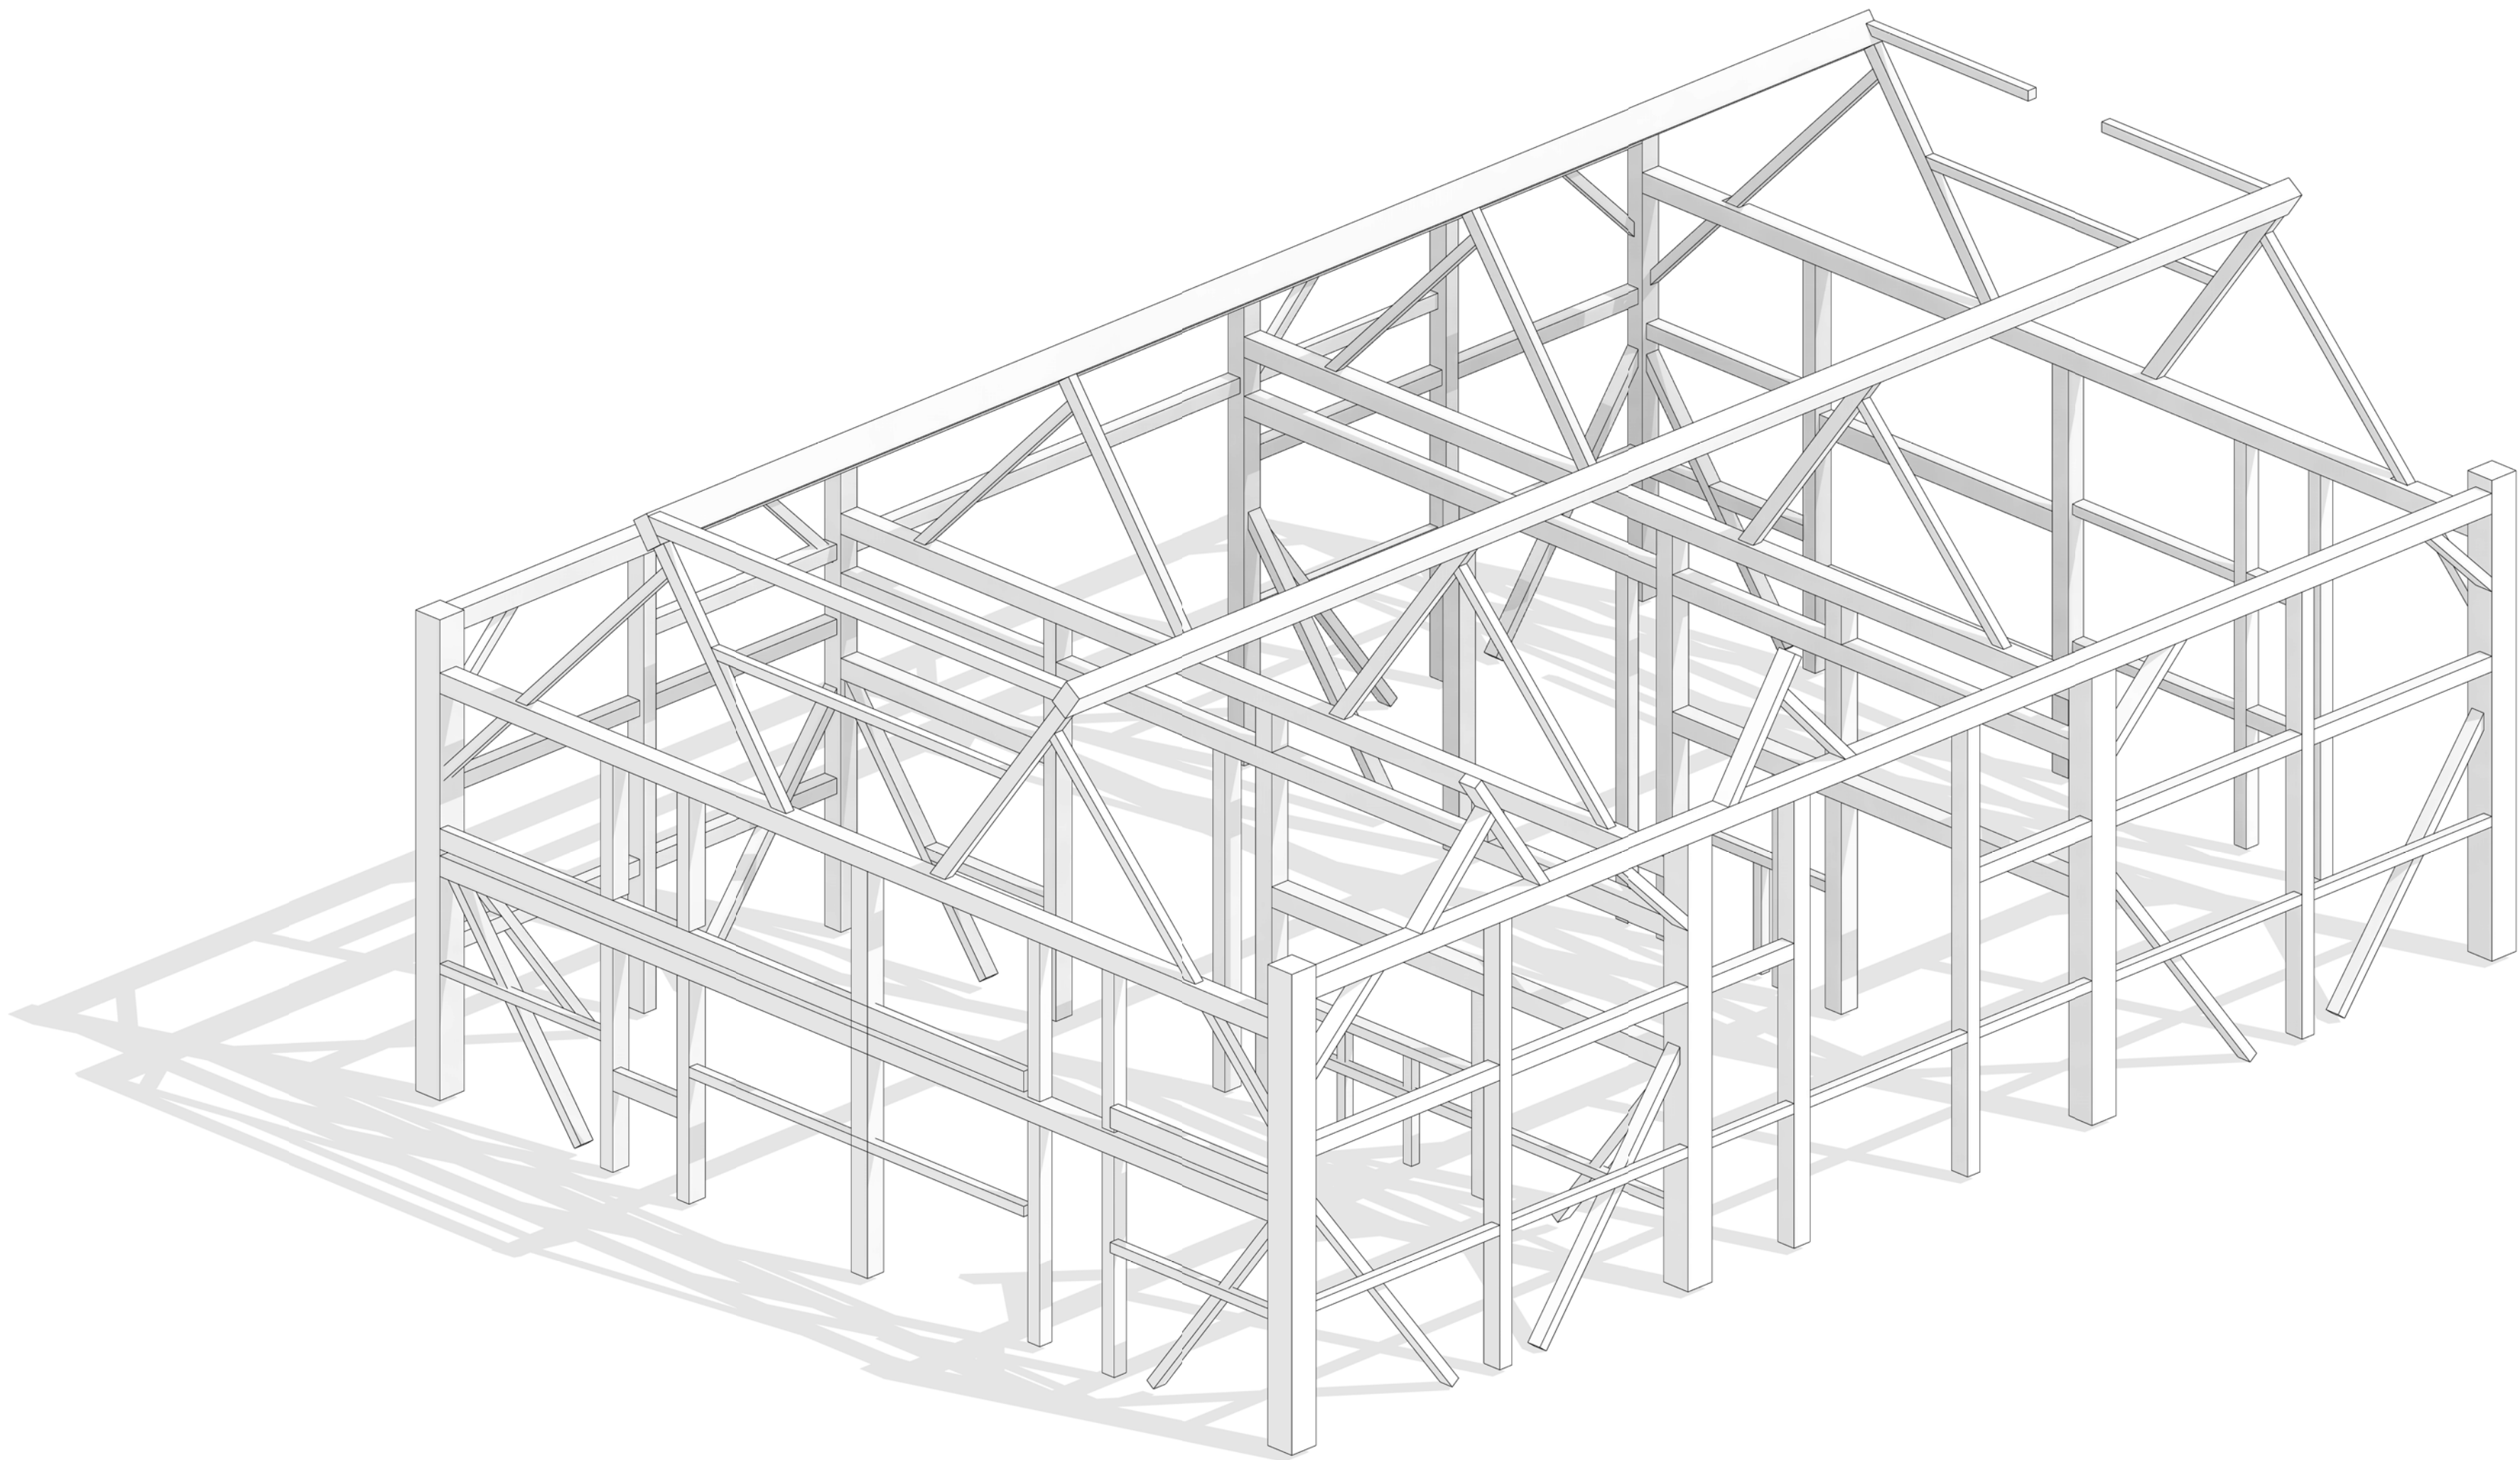

Sawmill Run

Cover Page

Project Number	Project 19
Date	20250811
Drawn By	
Checked By	
A101	
Scale	

Sawmill Run

Floor Plan

Project Number	Project 19
----------------	------------


Date	20250811
------	----------

Drawn By	
----------	--

Checked By	
------------	--

A102


Scale	1/4" = 1'-0"
-------	--------------

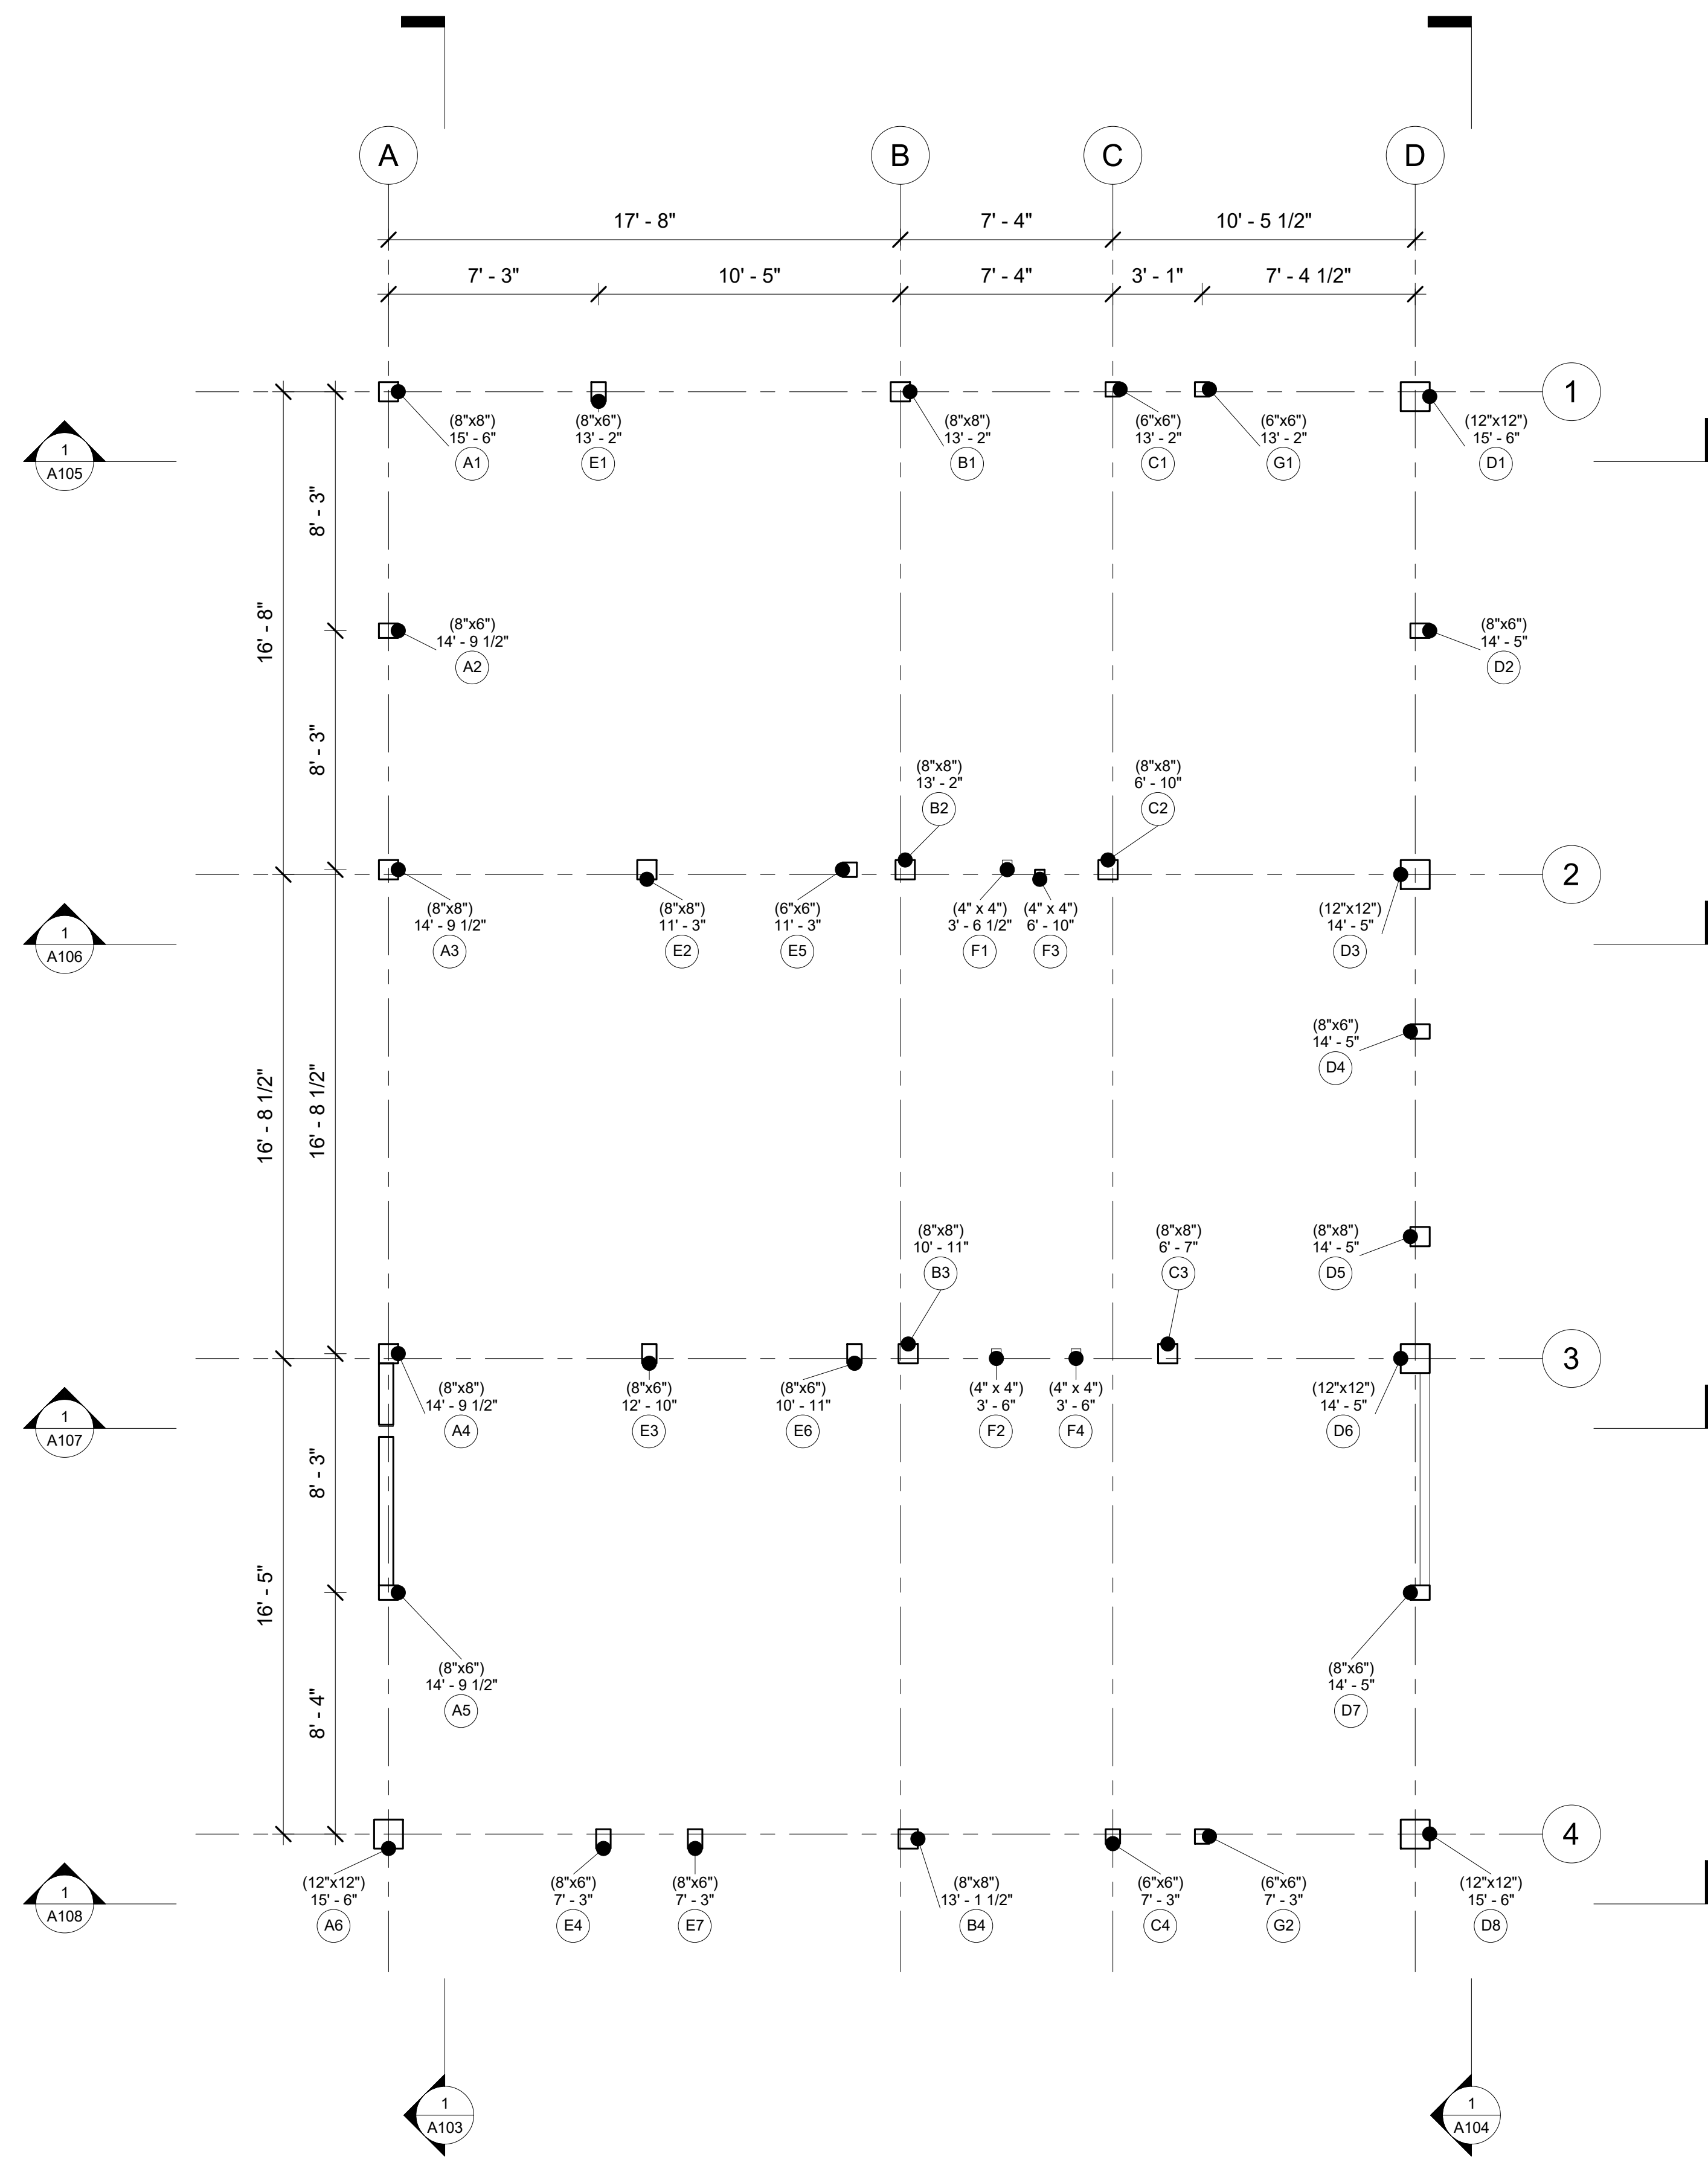

Sawmill Run

Bent A


Project Number	Project 19
Date	20250811
Drawn By	
Checked By	
A103	
Scale	1/4" = 1'-0"

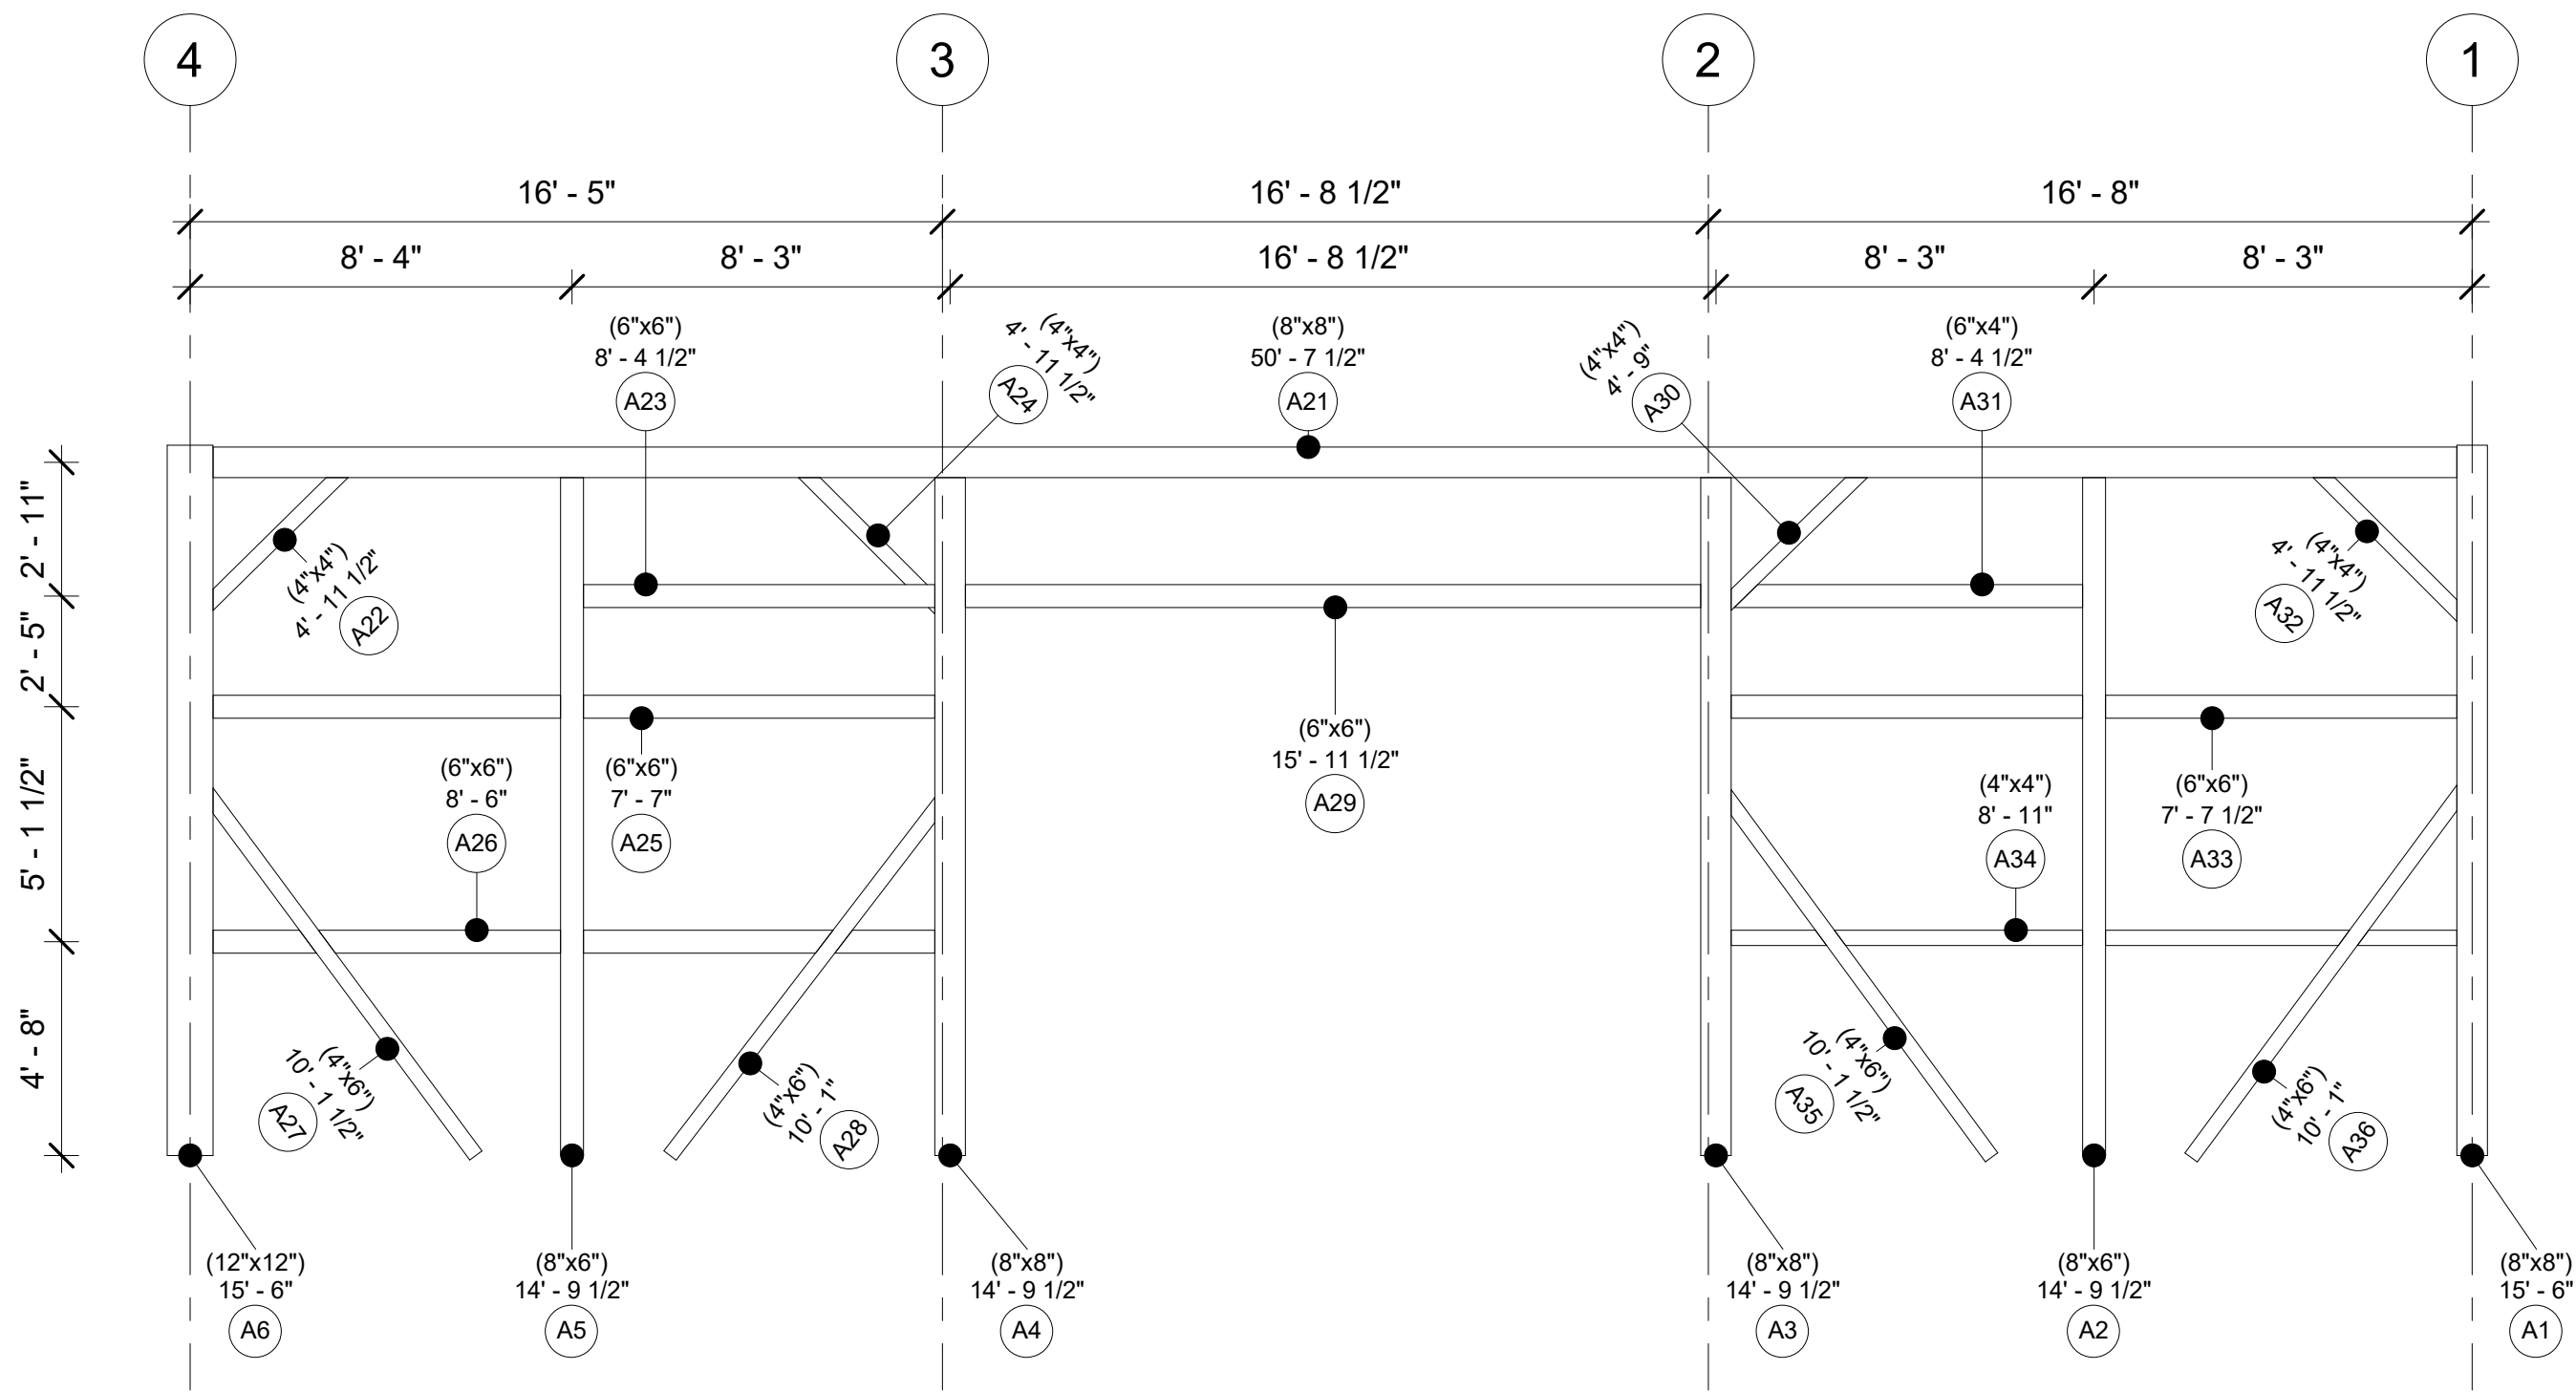


Sawmill Run

Bent B

Project Number	Project 19
Date	20250811
Drawn By	
Checked By	
A104	
Scale	1/4" = 1'-0"

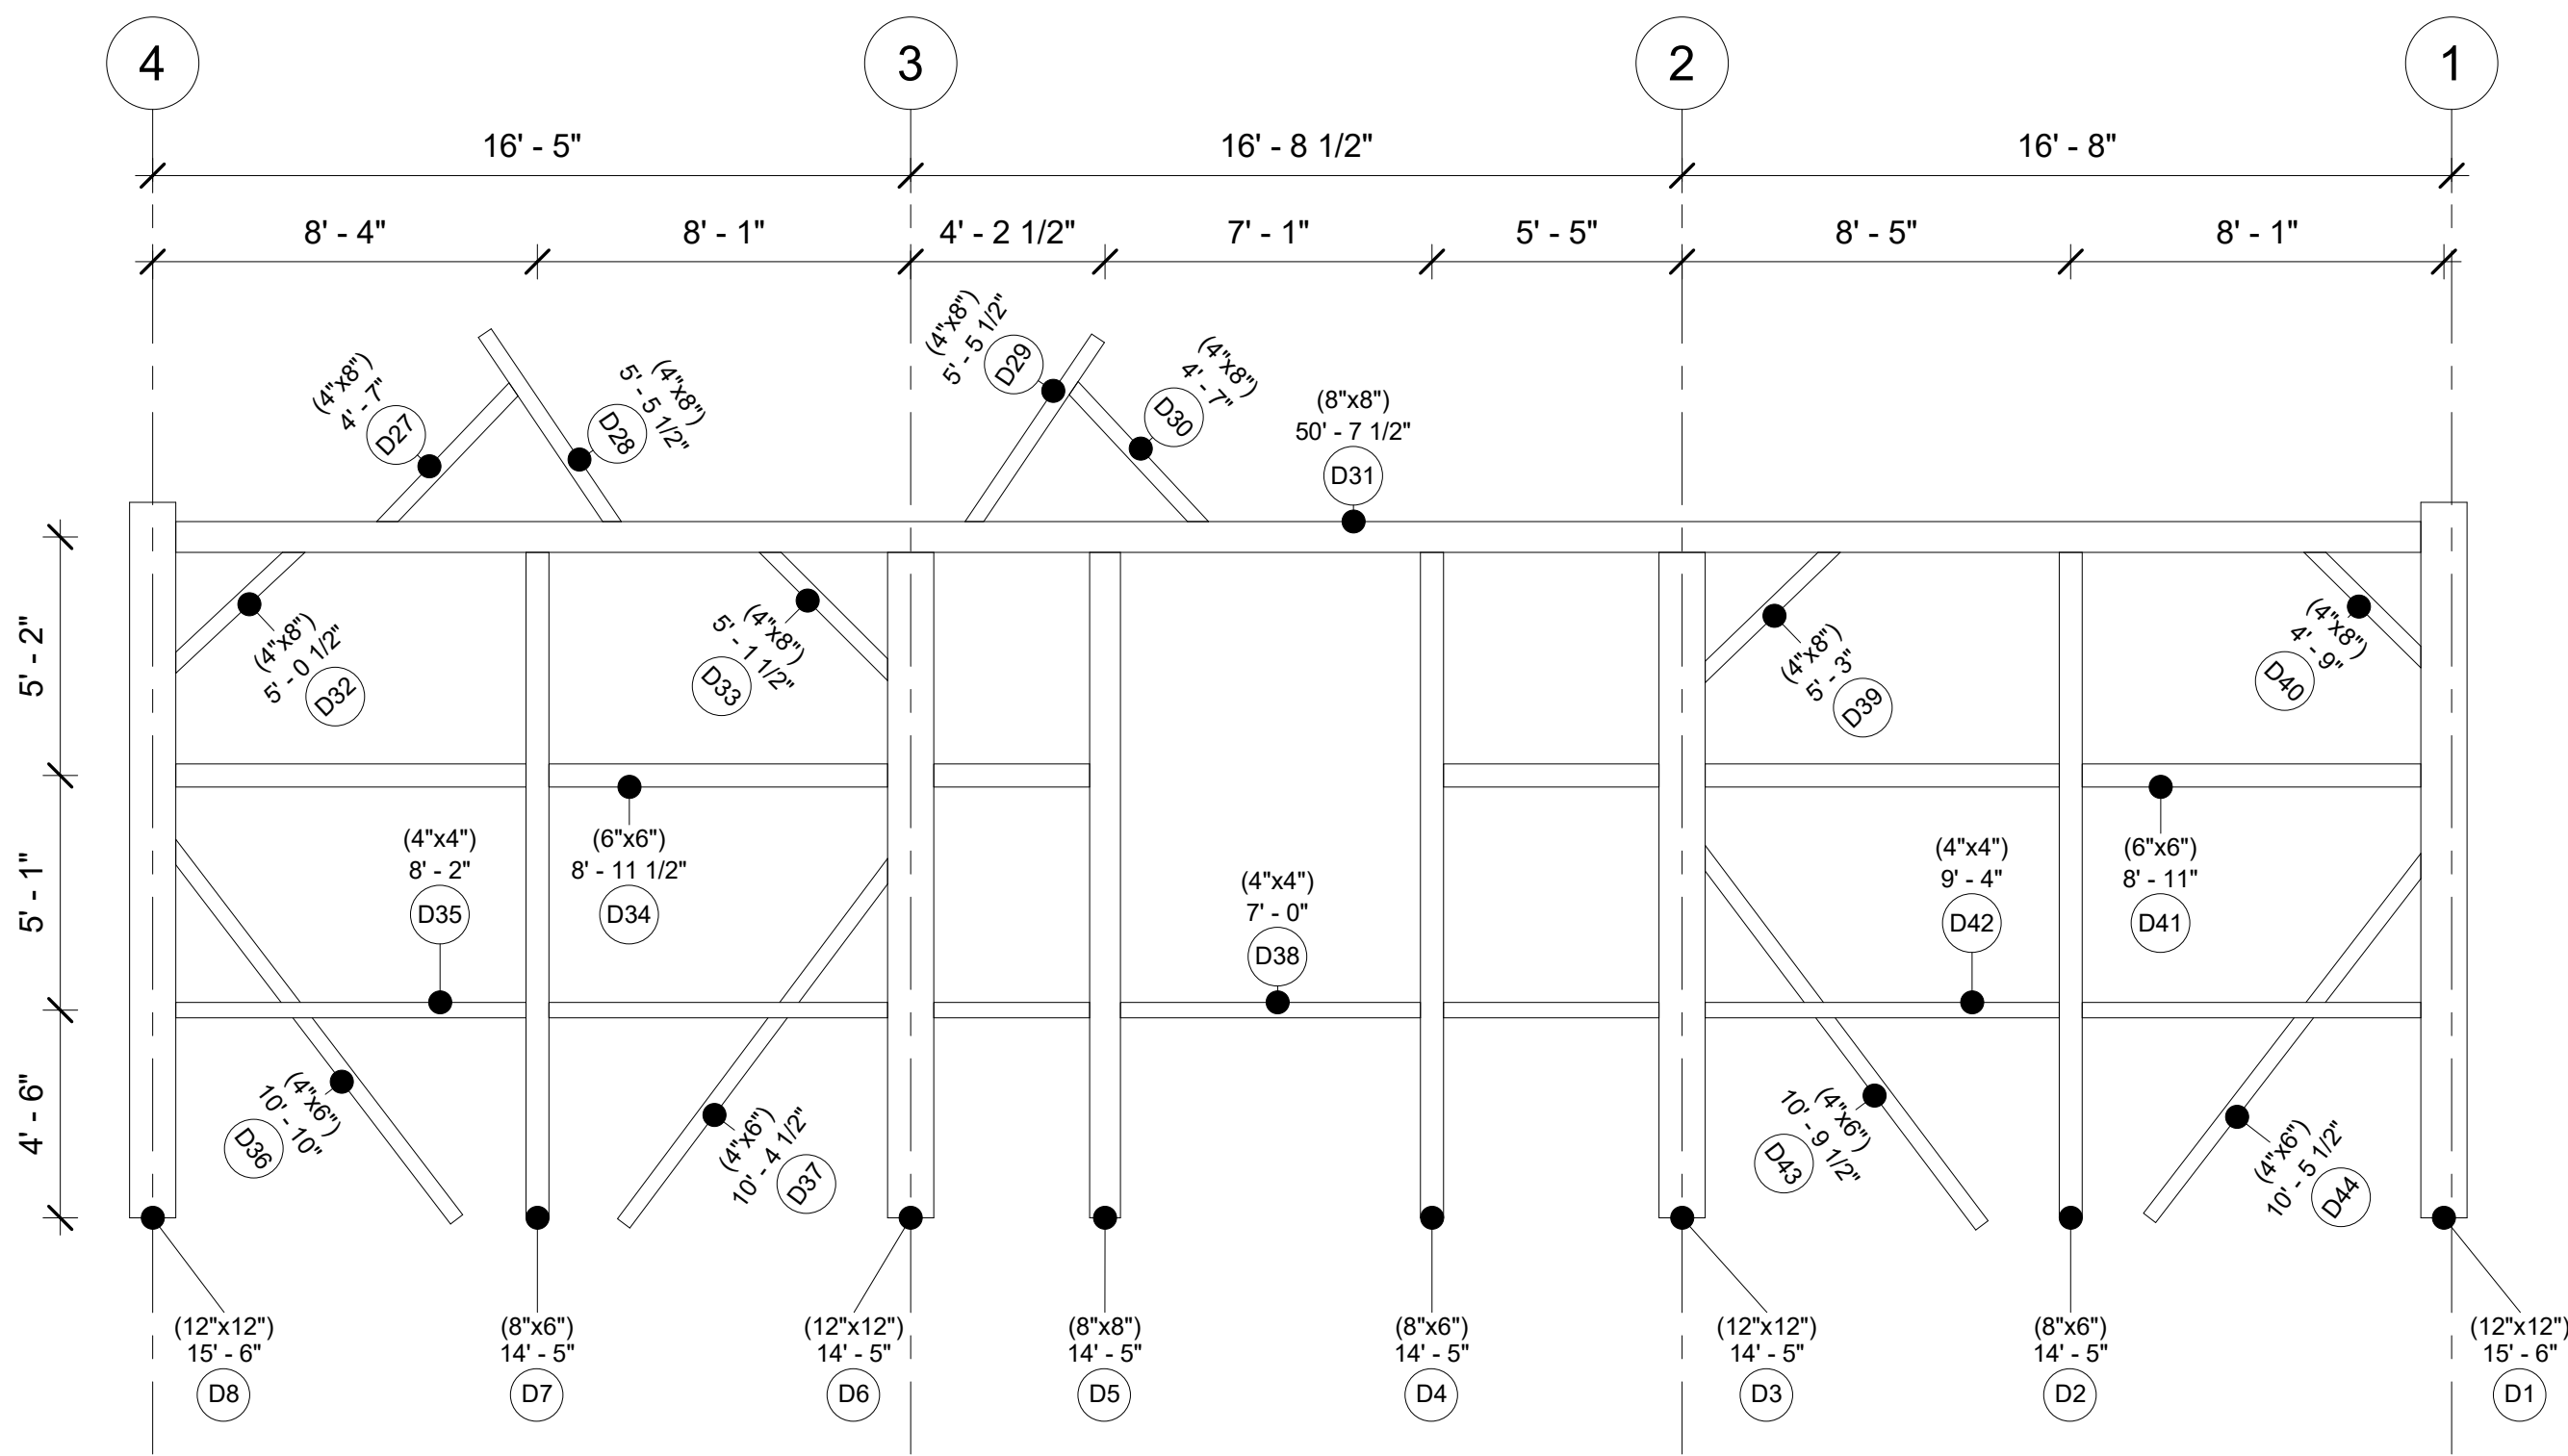


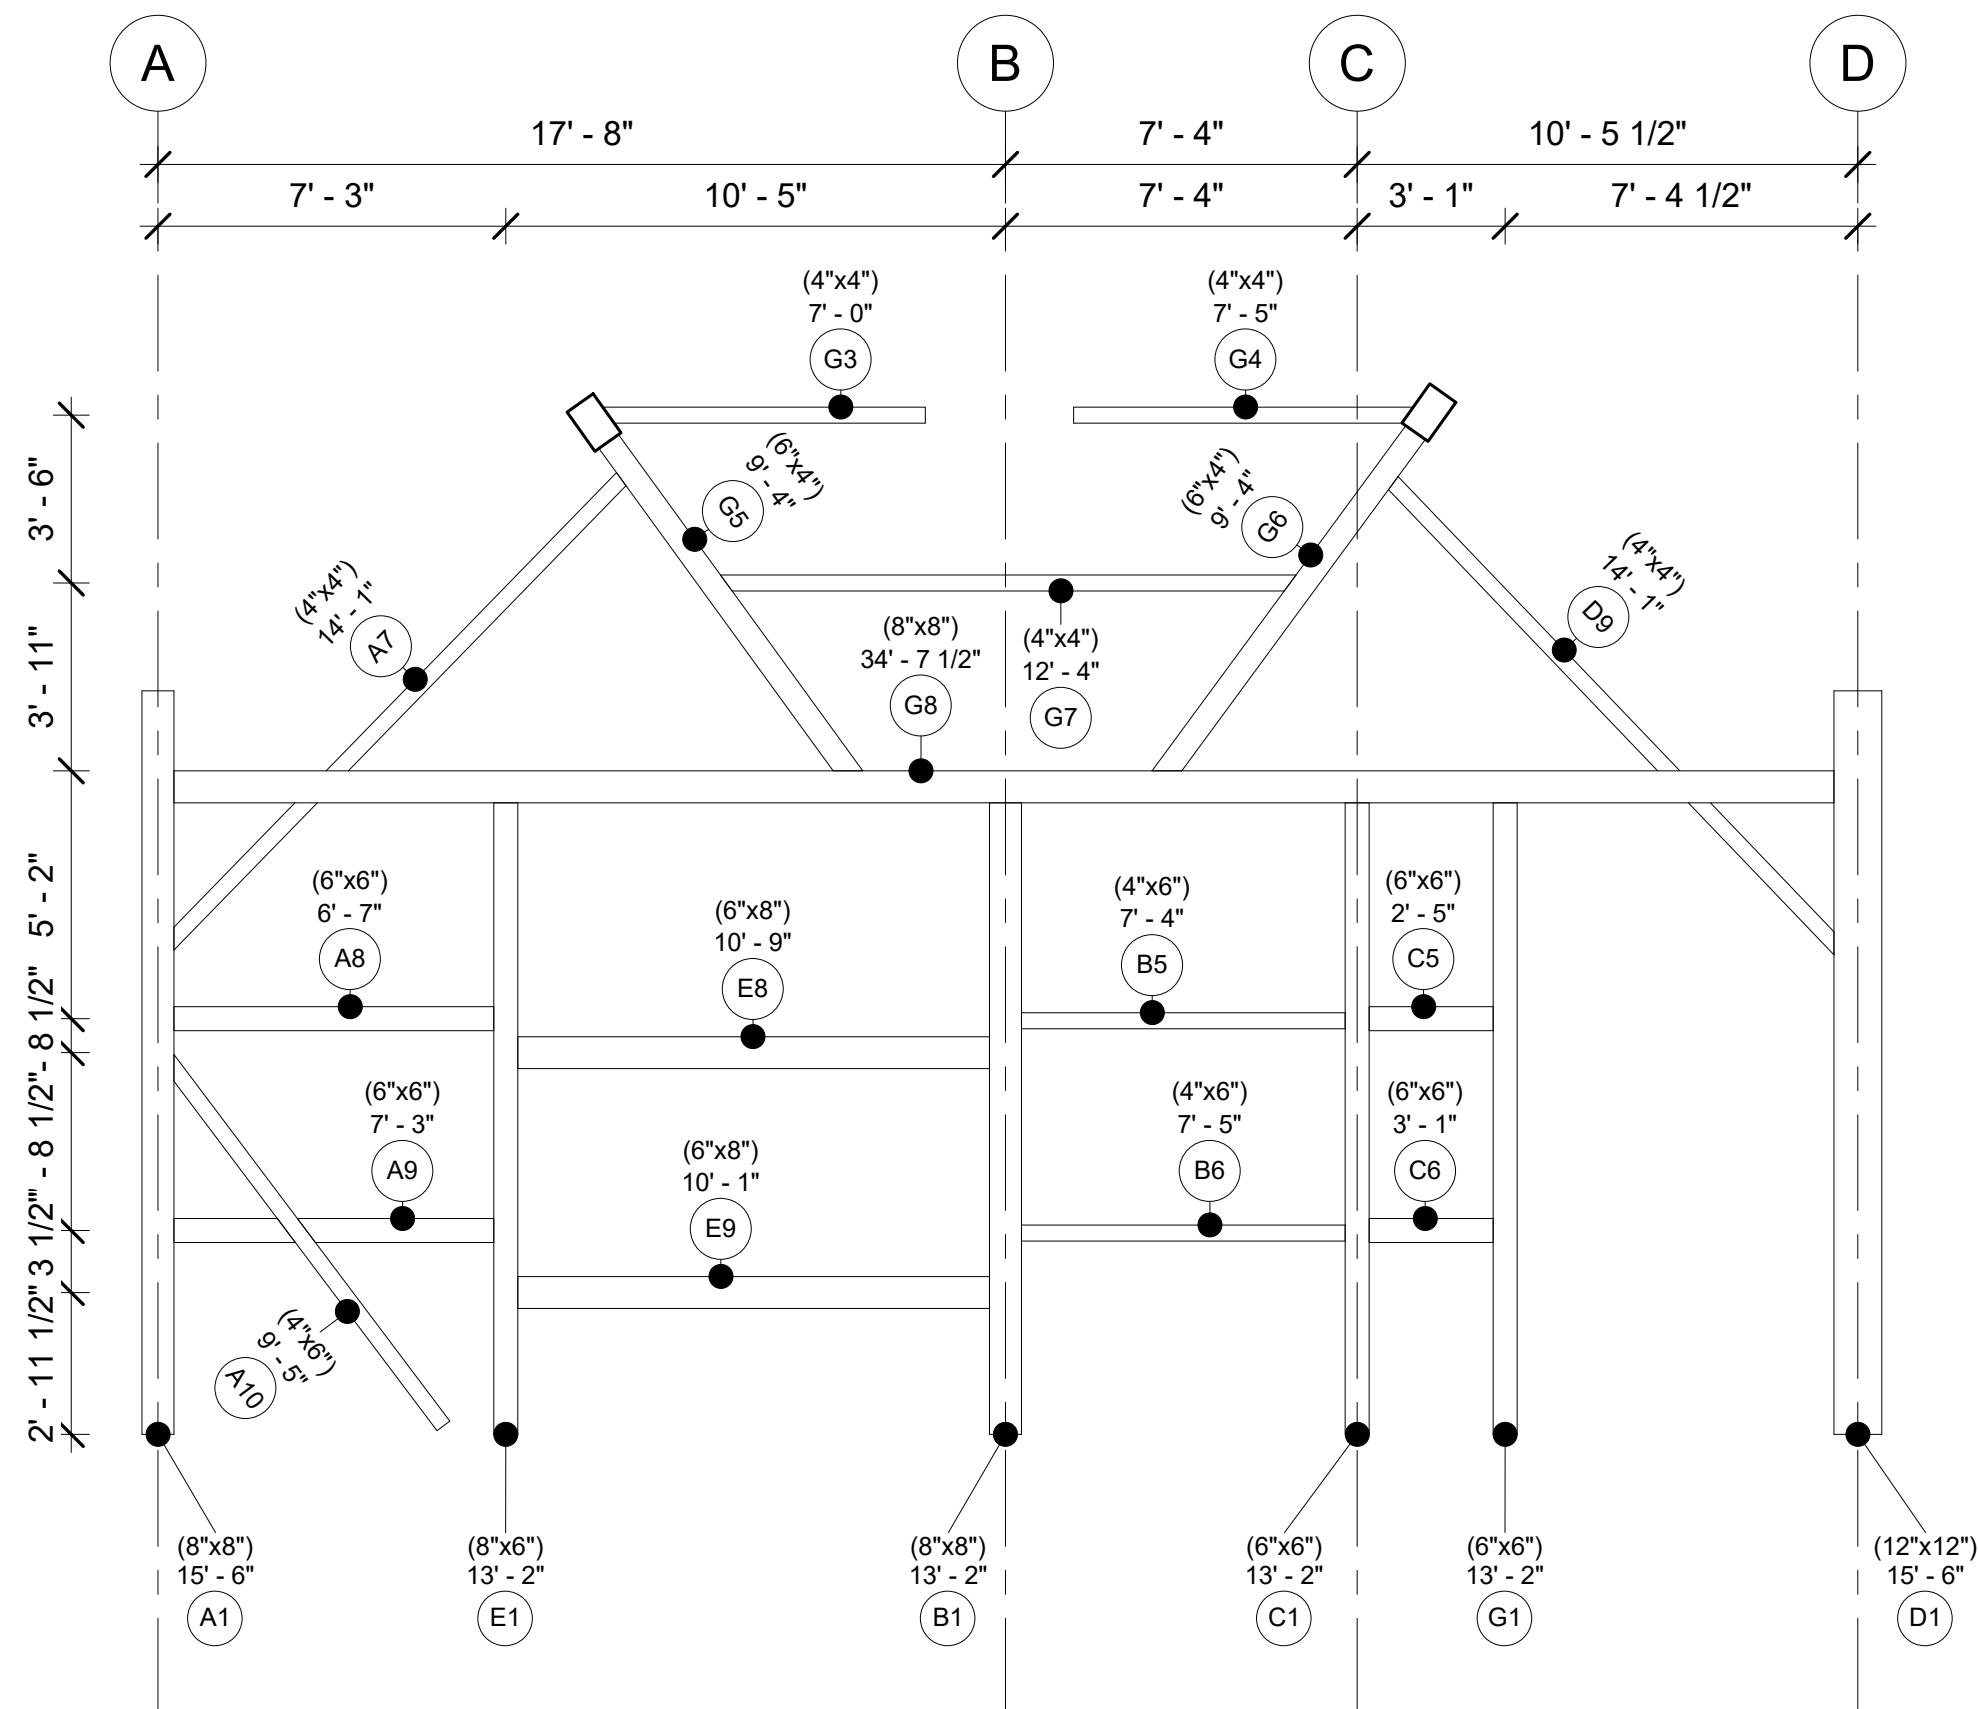

Sawmill Run

Bent 1

Project Number	Project 19
Date	20250811
Drawn By	
Checked By	
A105	
Scale	1/4" = 1'-0"

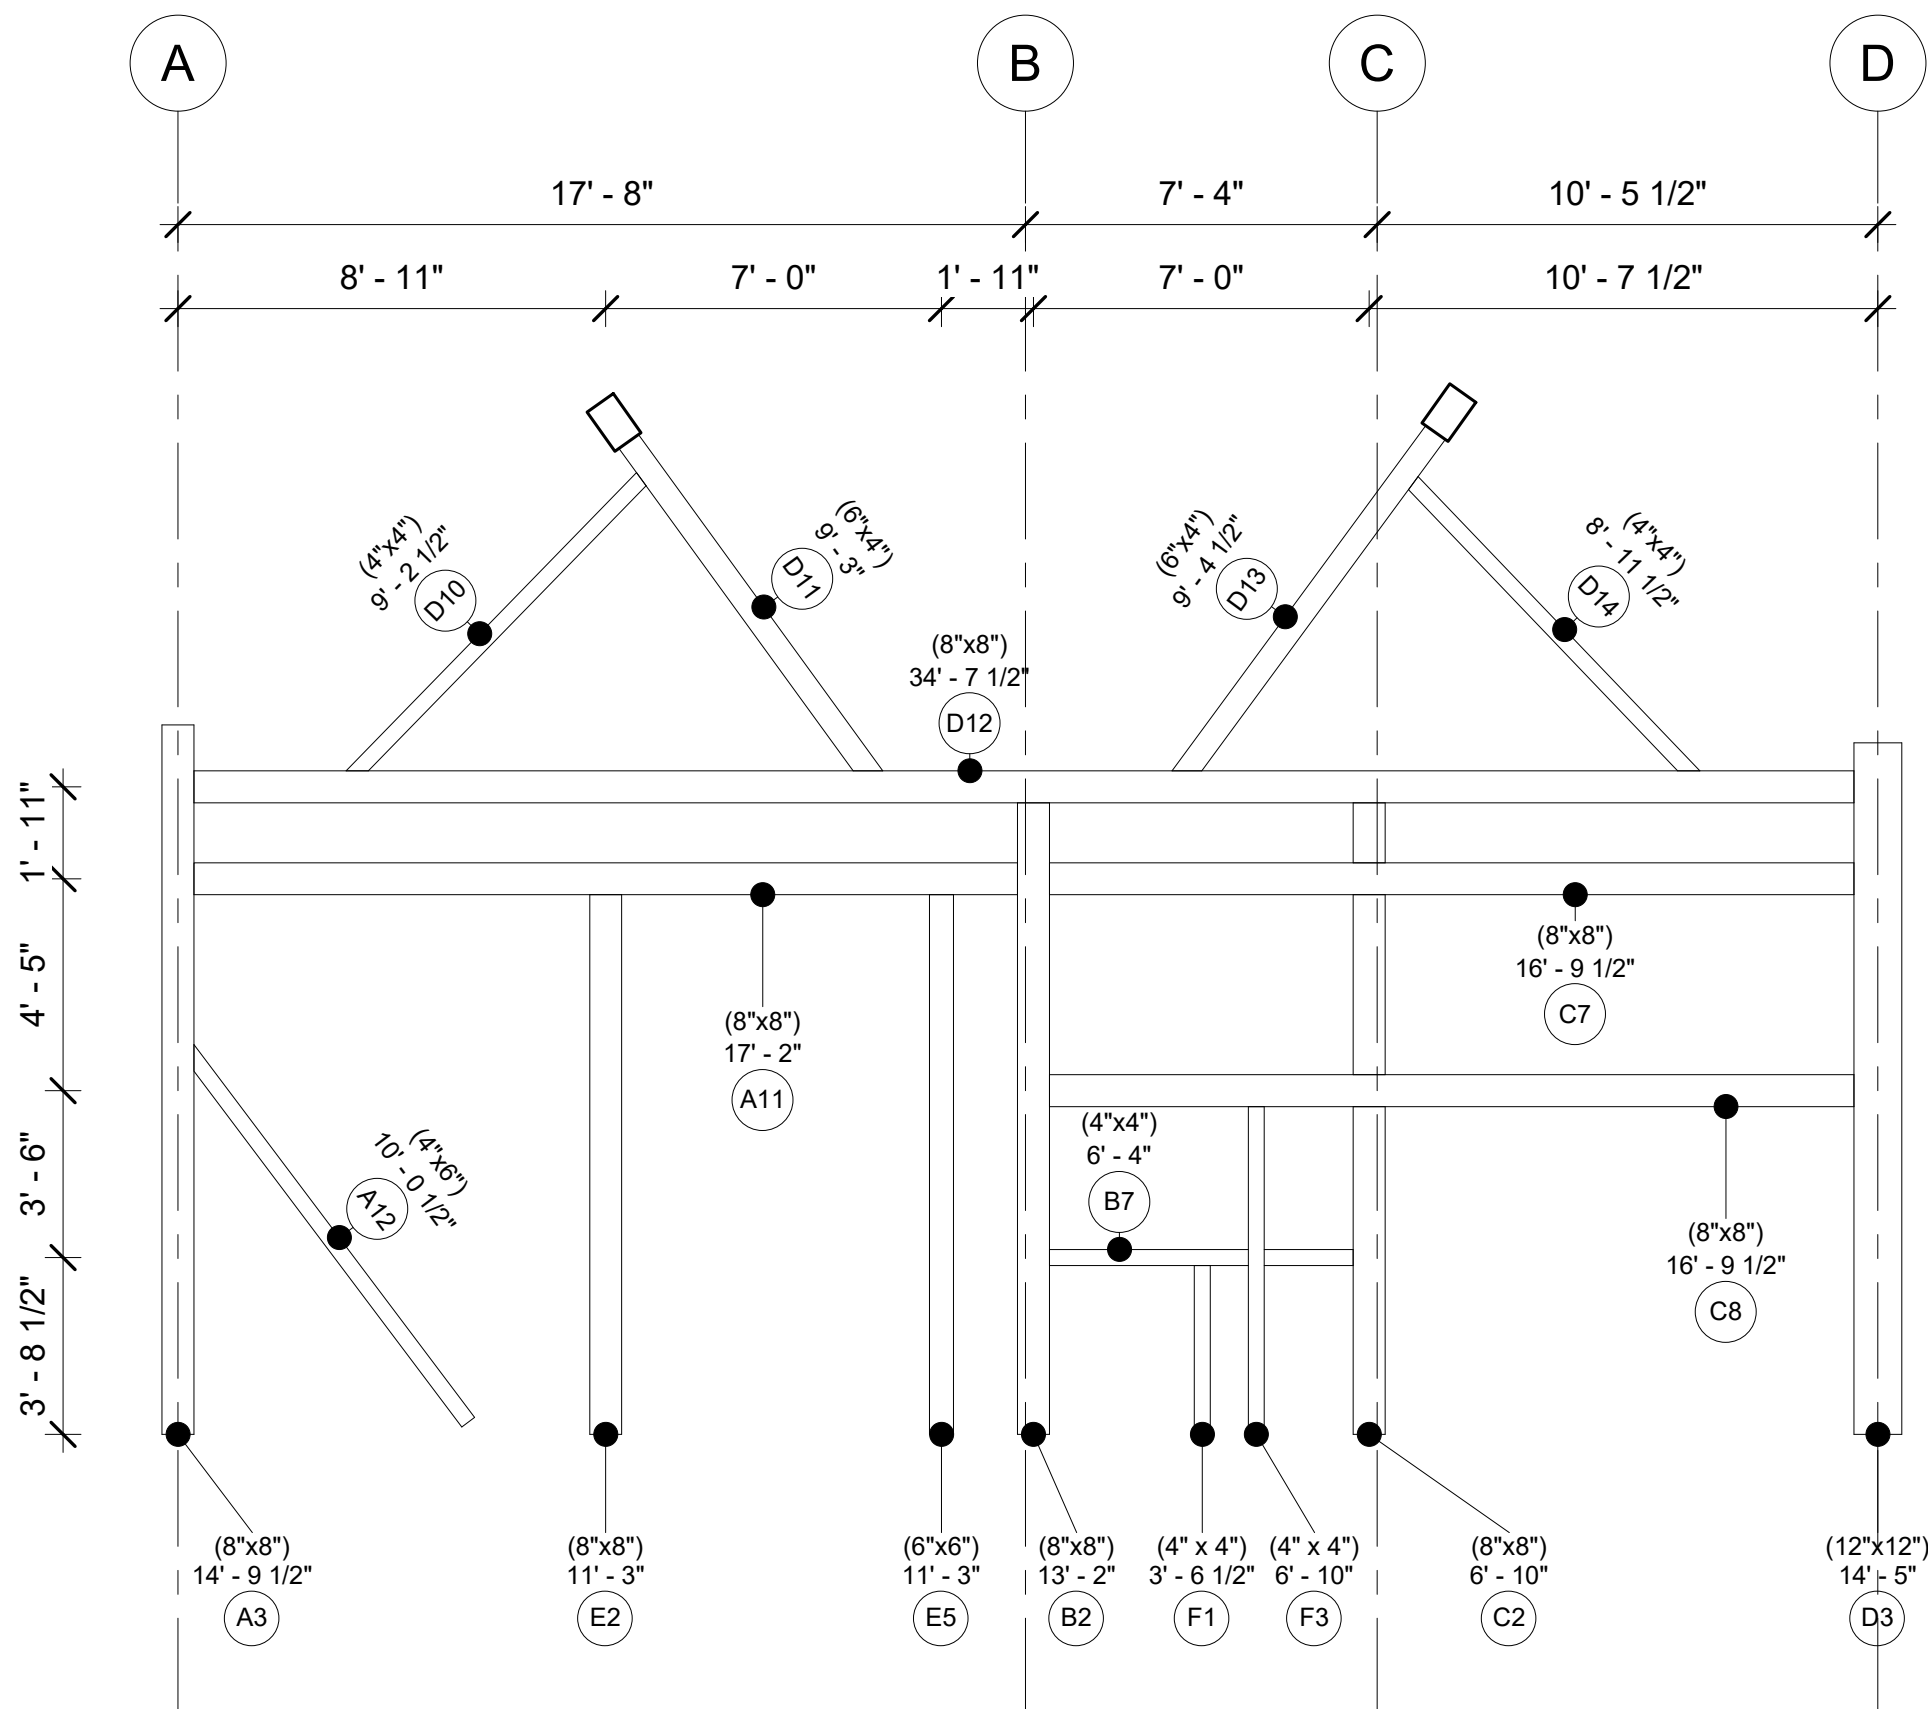


Sawmill Run

Bent 2

Project Number	Project 19
Date	20250811
Drawn By	
Checked By	
A106	
Scale	1/4" = 1'-0"

Sawmill Run

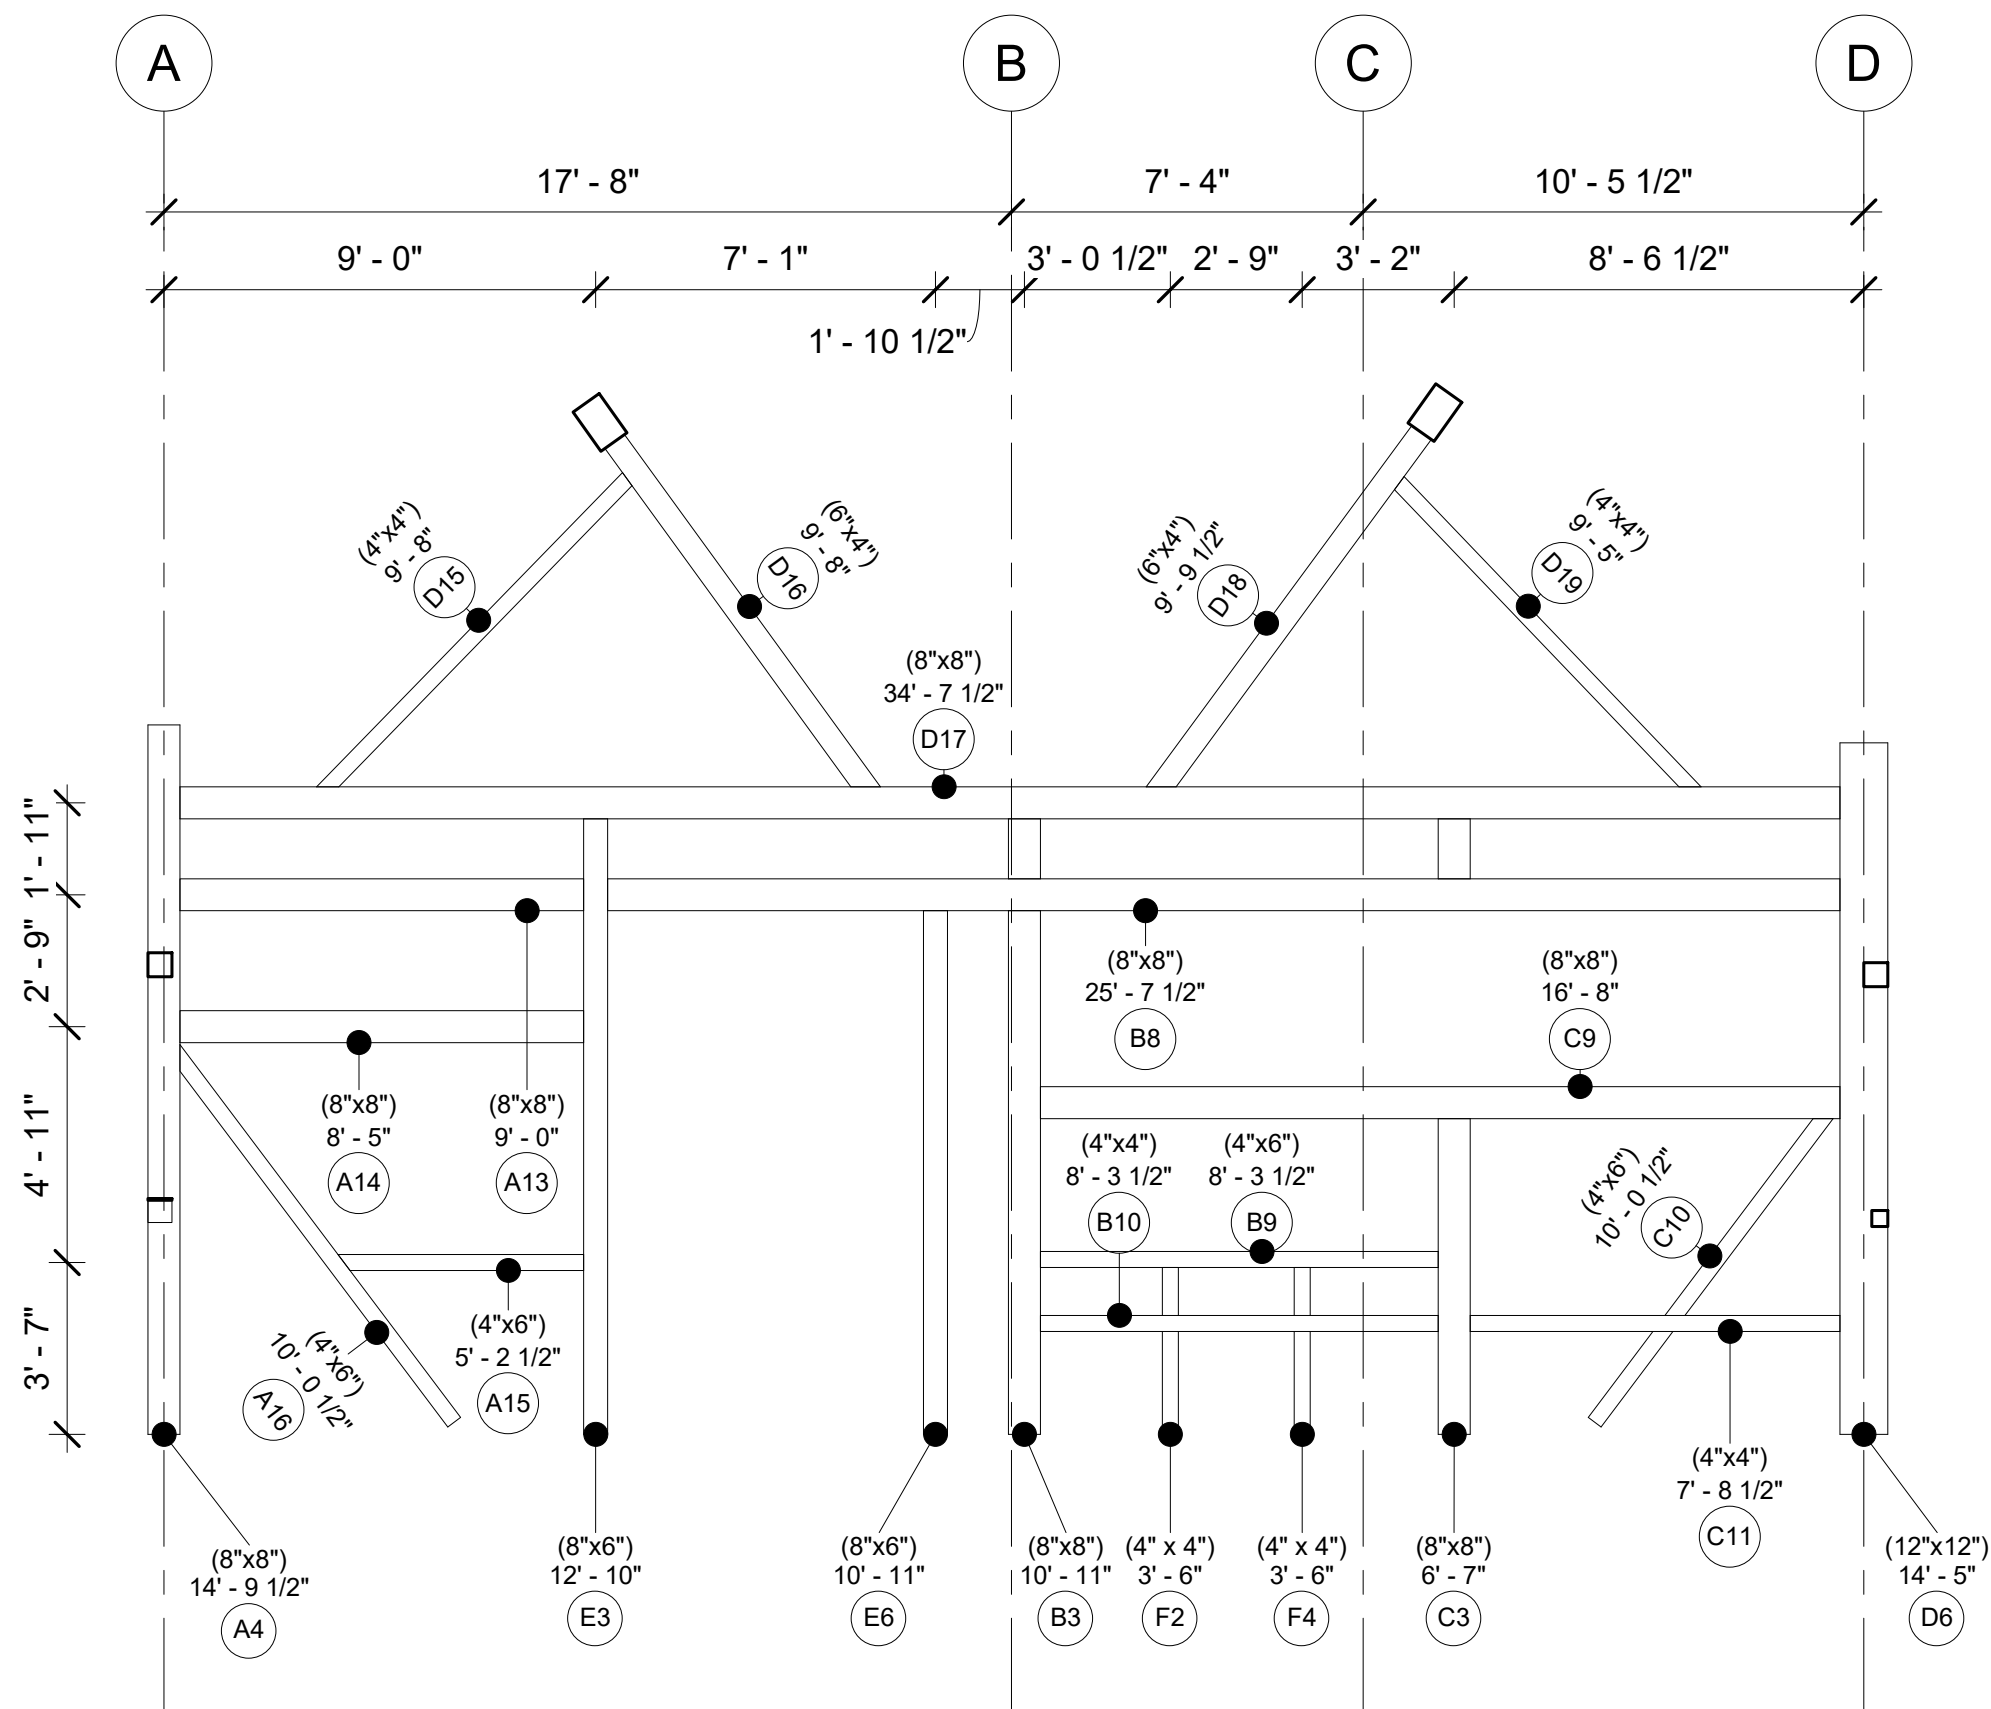

Bent 3

Project Number	Project 19
Date	20250811
Drawn By	
Checked By	
A107	
Scale	1/4" = 1'-0"

Sawmill Run

Bent 4

Project Number	Project 19
Date	20250811
Drawn By	
Checked By	
A108	
Scale	1/4" = 1'-0"

