



PROJECT: 108 Little-Red
SCOPE: AS BUILT DRAWINGS

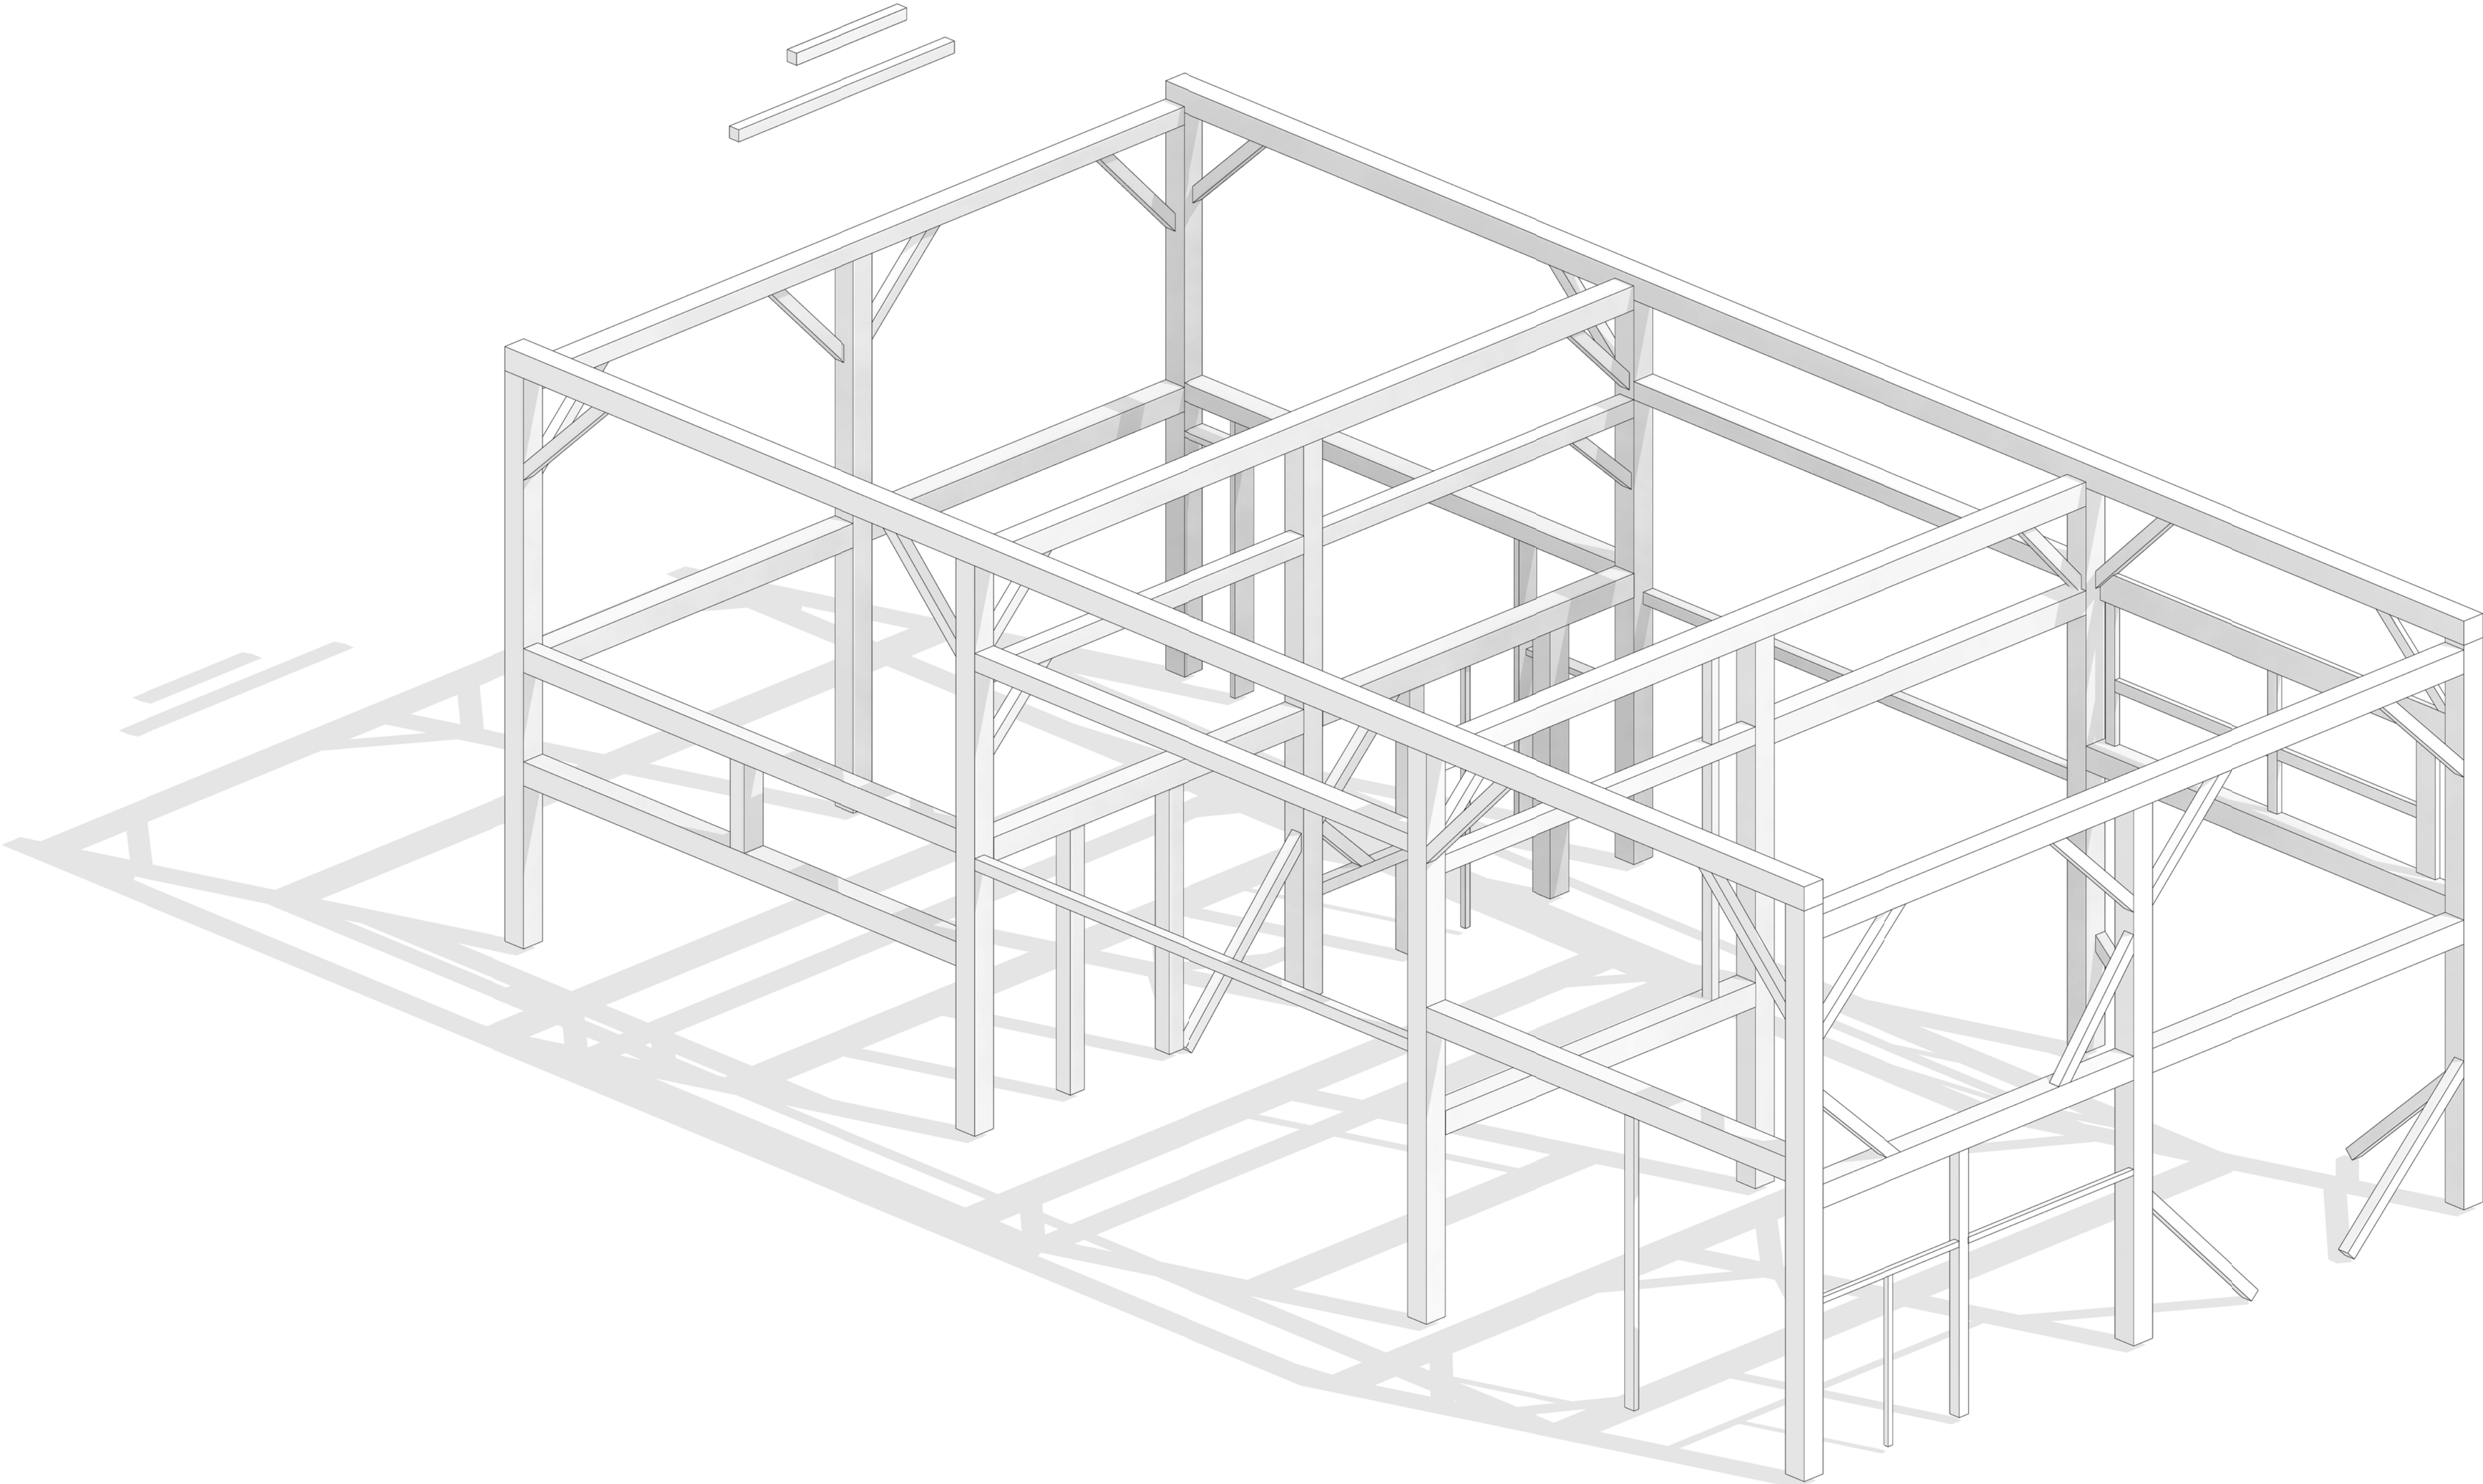

108-Little-Red

Cover Page


Project Number	Project 17
Date	20251113
Drawn By	
Checked By	
A101	
Scale	

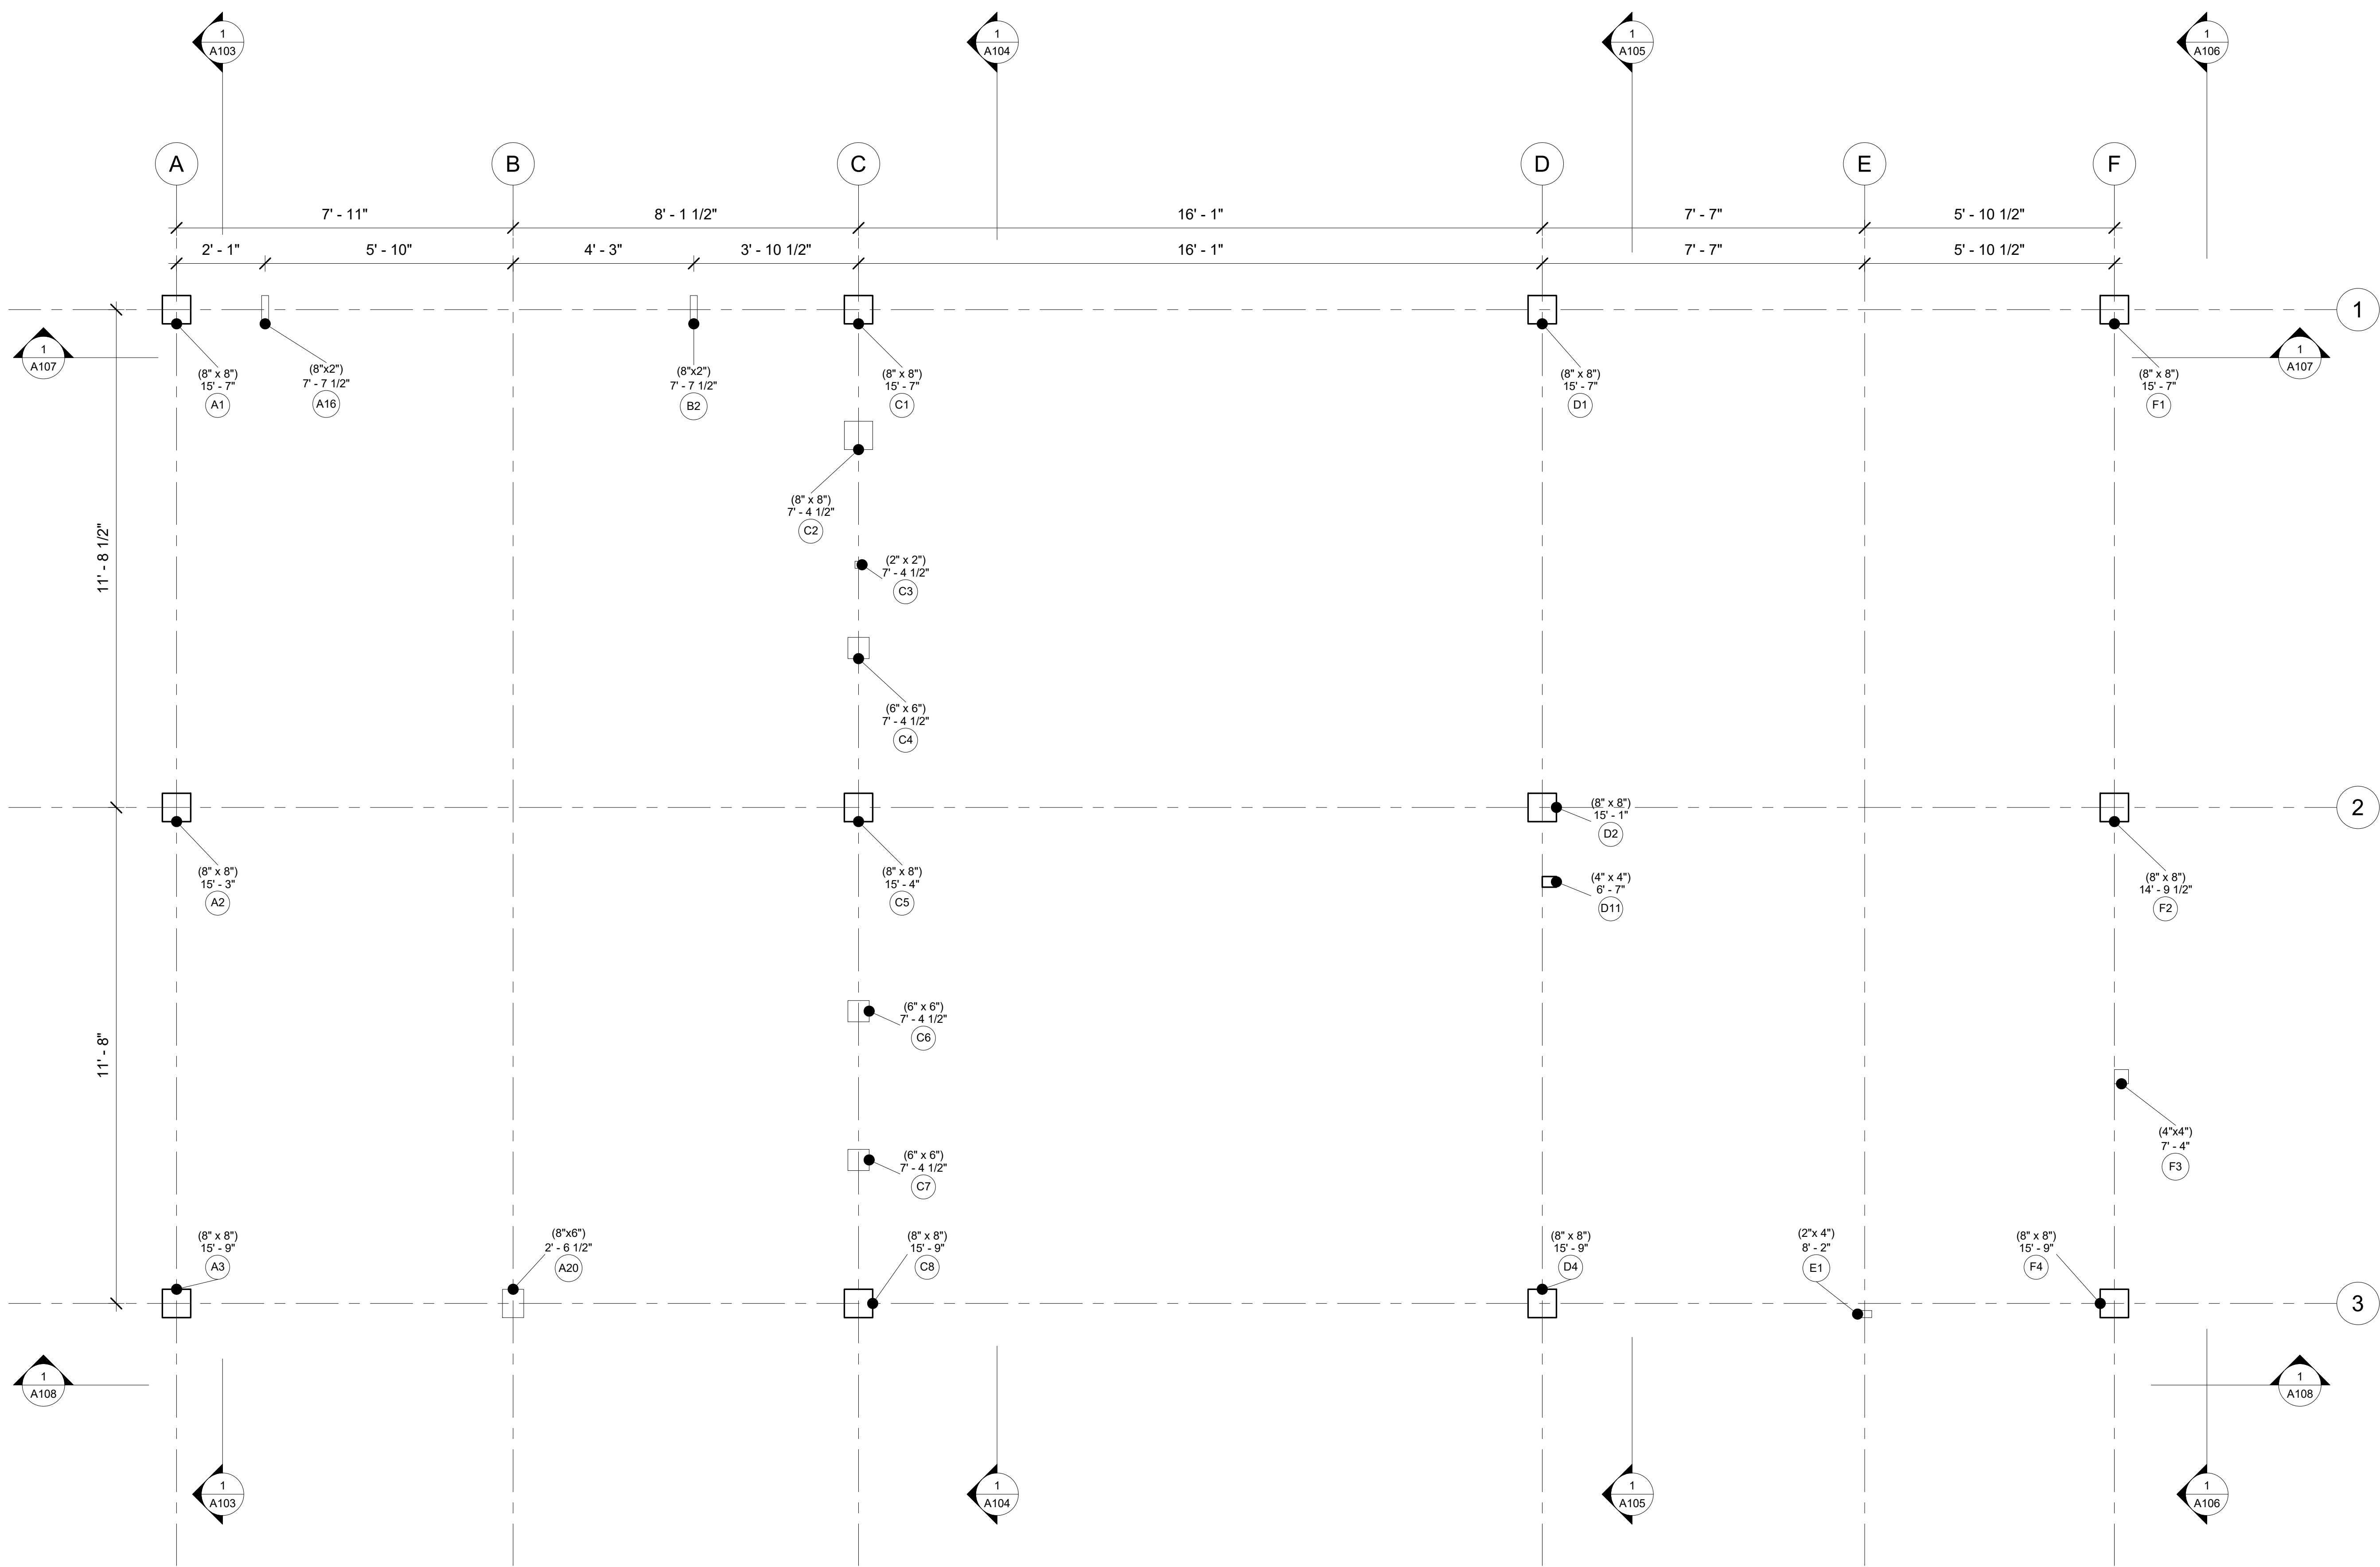

108-Little-Red

Ground

Project Number	Project 17
Date	20251113
Drawn By	
Checked By	
A102	
Scale	1/2" = 1'-0"

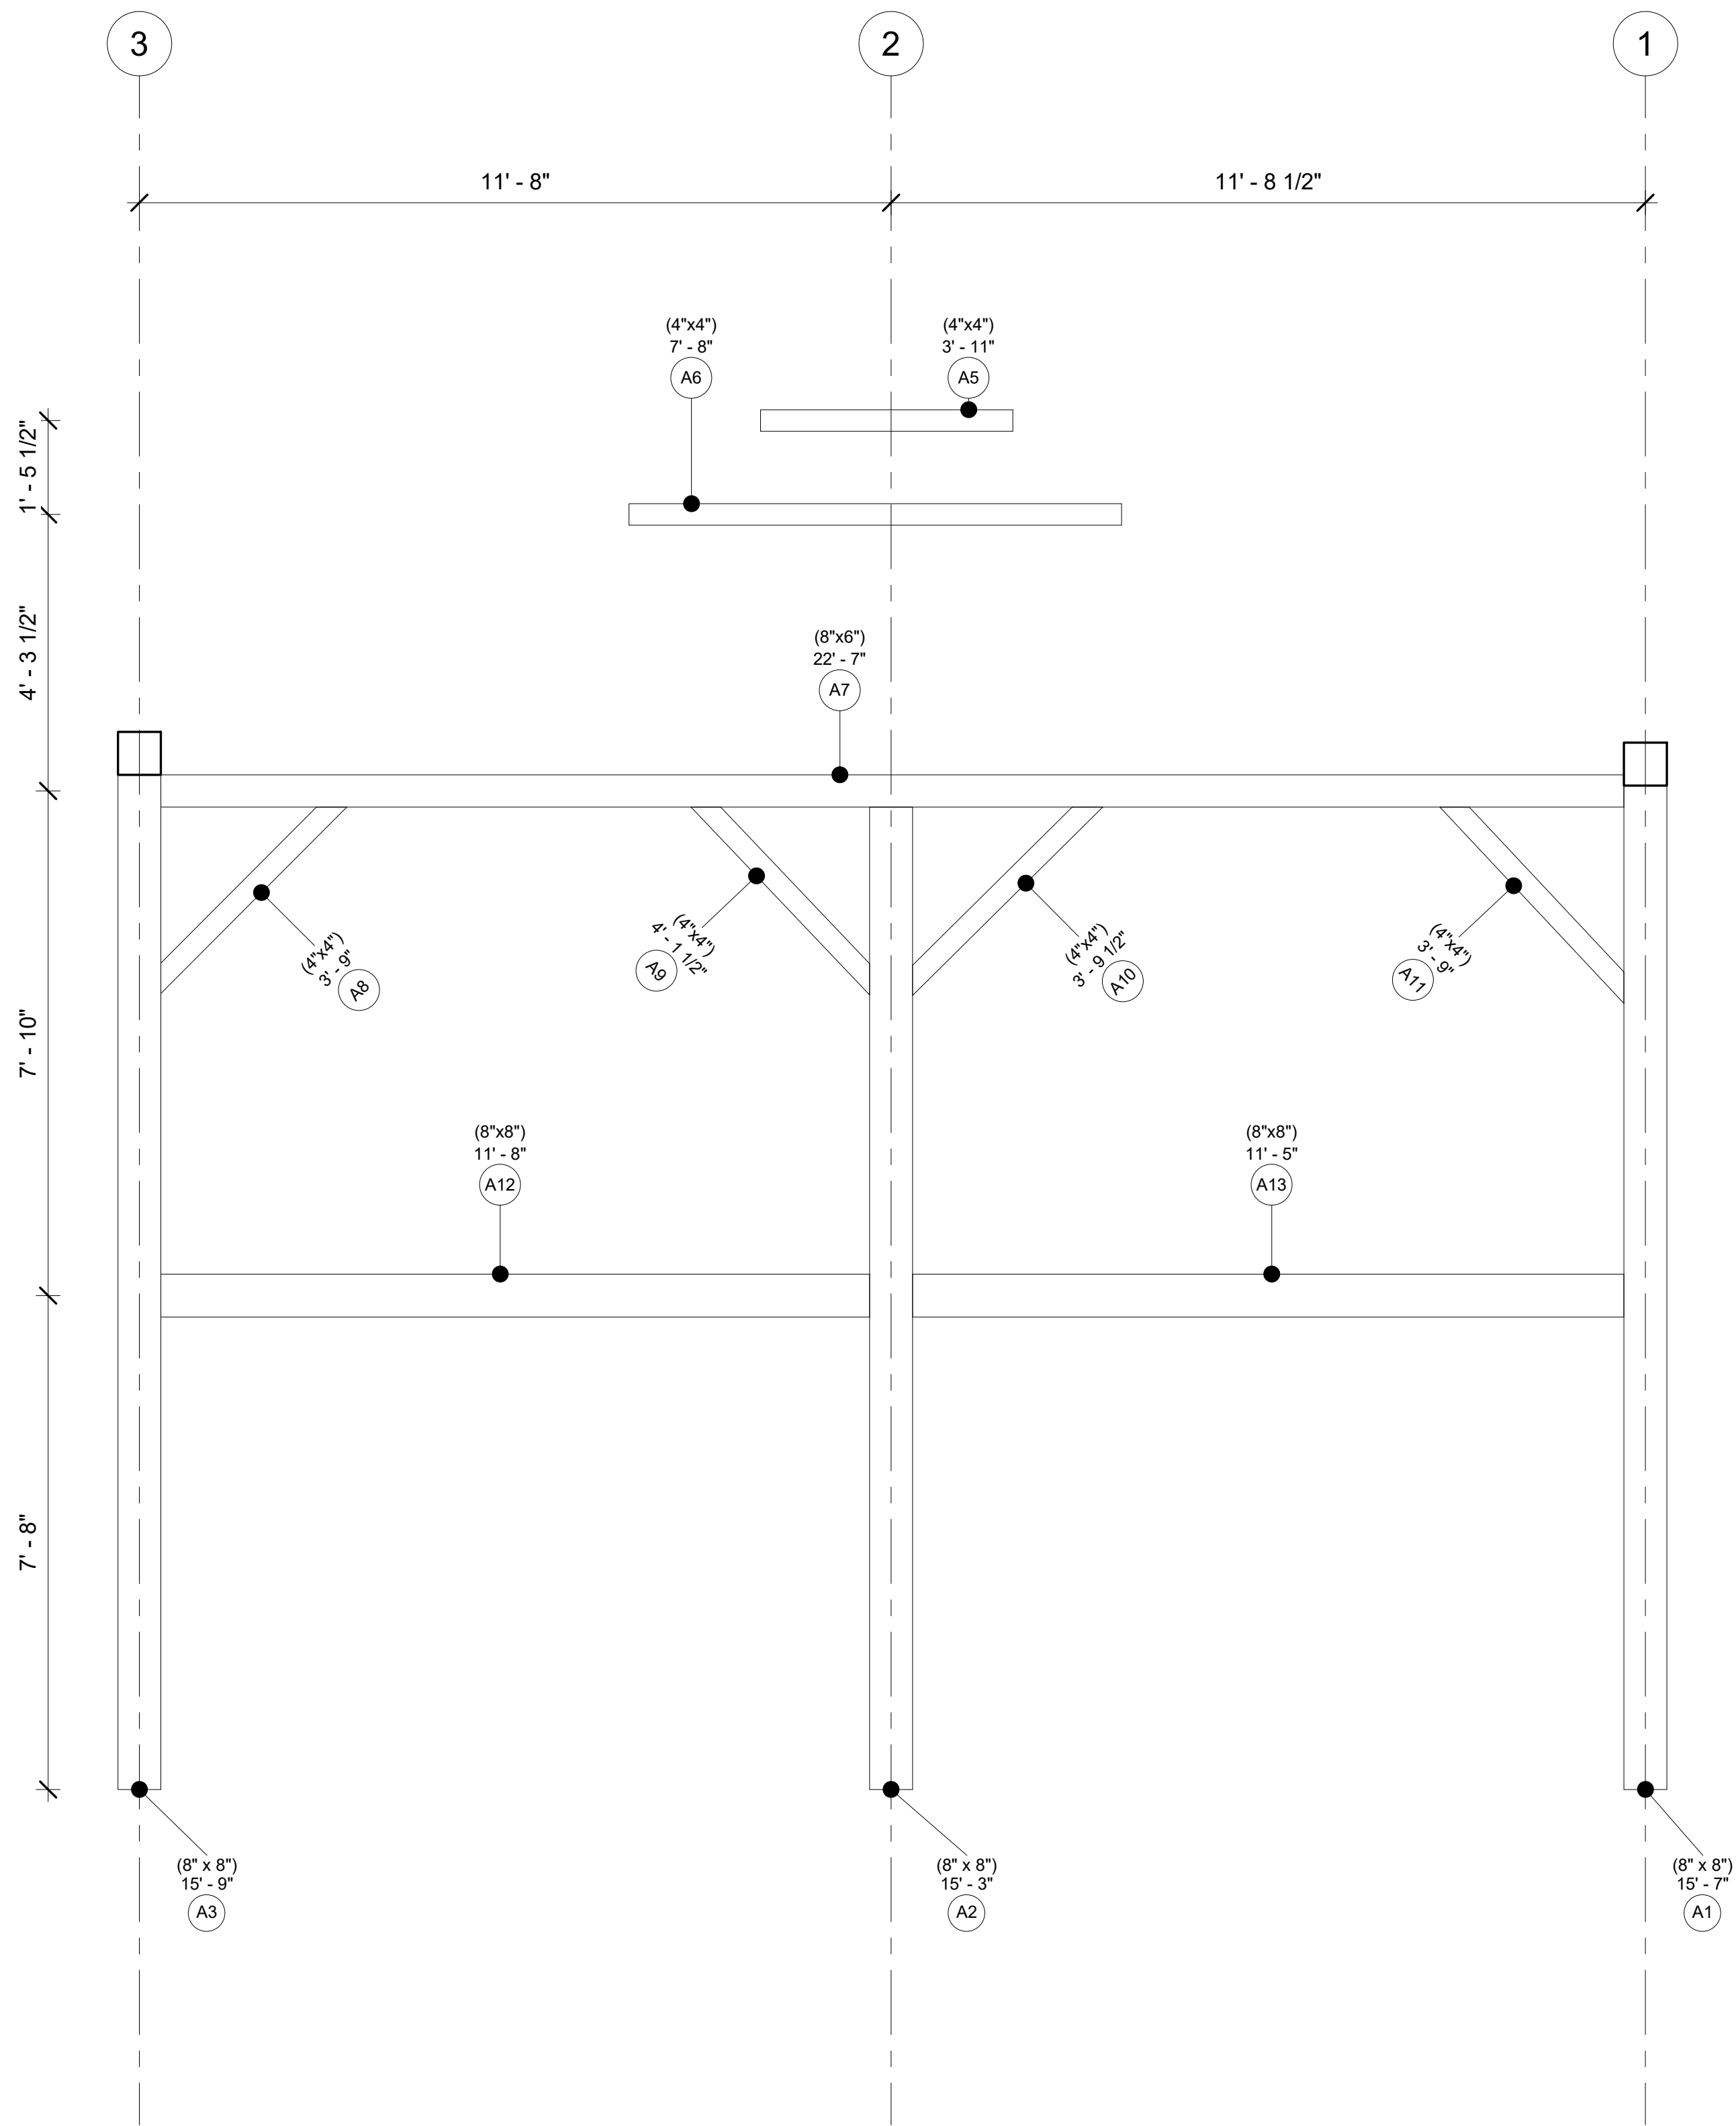

108-Little-Red


Bent A

Project Number	Project 17
Date	20251113
Drawn By	
Checked By	
A103	
Scale	1/2" = 1'-0"

108-Little-Red

Bent C


Project Number	Project 17
Date	20251113
Drawn By	
Checked By	
A104	
Scale	1/2" = 1'-0"

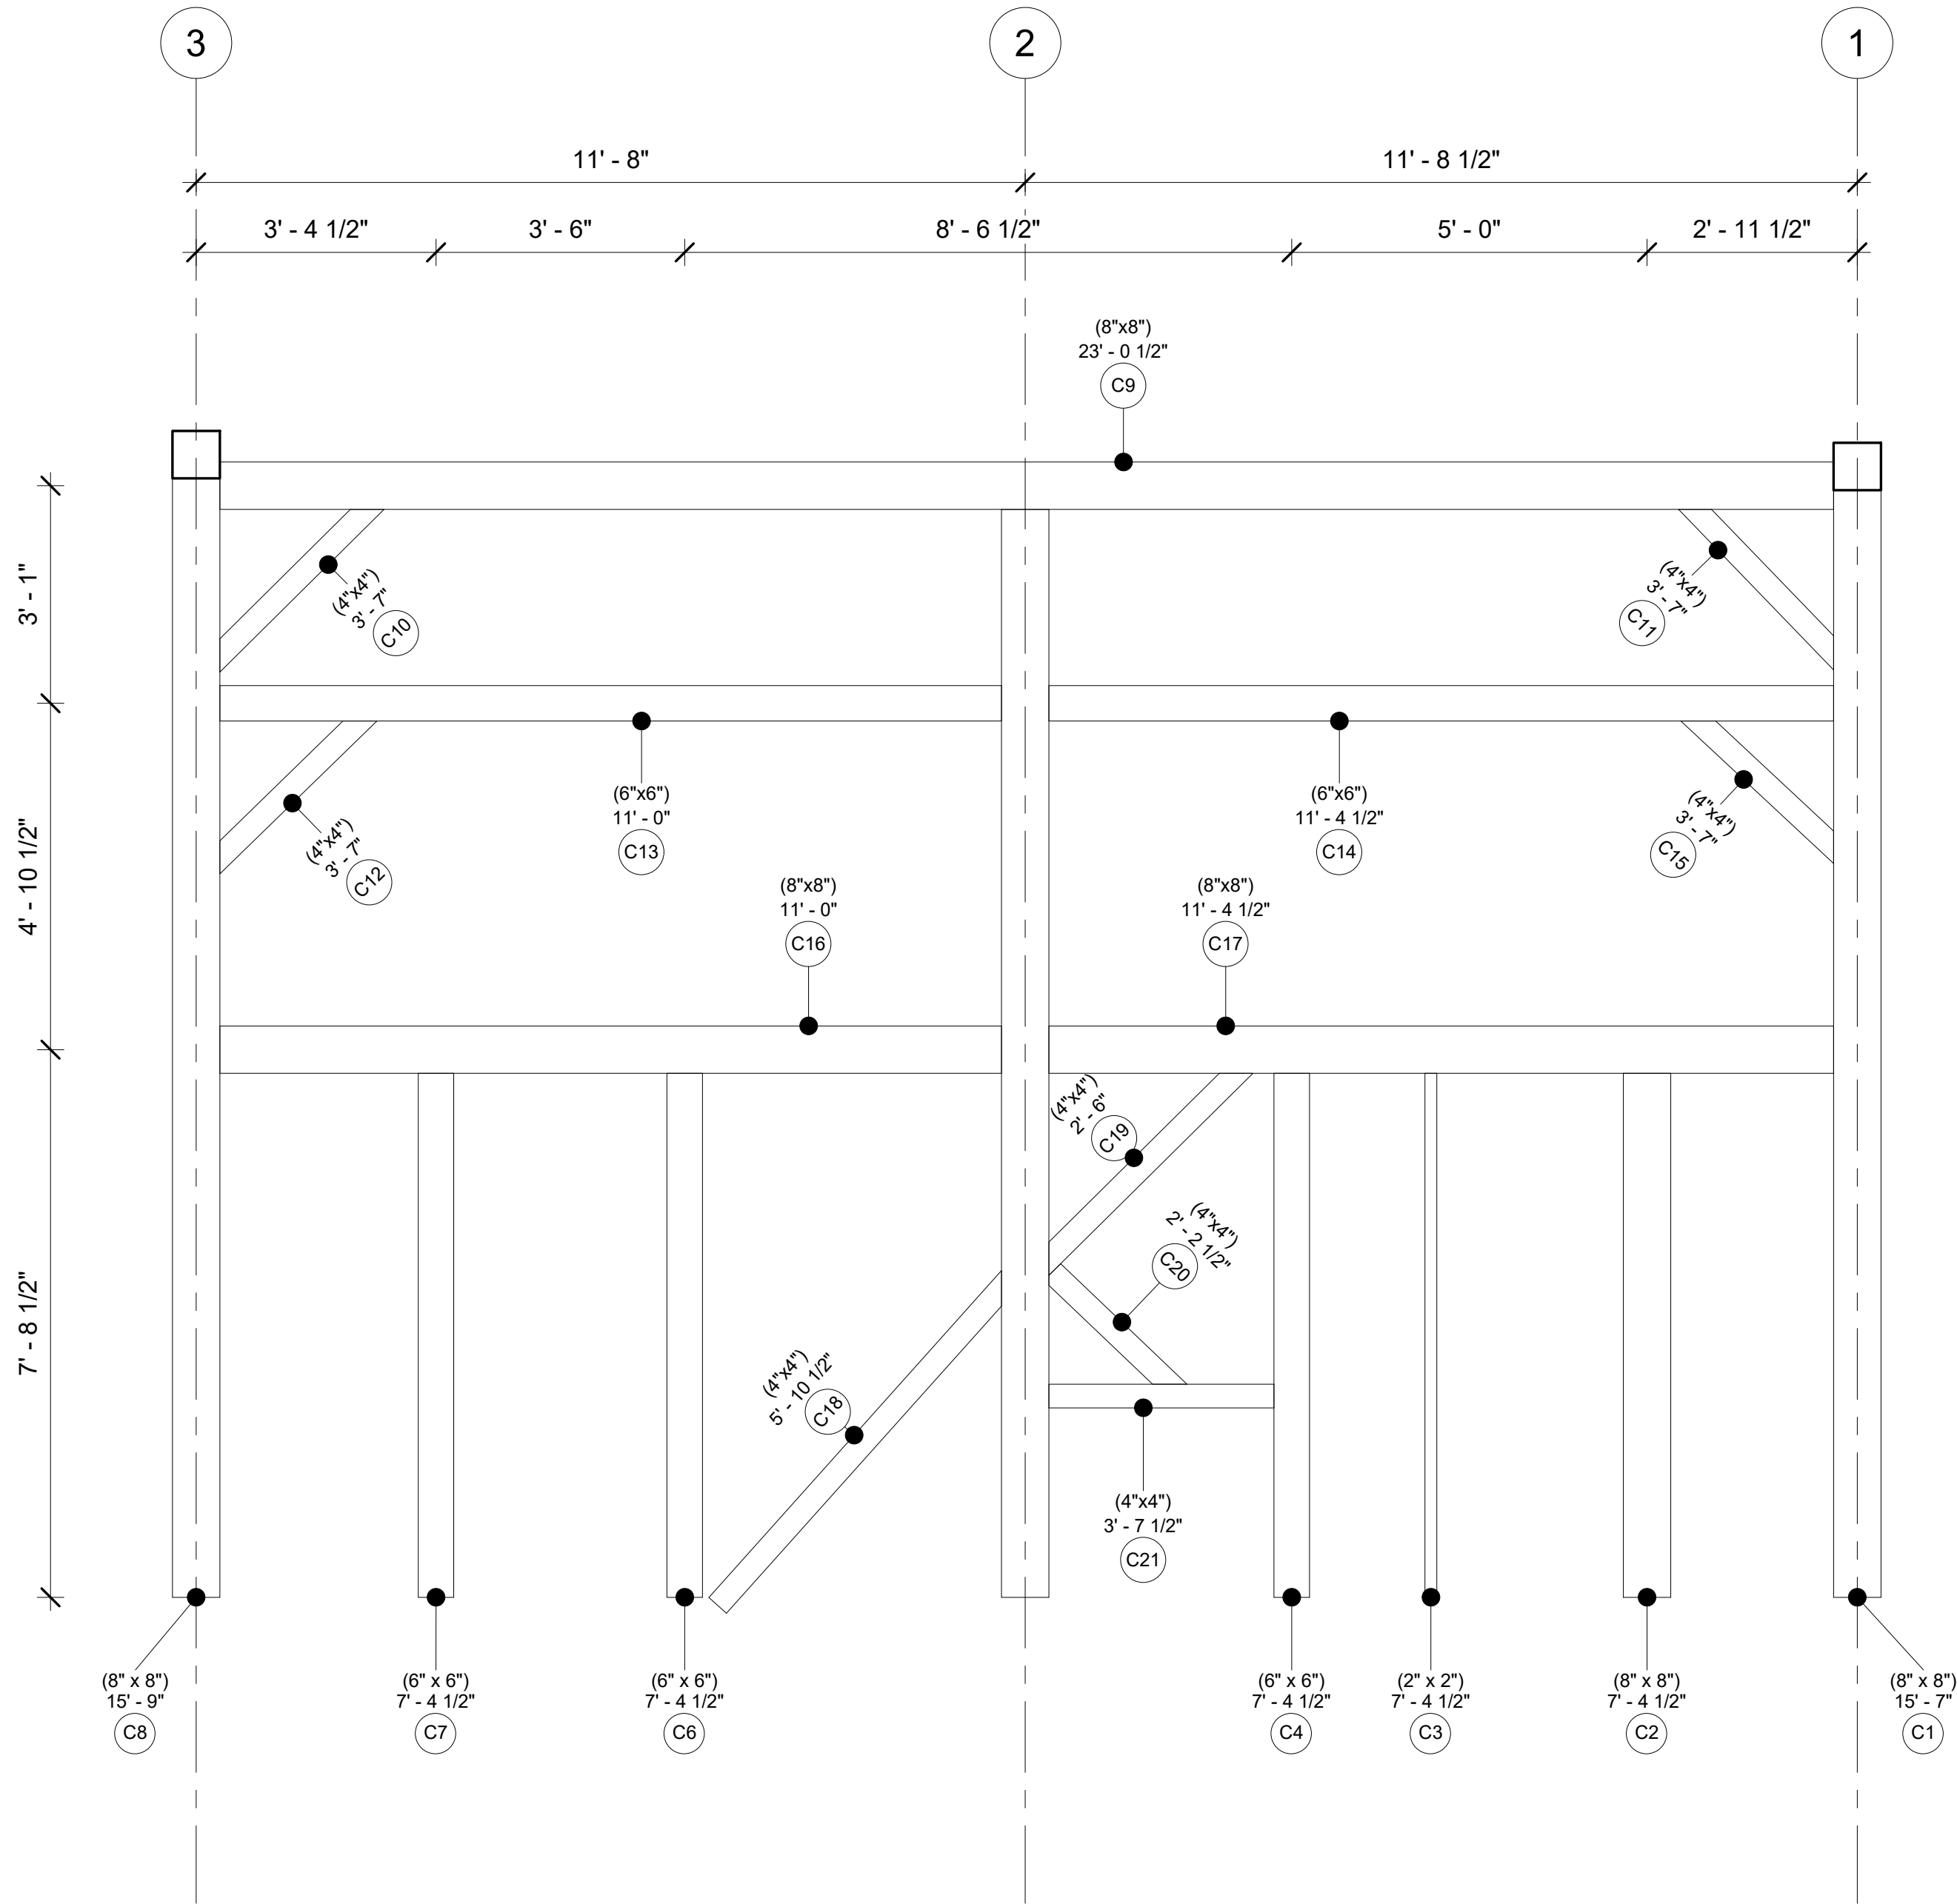

108-Little-Red

Bent D

Project Number	Project 17
Date	20251113
Drawn By	
Checked By	
A105	
Scale	1/2" = 1'-0"

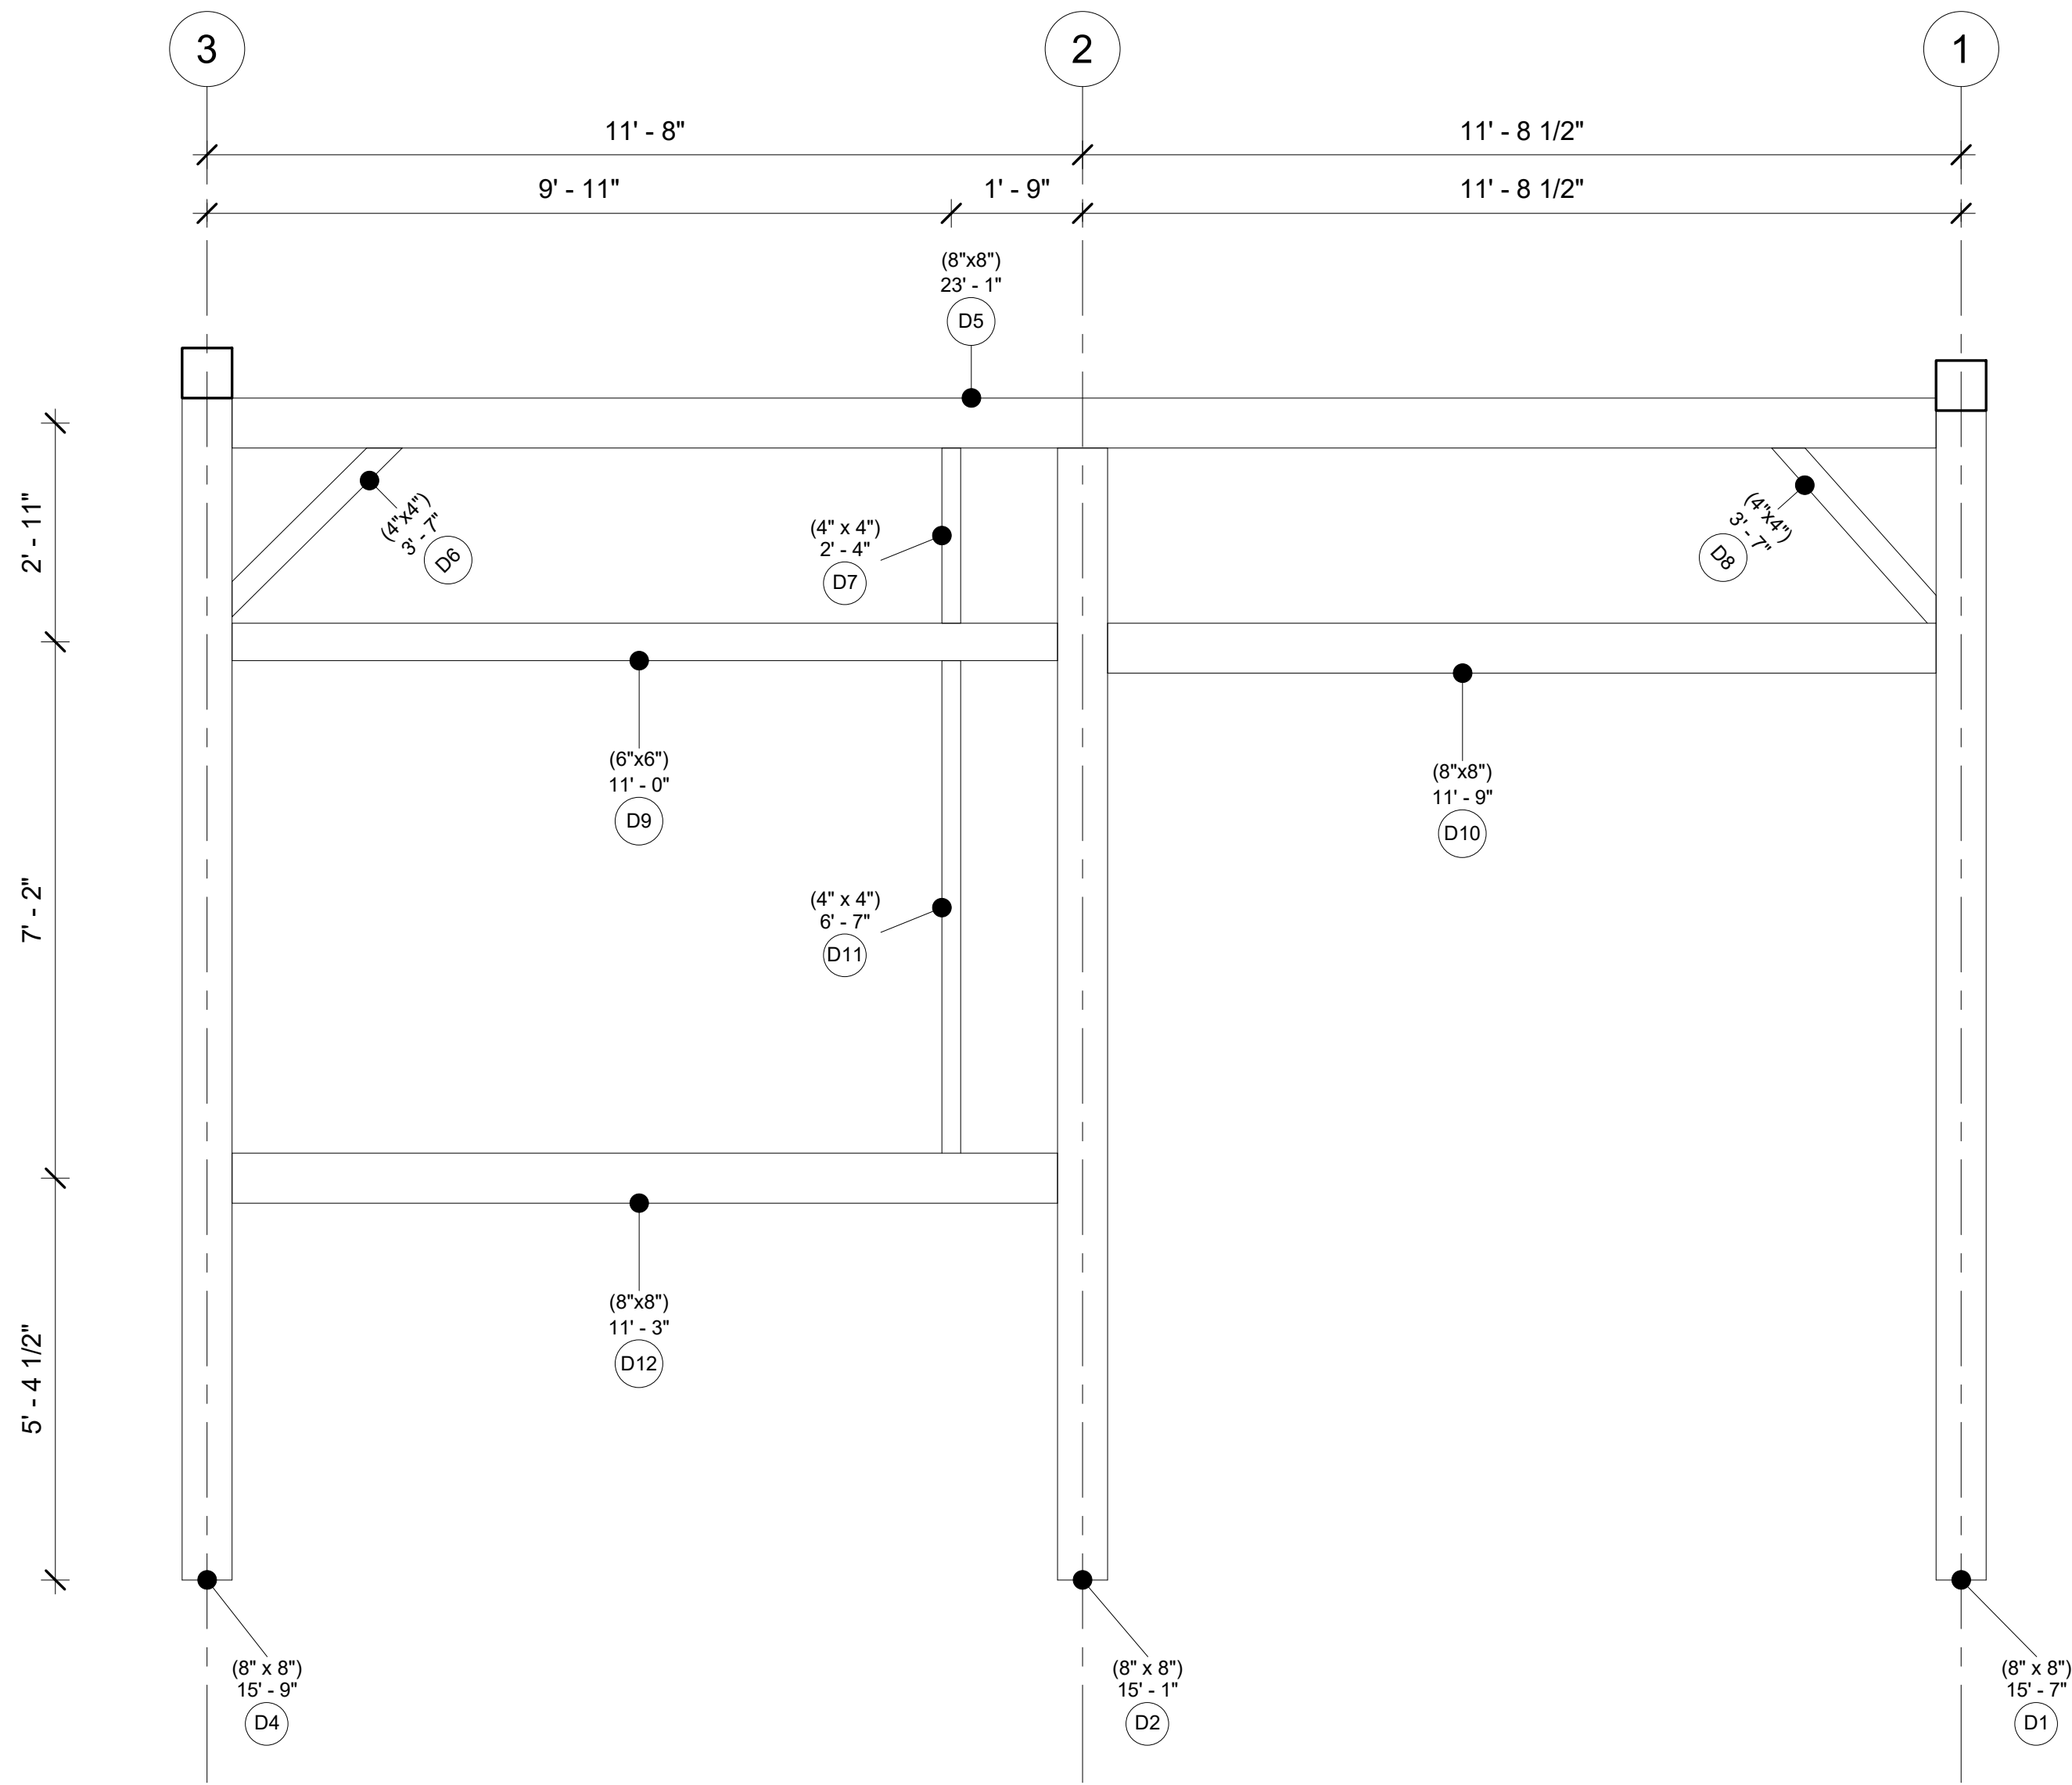


Bent F

Date	20251113
------	----------

Drawn By	
----------	--

Checked By	
------------	--


Scale	1/2" = 1'-0"
-------	--------------

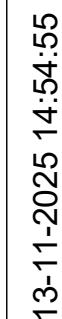


108-Little-Red

Bent 1

Project Number	Project 17
Date	20251113
Drawn By	
Checked By	
A107	
Scale	1/2" = 1'-0"

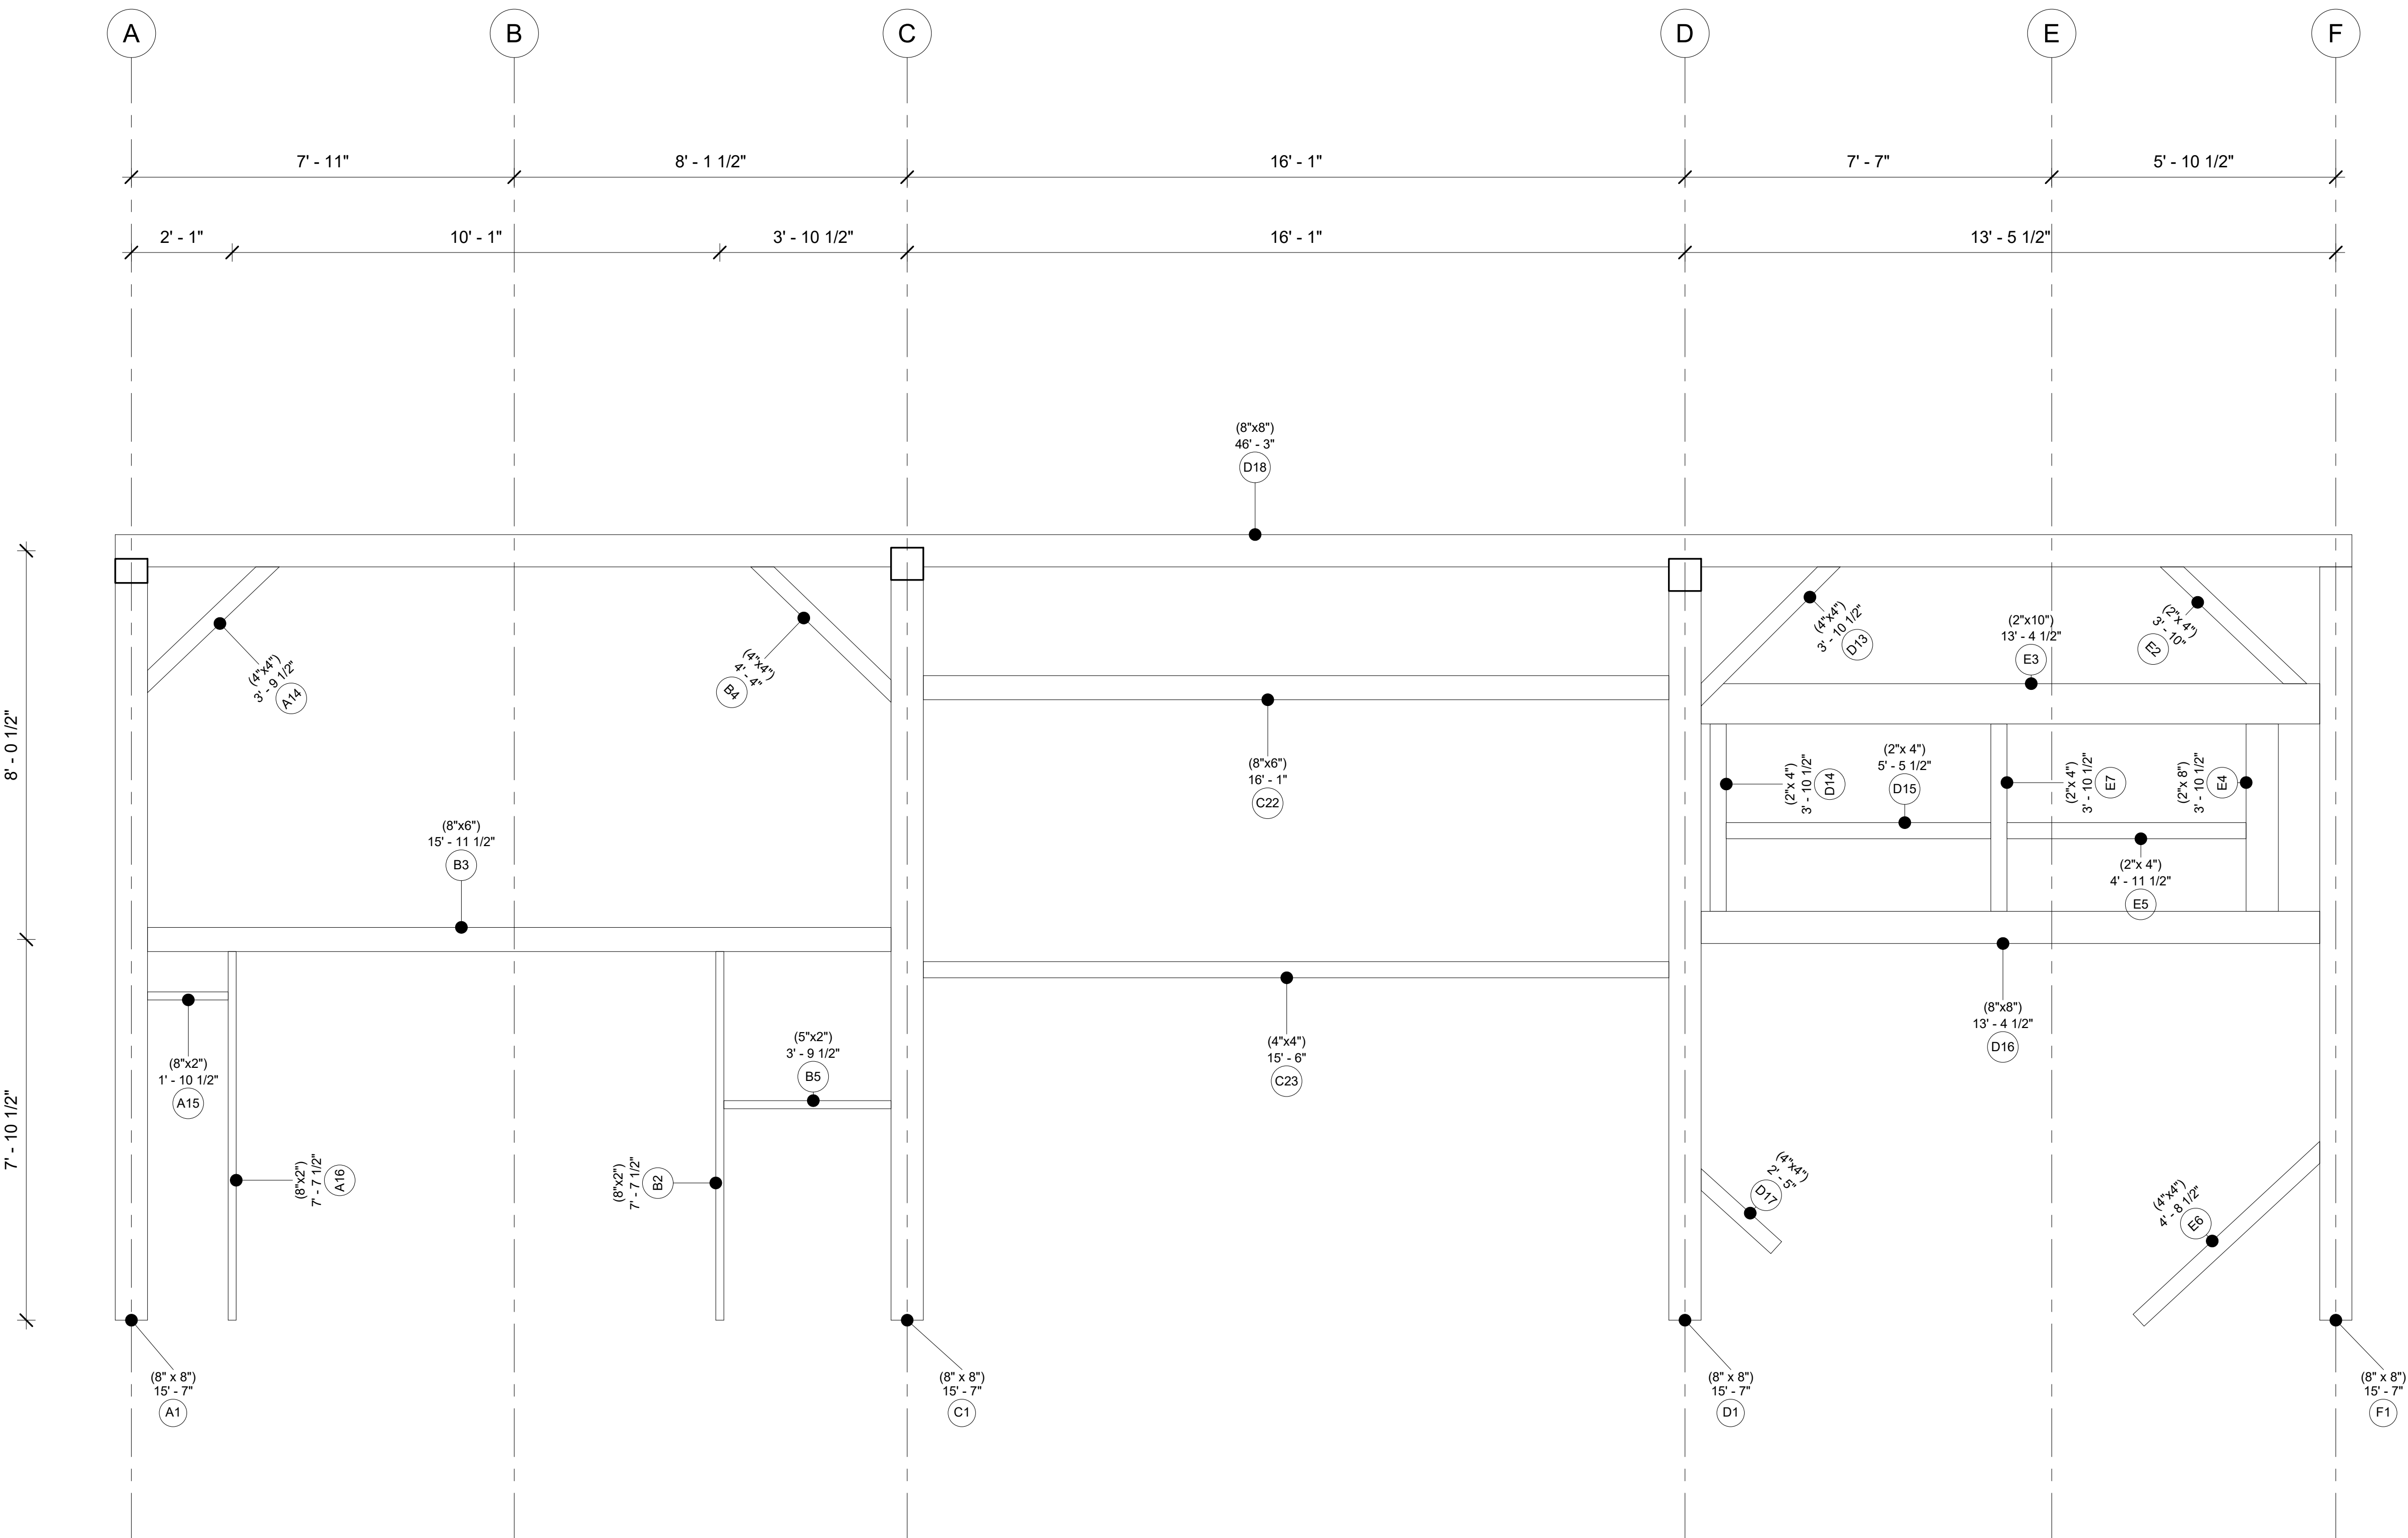

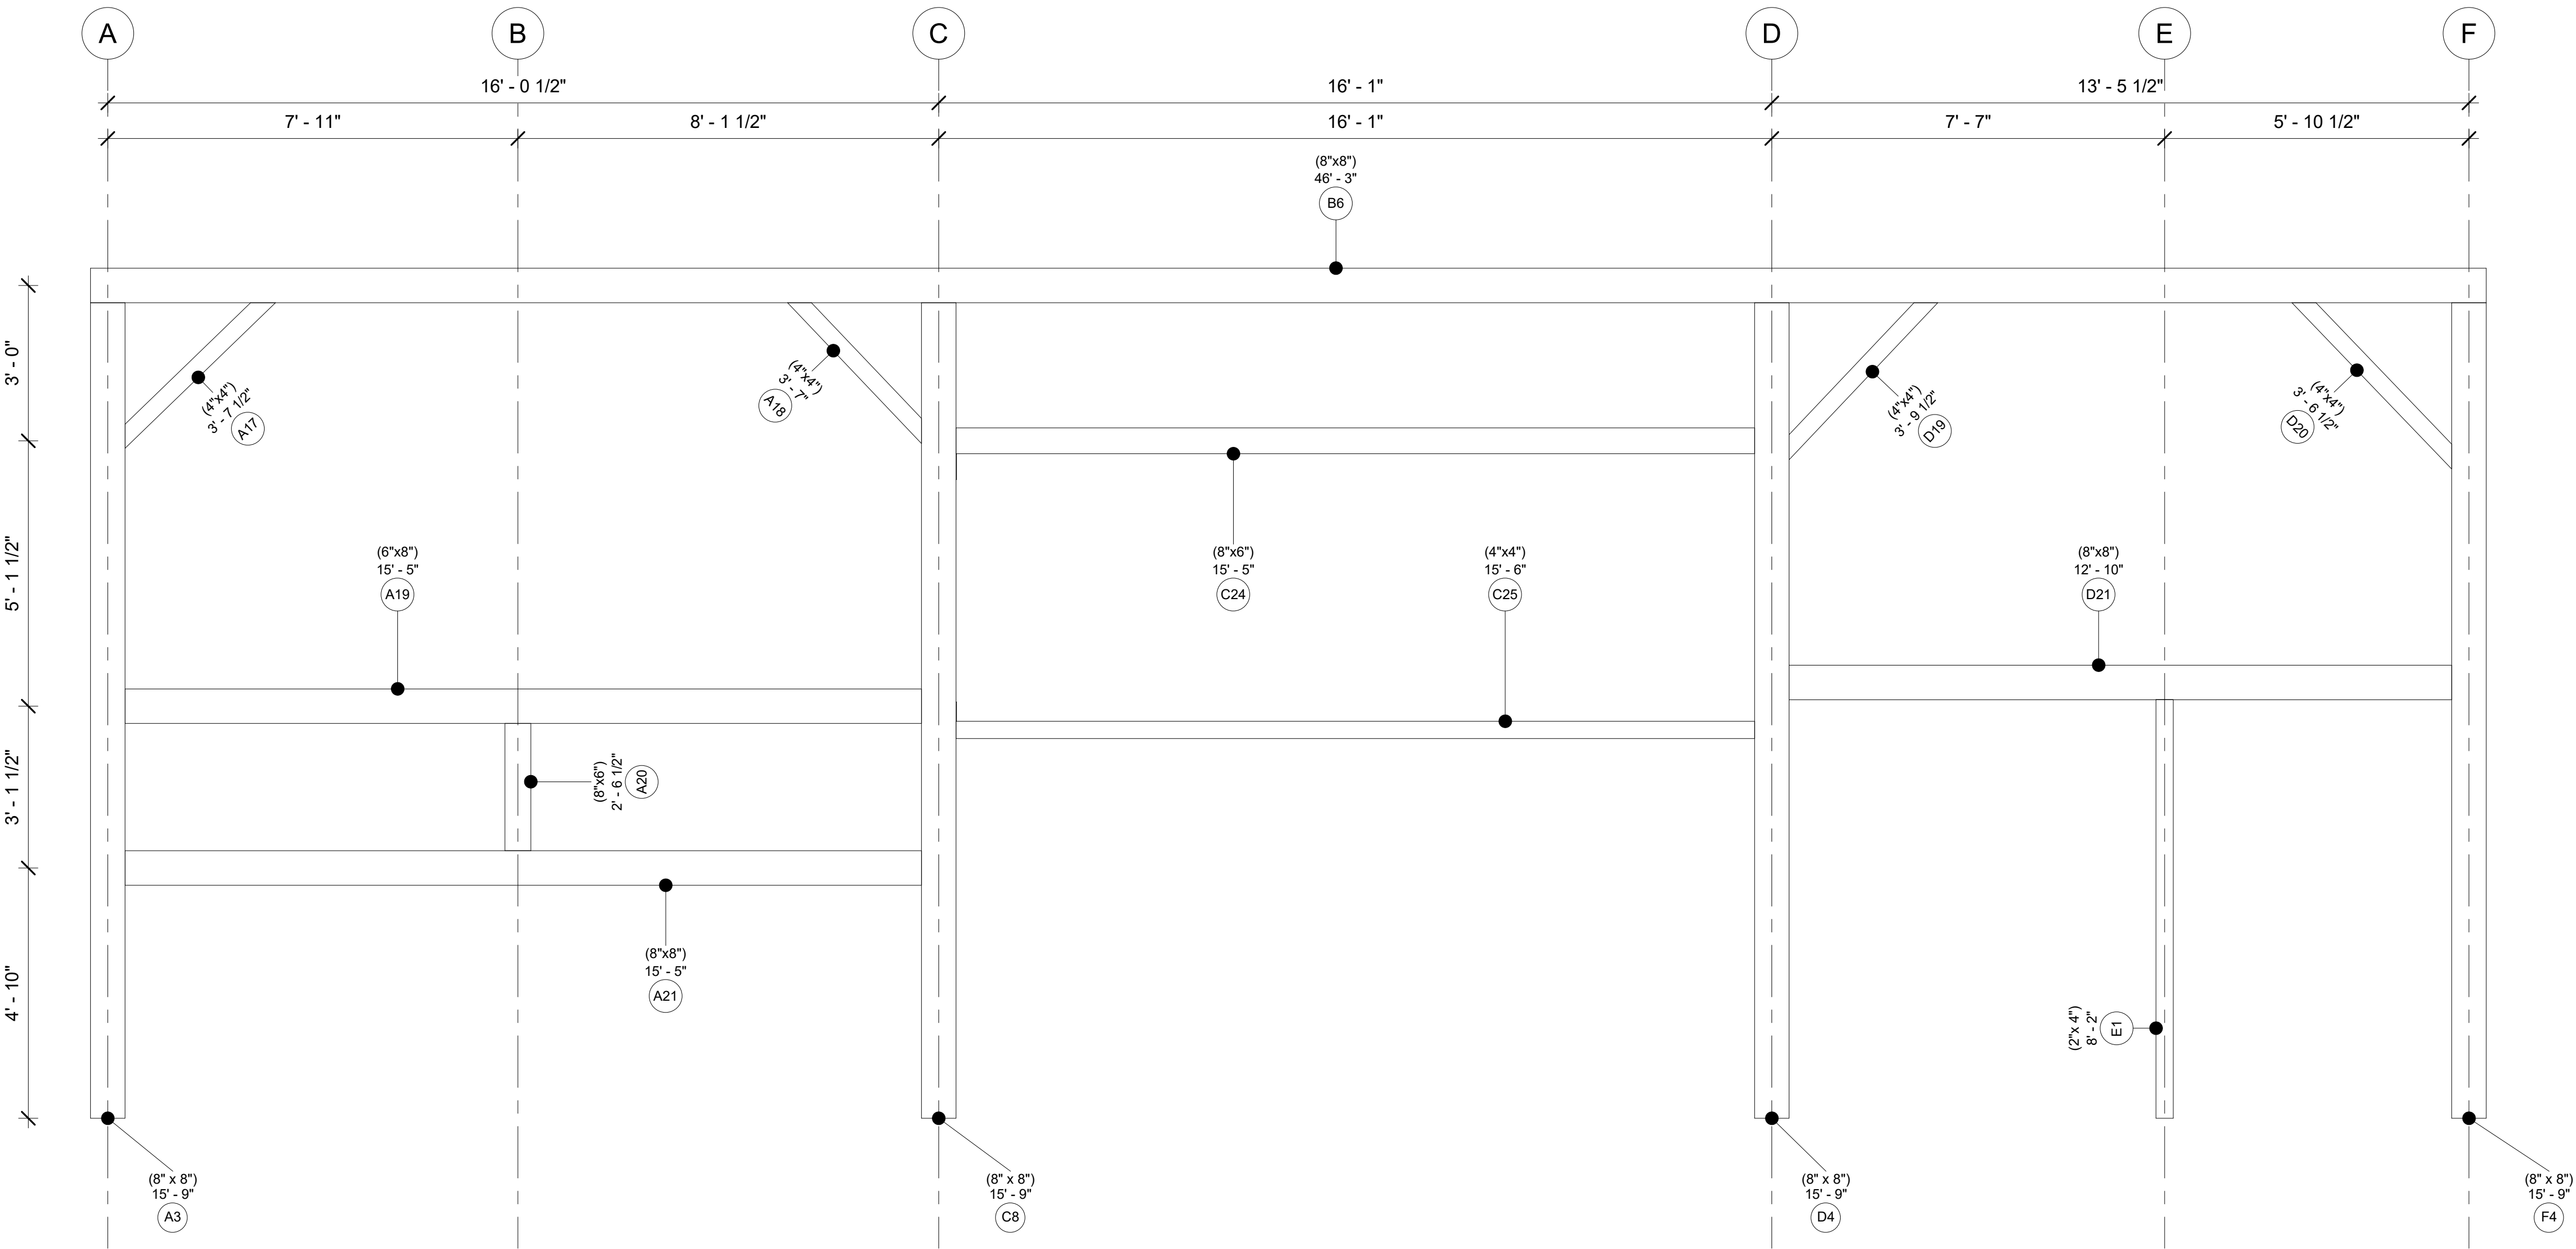

108-Little-Red

Bent 3

Project Number	Project 17
Date	20251113
Drawn By	
Checked By	
A108	
Scale	1/2" = 1'-0"