


PROJECT: 111-Whimsy-Creek
SCOPE: AS BUILT DRAWINGS

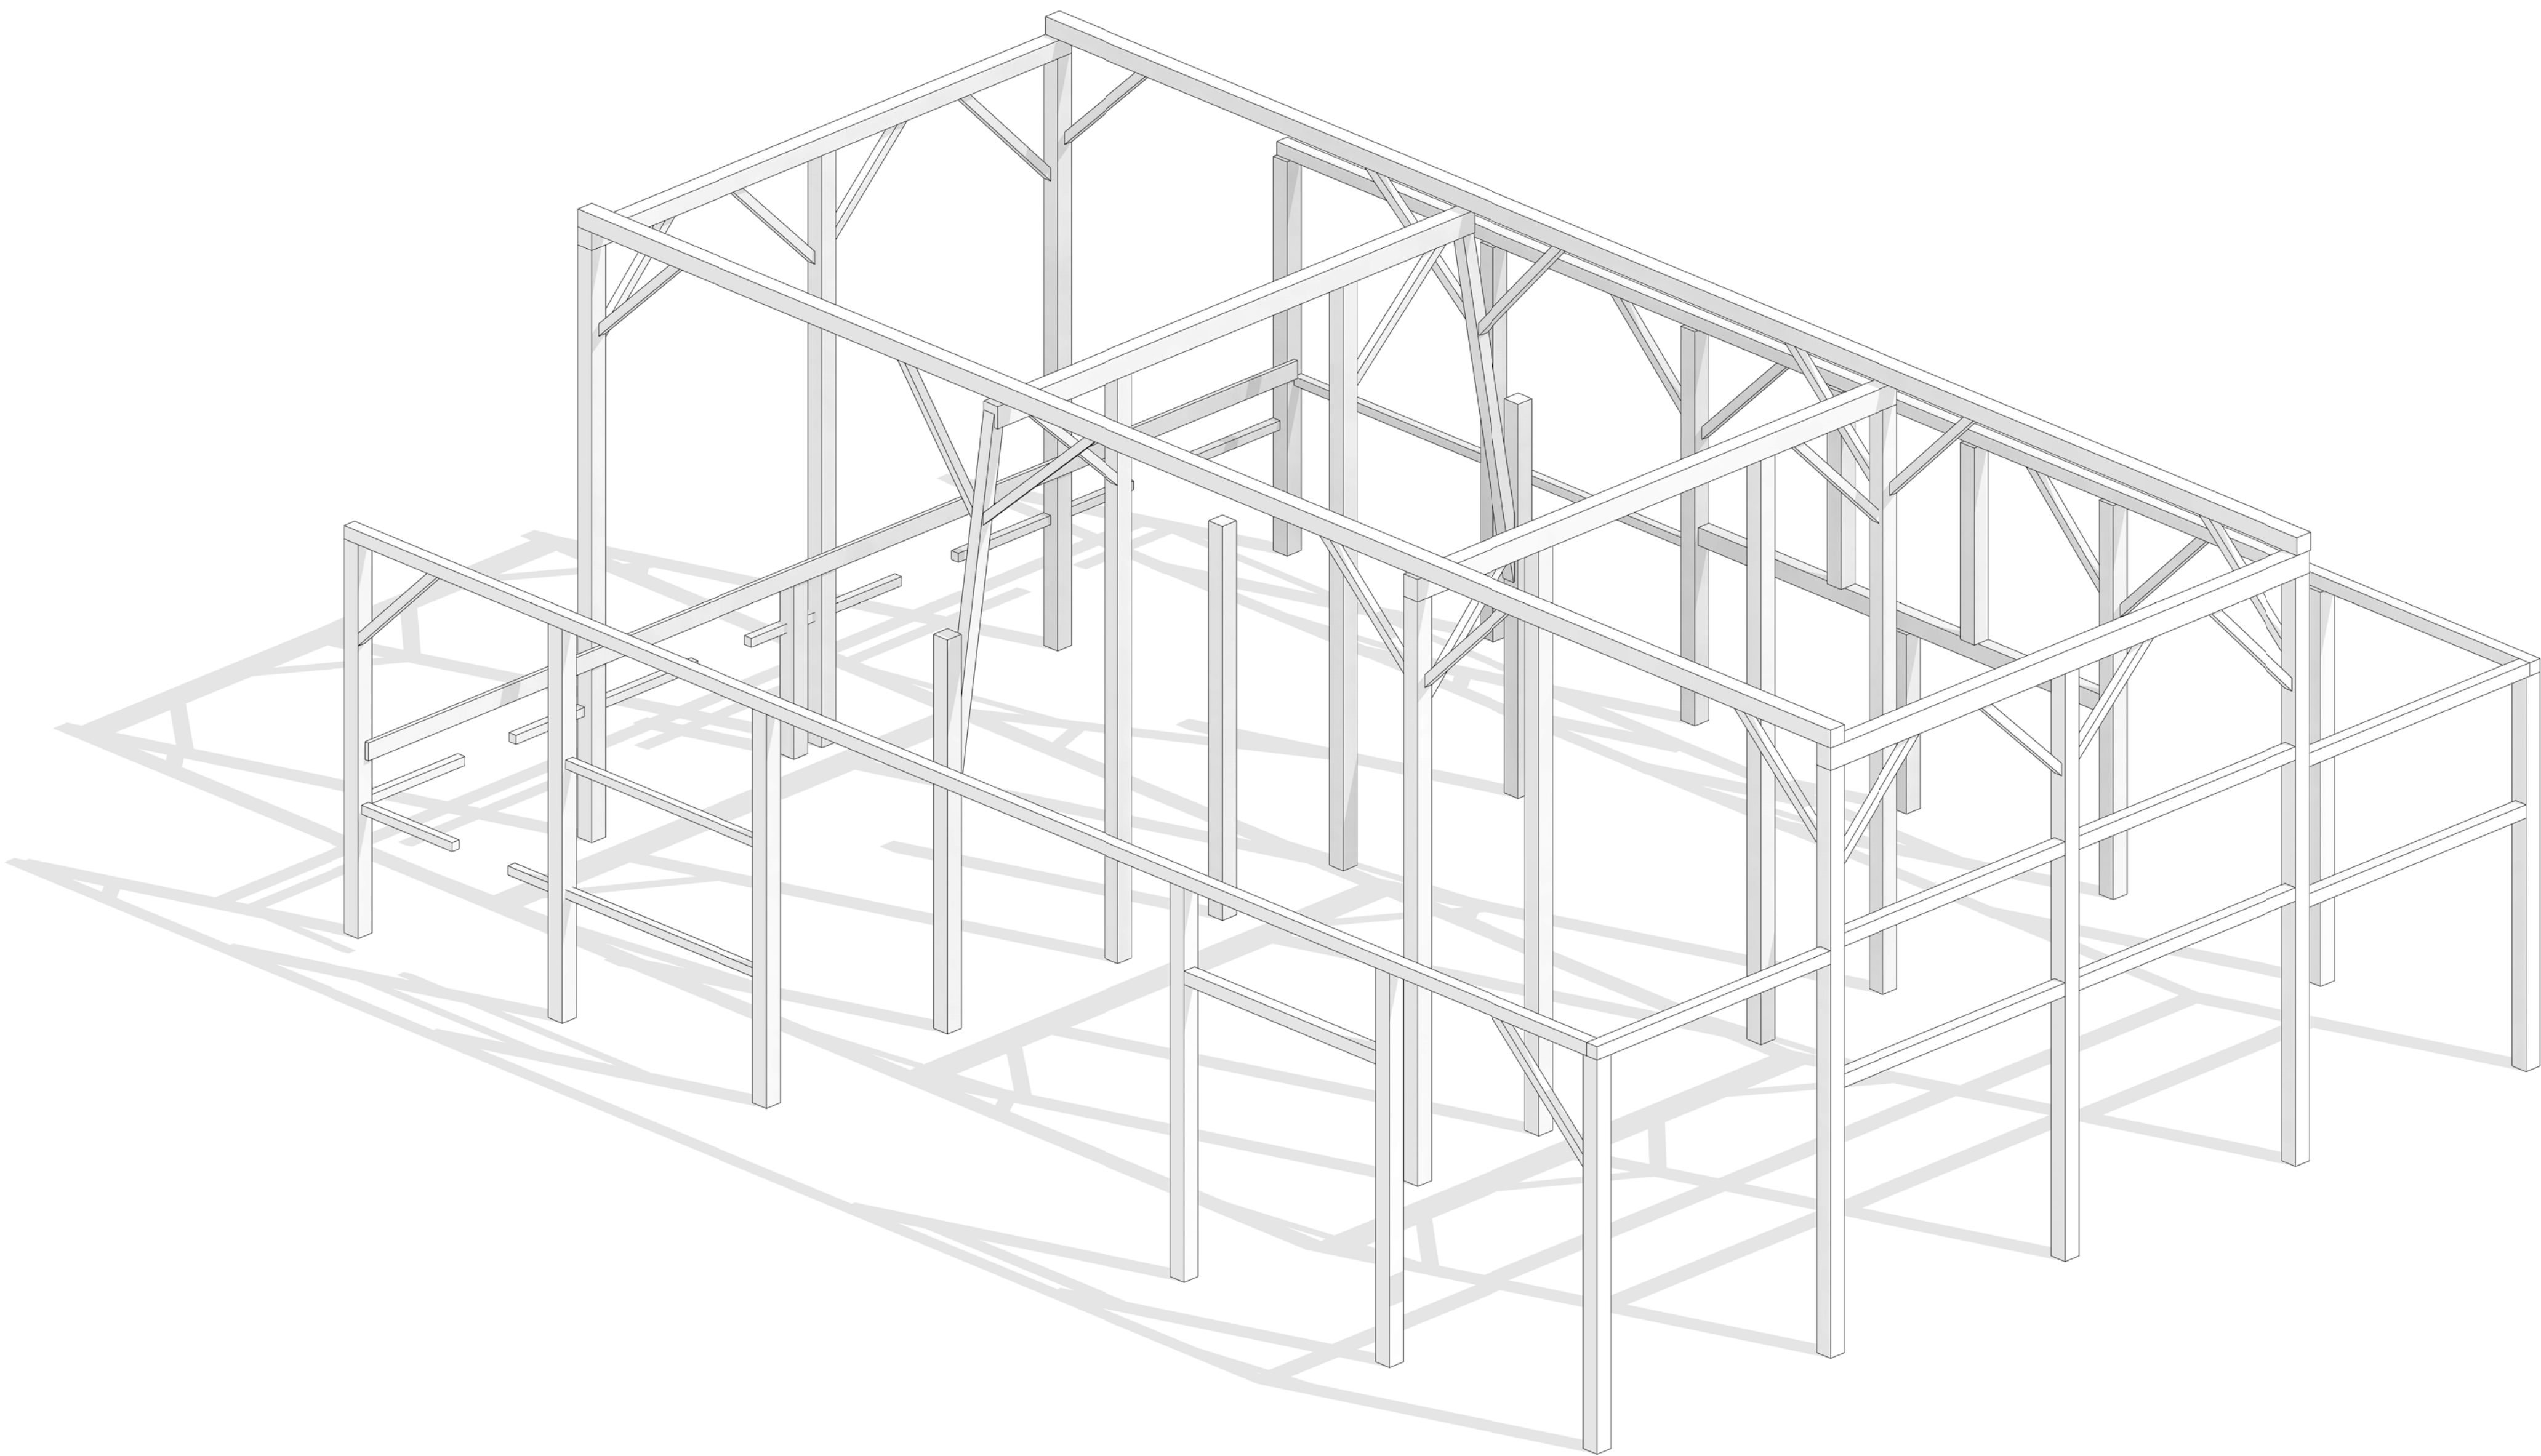

111-Whimsy-Creek

Cover Page

Project Number	Project 1
Date	20251120
Drawn By	
Checked By	
A101	
Scale	

111-Whimsy-Creek

Ground

Project Number	Project 1
----------------	-----------


Date	20251120
------	----------


Drawn By

Checked By	
------------	--

A102

Scale	1/4" = 1'-0"
-------	--------------

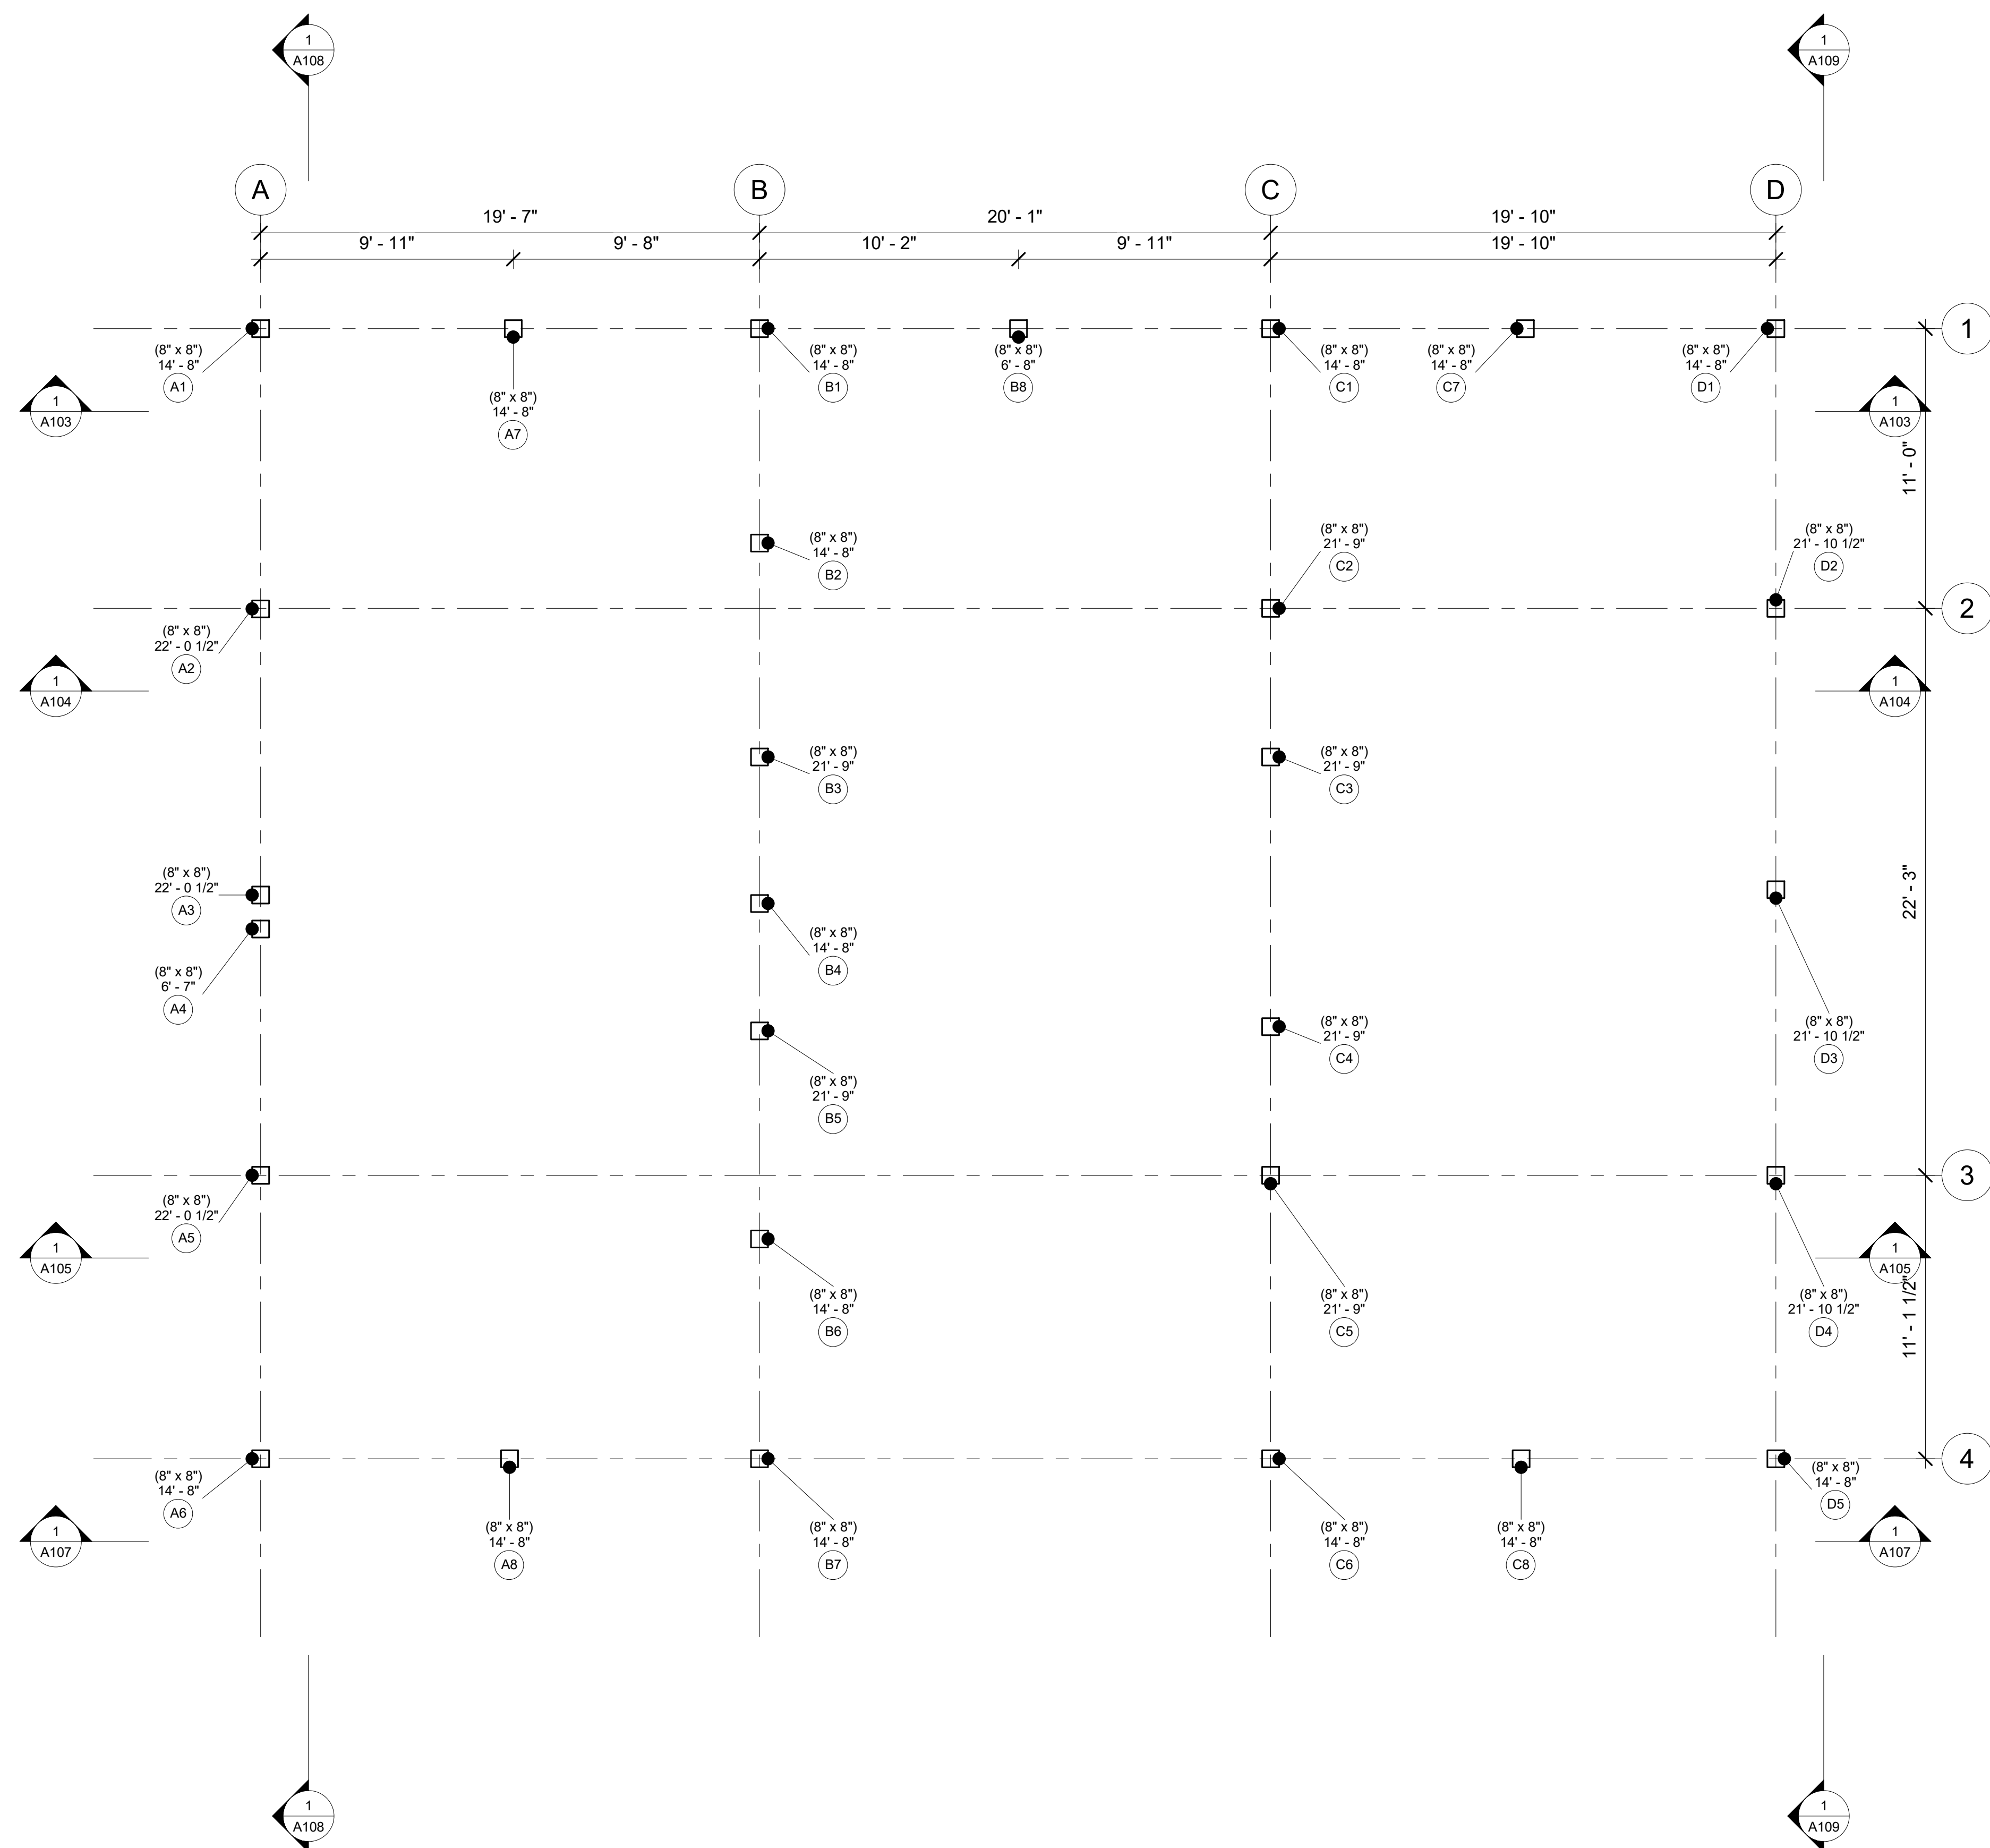


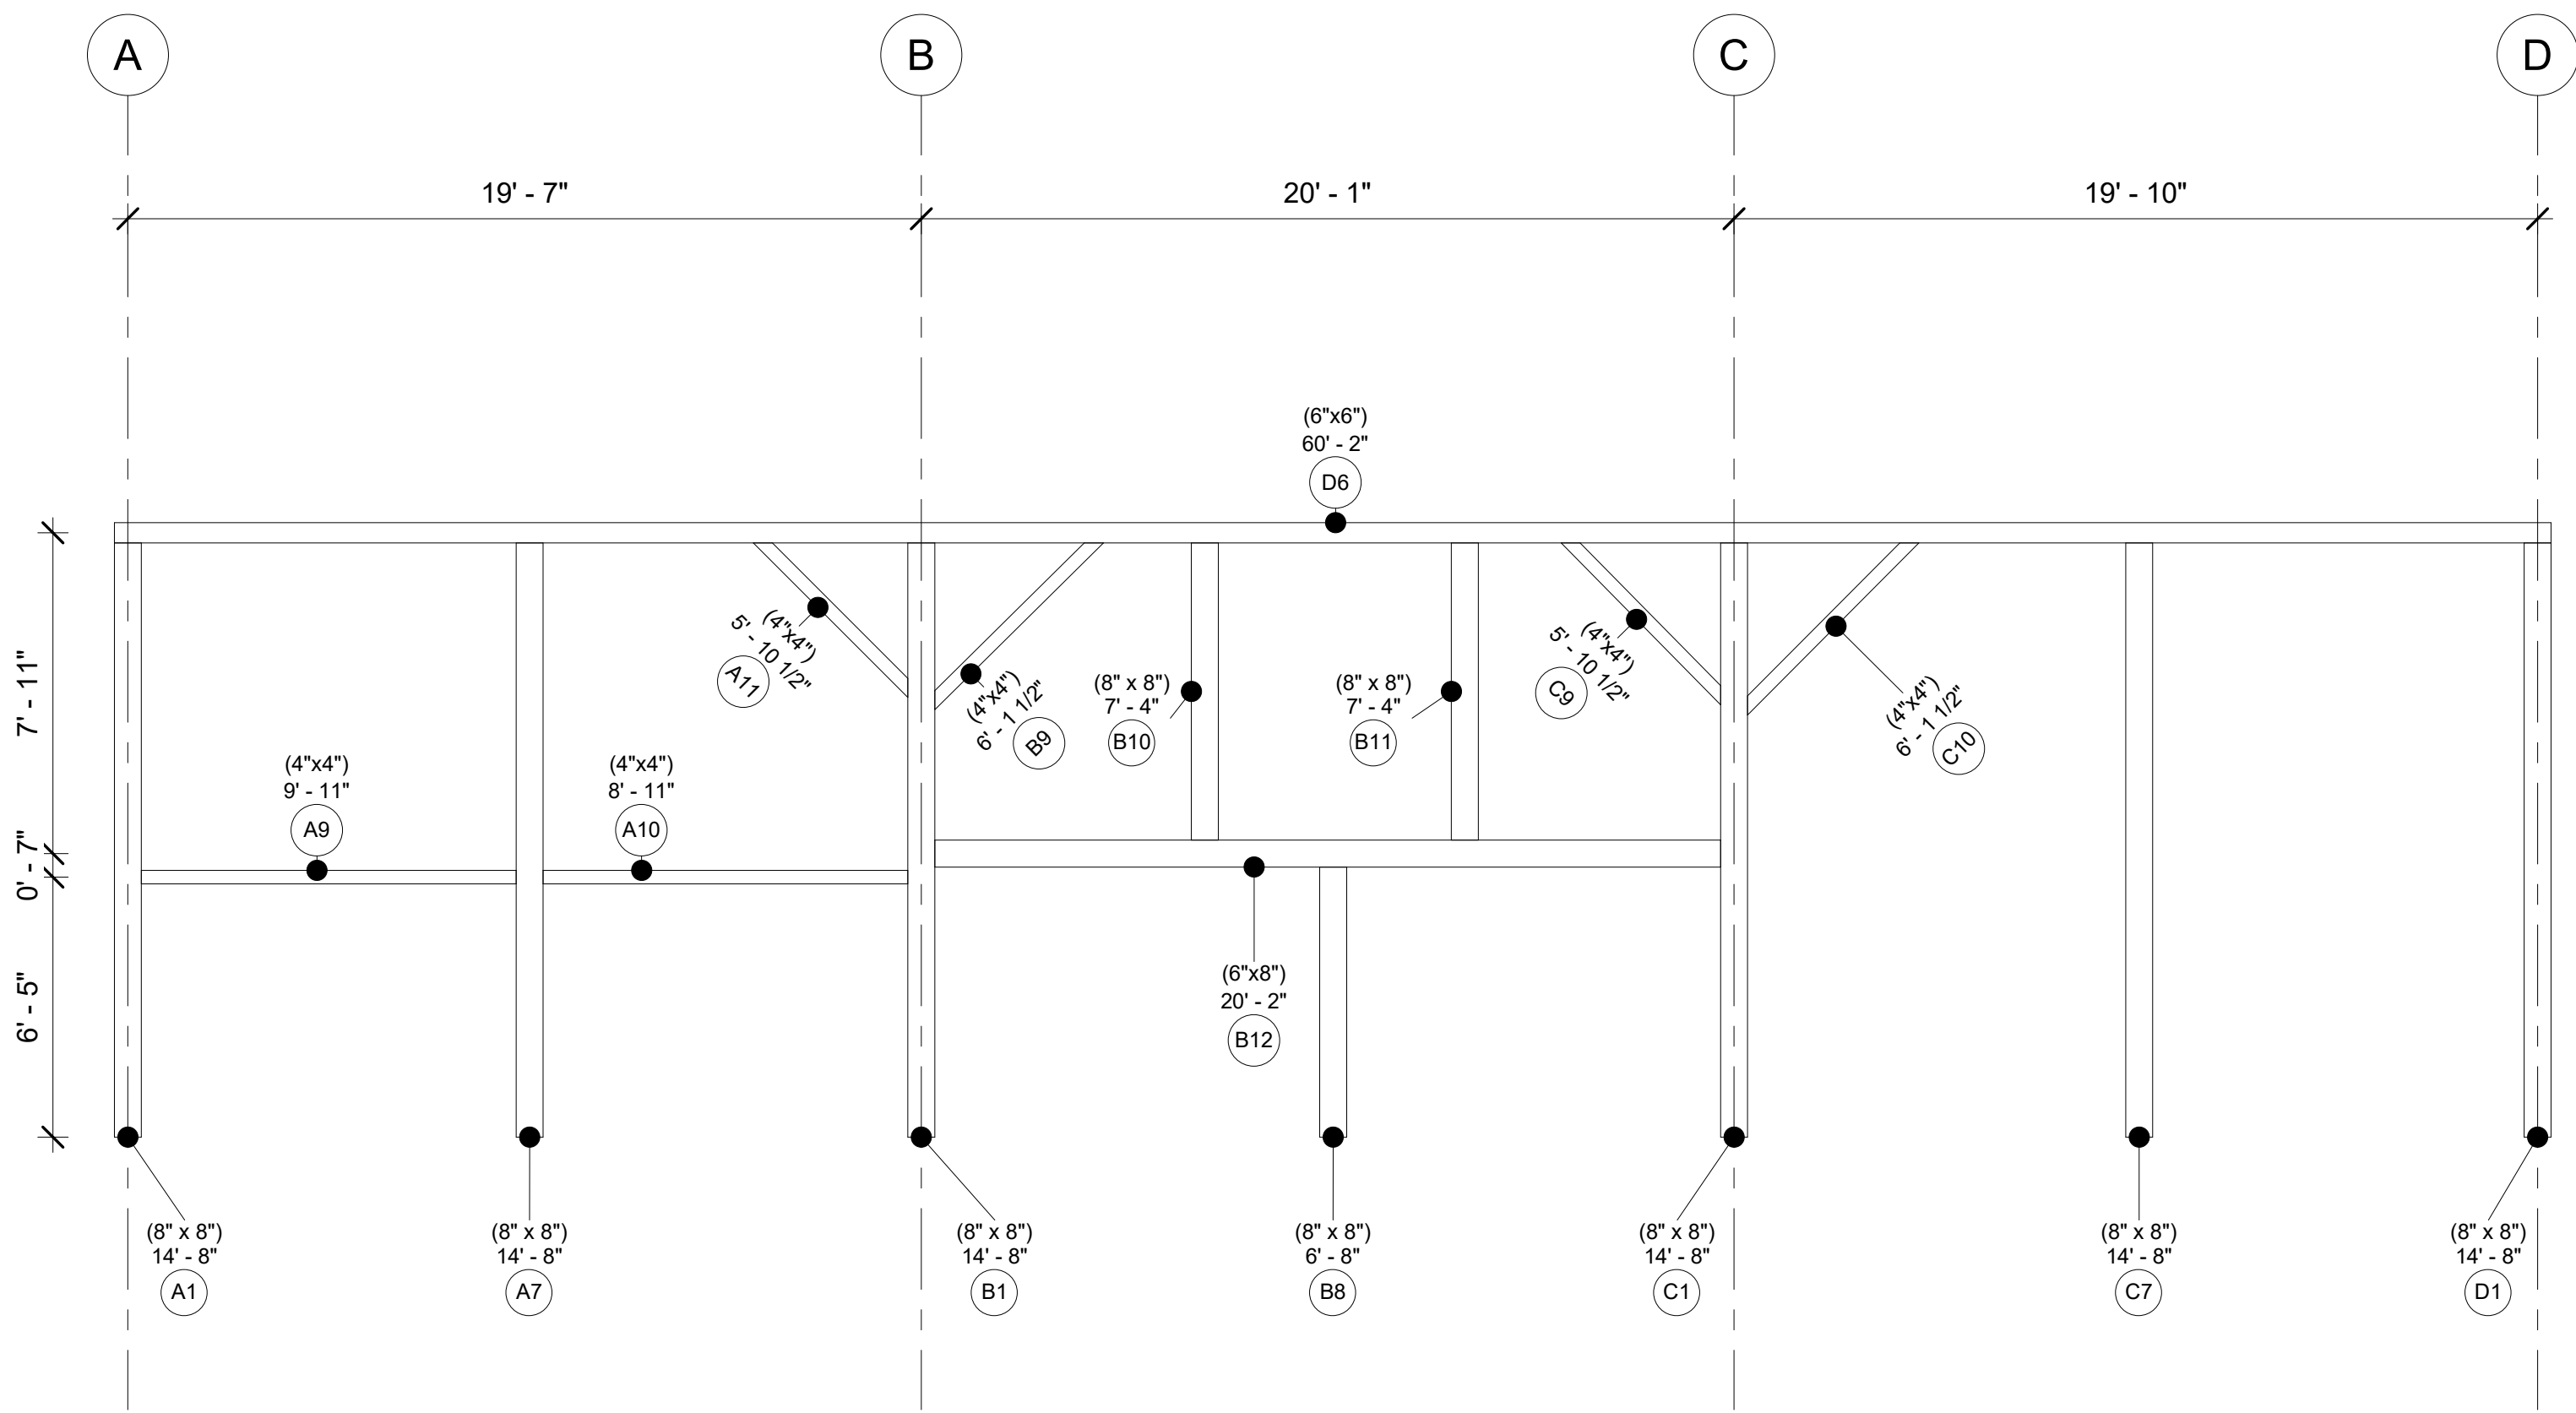

111-Whimsy-Creek

Bent 1


Project Number	Project 1
Date	20251120
Drawn By	
Checked By	
A103	
Scale	1/4" = 1'-0"

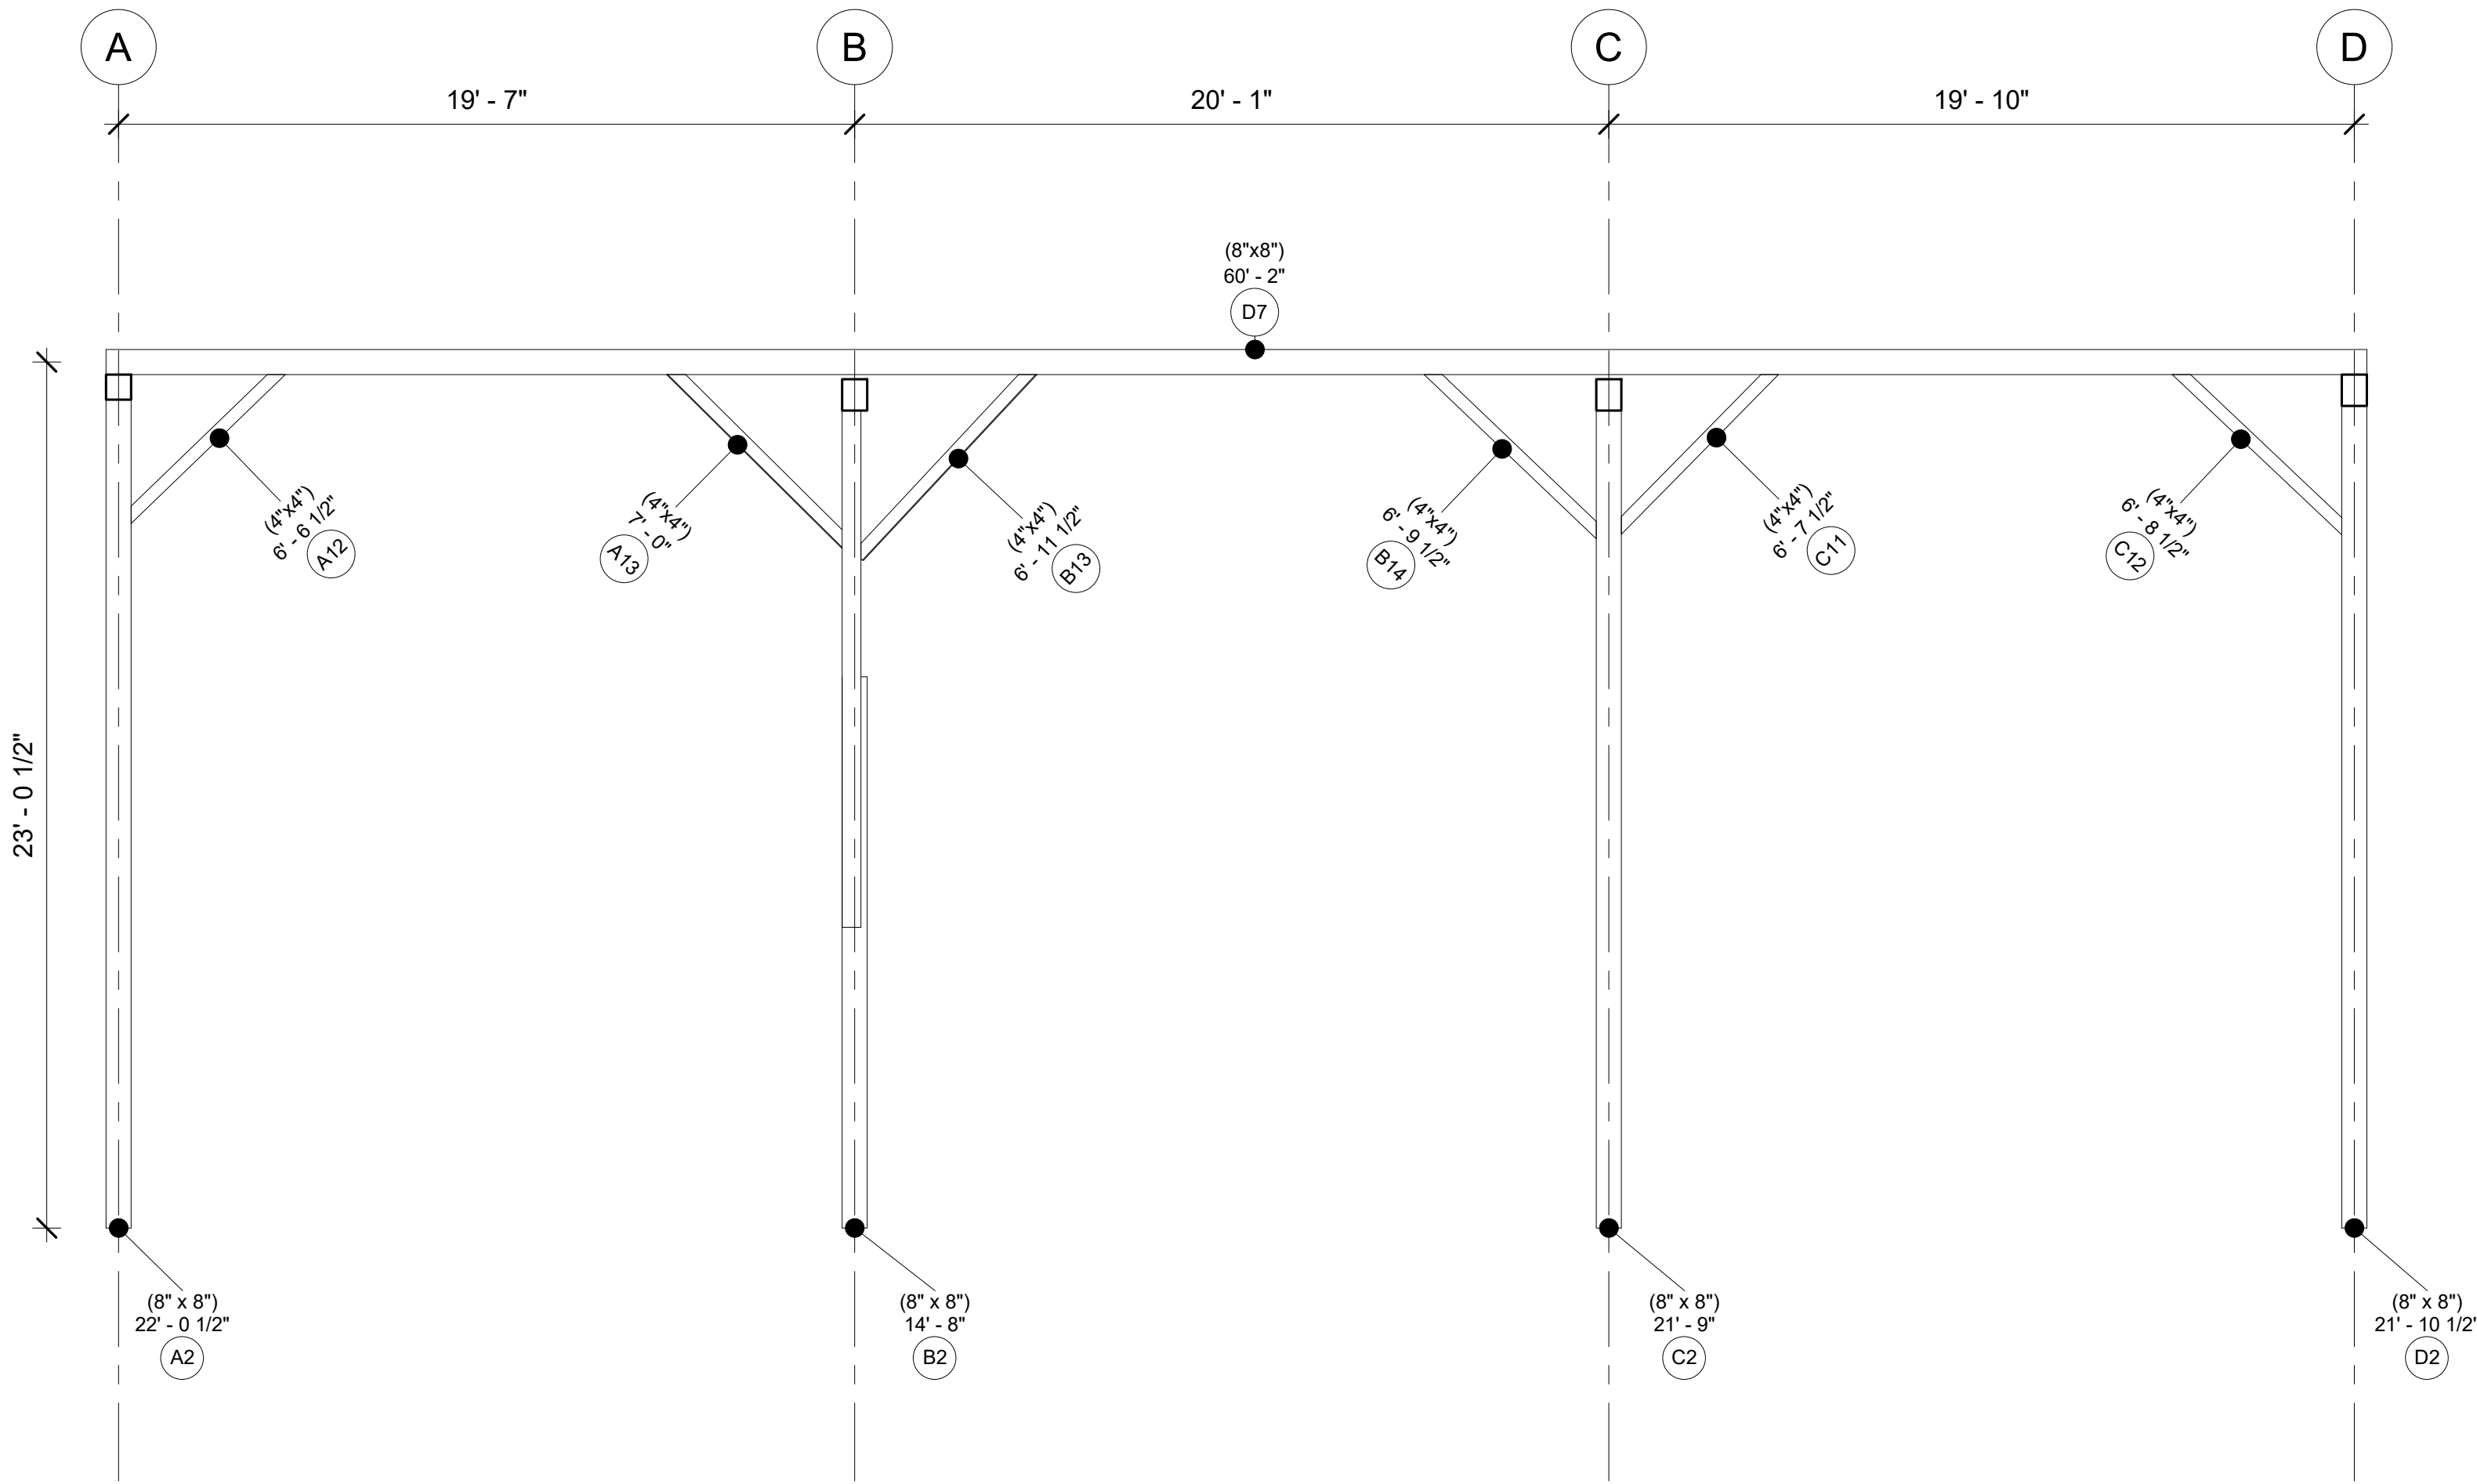

111-Whimsy-Creek

Bent 2


Project Number	Project 1
Date	20251120
Drawn By	
Checked By	
A104	
Scale	1/4" = 1'-0"

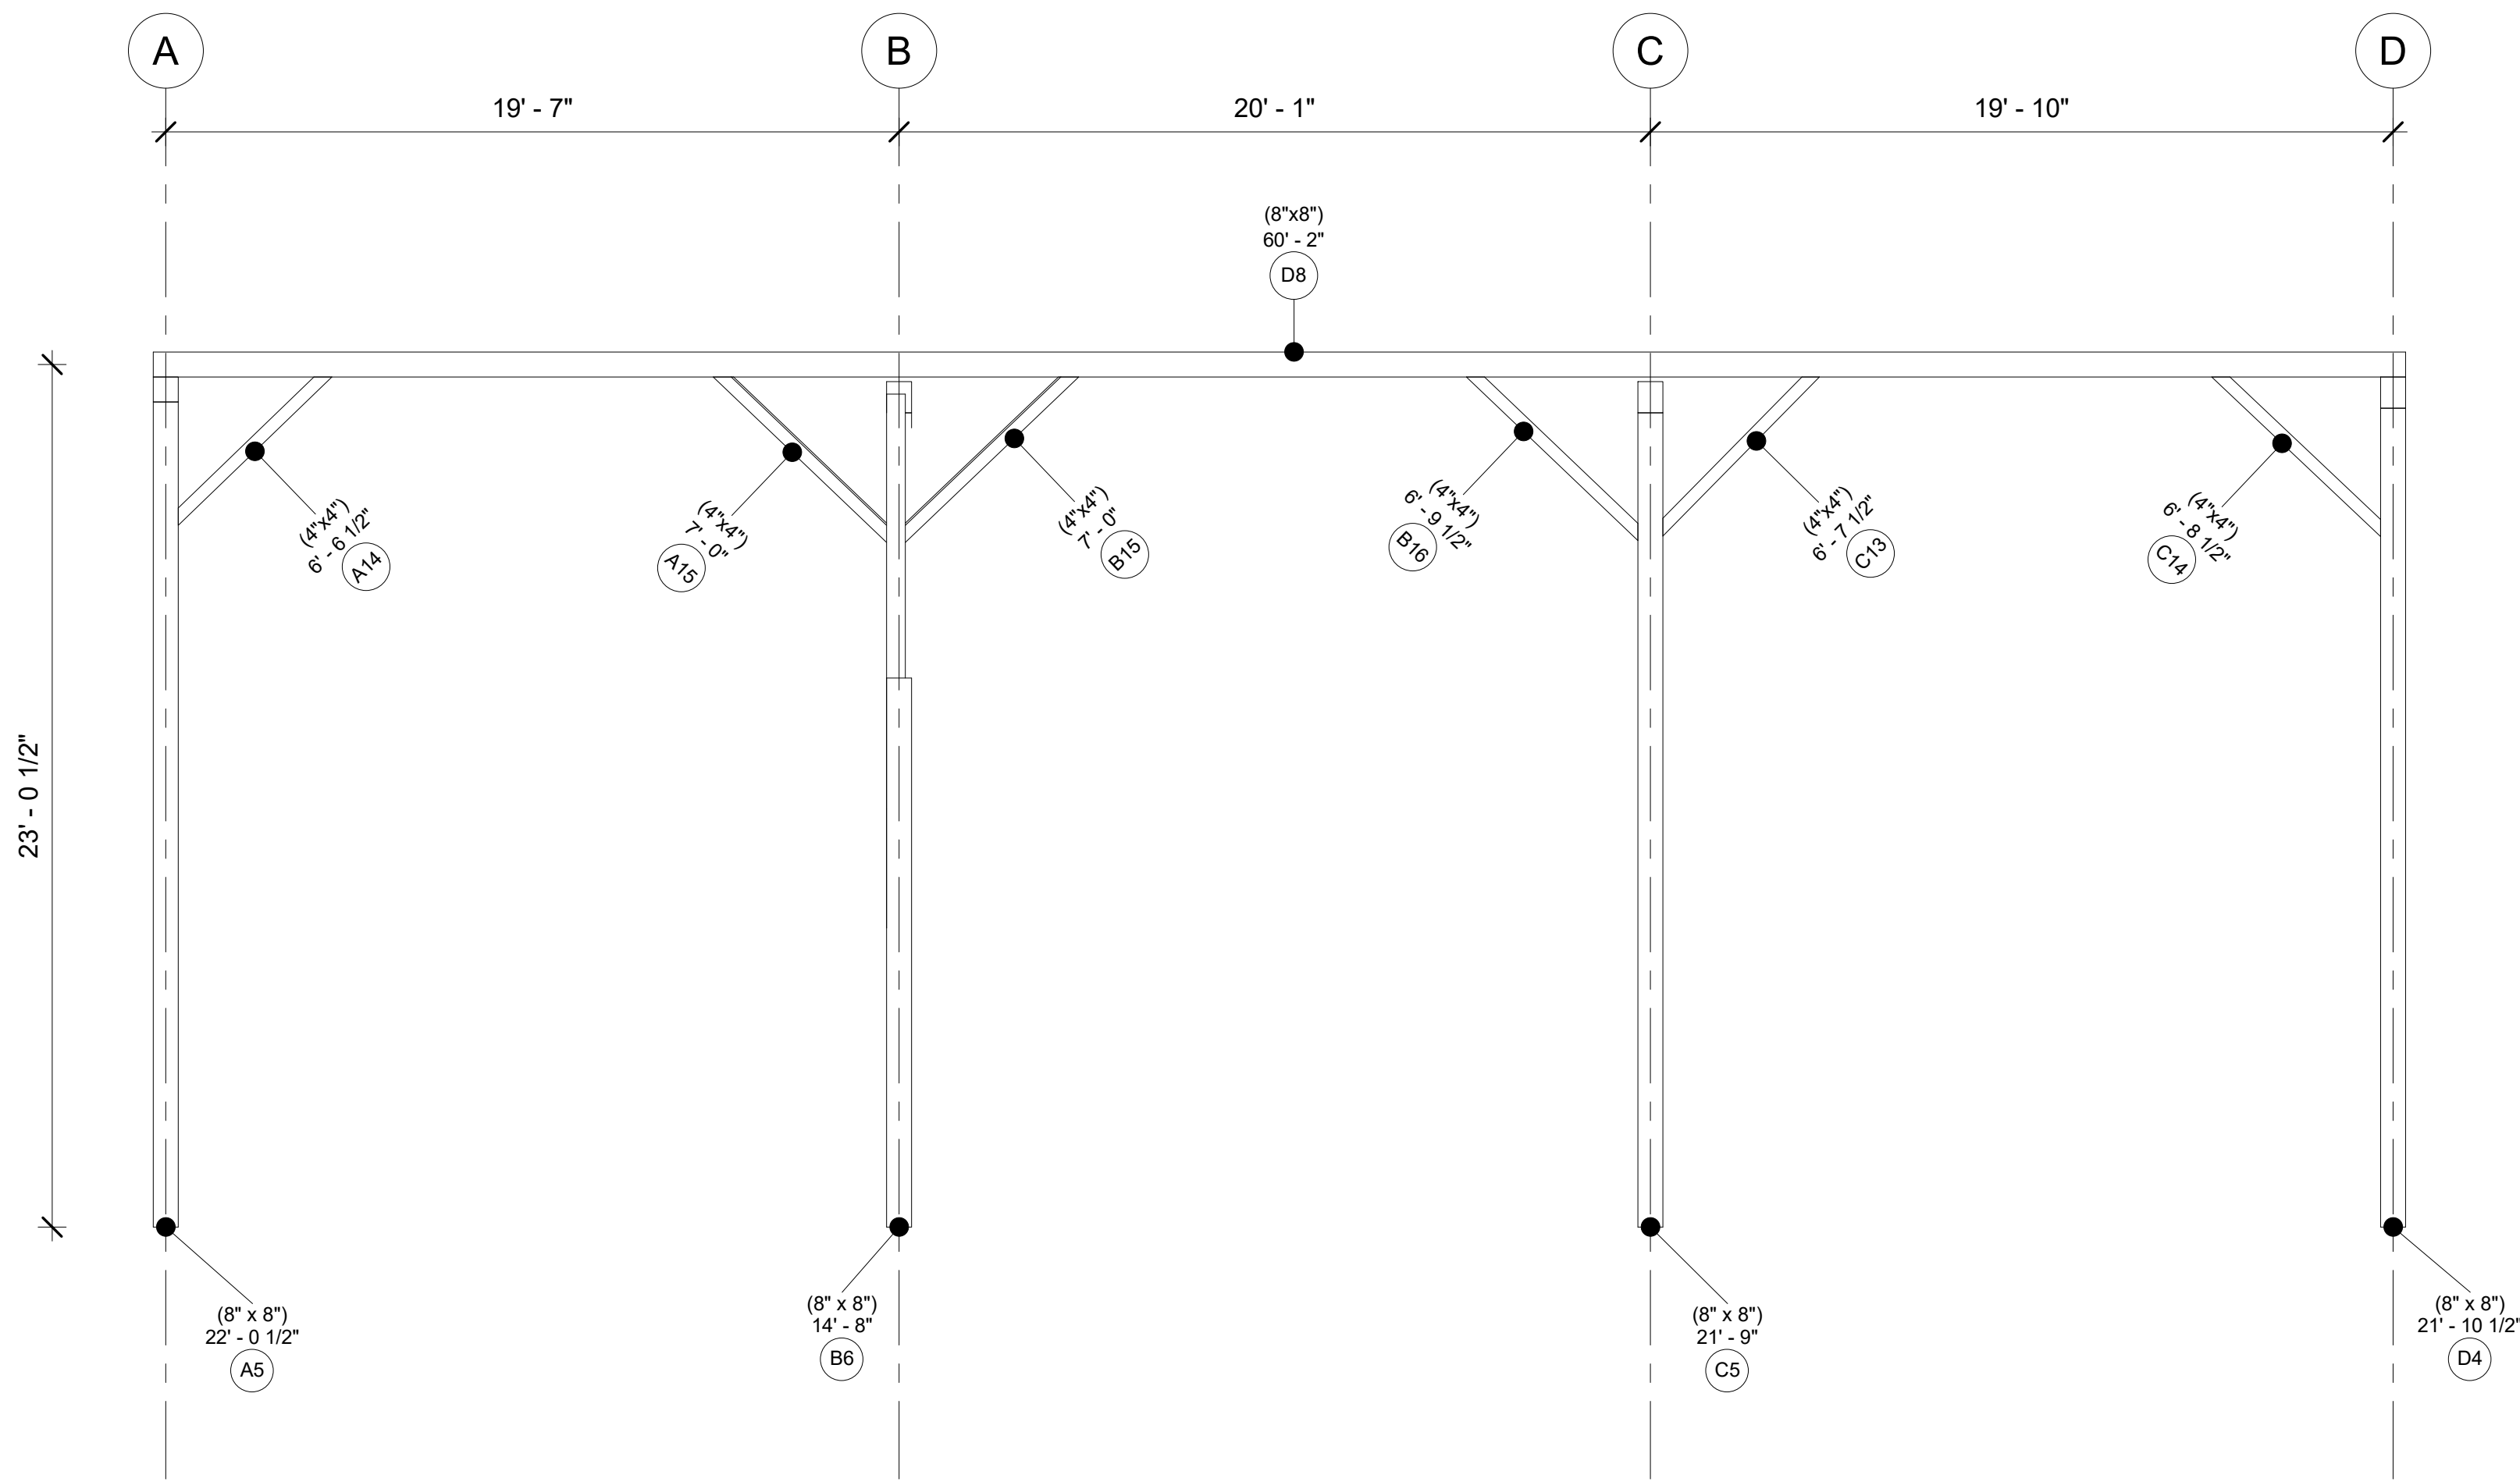

111-Whimsy-Creek

Bent 3

Project Number	Project 1
Date	20251120
Drawn By	
Checked By	
A105	
Scale	1/4" = 1'-0"

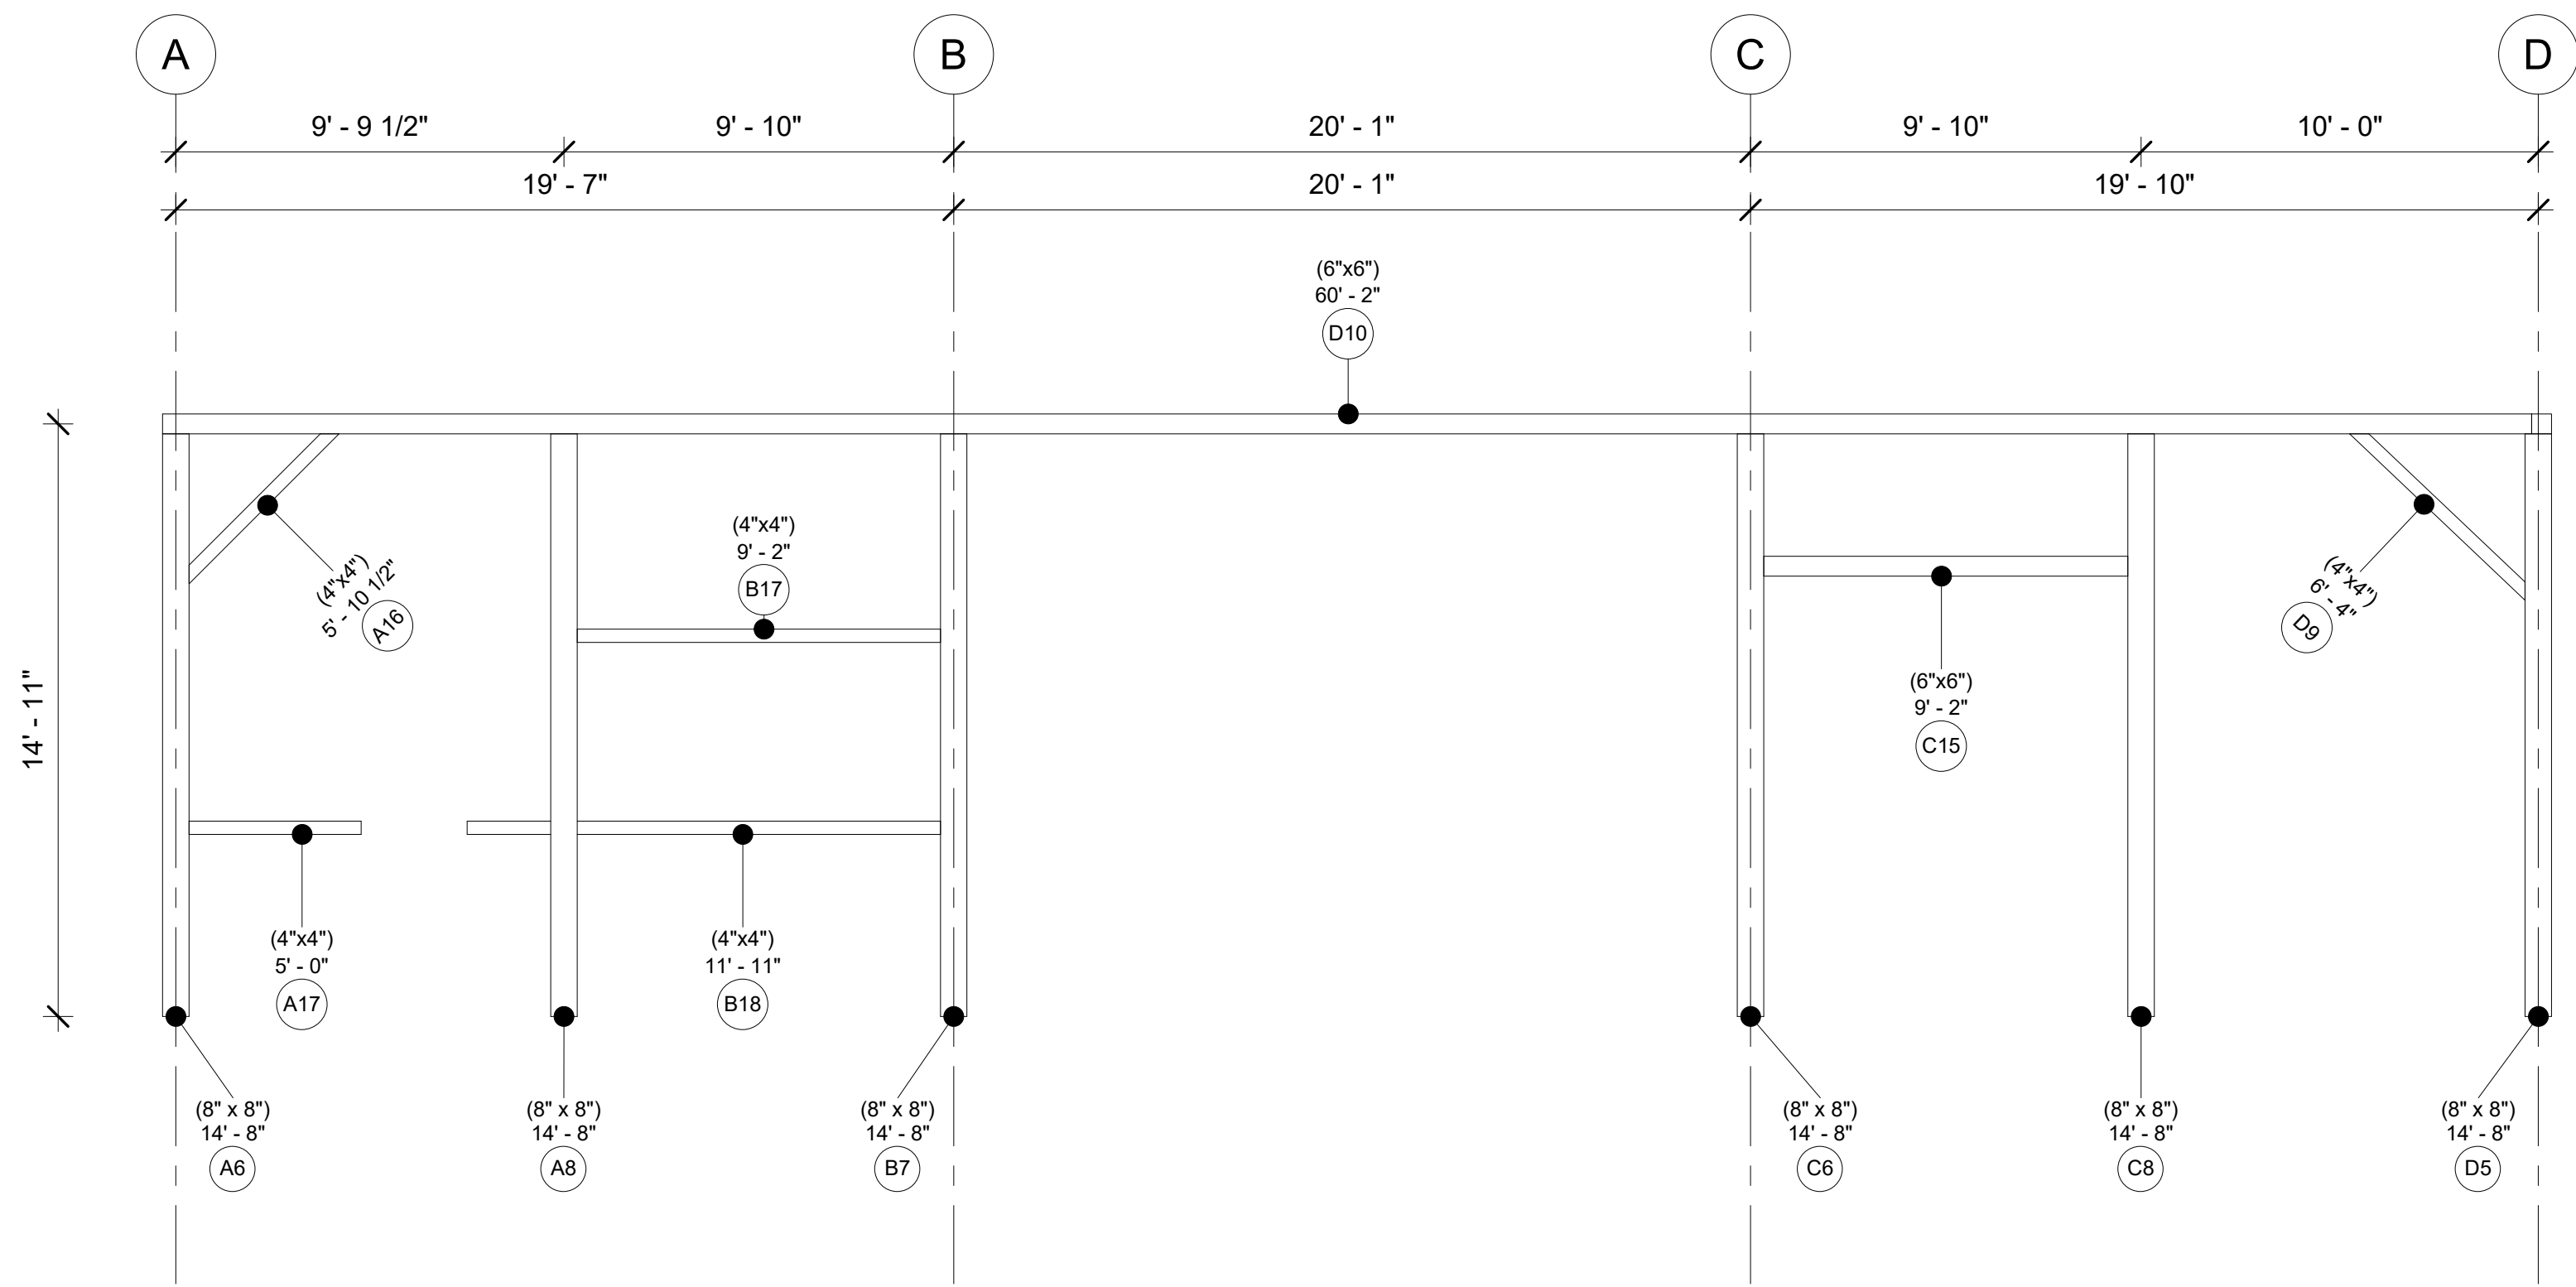

111-Whimsy-Creek


Bent 4

Project Number	Project 1
Date	20251120
Drawn By	
Checked By	
A107	
Scale	1/4" = 1'-0"

111-Whimsy-Creek

Bent A

Project Number	Project 1
Date	20251120
Drawn By	
Checked By	
A108	
Scale	1/4" = 1'-0"

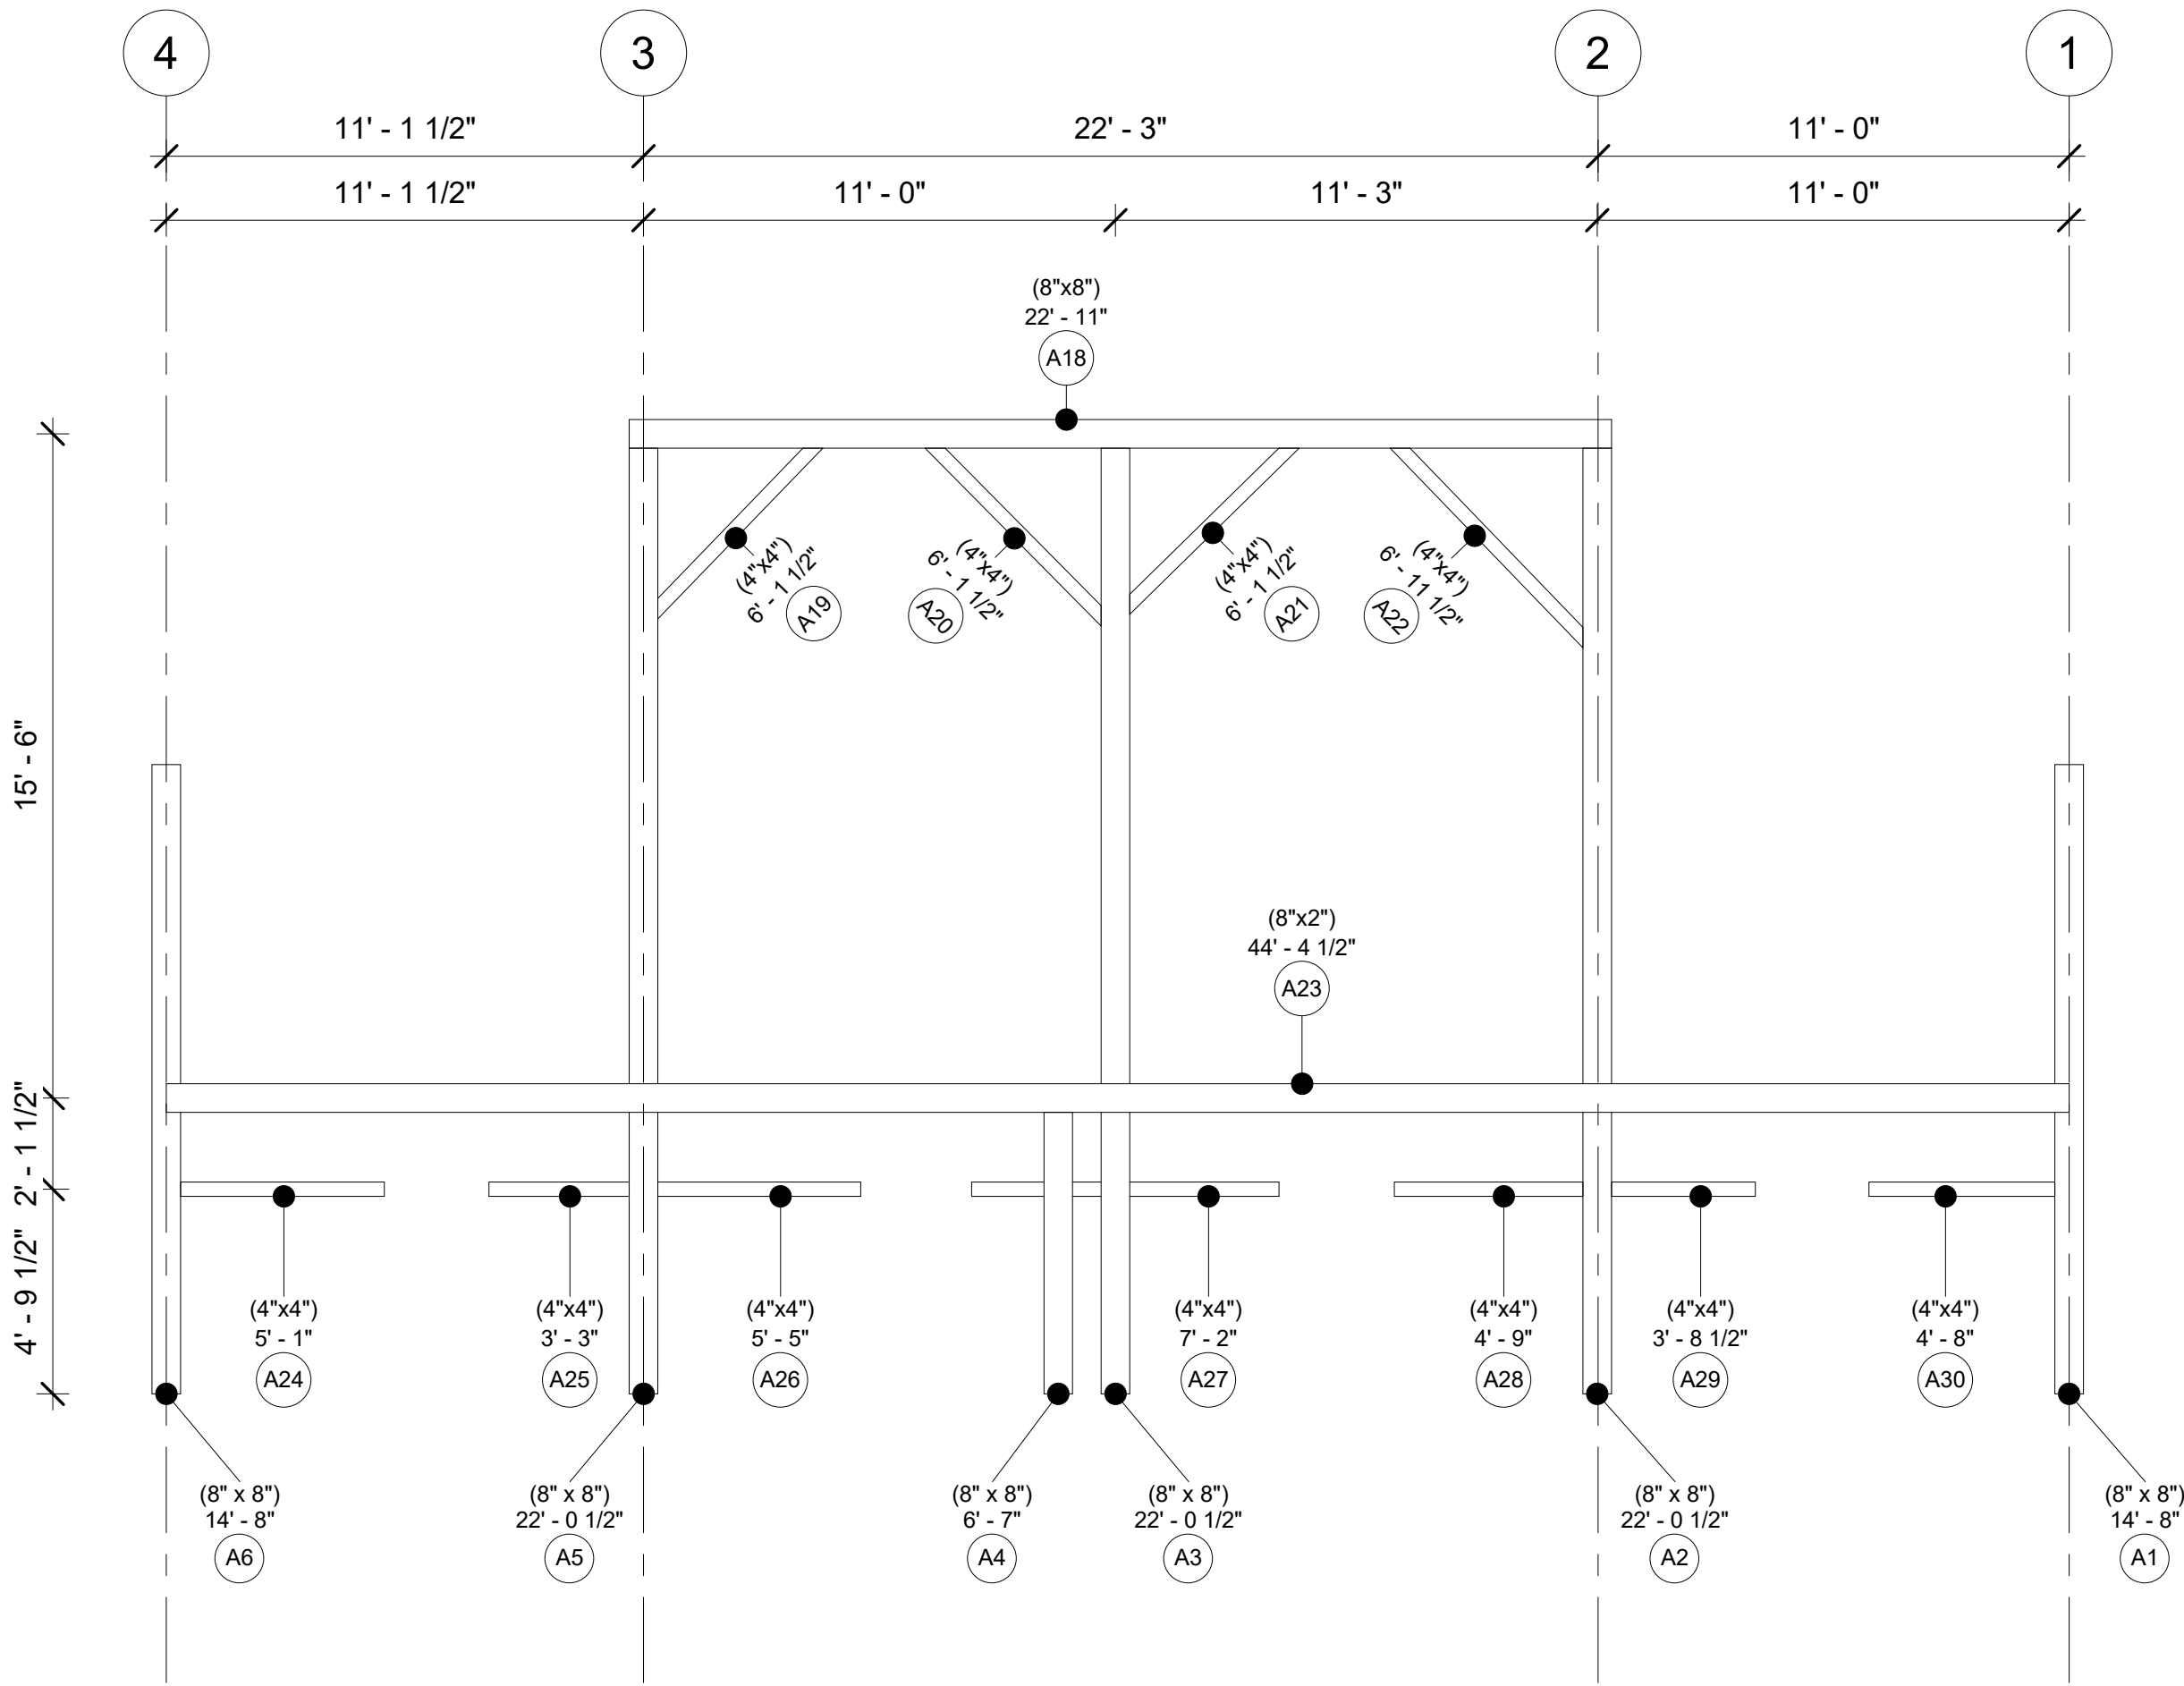

111-Whimsy-Creek

Bent B

Project Number	Project 1
Date	20251120
Drawn By	
Checked By	
A109	
Scale	1/4" = 1'-0"

