

PROJECT: 107-1852  
SCOPE: AS BUILT DRAWINGS

**Timber  
Home  
Services LLC**

107-1852

**DAN TRIMBLE**  
AA66 / TIMBER HOME SERVICES  
CELL PHONE/TEXT - 412-309-1161


EMAIL:  
[DANTRIMBLE@TIMBERHOMESERVICES.COM](mailto:DANTRIMBLE@TIMBERHOMESERVICES.COM)

**Cover Page**

Project Number	107-1852
Date	20260209
Drawn By	
Checked By	

**A101**

Scale

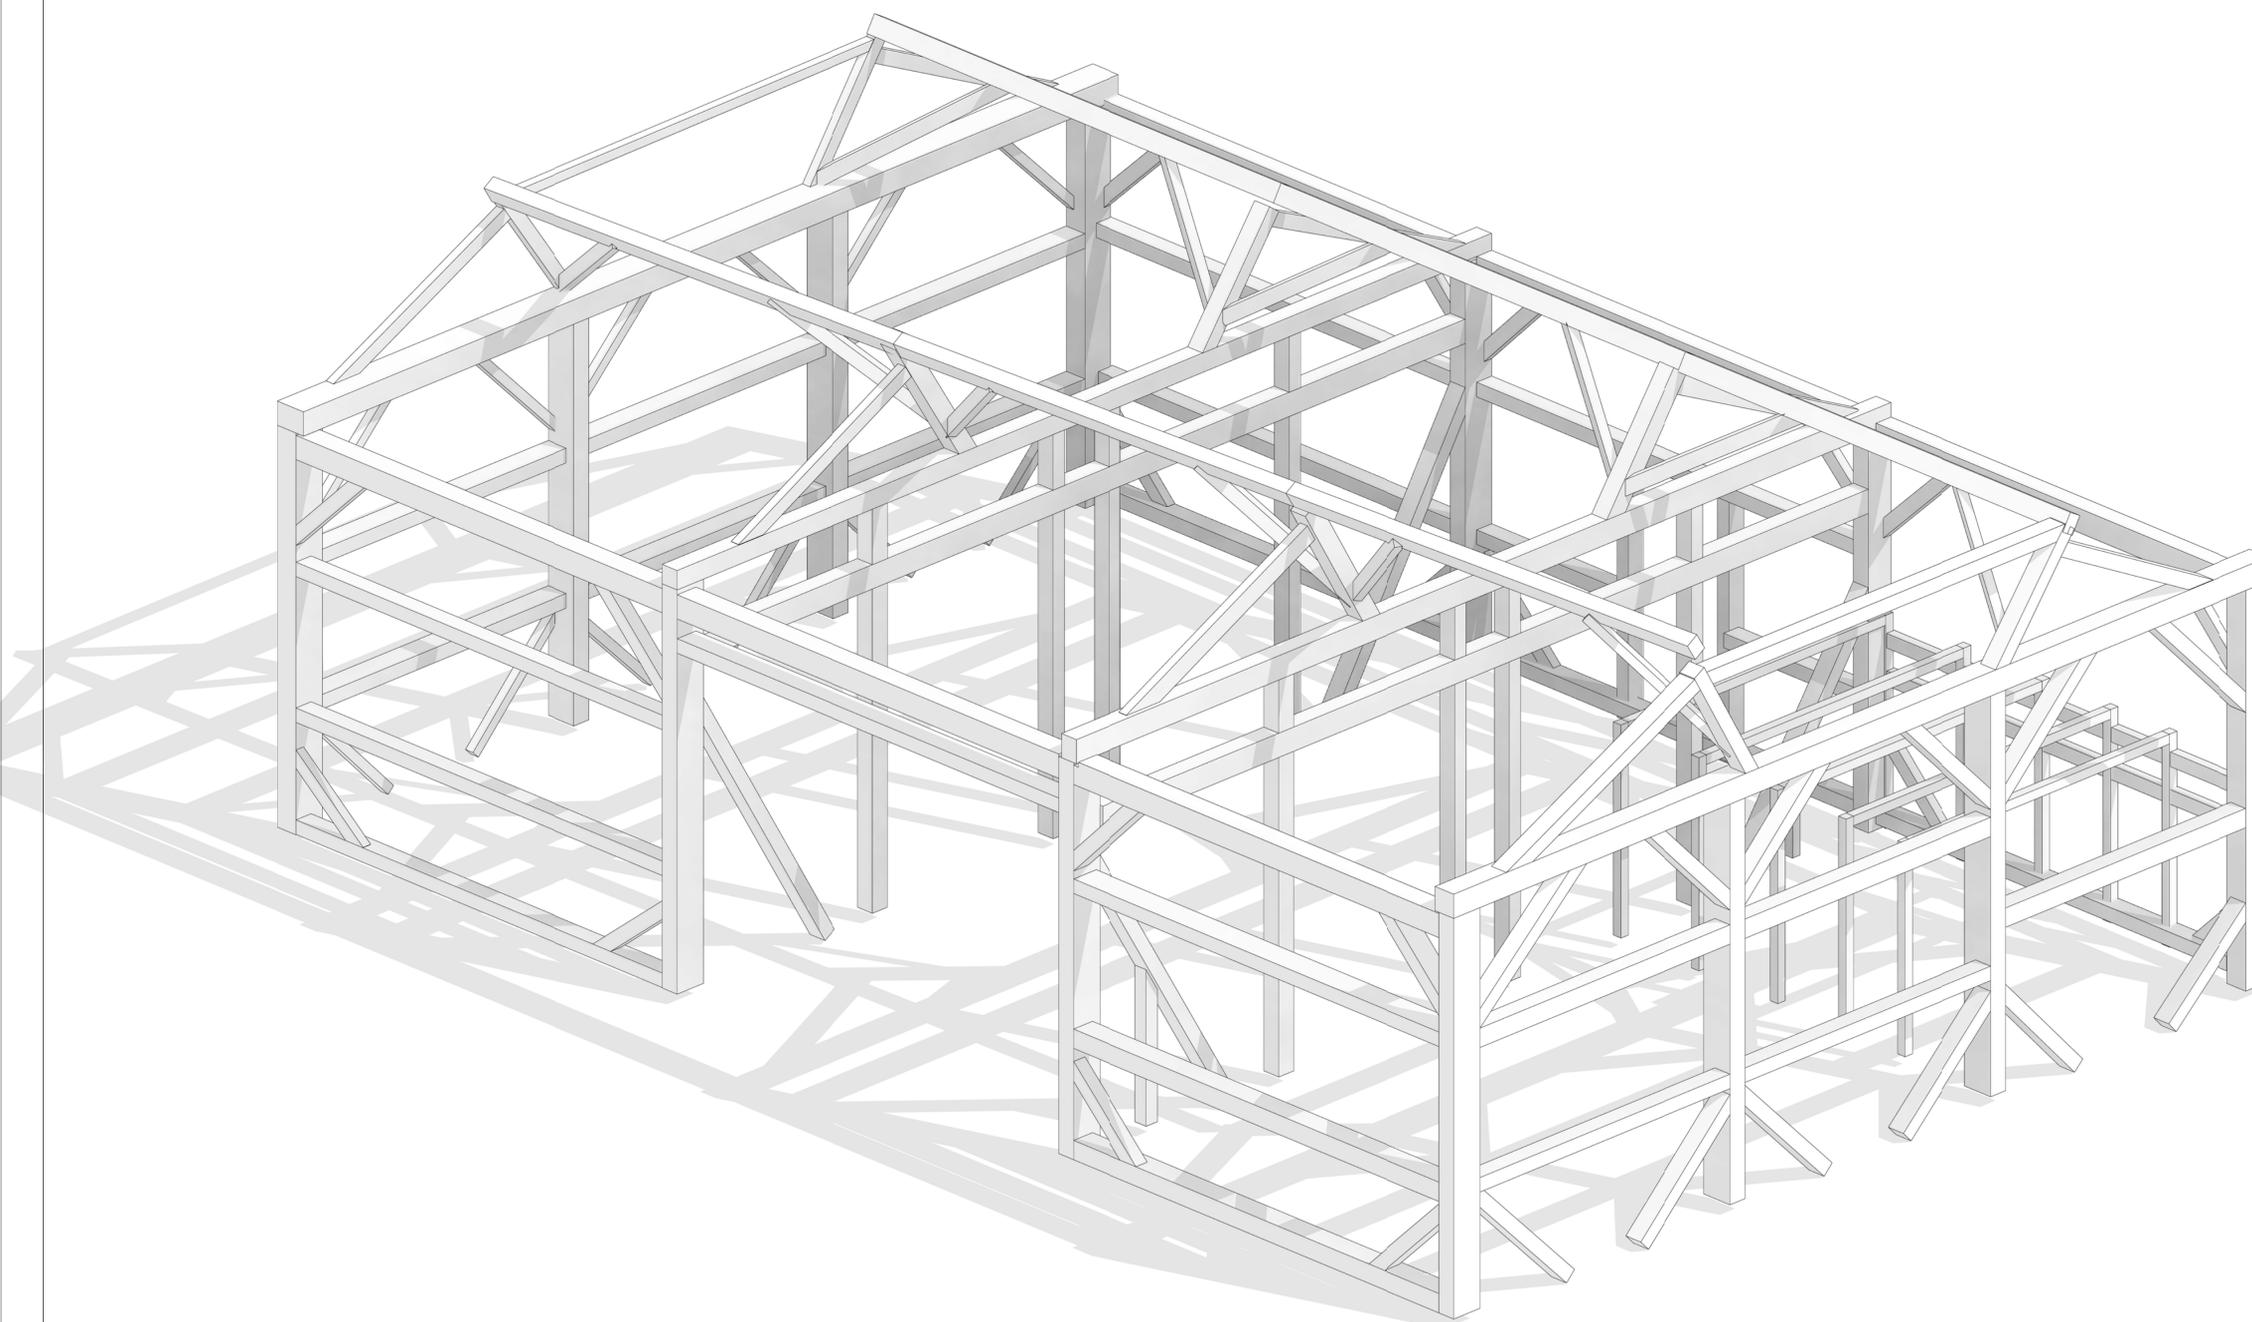


# Timber Home Services LLC

107-1852

**DAN TRIMBLE**  
AA66 / TIMBER HOME SERVICES  
CELL PHONE/TEXT - 412-309-1161

EMAIL:  
DANTRIMBLE@TIMBERHOMESERVICES.COM

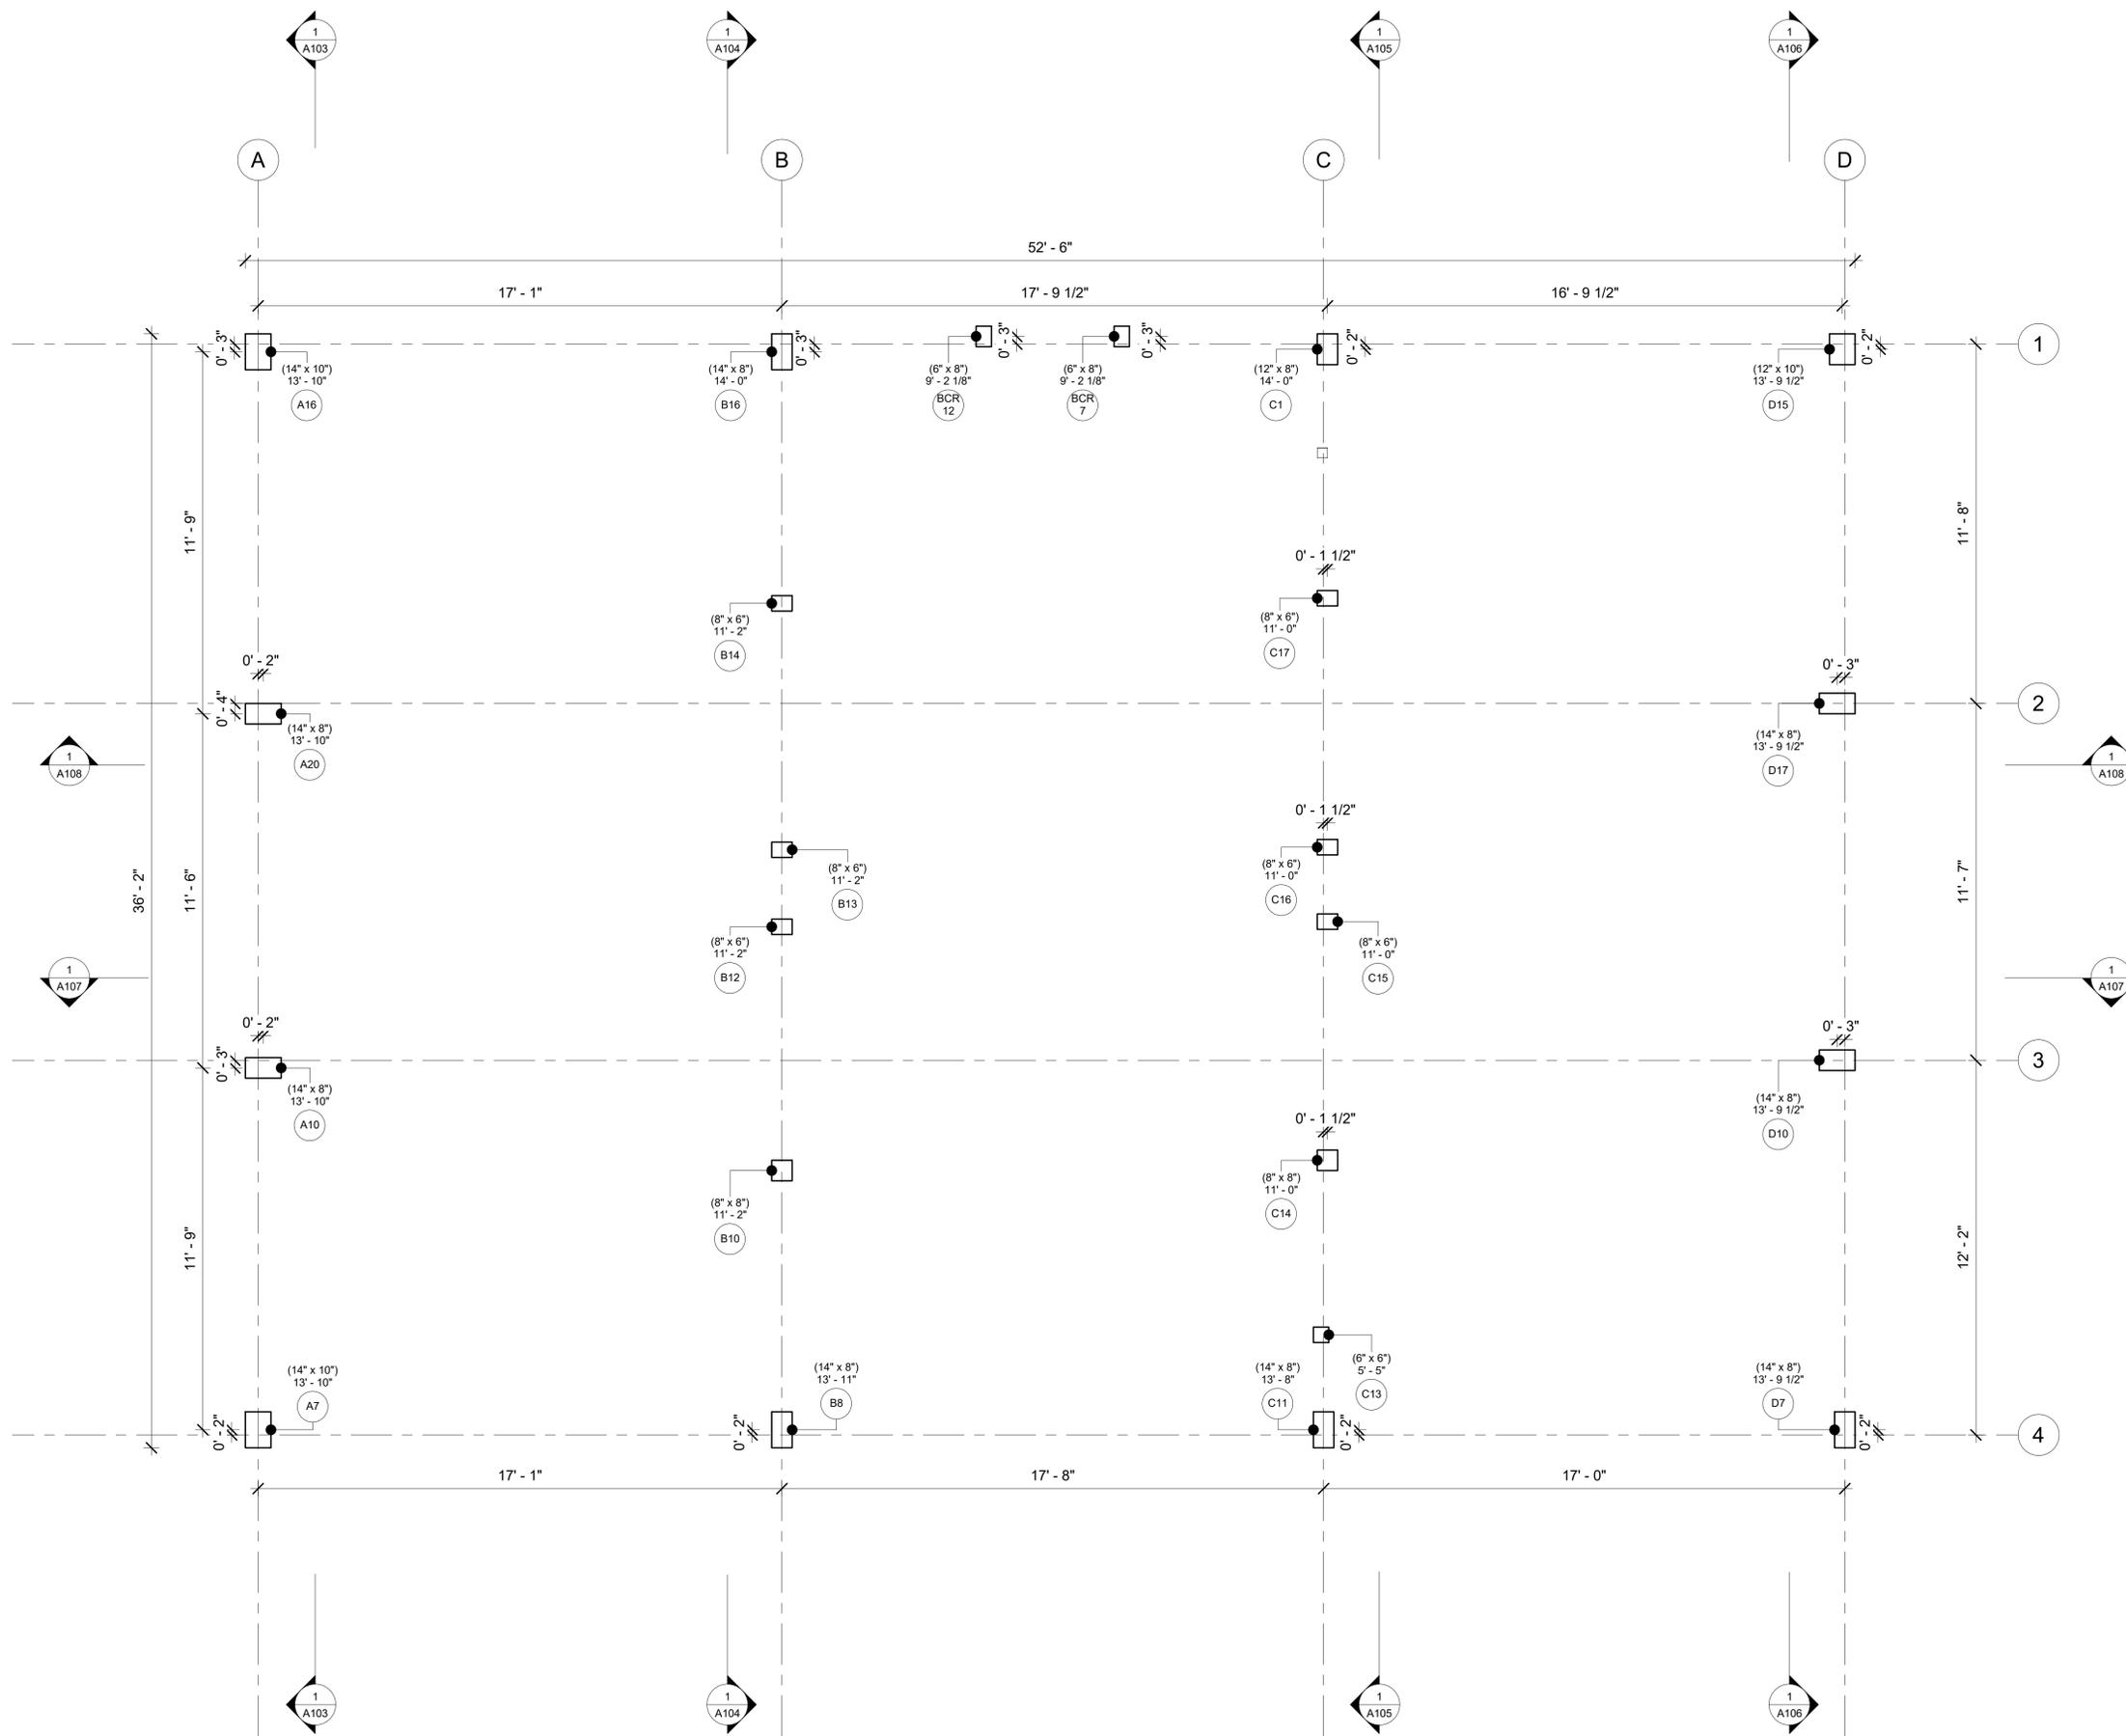

Ground

Project Number 107-1852  
Date 20260209  
Drawn By  
Checked By

## A102


Scale 3/8" = 1'-0"

# Timber Home Services LLC

107-1852

**DAN TRIMBLE**  
AA66 / TIMBER HOME SERVICES  
CELL PHONE/TEXT - 412-309-1161

EMAIL:  
DANTRIMBLE@TIMBERHOMESERVICES.COM

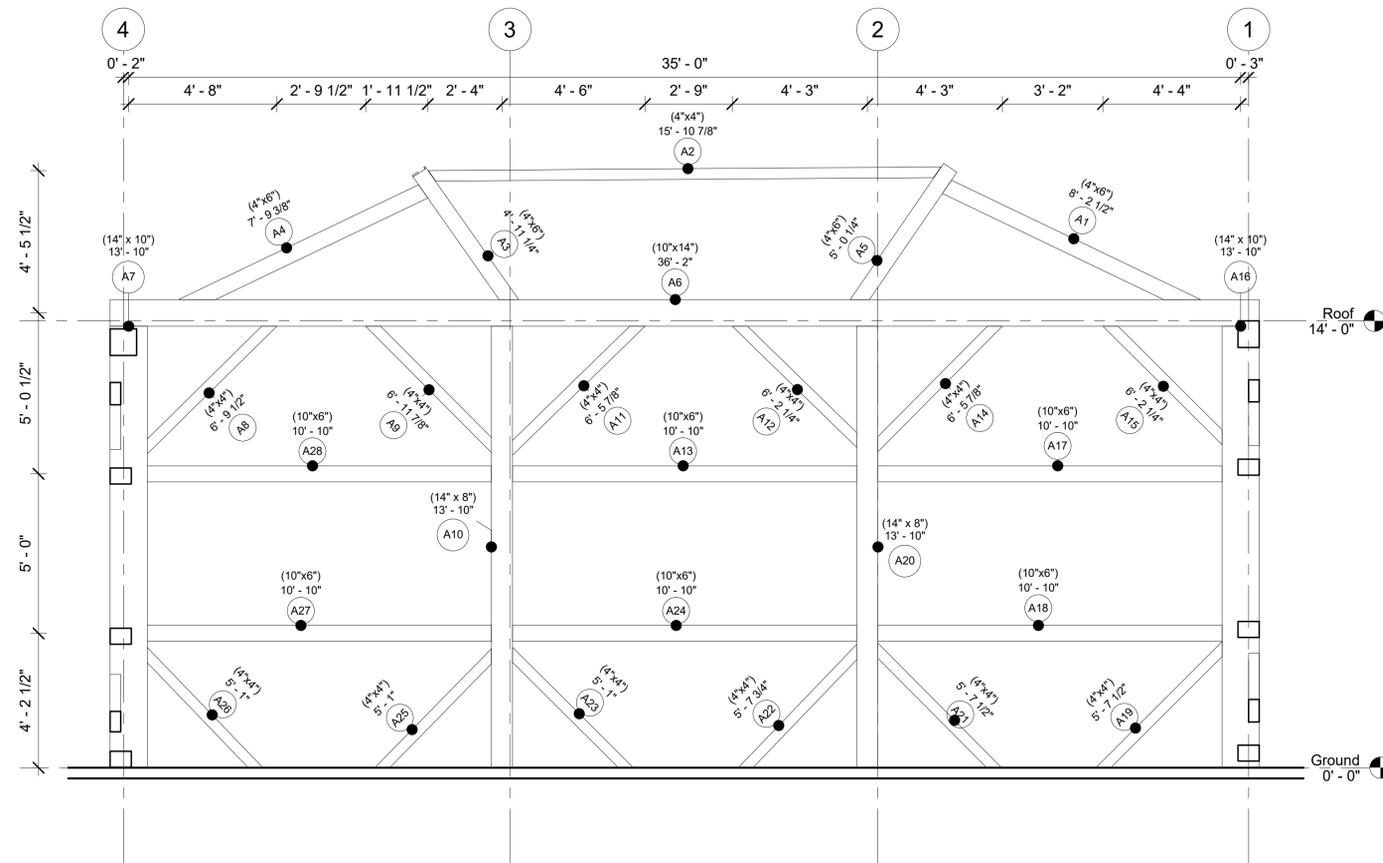

## Bent A

Project Number 107-1852  
Date 20260209  
Drawn By  
Checked By

# A103


Scale 3/8" = 1'-0"

# Timber Home Services LLC

107-1852

**DAN TRIMBLE**  
AA66 / TIMBER HOME SERVICES  
CELL PHONE/TEXT - 412-309-1161

EMAIL:  
DANTRIMBLE@TIMBERHOMESERVICES.COM

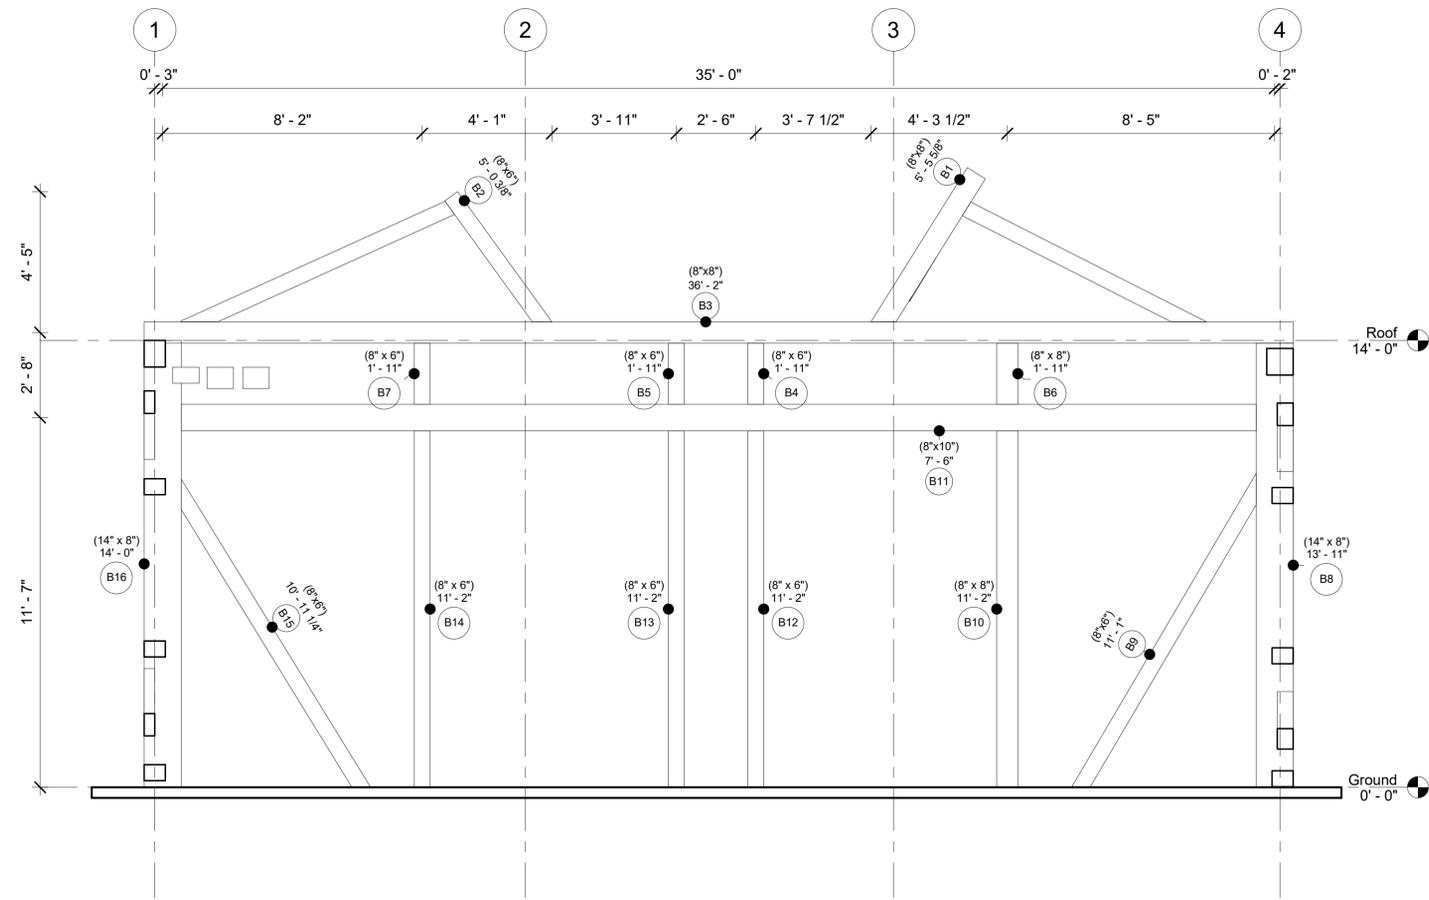

## Bent B

Project Number 107-1852  
Date 20260209  
Drawn By  
Checked By

# A104


Scale 3/8" = 1'-0"

# Timber Home Services LLC

107-1852

**DAN TRIMBLE**  
AA66 / TIMBER HOME SERVICES  
CELL PHONE/TEXT - 412-309-1161

EMAIL:  
DANTRIMBLE@TIMBERHOMESERVICES.COM

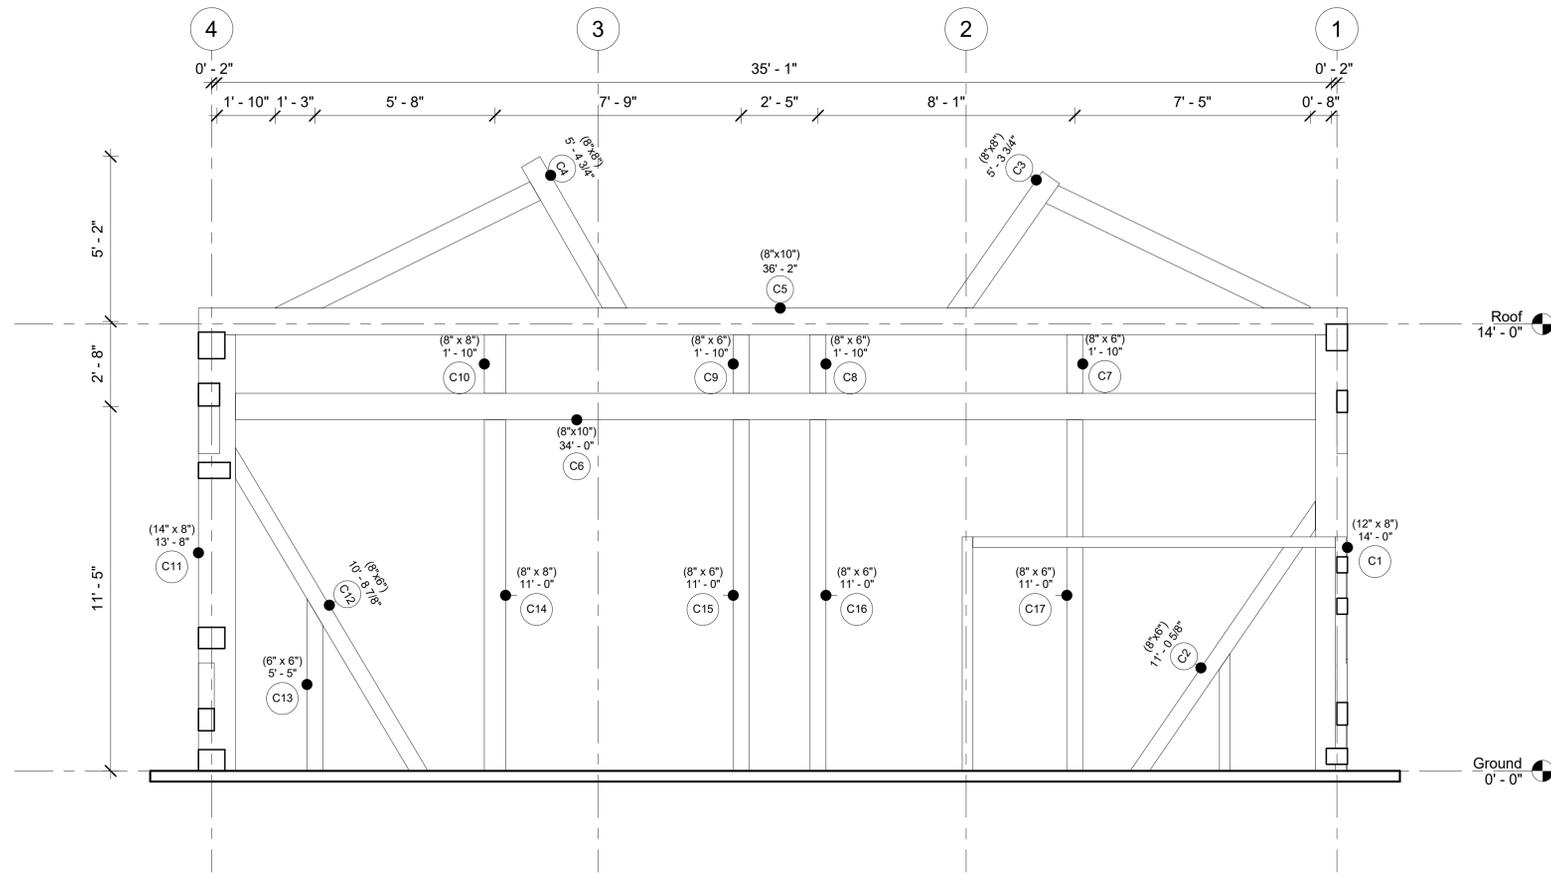

## Bent C

Project Number 107-1852  
Date 20260209  
Drawn By  
Checked By

# A105


Scale 3/8" = 1'-0"

# Timber Home Services LLC

107-1852

**DAN TRIMBLE**  
AA66 / TIMBER HOME SERVICES  
CELL PHONE/TEXT - 412-309-1161

EMAIL:  
DANTRIMBLE@TIMBERHOMESERVICES.COM

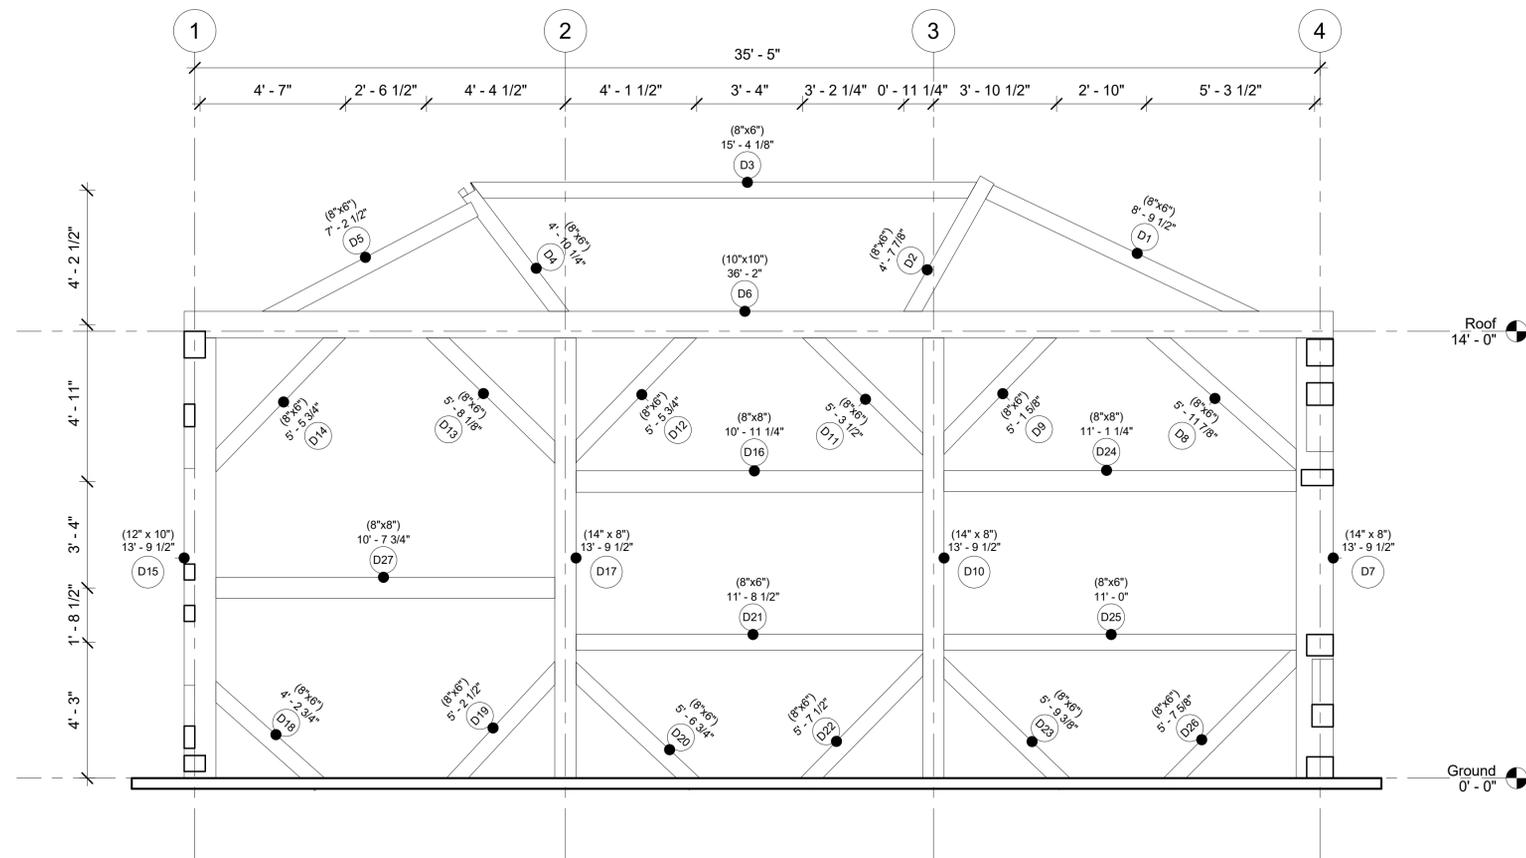

## Bent D

Project Number 107-1852  
Date 20260209  
Drawn By  
Checked By

# A106


Scale 3/8" = 1'-0"

# Timber Home Services LLC

107-1852

**DAN TRIMBLE**  
AA66 / TIMBER HOME SERVICES  
CELL PHONE/TEXT - 412-309-1161

EMAIL:  
DANTRIMBLE@TIMBERHOMESERVICES.COM

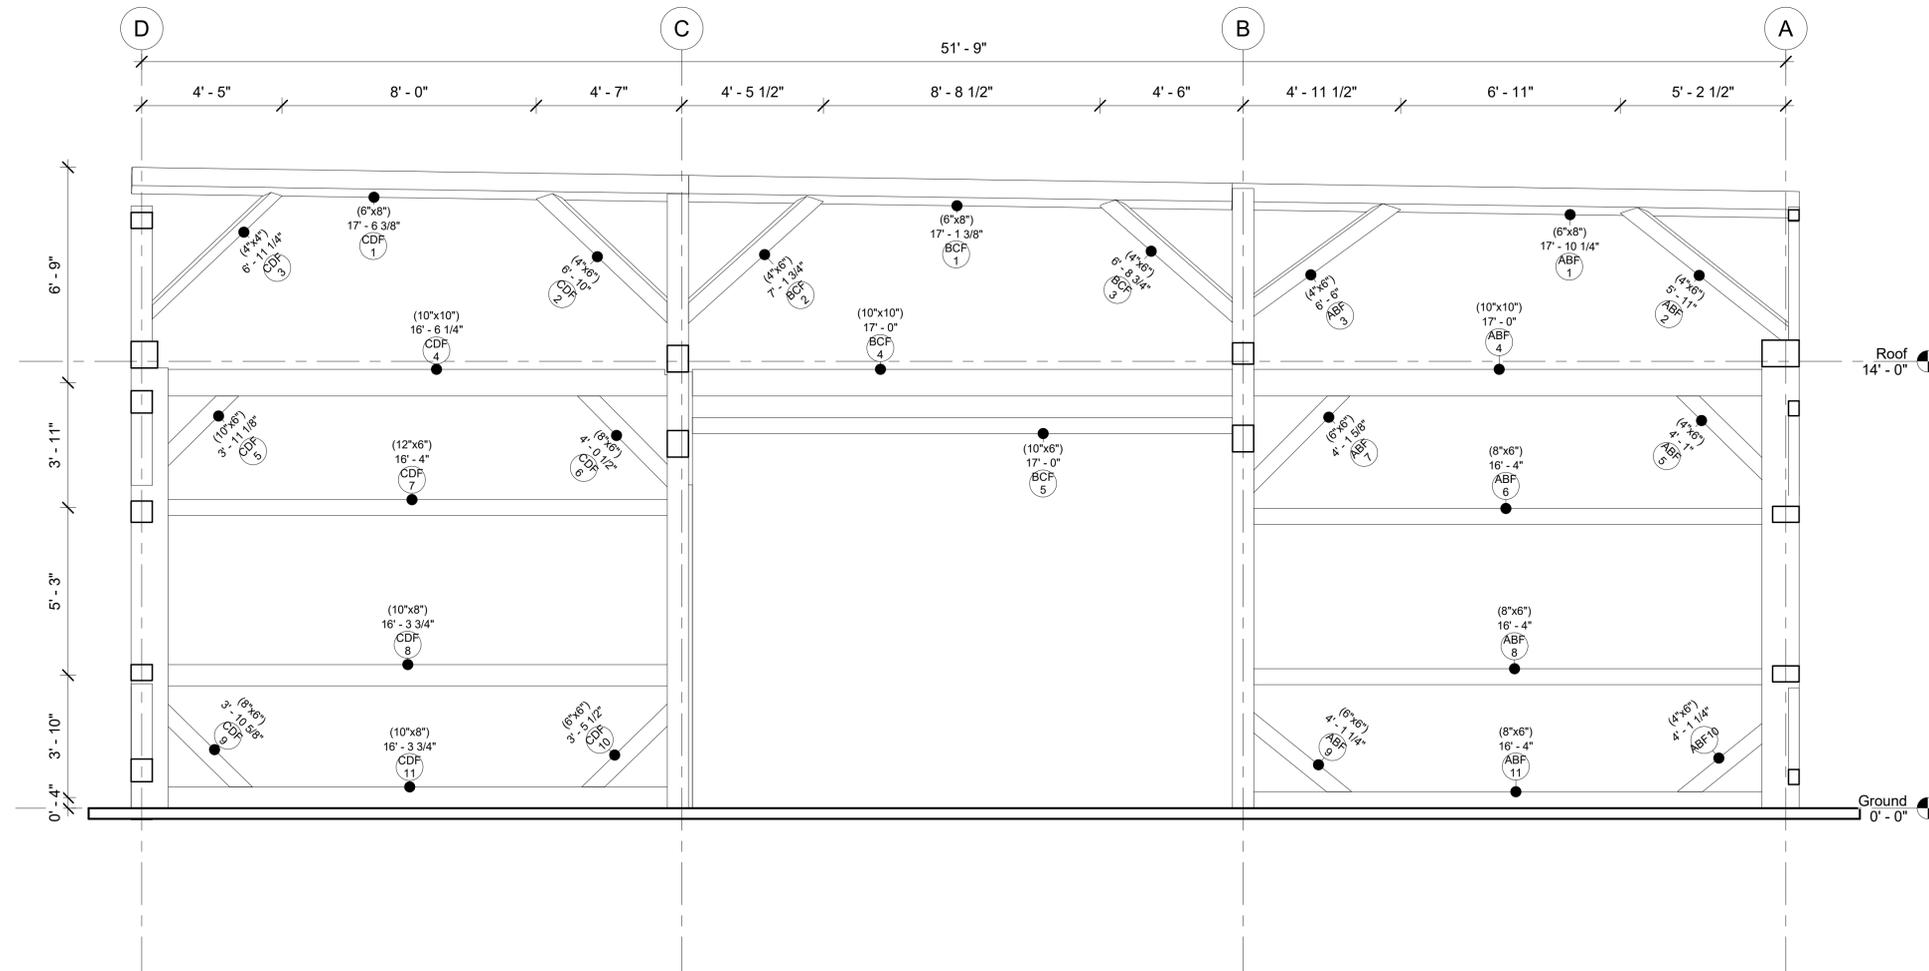

## Bent 1

Project Number 107-1852  
Date 20260209  
Drawn By  
Checked By

# A107


Scale 3/8" = 1'-0"

# Timber Home Services LLC

107-1852

**DAN TRIMBLE**  
AA66 / TIMBER HOME SERVICES  
CELL PHONE/TEXT - 412-309-1161

EMAIL:  
DANTRIMBLE@TIMBERHOMESERVICES.COM

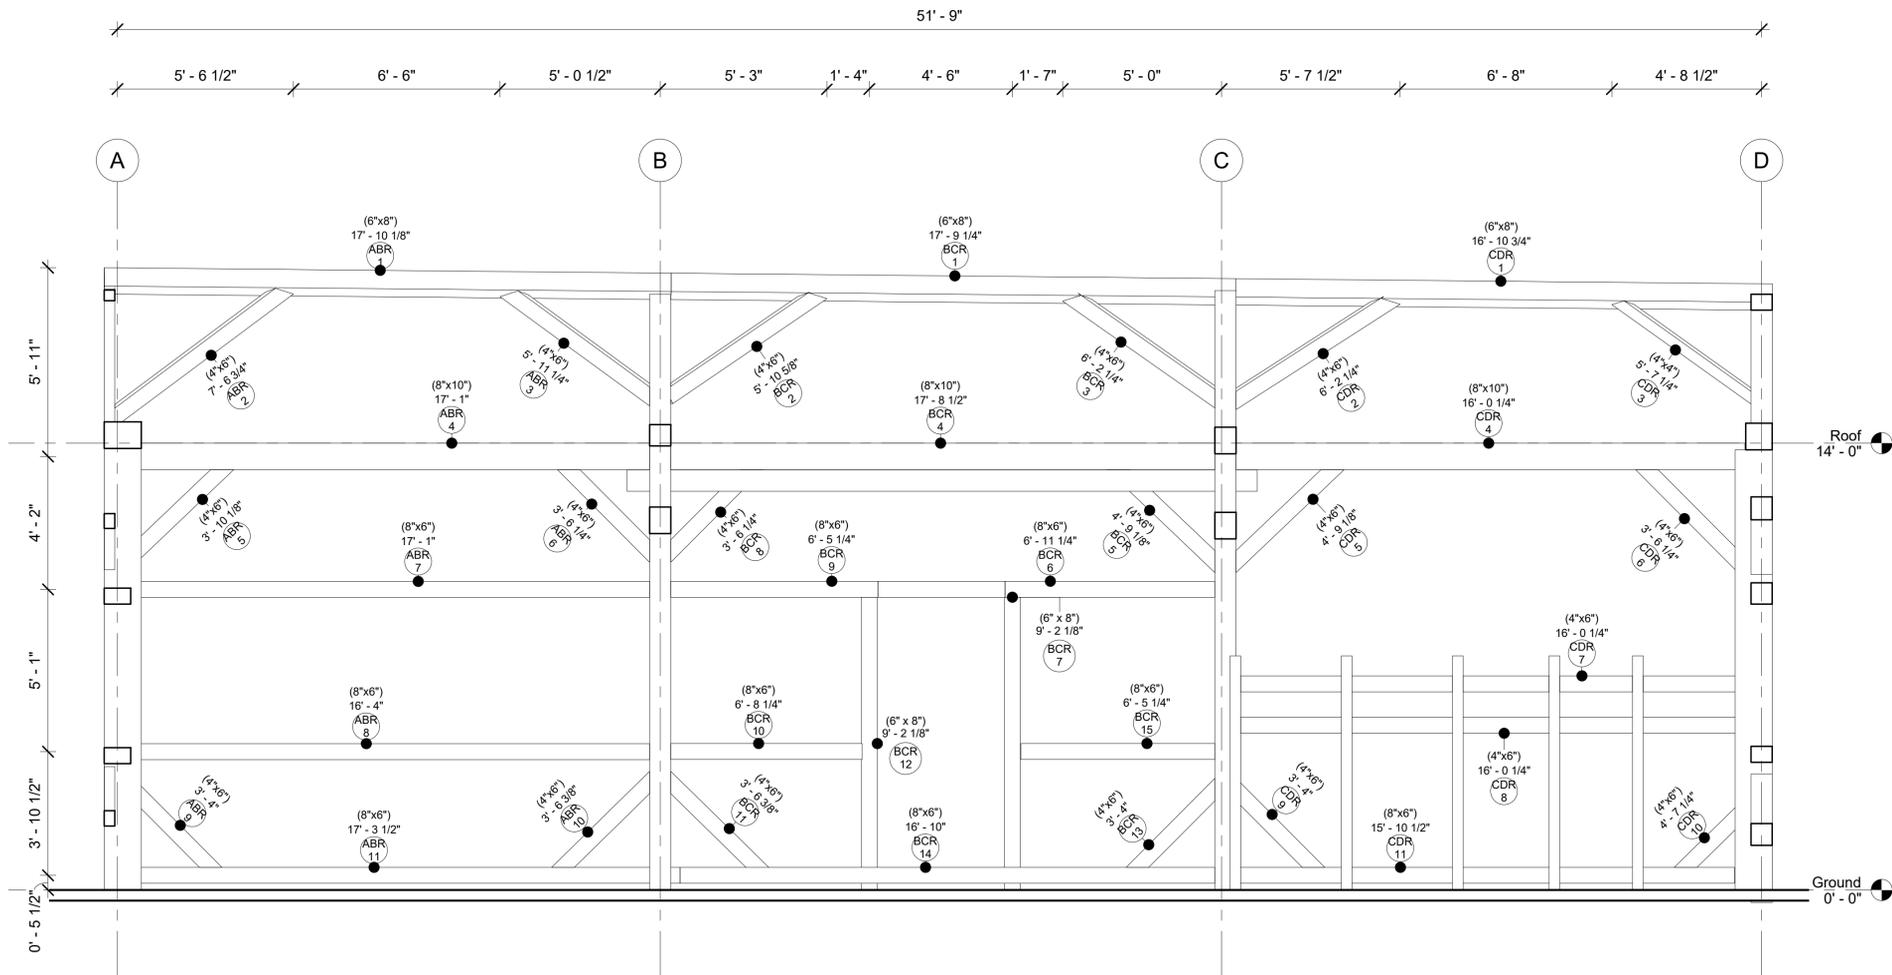

## Bent 2

Project Number 107-1852  
Date 20260209  
Drawn By  
Checked By

# A108

Scale 3/8" = 1'-0"