


PROJECT: PERDUE BARN  
SCOPE: AS BUILT DRAWINGS

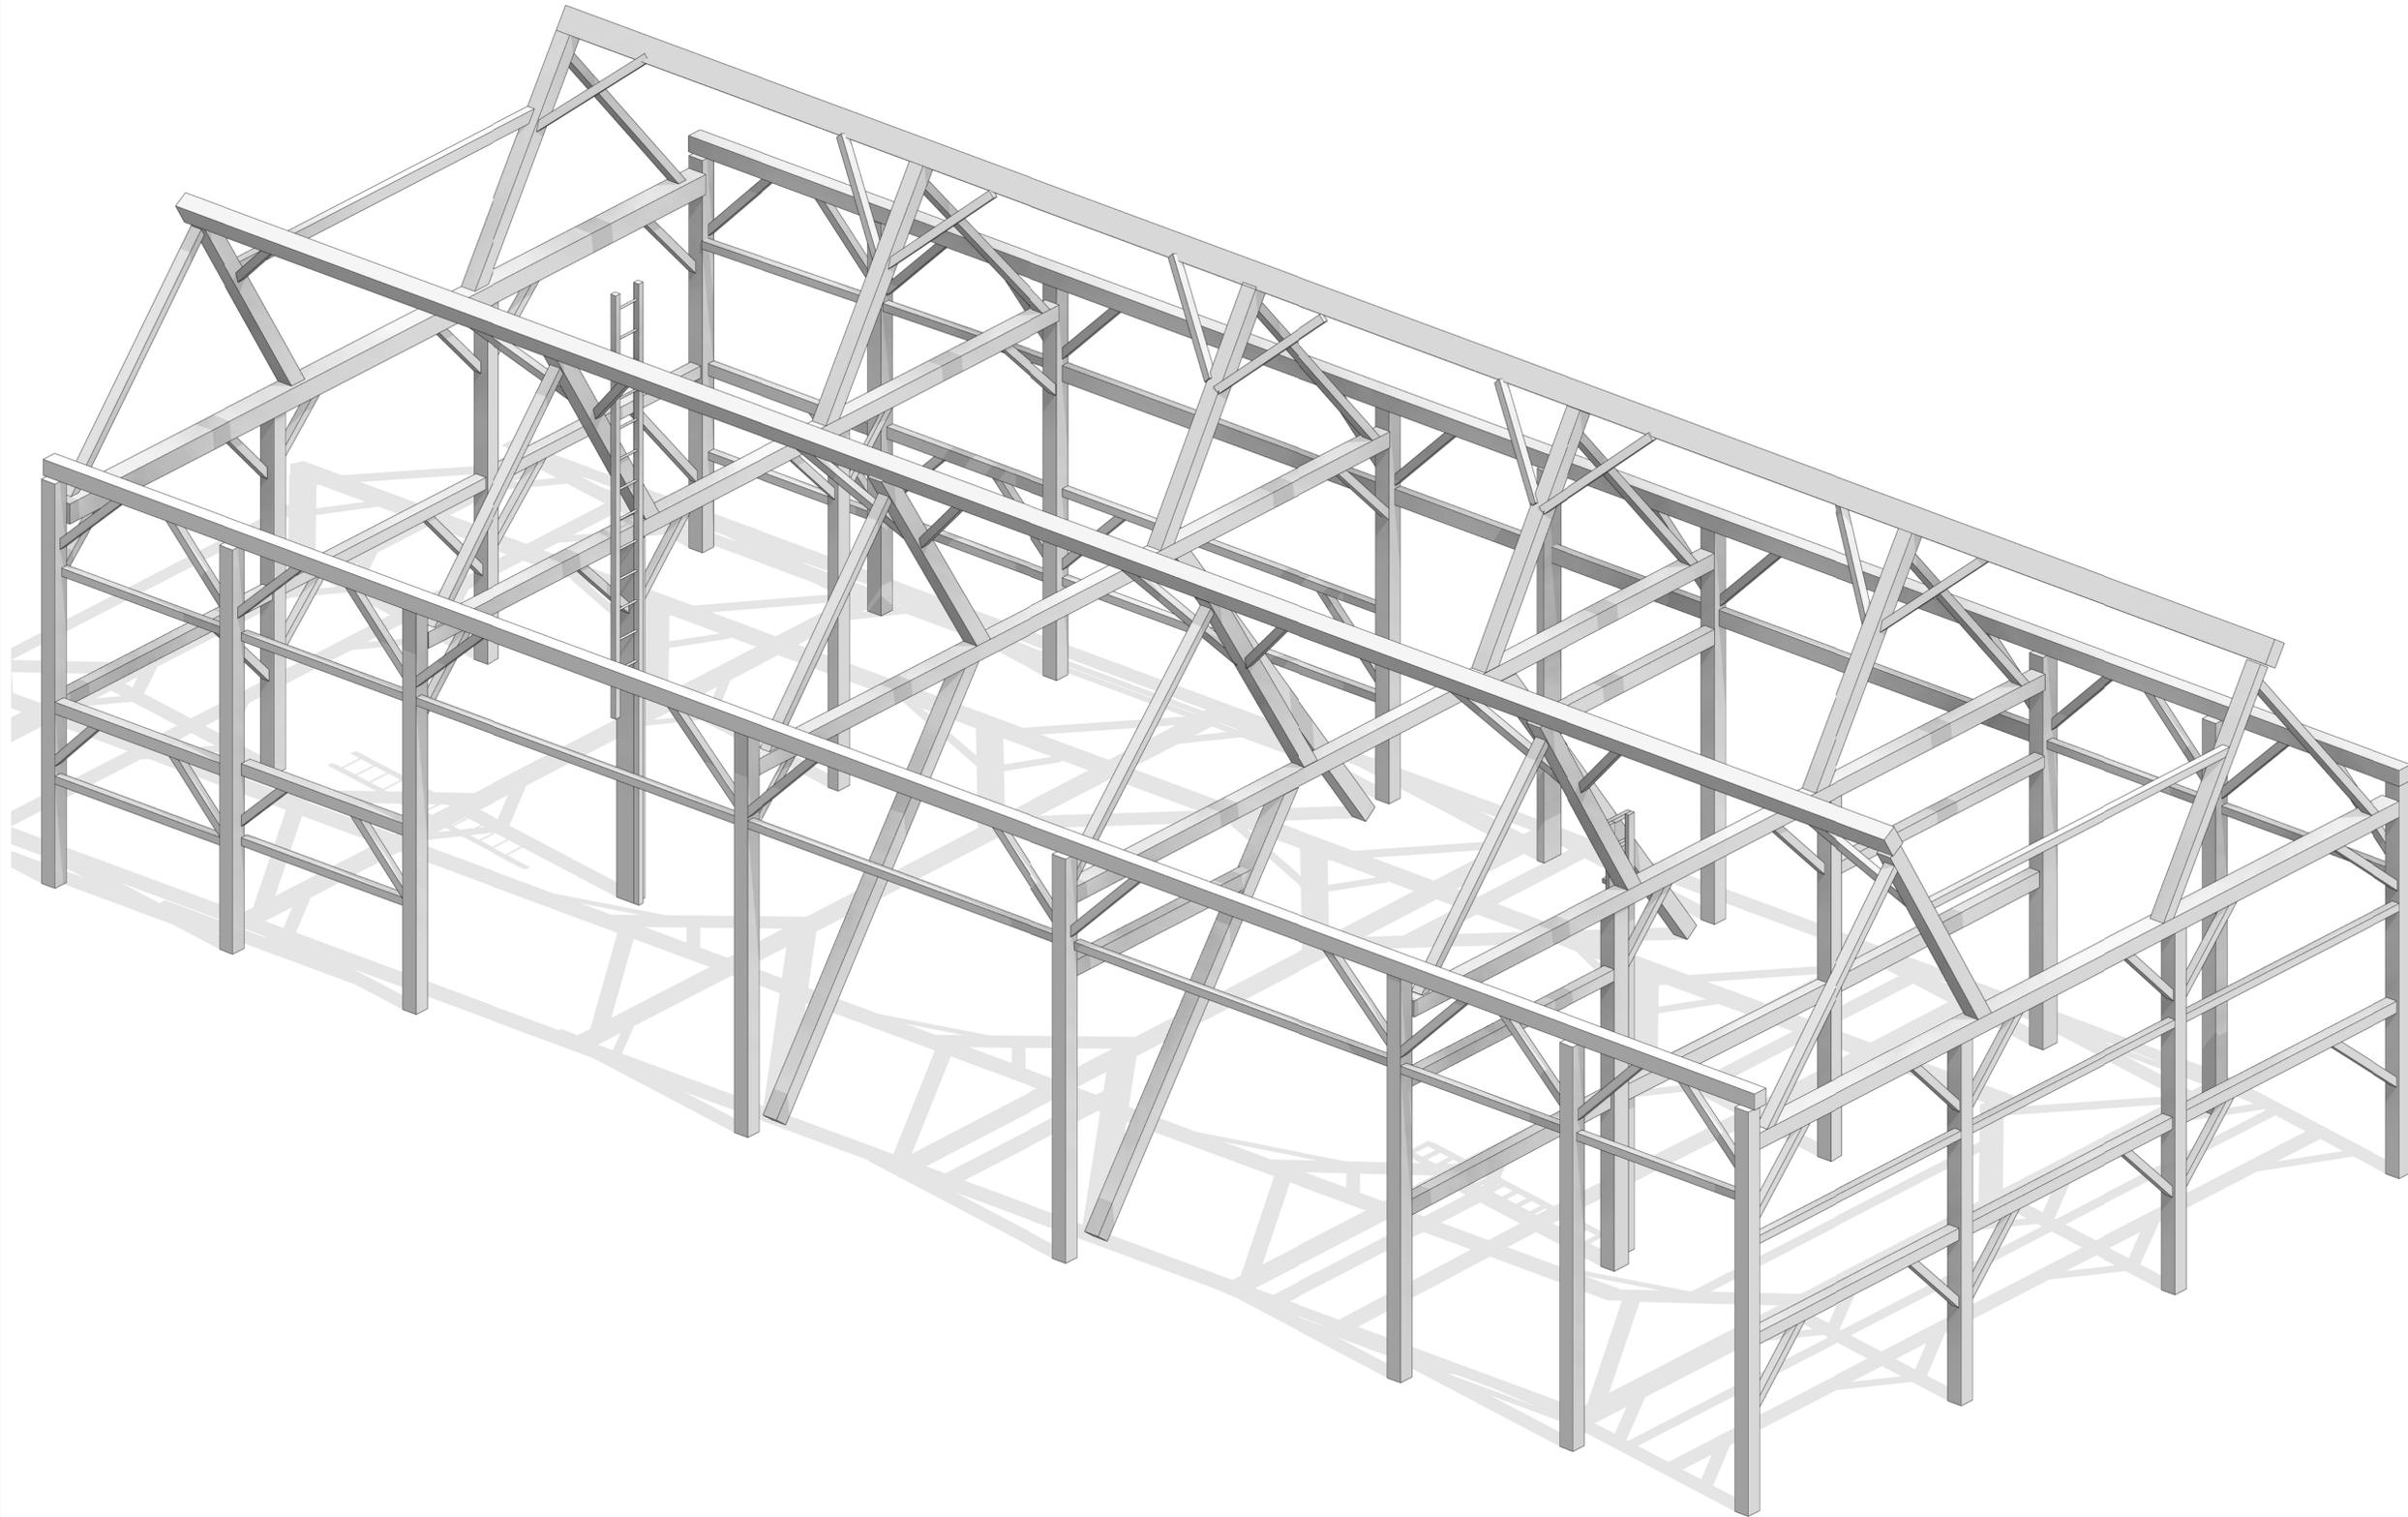

Timber  
Home  
Services LLC

80 Old Gate Road,  
Penn Run PA, 15765

**DAN TRIMBLE**  
AA66 / TIMBER HOME SERVICES  
CELL PHONE/TEXT - 412-309-1161

EMAIL:  
[DANTRIMBLE@TIMBERHOMESERVICES.COM](mailto:DANTRIMBLE@TIMBERHOMESERVICES.COM)

Cover Page

Project Number	Project 3
Date	20240804
Drawn By	
Checked By	

**A101**

Scale

# Timber Home Services LLC


80 Old Gate Road,  
Penn Run PA, 15765

**DAN TRIMBLE**  
AA66 / TIMBER HOME SERVICES

CELL PHONE/TEXT - 412-309-1161

EMAIL:

DANTRIMBLE@TIMBERHOMESERVICES.COM

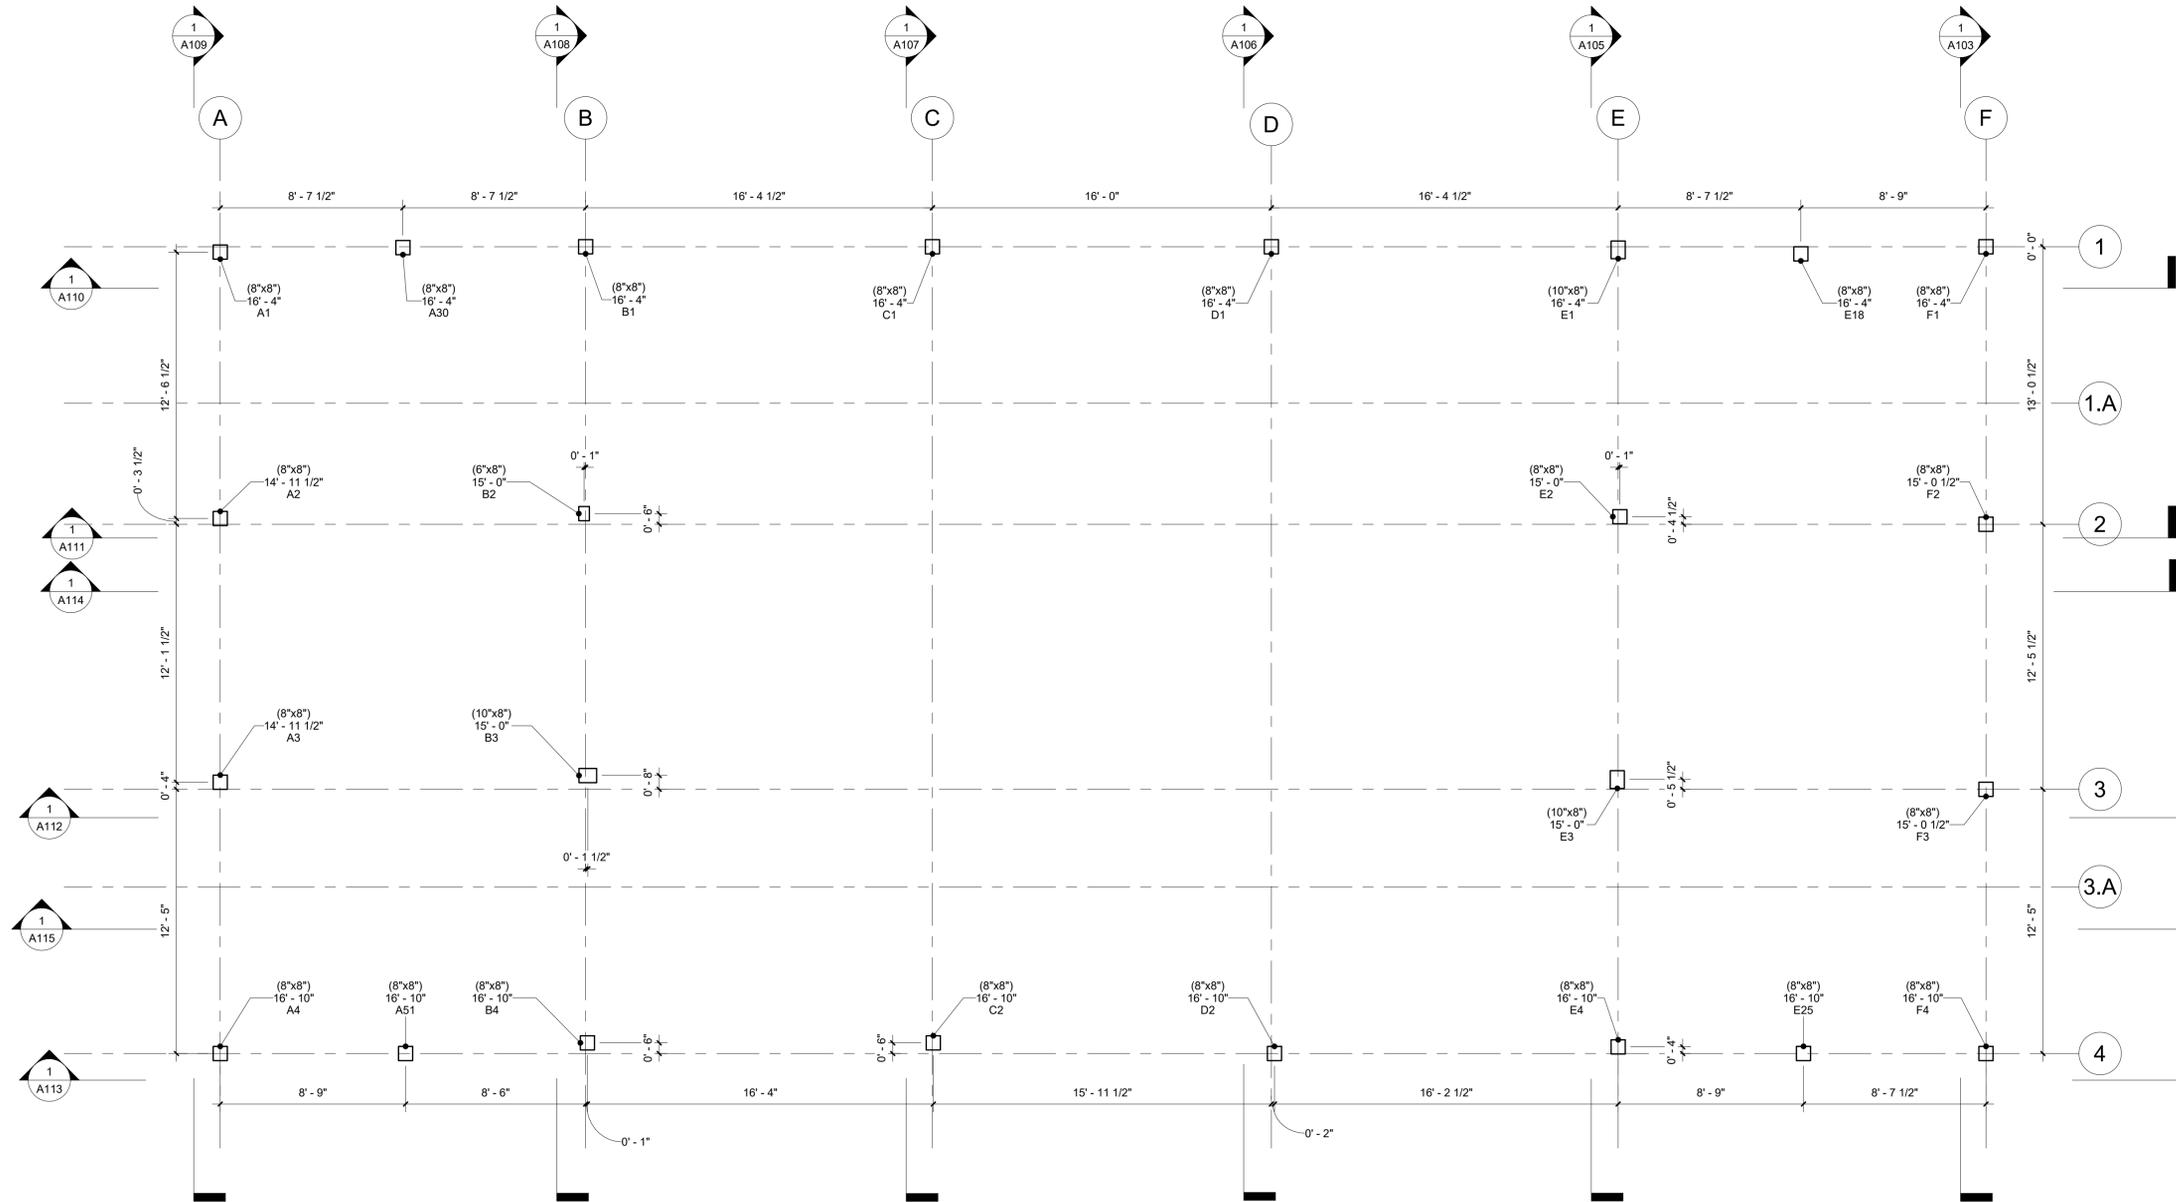

## Floor Plan

Project Number Project 3

Date 20240804

Drawn By

Checked By

# A102

Scale 1/4" = 1'-0"



# Timber Home Services LLC


80 Old Gate Road,  
Penn Run PA, 15765

**DAN TRIMBLE**  
AA66 / TIMBER HOME SERVICES

CELL PHONE/TEXT - 412-309-1161

EMAIL:

DANTRIMBLE@TIMBERHOMESERVICES.COM

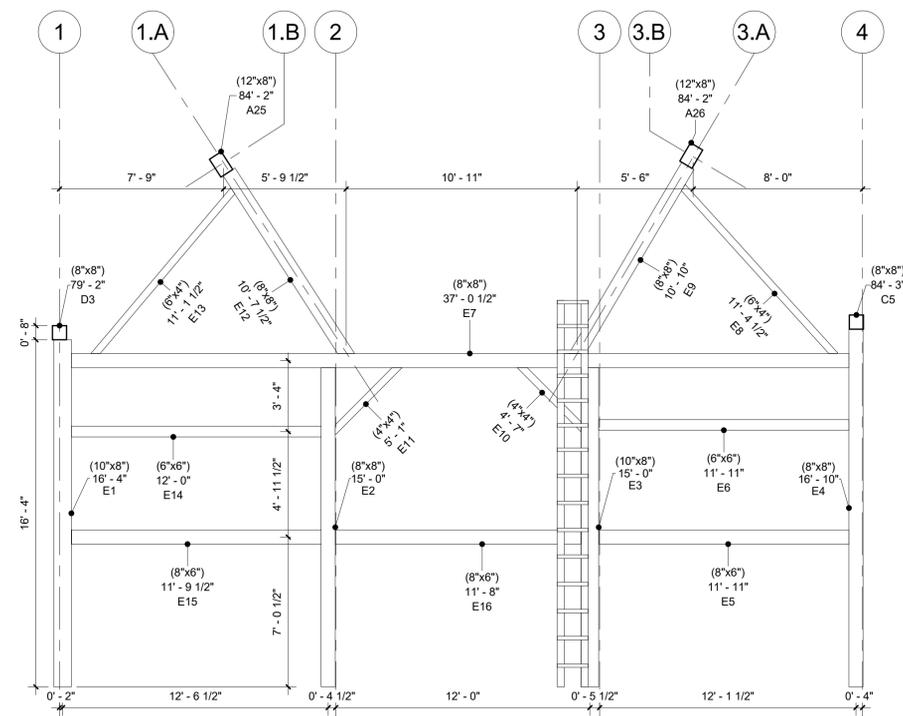

## Bent E

Project Number **Project 3**

Date **20240804**

Drawn By

Checked By

# A105

Scale **1/4" = 1'-0"**

# Timber Home Services LLC


80 Old Gate Road,  
Penn Run PA, 15765

**DAN TRIMBLE**  
AA66 / TIMBER HOME SERVICES

CELL PHONE/TEXT - 412-309-1161

EMAIL:

DANTRIMBLE@TIMBERHOMESERVICES.COM

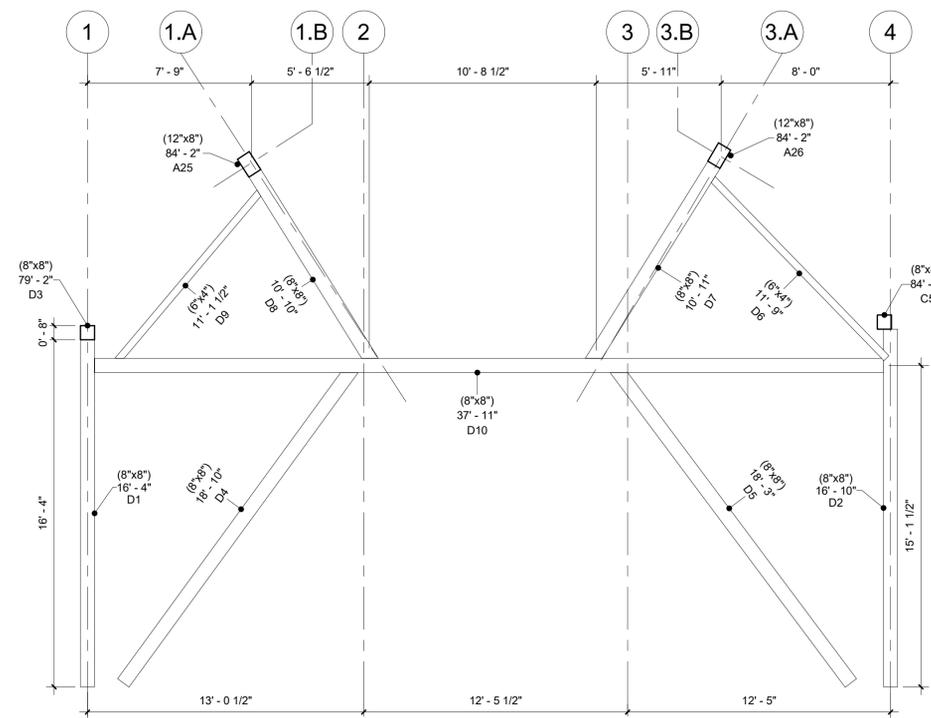

## Bent D

Project Number **Project 3**

Date **20240804**

Drawn By

Checked By

# A106

Scale **1/4" = 1'-0"**

# Timber Home Services LLC


80 Old Gate Road,  
Penn Run PA, 15765

**DAN TRIMBLE**  
AA66 / TIMBER HOME SERVICES

CELL PHONE/TEXT - 412-309-1161

EMAIL:

DANTRIMBLE@TIMBERHOMESERVICES.COM

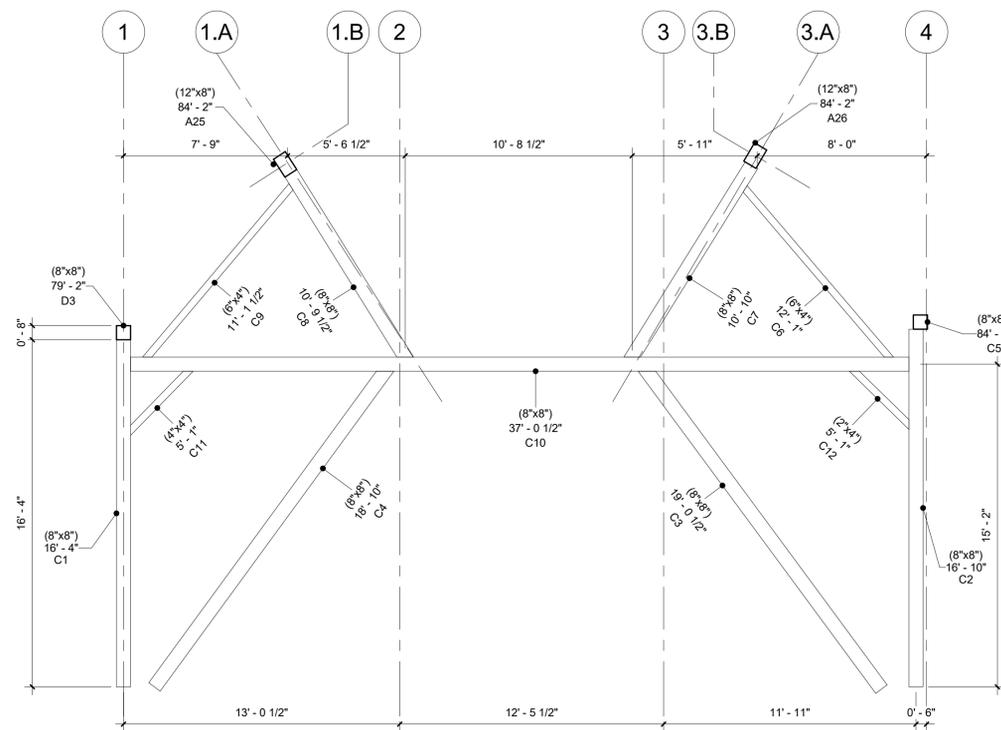

## Bent C

Project Number **Project 3**

Date **20240804**

Drawn By

Checked By

# A107


Scale **1/4" = 1'-0"**

# Timber Home Services LLC

80 Old Gate Road,  
Penn Run PA, 15765

**DAN TRIMBLE**  
AA66 / TIMBER HOME SERVICES  
CELL PHONE/TEXT - 412-309-1161

EMAIL:  
DANTRIMBLE@TIMBERHOMESERVICES.COM

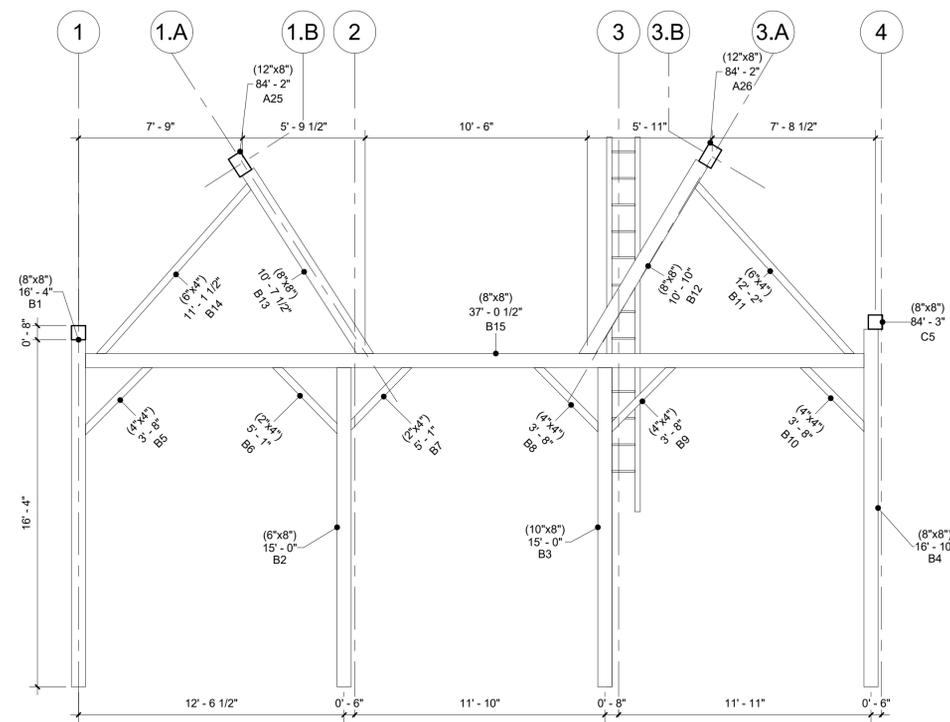

## Bent B

Project Number	Project 3
Date	20240804
Drawn By	
Checked By	

# A108

Scale 1/4" = 1'-0"

# Timber Home Services LLC


80 Old Gate Road,  
Penn Run PA, 15765

**DAN TRIMBLE**  
AA66 / TIMBER HOME SERVICES

CELL PHONE/TEXT - 412-309-1161

EMAIL:

DANTRIMBLE@TIMBERHOMESERVICES.COM

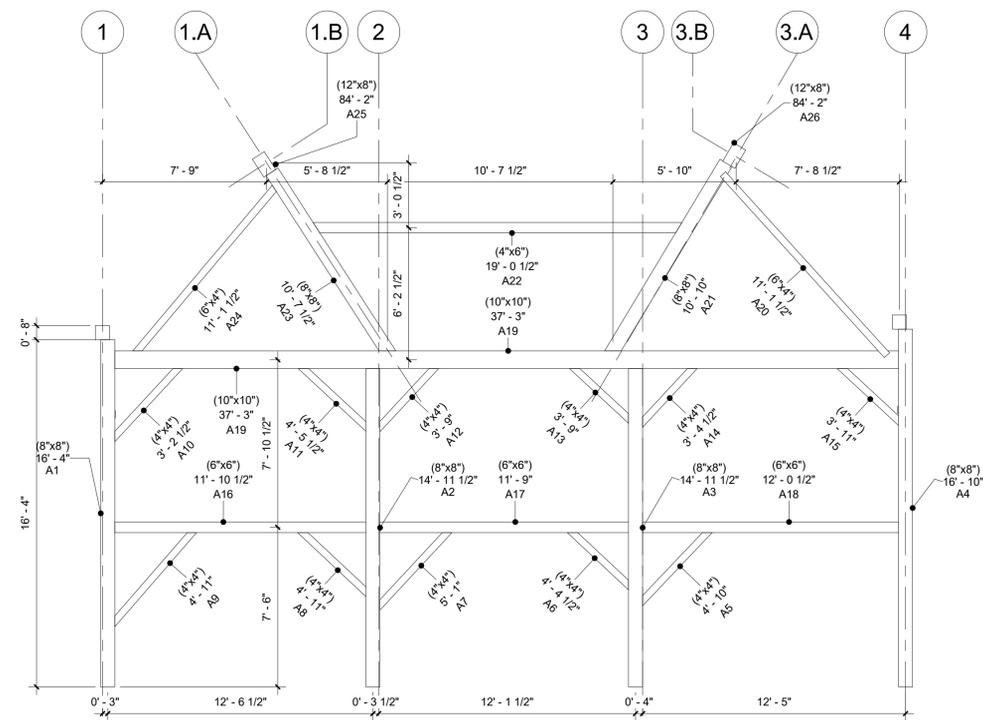

## Bent A

Project Number **Project 3**

Date **20240804**

Drawn By

Checked By

# A109

Scale **1/4" = 1'-0"**

# Timber Home Services LLC


80 Old Gate Road,  
Penn Run PA, 15765

**DAN TRIMBLE**  
AA66 / TIMBER HOME SERVICES

CELL PHONE/TEXT - 412-309-1161

EMAIL:

DANTRIMBLE@TIMBERHOMESERVICES.COM

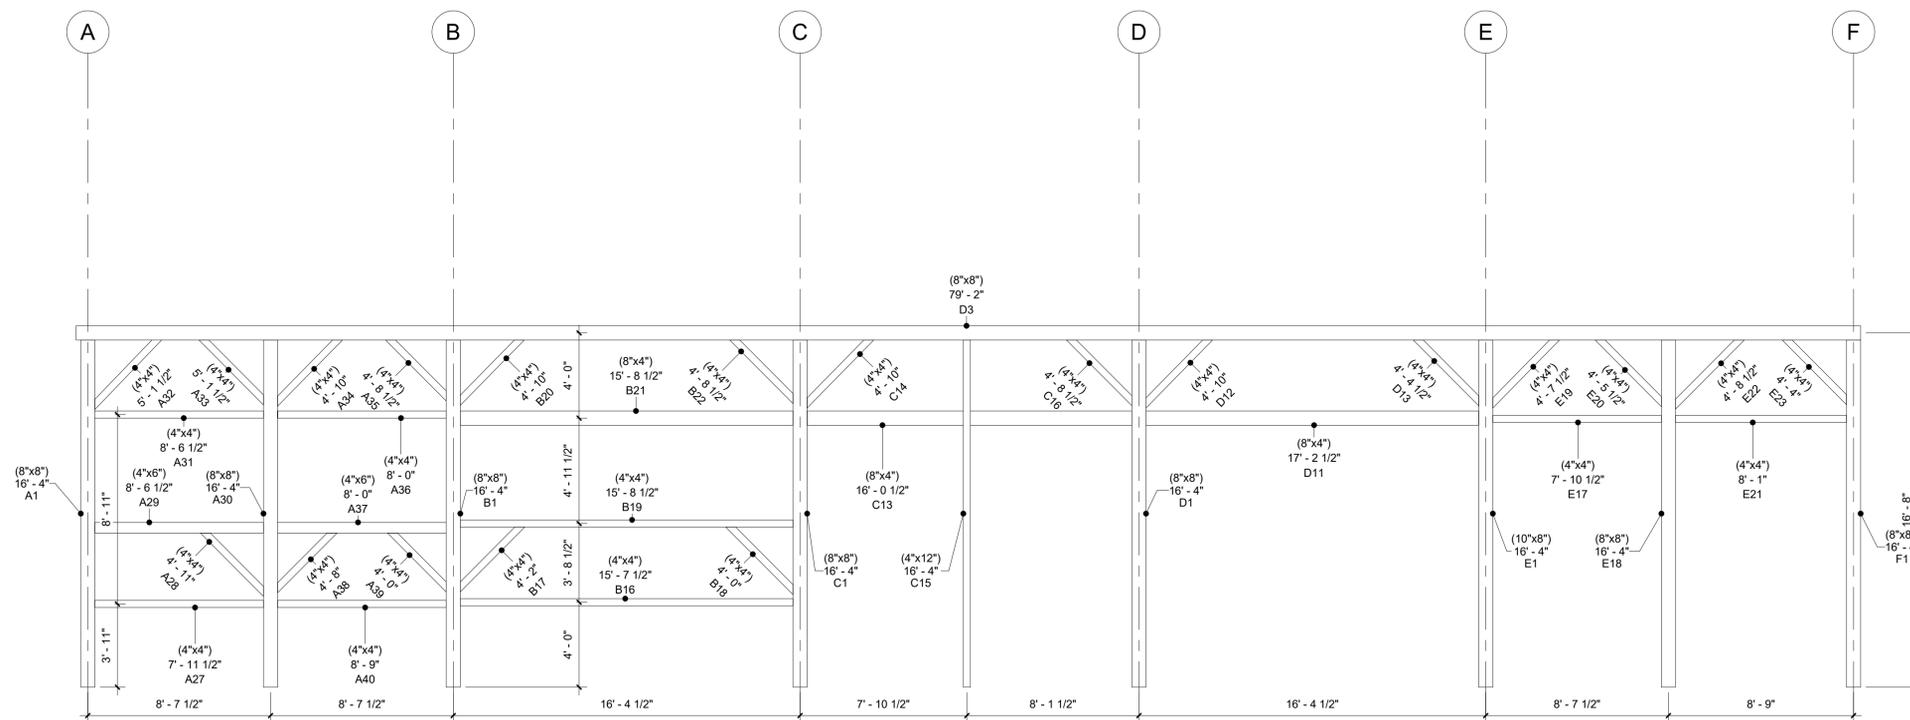

## Bent 1

Project Number **Project 3**

Date **20240804**

Drawn By

Checked By

# A110


Scale **1/4" = 1'-0"**

# Timber Home Services LLC

80 Old Gate Road,  
Penn Run PA, 15765

**DAN TRIMBLE**  
AA66 / TIMBER HOME SERVICES  
CELL PHONE/TEXT - 412-309-1161

EMAIL:  
DANTRIMBLE@TIMBERHOMESERVICES.COM

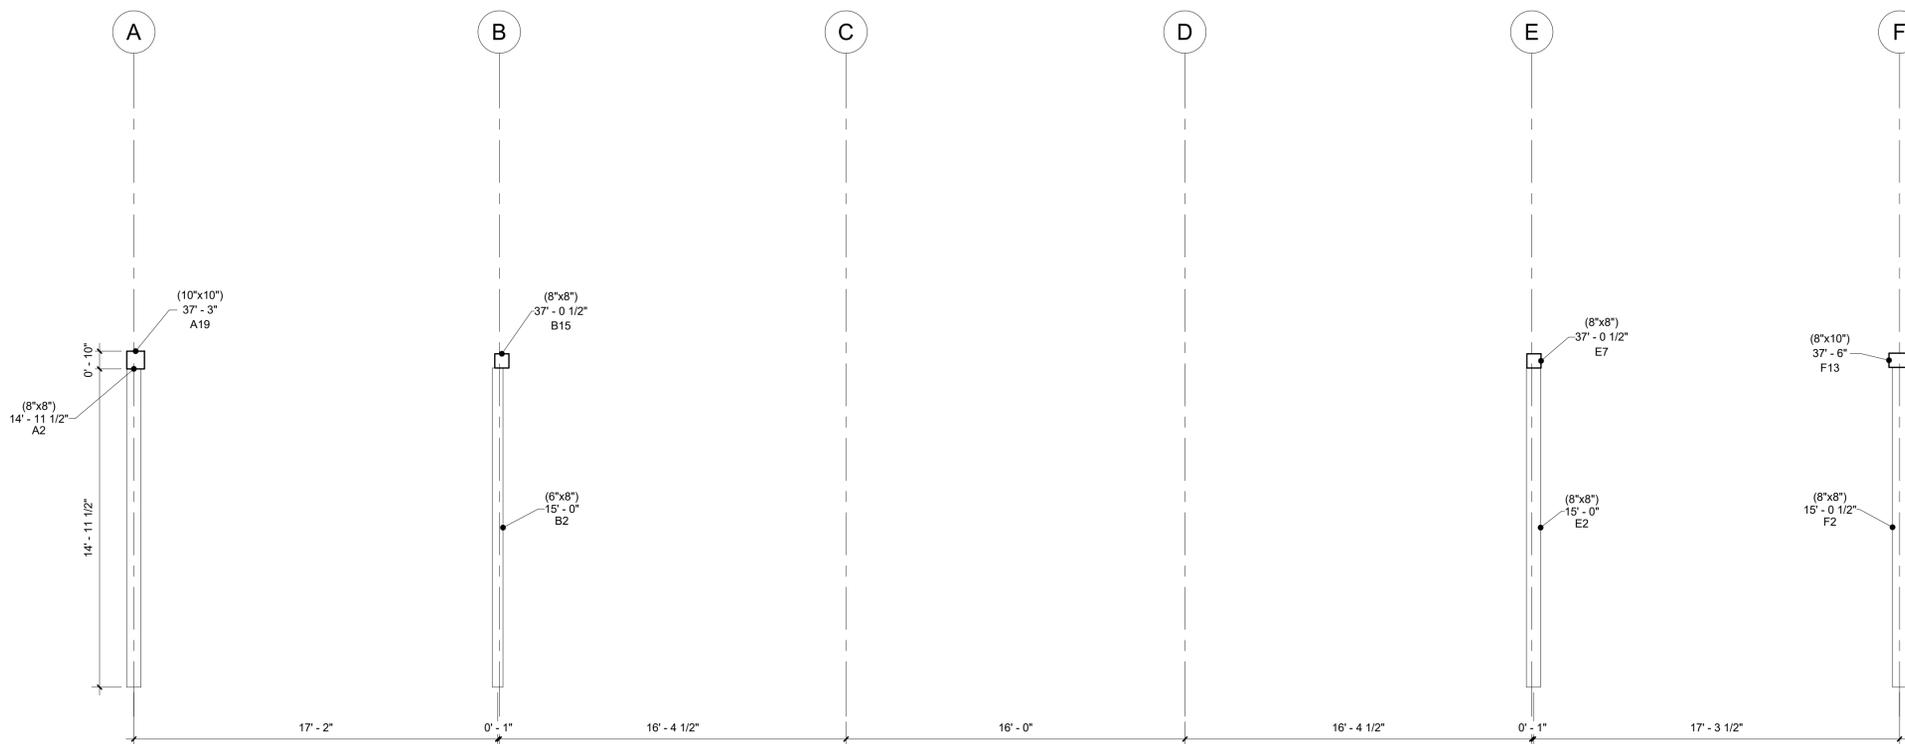

## Bent 2

Project Number	Project 3
Date	20240804
Drawn By	
Checked By	

# A111


Scale 1/4" = 1'-0"

# Timber Home Services LLC

80 Old Gate Road,  
Penn Run PA, 15765

**DAN TRIMBLE**  
AA66 / TIMBER HOME SERVICES  
CELL PHONE/TEXT - 412-309-1161

EMAIL:  
DANTRIMBLE@TIMBERHOMESERVICES.COM

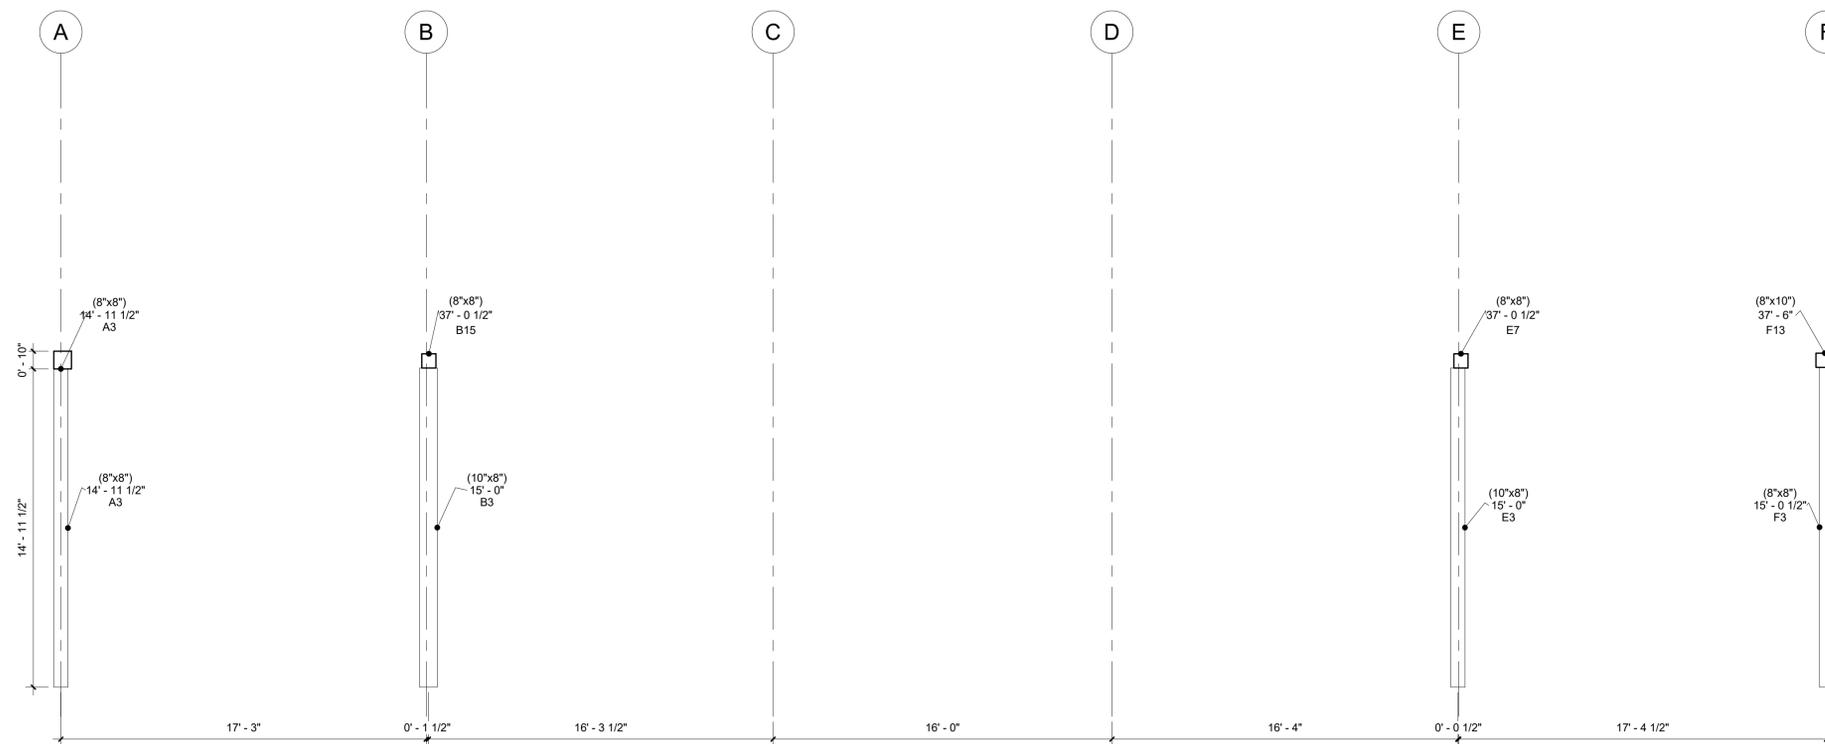

## Bent 3

Project Number	Project 3
Date	20240804
Drawn By	
Checked By	

# A112

Scale 1/4" = 1'-0"

# Timber Home Services LLC


80 Old Gate Road,  
Penn Run PA, 15765

**DAN TRIMBLE**  
AA66 / TIMBER HOME SERVICES

CELL PHONE/TEXT - 412-309-1161

EMAIL:

DANTRIMBLE@TIMBERHOMESERVICES.COM

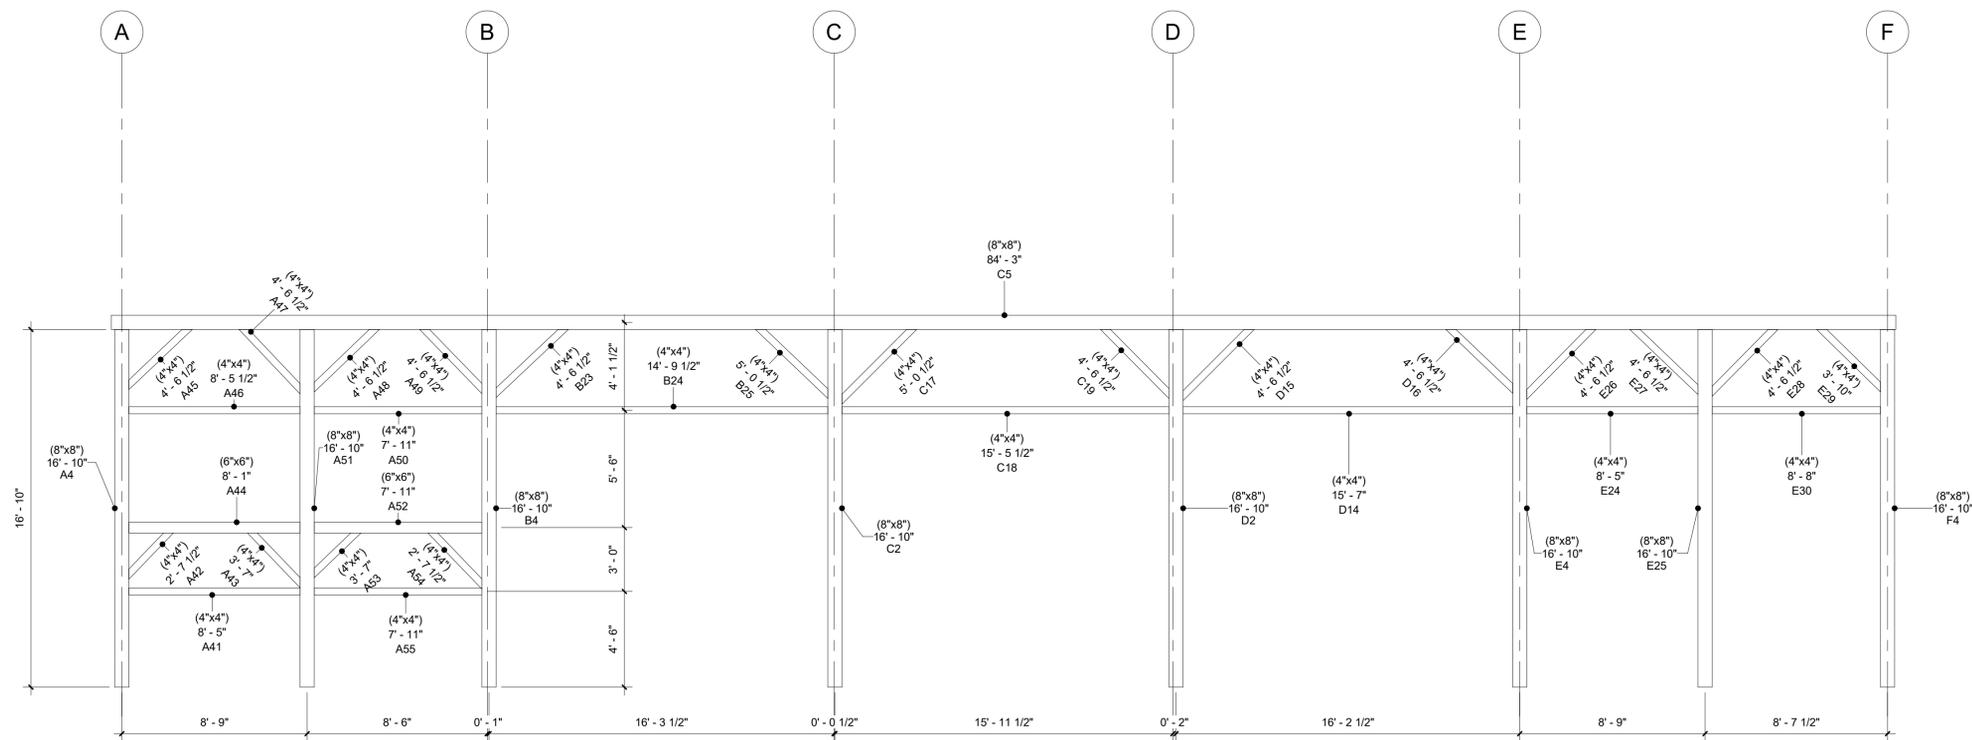

## Bent 4

Project Number **Project 3**

Date **20240804**

Drawn By

Checked By

# A113

Scale **1/4" = 1'-0"**

# Timber Home Services LLC


80 Old Gate Road,  
Penn Run PA, 15765

**DAN TRIMBLE**  
AA66 / TIMBER HOME SERVICES

CELL PHONE/TEXT - 412-309-1161

EMAIL:

DANTRIMBLE@TIMBERHOMESERVICES.COM

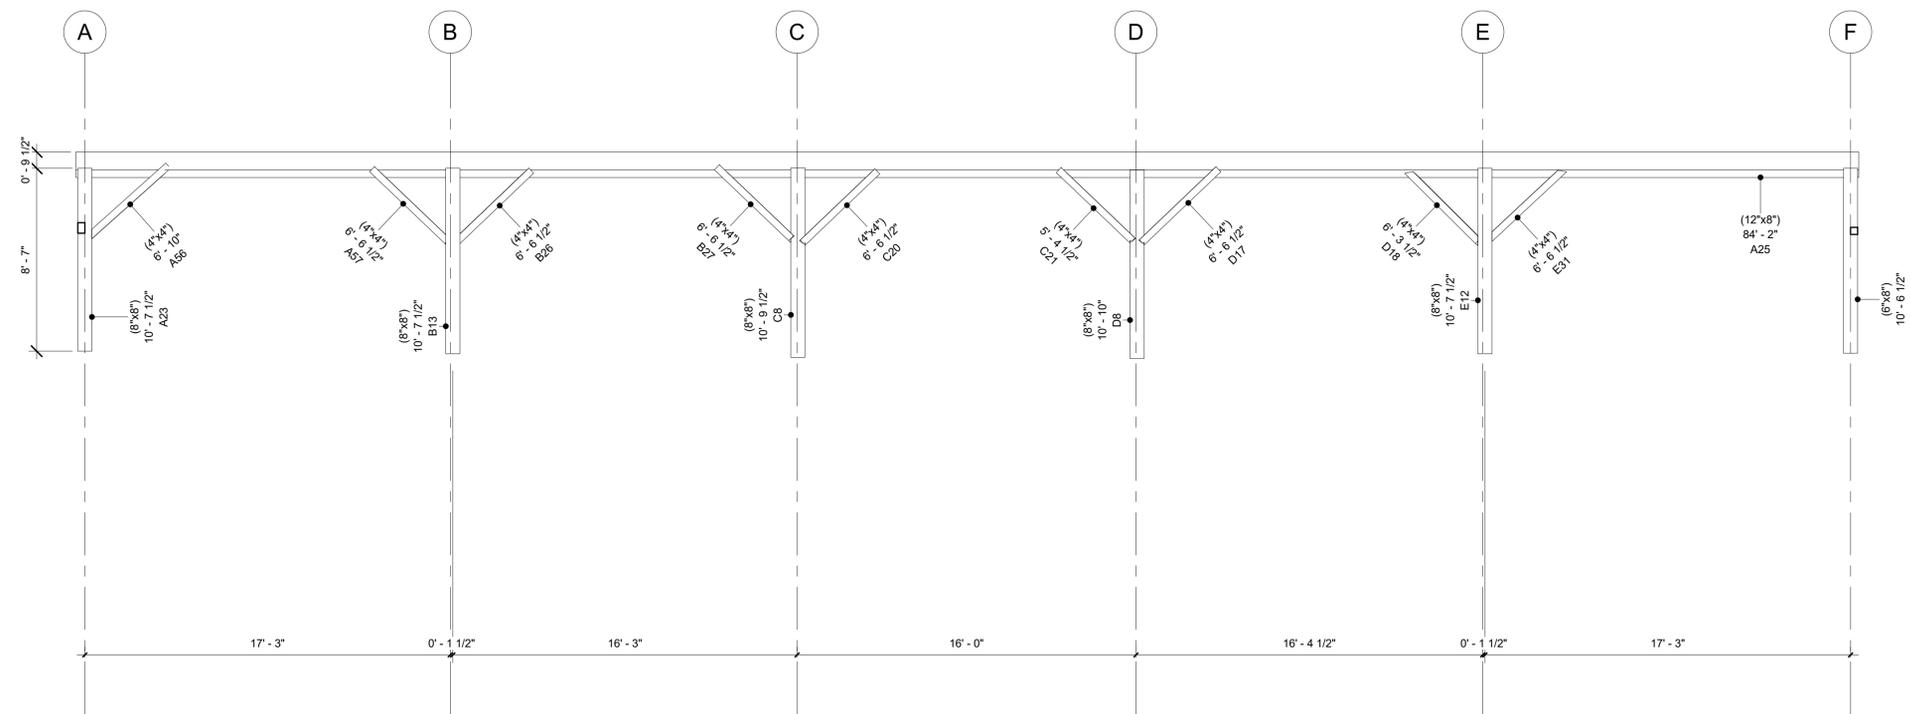

## Bent 1.A

Project Number Project 3

Date 20240804

Drawn By

Checked By

# A114


Scale 1/4" = 1'-0"

# Timber Home Services LLC

80 Old Gate Road,  
Penn Run PA, 15765

**DAN TRIMBLE**  
AA66 / TIMBER HOME SERVICES  
CELL PHONE/TEXT - 412-309-1161

EMAIL:  
DANTRIMBLE@TIMBERHOMESERVICES.COM

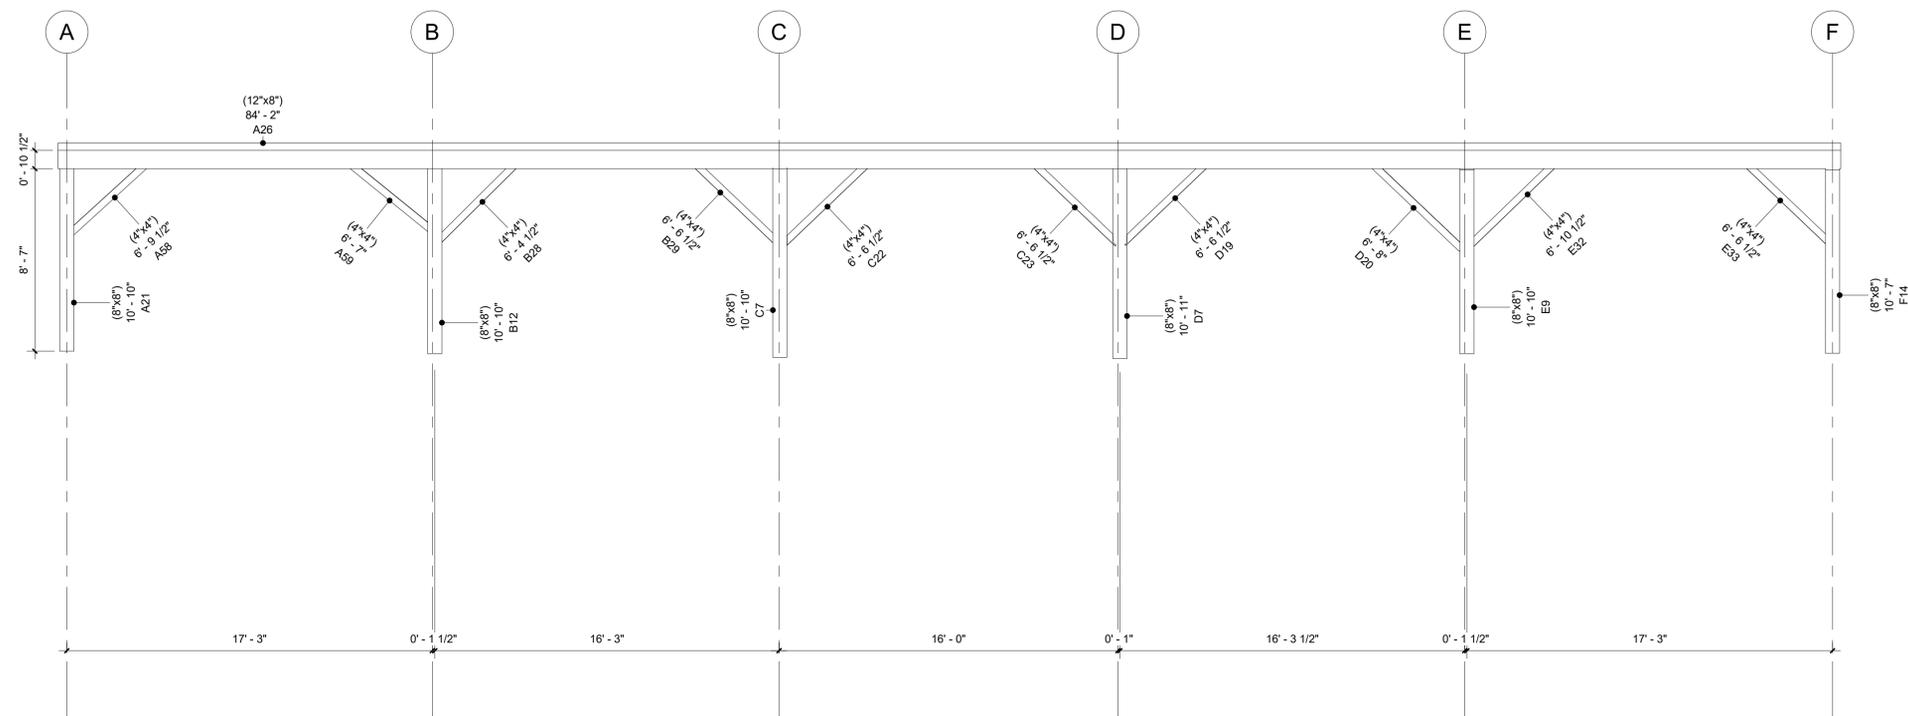

## Bent 3.A

Project Number	Project 3
Date	20240804
Drawn By	
Checked By	

# A115

Scale 1/4" = 1'-0"