


PROJECT: Piney Hollow

SCOPE: AS BUILT DRAWINGS

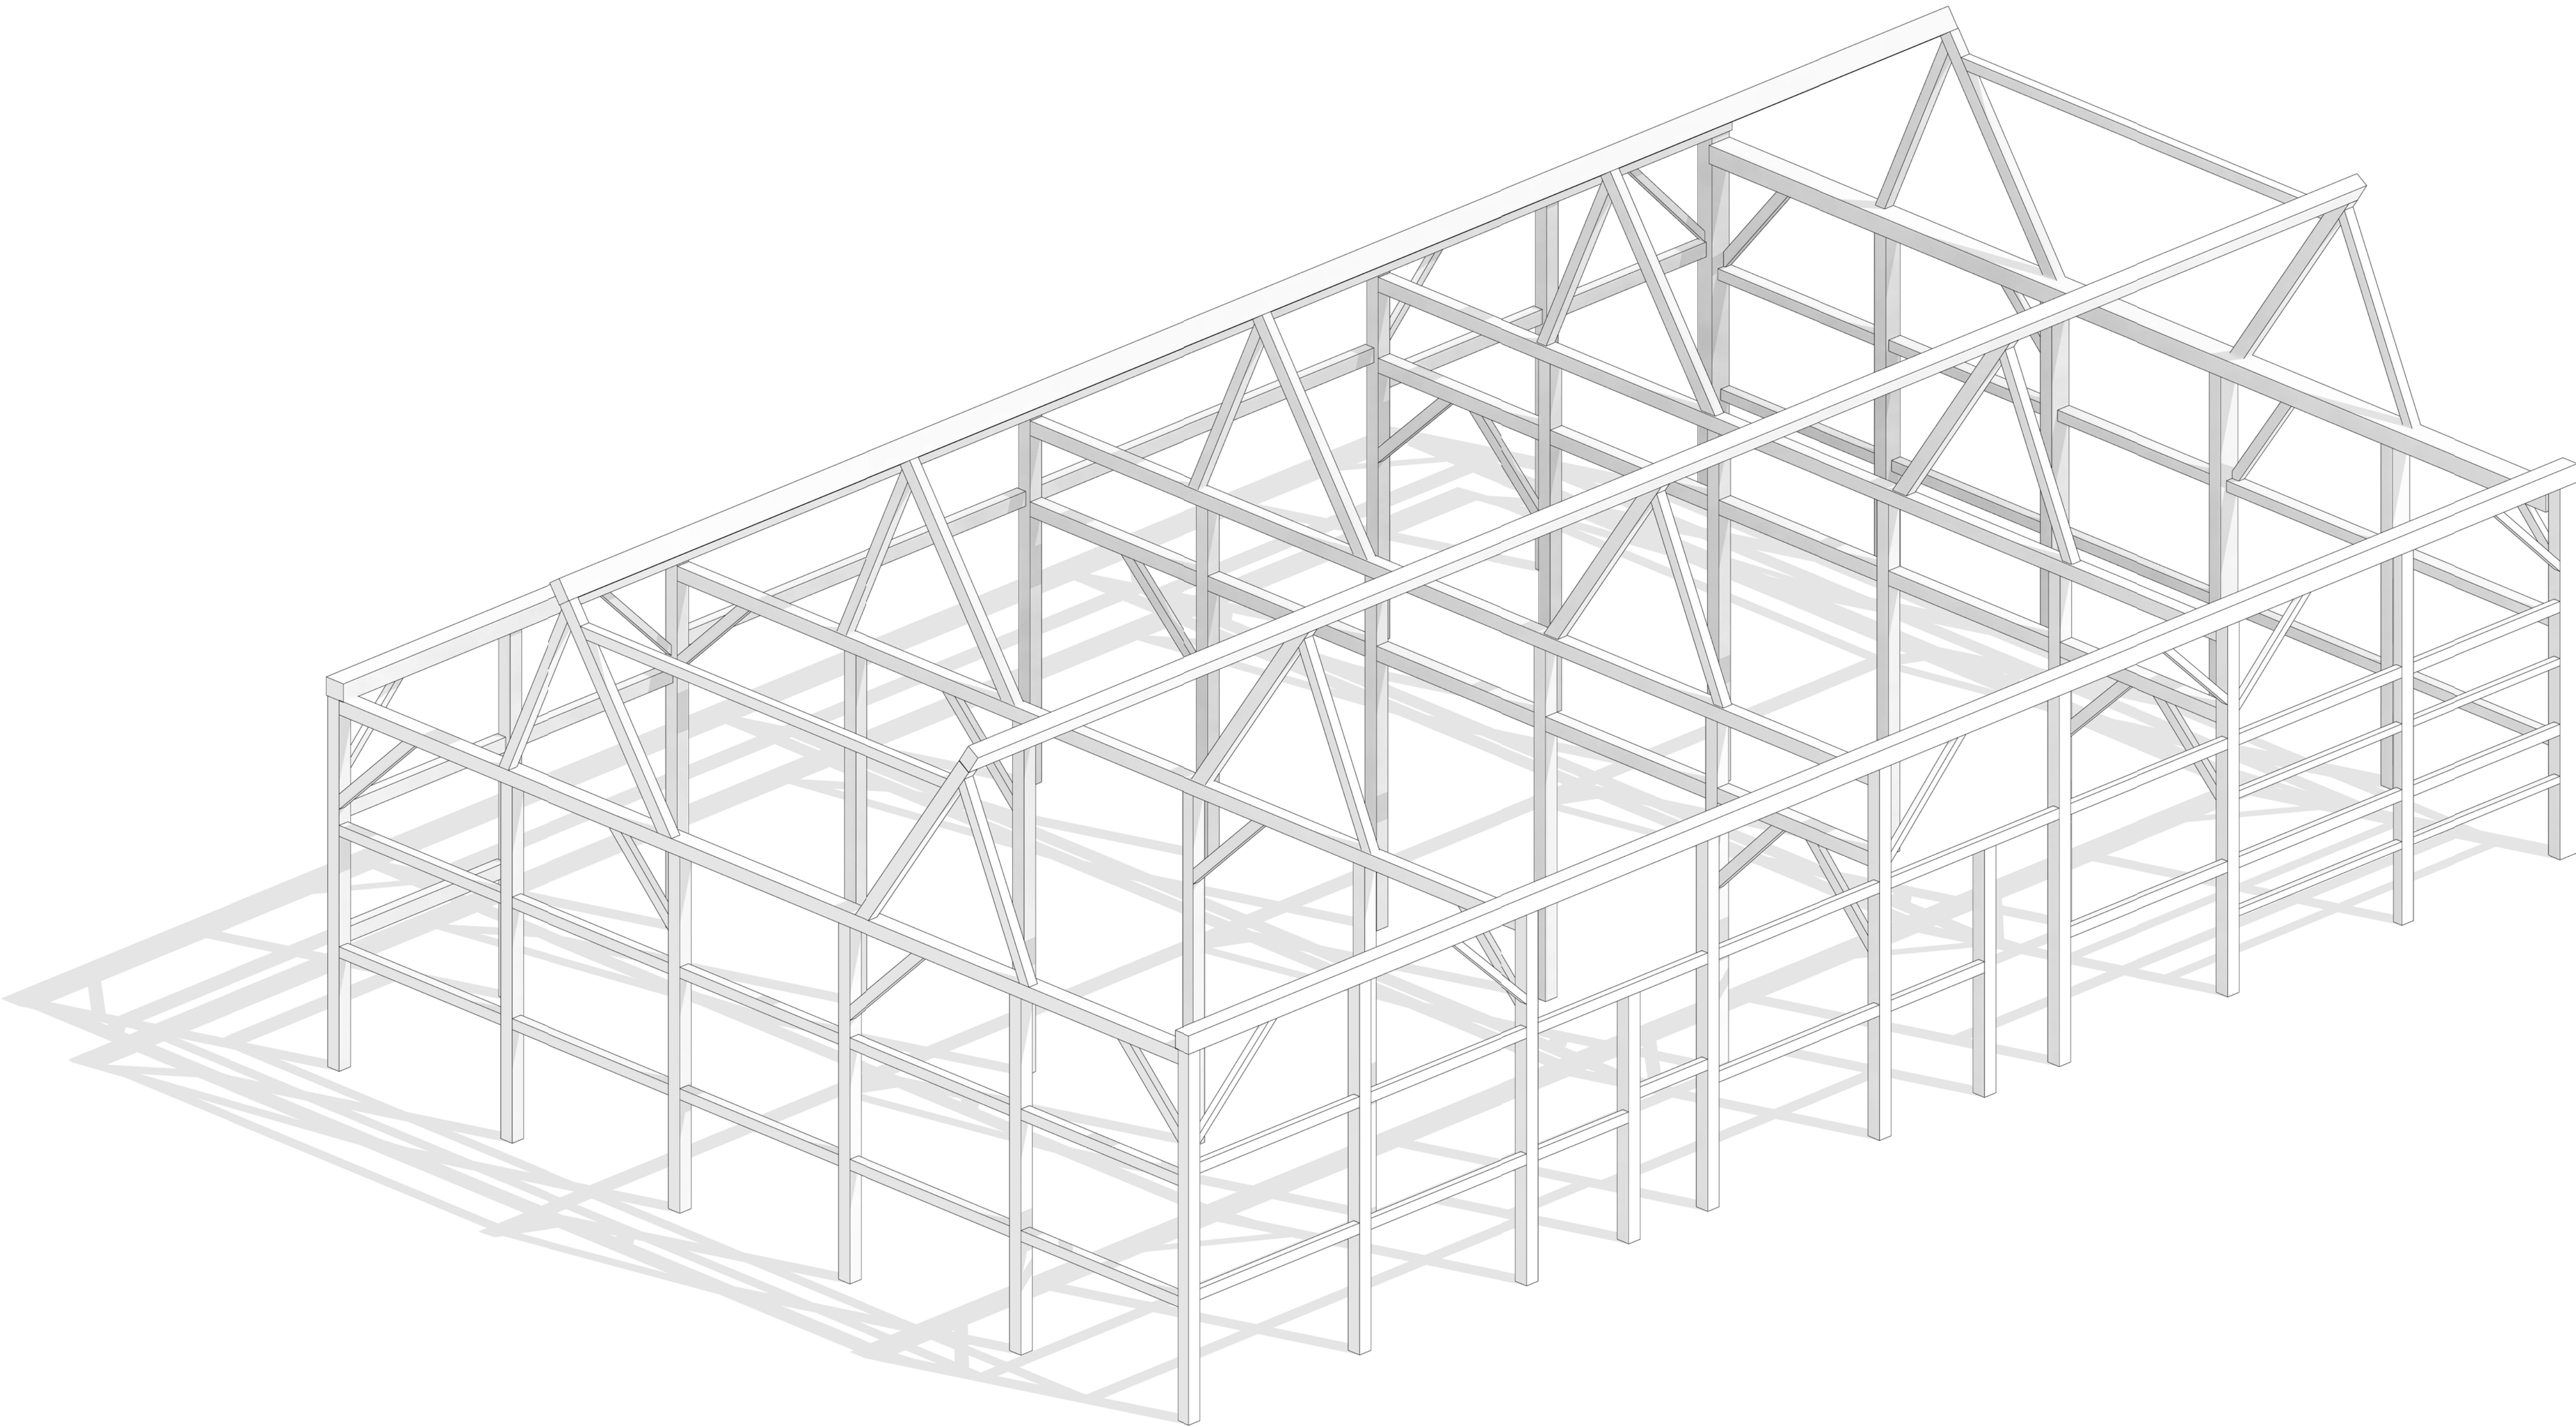

Timber
Home
Services LLC

Piney Hollow

DAN TRIMBLE
AA66 / TIMBER HOME SERVICES
CELL PHONE/TEXT - 412-309-1161

EMAIL:
DANTRIMBLE@TIMBERHOMESERVICES.COM

Cover Page

Project Number	Project 16
Date	20250605
Drawn By	
Checked By	

A101

Scale

Timber
Home
Services LLC

Piney Hollow

DAN TRIMBLE
AA66 / TIMBER HOME SERVICES
CELL PHONE/TEXT - 412-309-1161

EMAIL:
DANTRIMBLE@TIMBERHOMESERVICES.COM

Floor Plan

Project Number	Project 16
Date	20250605
Drawn By	
Checked By	

A102

Scale 1/4" = 1'-0"



Timber Home Services LLC

Piney Hollow


Piney Hollow

DAN TRIMBLE
AA66 / TIMBER HOME SERVICES

CELL PHONE/TEXT - 412-309-1161

EMAIL:

DANTRIMBLE@TIMBERHOMESERVICES.COM

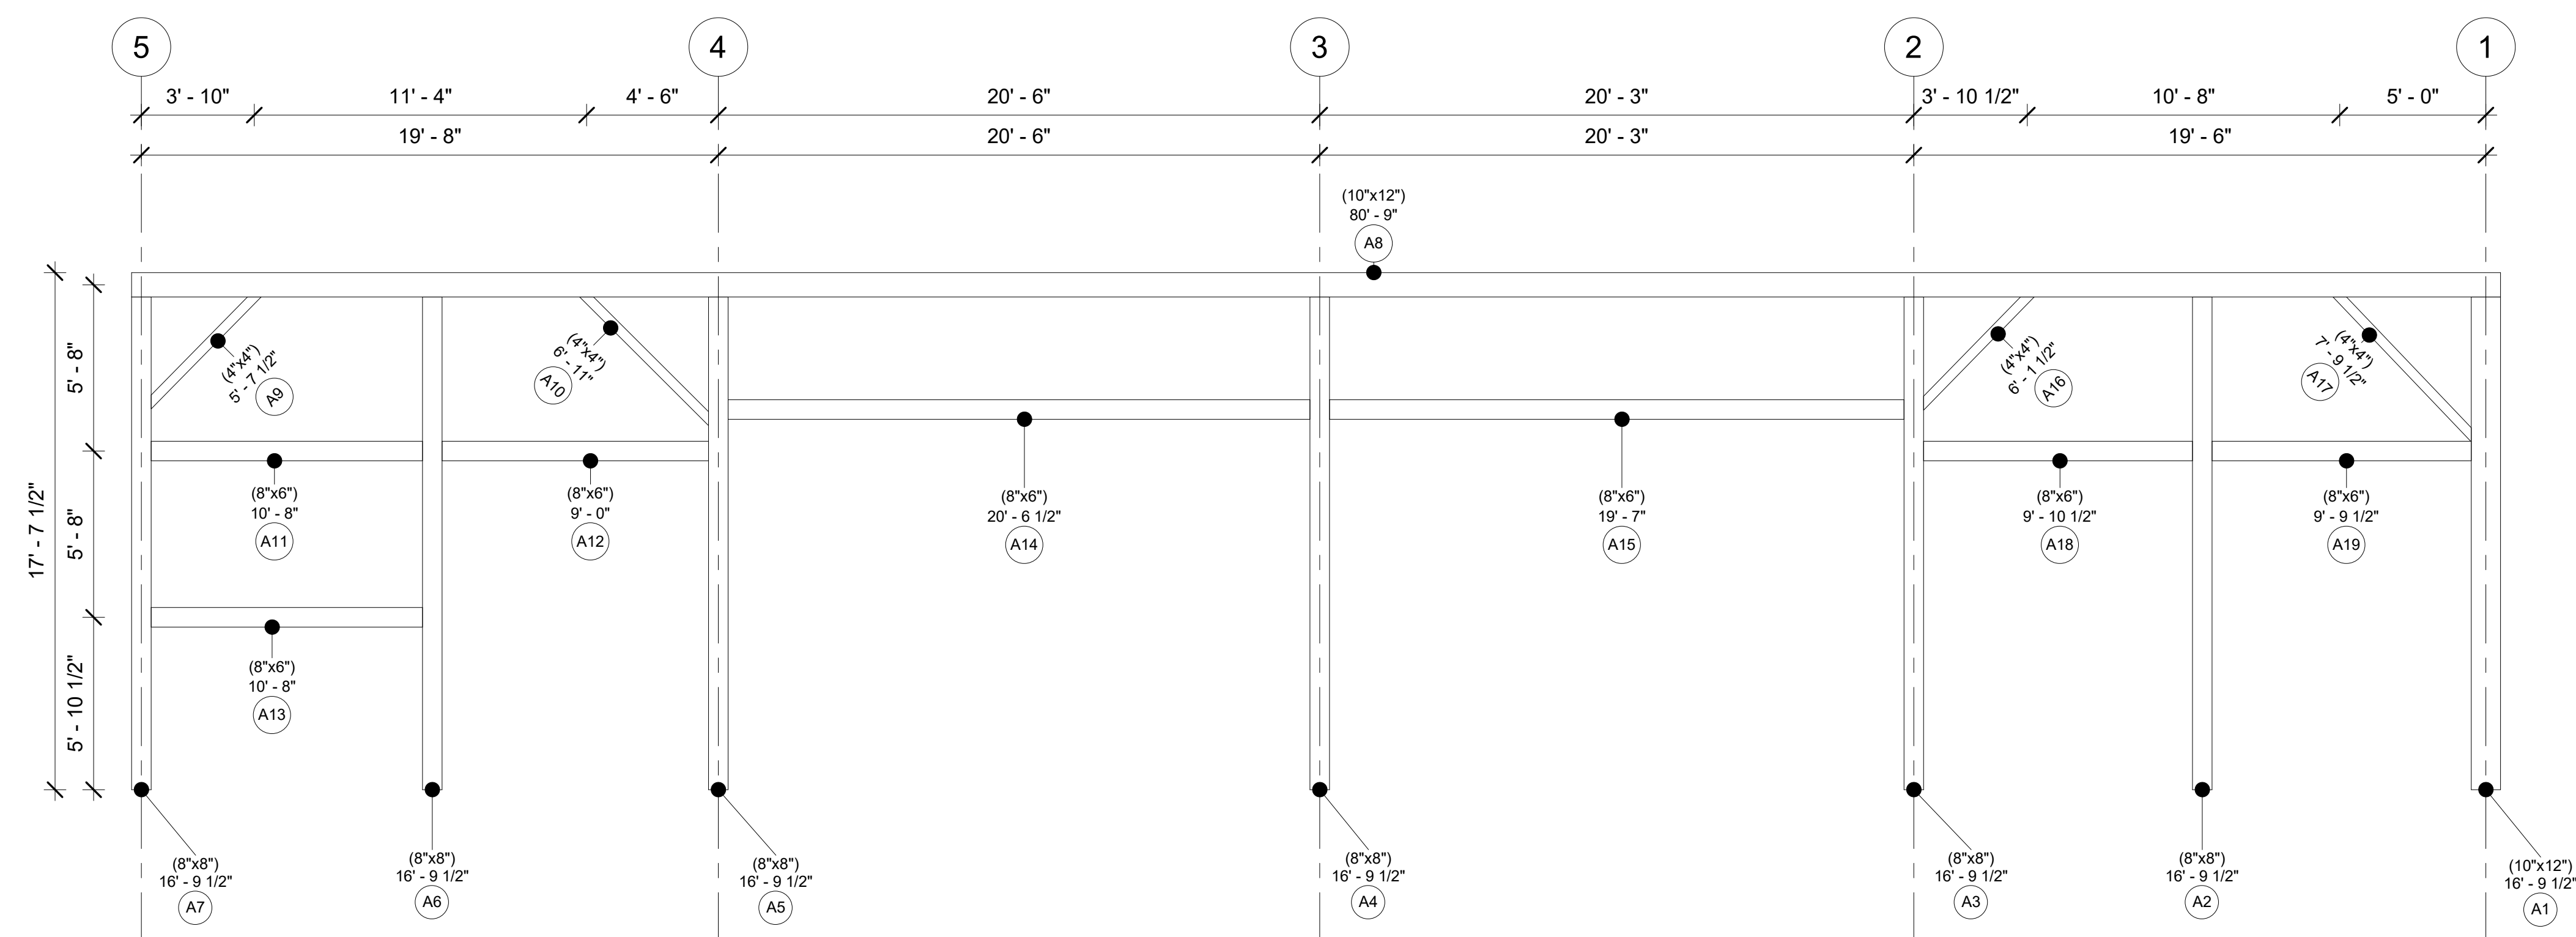

Bent A

Project Number	Project 16
----------------	------------

Date	20250605
------	----------

Drawn By

Checked By	
------------	--

A103


Scale	1/4" = 1'-0"
-------	--------------

Timber
Home
Services LLC

Piney Hollow

DAN TRIMBLE
AA66 / TIMBER HOME SERVICES
CELL PHONE/TEXT - 412-309-1161

EMAIL:
DANTRIMBLE@TIMBERHOMESERVICES.COM

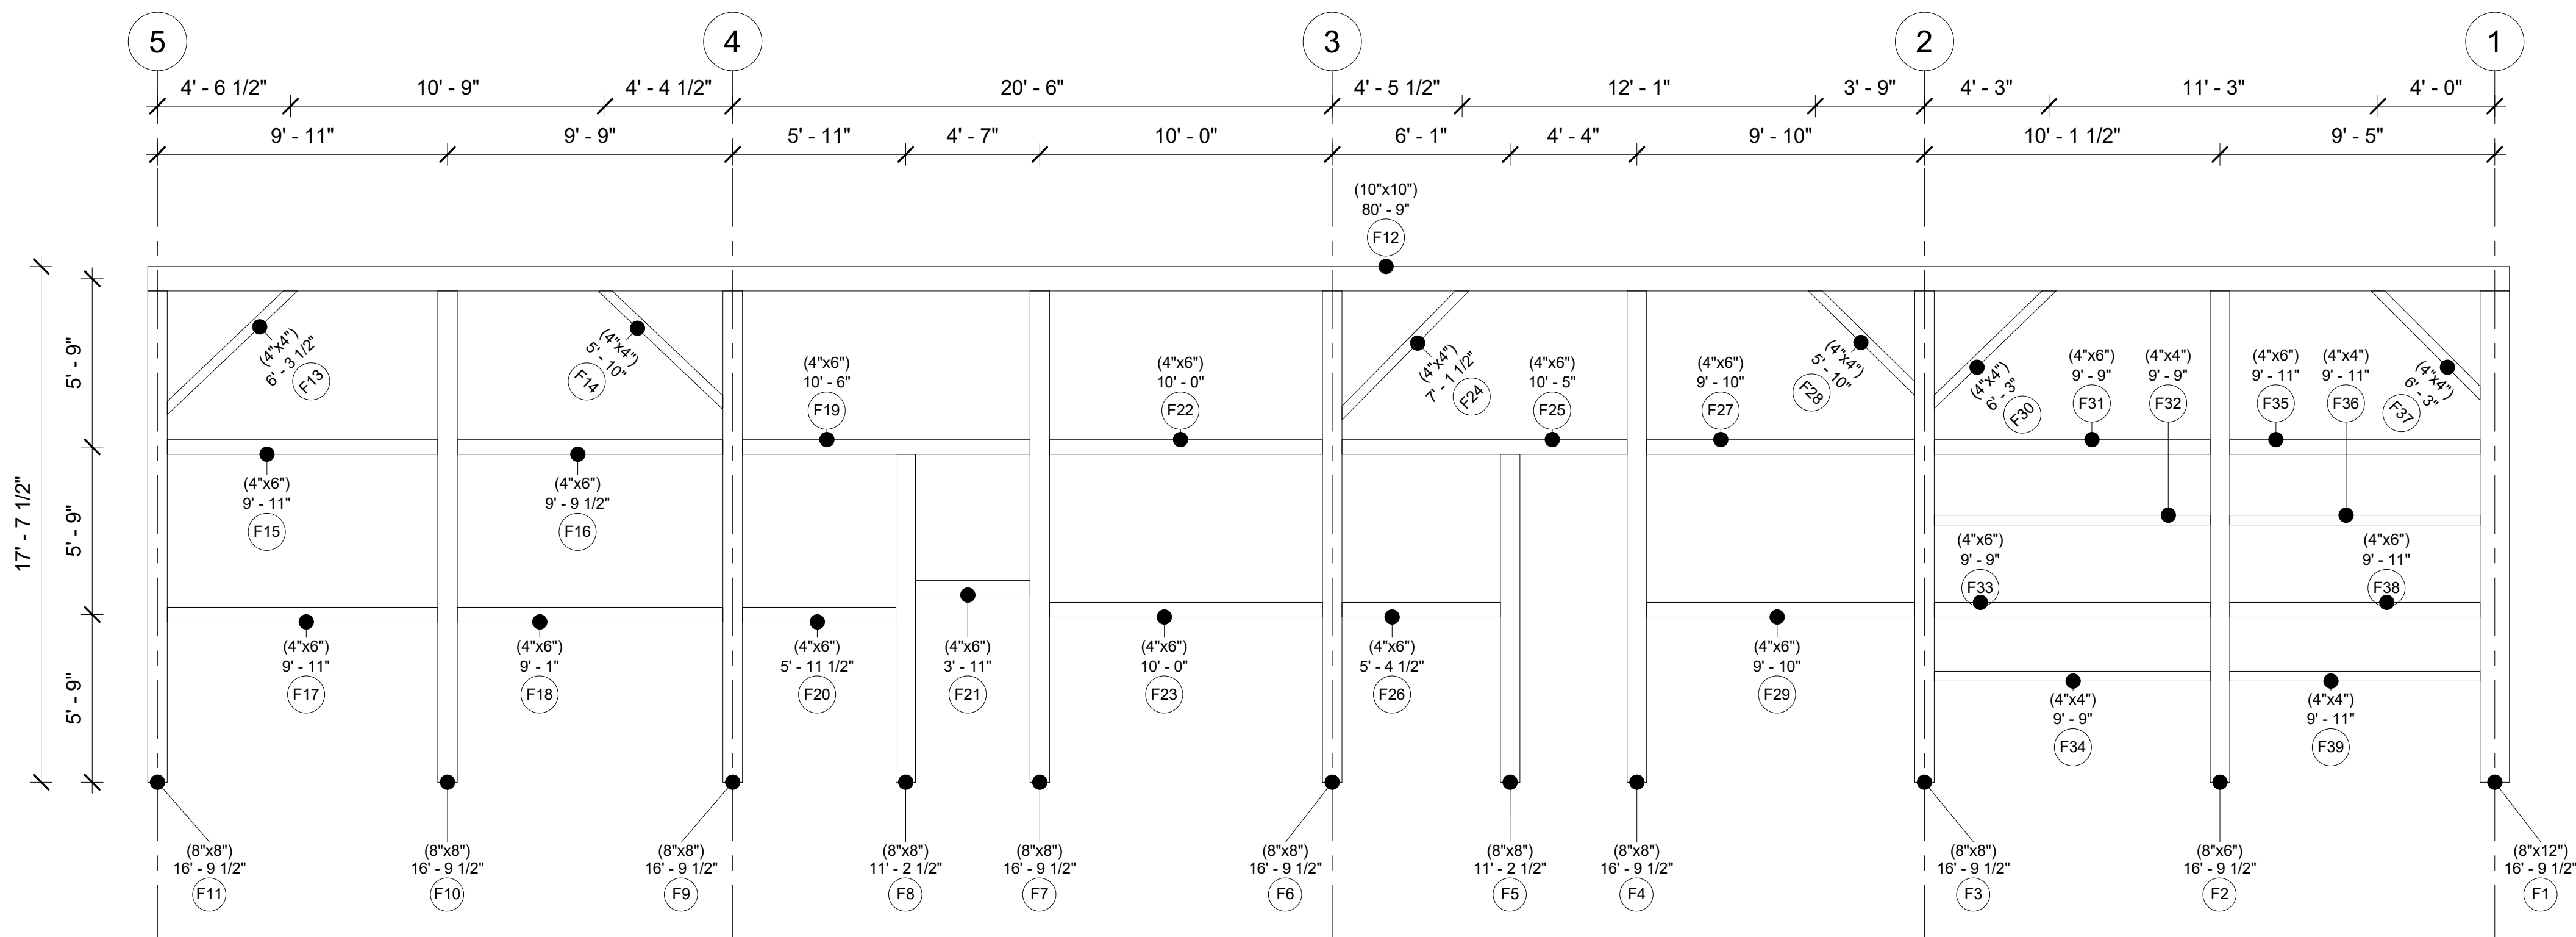

Bent F

Project Number	Project 16
Date	20250605
Drawn By	
Checked By	
A104	
Scale	1/4" = 1'-0"

Timber
Home
Services LLC


Piney Hollow

DAN TRIMBLE
AA66 / TIMBER HOME SERVICES

CELL PHONE/TEXT - 412-309-1161

EMAIL:

DANTRIMBLE@TIMBERHOMESERVICES.COM

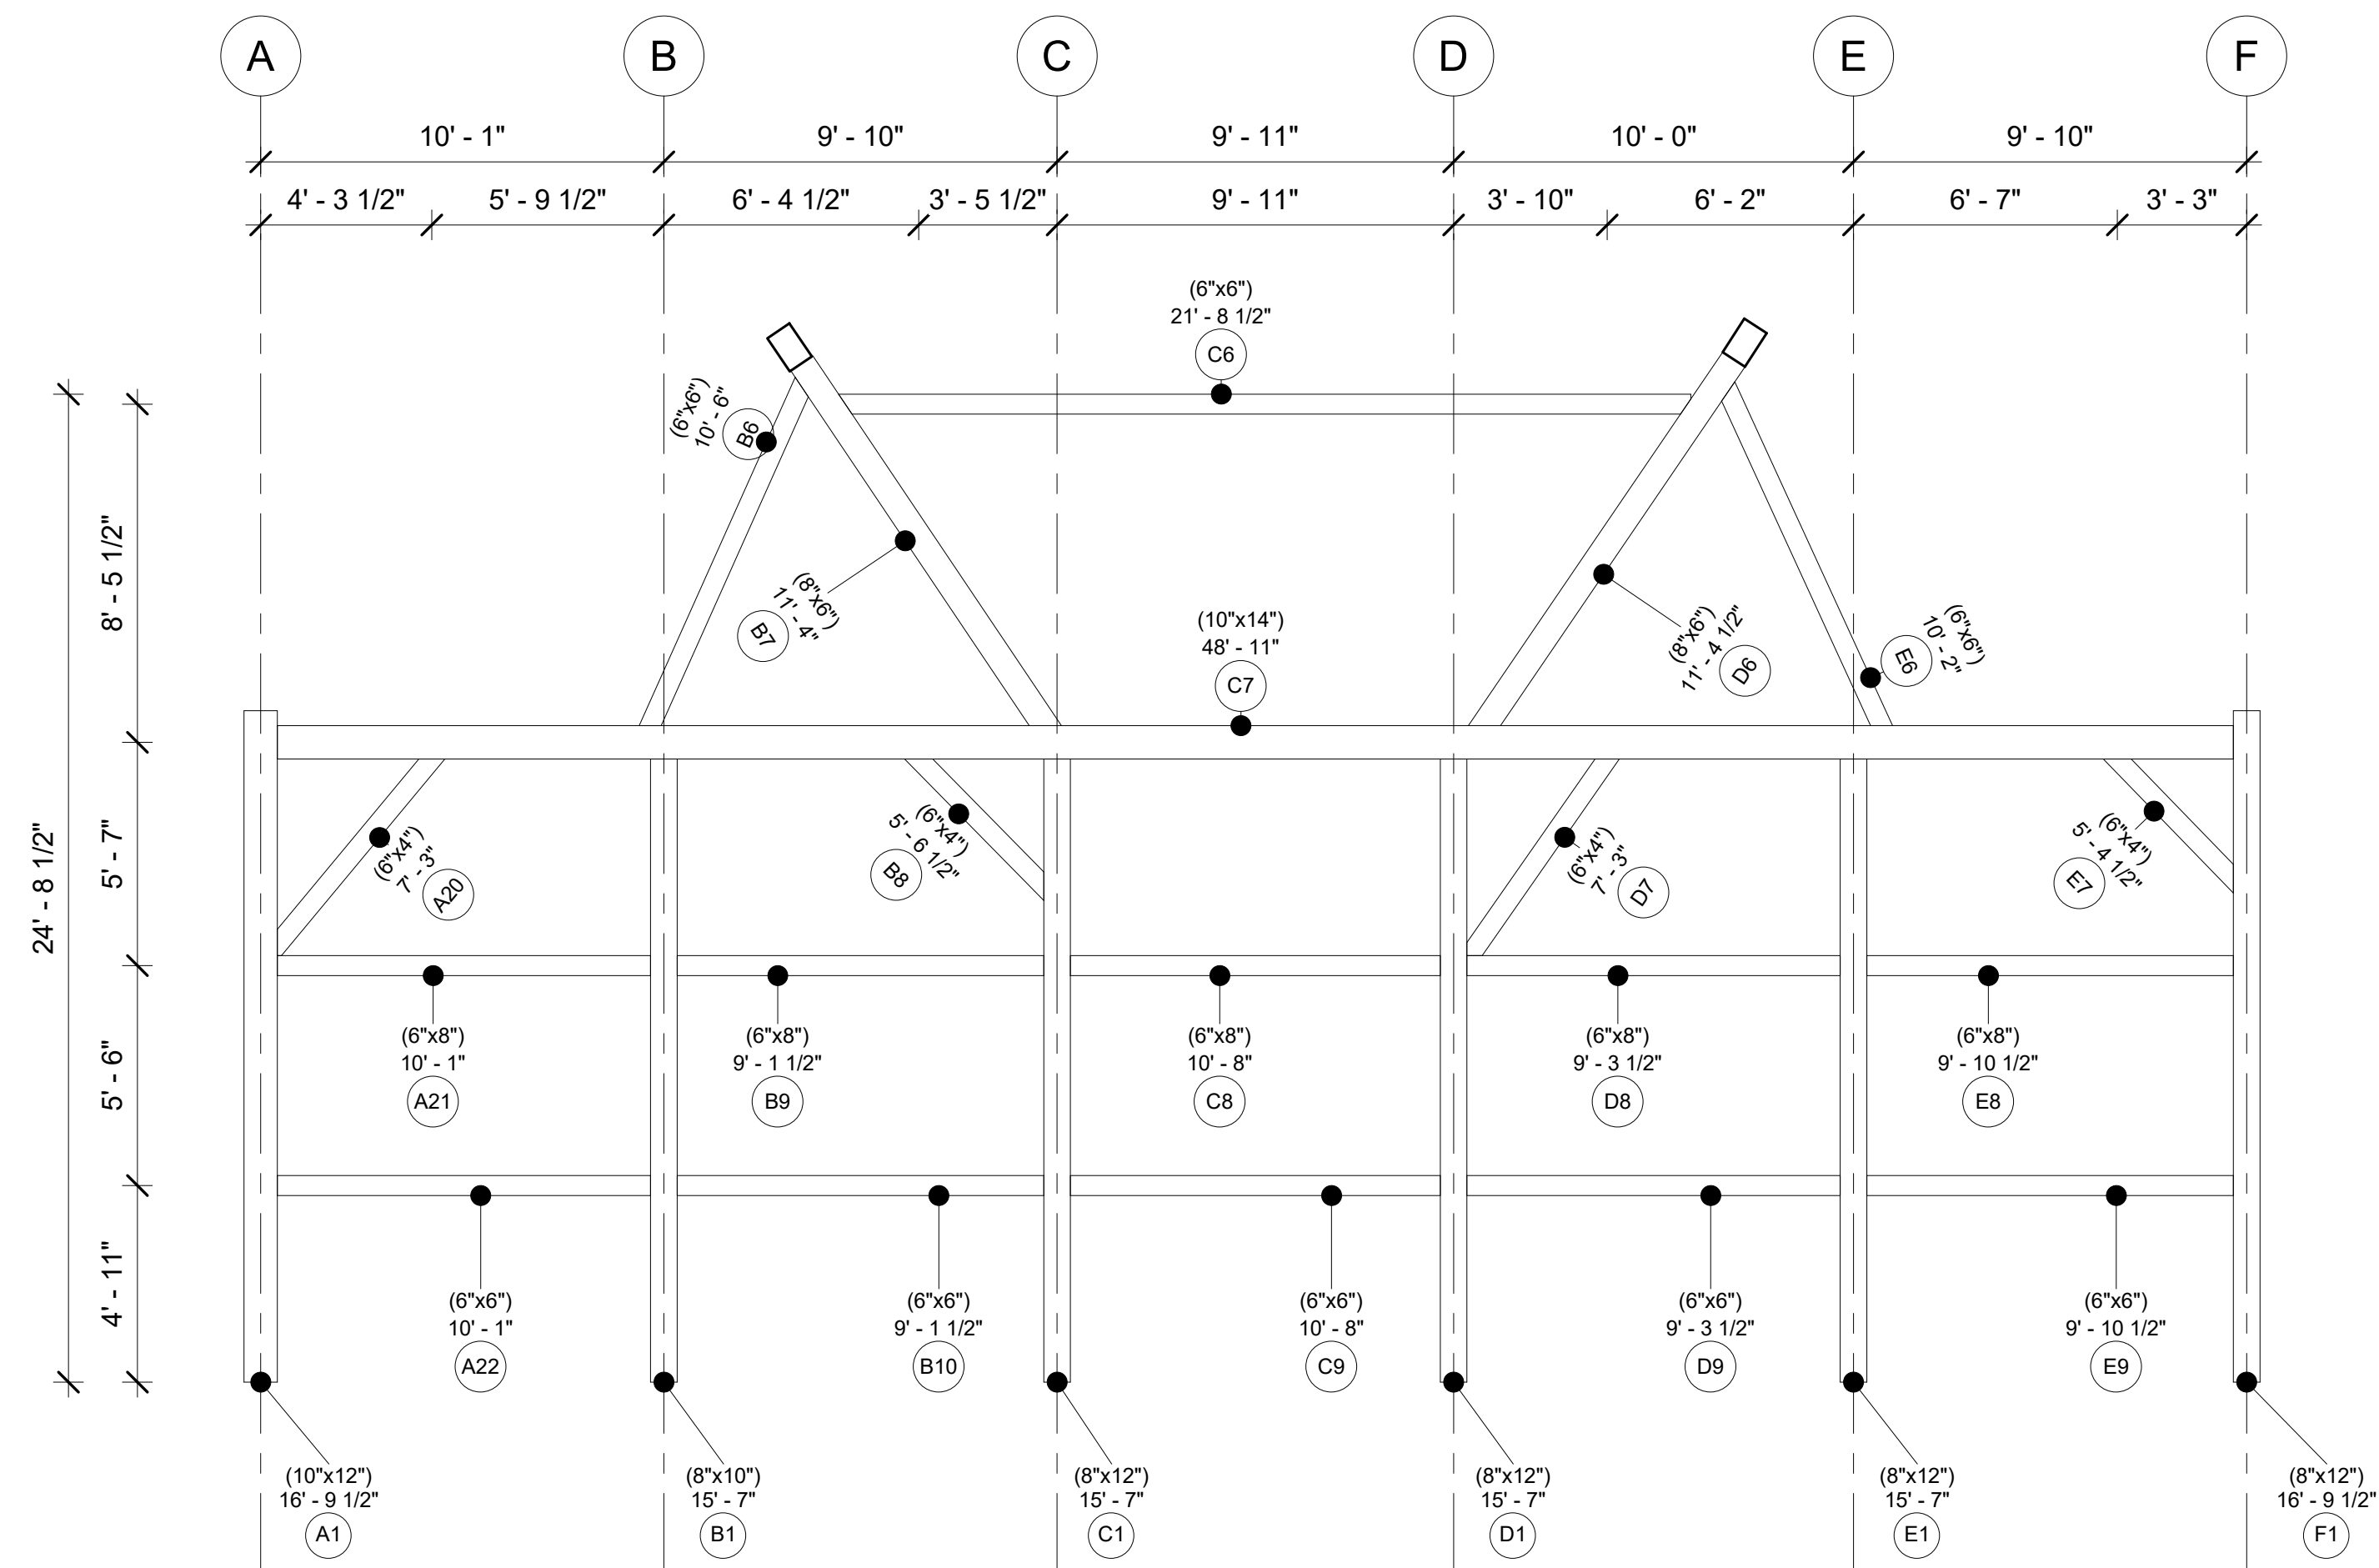

Bent 1

Project Number Project 16

Date	20250605
------	----------

Drawn By _____

Checked By _____

A105


Scale $1/4" = 1'-0"$

Timber
Home
Services LLC

Piney Hollow

DAN TRIMBLE
AA66 / TIMBER HOME SERVICES
CELL PHONE/TEXT - 412-309-1161

EMAIL:
DANTRIMBLE@TIMBERHOMESERVICES.COM

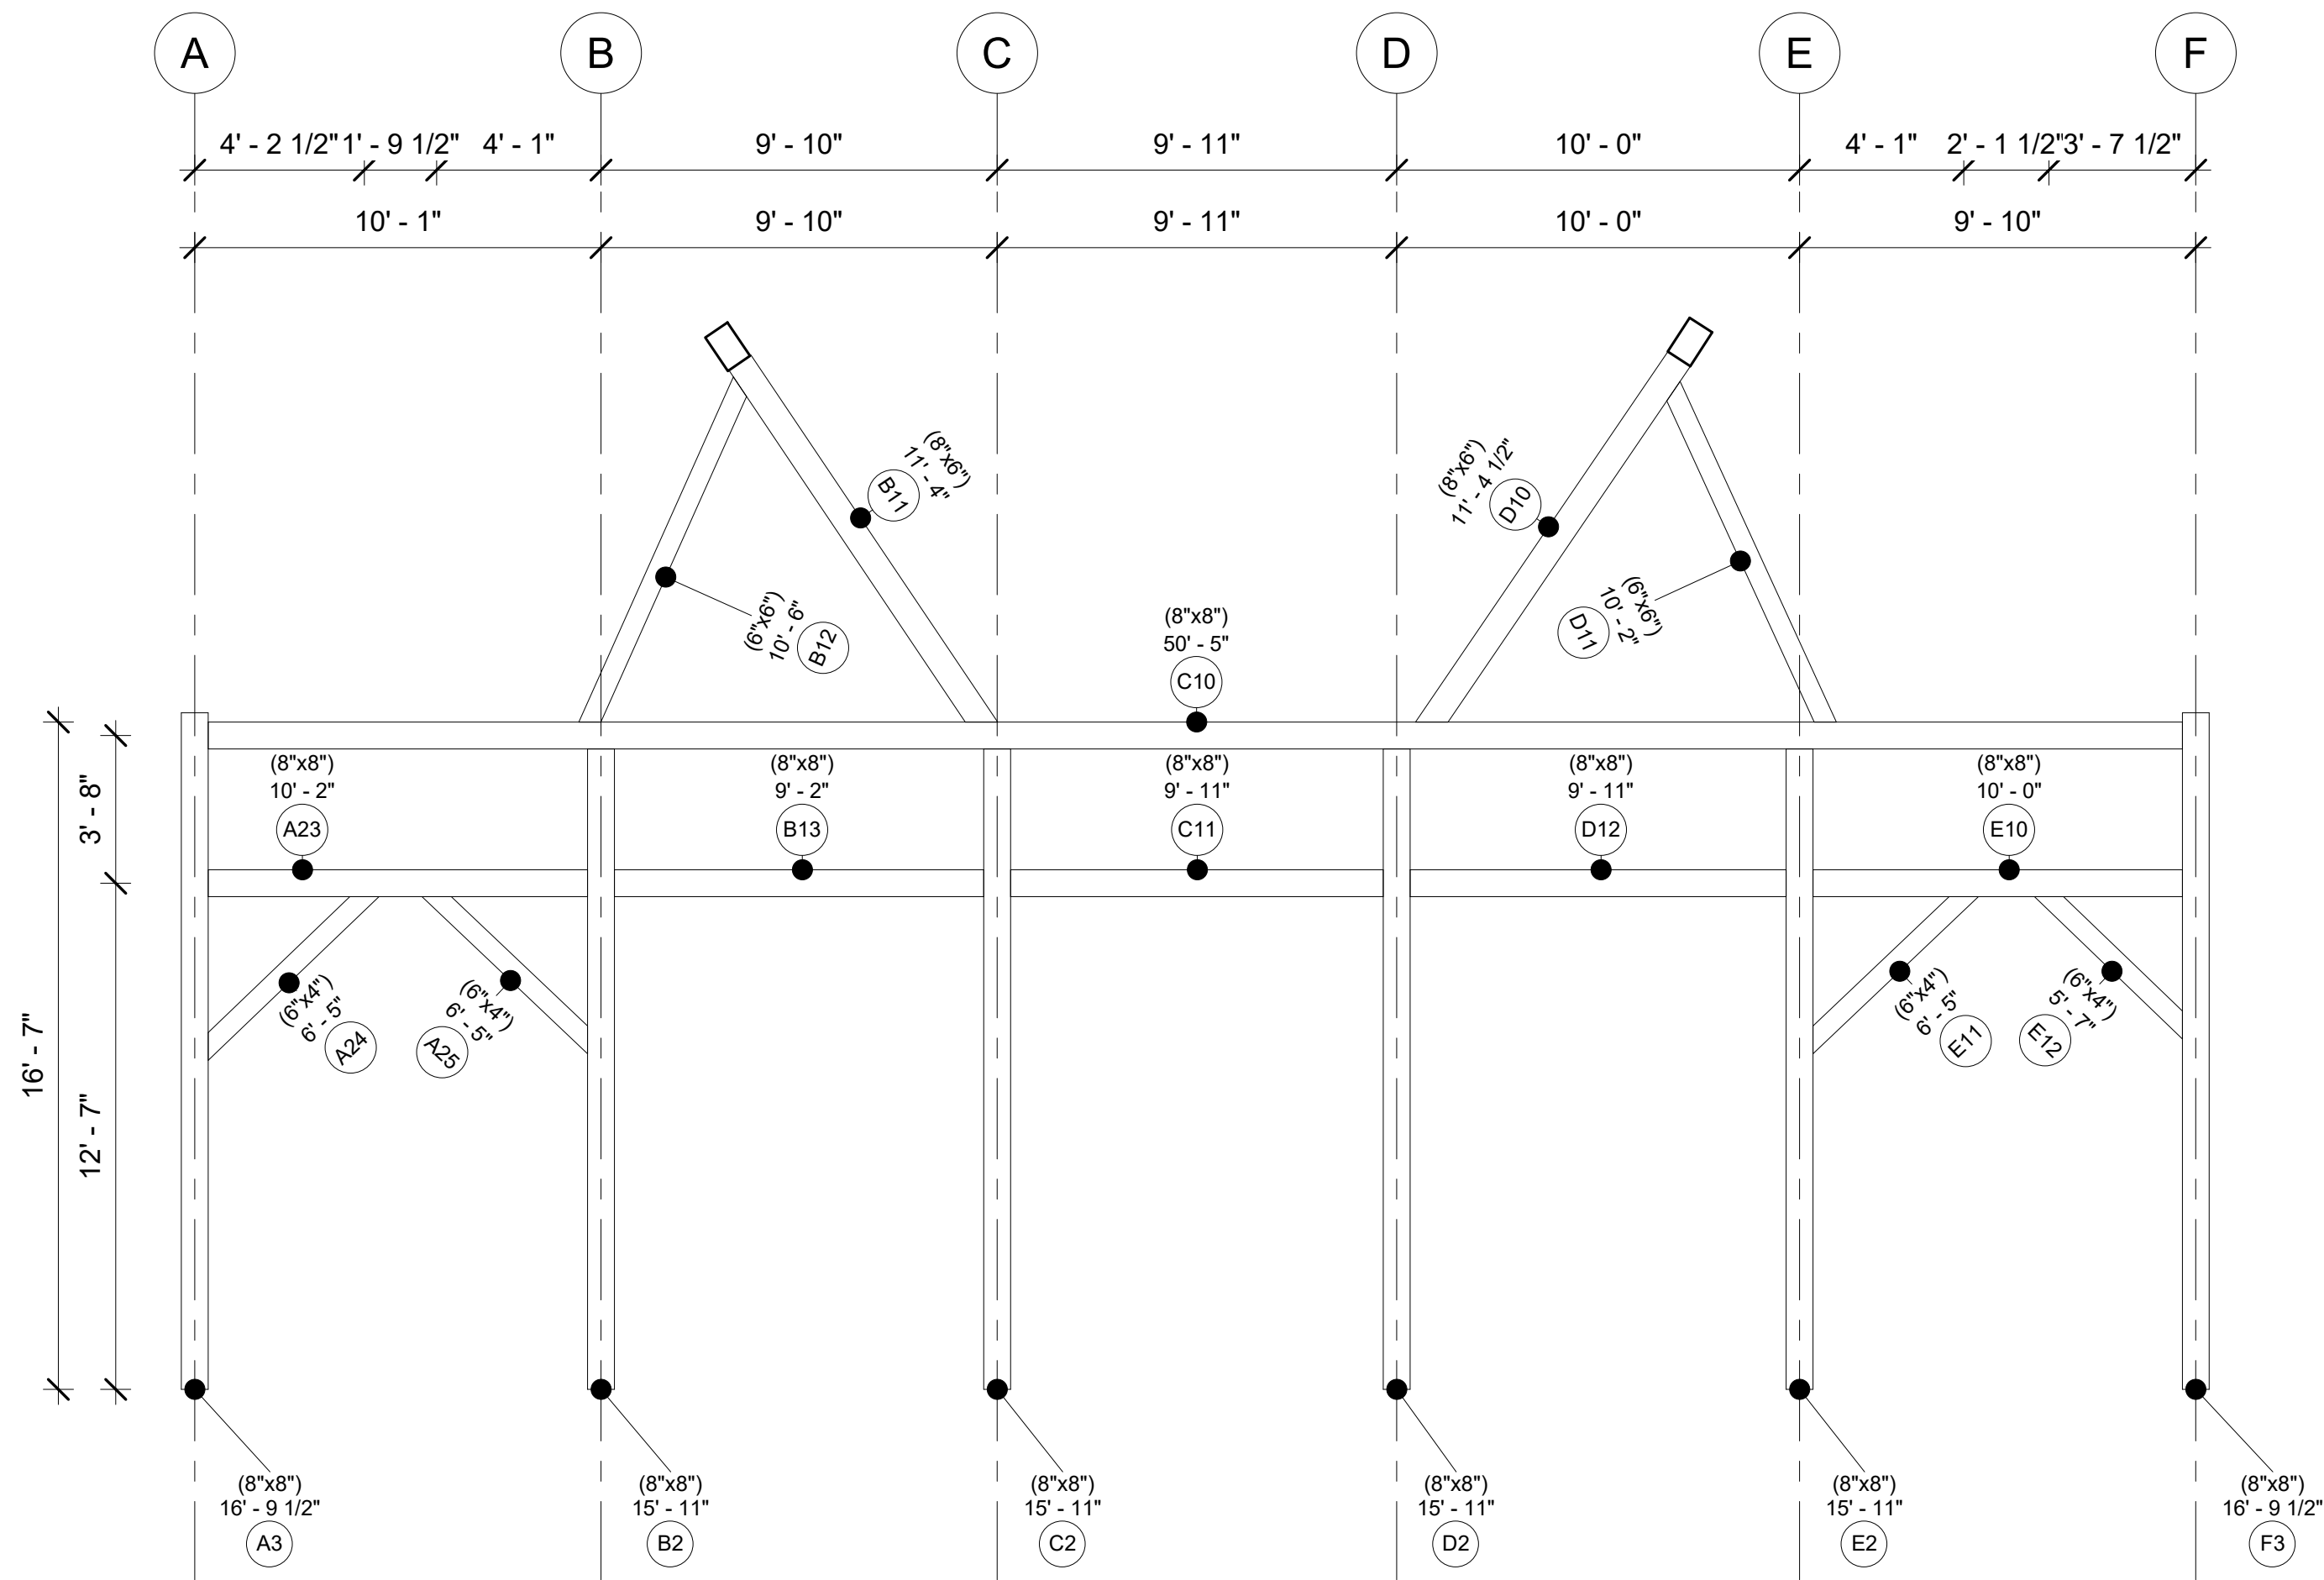

Bent 2

Project Number Project 16
Date 20250605
Drawn By
Checked By

A106

Scale 1/4" = 1'-0"

Timber
Home
Services LLC


Piney Hollow

DAN TRIMBLE
AA66 / TIMBER HOME SERVICES

CELL PHONE/TEXT - 412-309-1161

EMAIL:

DANTRIMBLE@TIMBERHOMESERVICES.COM

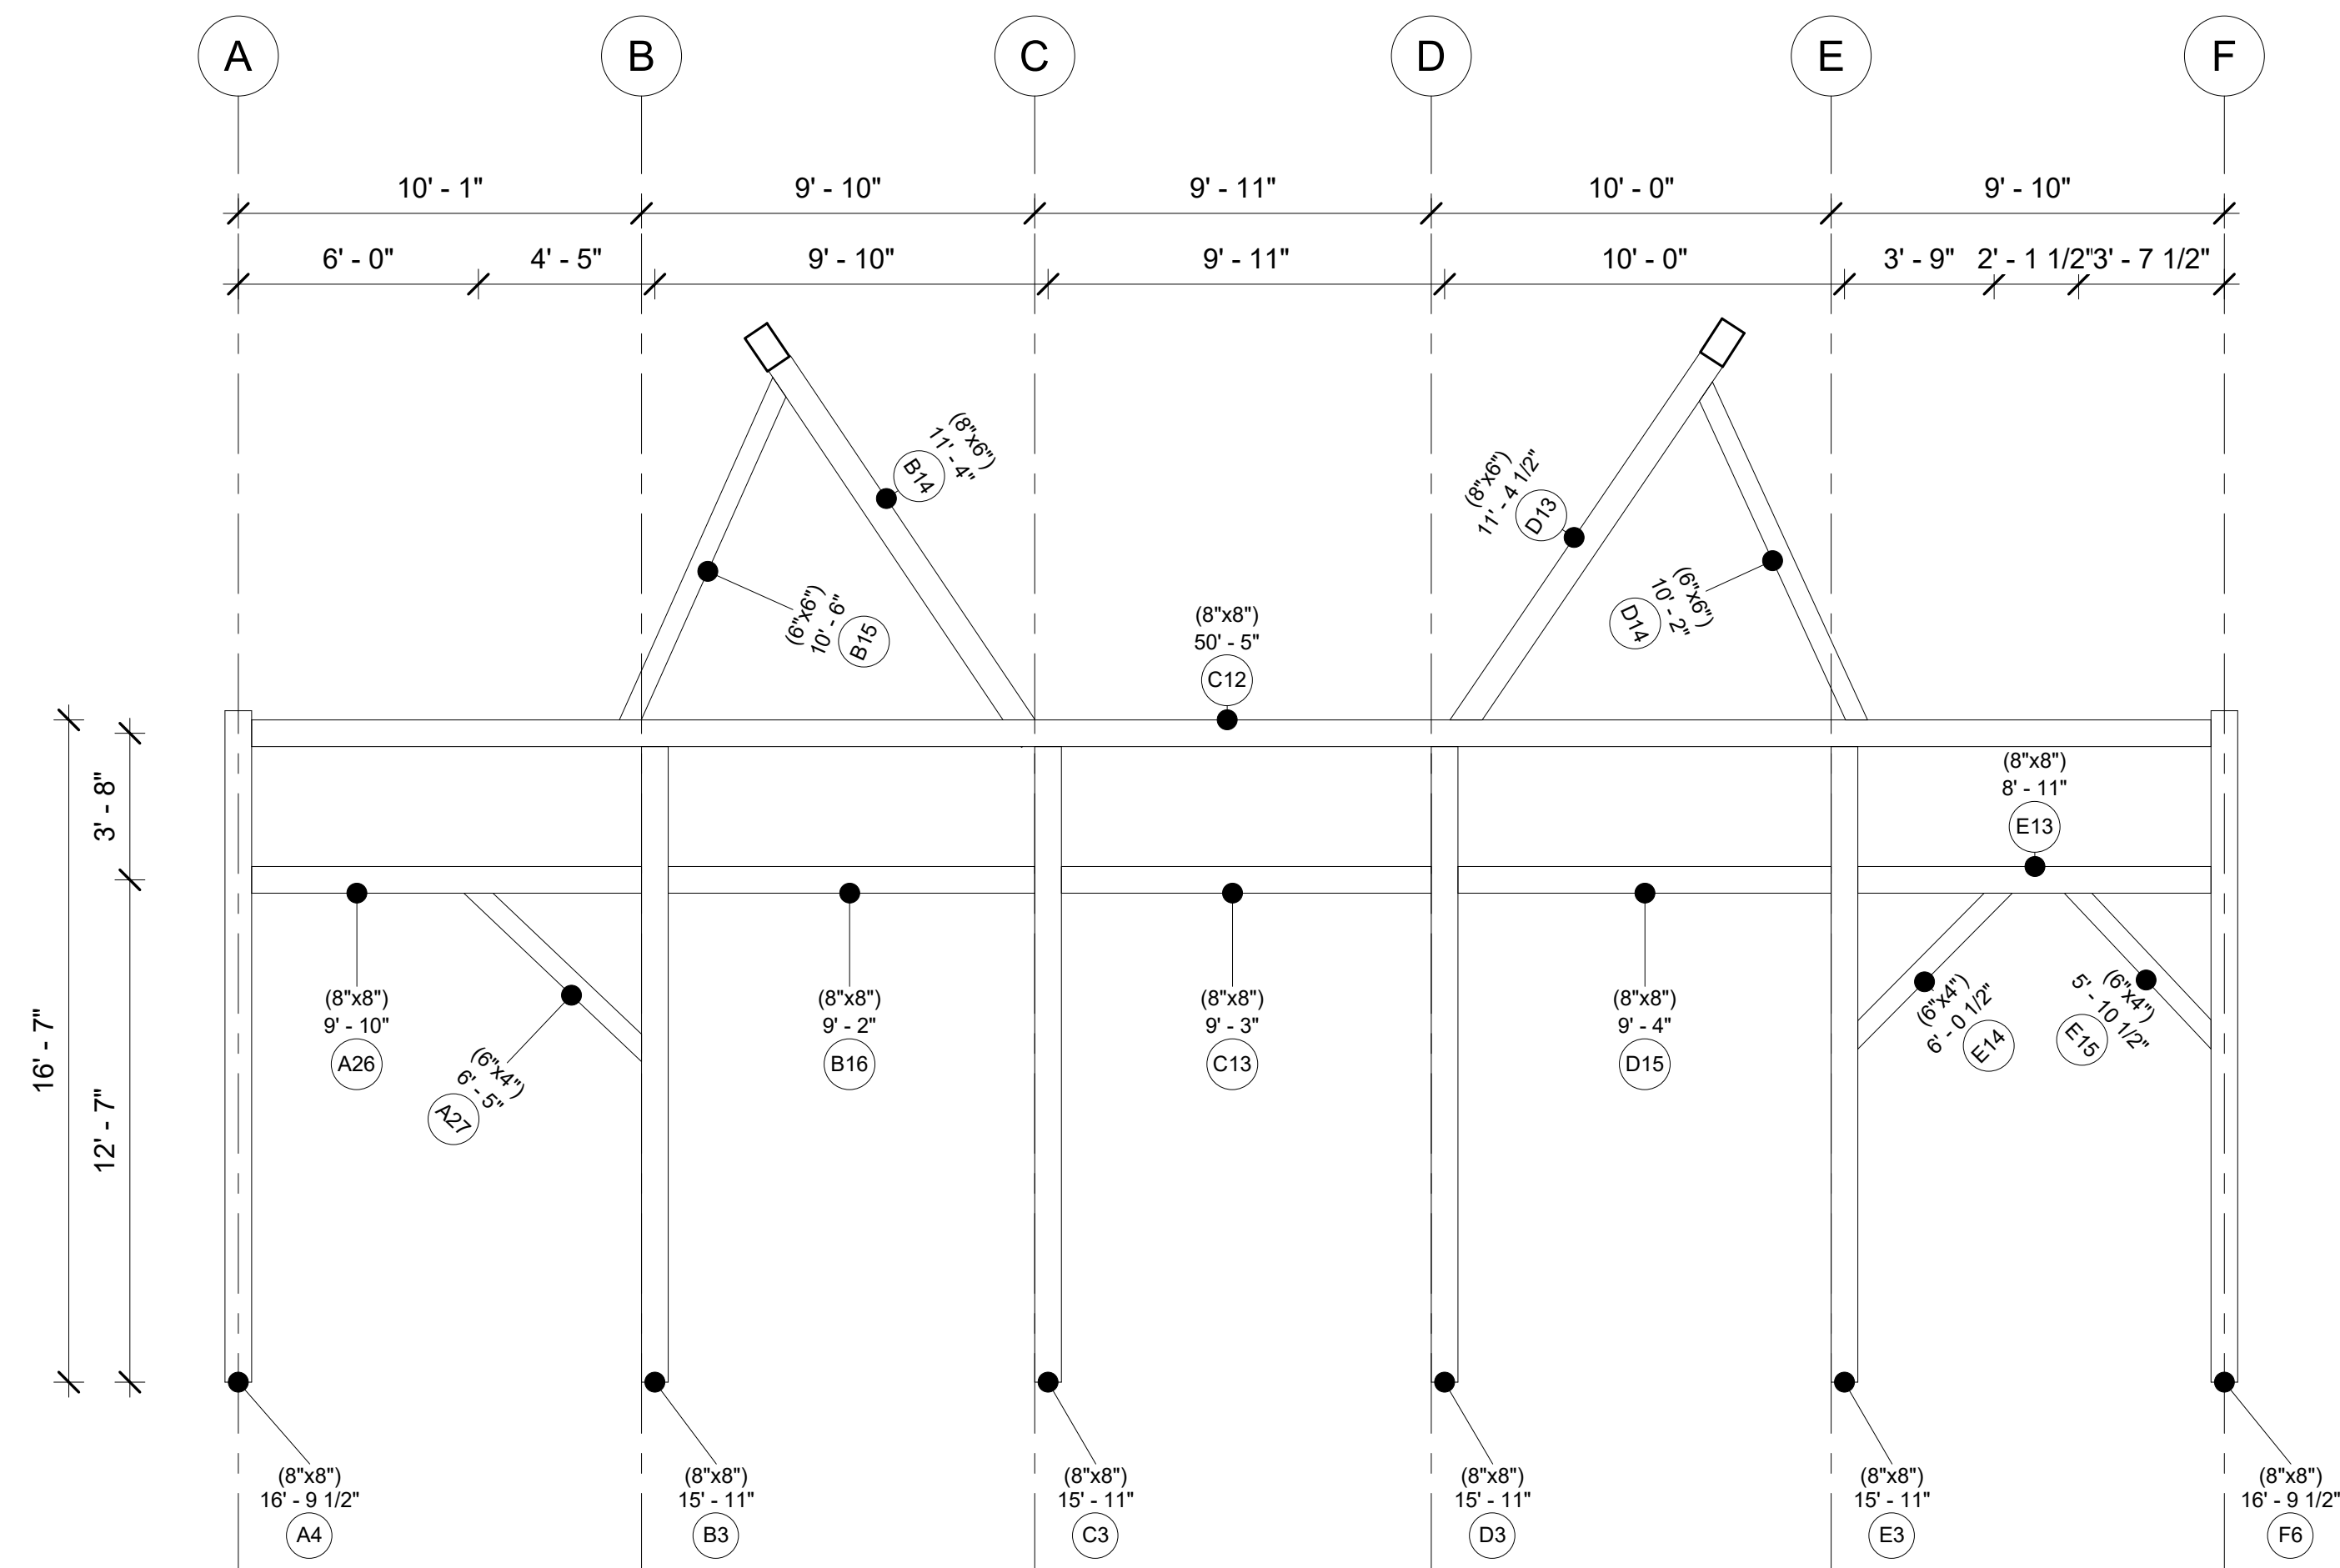

Bent 3

Project Number Project 16

Date	20250605
------	----------

Drawn By _____

Checked By _____

A107


Scale $1/4" = 1'-0"$

Timber
Home
Services LLC

Piney Hollow

DAN TRIMBLE
AA66 / TIMBER HOME SERVICES
CELL PHONE/TEXT - 412-309-1161

EMAIL:
DANTRIMBLE@TIMBERHOMESERVICES.COM

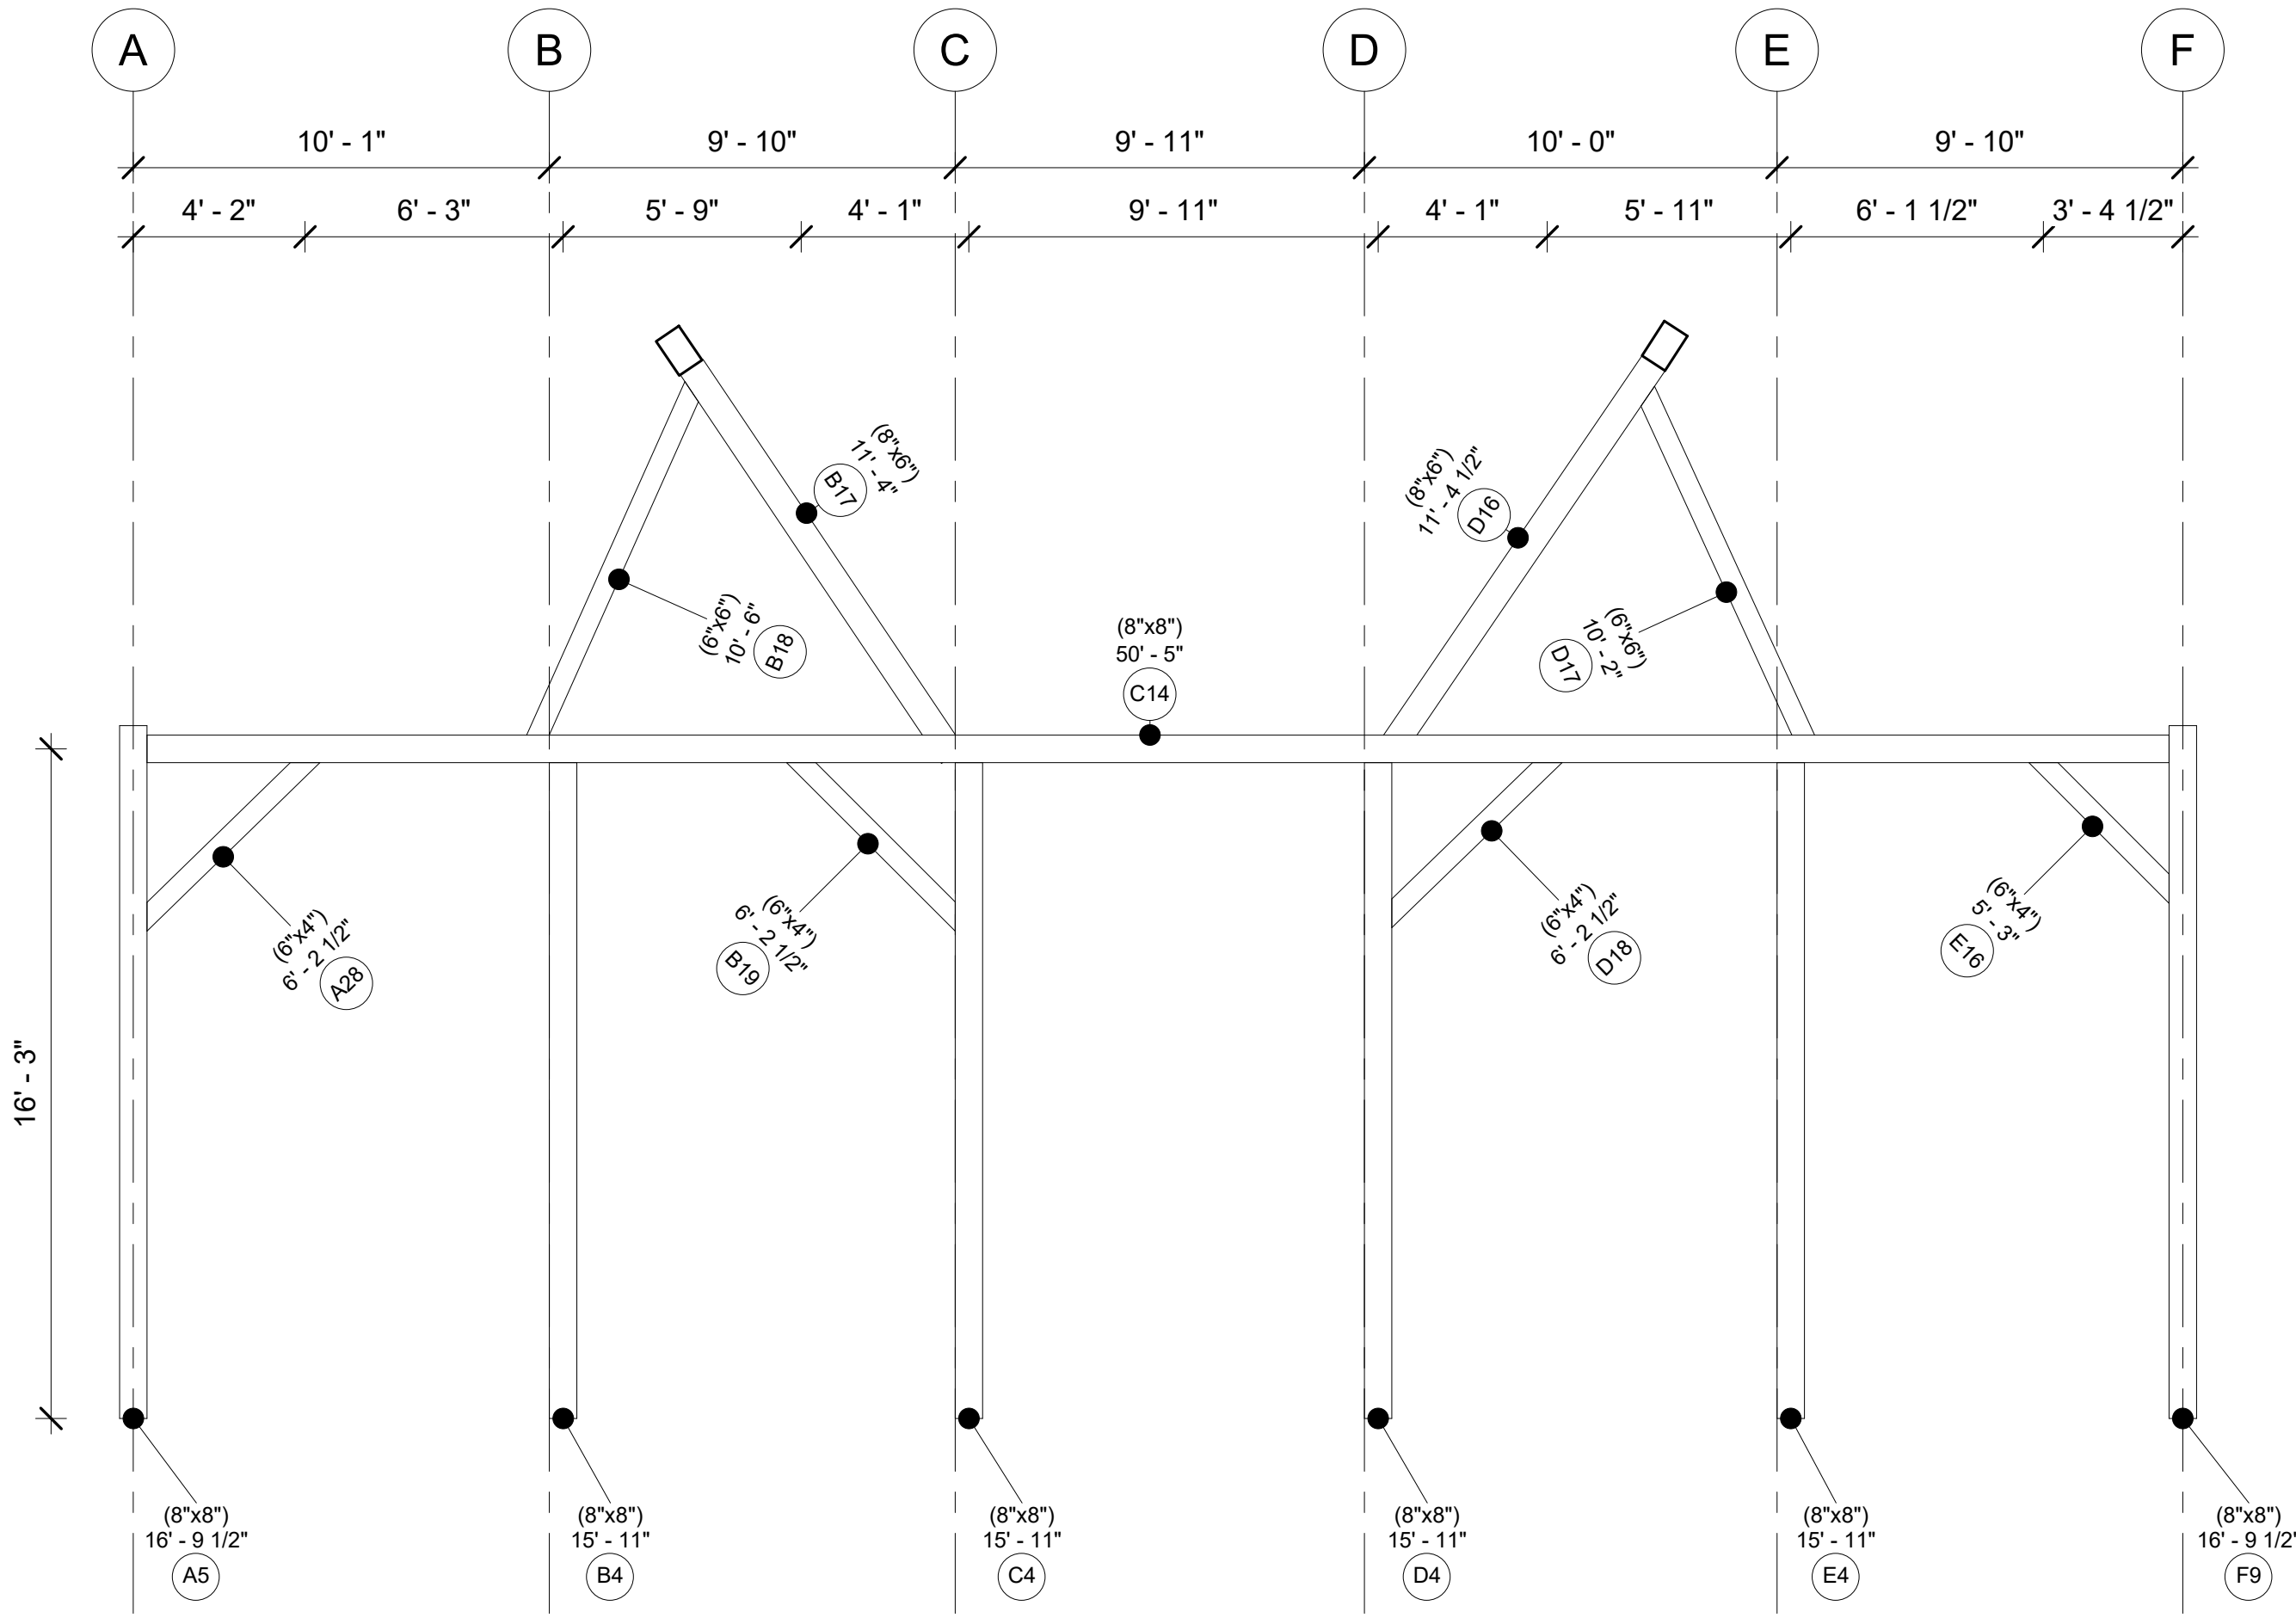

Bent 4


Project Number	Project 16
Date	20250605
Drawn By	
Checked By	
A108	
Scale	1/4" = 1'-0"

Timber
Home
Services LLC

Piney Hollow

DAN TRIMBLE
AA66 / TIMBER HOME SERVICES
CELL PHONE/TEXT - 412-309-1161

EMAIL:
DANTRIMBLE@TIMBERHOMESERVICES.COM

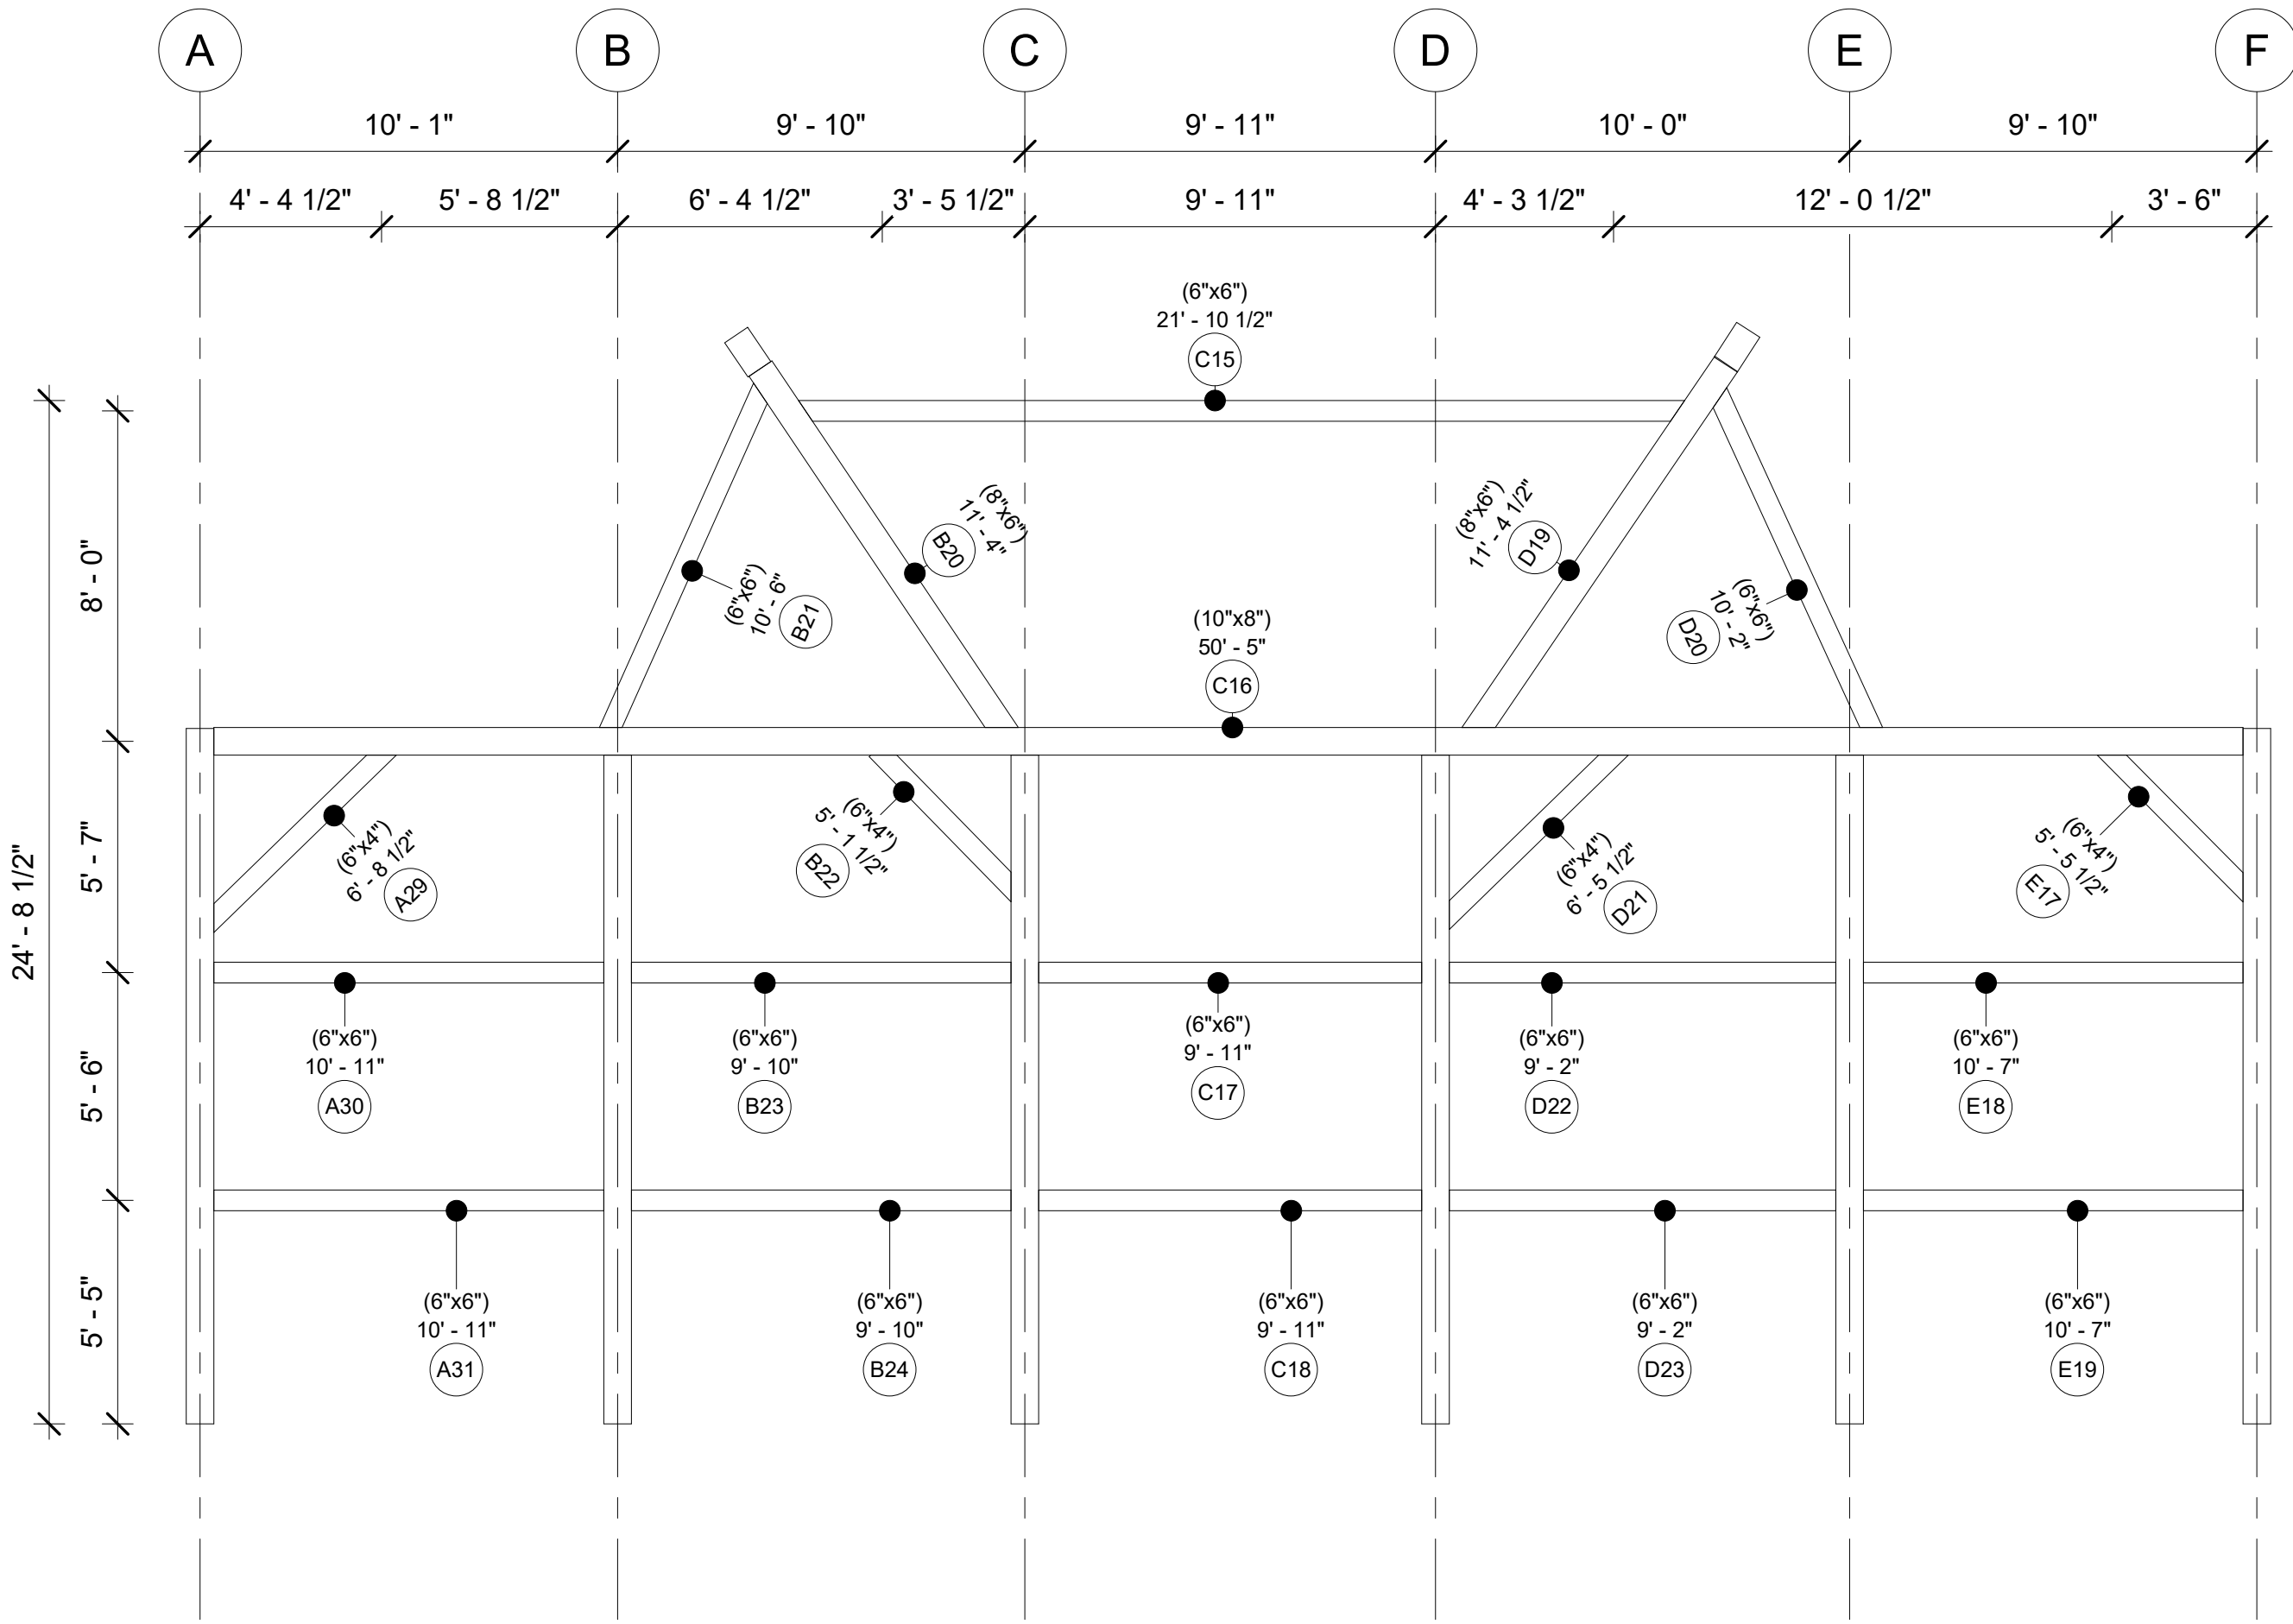

Bent 5

Project Number	Project 16
Date	20250605
Drawn By	
Checked By	
A109	
Scale	1/4" = 1'-0"