


PROJECT: Mossy Creek

SCOPE: AS BUILT DRAWINGS

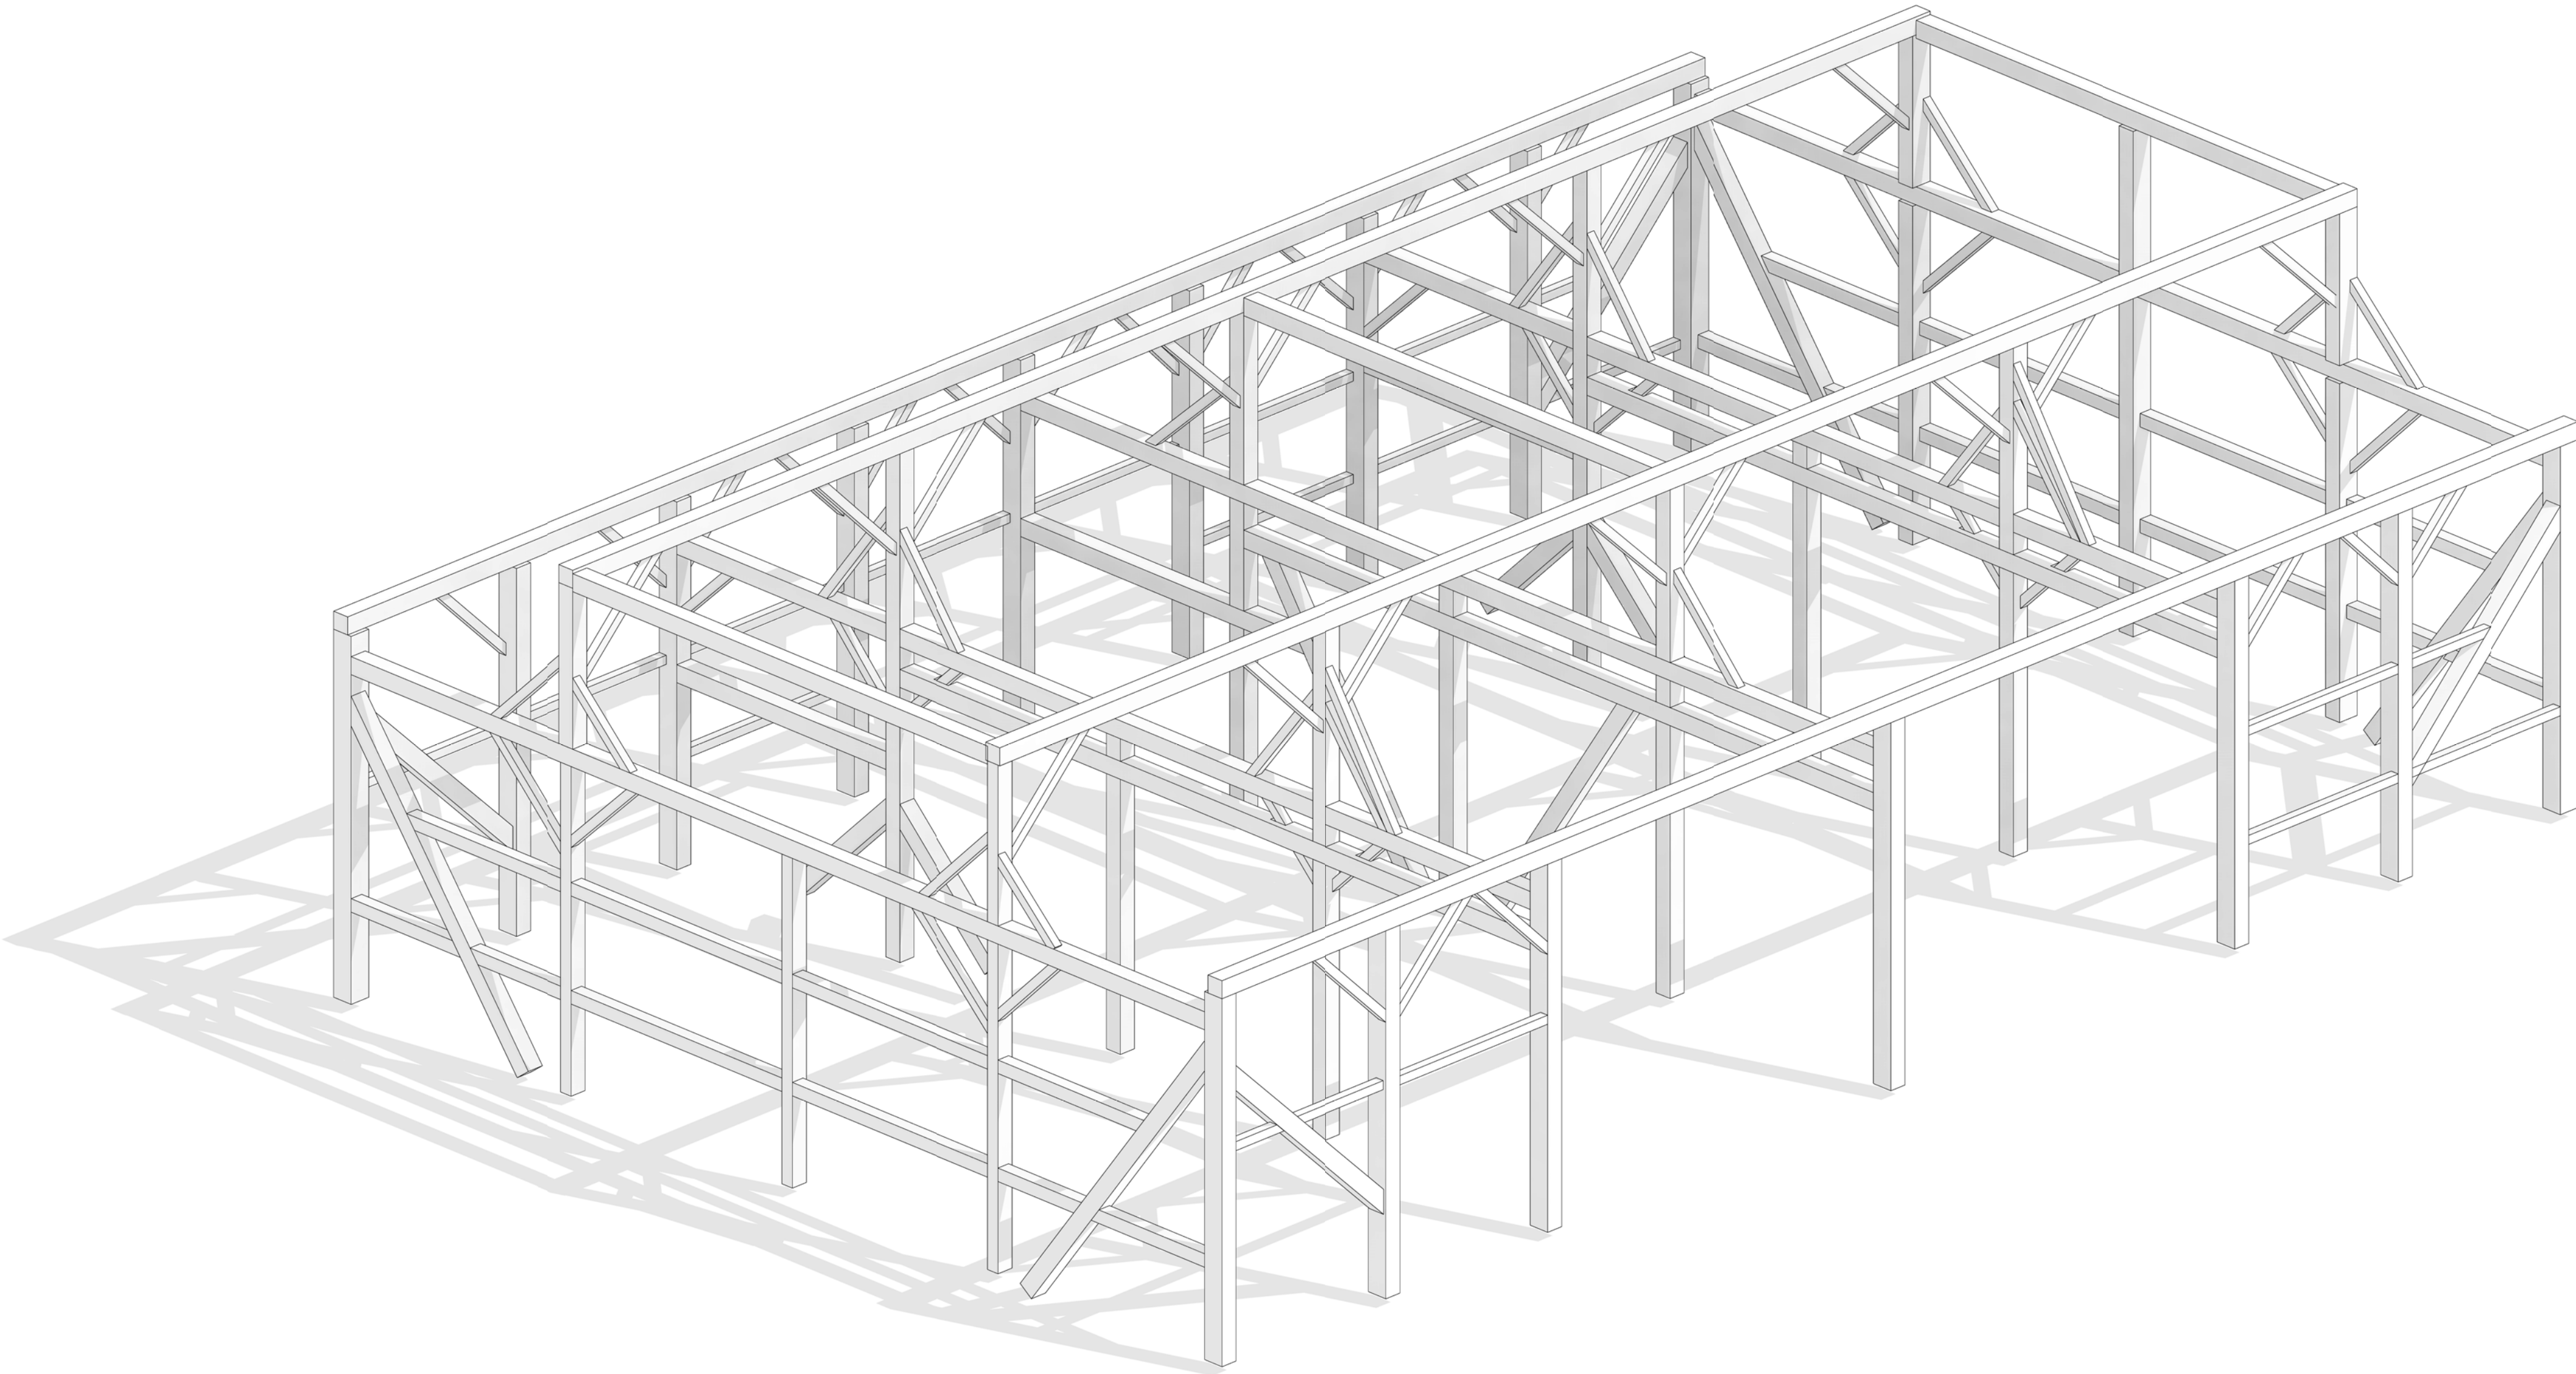

Timber
Home
Services LLC

Mossy Creek

DAN TRIMBLE
AA66 / TIMBER HOME SERVICES
CELL PHONE/TEXT - 412-309-1161

EMAIL:
DANTRIMBLE@TIMBERHOMESERVICES.COM

Cover Page

Project Number	Project 17
Date	20250618
Drawn By	
Checked By	

A101

Scale

Timber
Home
Services LLC


Mossy Creek

DAN TRIMBLE
AA66 / TIMBER HOME SERVICES
CELL PHONE/TEXT - 412-309-1161

EMAIL:
DANTRIMBLE@TIMBERHOMESERVICES.COM

Floor Plan

Project Number	Project 17
Date	20250618
Drawn By	
Checked By	
A102	
Scale	1/4" = 1'-0"

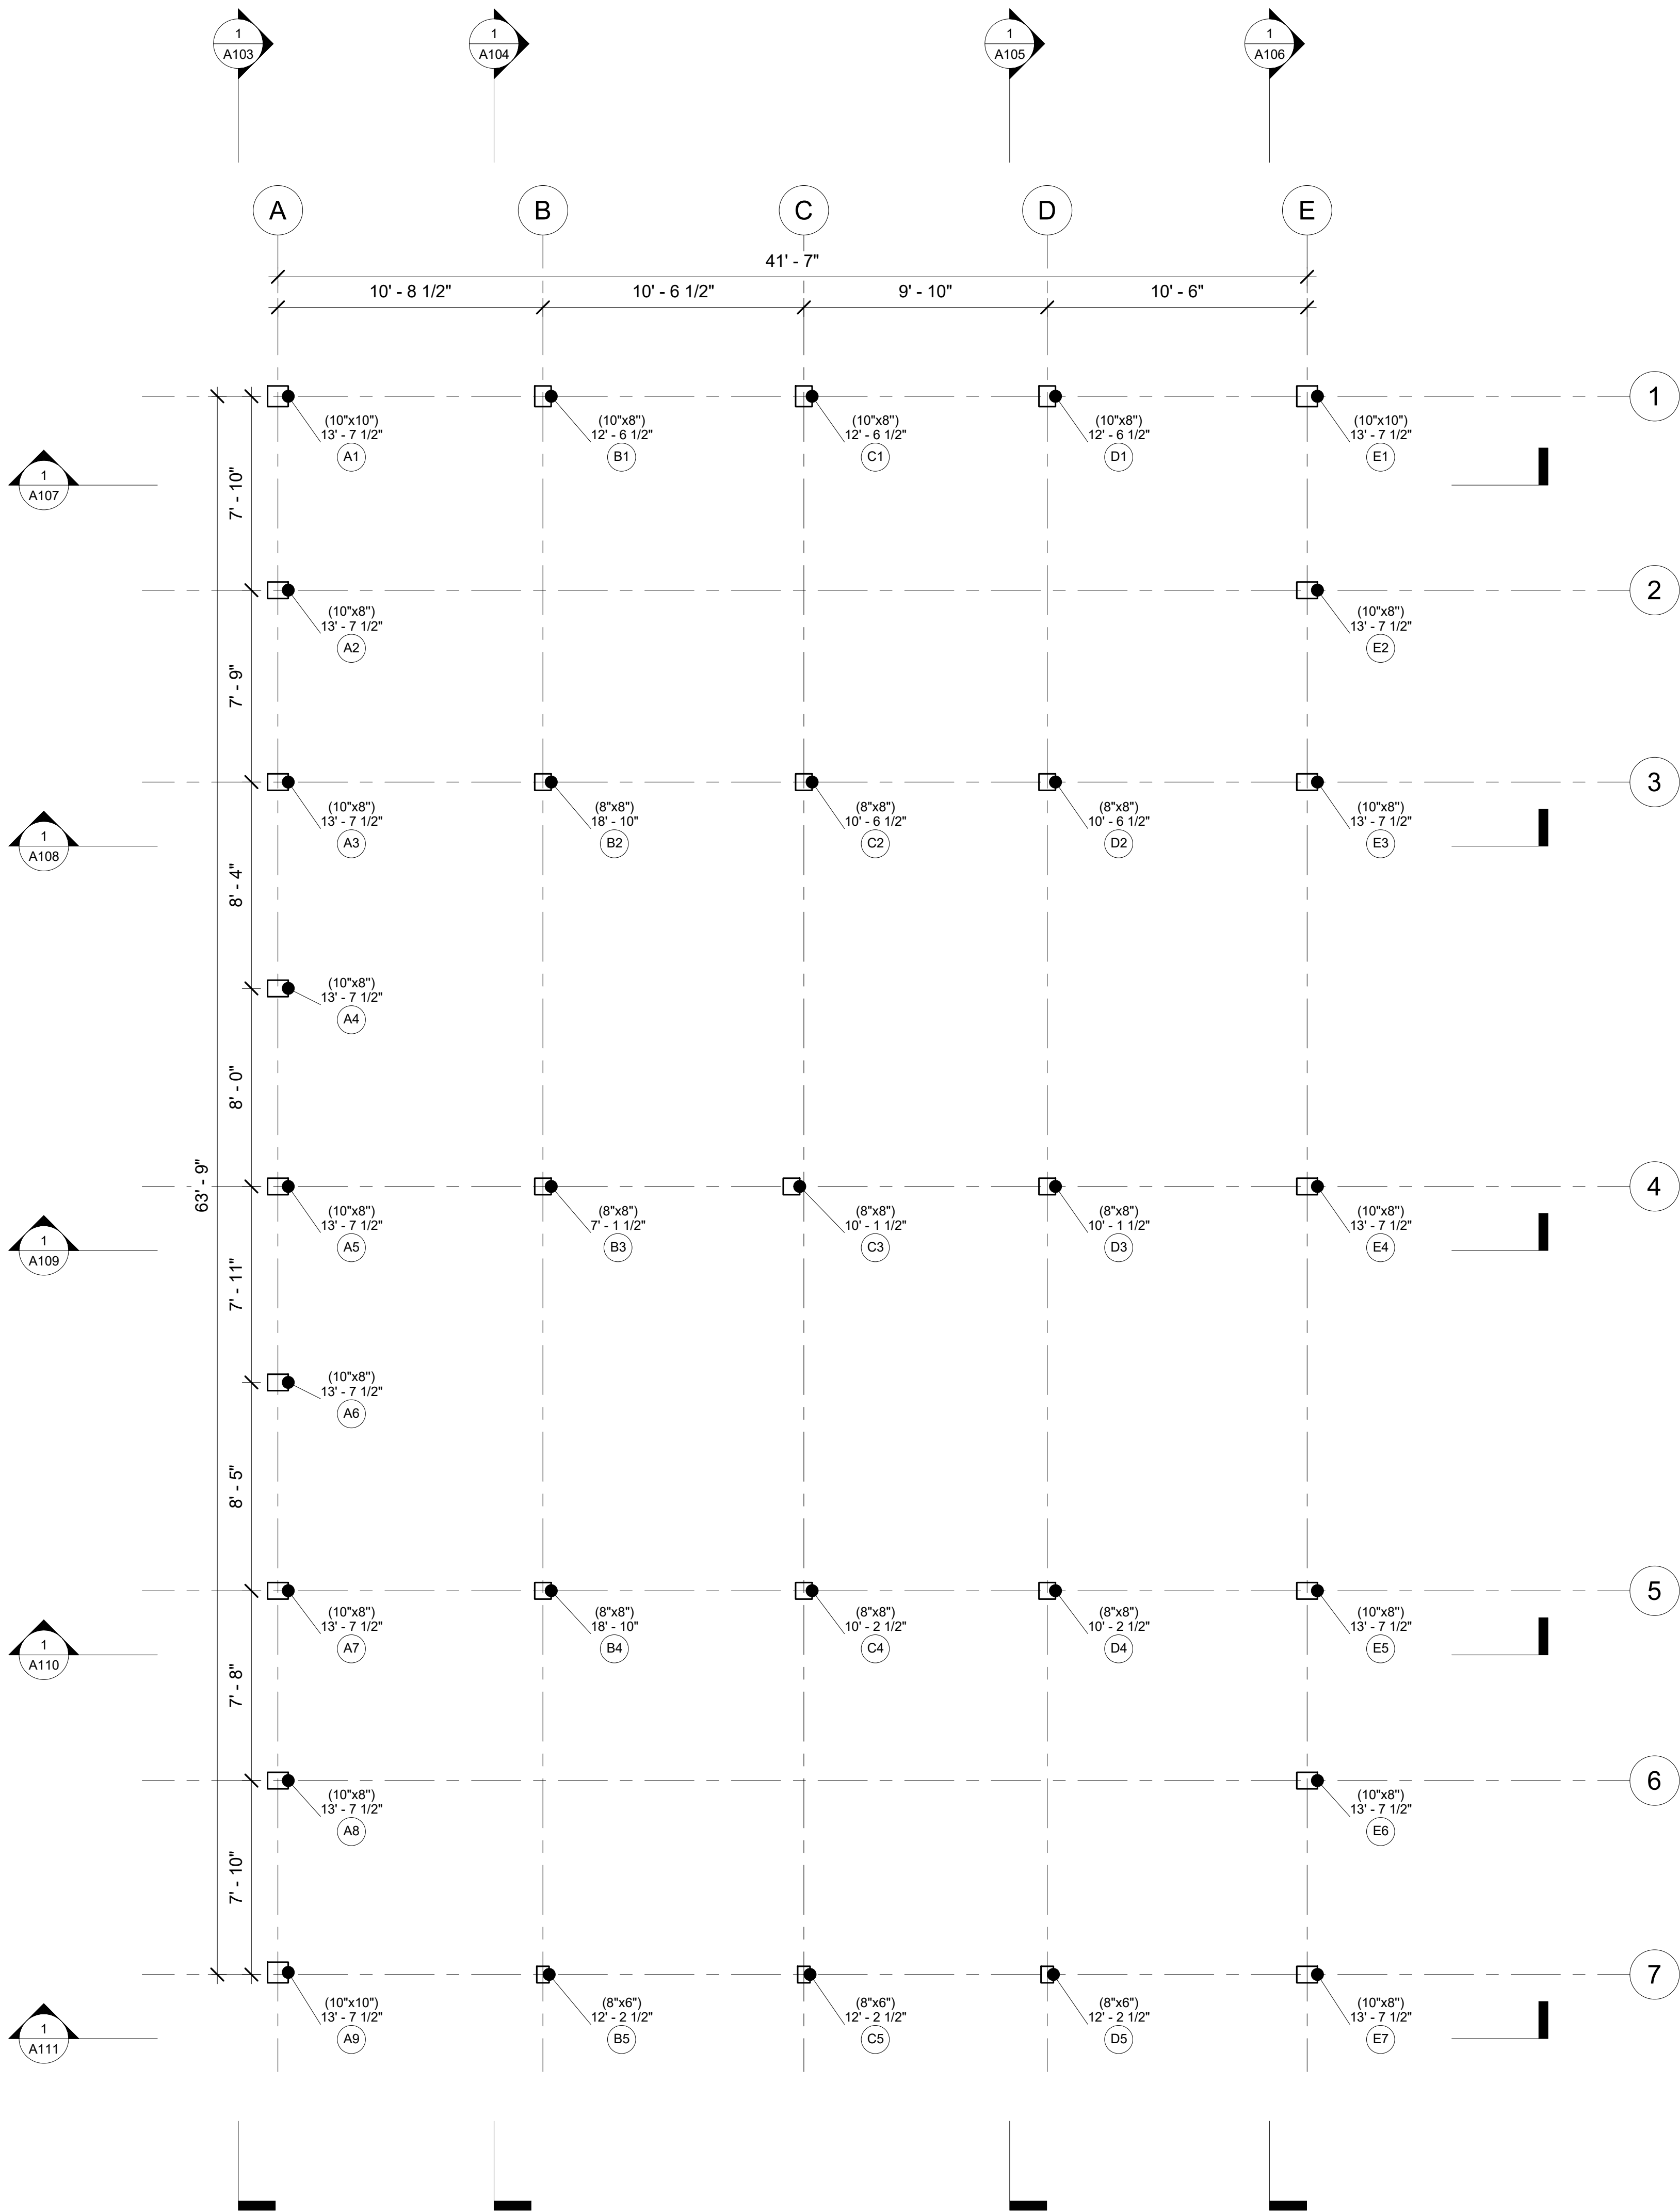

Timber Home Services LLC

Mossy Creek


Mossy Creek

DAN TRIMBLE
AA66 / TIMBER HOME SERVICES
CELL PHONE/TEXT - 412-309-1161

EMAIL:

DANTRIMBLE@TIMBERHOMESERVICES.COM

DANTRIMBLE@TIMBERHOMESERVICES.COM

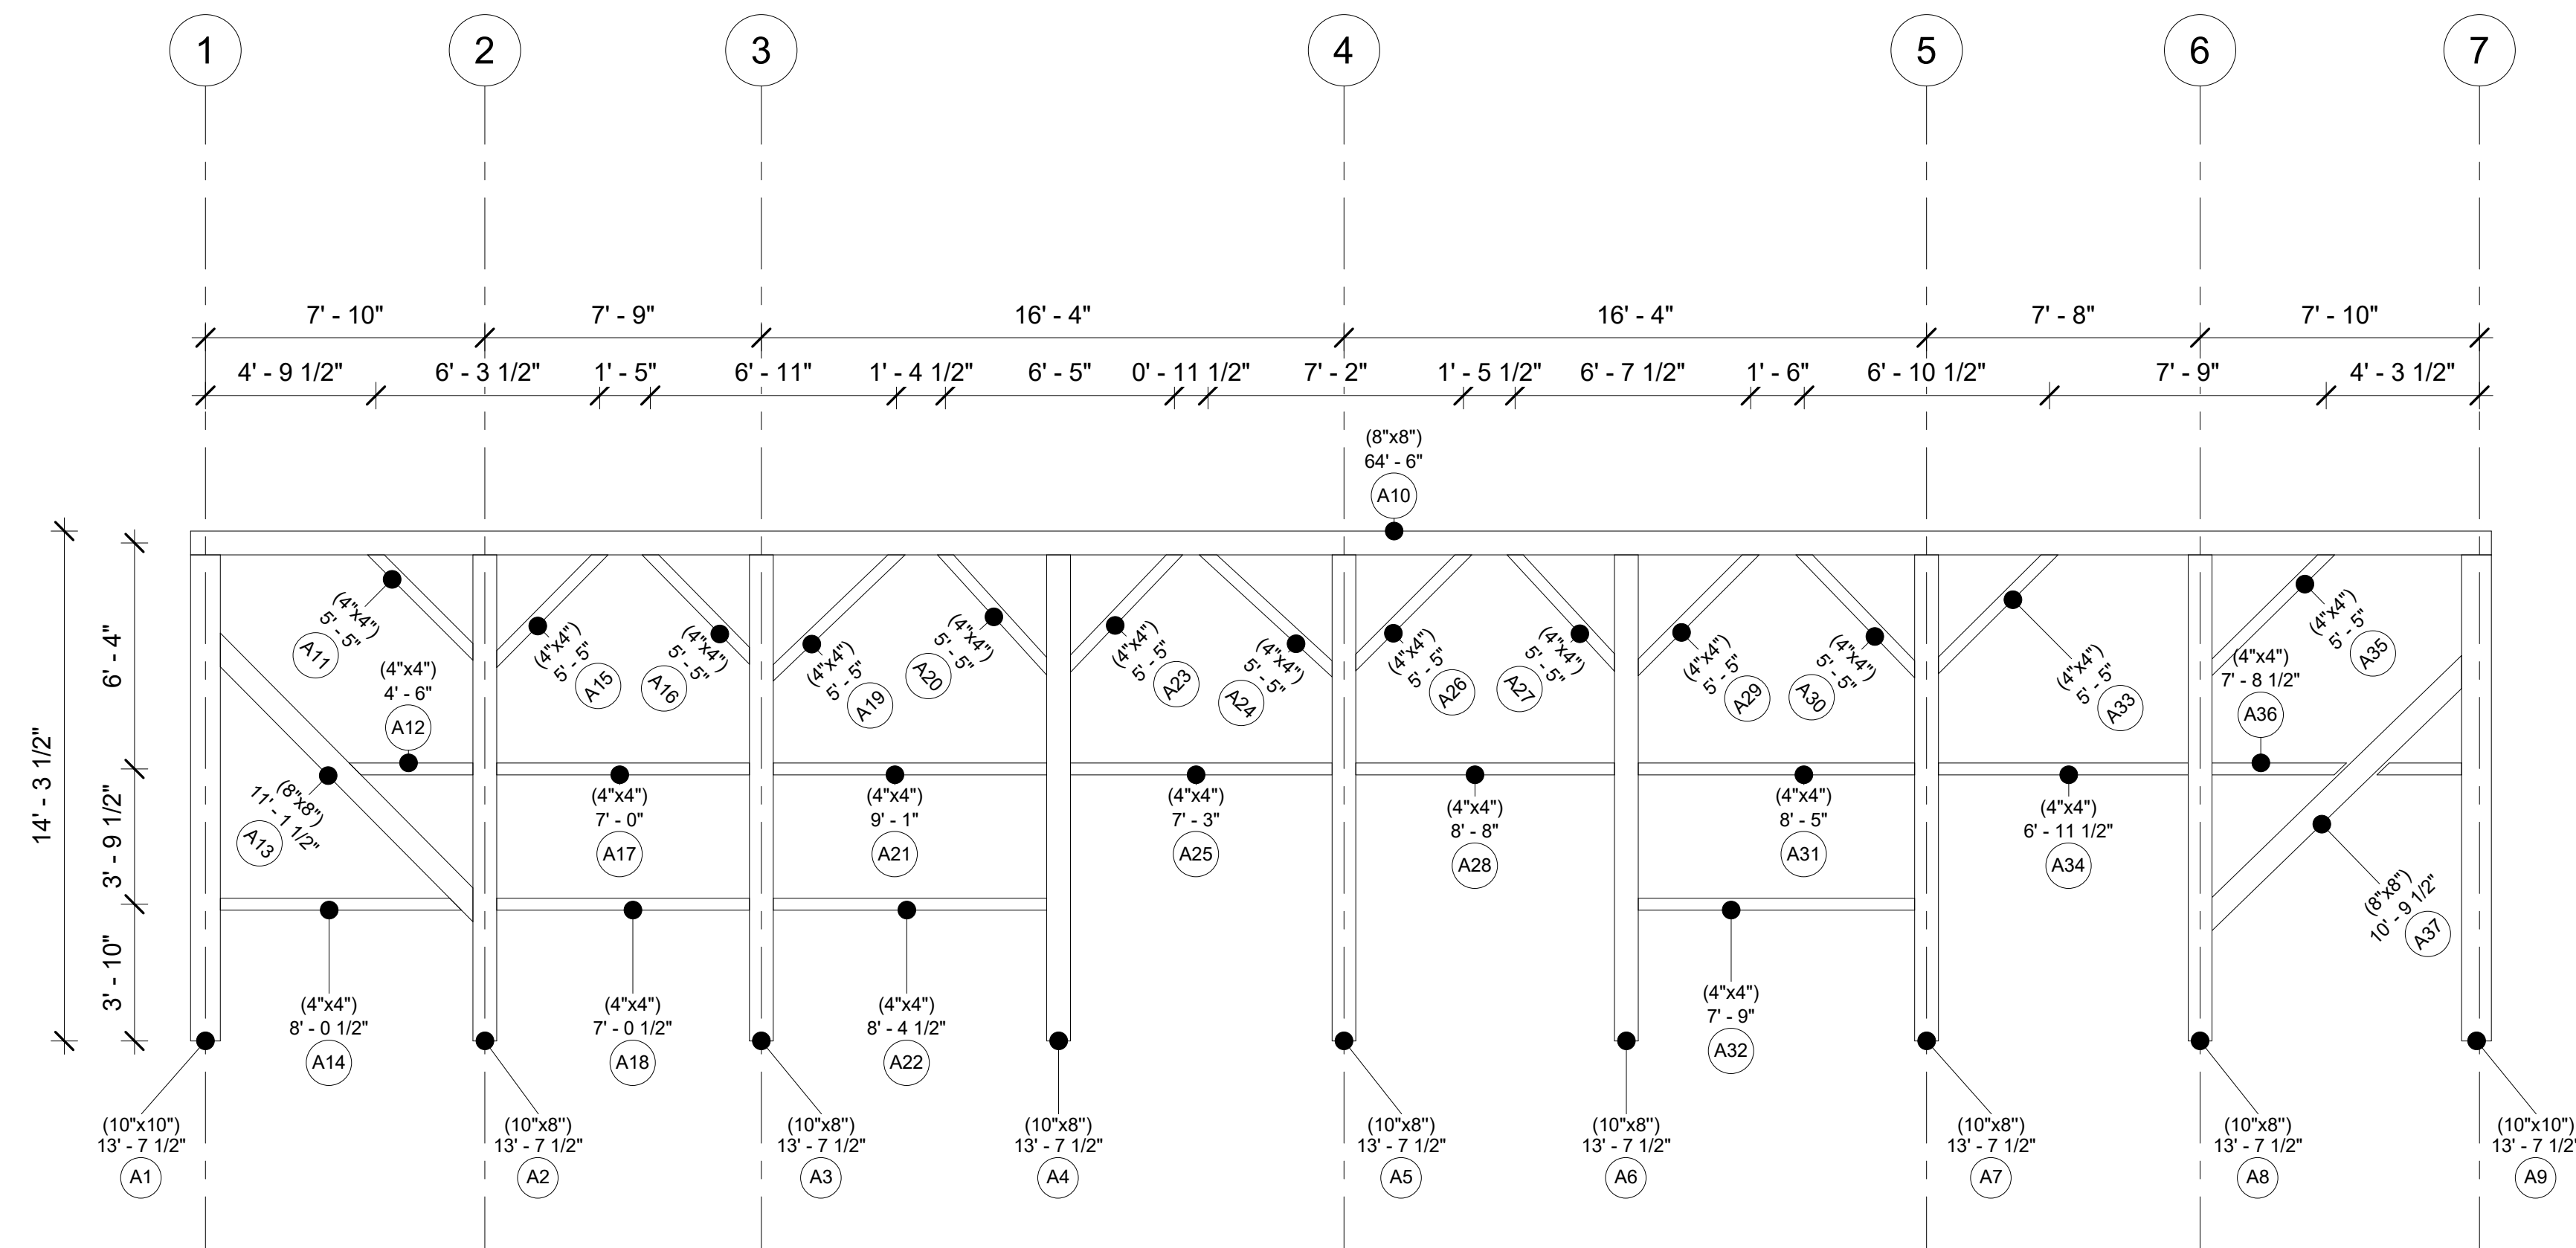

Bent A

Project Number	Project 17
----------------	------------

Date	20250618
------	----------

Drawn By _____

Checked By	
------------	--

A103


Scale	1/4" = 1'-0"
-------	--------------

Timber
Home
Services LLC

Mossy Creek

DAN TRIMBLE
AA66 / TIMBER HOME SERVICES
CELL PHONE/TEXT - 412-309-1161

EMAIL:
DANTRIMBLE@TIMBERHOMESERVICES.COM

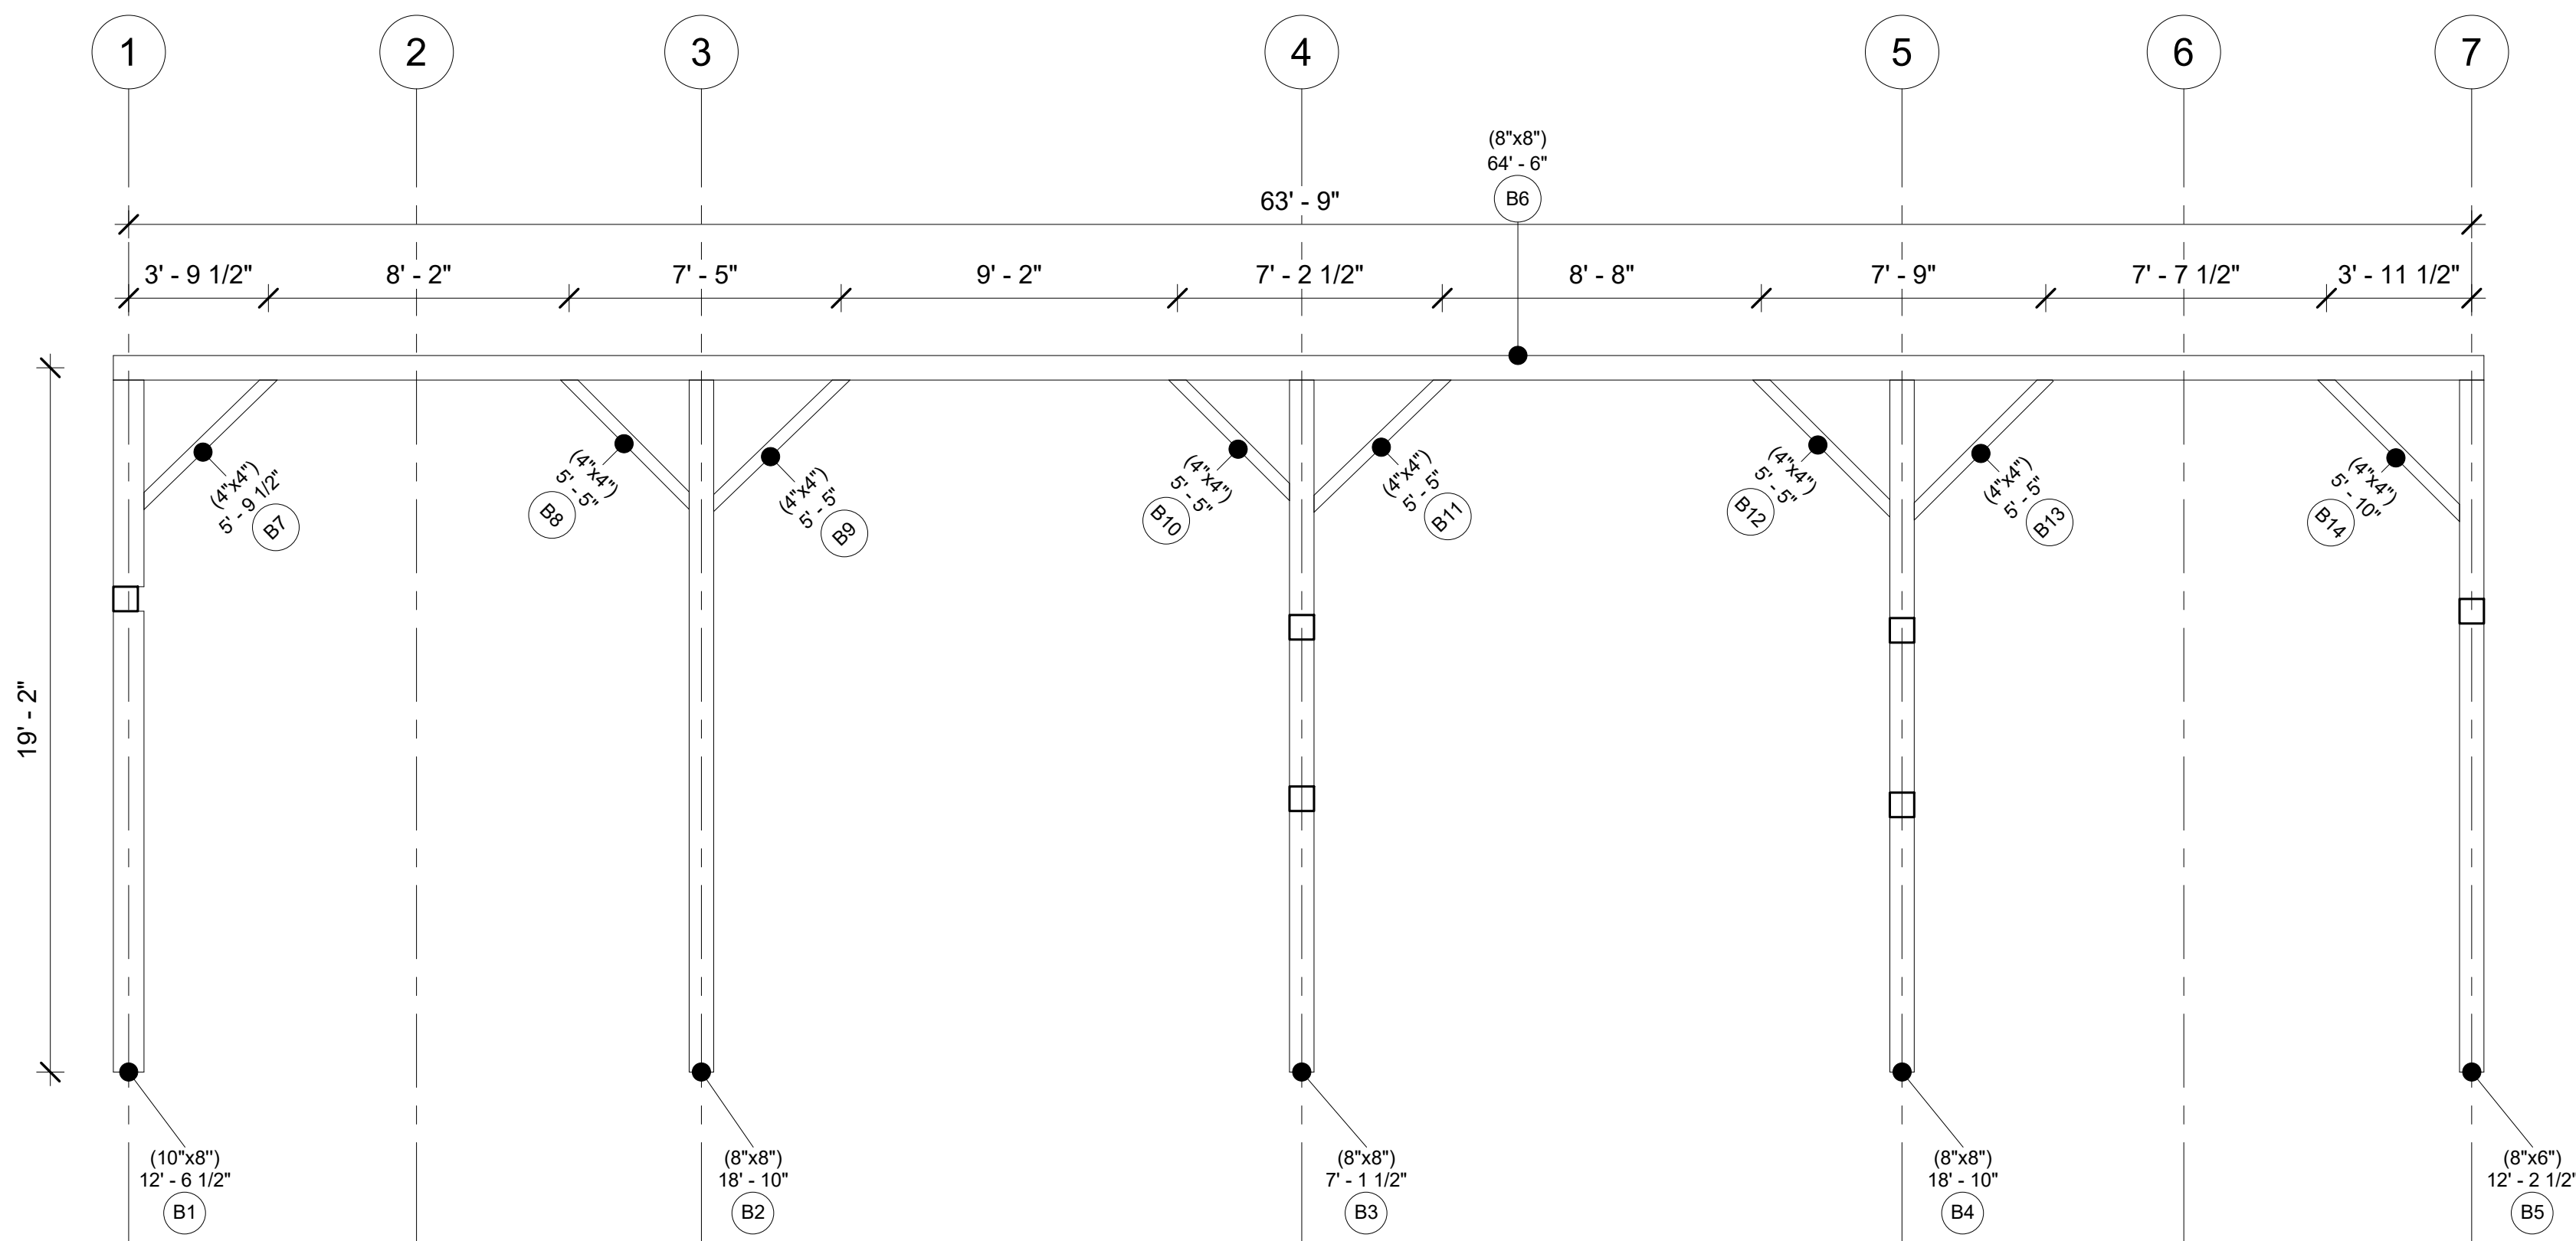

Bent B

Project Number	Project 17
Date	20250618
Drawn By	
Checked By	

A104


Scale	1/4" = 1'-0"
-------	--------------

Timber
Home
Services LLC

Mossy Creek

DAN TRIMBLE
AA66 / TIMBER HOME SERVICES
CELL PHONE/TEXT - 412-309-1161

EMAIL:
DANTRIMBLE@TIMBERHOMESERVICES.COM

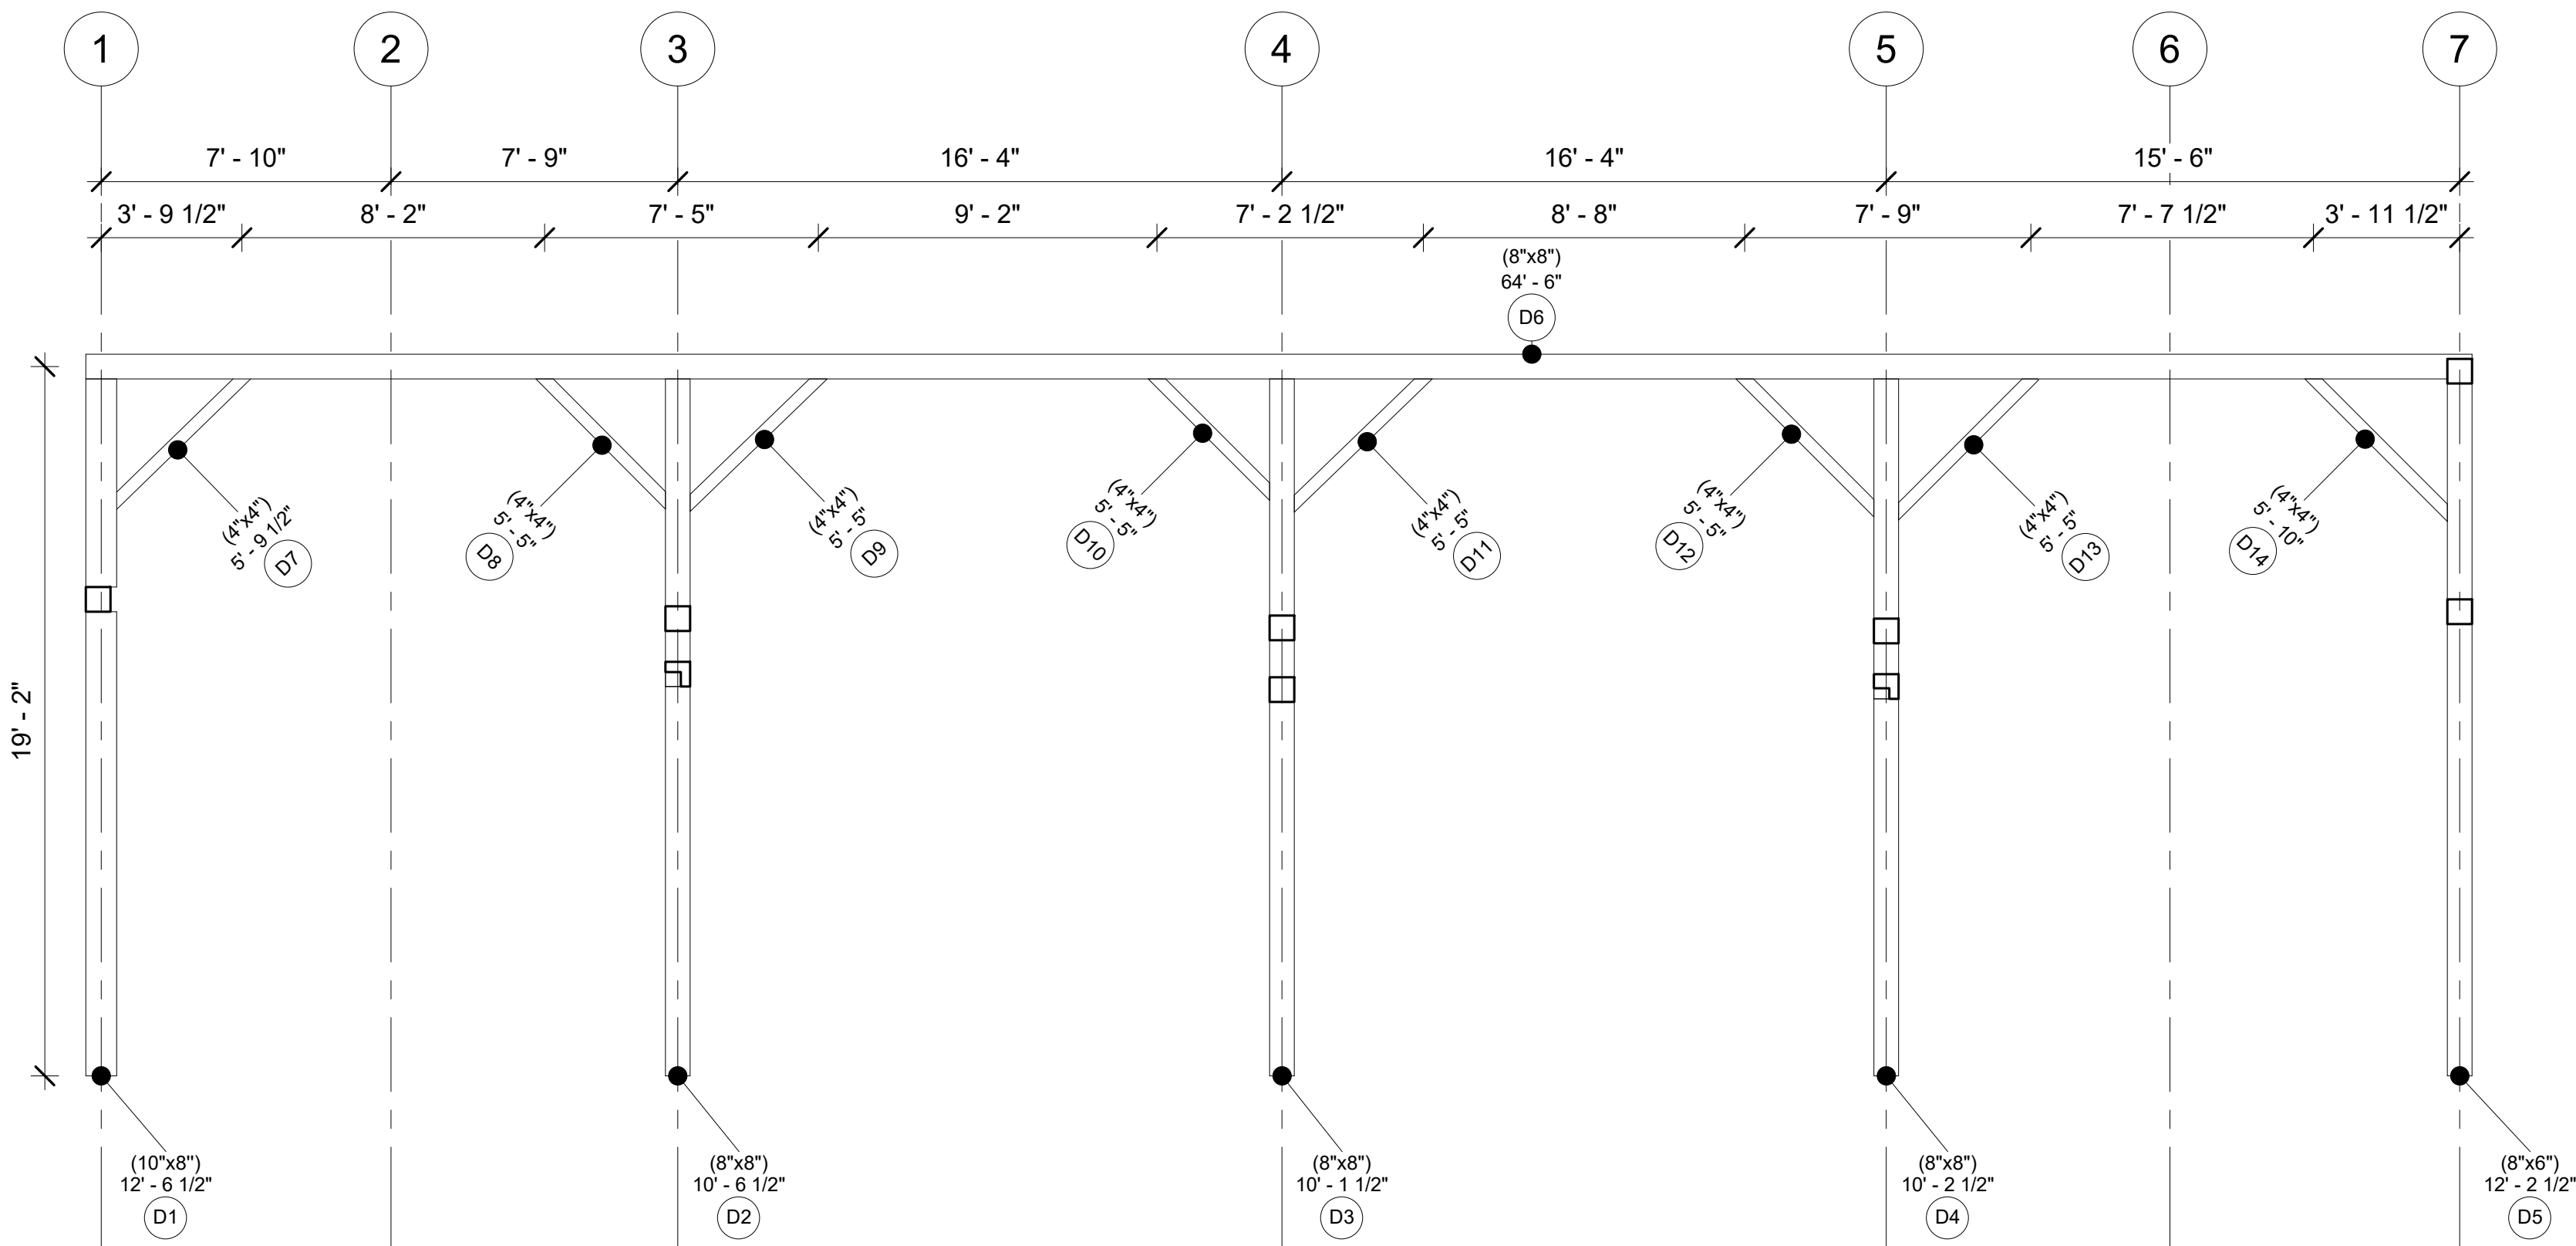

Bent D

Project Number	Project 17
Date	20250618
Drawn By	
Checked By	

A105


Scale	1/4" = 1'-0"
-------	--------------

Timber
Home
Services LLC

Mossy Creek

DAN TRIMBLE
AA66 / TIMBER HOME SERVICES
CELL PHONE/TEXT - 412-309-1161

EMAIL:
DANTRIMBLE@TIMBERHOMESERVICES.COM

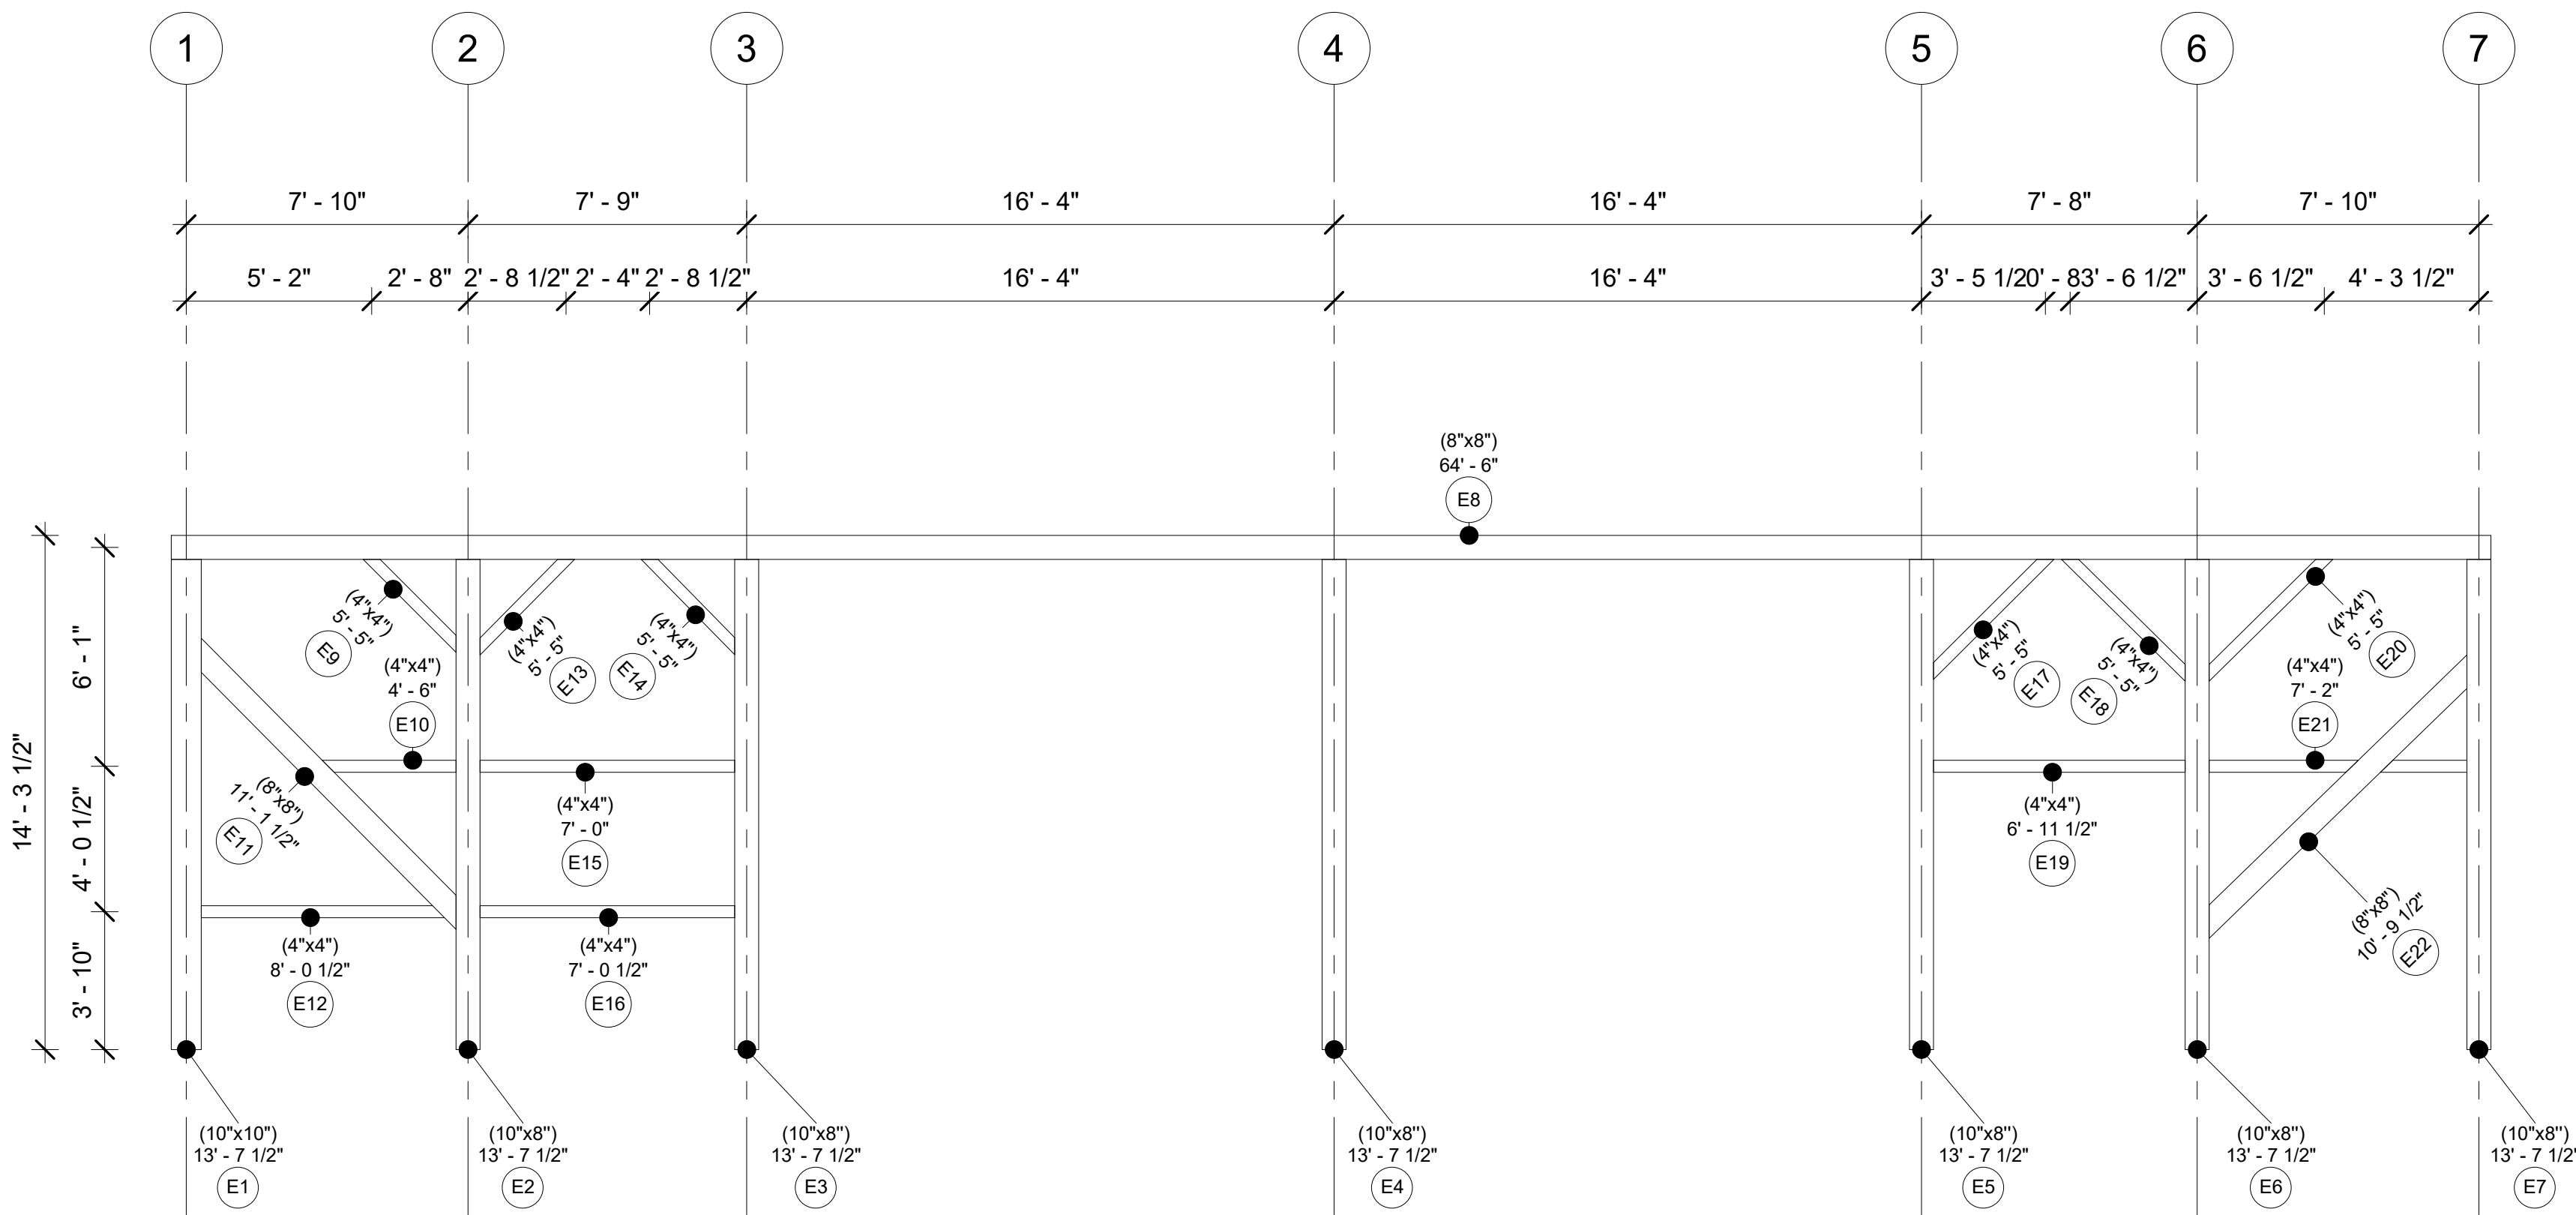

Bent E

Project Number	Project 17
Date	20250618
Drawn By	
Checked By	
A106	
Scale	1/4" = 1'-0"

Timber Home Services LLC

Mossy Creek


Mossy Creek

DAN TRIMBLE
AA66 / TIMBER HOME SERVICES
CELL PHONE/TEXT - 412-309-1161

EMAIL:

DANTRIMBLE@TIMBERHOMESERVICES.COM

DANTRIMBLE@TIMBERHOMESERVICES.COM

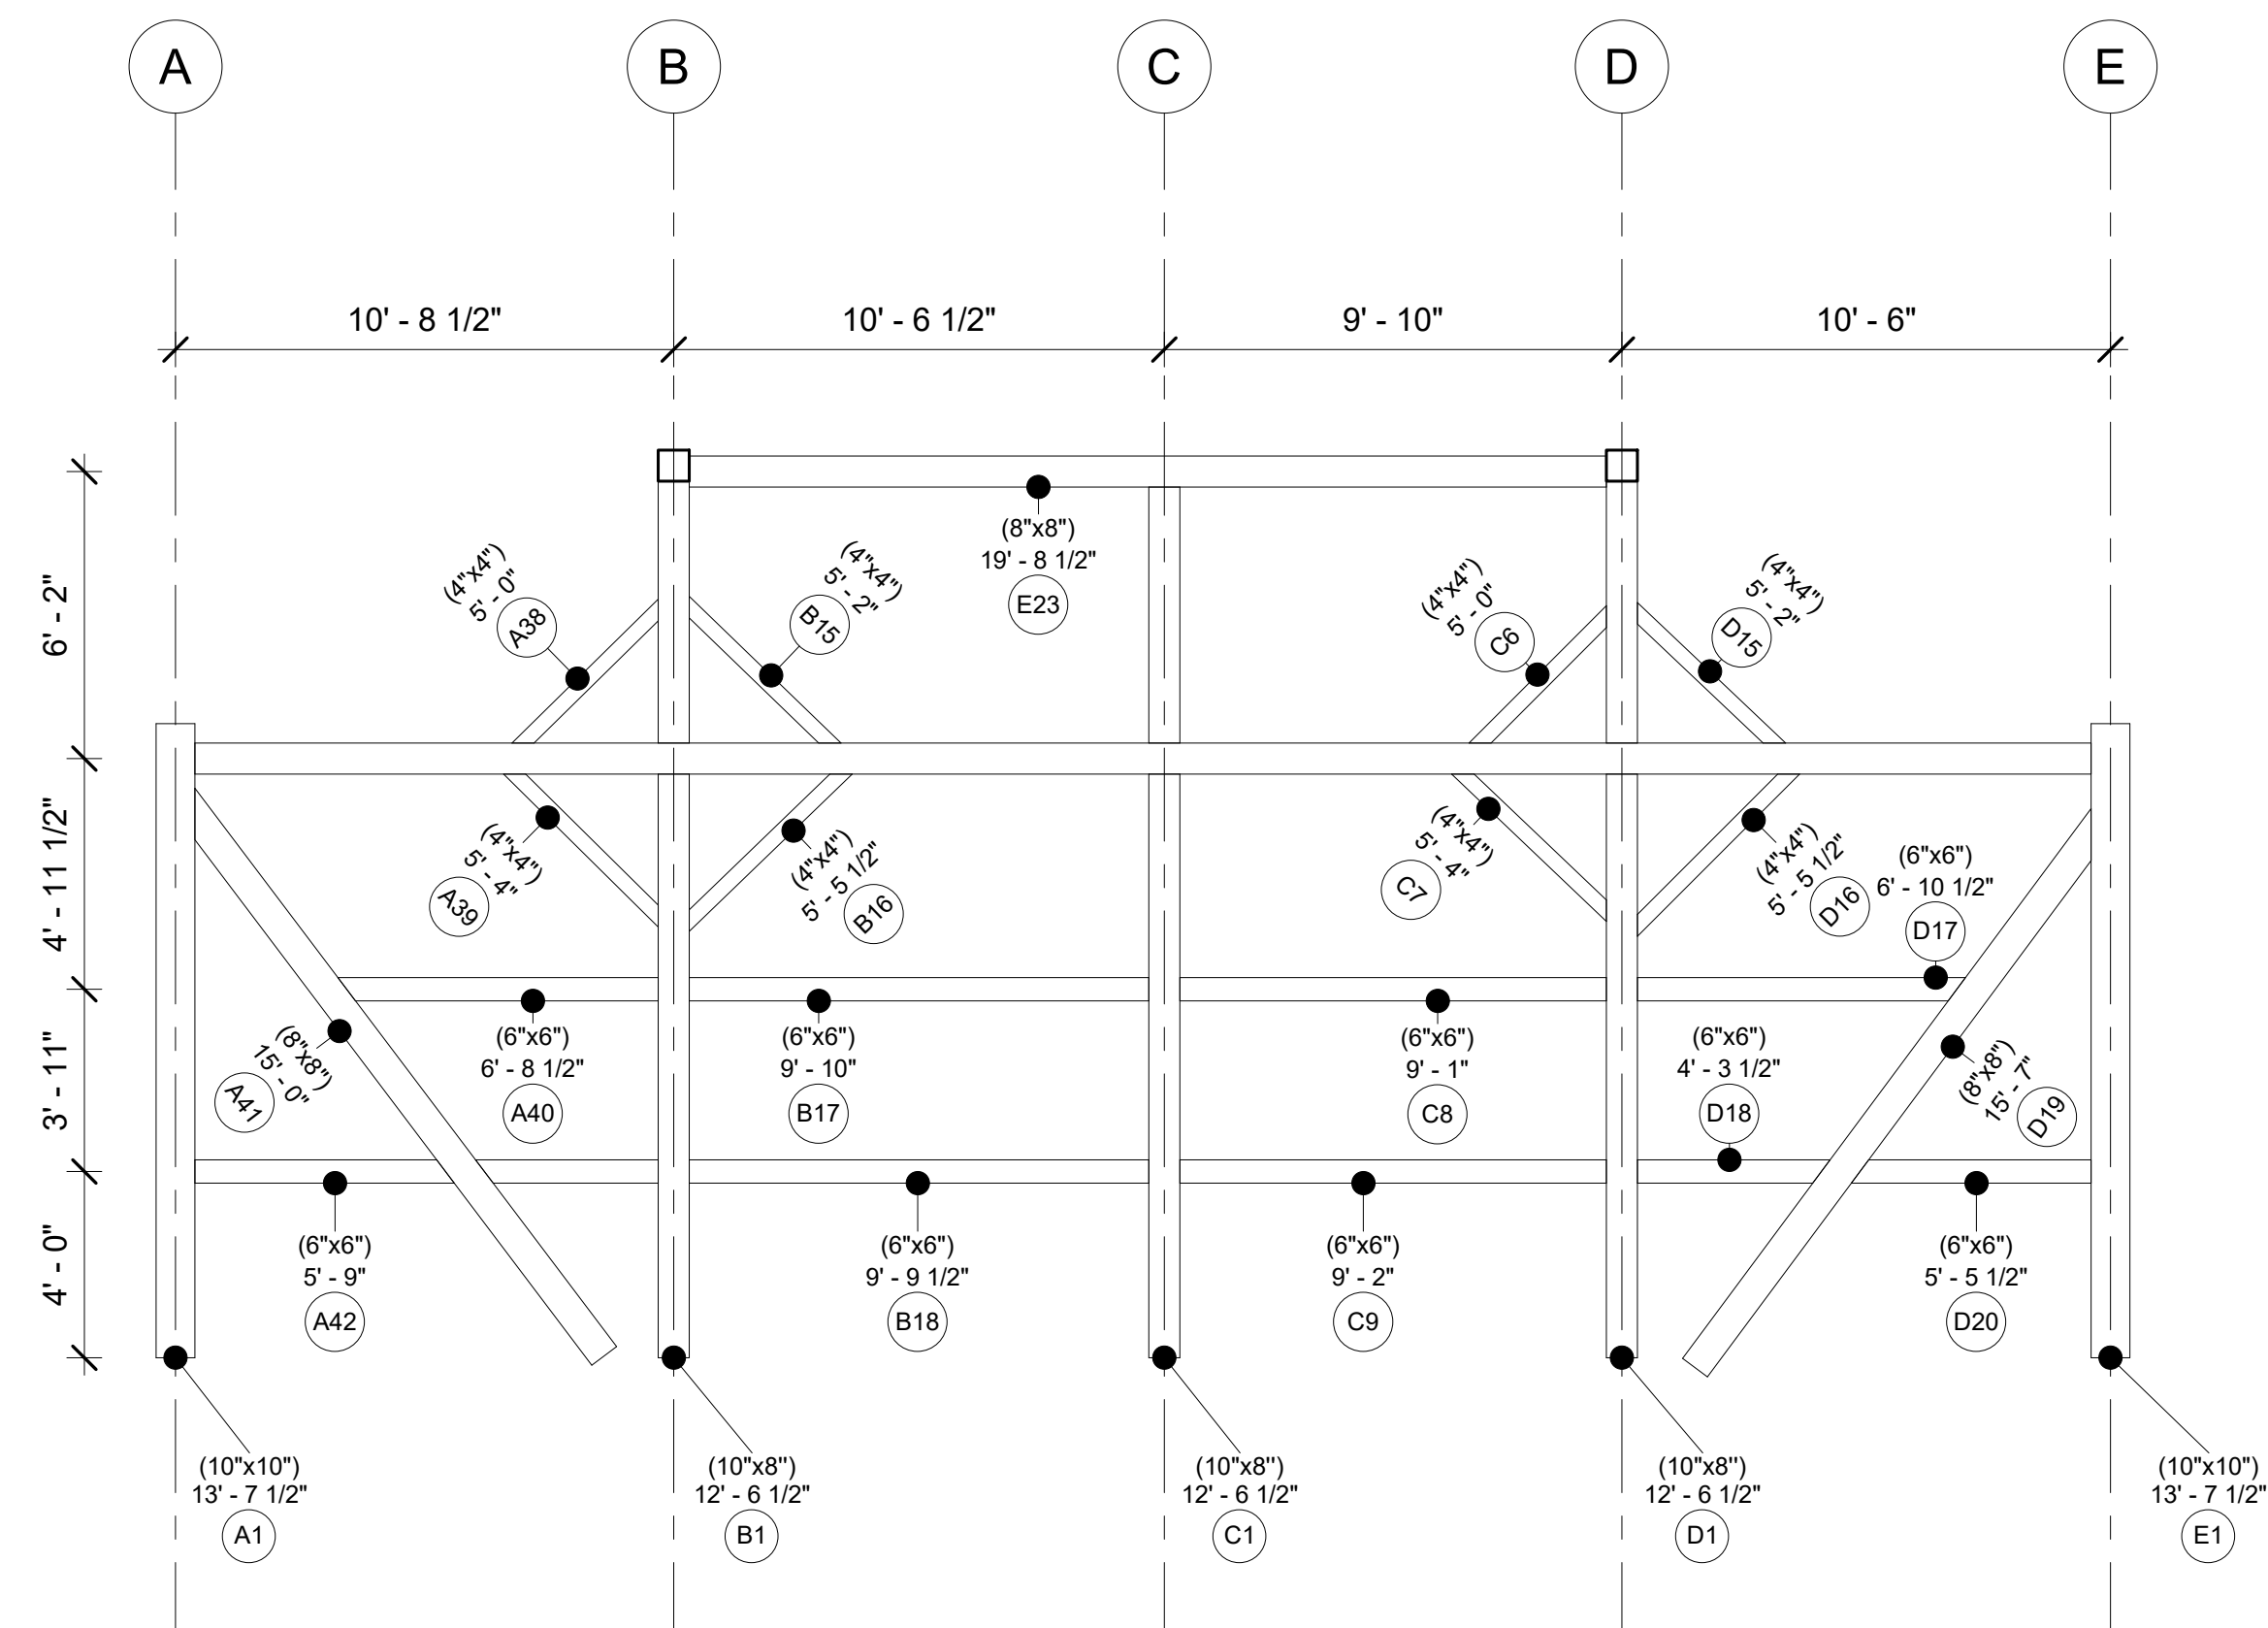

Bent 1

Project Number	Project 17
----------------	------------

Date	20250618
------	----------

Drawn By	
----------	--

Checked By	
------------	--

A107

Scale	1/4" = 1'-0"
-------	--------------

Timber Home Services LLC


Mossy Creek

DAN TRIMBLE
AA66 / TIMBER HOME SERVICES
CELL PHONE/TEXT - *412-309-1161*

EMAIL:

DANTRIMBLE@TIMBERHOMESERVICES.COM

DANTRIMBLE@TIMBERHOMESERVICES.COM

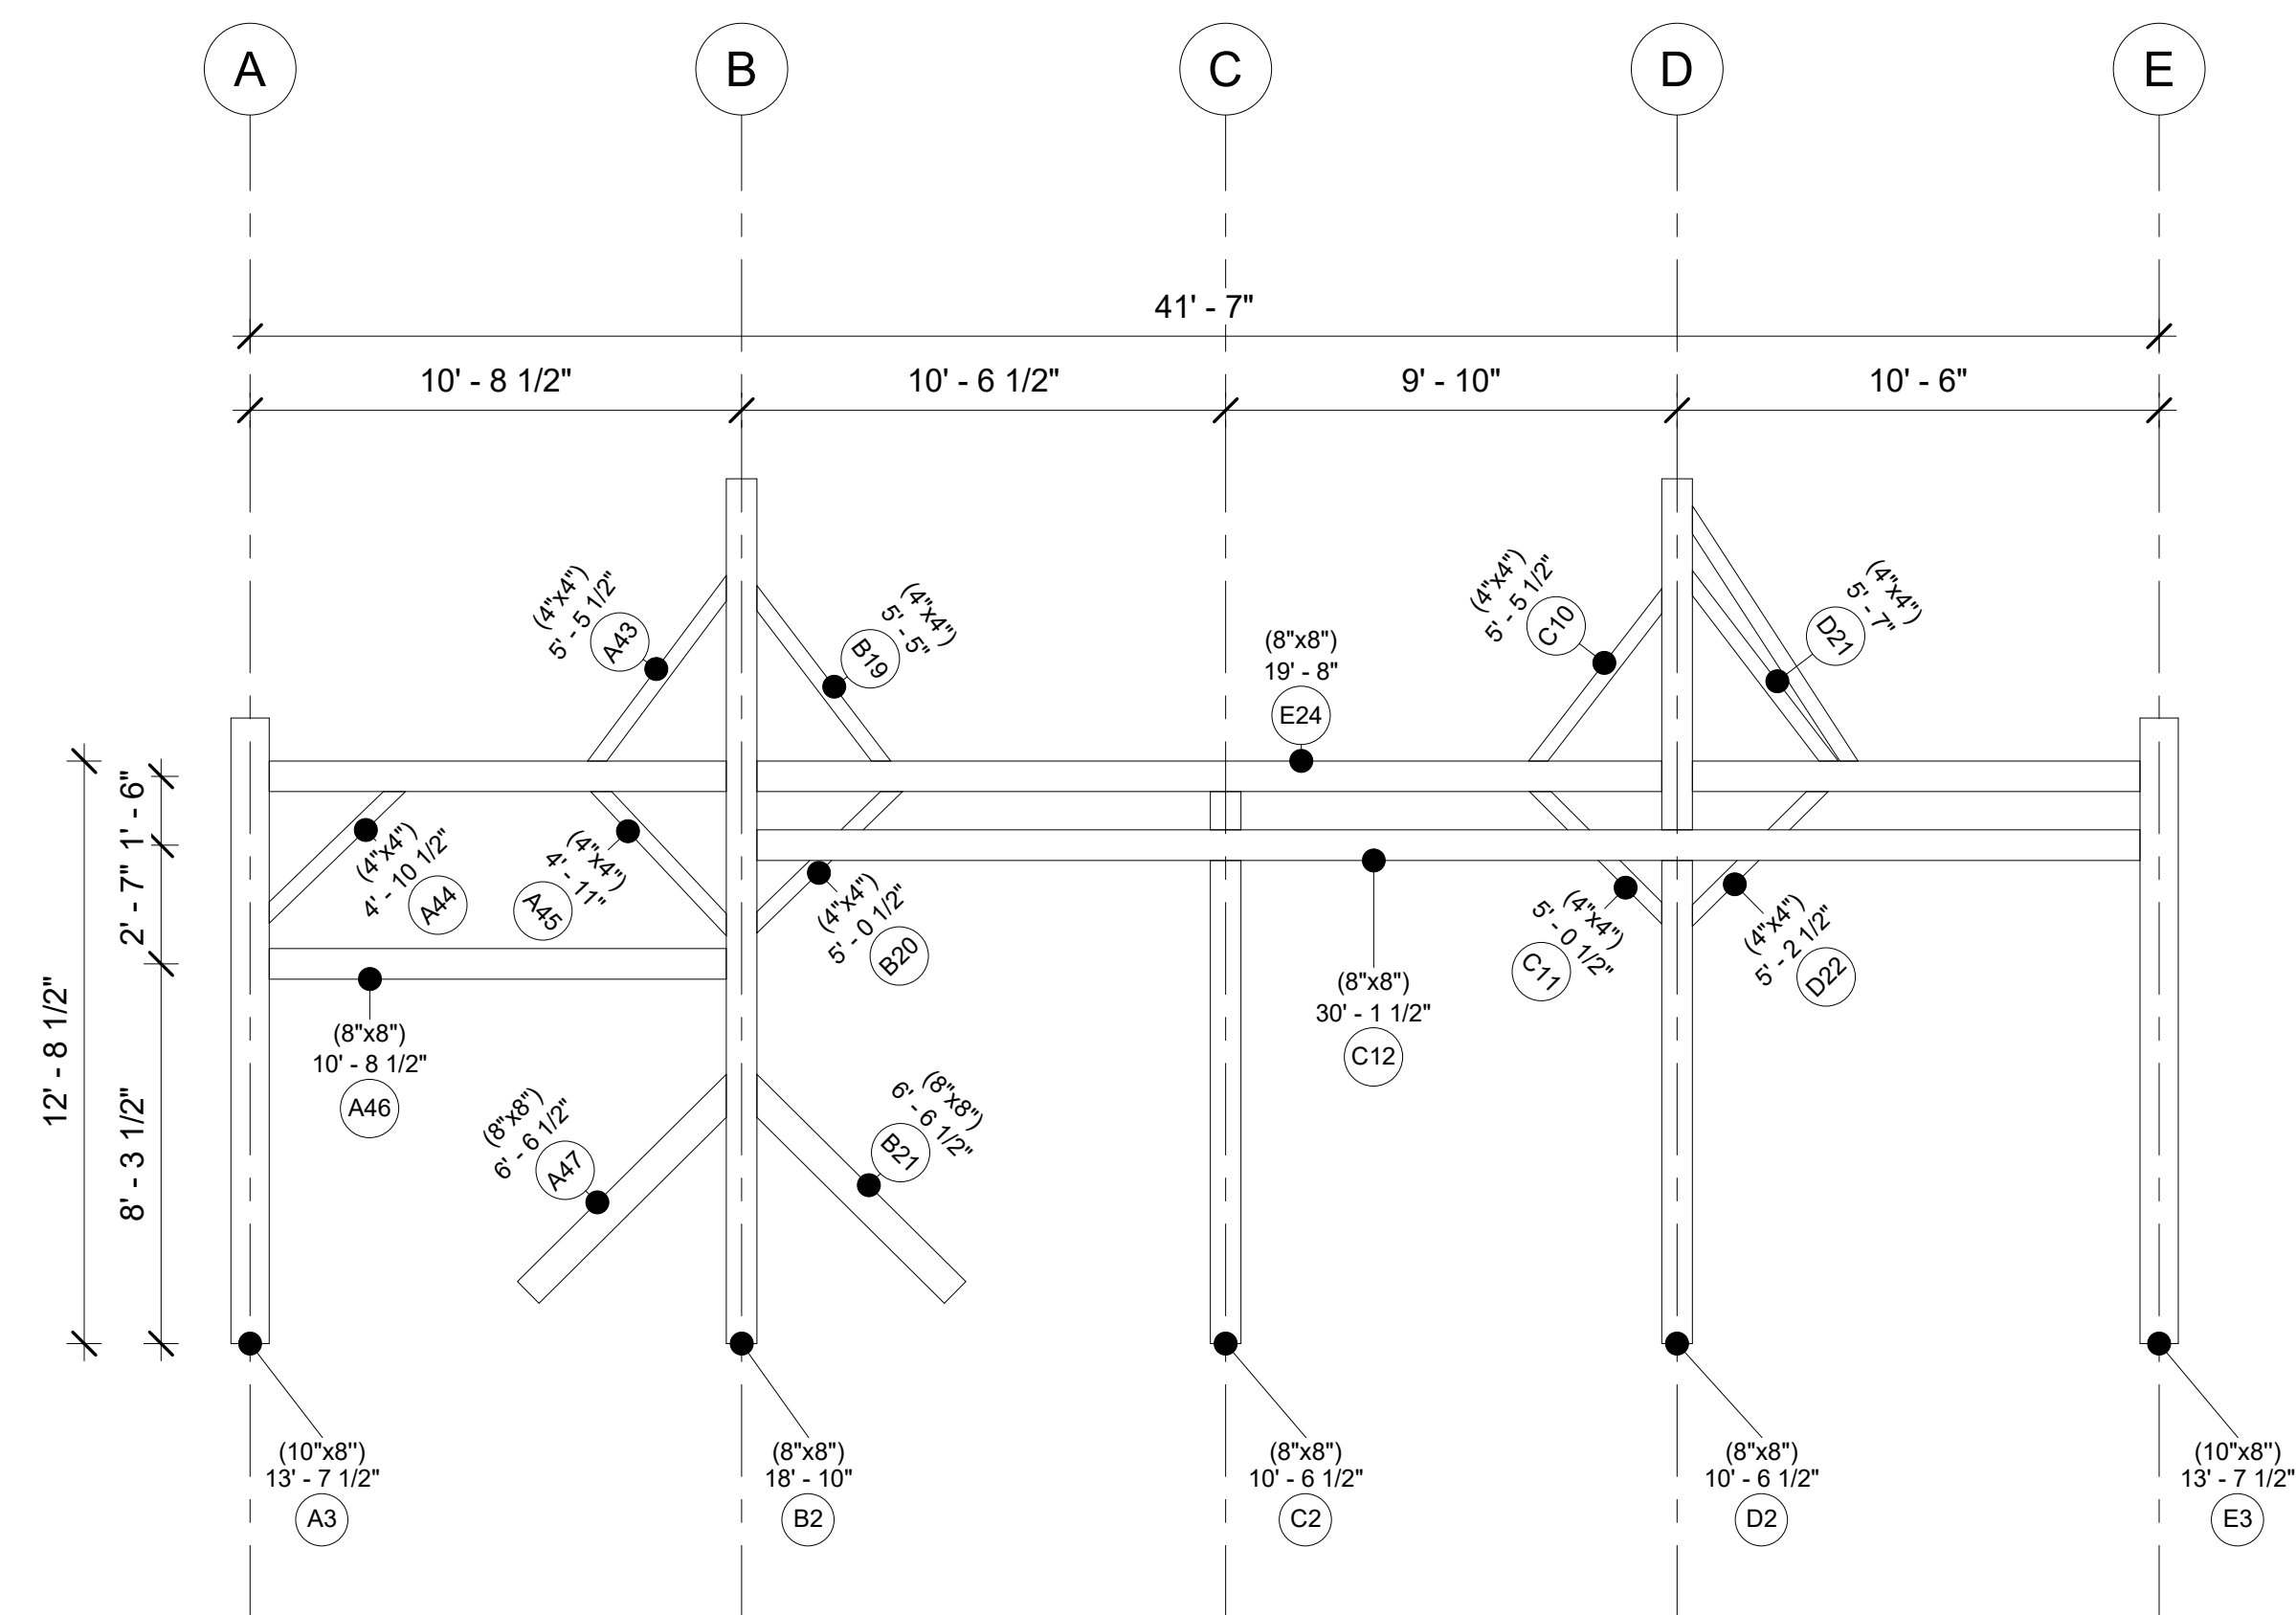

Bent 3

Project Number	Project 17
Date	20250618
Drawn By	
Checked By	

A108

Scale $1/4" = 1'-0"$


Scale $1/4" = 1'-0"$

Timber
Home
Services LLC

Mossy Creek

DAN TRIMBLE
AA66 / TIMBER HOME SERVICES
CELL PHONE/TEXT - 412-309-1161

EMAIL:
DANTRIMBLE@TIMBERHOMESERVICES.COM

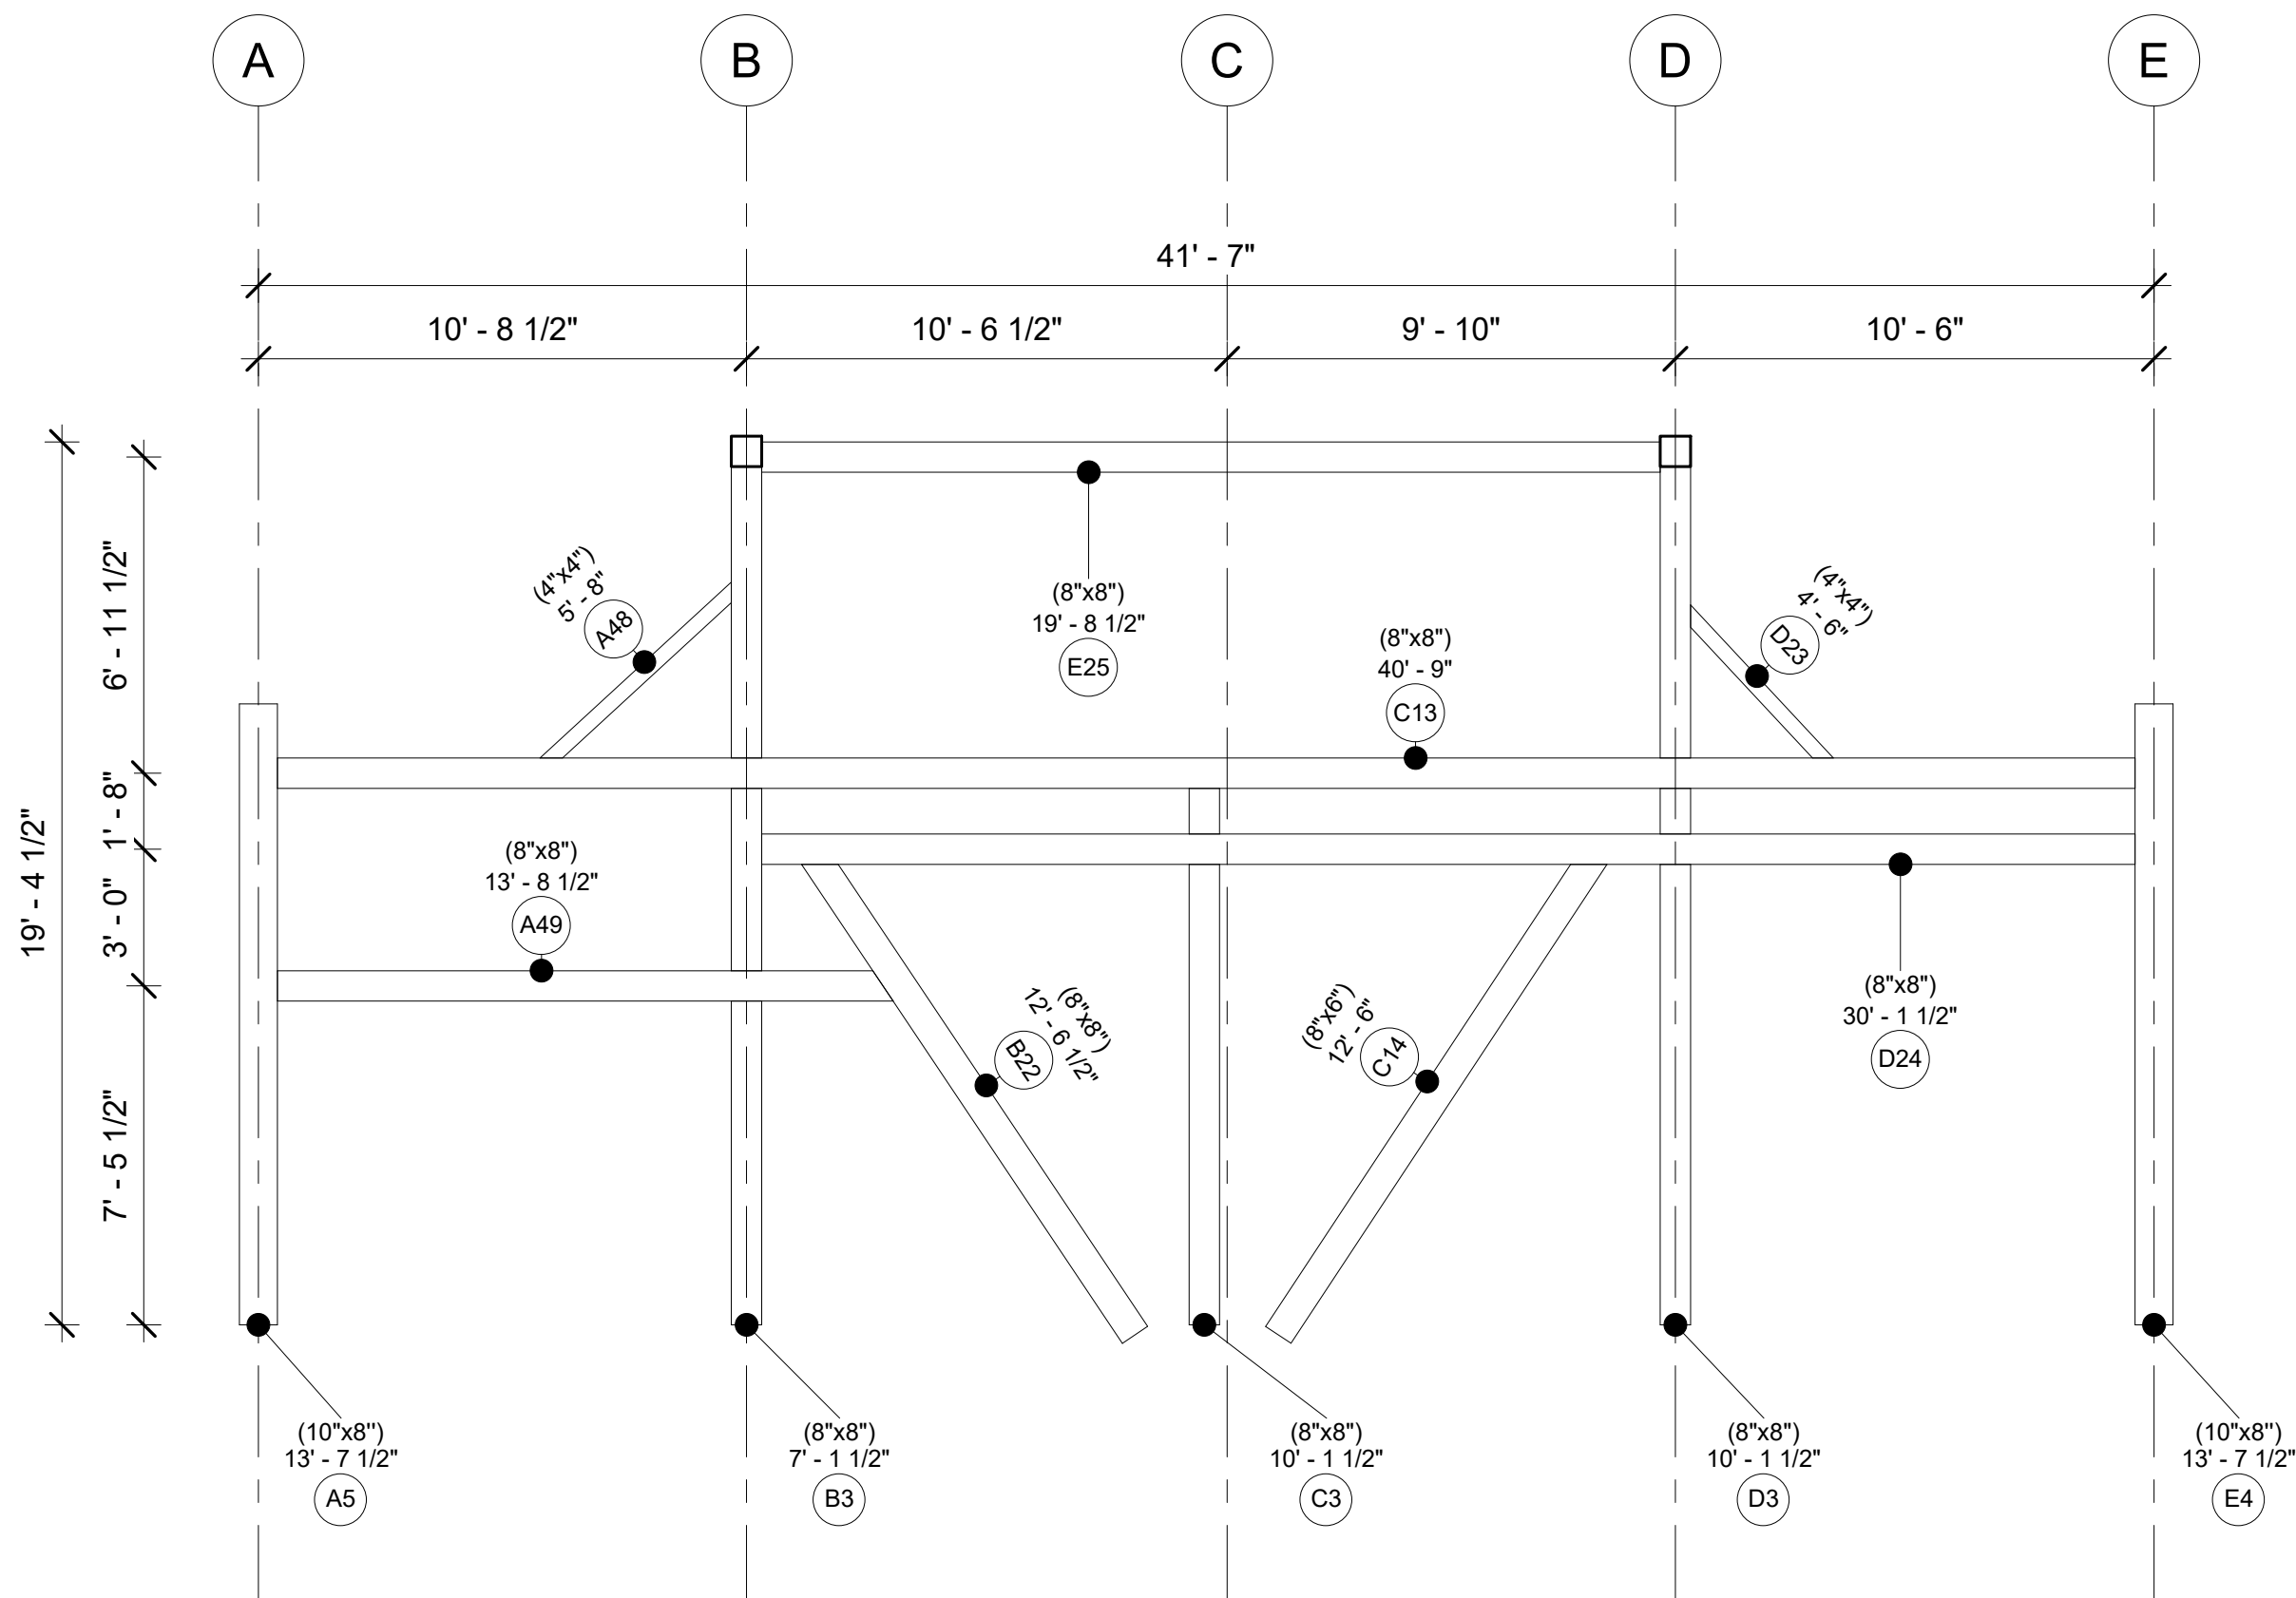

Bent 4

Project Number	Project 17
Date	20250618
Drawn By	
Checked By	

A109


Scale 1/4" = 1'-0"

Timber
Home
Services LLC

Mossy Creek

DAN TRIMBLE
AA66 / TIMBER HOME SERVICES
CELL PHONE/TEXT - 412-309-1161

EMAIL:
DANTRIMBLE@TIMBERHOMESERVICES.COM

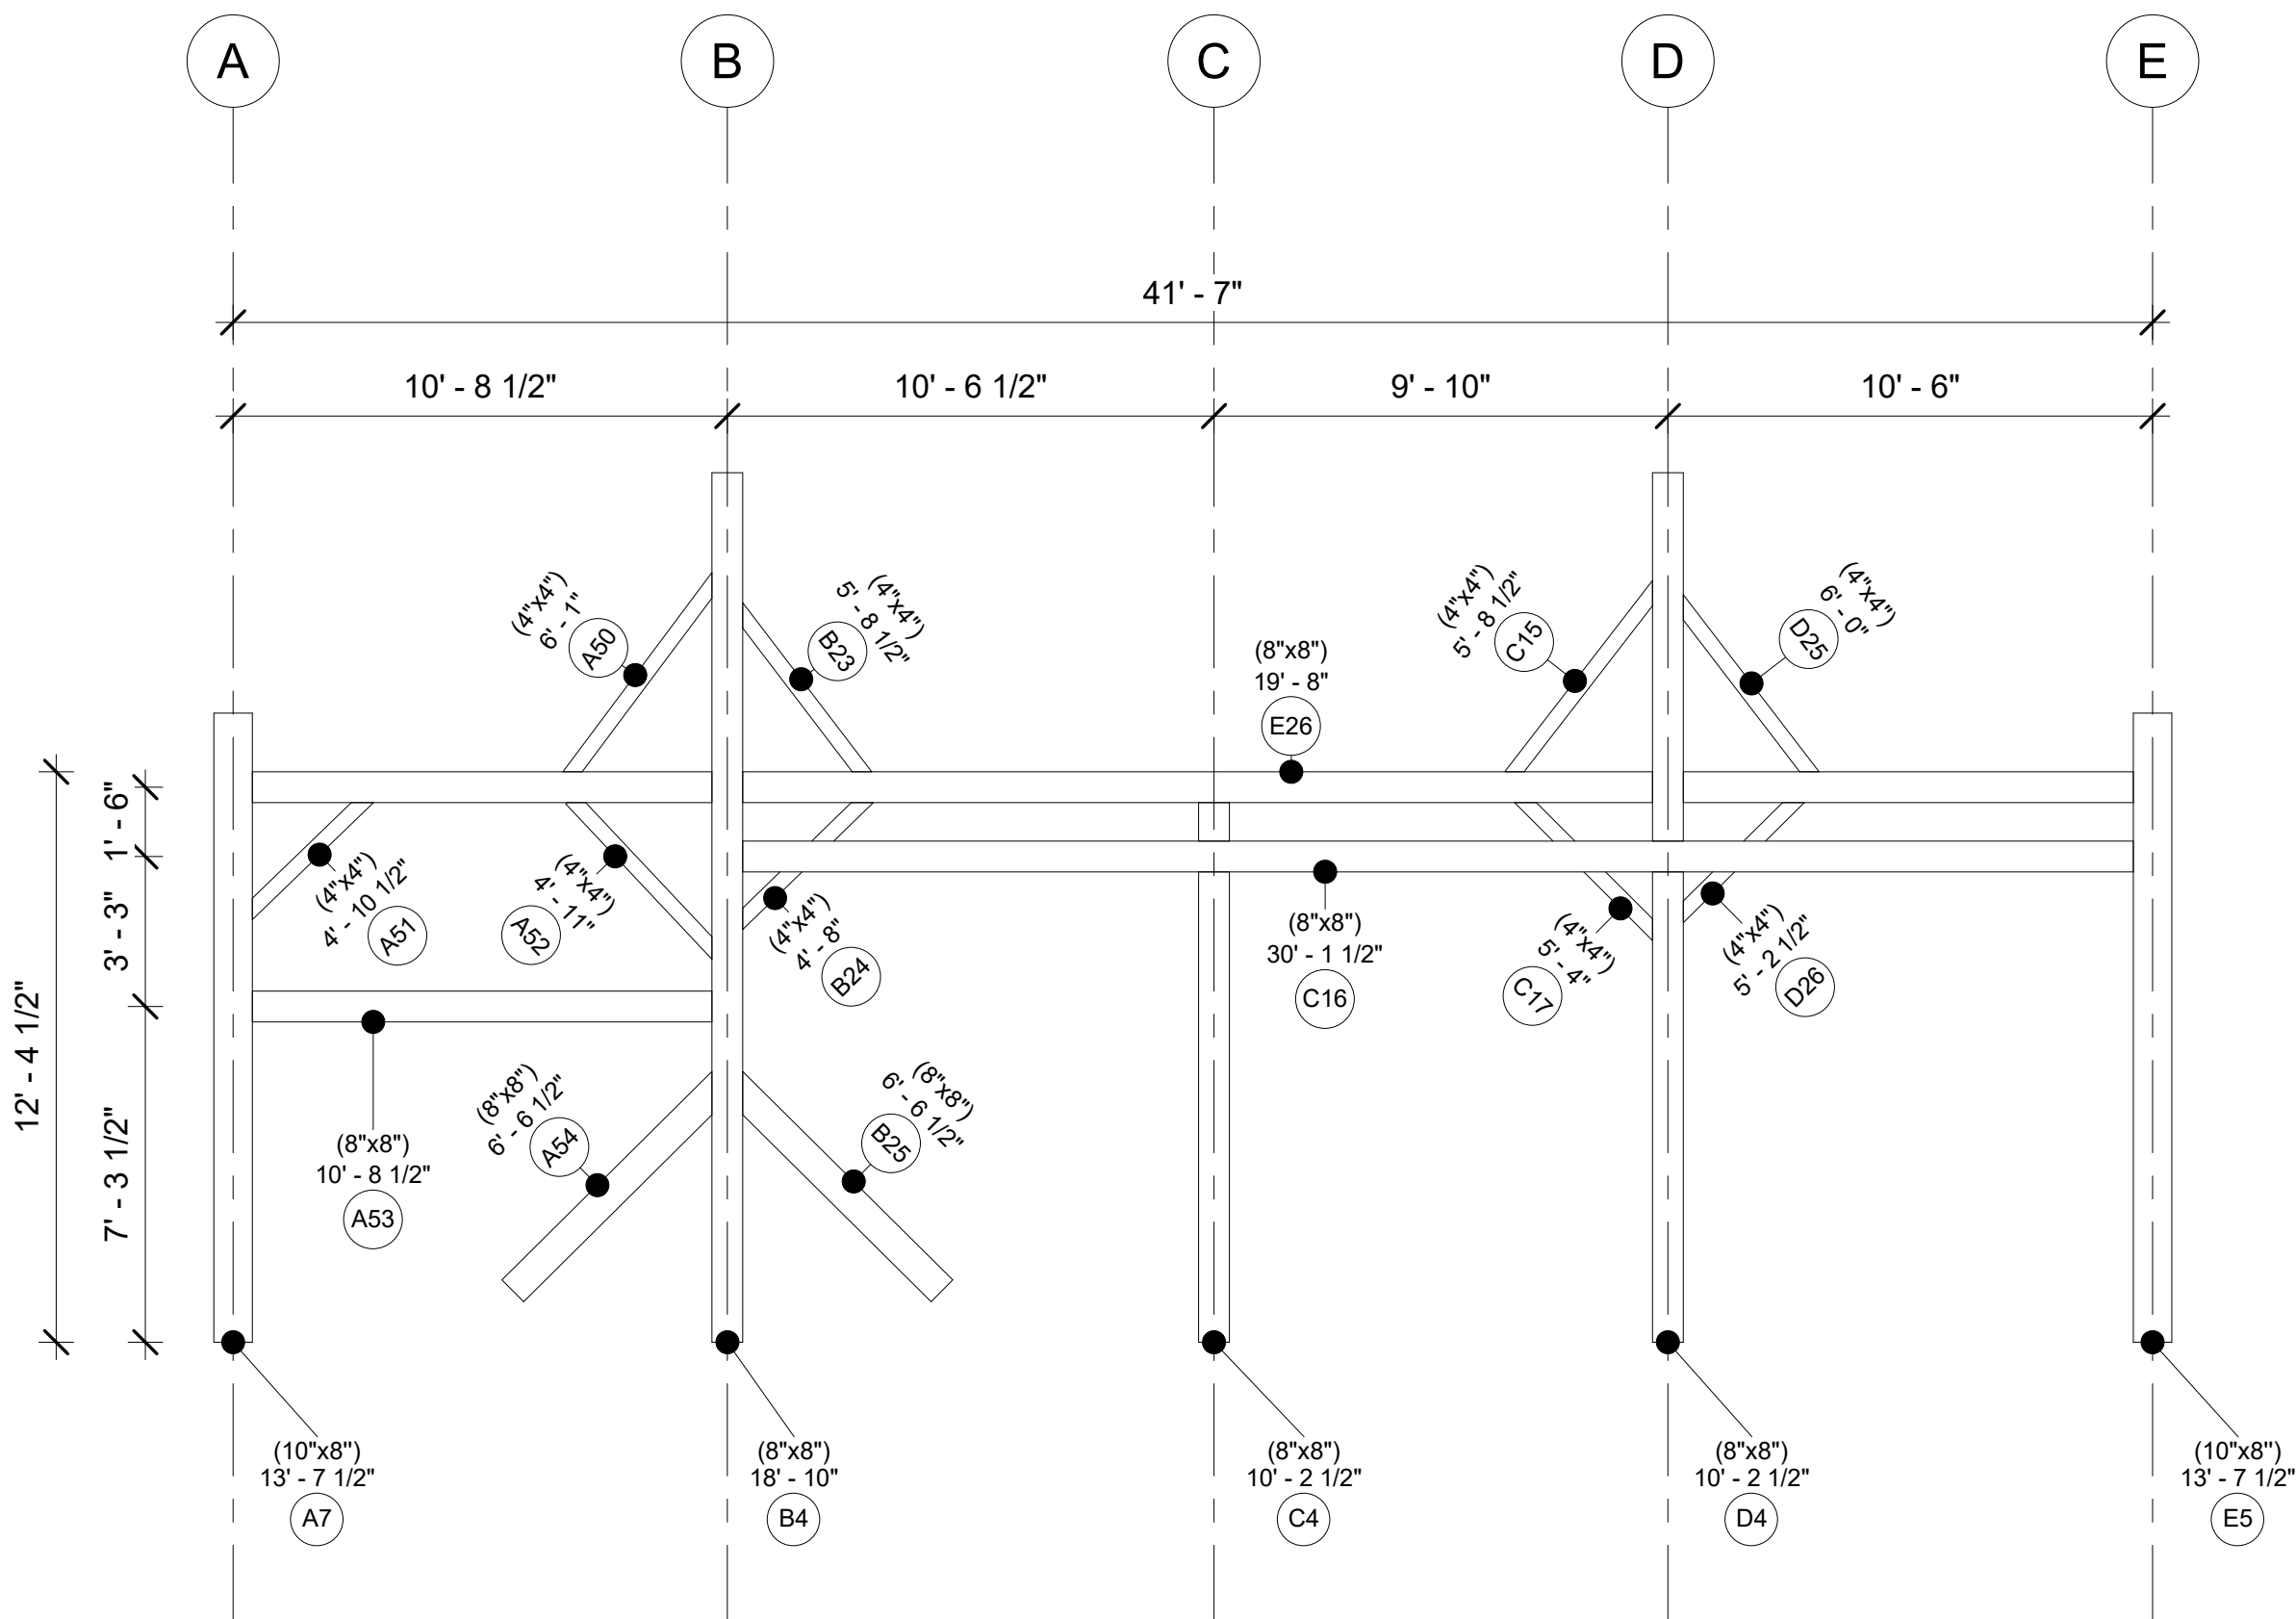

Bent 5

Project Number	Project 17
Date	20250618
Drawn By	
Checked By	

A110

Scale	1/4" = 1'-0"
-------	--------------

Timber Home Services LLC

Mossy Creek


Mossy Creek

DAN TRIMBLE
AA66 / TIMBER HOME SERVICES
CELL PHONE/TEXT - 412-309-1161

EMAIL:

DANTRIMBLE@TIMBERHOMESERVICES.COM

DANTRIMBLE@TIMBERHOMESERVICES.COM

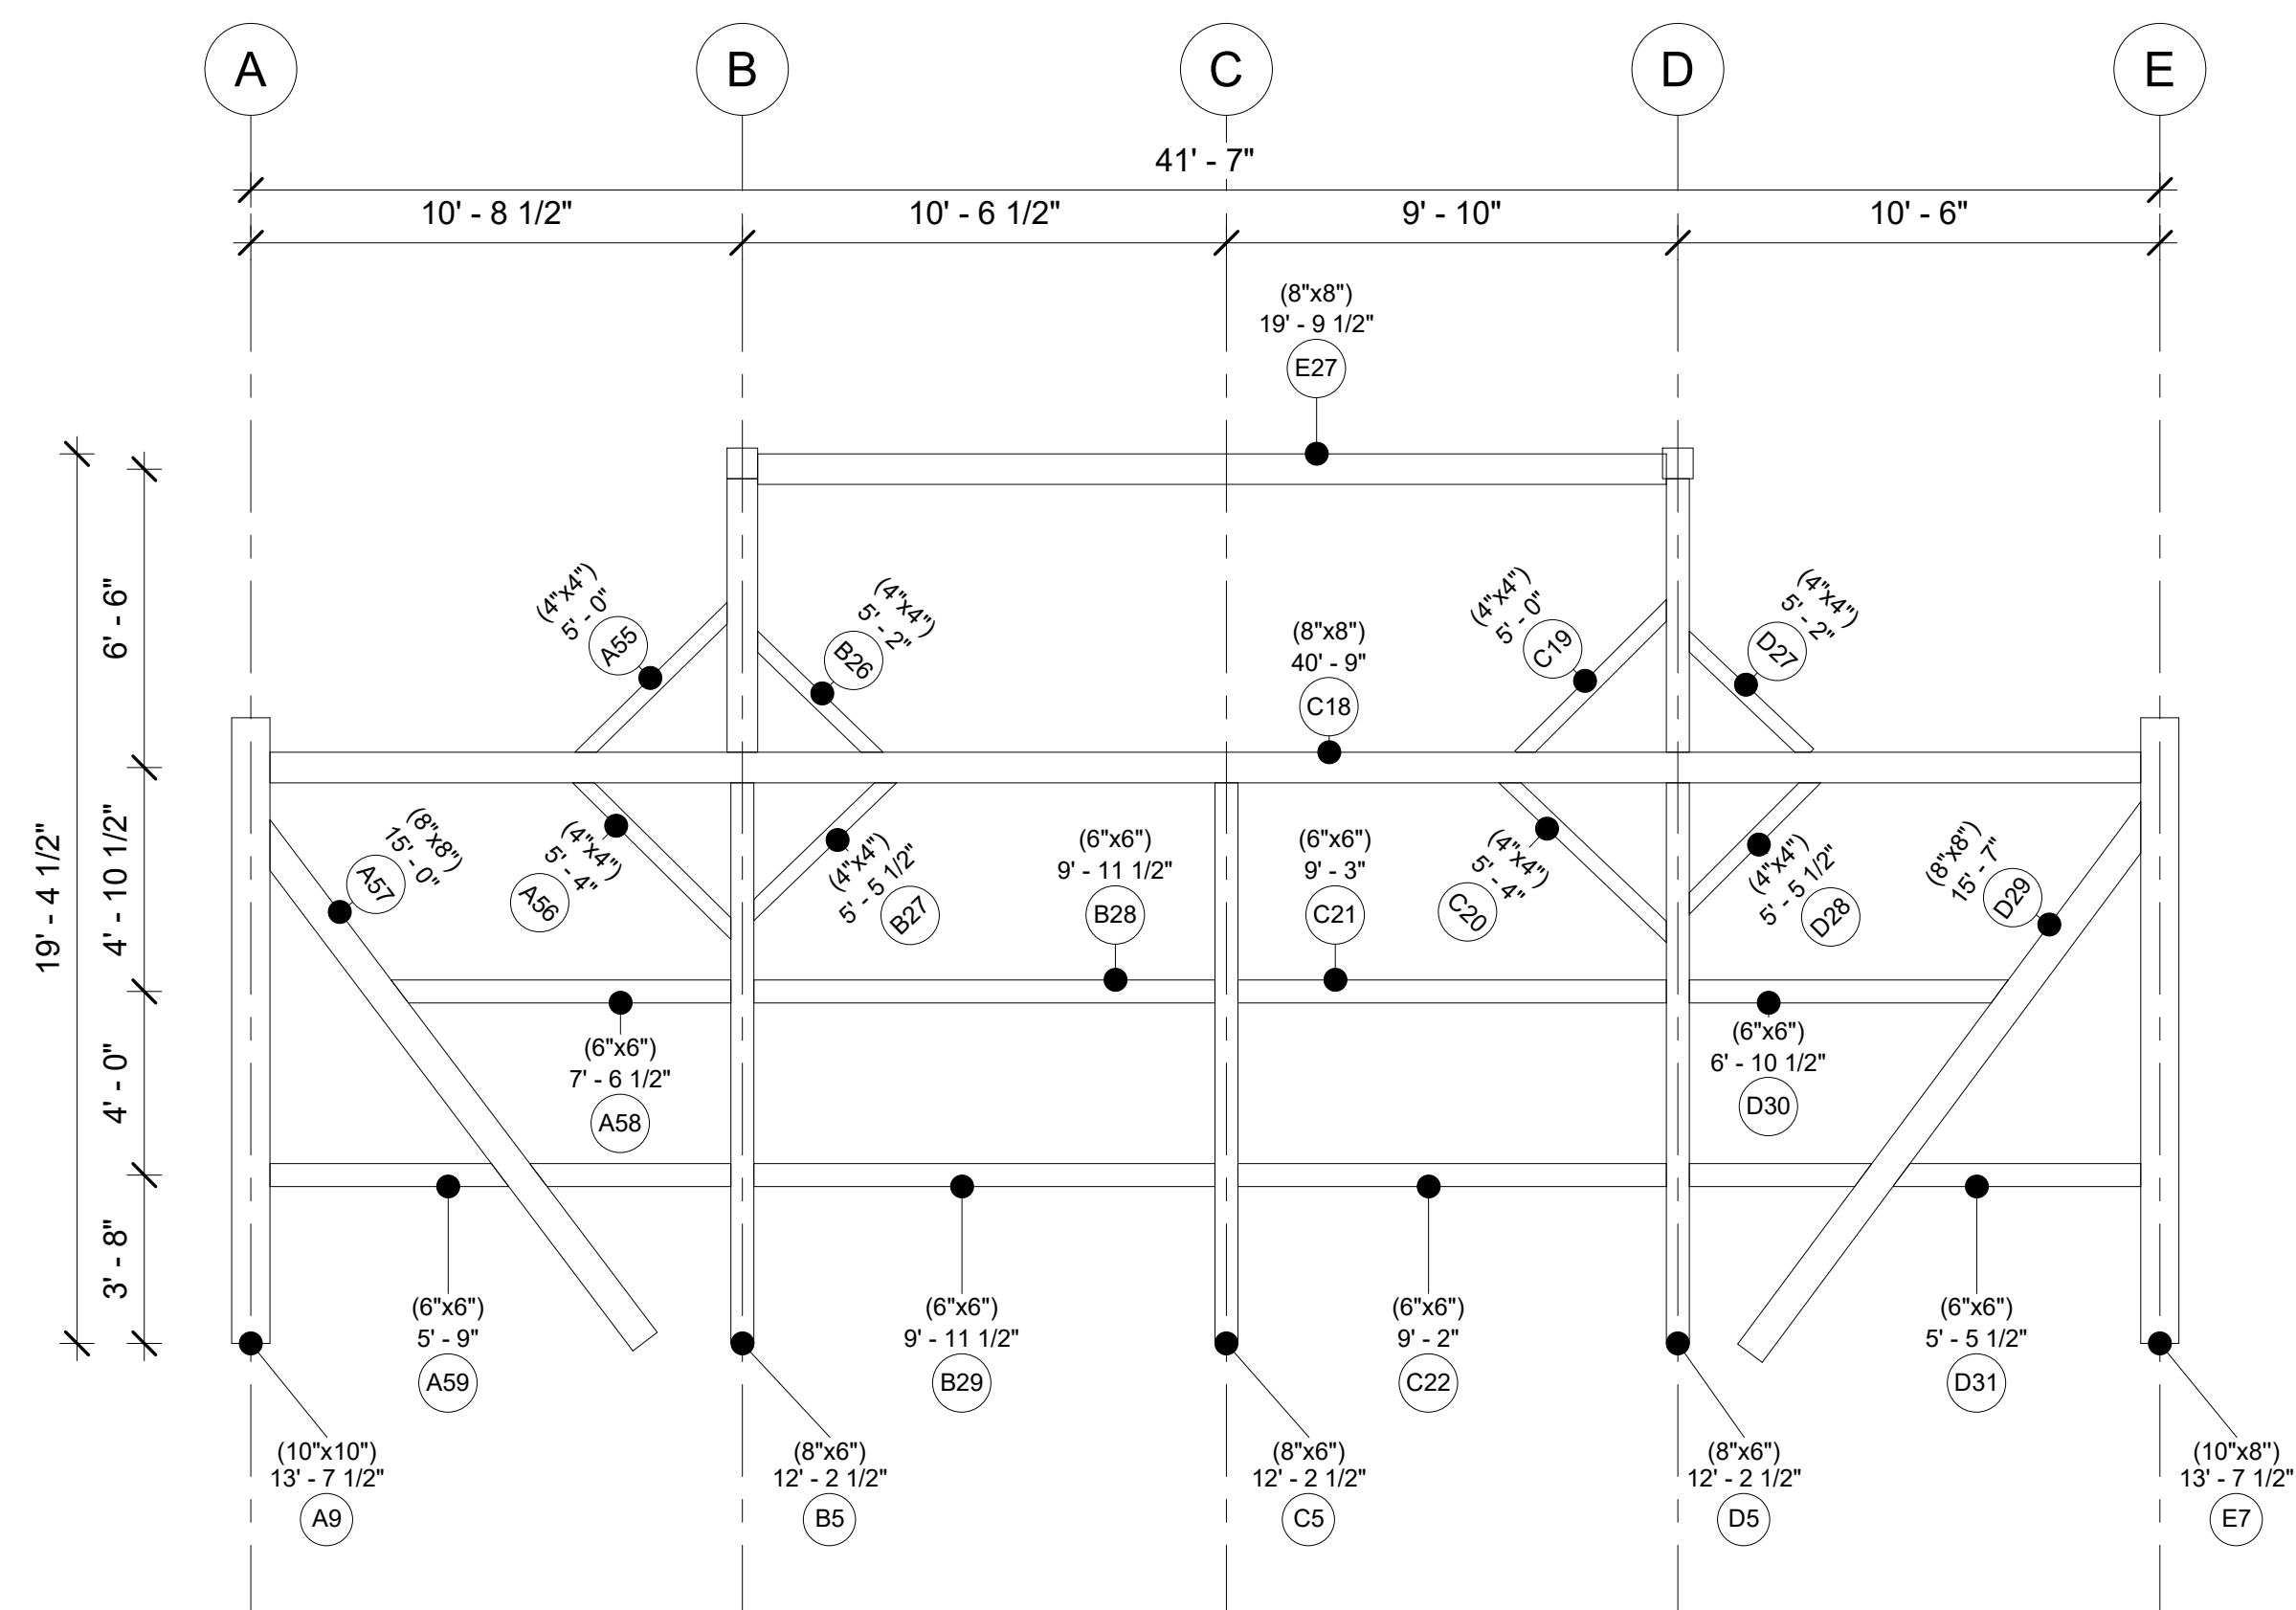

Bent 7

Project Number	Project 17
----------------	------------

Date	20250618
------	----------

Drawn By _____

Checked By	
------------	--

A111

Scale	1/4" = 1'-0"
-------	--------------