


PROJECT: Whitetail Hollow

SCOPE: AS BUILT DRAWINGS

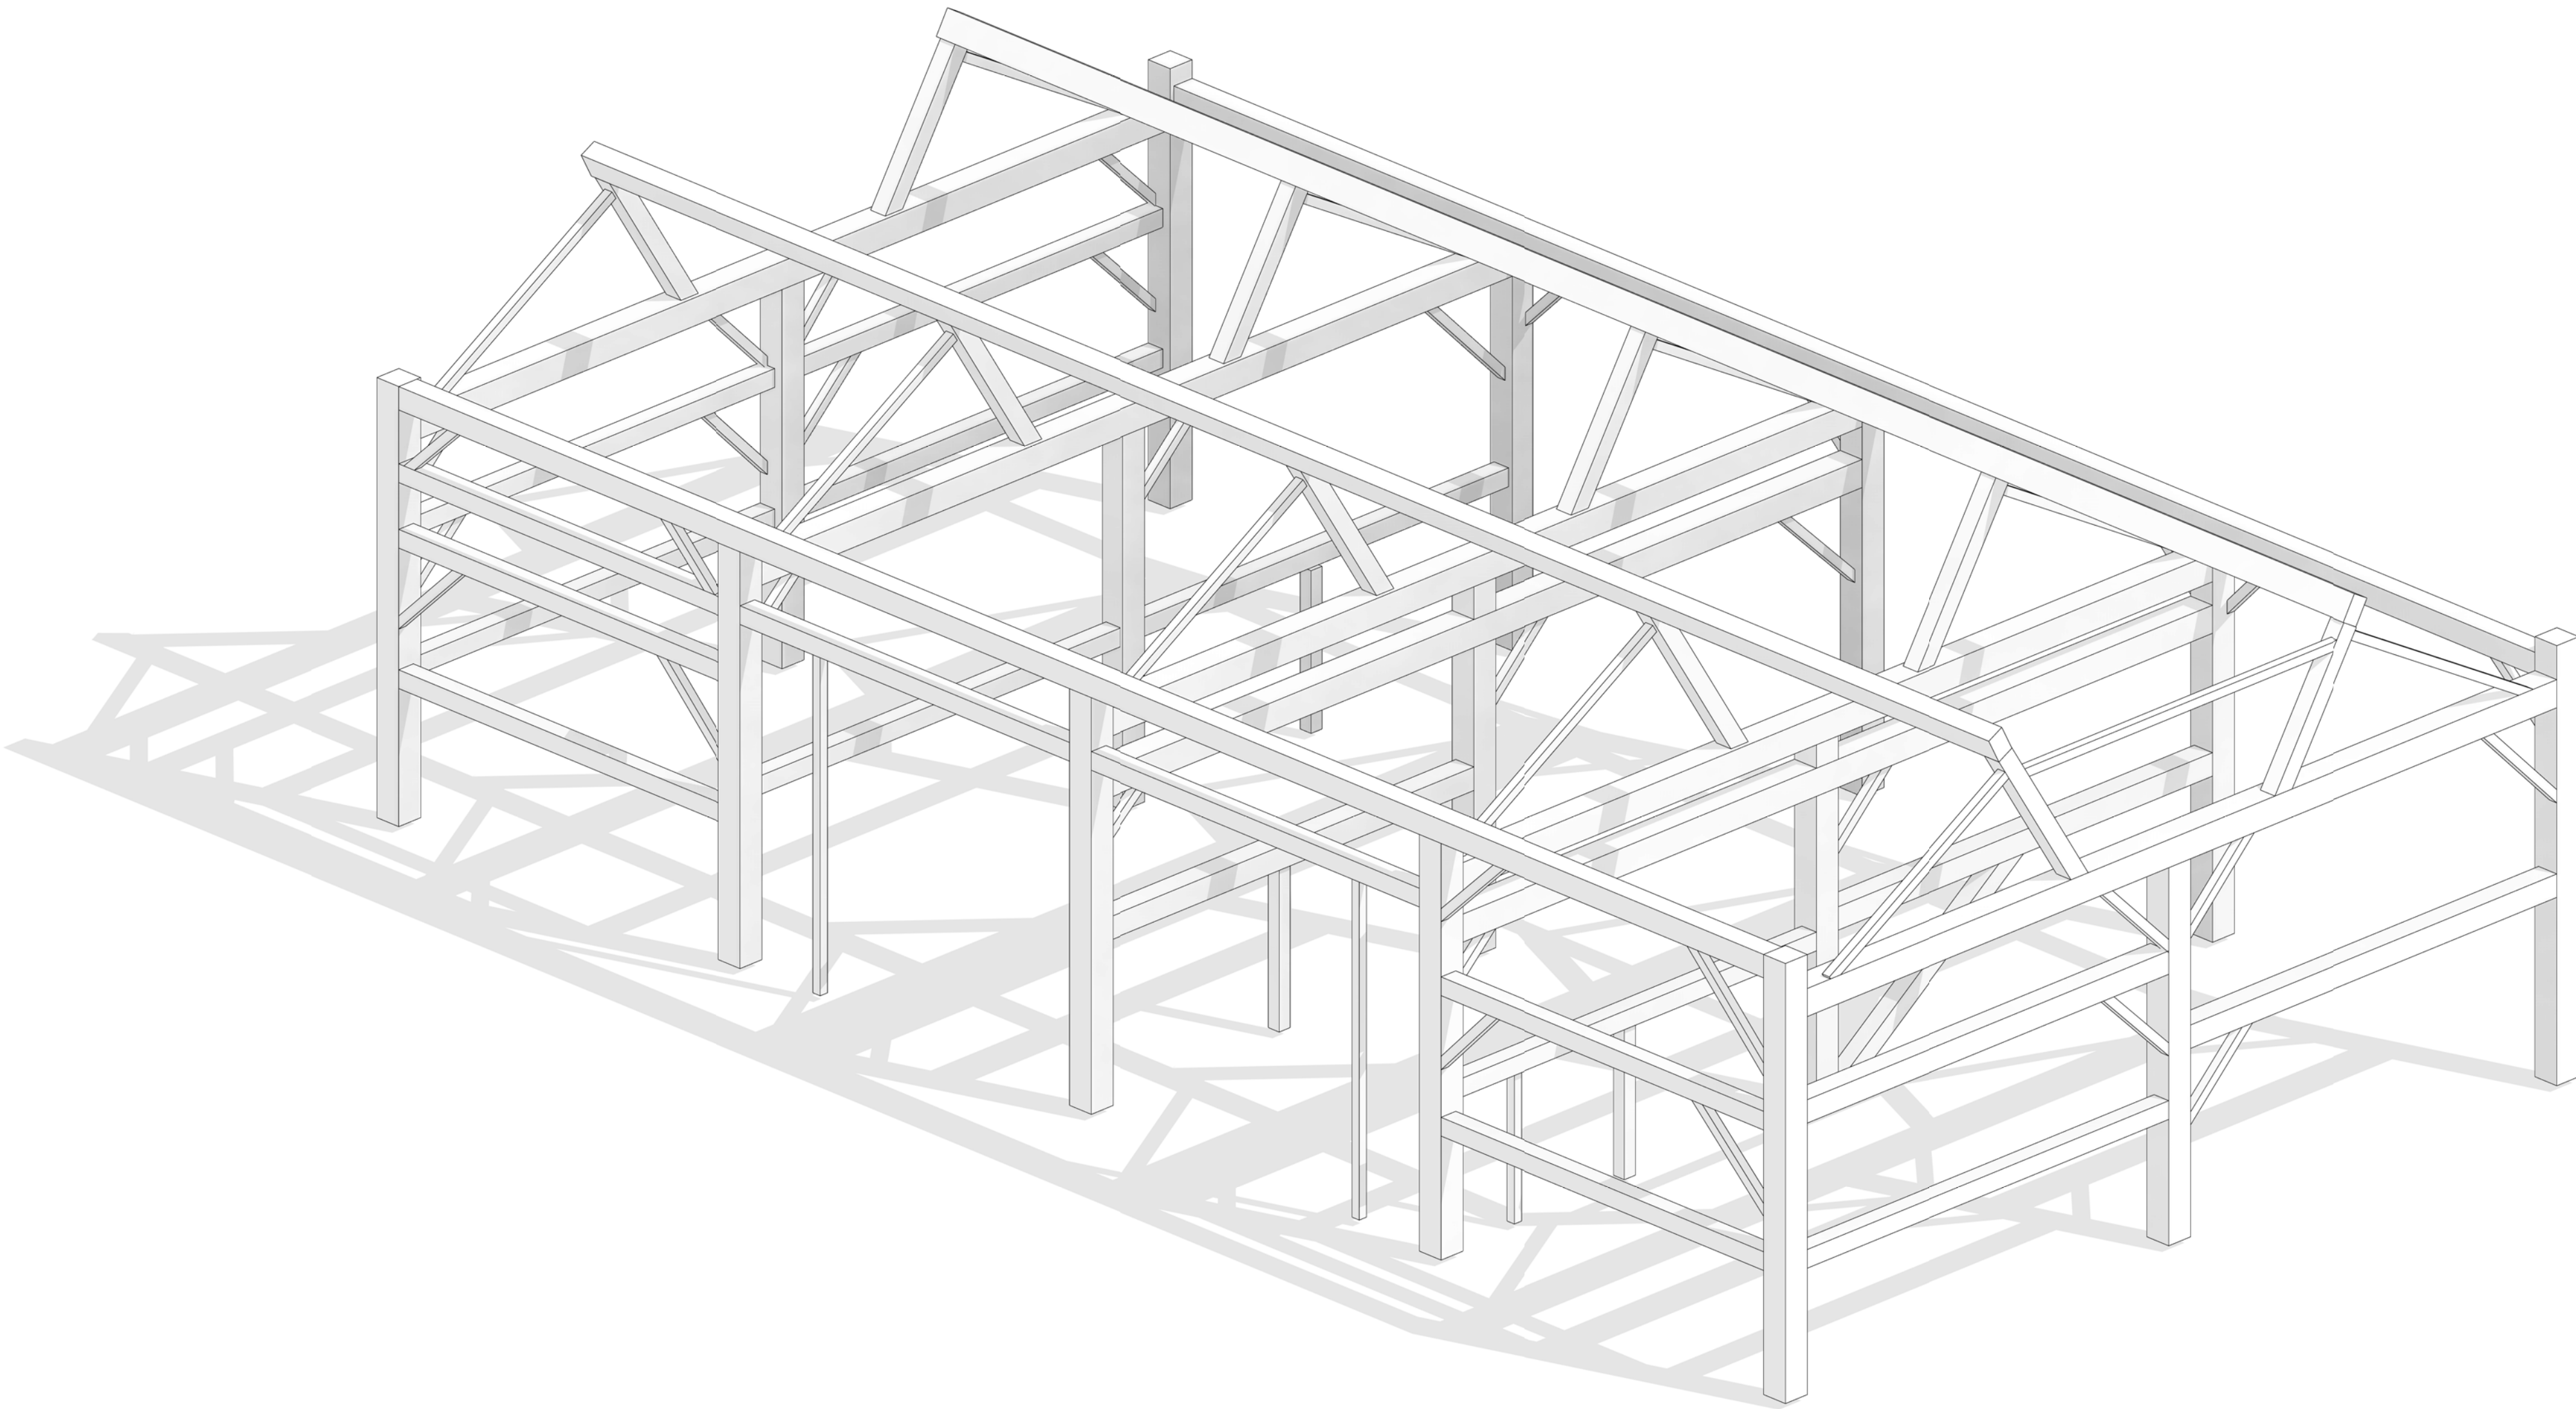

Timber
Home
Services LLC

Whitetail Hollow

DAN TRIMBLE
AA66 / TIMBER HOME SERVICES
CELL PHONE/TEXT - 412-309-1161

EMAIL:
DANTRIMBLE@TIMBERHOMESERVICES.COM

Cover Page

Project Number	Project 16
Date	20250623
Drawn By	
Checked By	

A101

Scale

Timber
Home
Services LLC

Whitetail Hollow

DAN TRIMBLE
AA66 / TIMBER HOME SERVICES
CELL PHONE/TEXT - 412-309-1161

EMAIL:

DANTRIMBLE@TIMBERHOMESERVICES.COM

Floor Plan

Project Number	Project 16
----------------	------------


Date	20250623
------	----------

Drawn By _____

Checked By	
------------	--

A102

Scale	1/4" = 1'-0"
-------	--------------

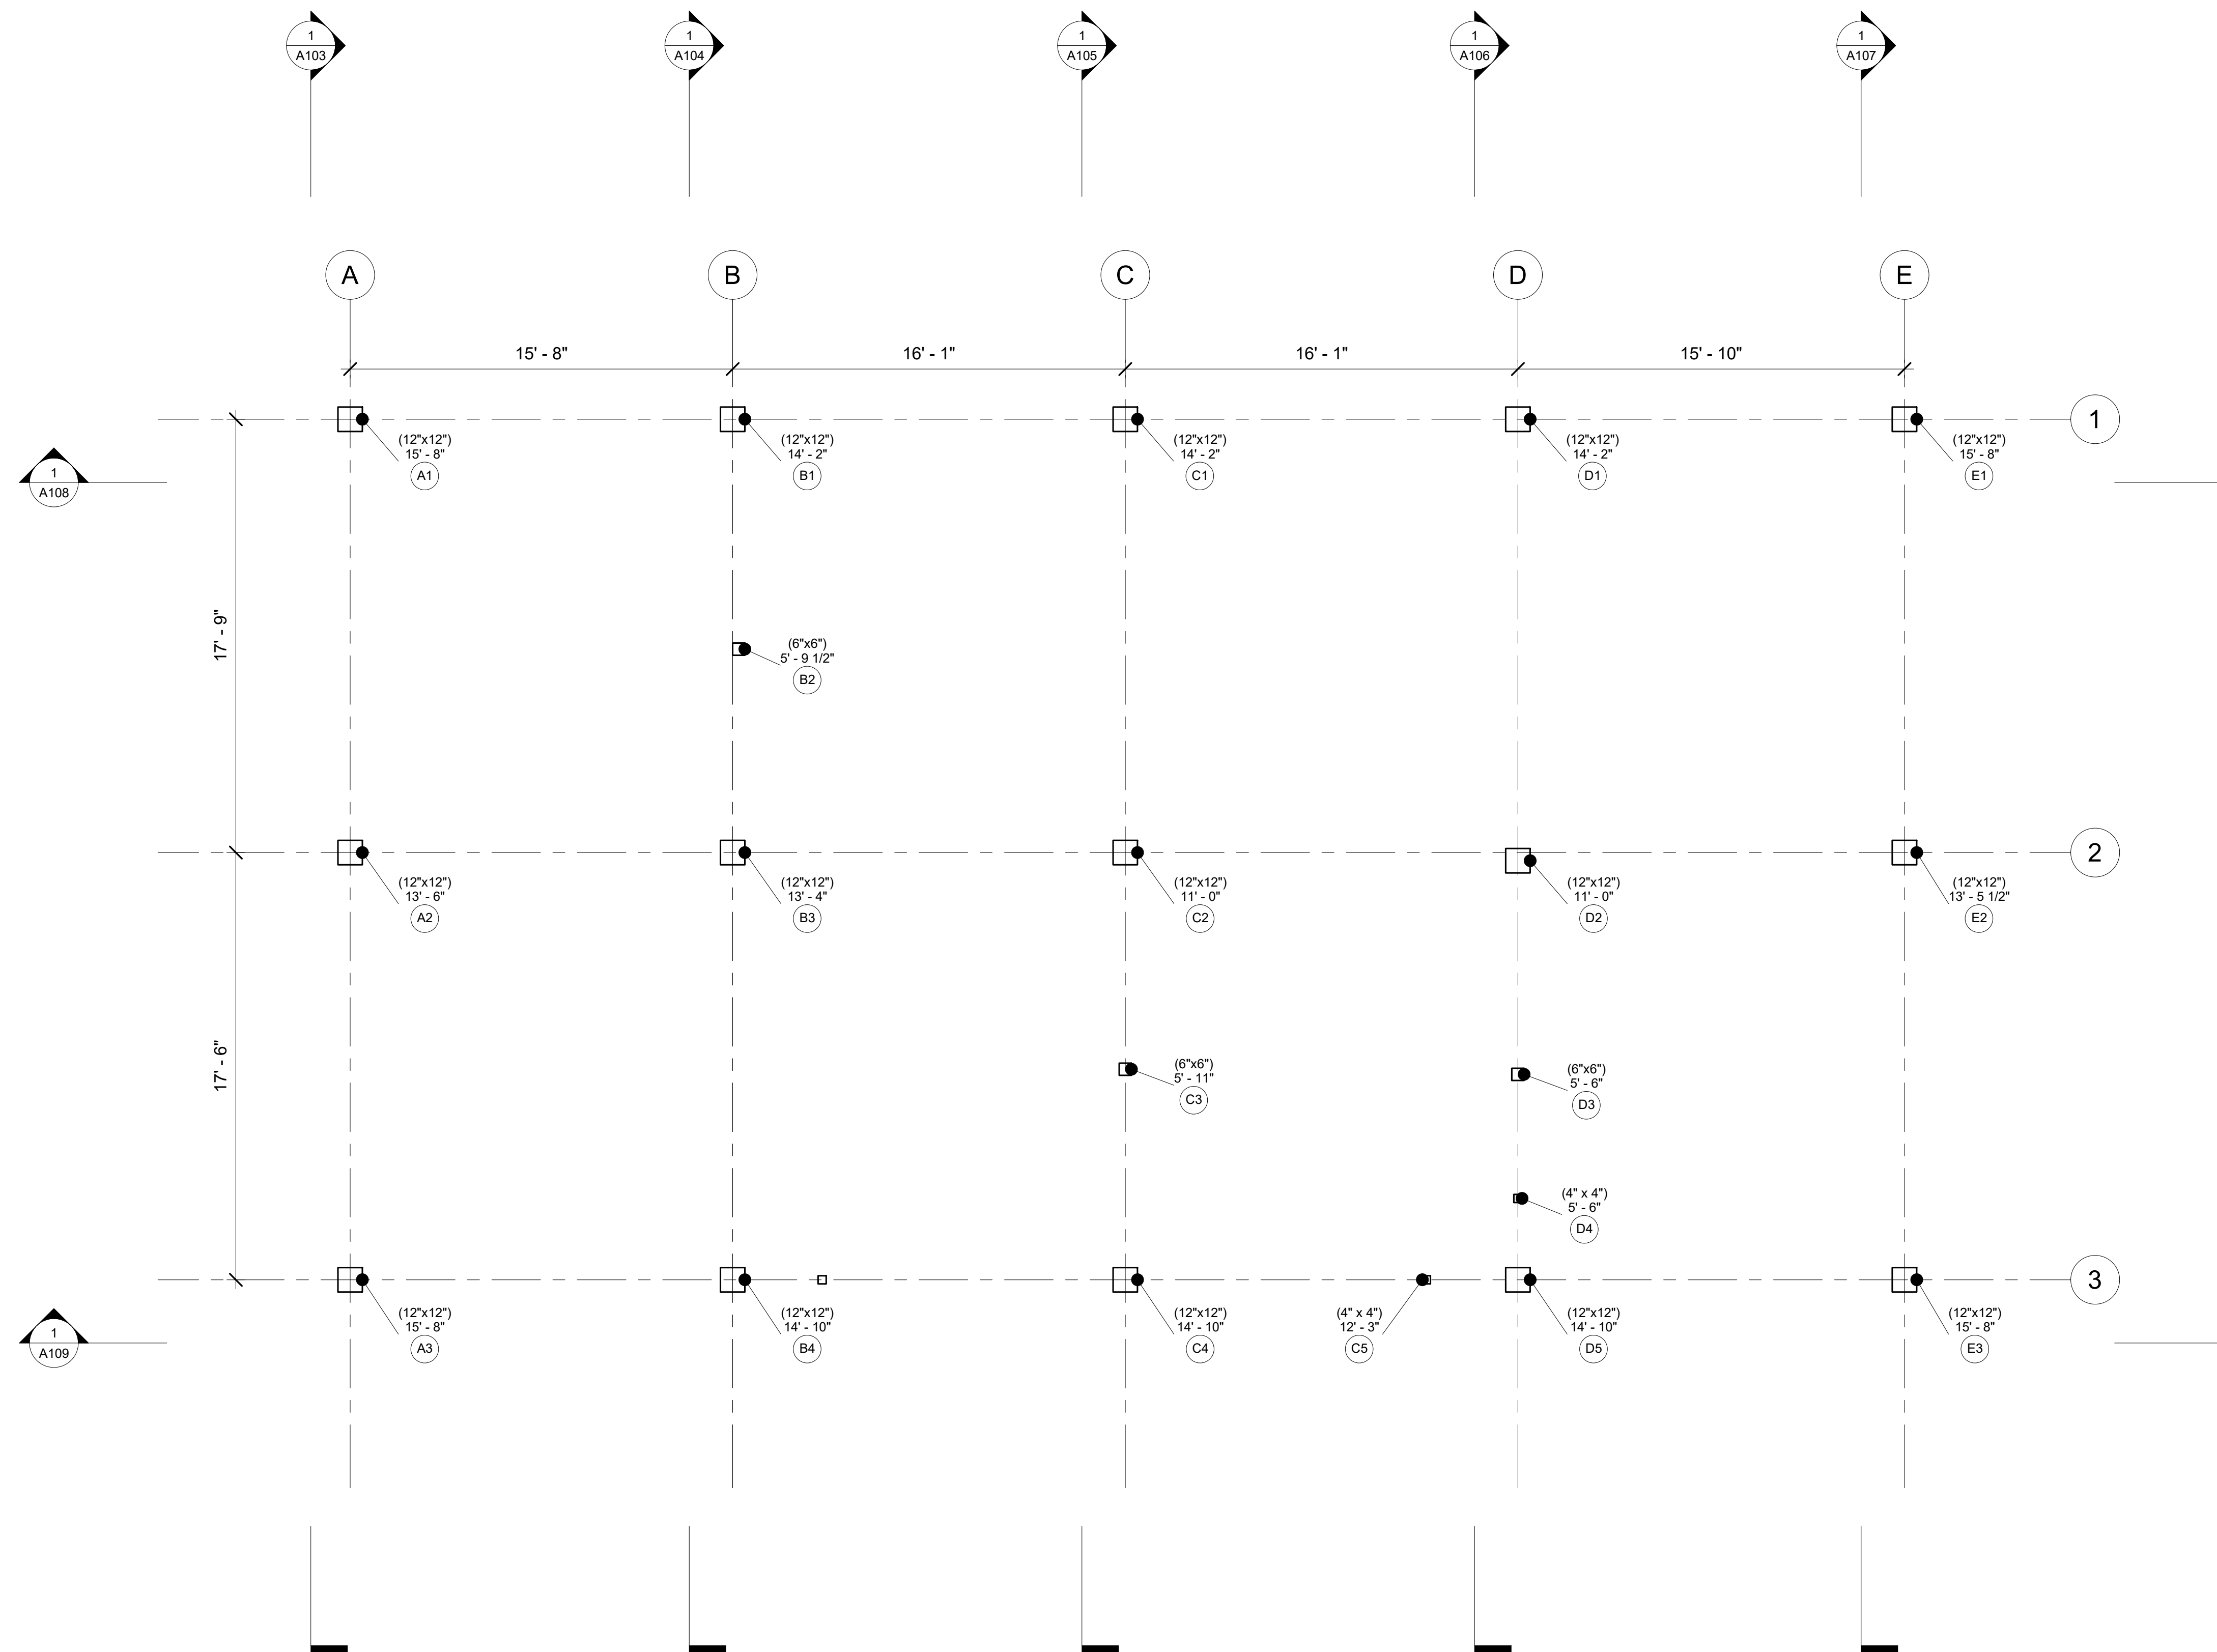

Timber Home Services LLC

Whitetail Hollow

CELL PHONE/TEXT - 412-309-1161

DANTRIMBLE@TIMBERHOMESERVICES.COM

Bent A

Date 20250623

Checked By _____

A103


Scale $1/4" = 1'-0"$

Timber
Home
Services LLC

Whitetail Hollow

DAN TRIMBLE
AA66 / TIMBER HOME SERVICES
CELL PHONE/TEXT - 412-309-1161

EMAIL:
DANTRIMBLE@TIMBERHOMESERVICES.COM

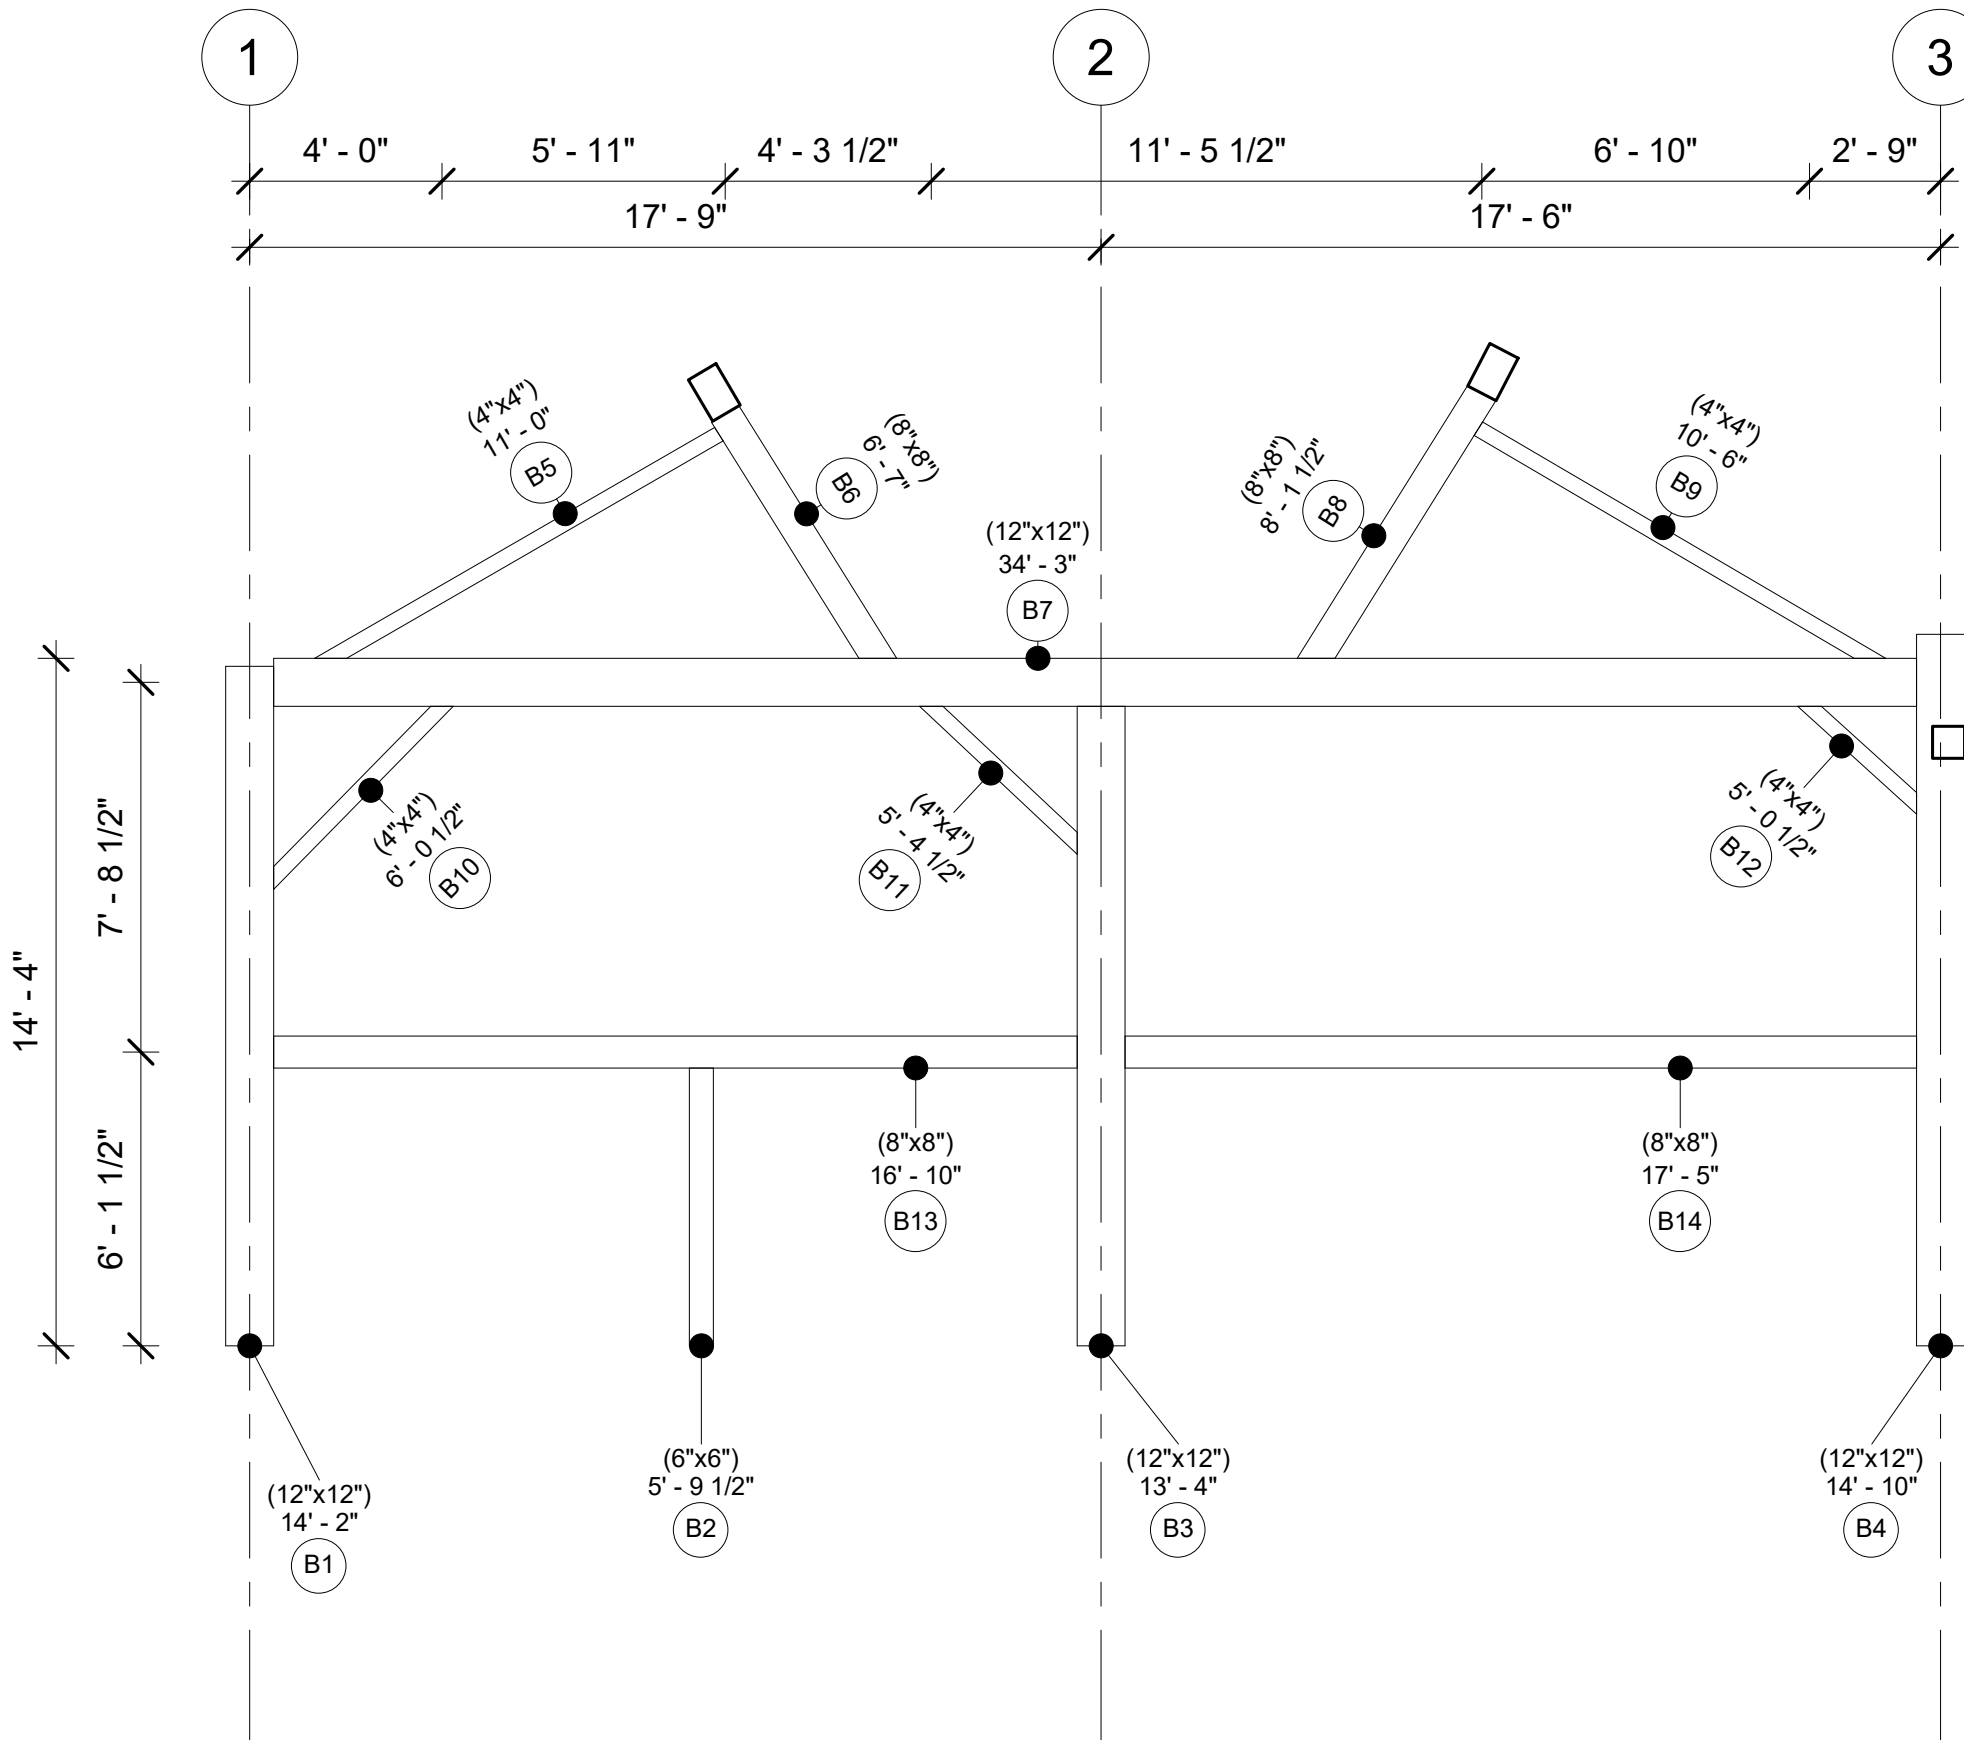

Bent B


Project Number	Project 16
Date	20250623
Drawn By	
Checked By	
A104	
Scale	1/4" = 1'-0"

Timber
Home
Services LLC

Whitetail Hollow

DAN TRIMBLE
AA66 / TIMBER HOME SERVICES
CELL PHONE/TEXT - 412-309-1161

EMAIL:
DANTRIMBLE@TIMBERHOMESERVICES.COM

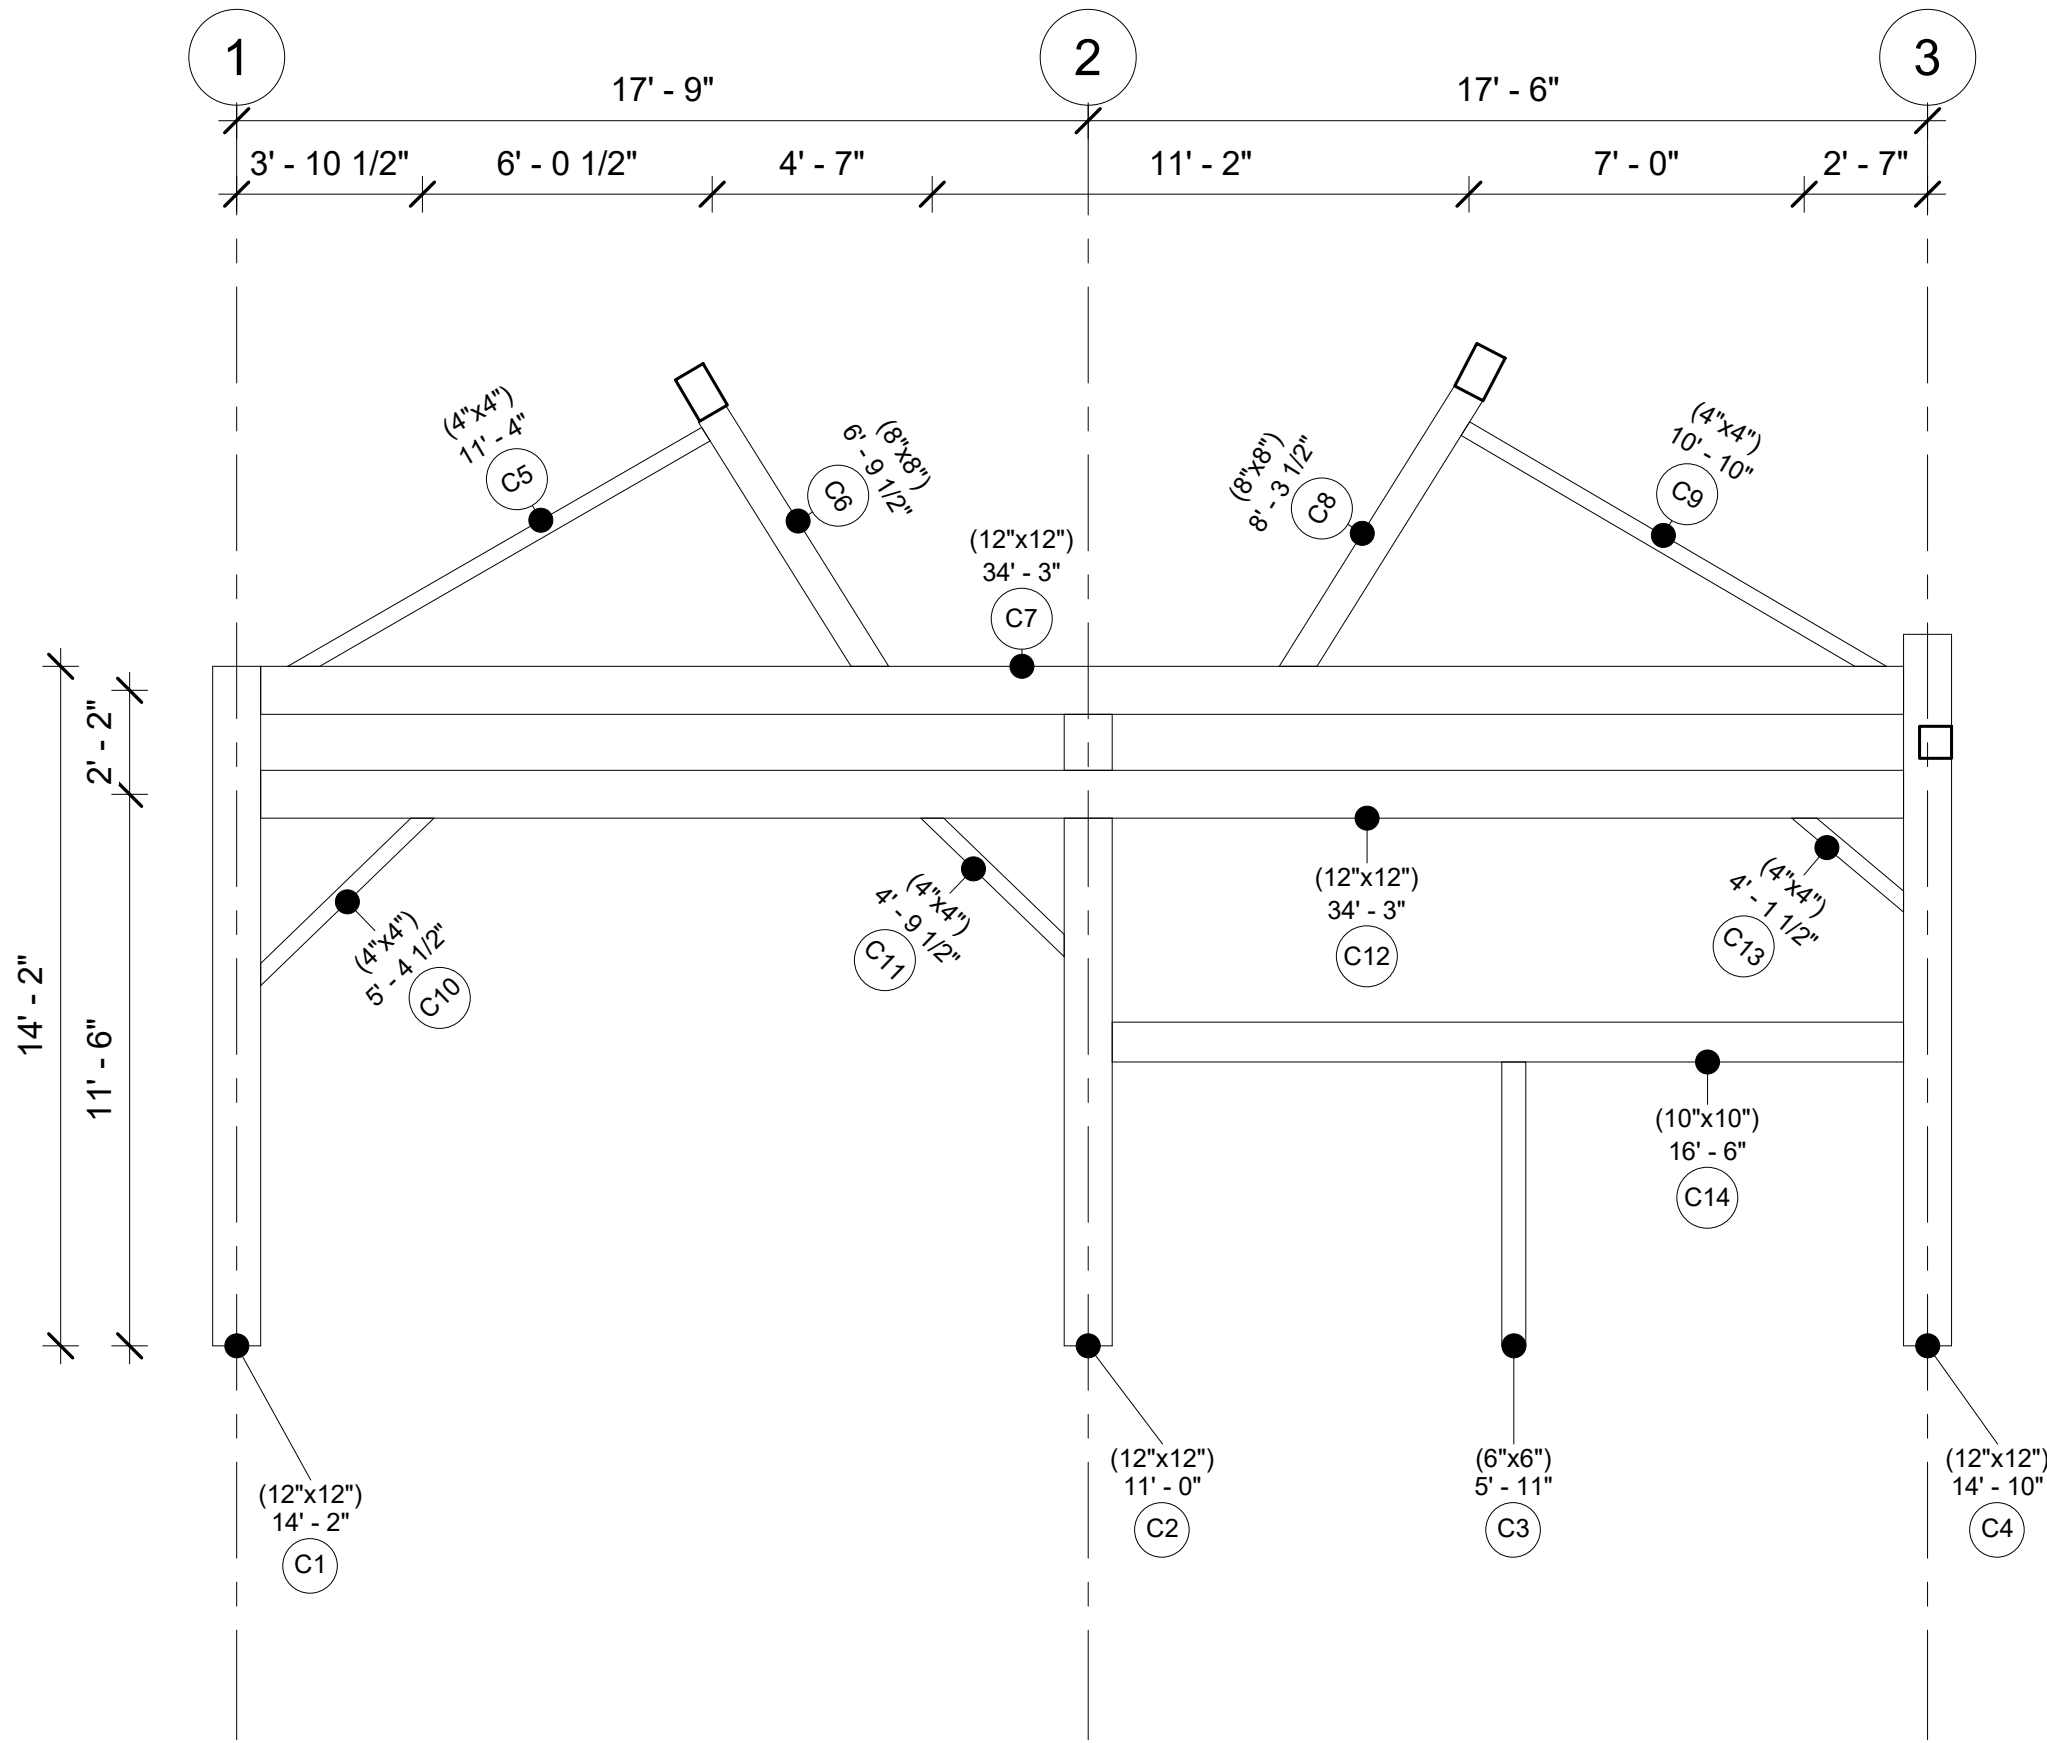

Bent C


Project Number	Project 16
Date	20250623
Drawn By	
Checked By	
A105	
Scale	1/4" = 1'-0"

Timber Home Services LLC

Whitetail Hollow

CELL PHONE/TEXT - 412-309-1161

DANTRIMBLE@TIMBERHOMESERVICES.COM

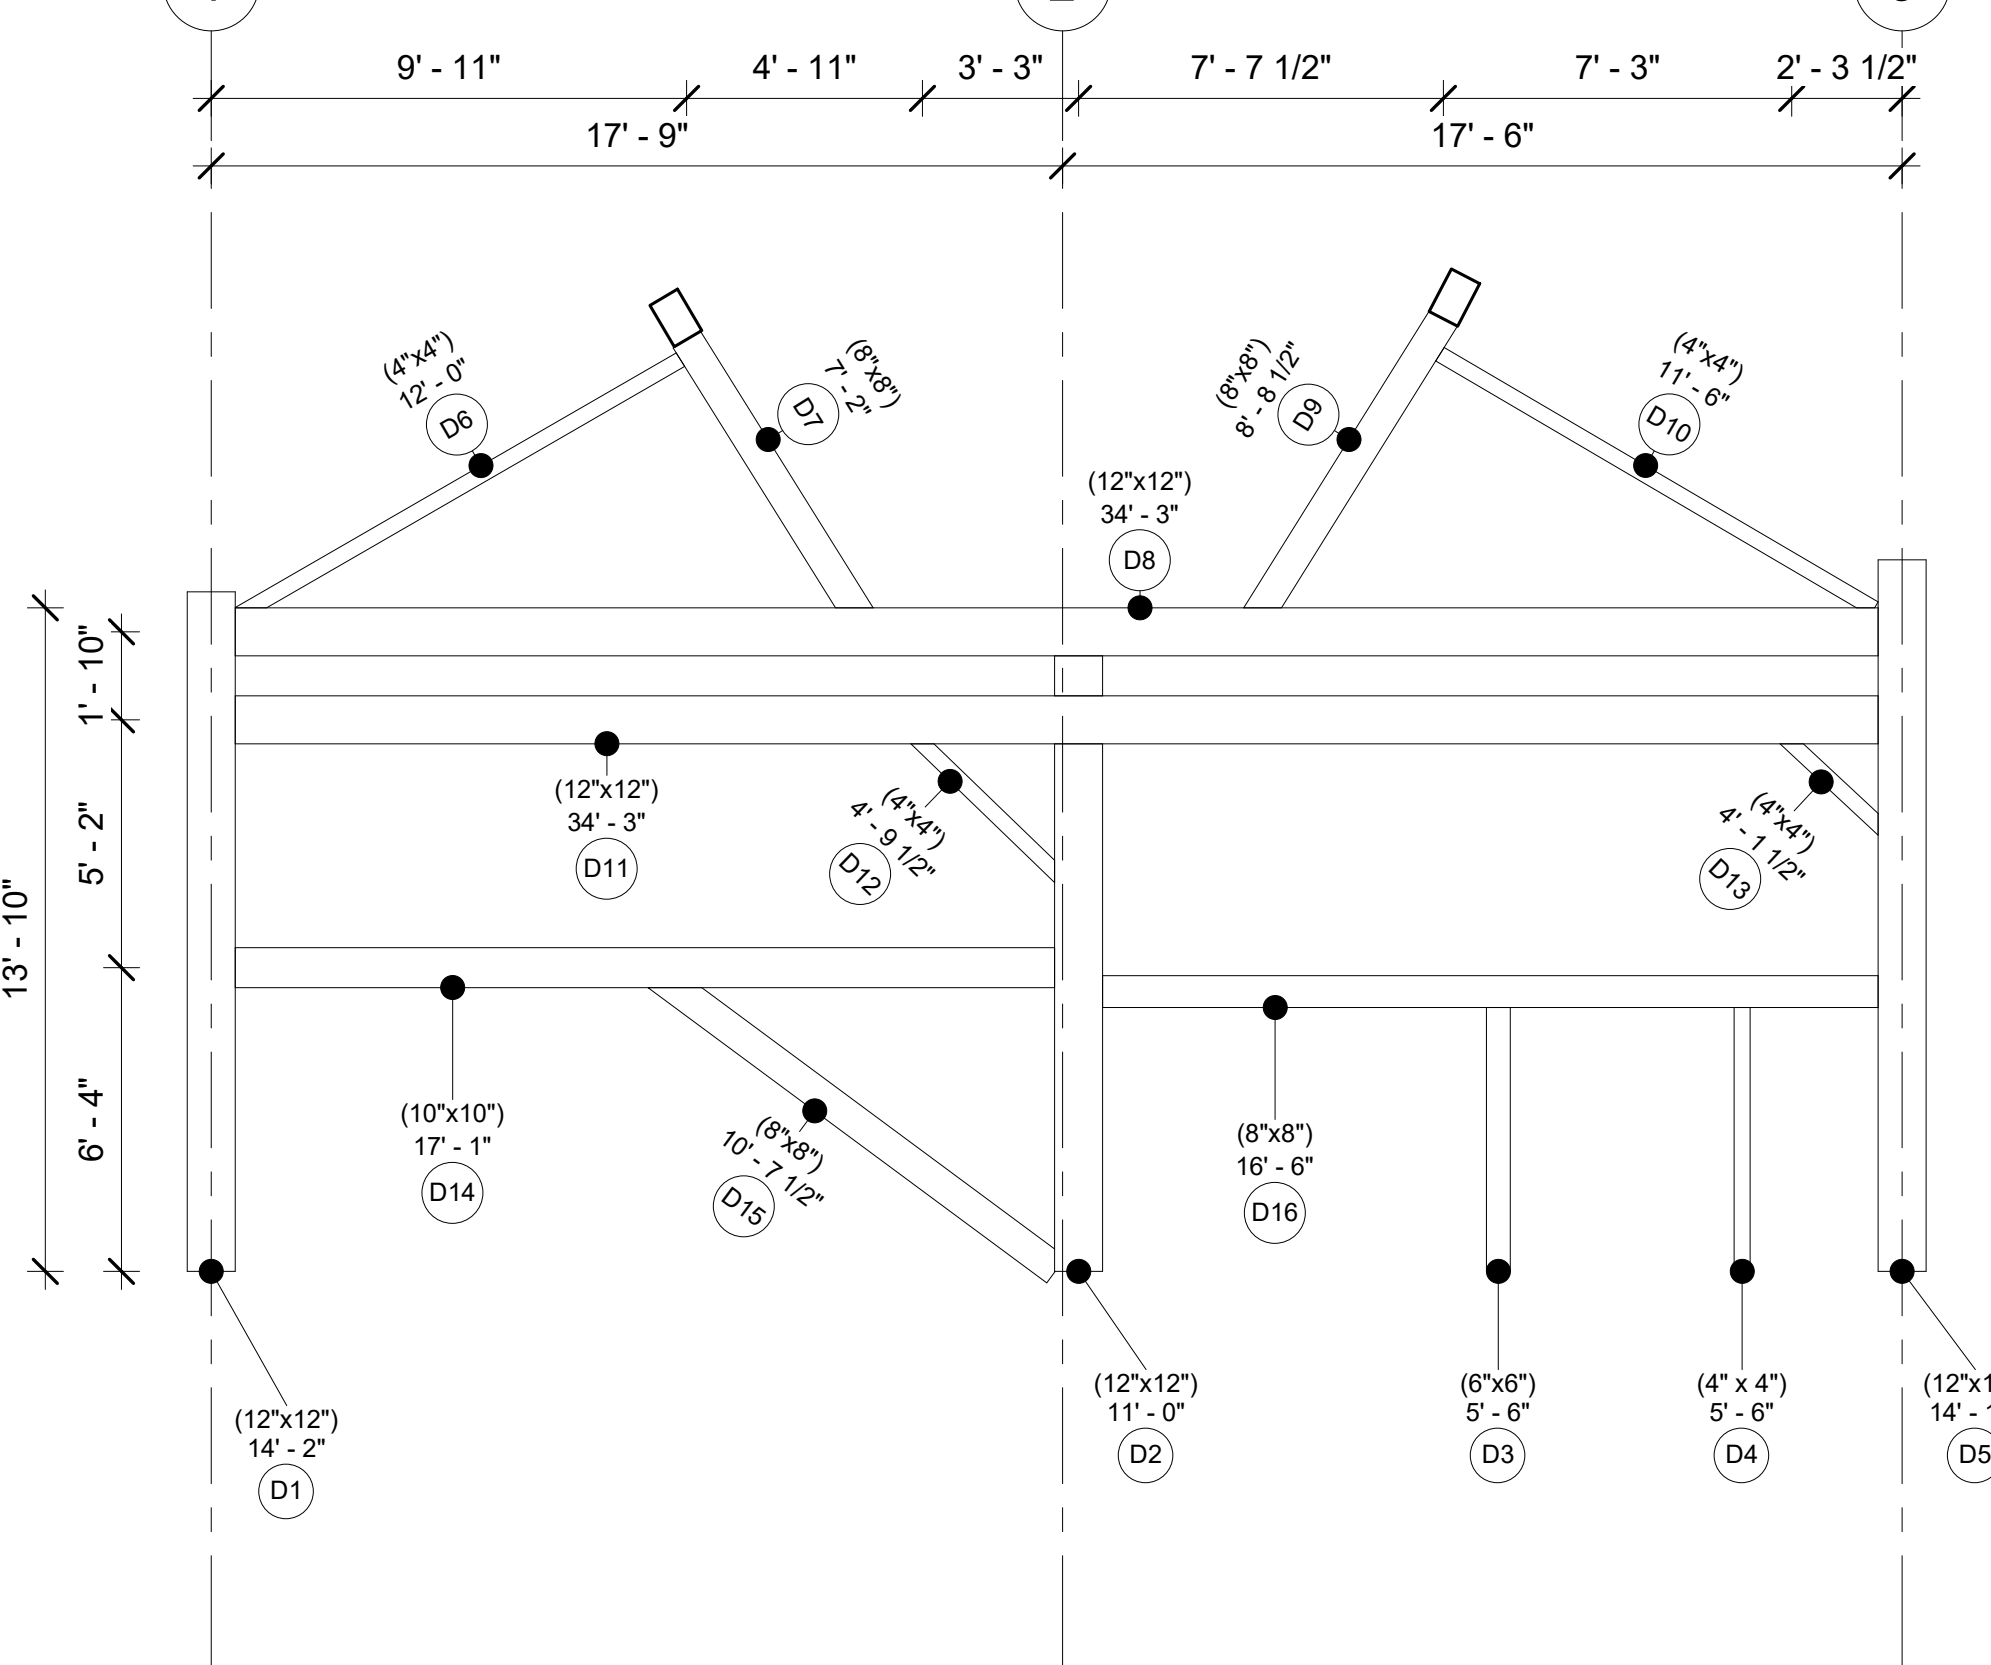

Bent D

Project Number	Project 16
----------------	------------

Date	20250623
------	----------

Drawn By	
----------	--

Checked By	
------------	--

A106


Scale	1/4" = 1'-0"
-------	--------------

Timber
Home
Services LLC

Whitetail Hollow

DAN TRIMBLE
AA66 / TIMBER HOME SERVICES
CELL PHONE/TEXT - 412-309-1161

EMAIL:
DANTRIMBLE@TIMBERHOMESERVICES.COM

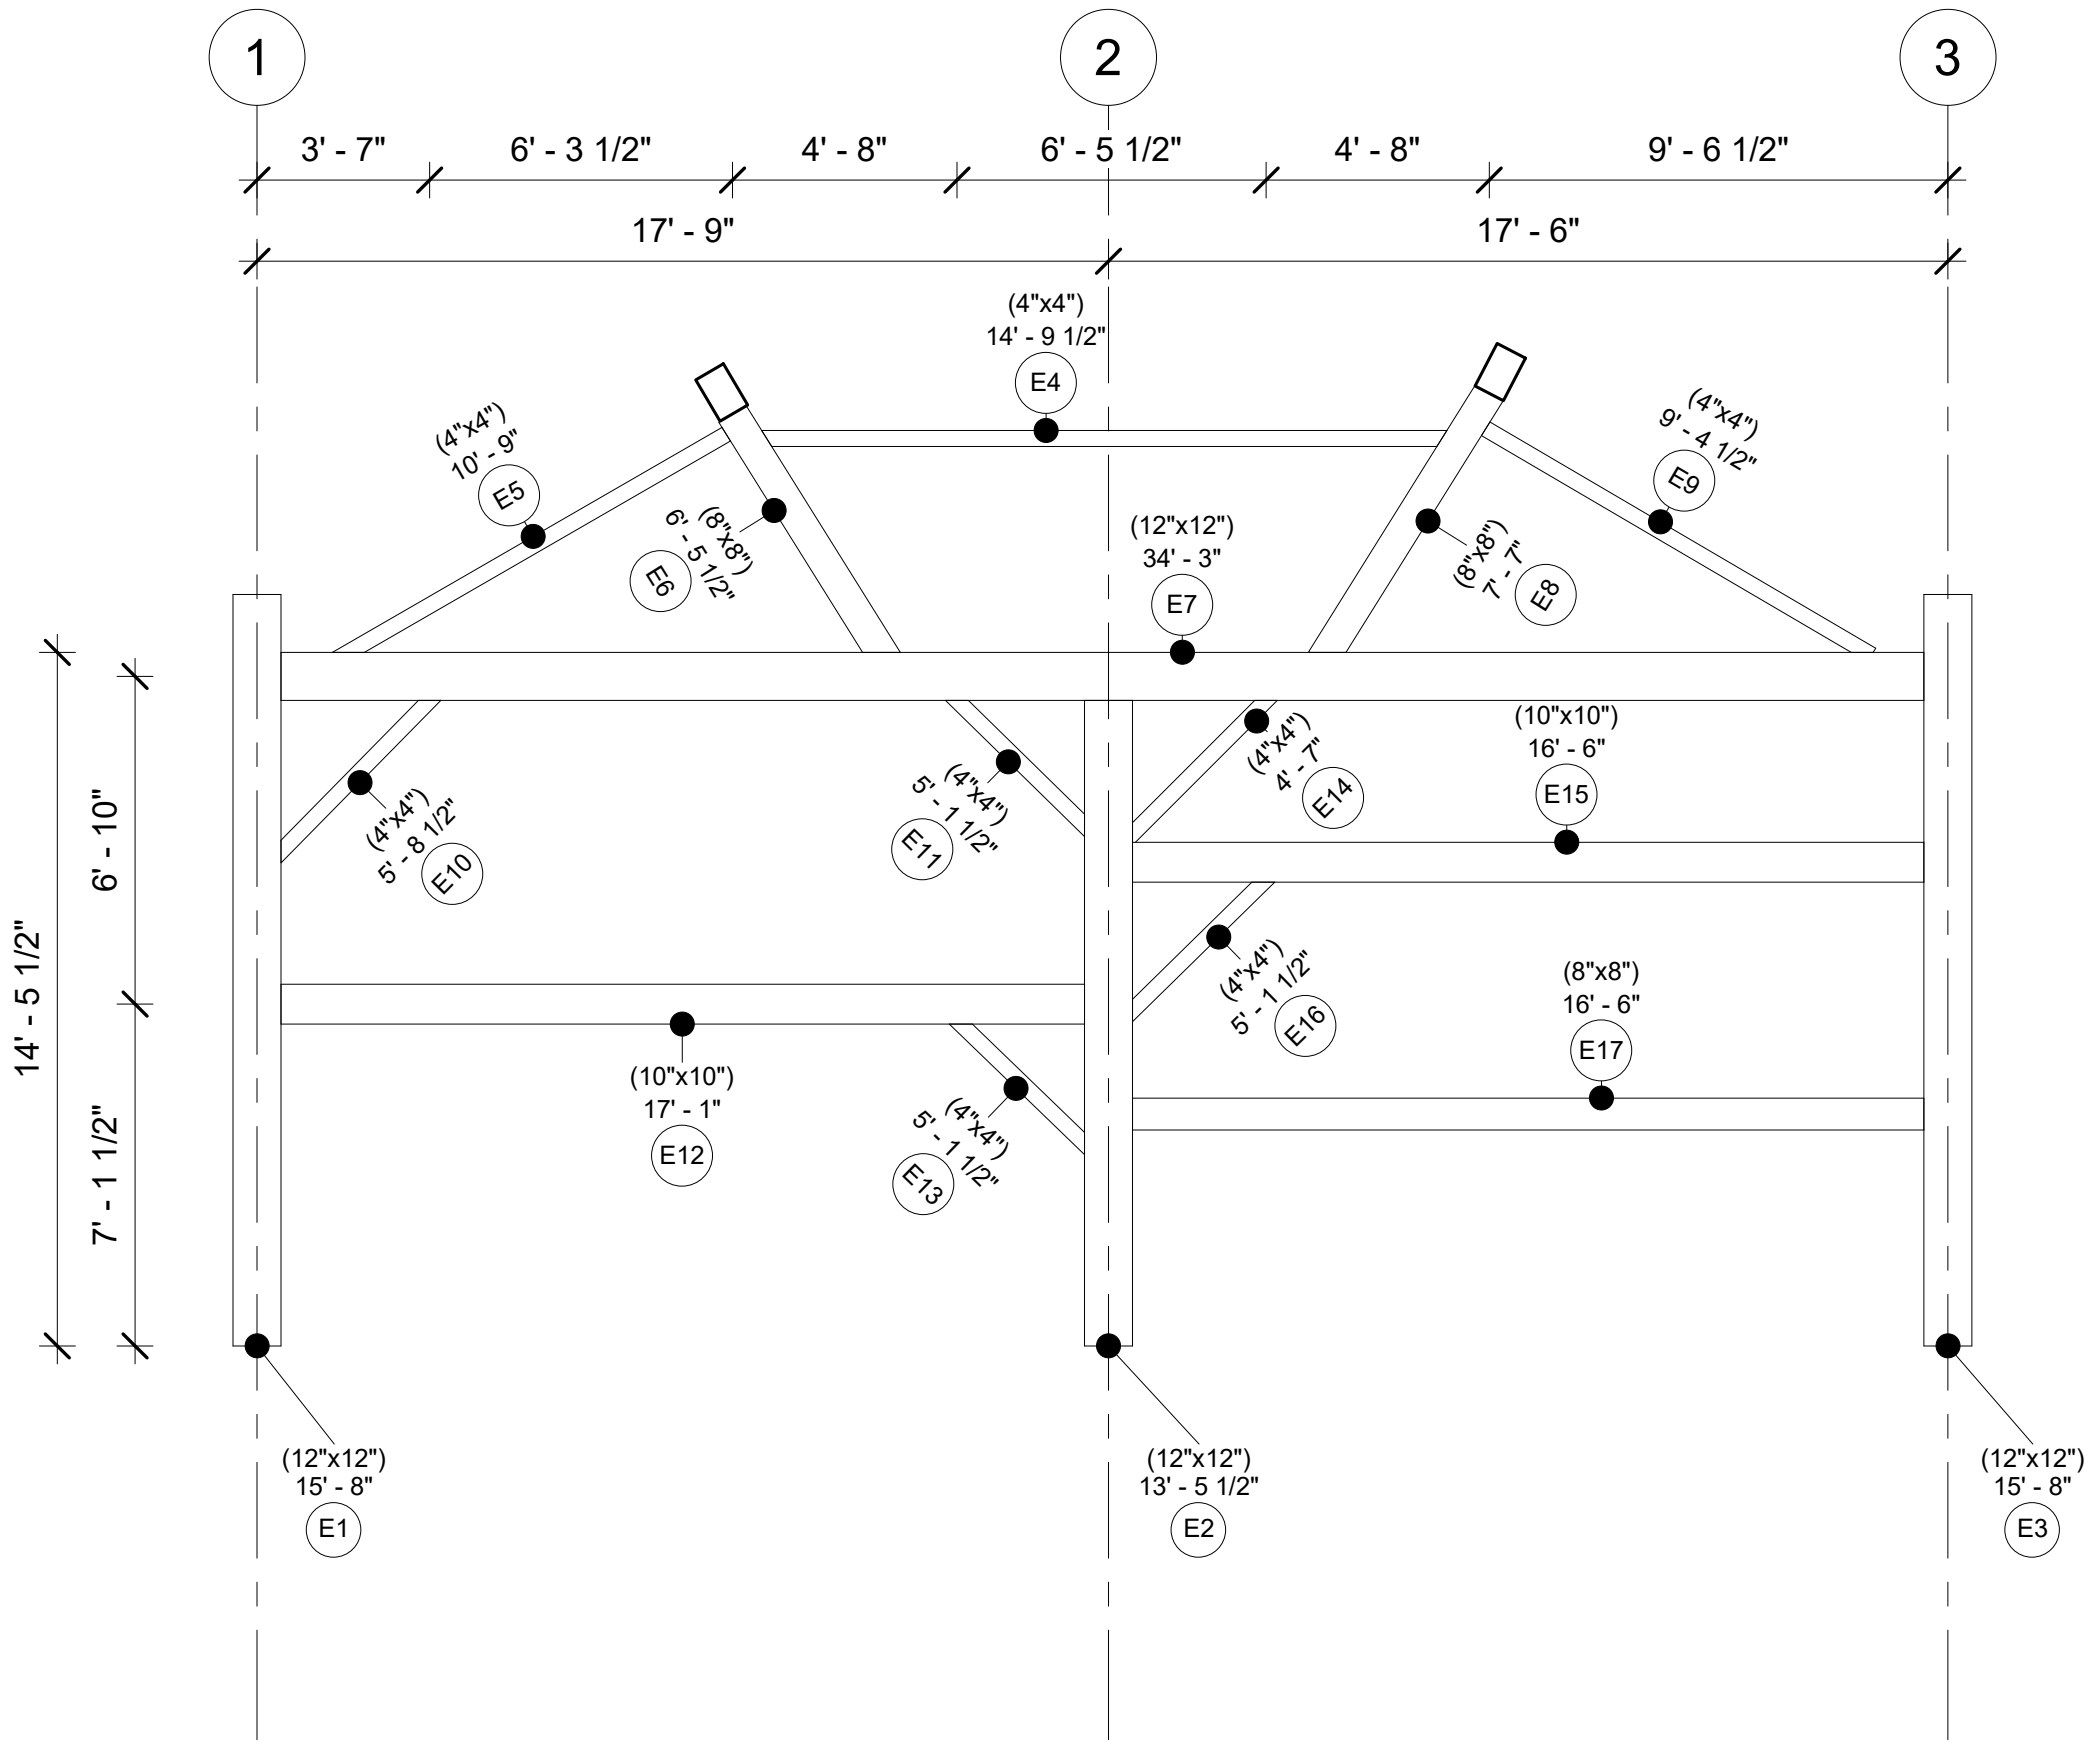

Bent E


Project Number	Project 16
Date	20250623
Drawn By	
Checked By	
A107	
Scale	1/4" = 1'-0"

Timber
Home
Services LLC

Whitetail Hollow

DAN TRIMBLE
AA66 / TIMBER HOME SERVICES
CELL PHONE/TEXT - 412-309-1161

EMAIL:
DANTRIMBLE@TIMBERHOMESERVICES.COM

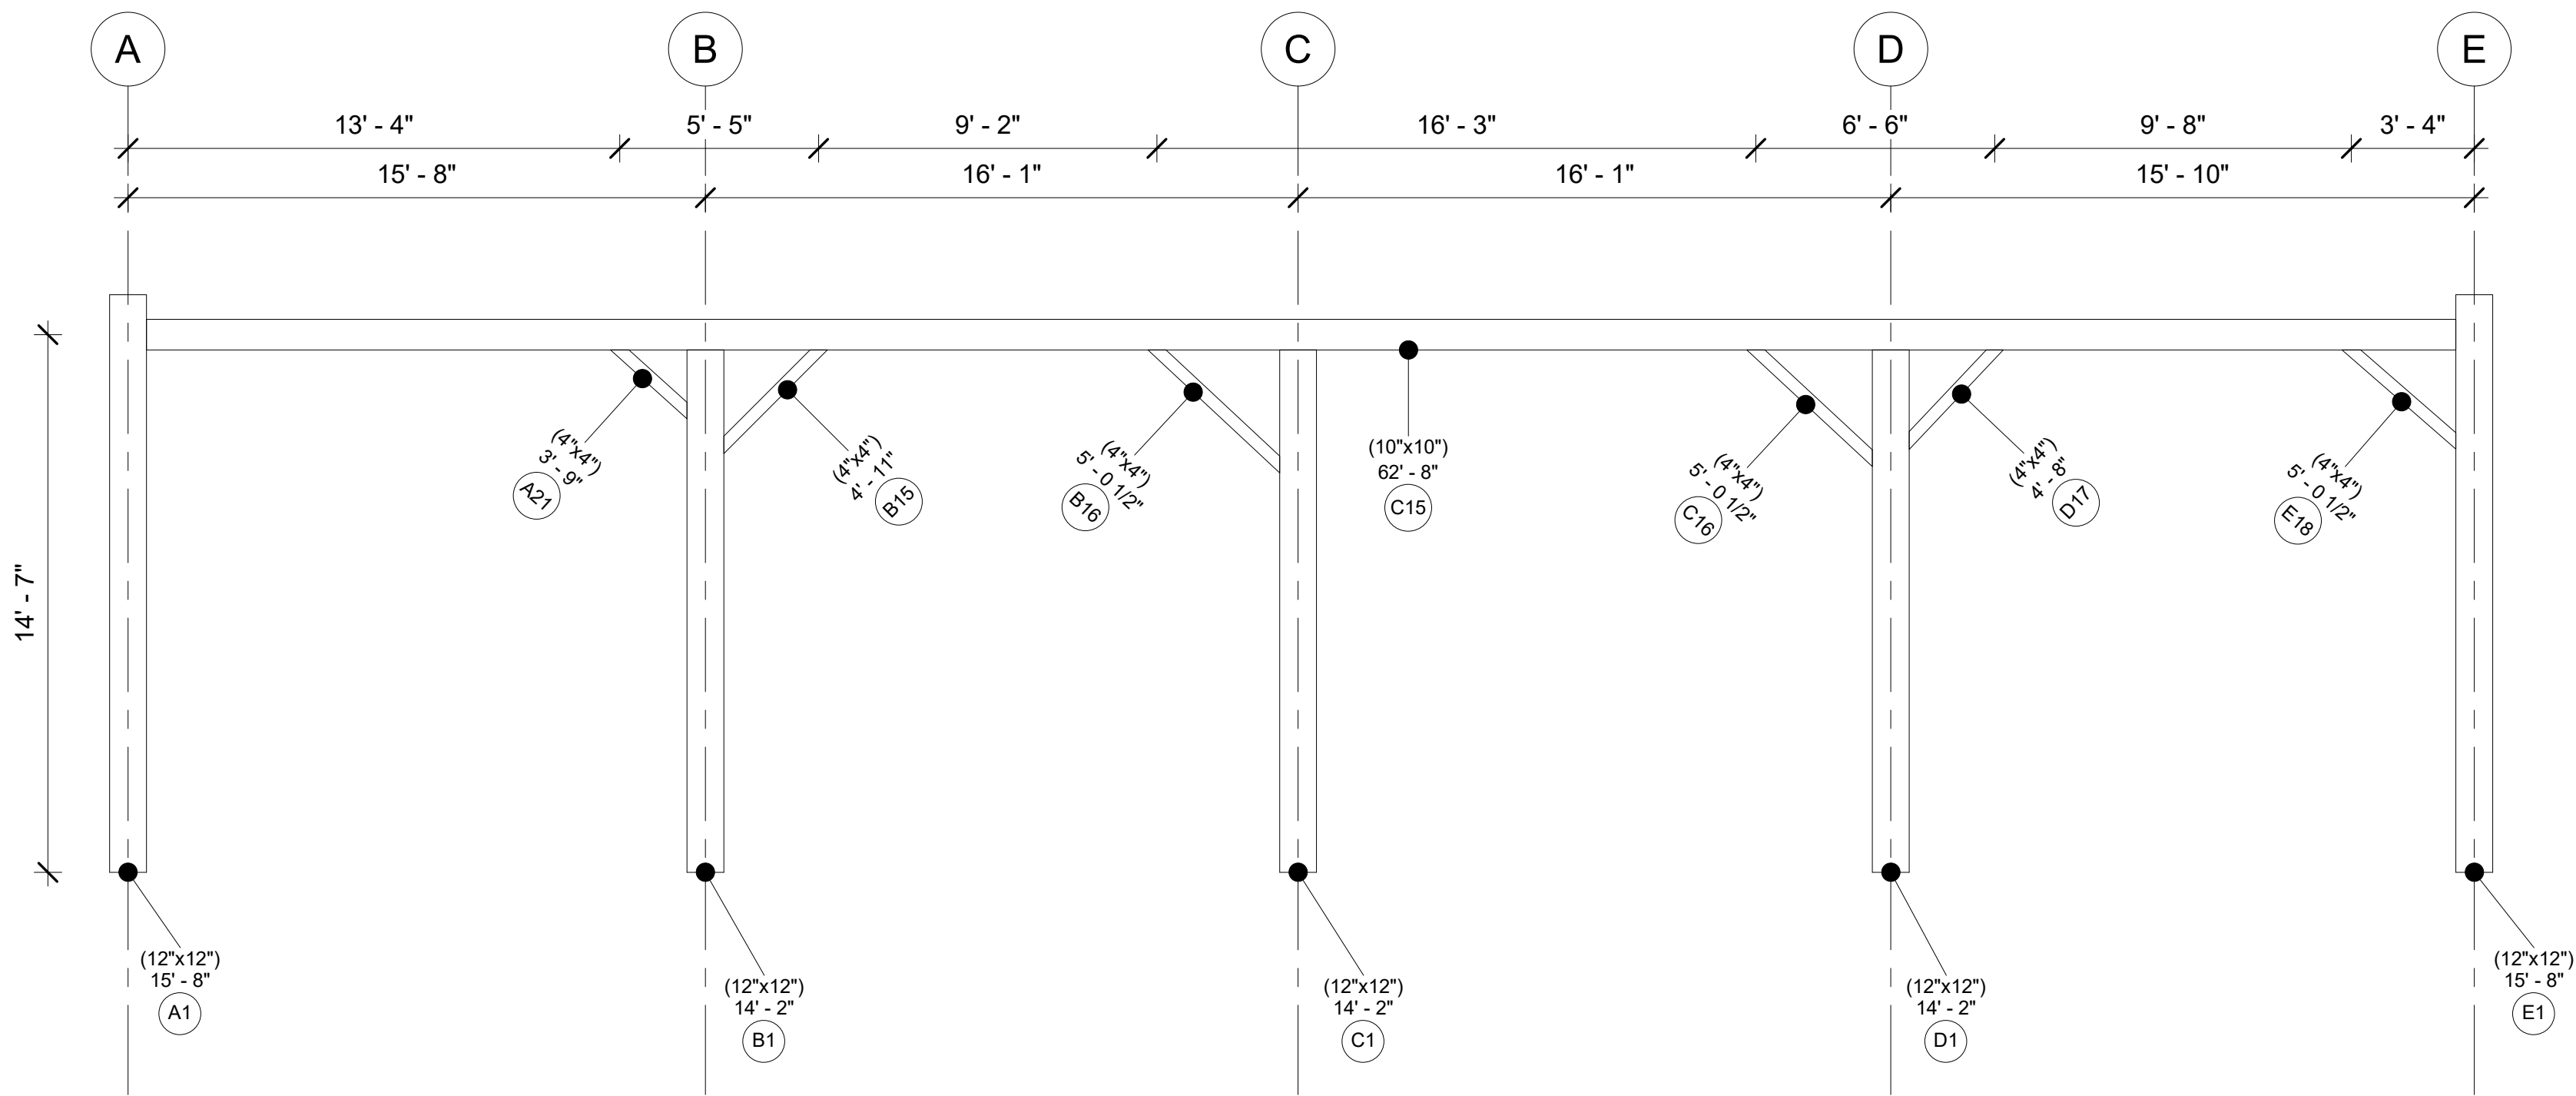

Bent 1

Project Number Project 16
Date 20250623
Drawn By
Checked By

A108


Scale 1/4" = 1'-0"

Timber
Home
Services LLC

Whitetail Hollow

DAN TRIMBLE
AA66 / TIMBER HOME SERVICES
CELL PHONE/TEXT - 412-309-1161

EMAIL:
DANTRIMBLE@TIMBERHOMESERVICES.COM

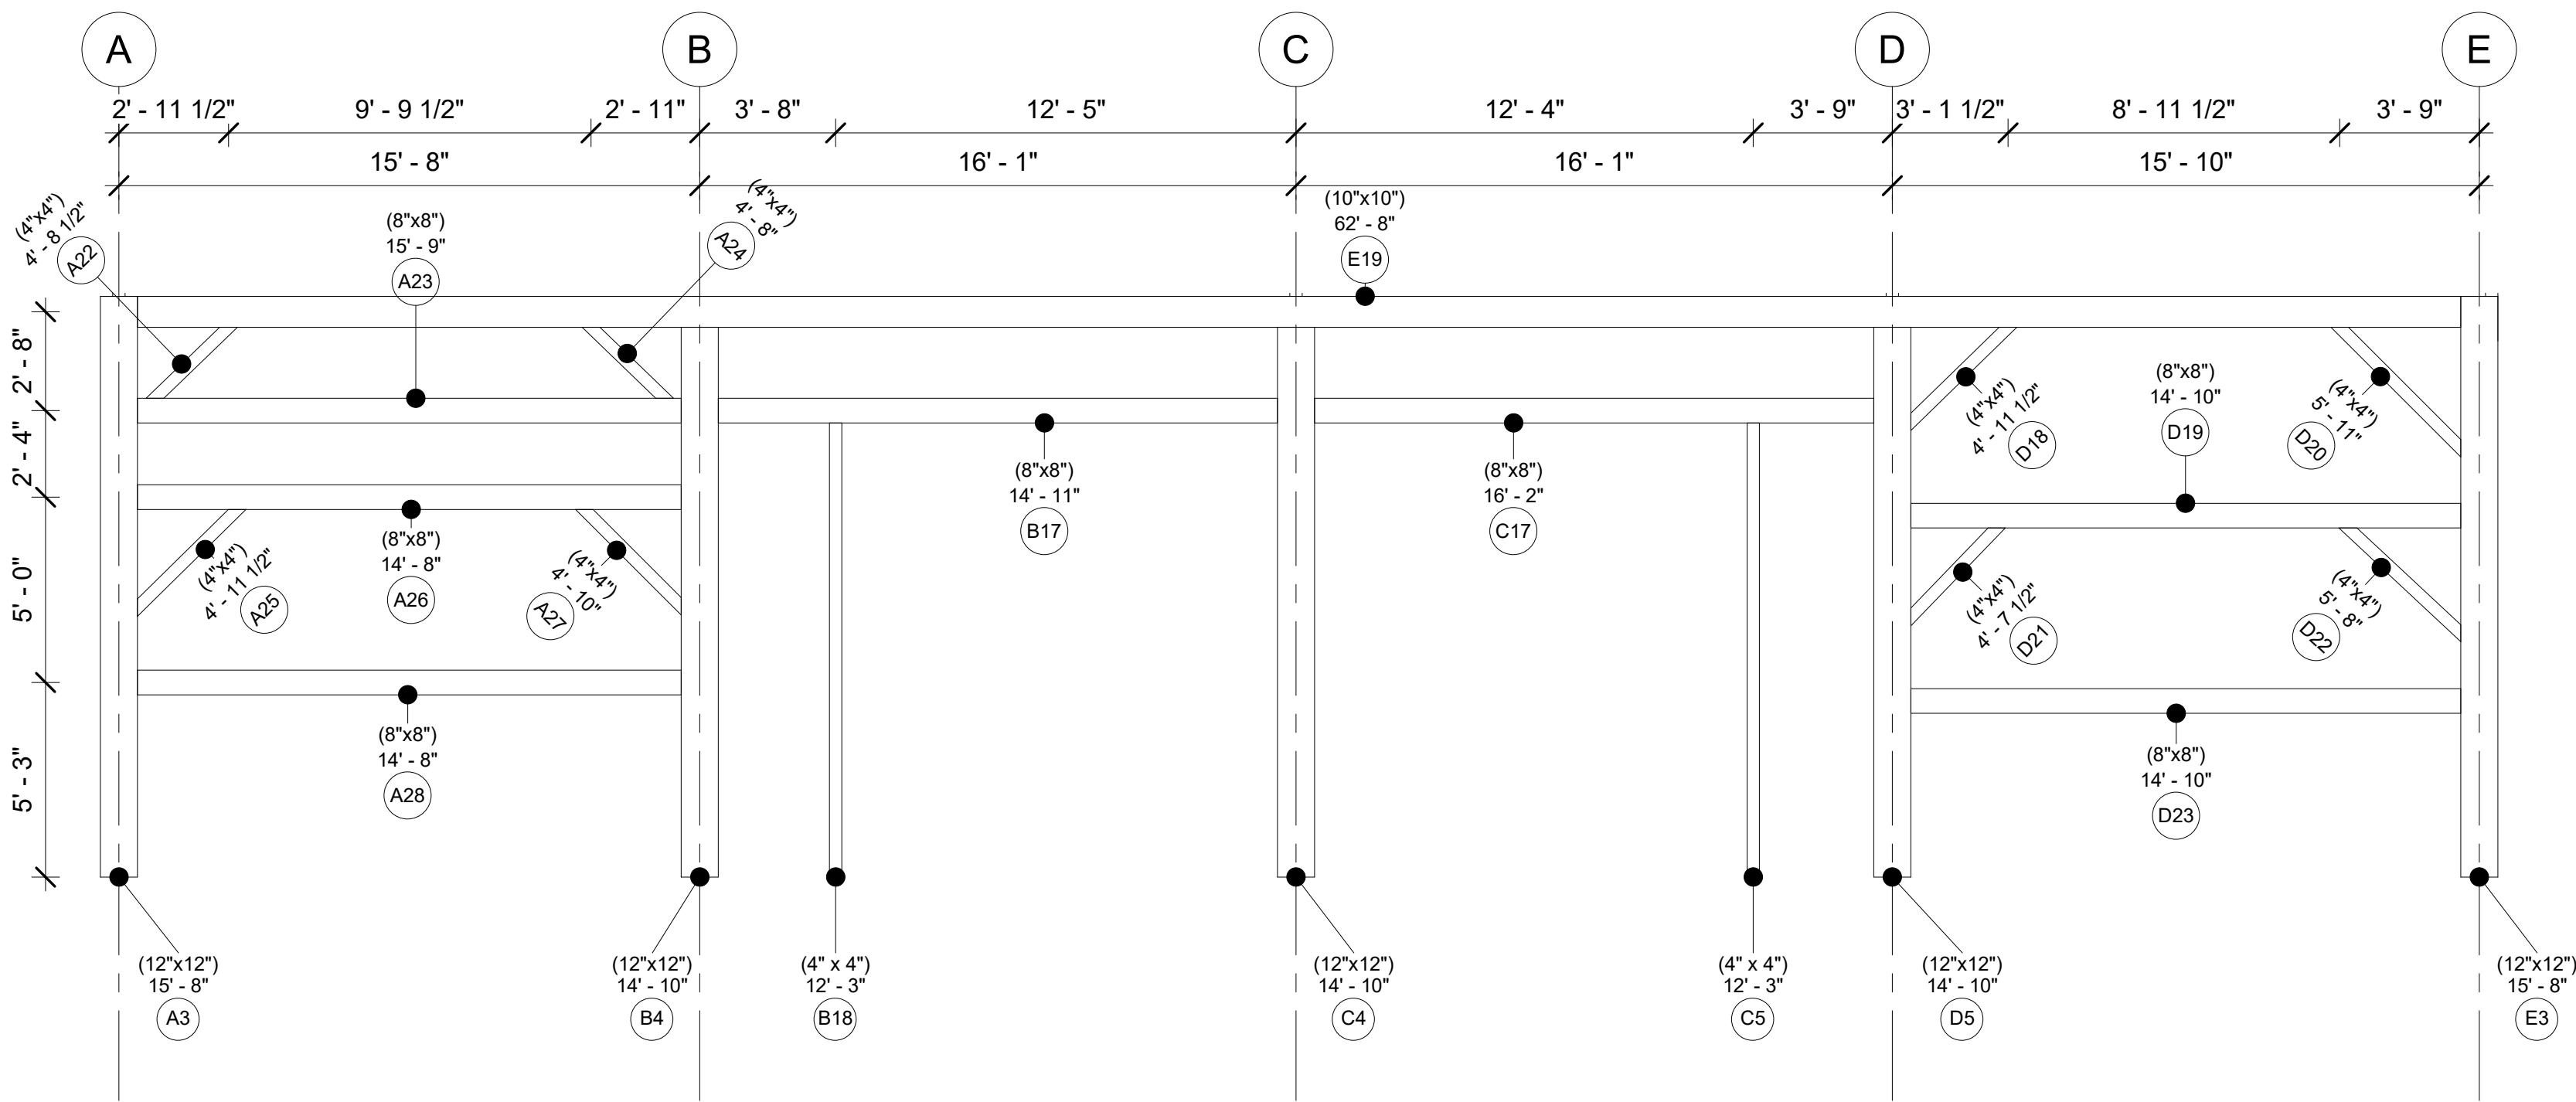

Bent 3

Project Number Project 16
Date 20250623
Drawn By
Checked By

A109

Scale 1/4" = 1'-0"