


PROJECT: Heritage Haven

SCOPE: AS BUILT DRAWINGS

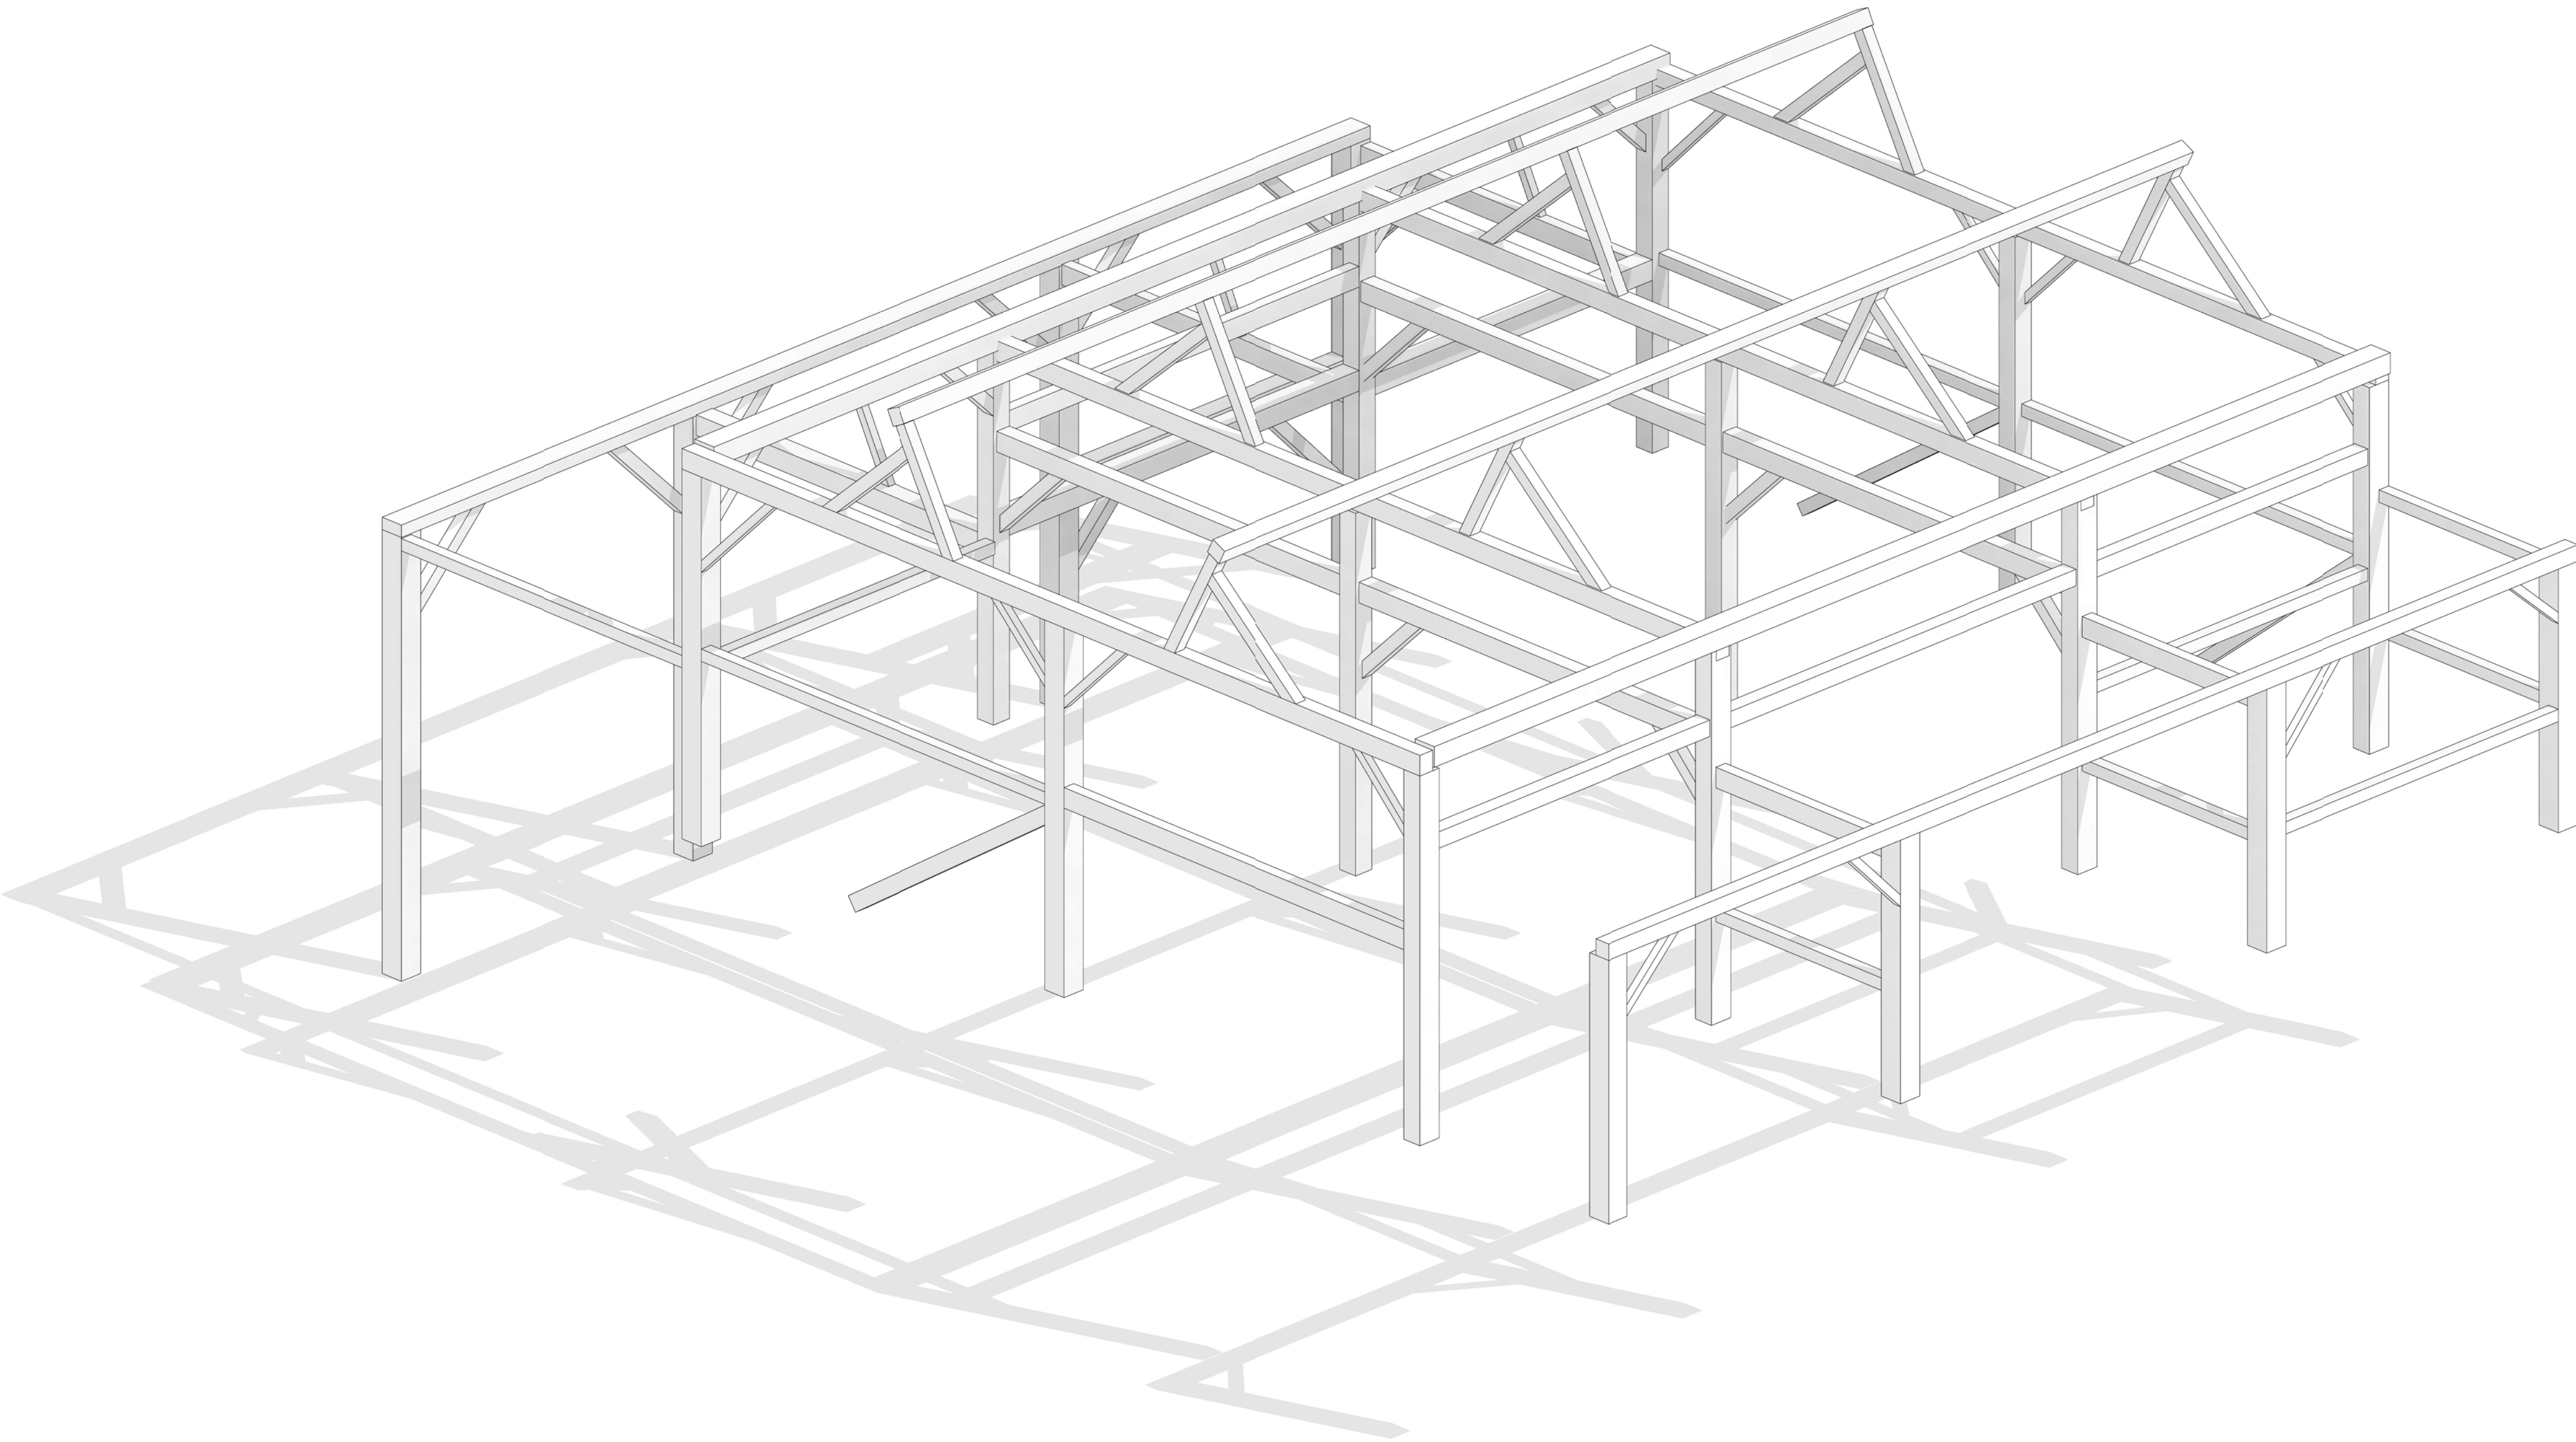

Timber
Home
Services LLC

Heritage Haven

DAN TRIMBLE
AA66 / TIMBER HOME SERVICES
CELL PHONE/TEXT - 412-309-1161

EMAIL:
DANTRIMBLE@TIMBERHOMESERVICES.COM

Cover Page

Project Number	Project 18
Date	20250724
Drawn By	
Checked By	

A101

Scale

Timber
Home
Services LLC

Heritage Haven

DAN TRIMBLE
AA66 / TIMBER HOME SERVICES
CELL PHONE/TEXT - 412-309-1161


EMAIL:
DANTRIMBLE@TIMBERHOMESERVICES.COM

Floor Plan

Project Number	Project 18
Date	20250724
Drawn By	
Checked By	

A102

Scale 1/4" = 1'-0"

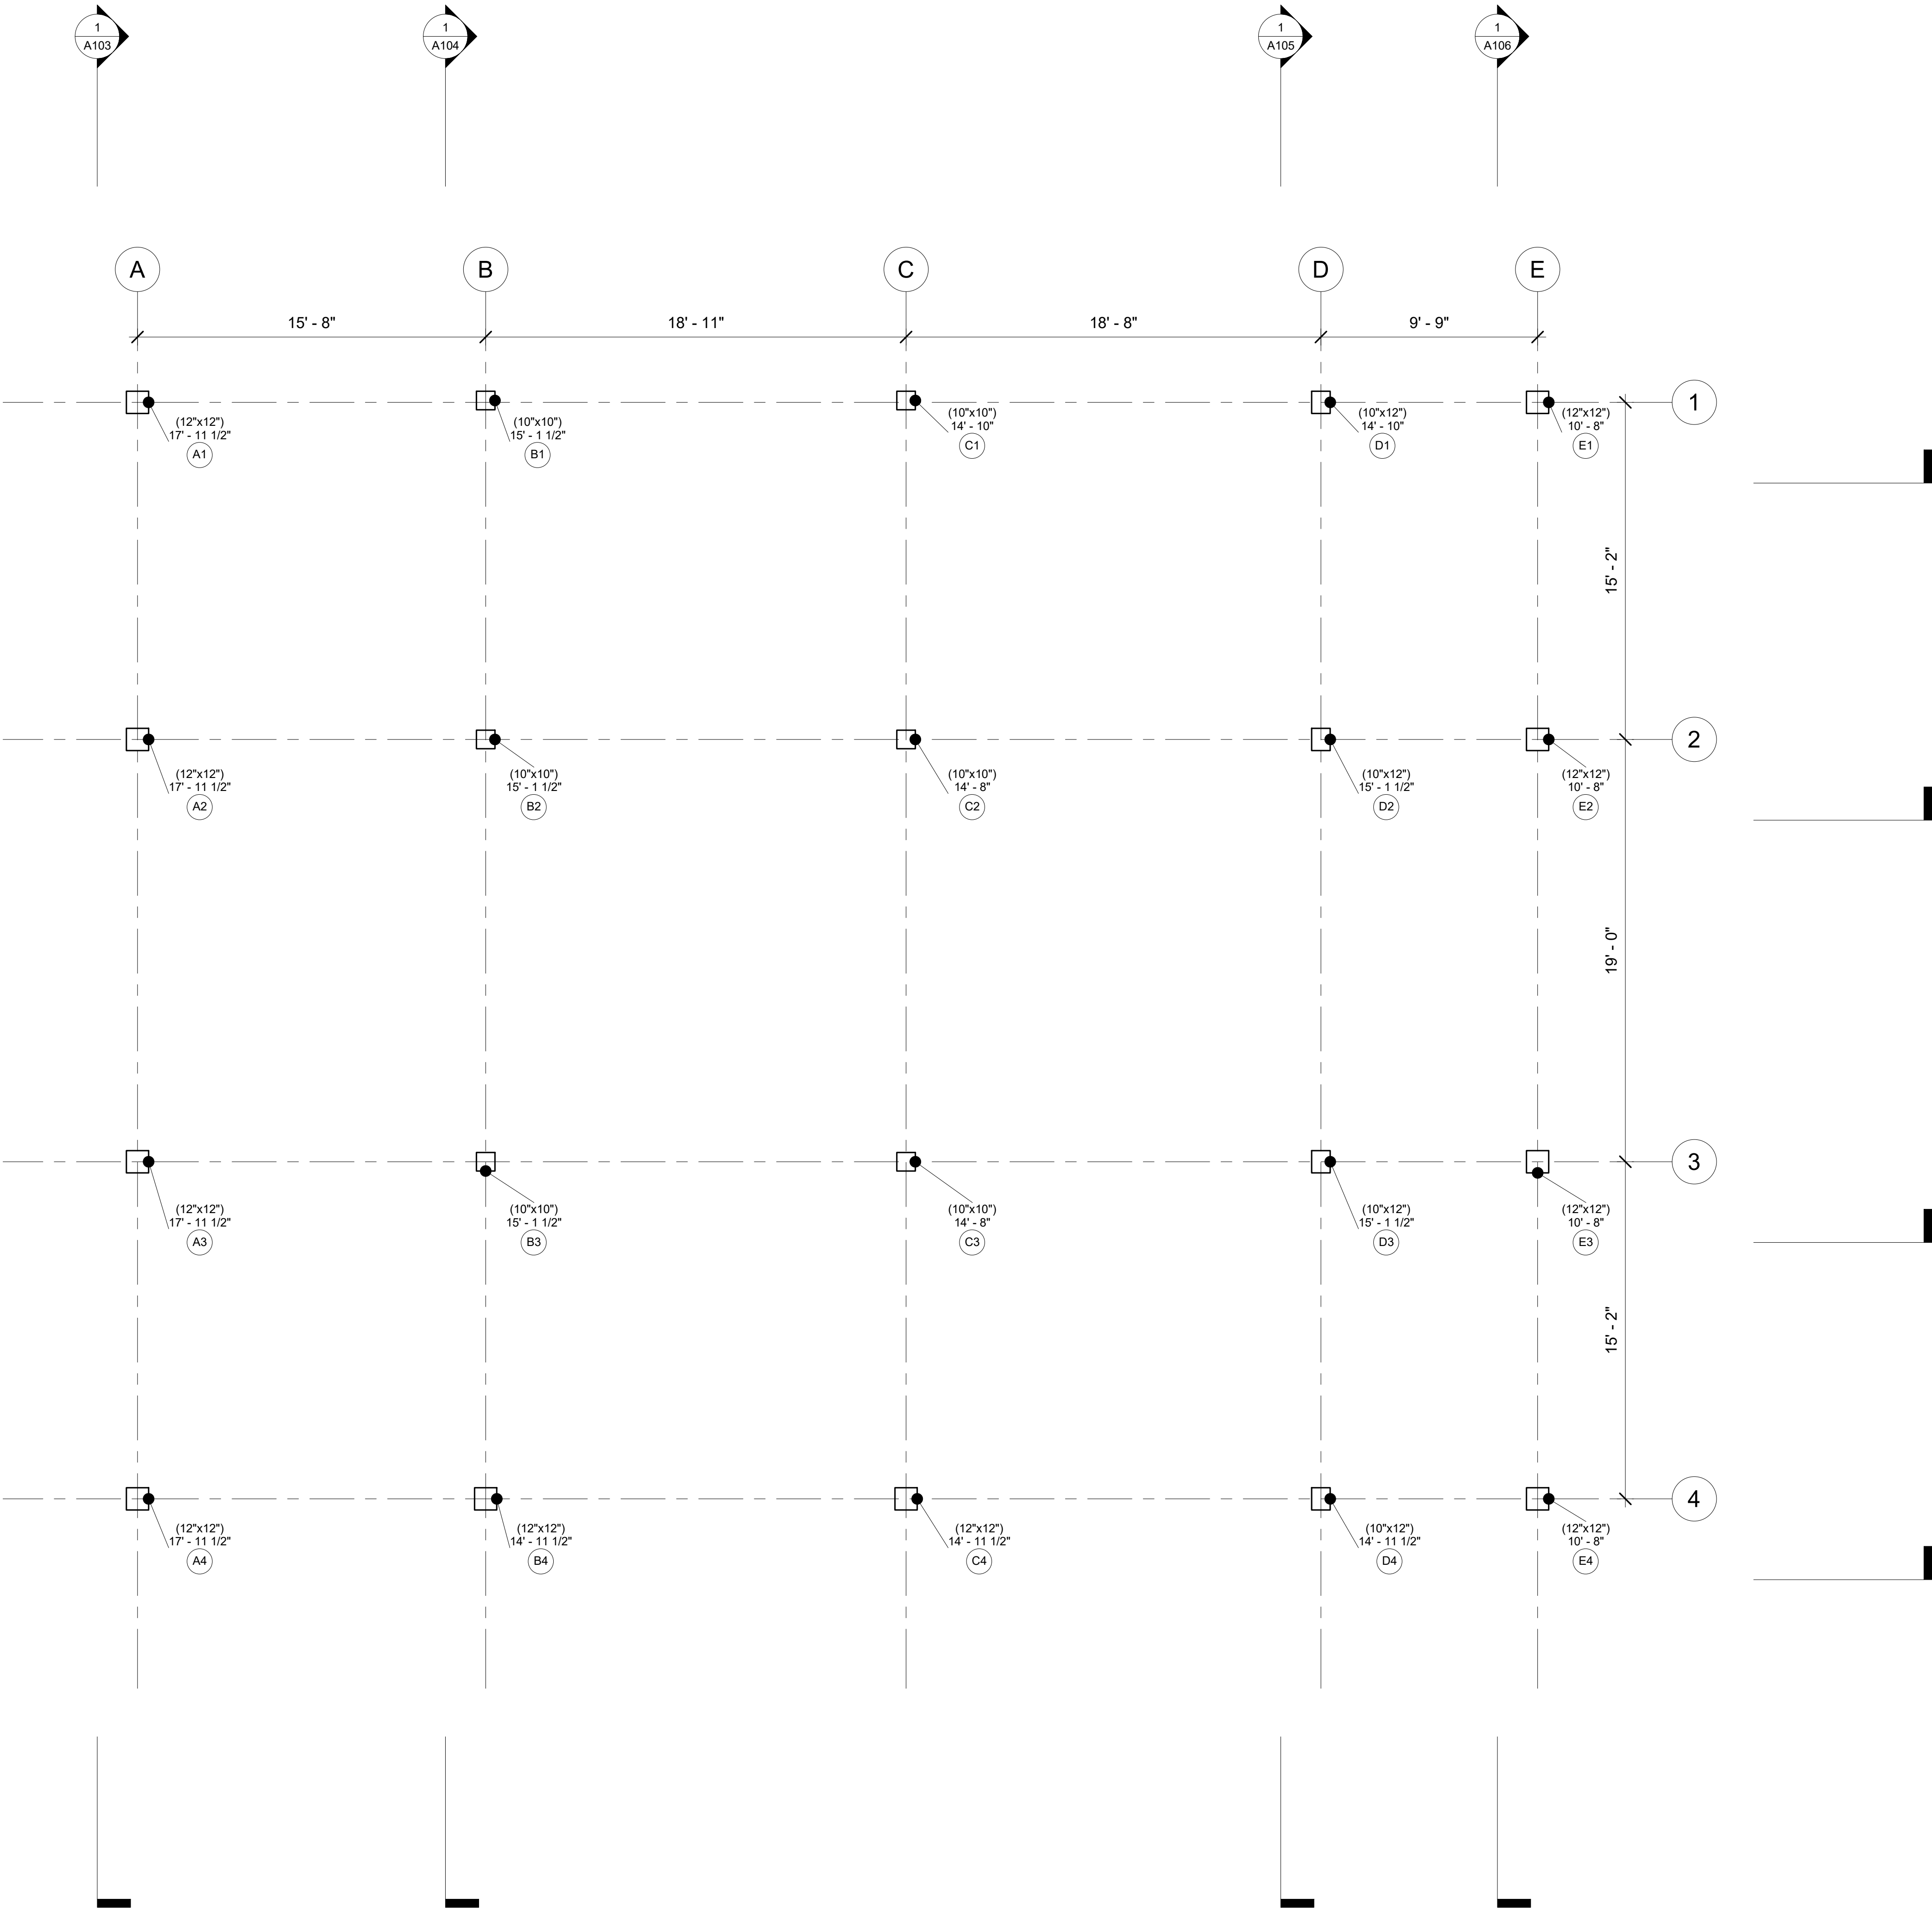


Timber
Home
Services LLC

Heritage Haven

DAN TRIMBLE
AA66 / TIMBER HOME SERVICES
CELL PHONE/TEXT - 412-309-1161

EMAIL:
DANTRIMBLE@TIMBERHOMESERVICES.COM

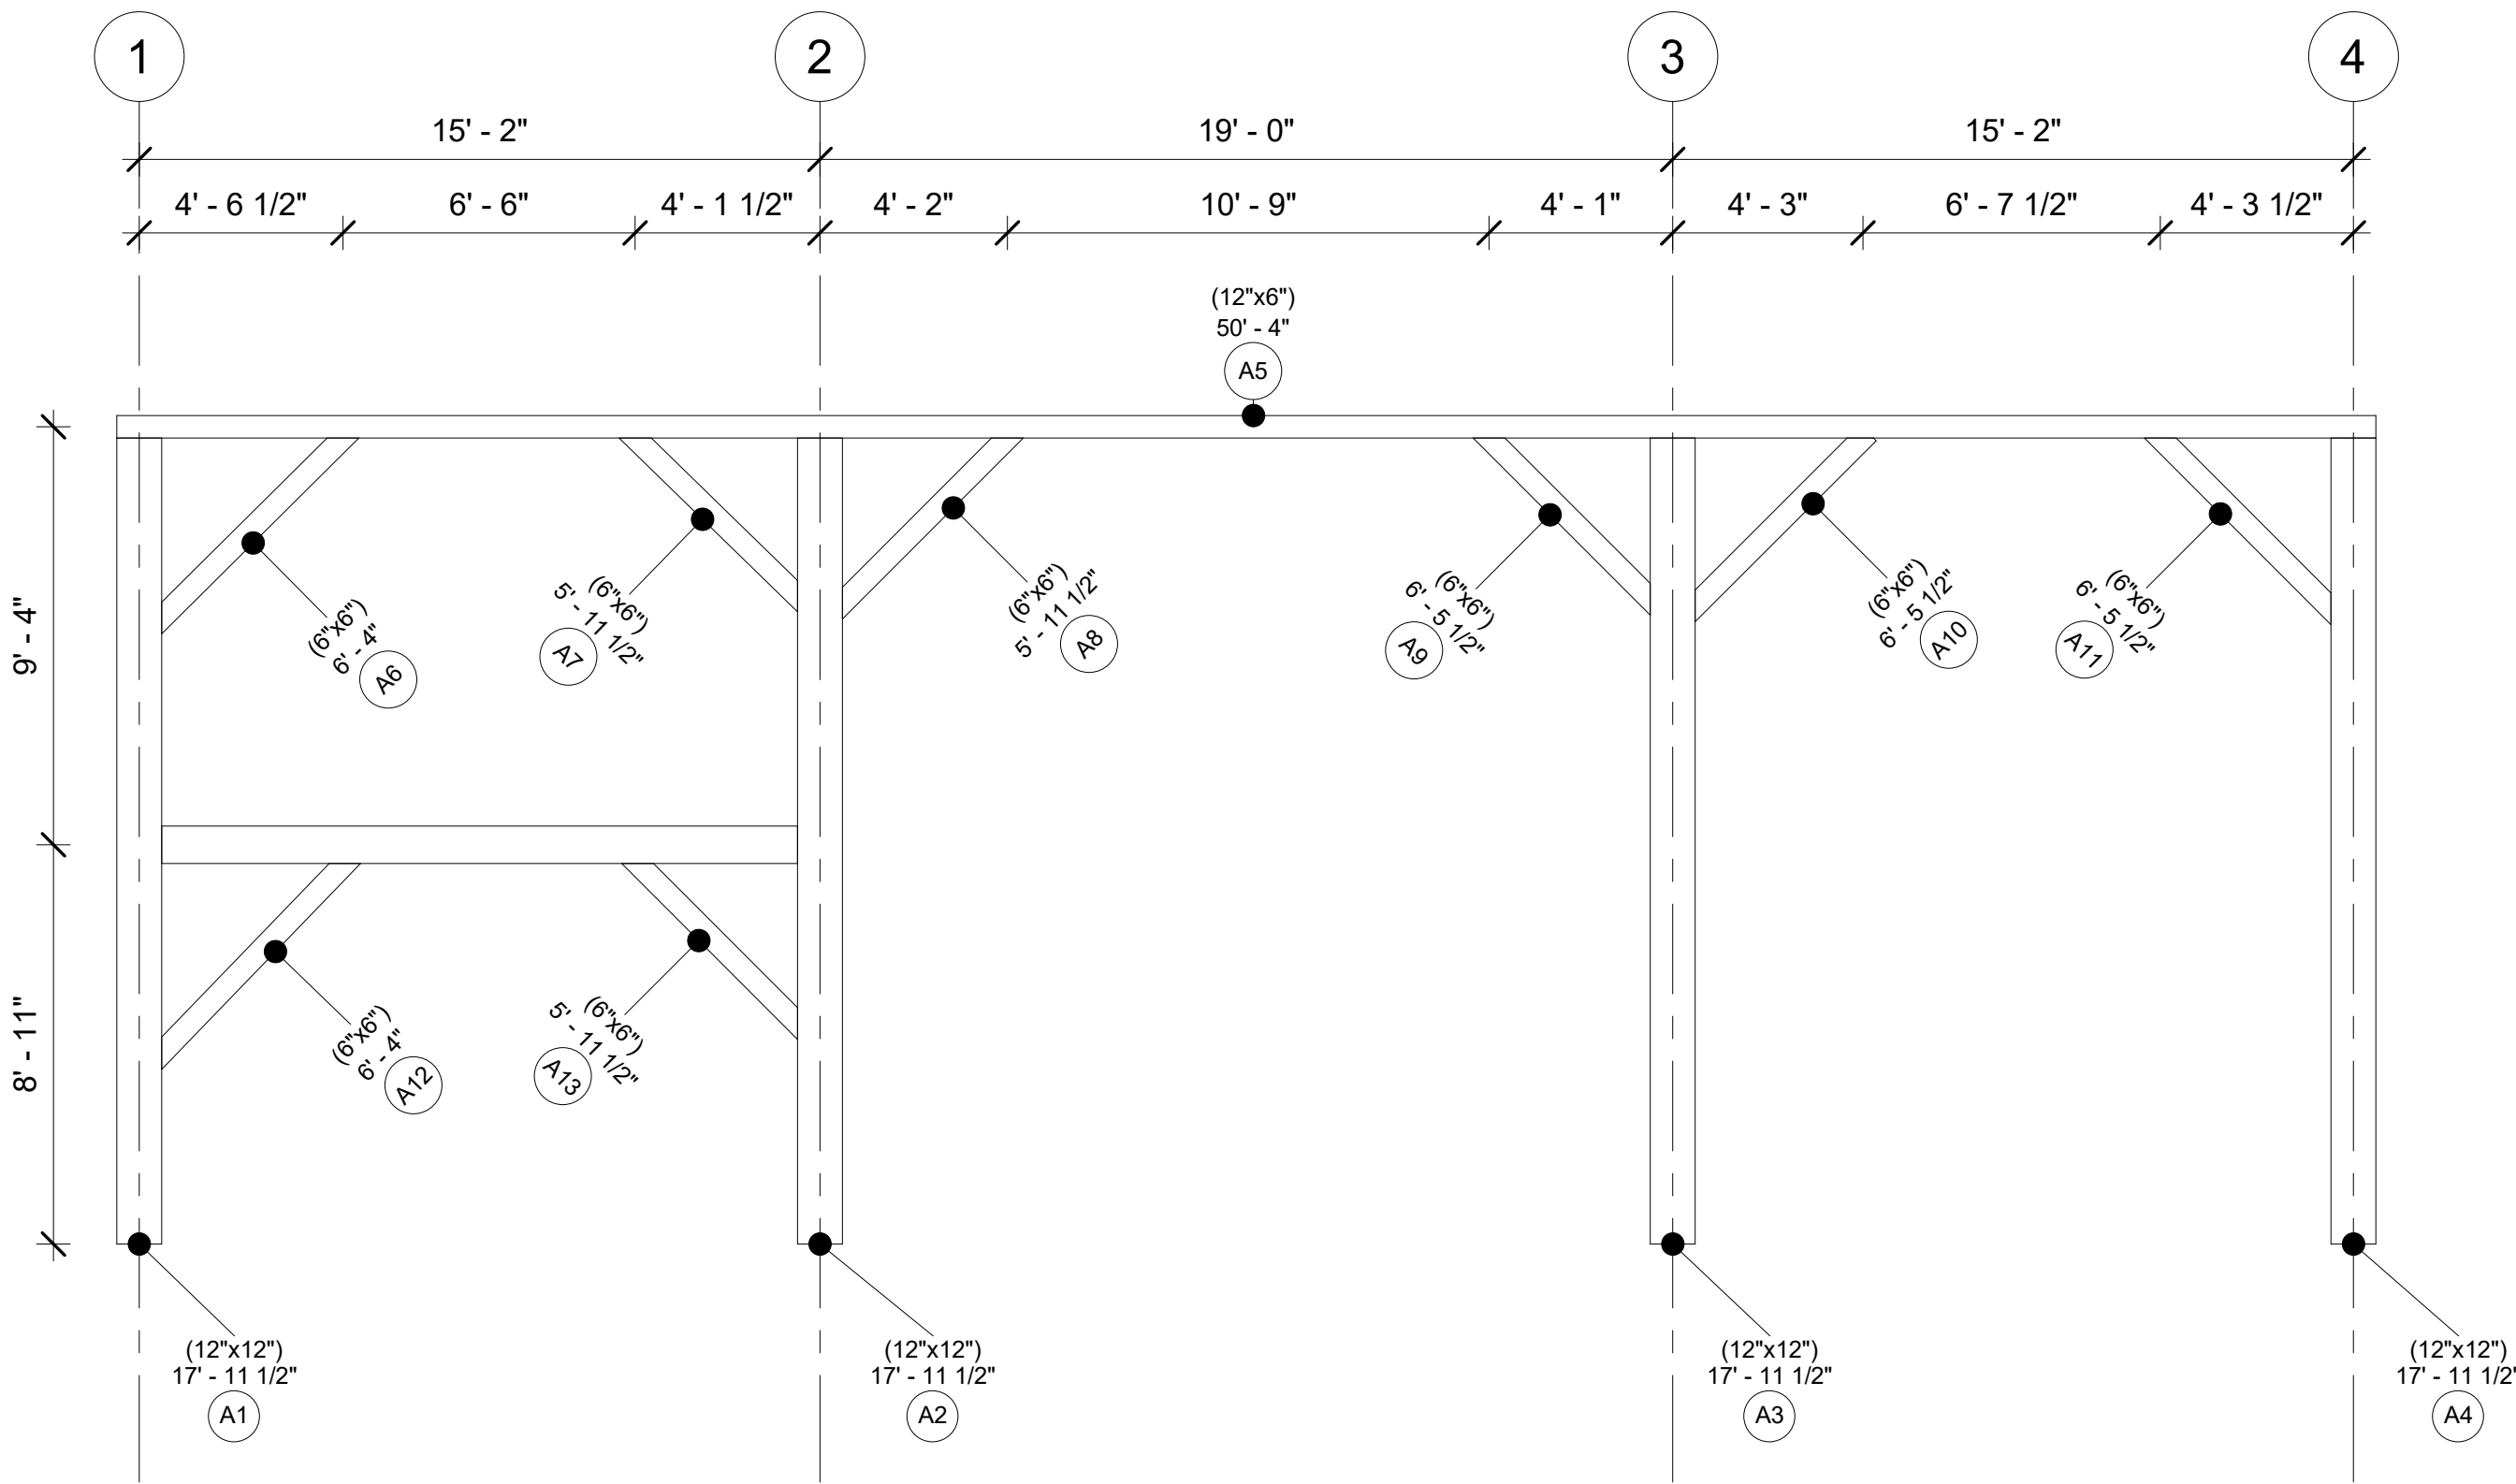

Bent A


Project Number	Project 18
Date	20250724
Drawn By	
Checked By	
A103	
Scale	1/4" = 1'-0"

Timber
Home
Services LLC

Heritage Haven

DAN TRIMBLE
AA66 / TIMBER HOME SERVICES
CELL PHONE/TEXT - 412-309-1161

EMAIL:
DANTRIMBLE@TIMBERHOMESERVICES.COM

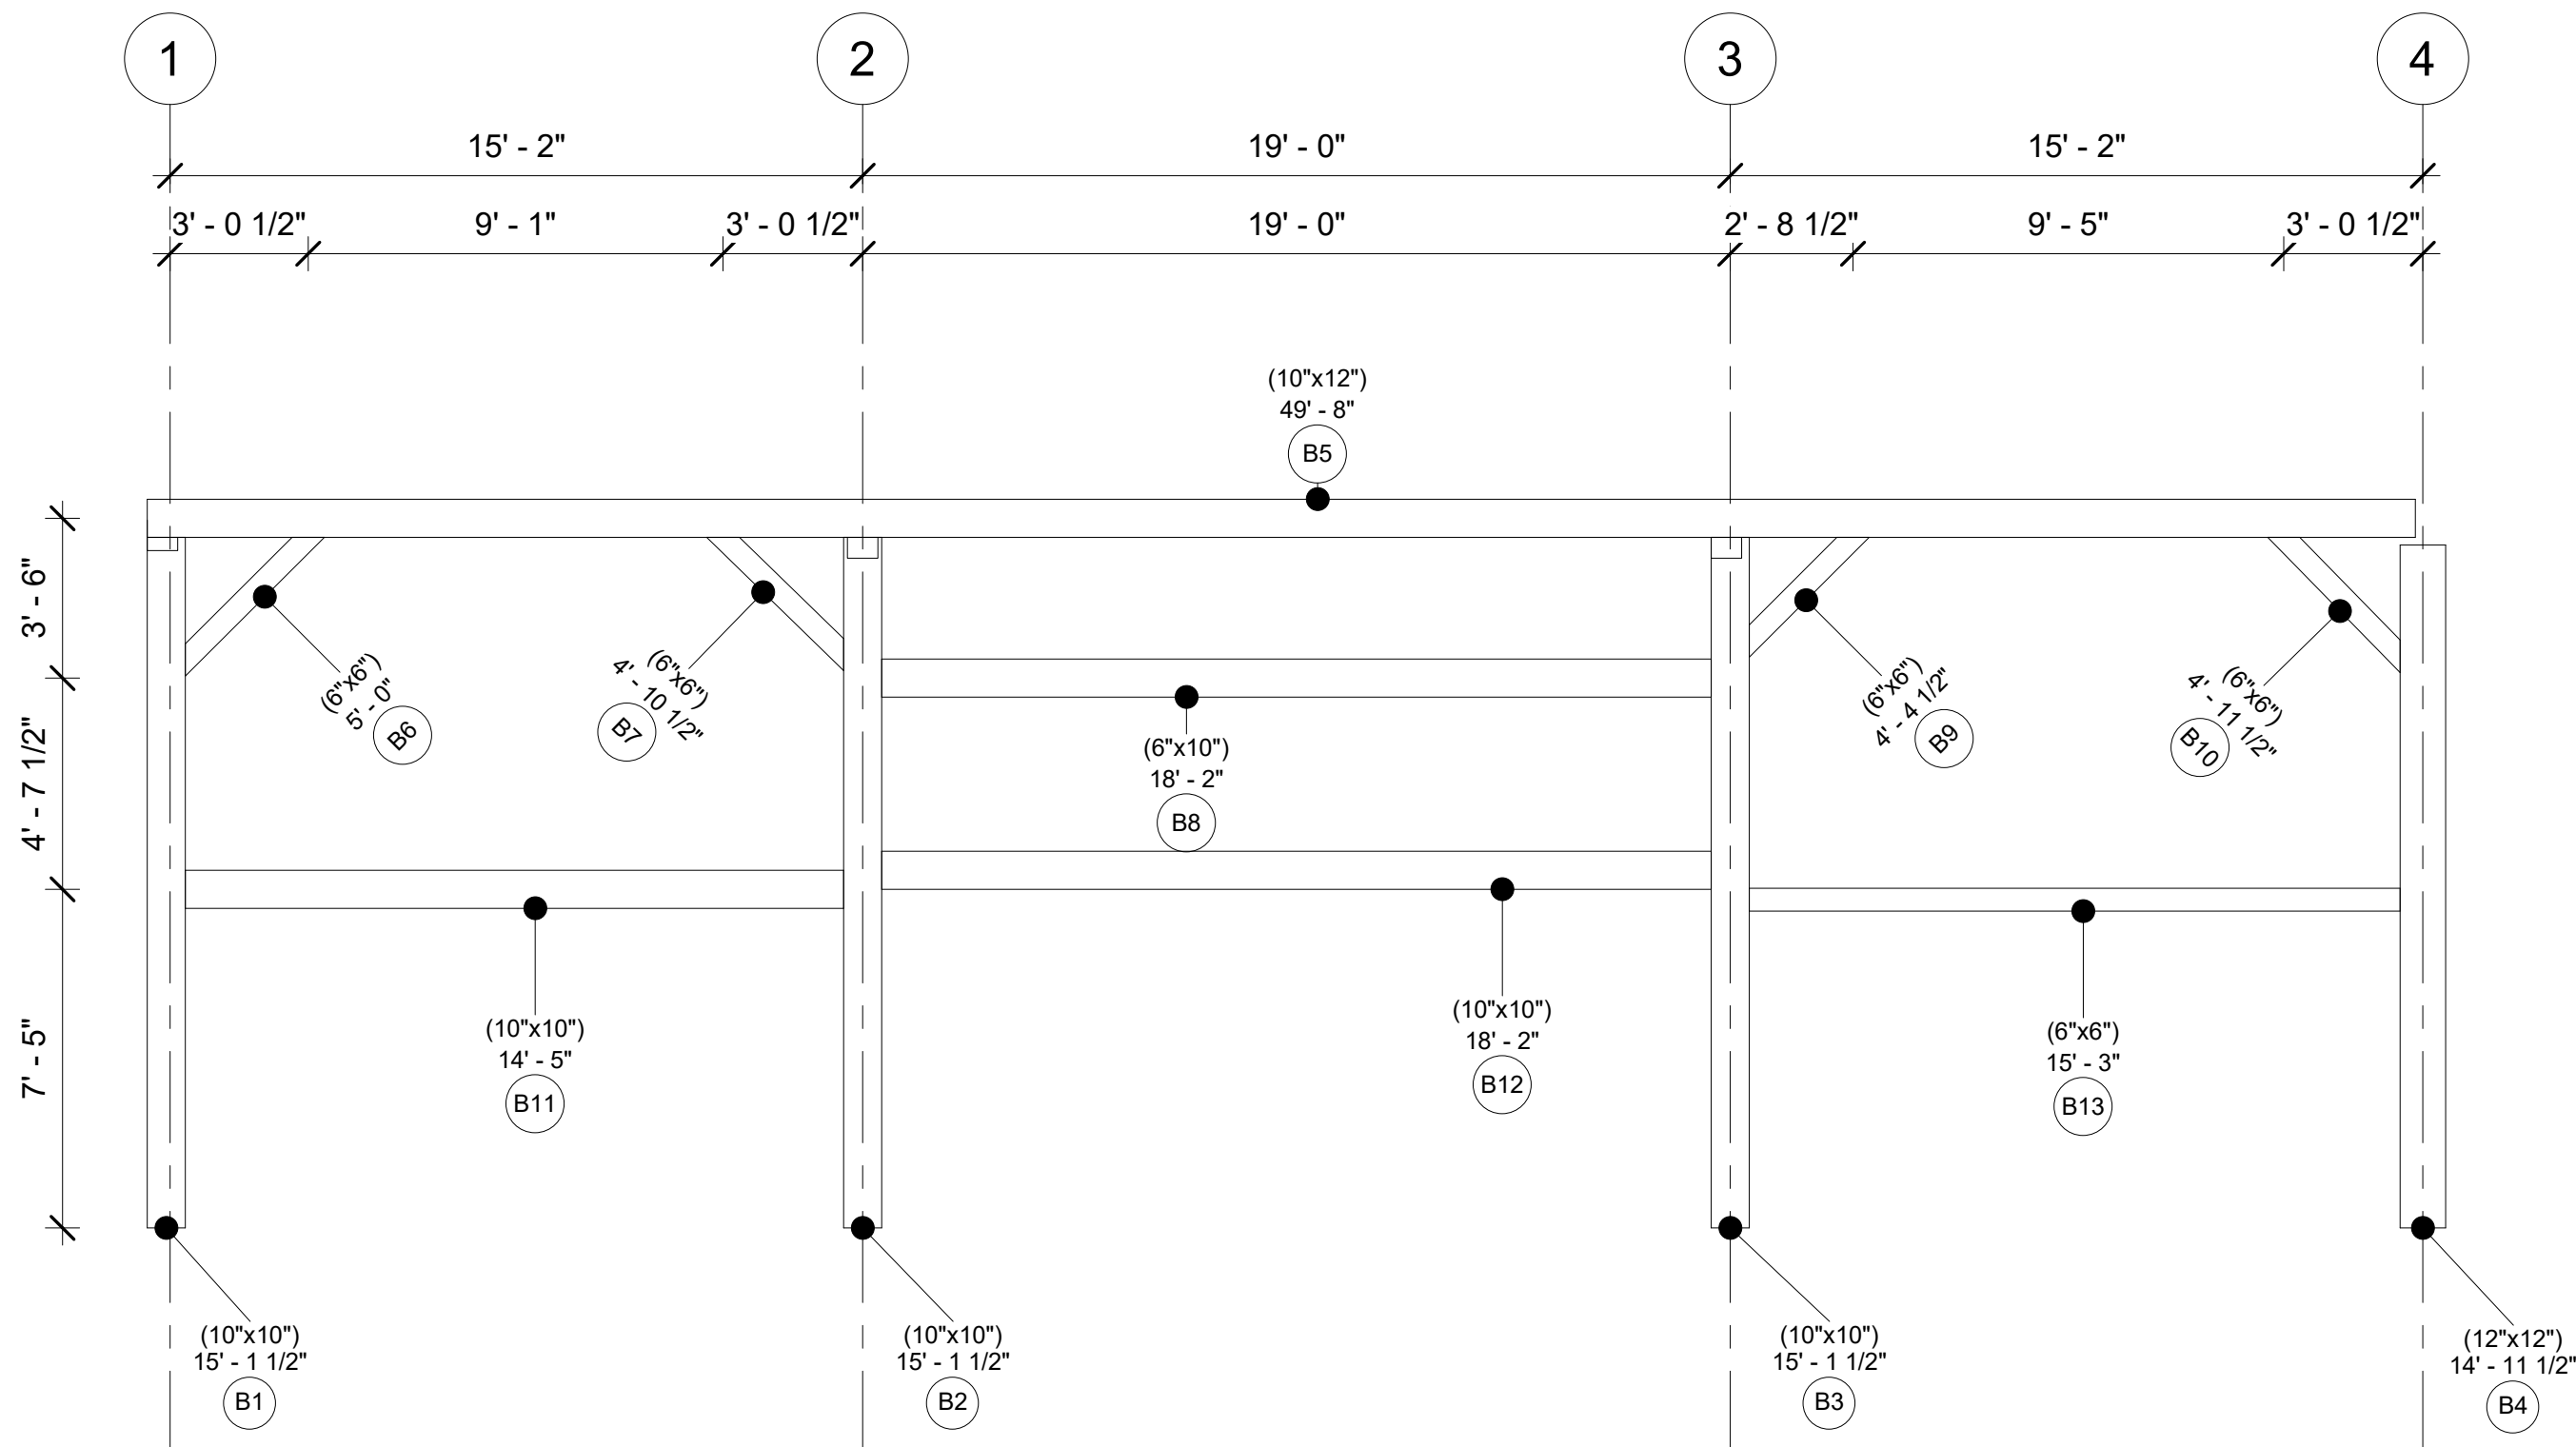

Bent B


Project Number	Project 18
Date	20250724
Drawn By	
Checked By	
A104	
Scale	1/4" = 1'-0"

Timber
Home
Services LLC

Heritage Haven

DAN TRIMBLE
AA66 / TIMBER HOME SERVICES
CELL PHONE/TEXT - 412-309-1161

EMAIL:
DANTRIMBLE@TIMBERHOMESERVICES.COM

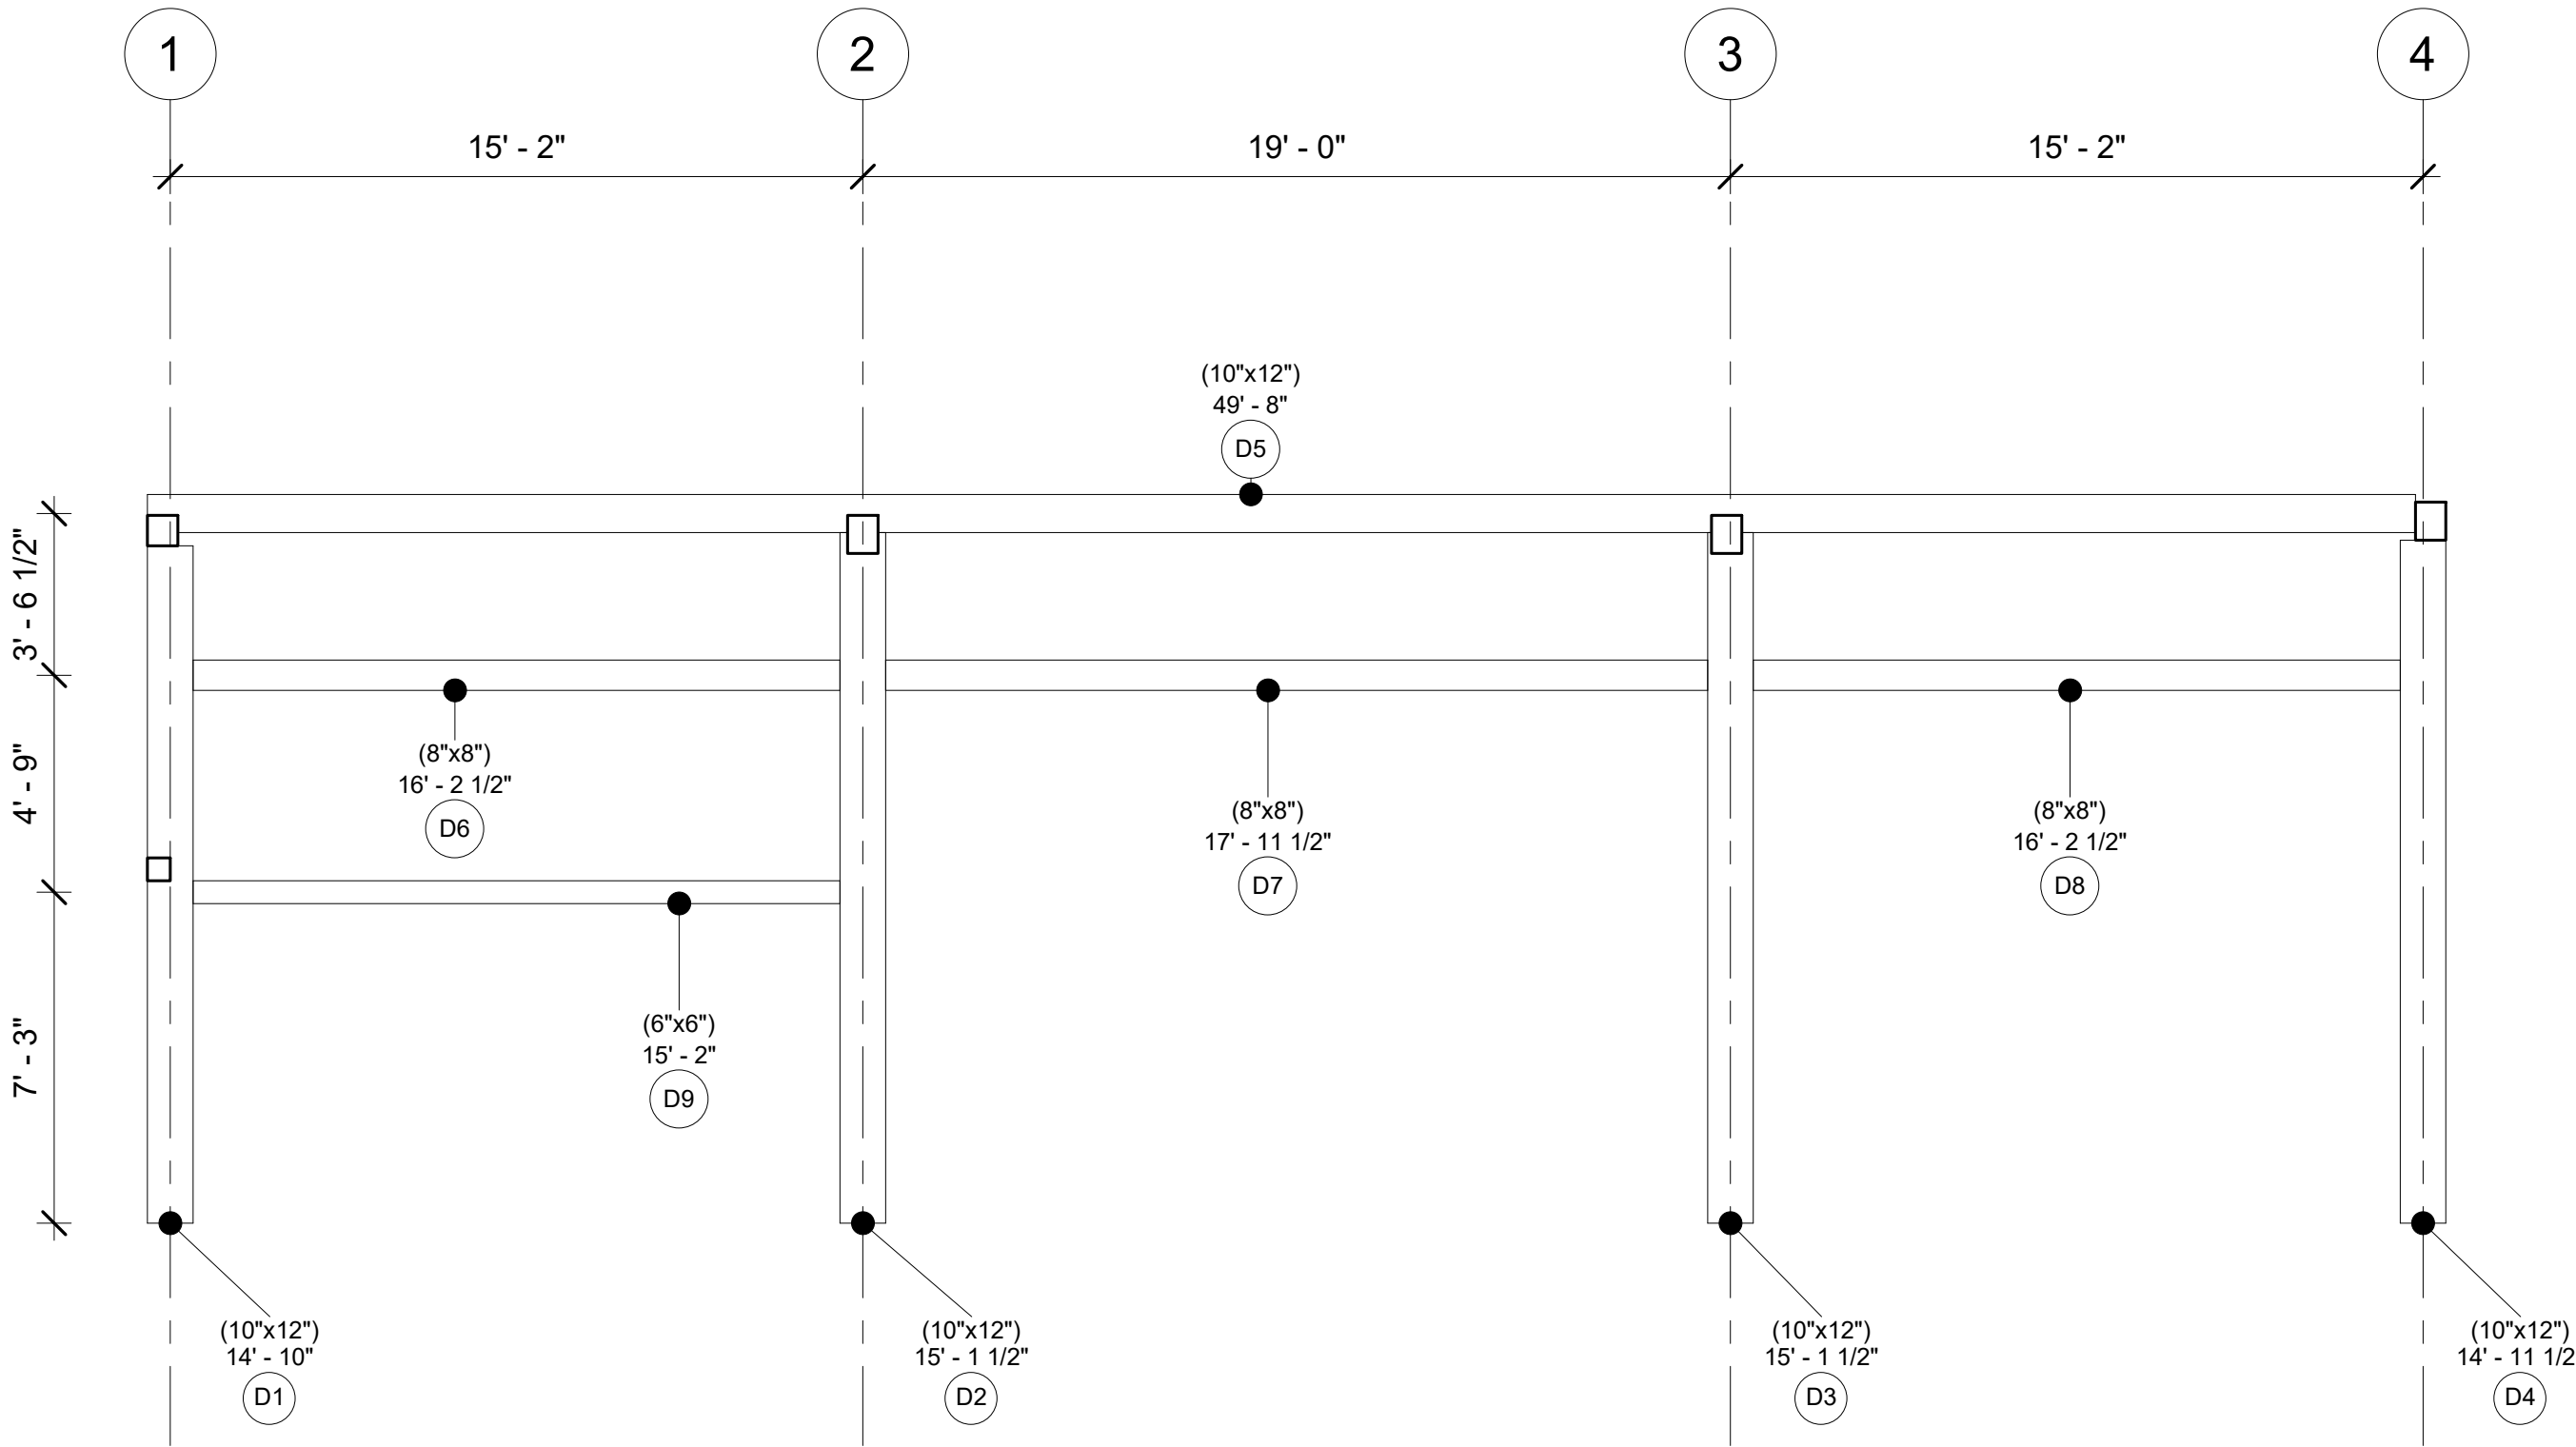

Bent D


Project Number	Project 18
Date	20250724
Drawn By	
Checked By	
A105	
Scale	1/4" = 1'-0"

Timber
Home
Services LLC

Heritage Haven

DAN TRIMBLE
AA66 / TIMBER HOME SERVICES
CELL PHONE/TEXT - 412-309-1161

EMAIL:
DANTRIMBLE@TIMBERHOMESERVICES.COM

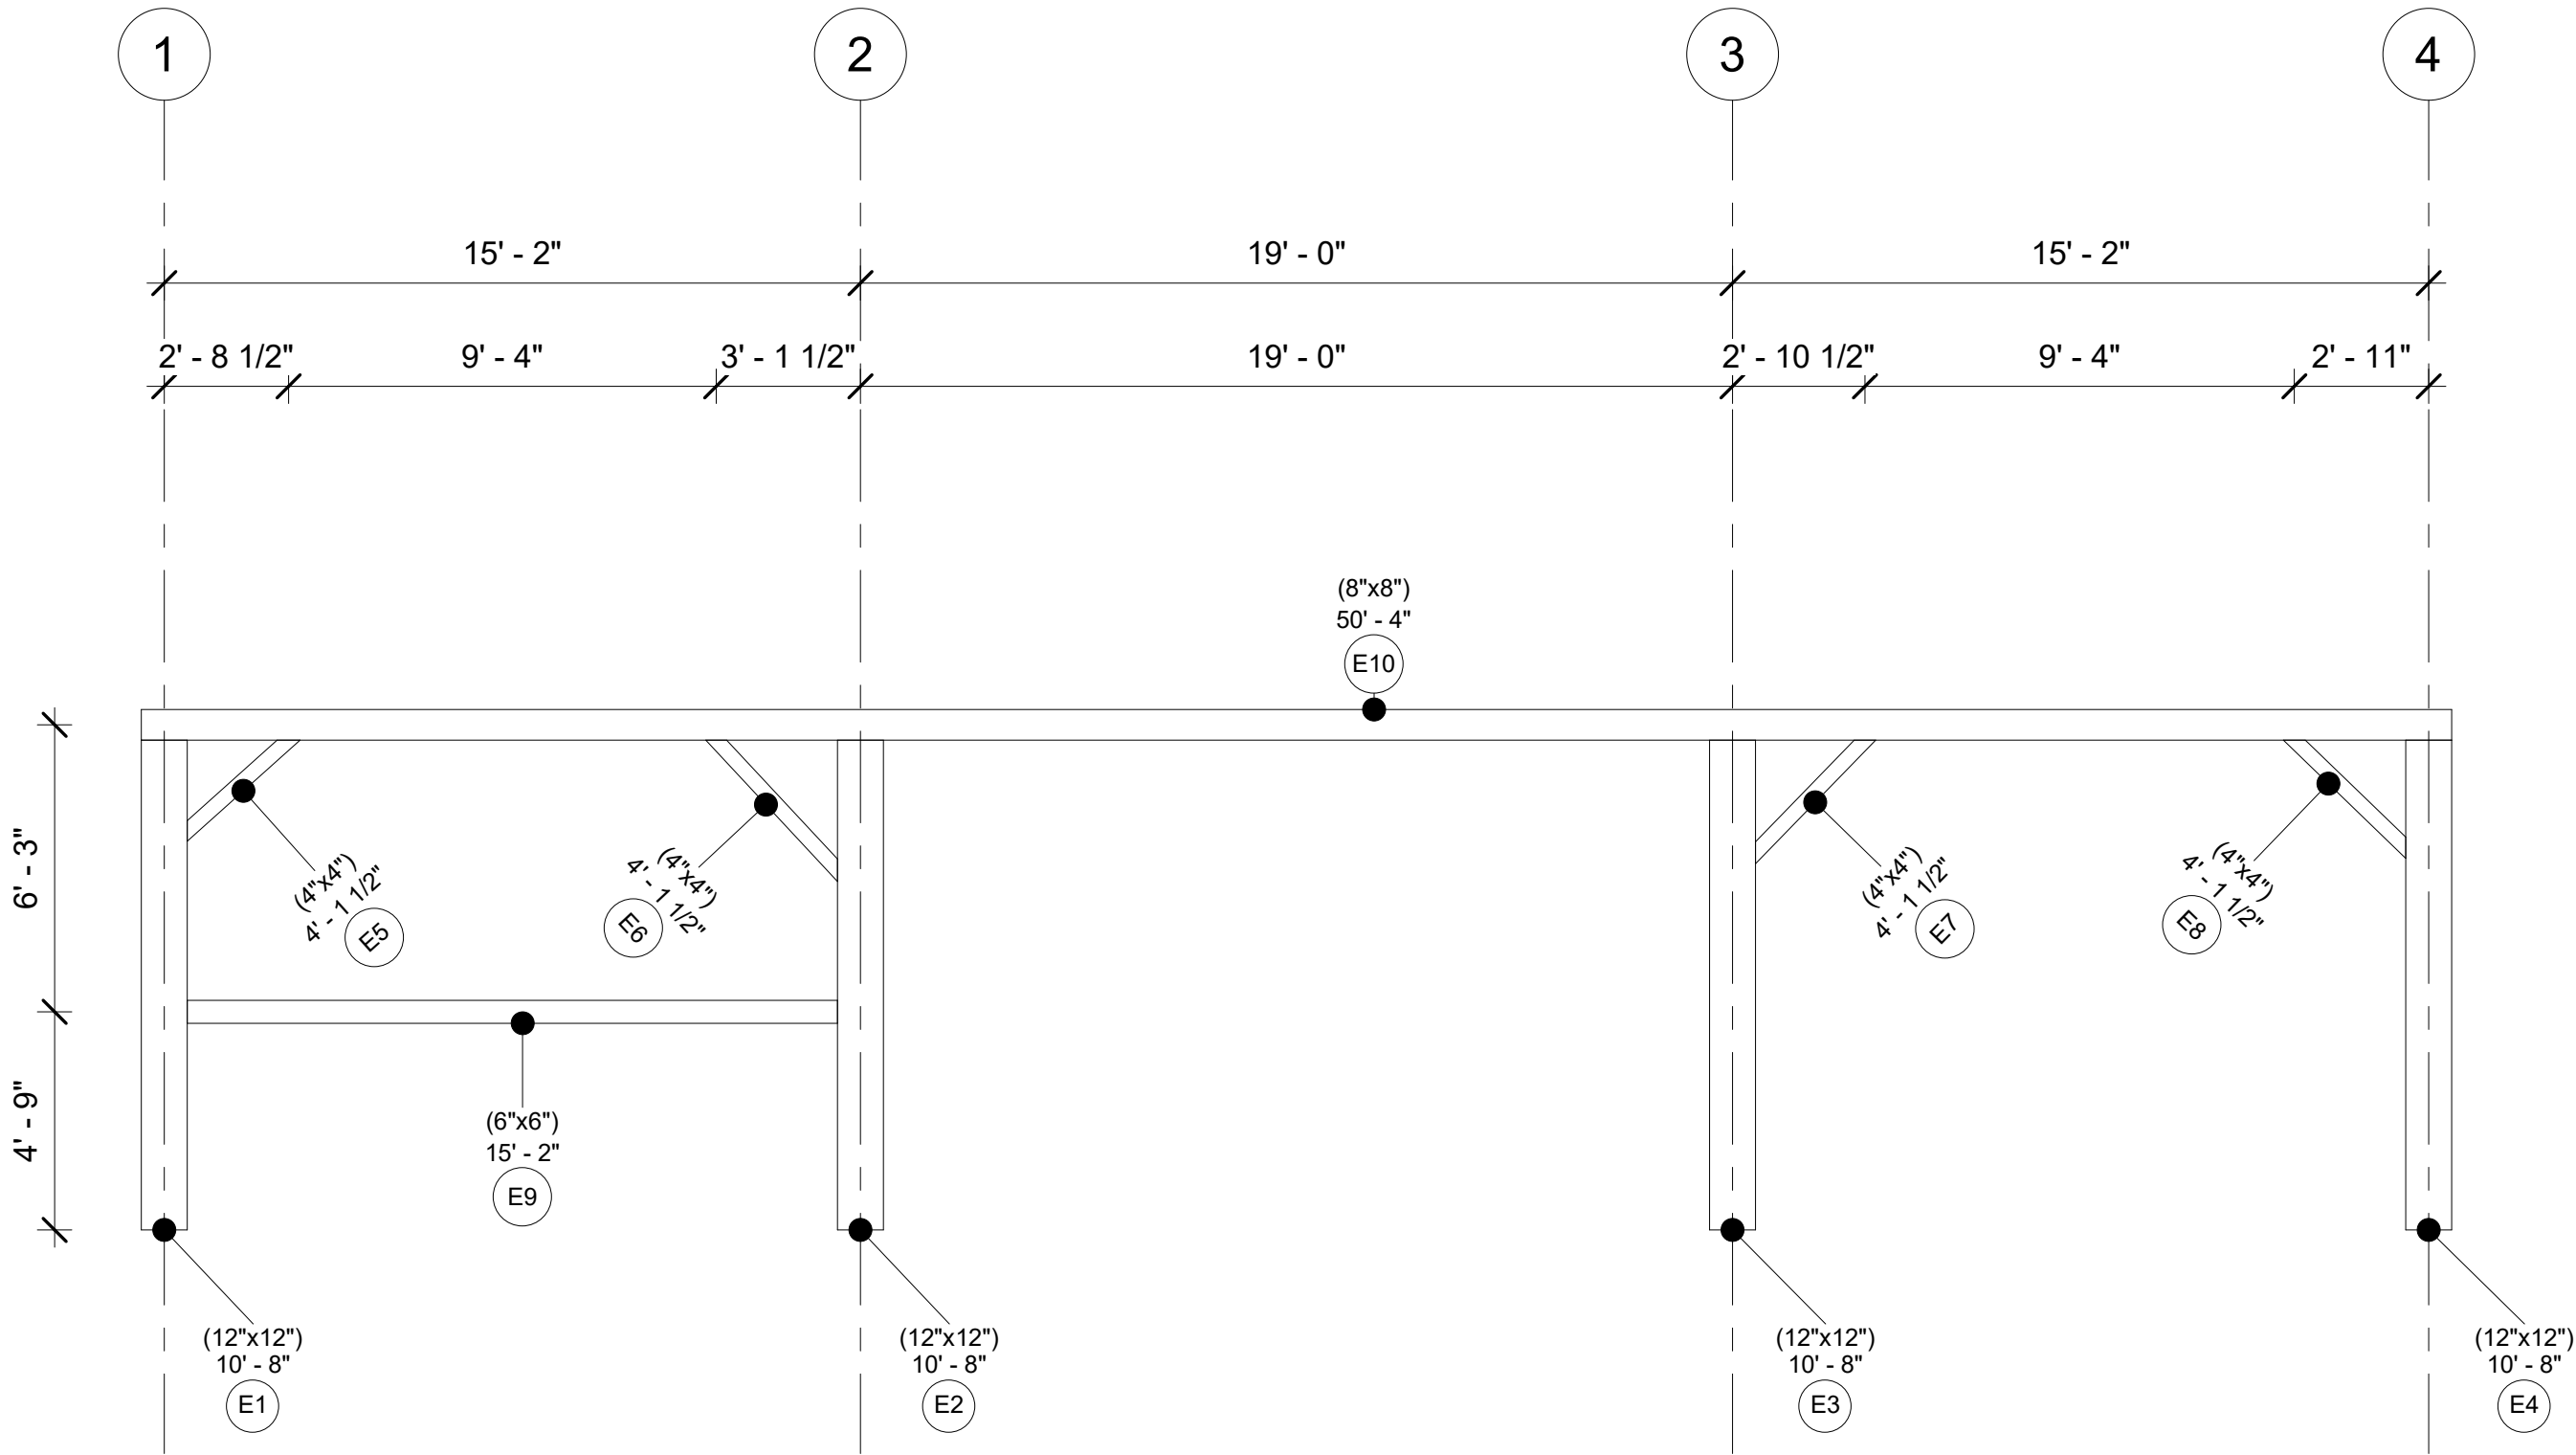

Bent E

Project Number	Project 18
Date	20250724
Drawn By	
Checked By	

A106


Scale	1/4" = 1'-0"
-------	--------------

Timber
Home
Services LLC

Heritage Haven

DAN TRIMBLE
AA66 / TIMBER HOME SERVICES
CELL PHONE/TEXT - 412-309-1161

EMAIL:
DANTRIMBLE@TIMBERHOMESERVICES.COM

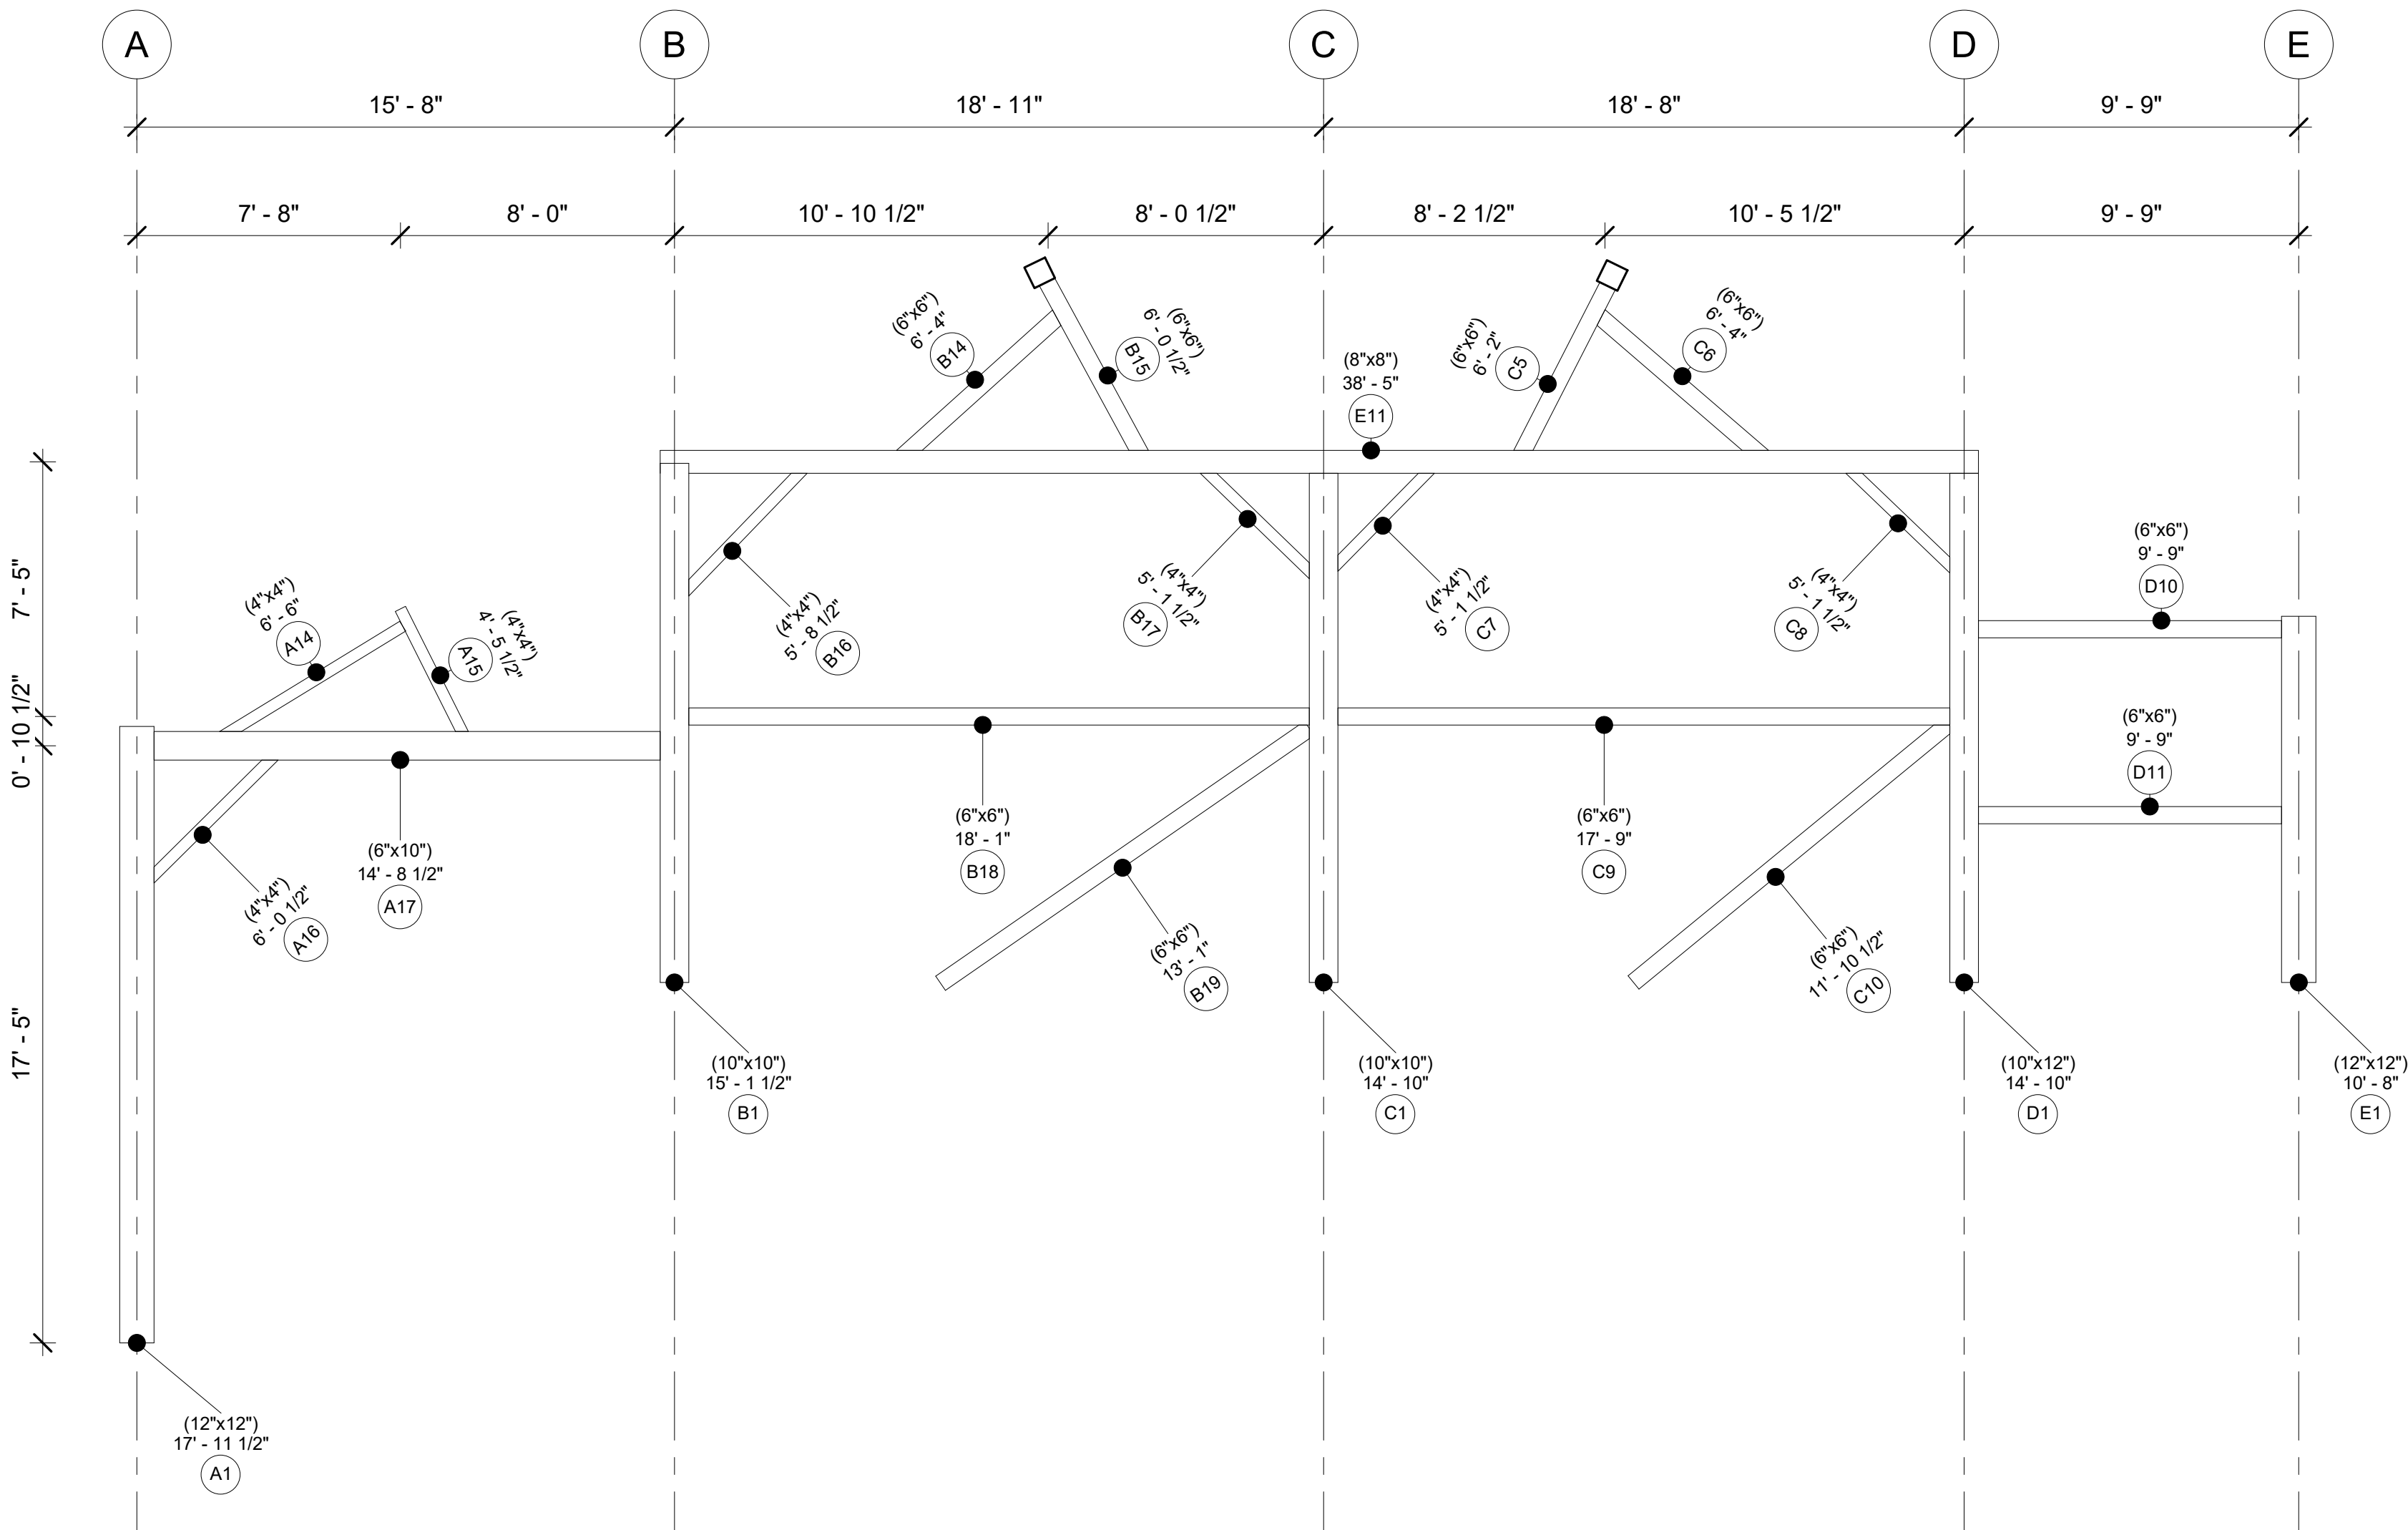

Bent 1

Project Number	Project 18
Date	20250724
Drawn By	
Checked By	
A107	
Scale	1/4" = 1'-0"

Timber Home Services LLC

Heritage Haven

--


CELL PHONE/TEXT - 412-309-1161

DANTRIMBLE@TIMBERHOMESERVICES.COM

Date	20250724
------	----------

Checked By	
------------	--

A108

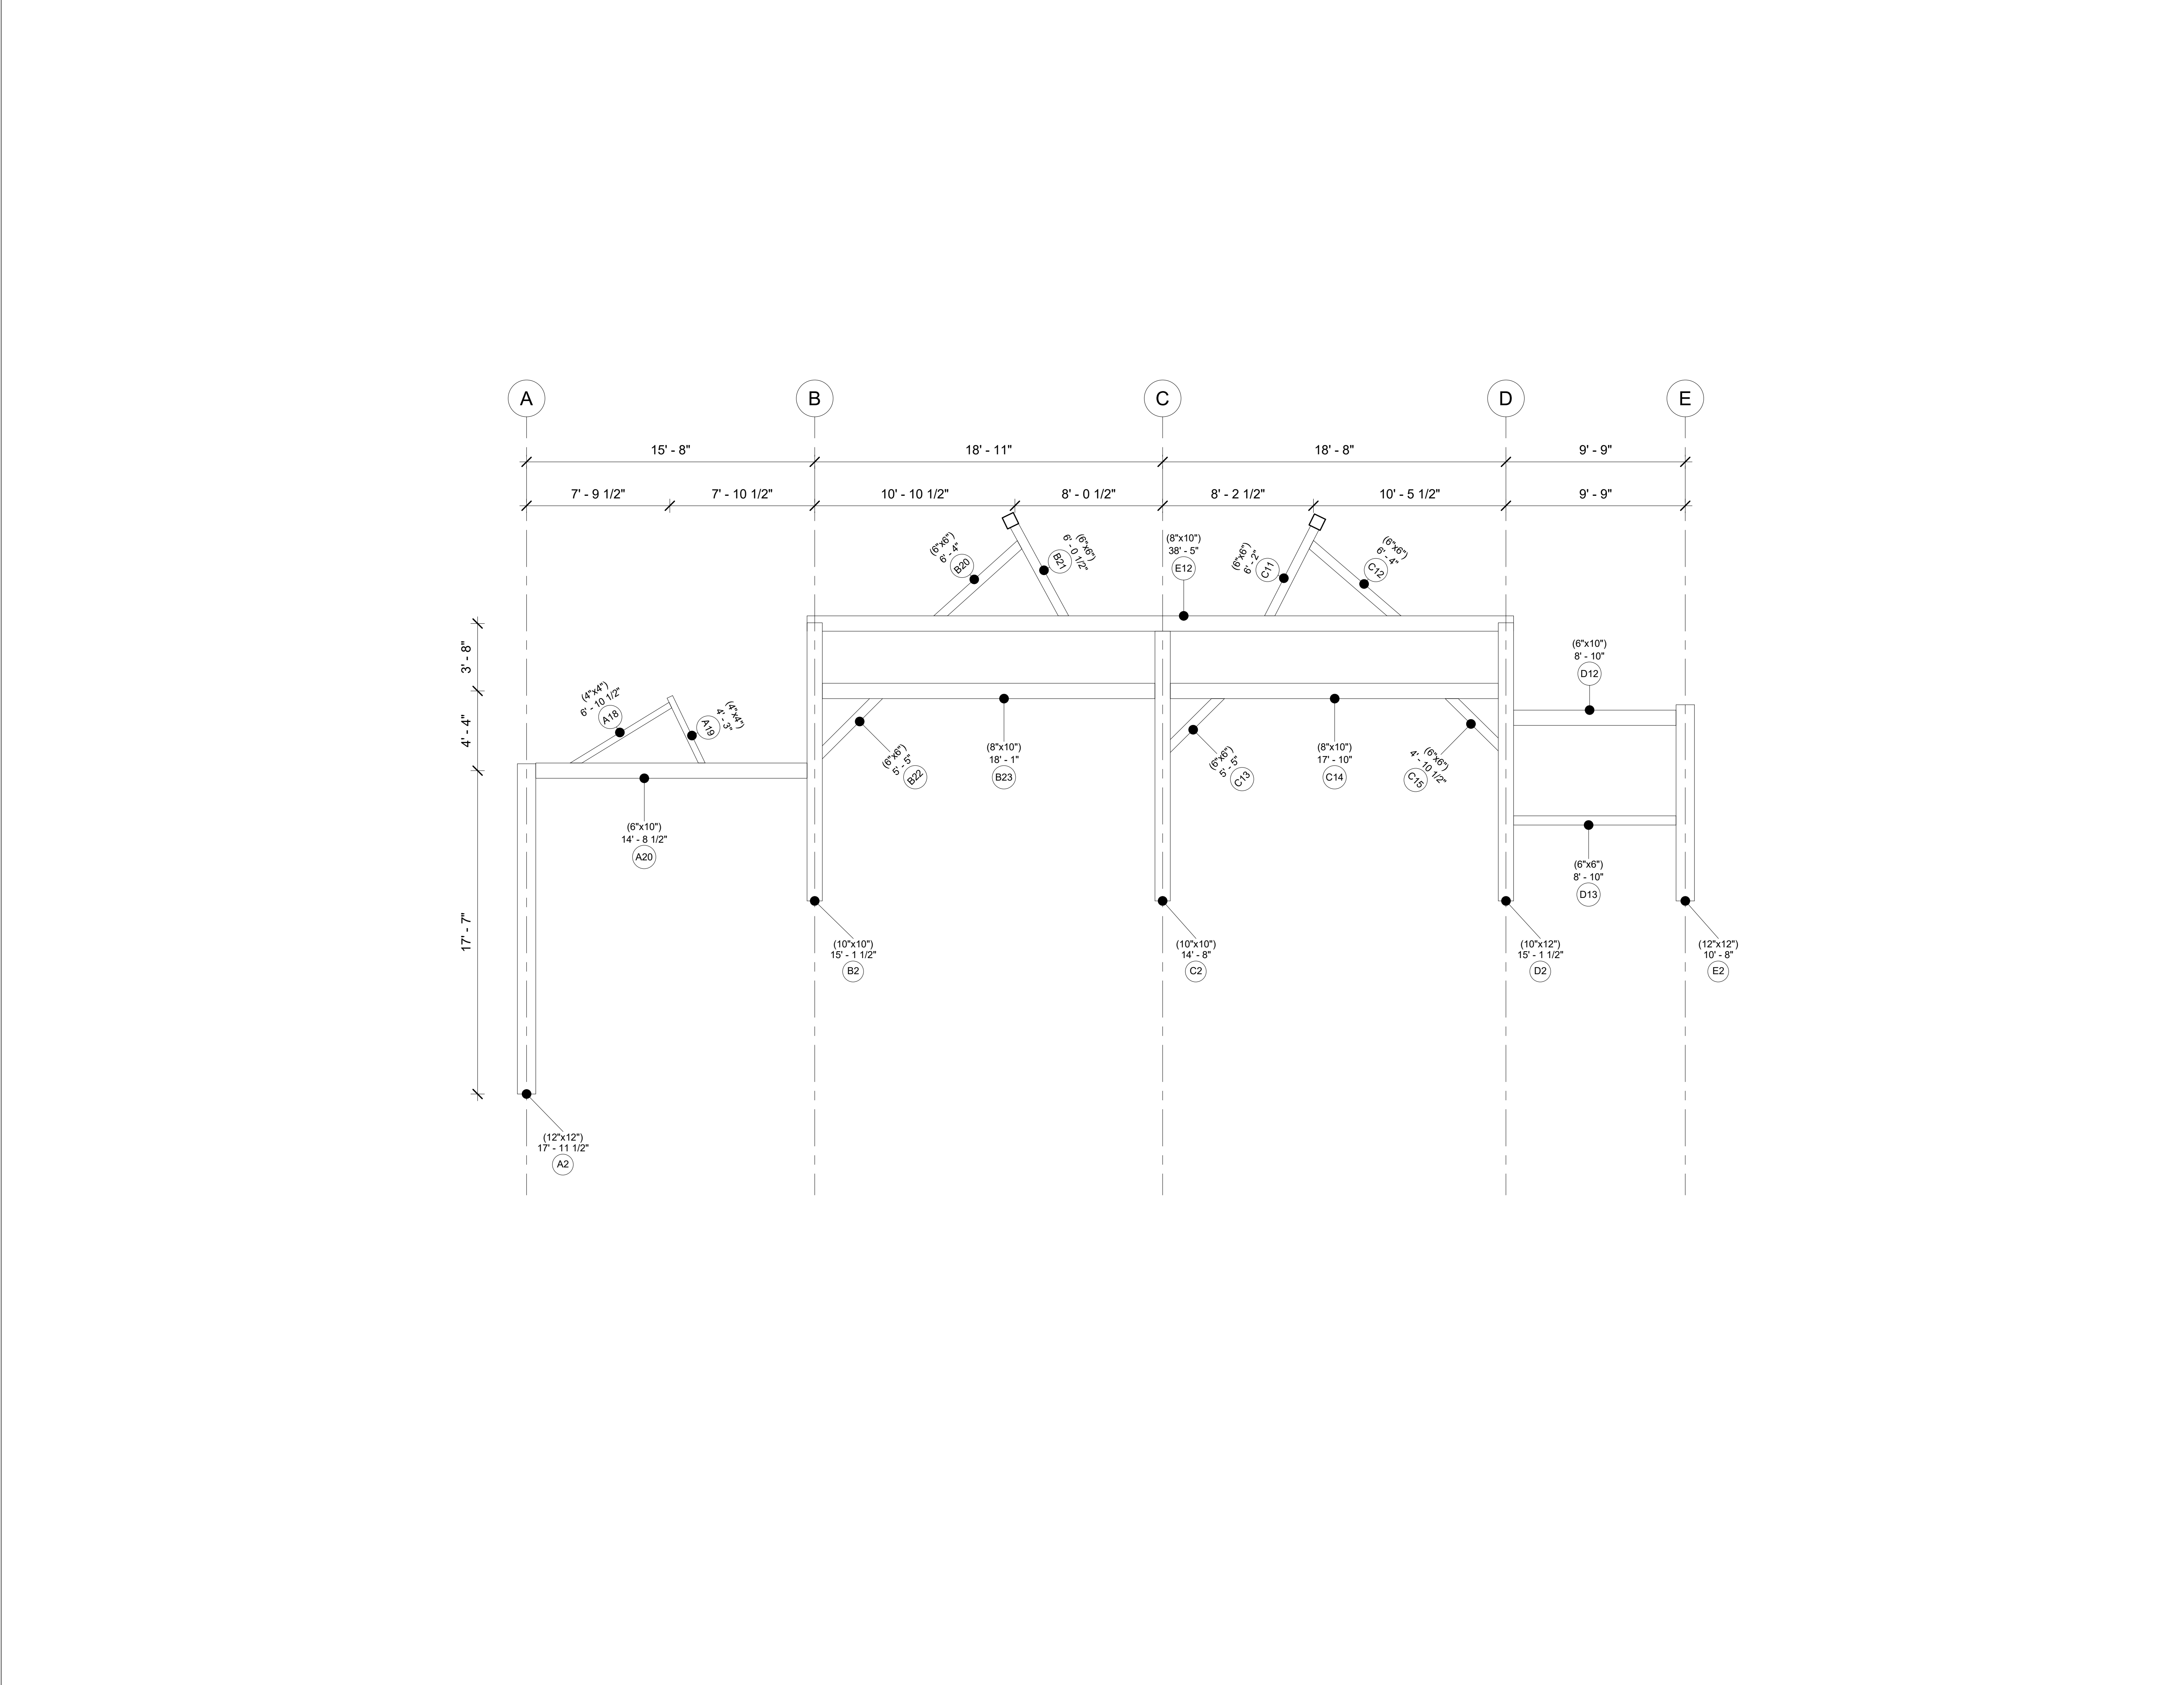

Timber
Home
Services LLC


Heritage Haven

DAN TRIMBLE
AA66 / TIMBER HOME SERVICES

CELL PHONE/TEXT - 412-309-1161

EMAIL:

DANTRIMBLE@TIMBERHOMESERVICES.COM

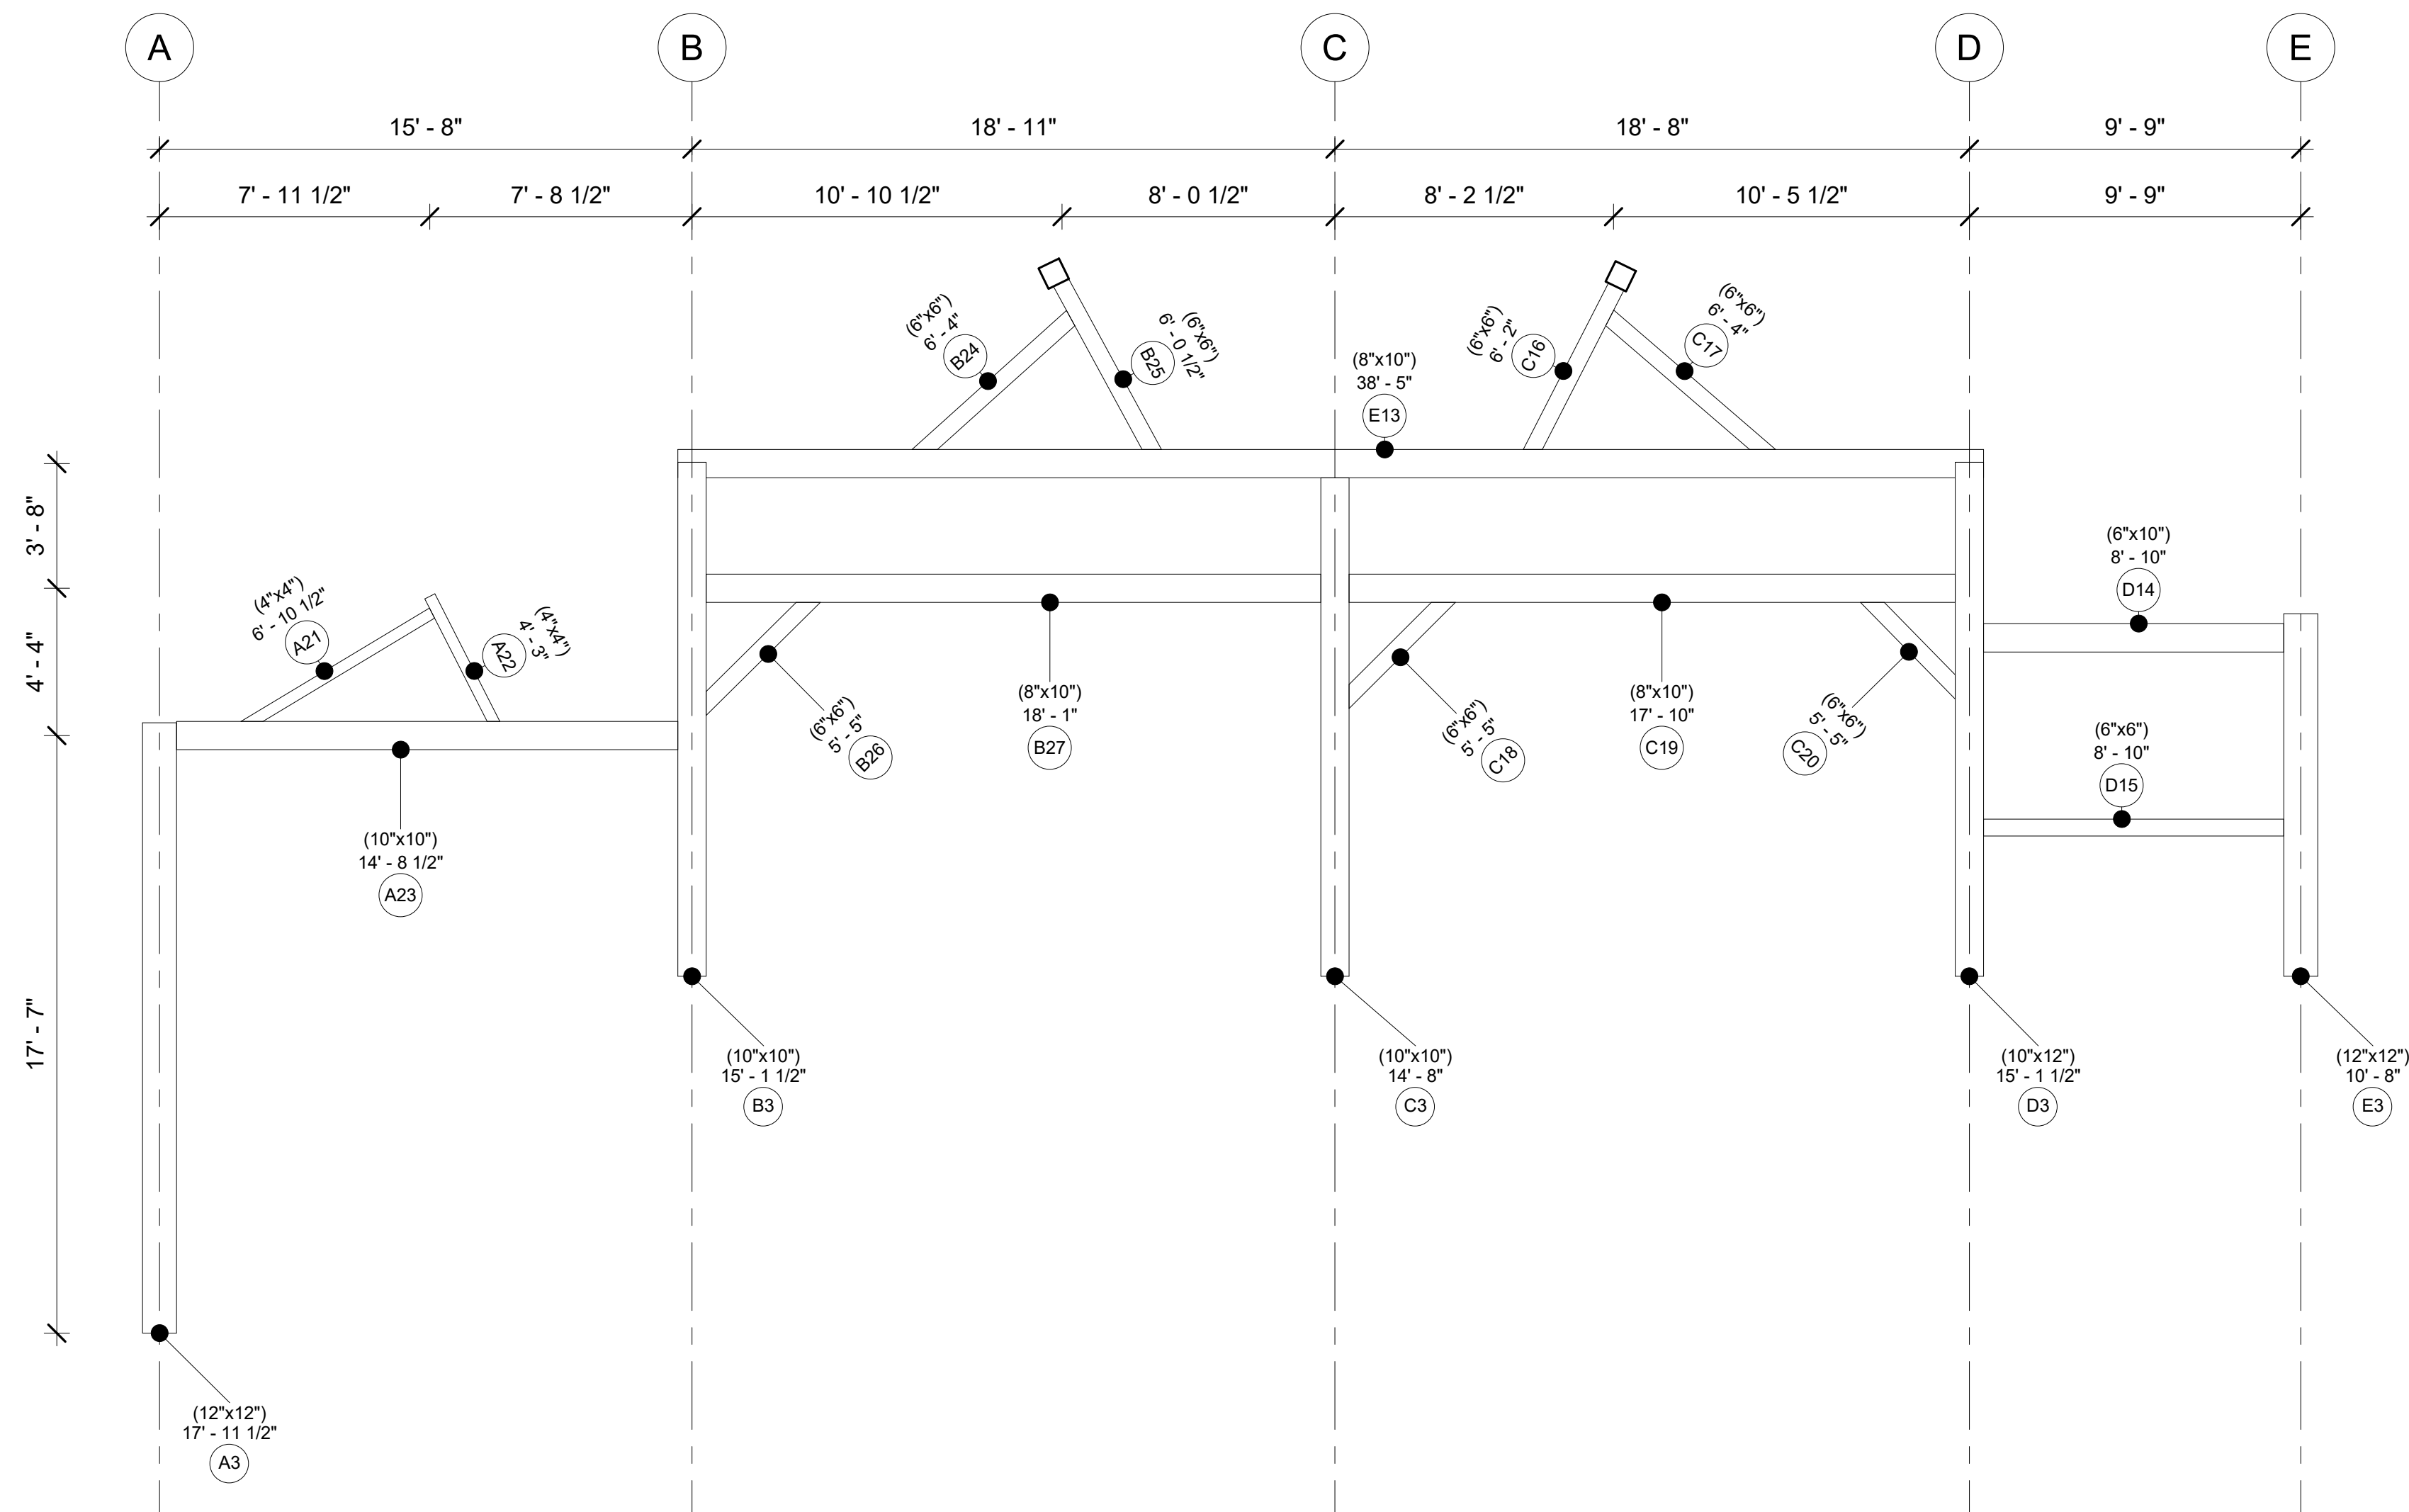

Bent 3

Project Number Project 18

Date 20250724

Drawn By _____

Checked By _____

A109


Scale $1/4" = 1'-0"$

Timber
Home
Services LLC

Heritage Haven

DAN TRIMBLE
AA66 / TIMBER HOME SERVICES
CELL PHONE/TEXT - 412-309-1161

EMAIL:
DANTRIMBLE@TIMBERHOMESERVICES.COM

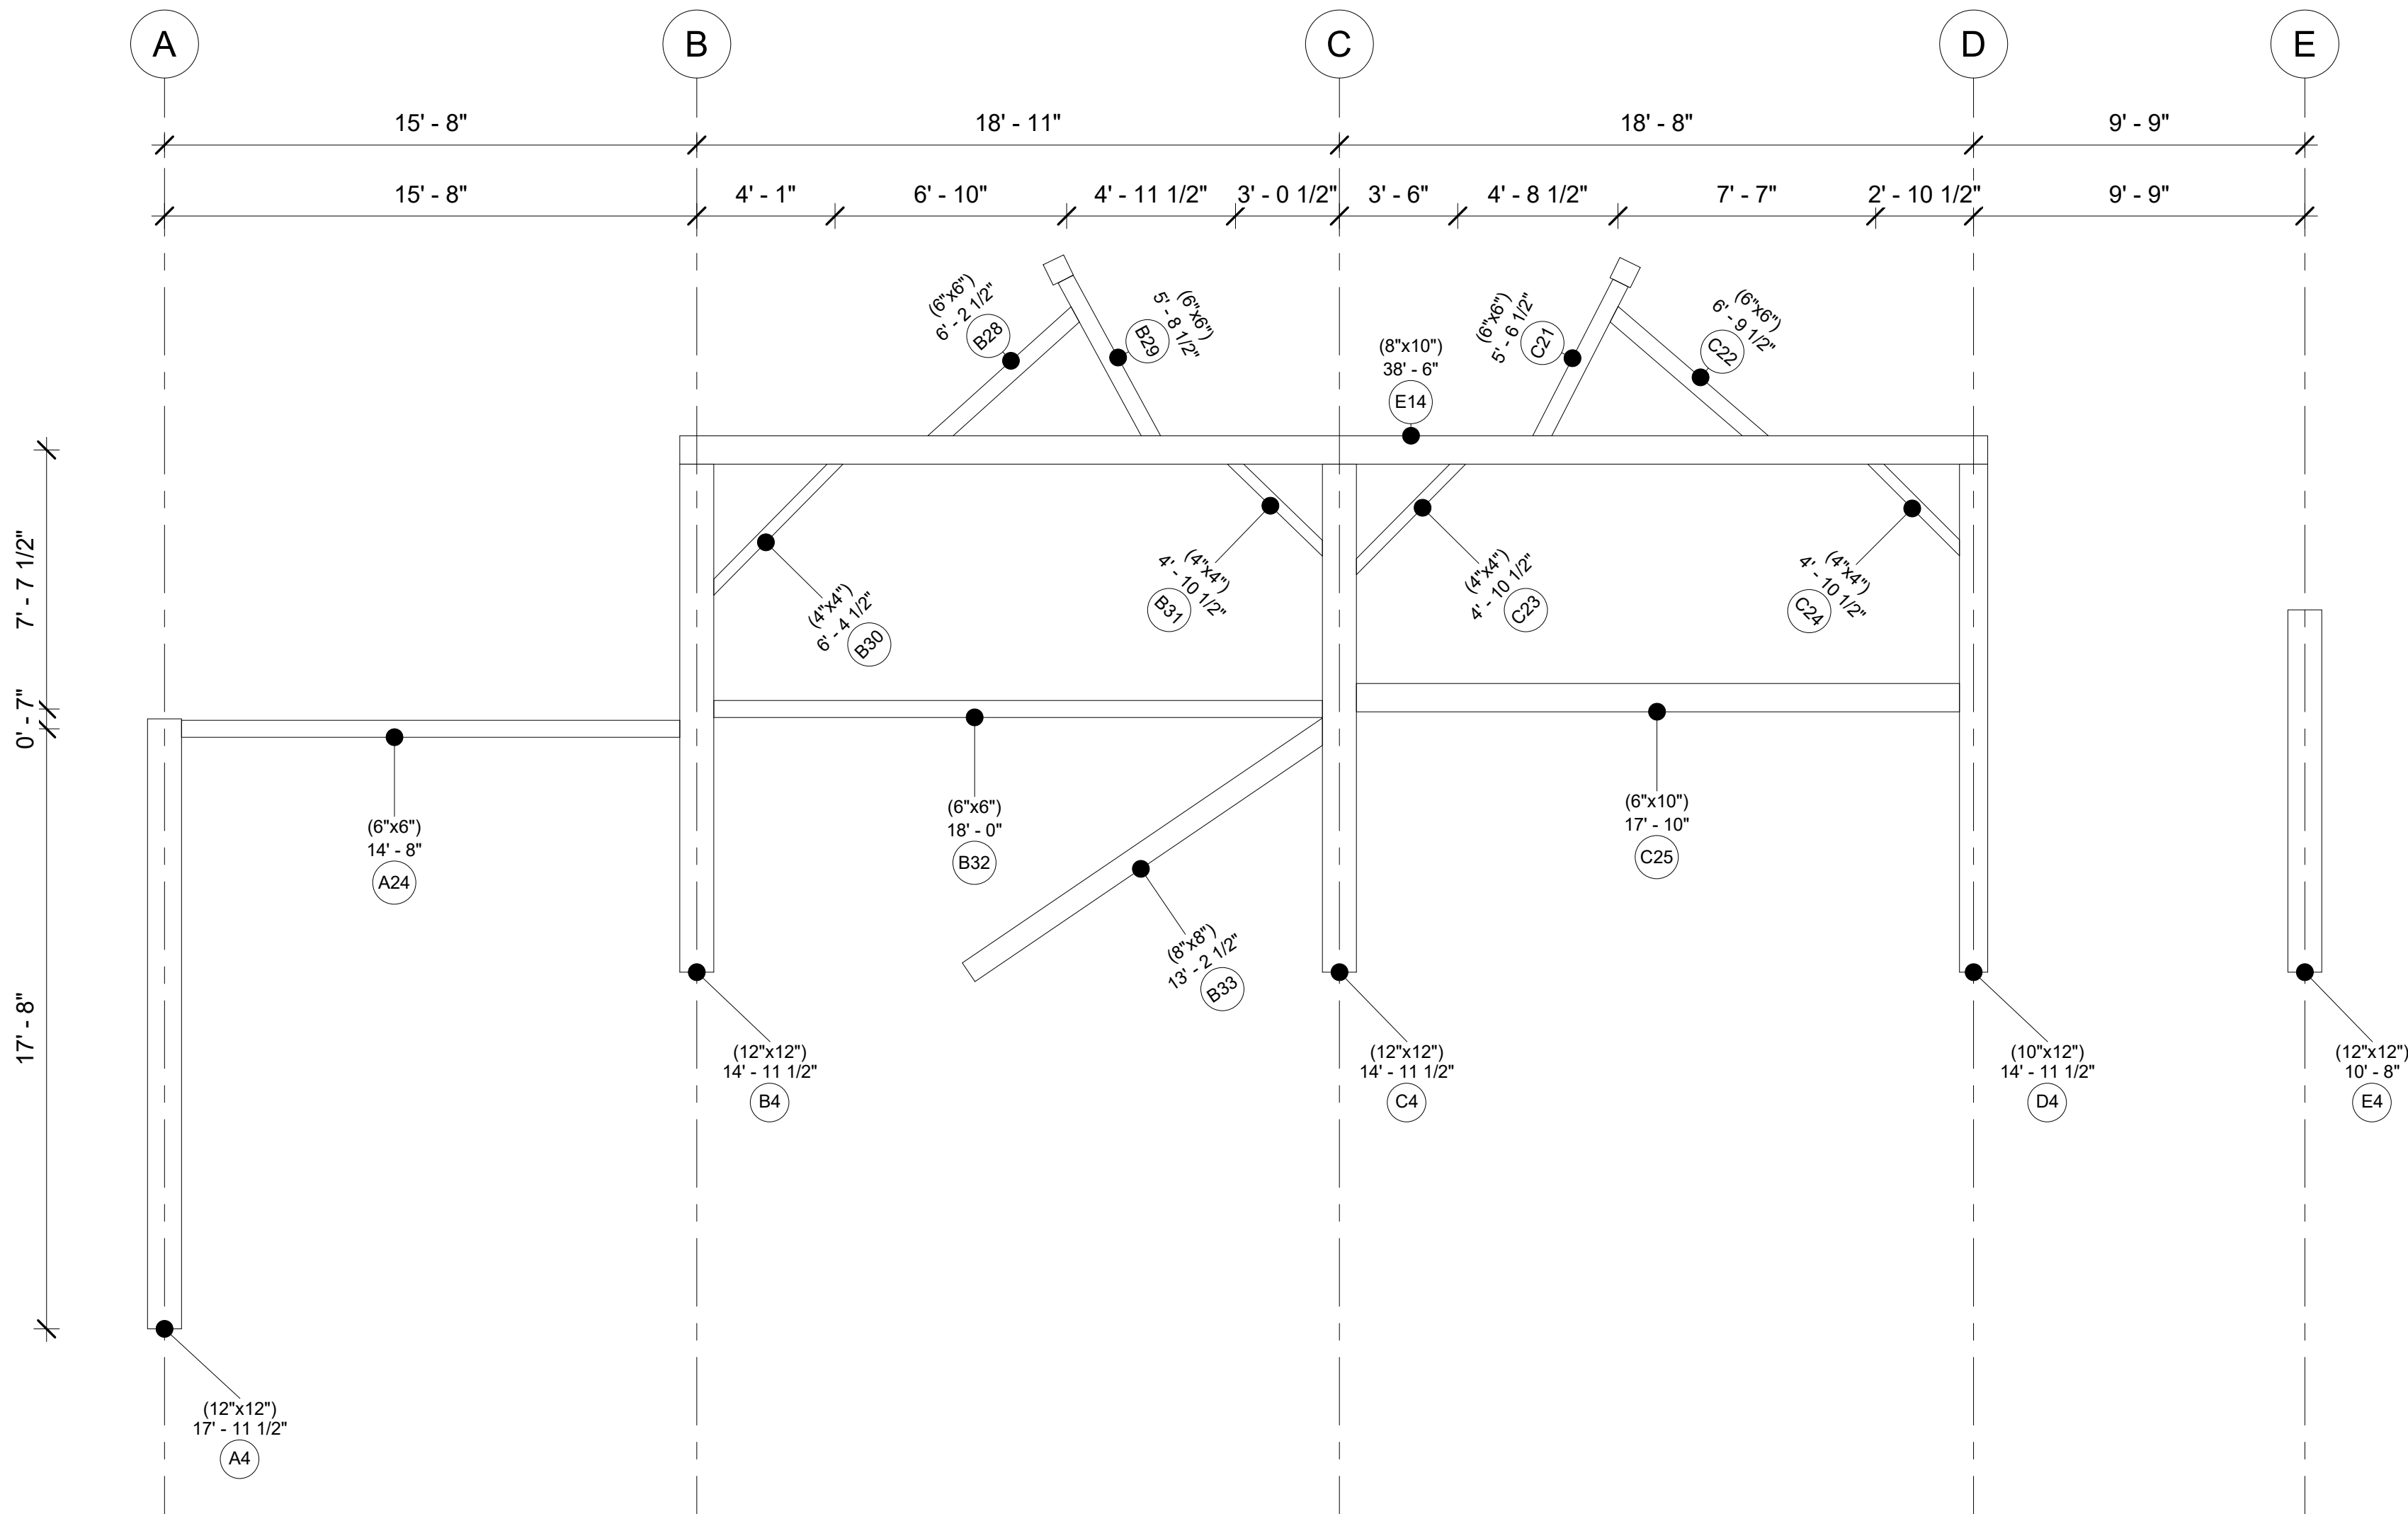

Bent 4

Project Number	Project 18
Date	20250724
Drawn By	
Checked By	
A110	
Scale	1/4" = 1'-0"