


PROJECT: Sawmill Run

SCOPE: AS BUILT DRAWINGS

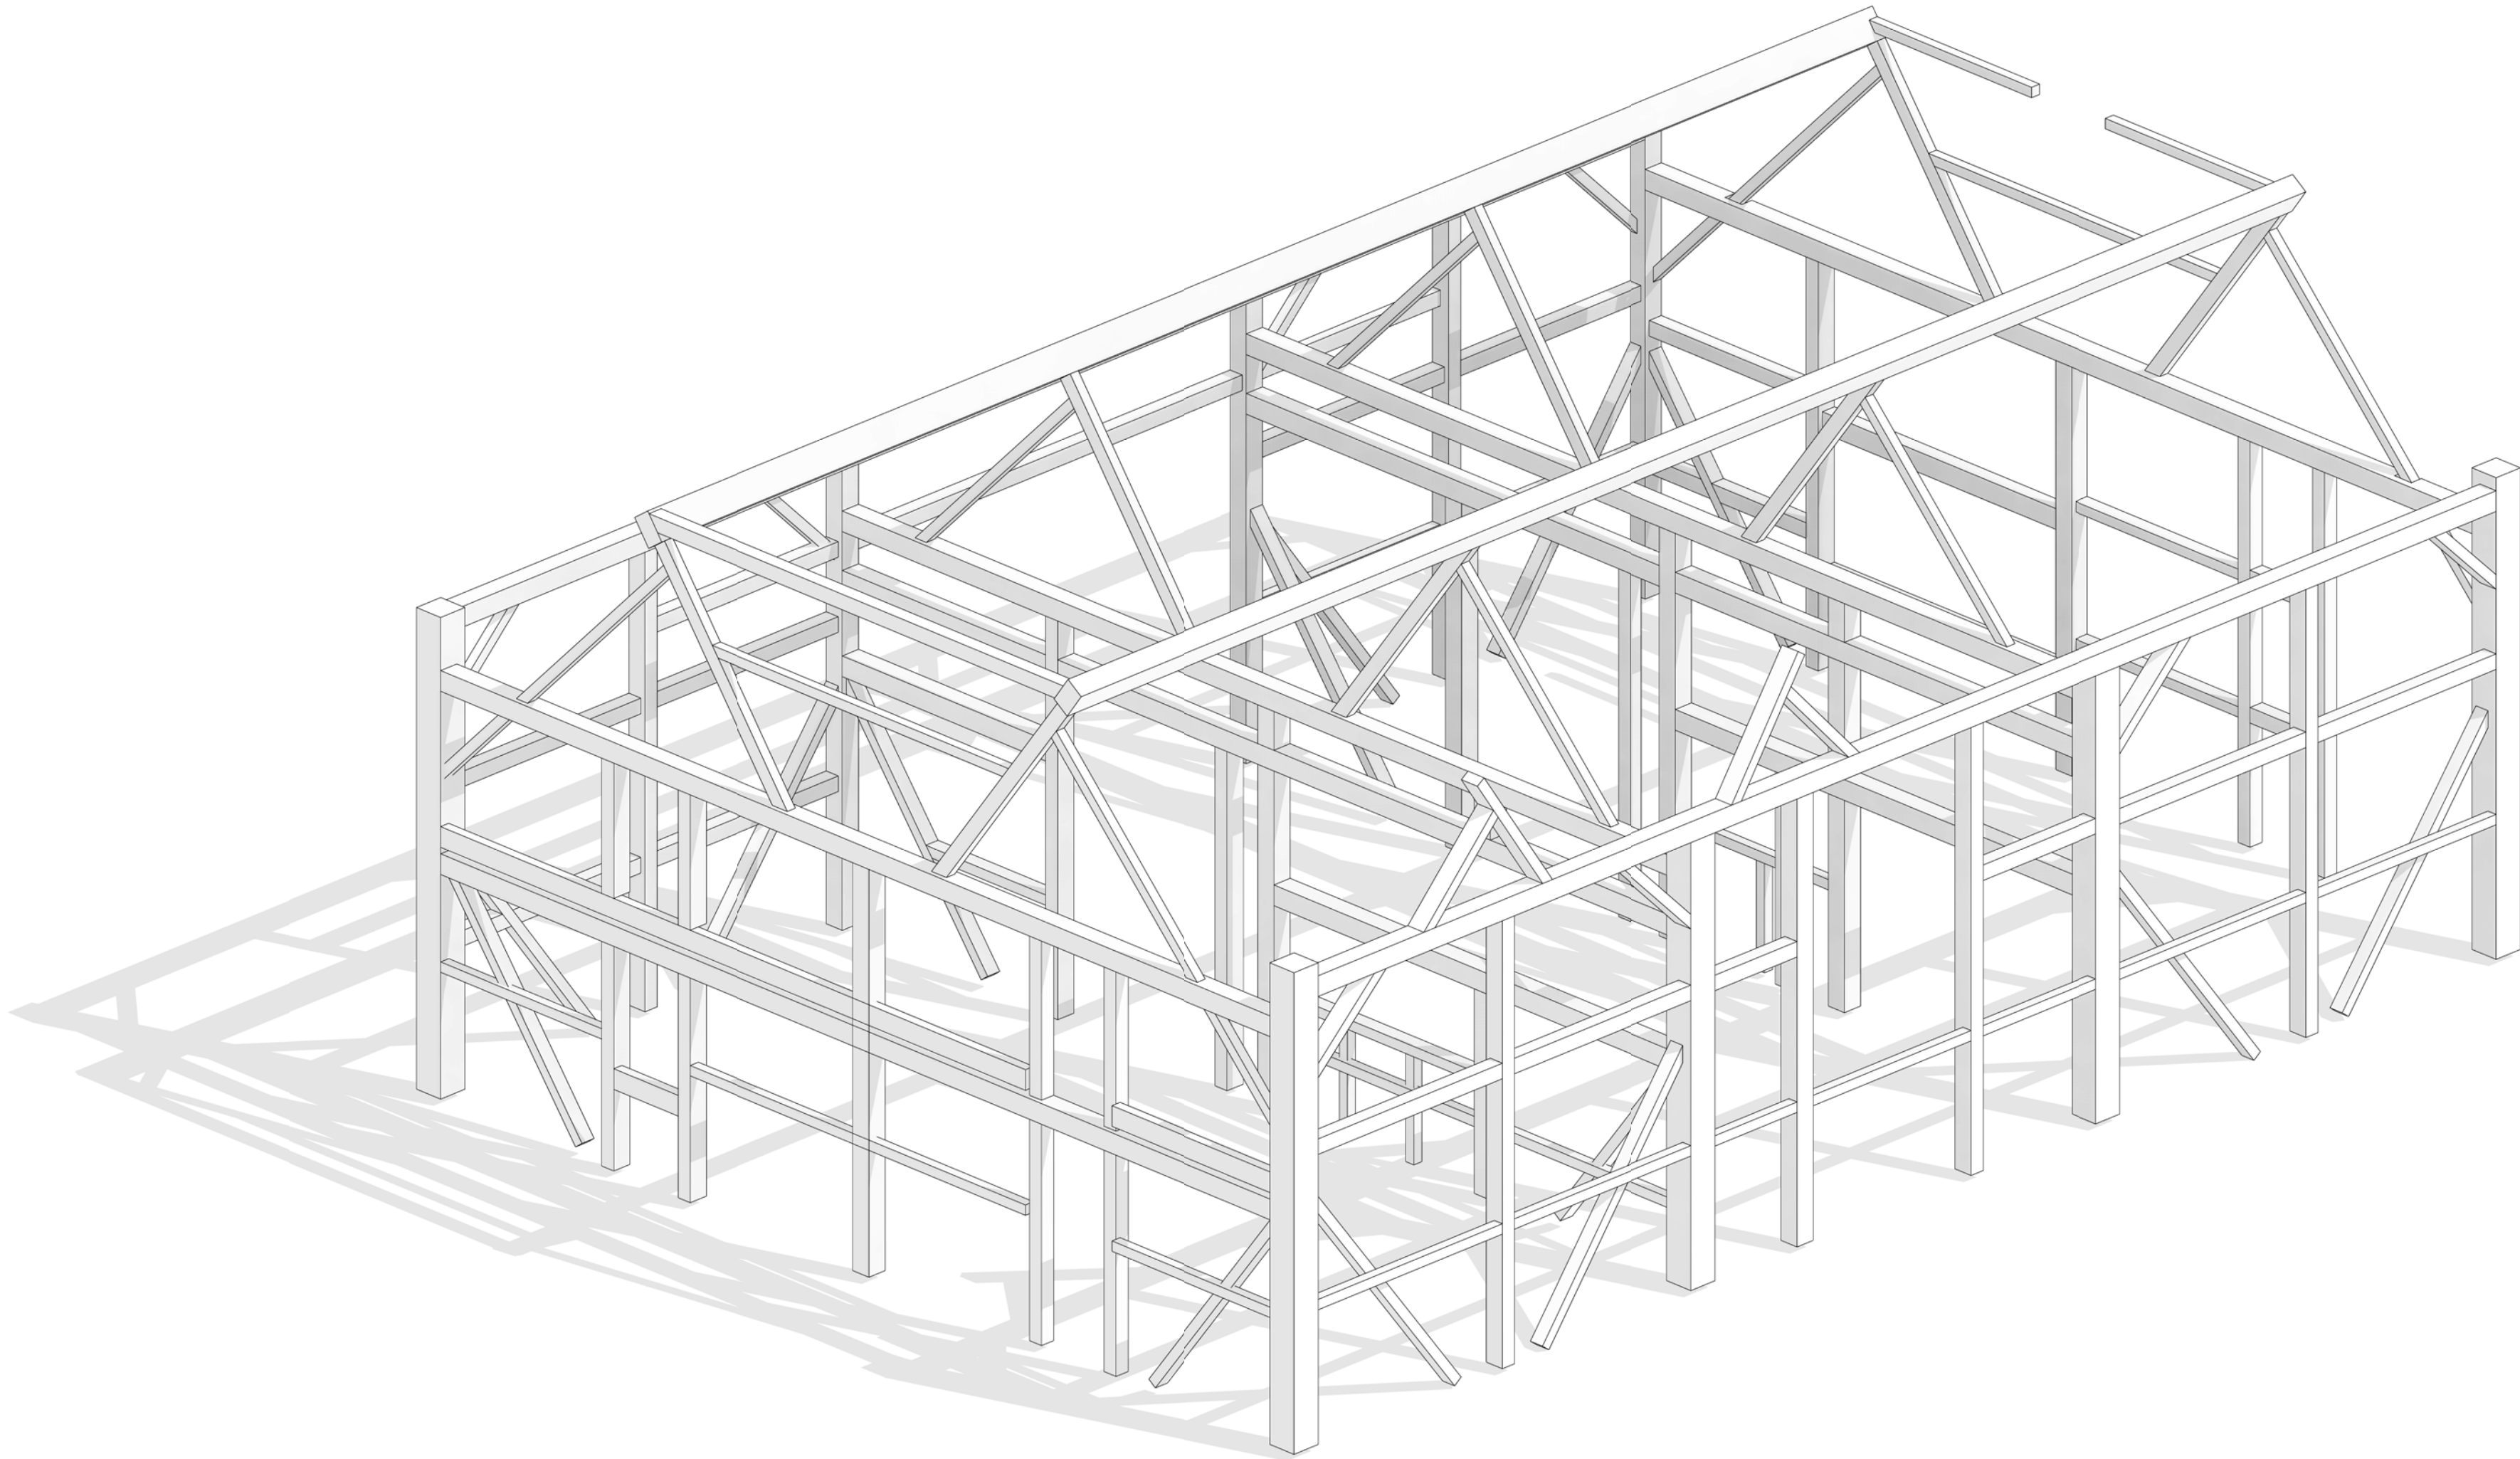

Timber
Home
Services LLC

Sawmill Run

DAN TRIMBLE
AA66 / TIMBER HOME SERVICES
CELL PHONE/TEXT - 412-309-1161

EMAIL:
DANTRIMBLE@TIMBERHOMESERVICES.COM

Cover Page

Project Number	Project 19
Date	20250811
Drawn By	
Checked By	

A101

Scale

Timber
Home
Services LLC


Sawmill Run

DAN TRIMBLE
AA66 / TIMBER HOME SERVICES
CELL PHONE/TEXT - 412-309-1161

EMAIL:
DANTRIMBLE@TIMBERHOMESERVICES.COM

Floor Plan

Project Number	Project 19
Date	20250811
Drawn By	
Checked By	
A102	
Scale	1/4" = 1'-0"

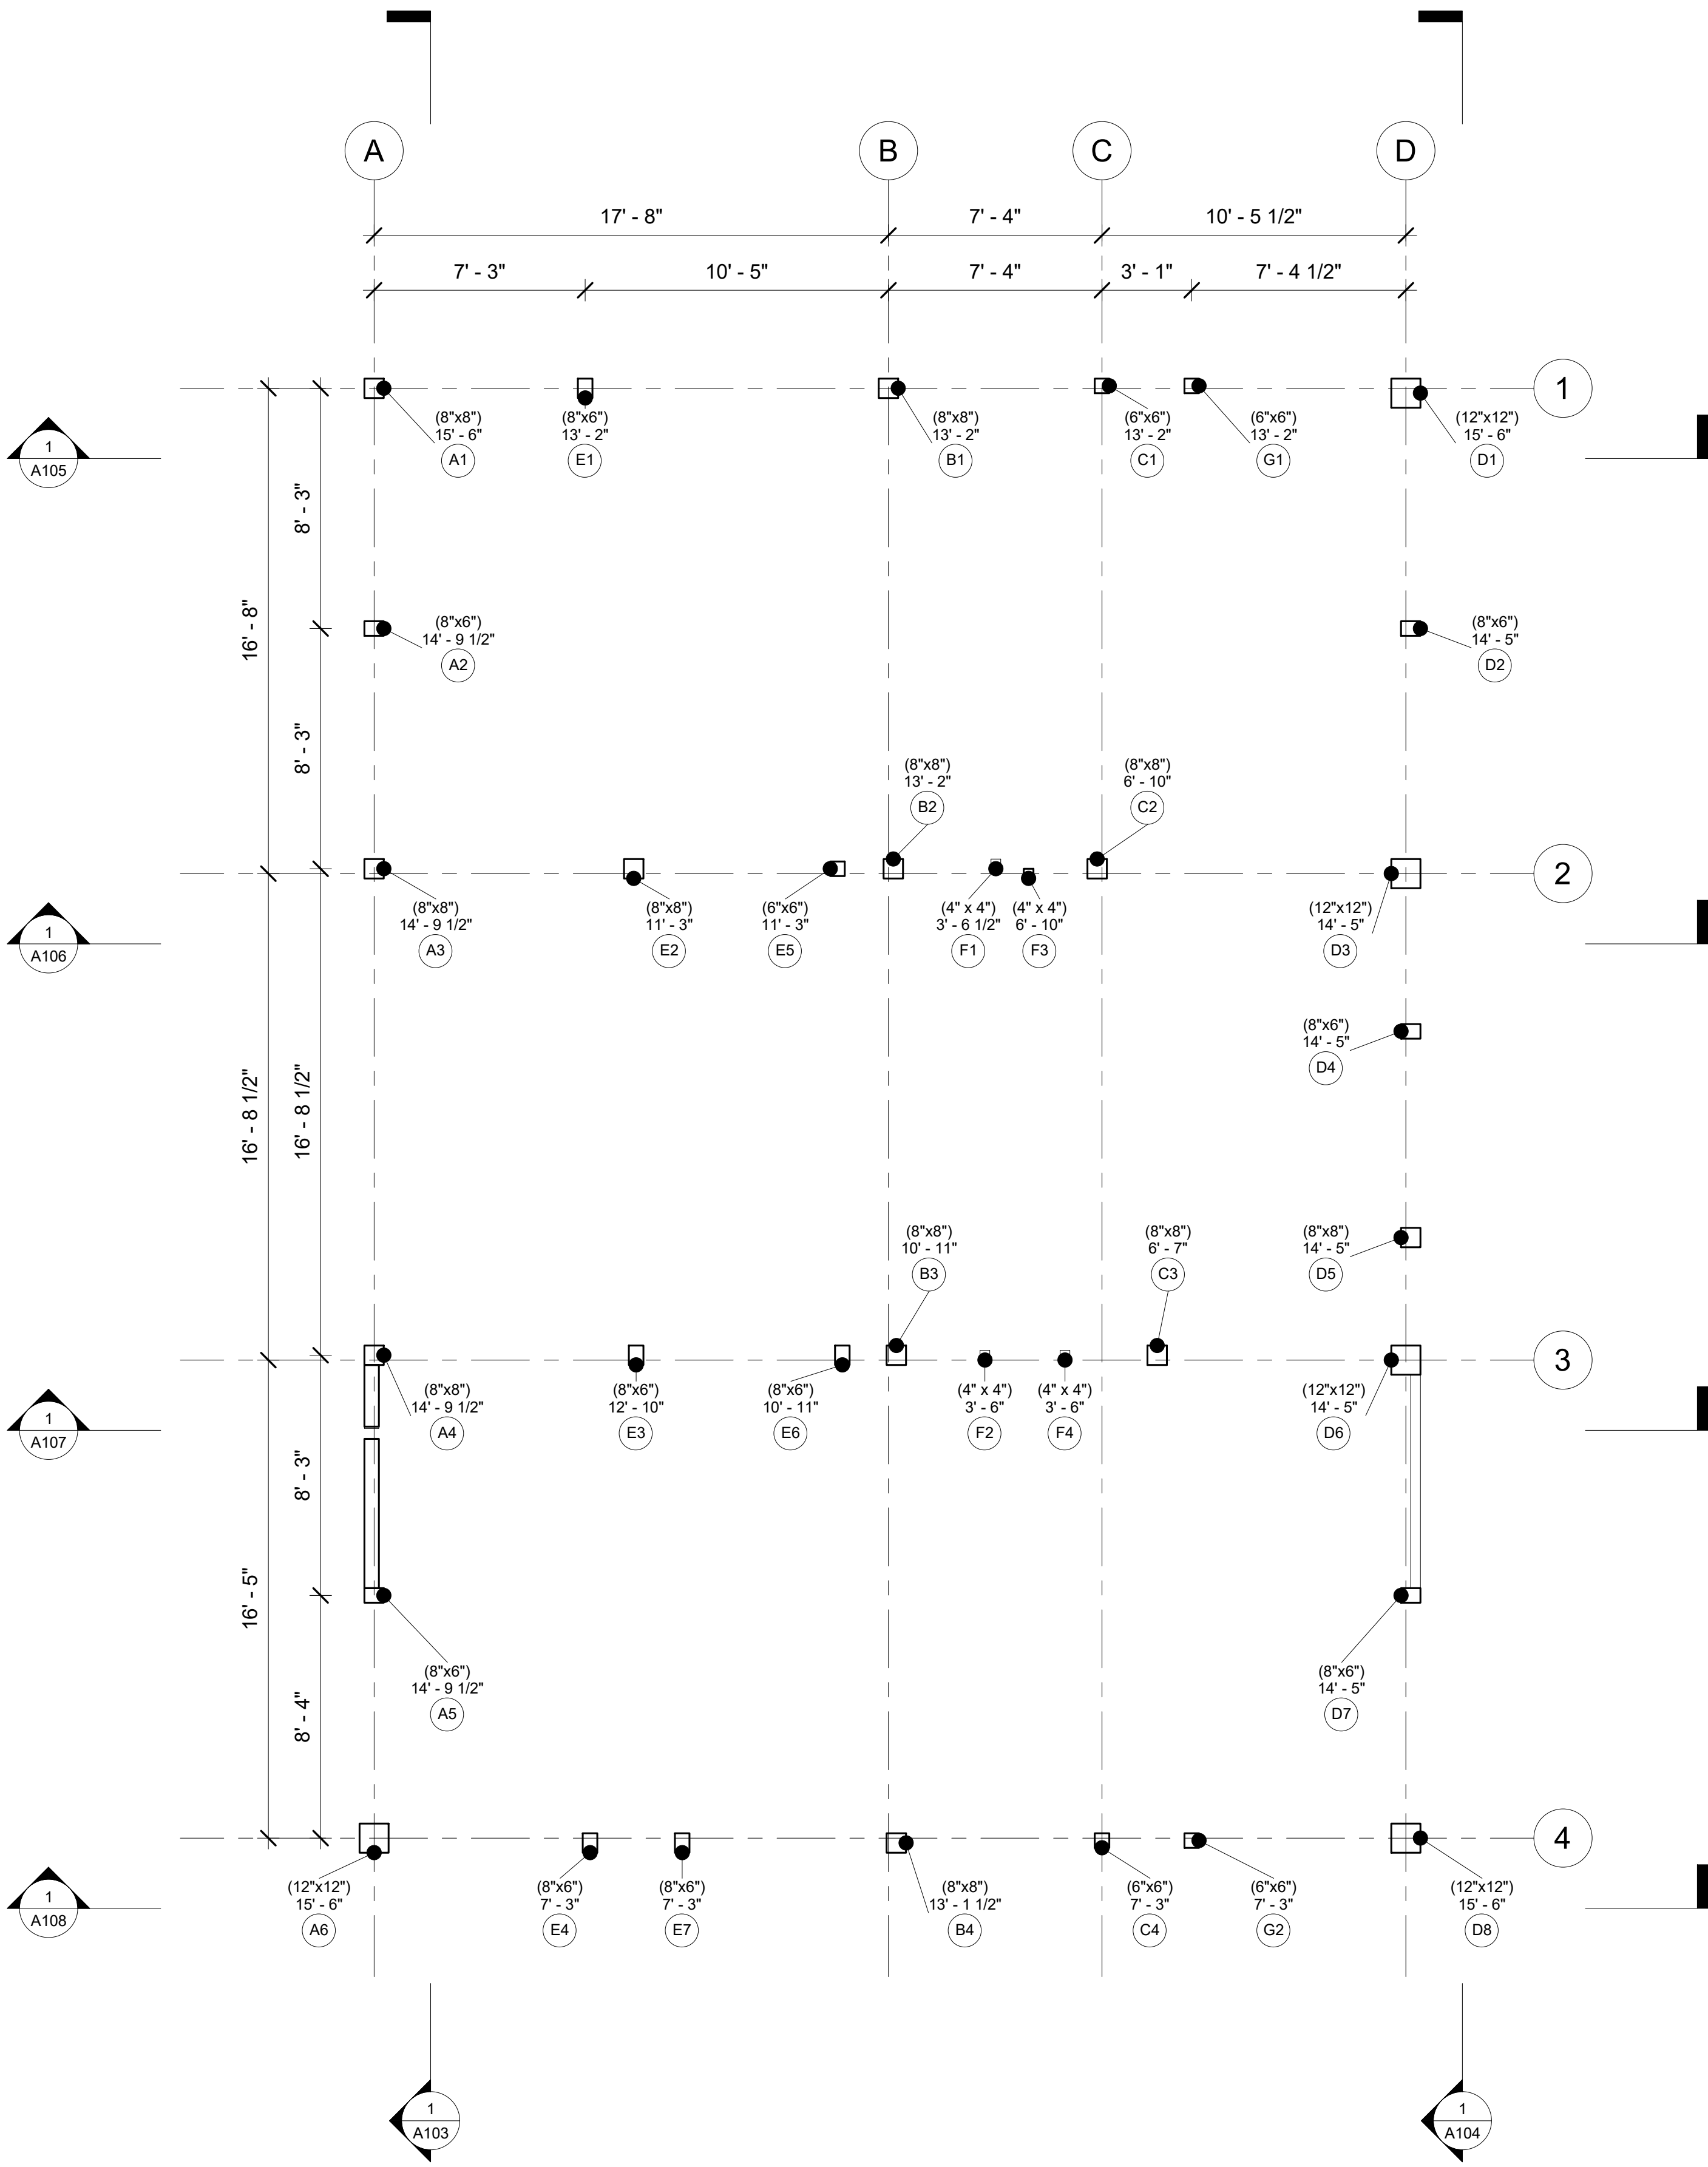


Timber Home Services LLC

Sawmill Run

CELL PHONE/TEXT - 412-309-1161

DANTRIMBLE@TIMBERHOMESERVICES.COM

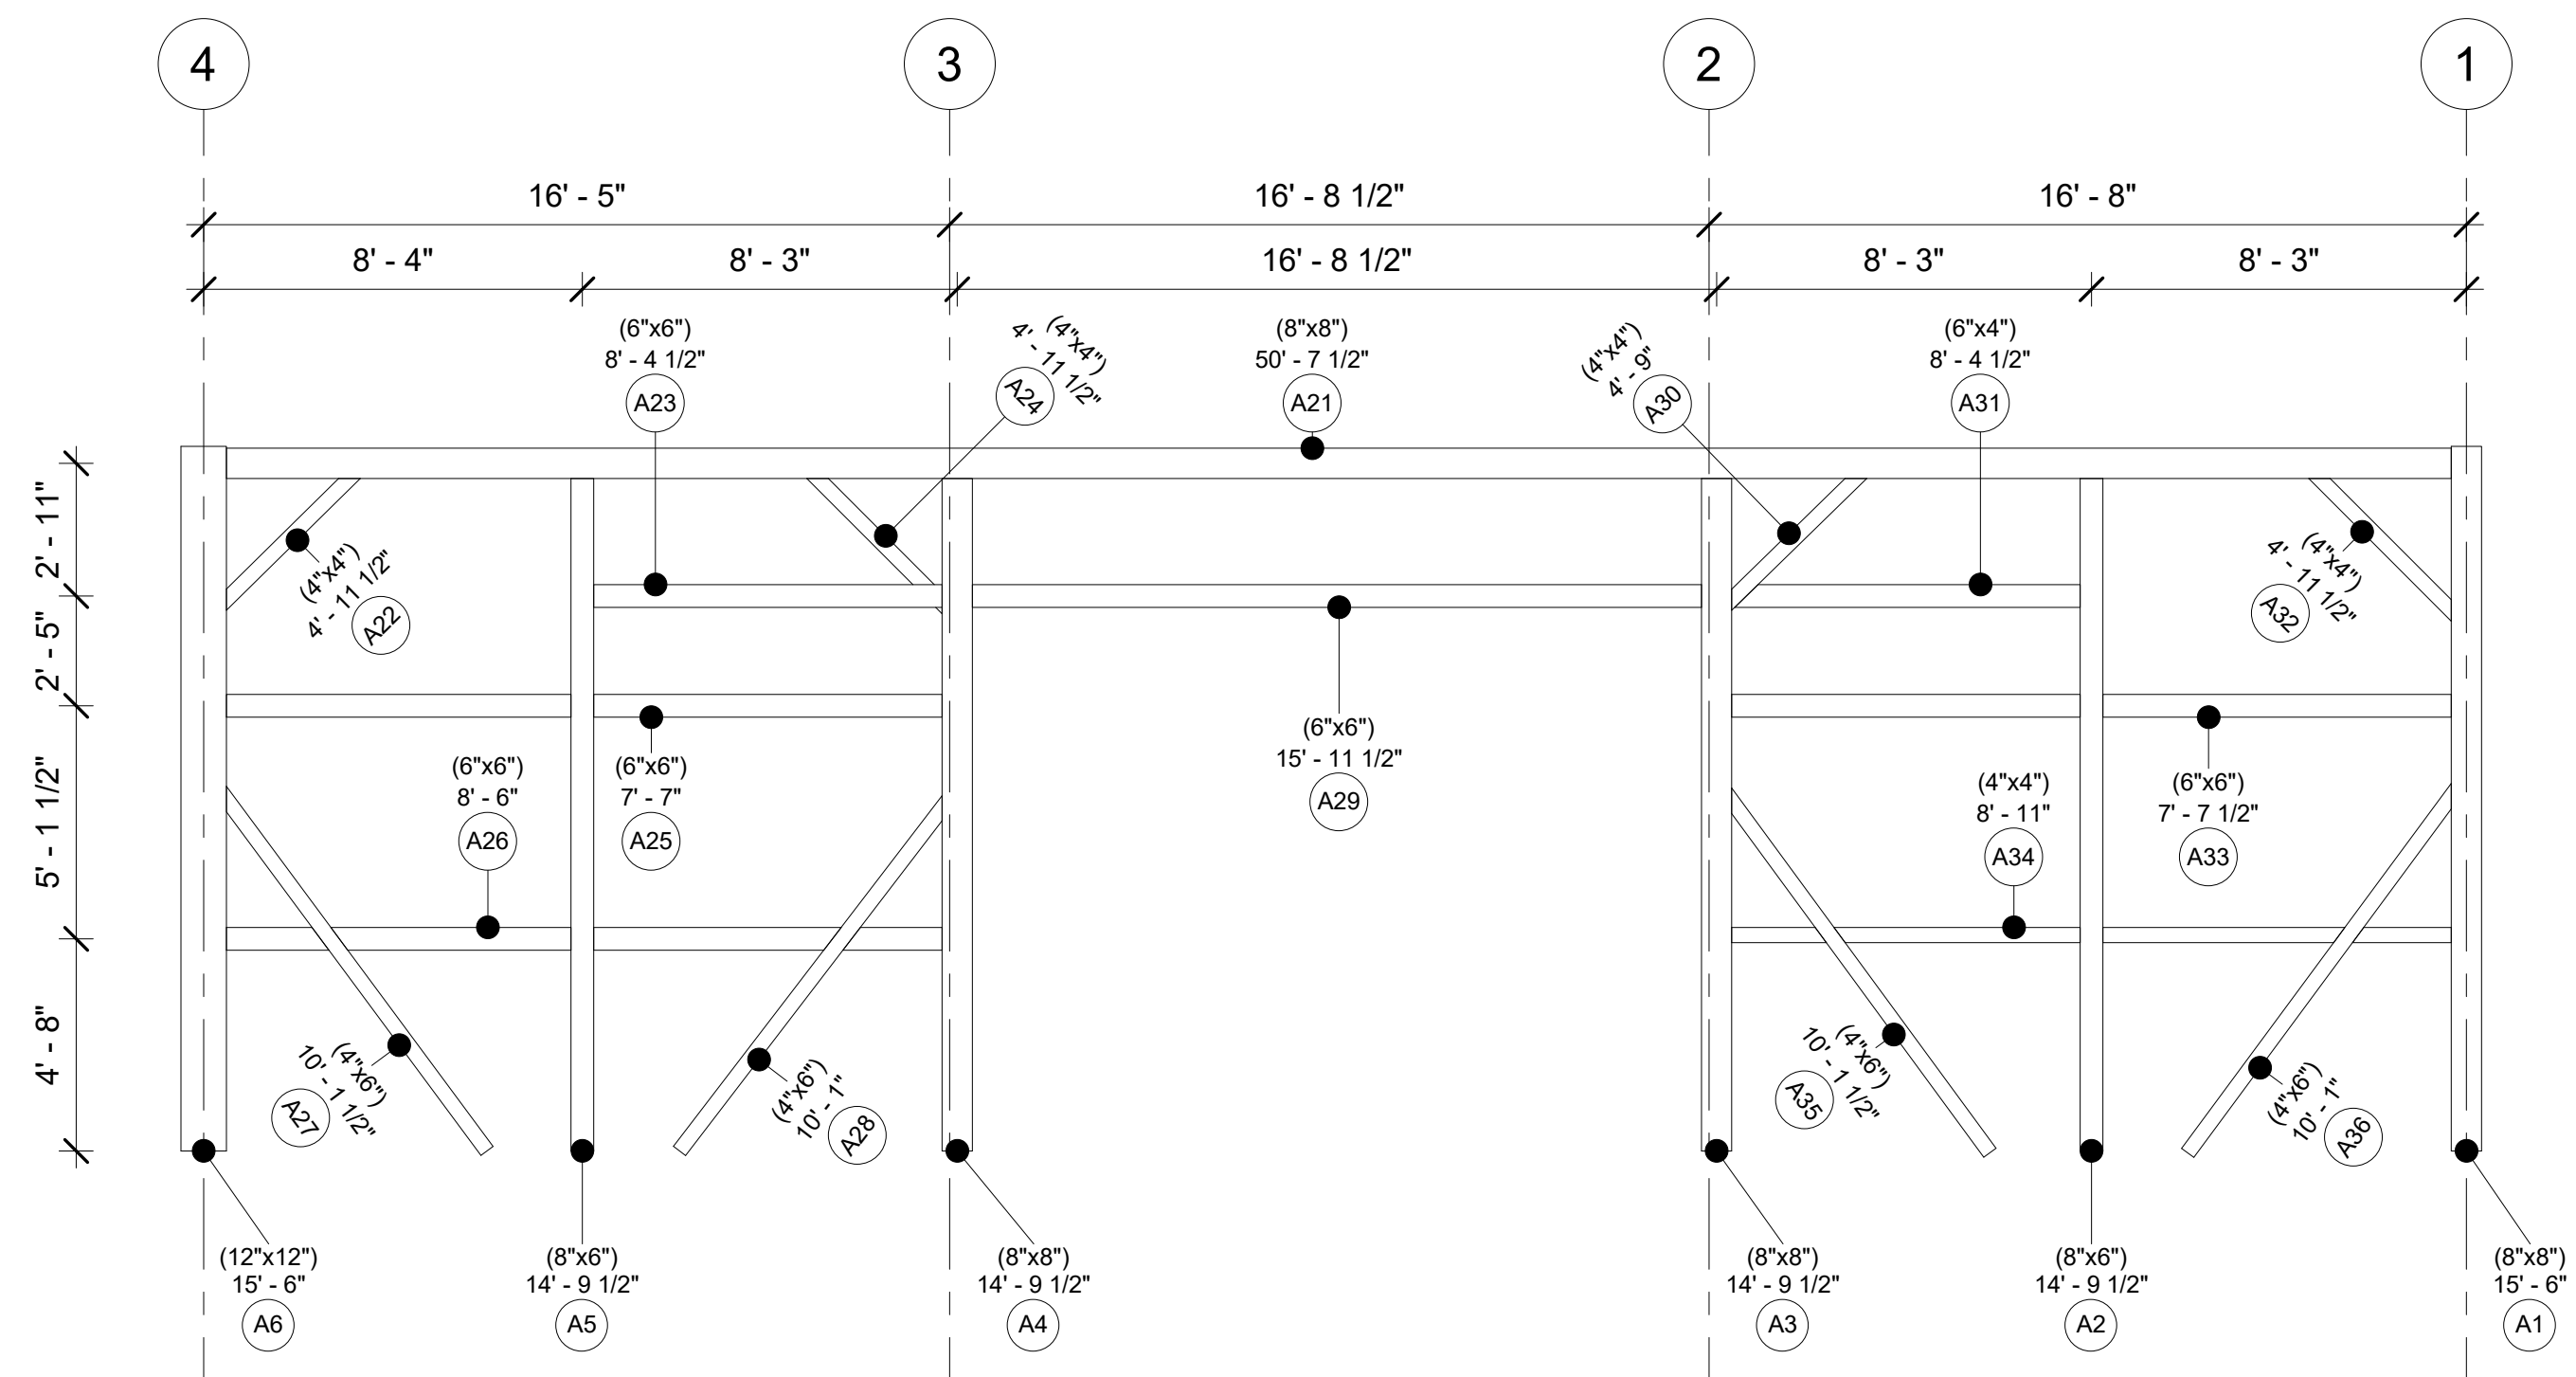

Bent A

Date 20250811

Checked By _____


A103

Timber
Home
Services LLC

Sawmill Run

DAN TRIMBLE
AA66 / TIMBER HOME SERVICES
CELL PHONE/TEXT - 412-309-1161

EMAIL:
DANTRIMBLE@TIMBERHOMESERVICES.COM

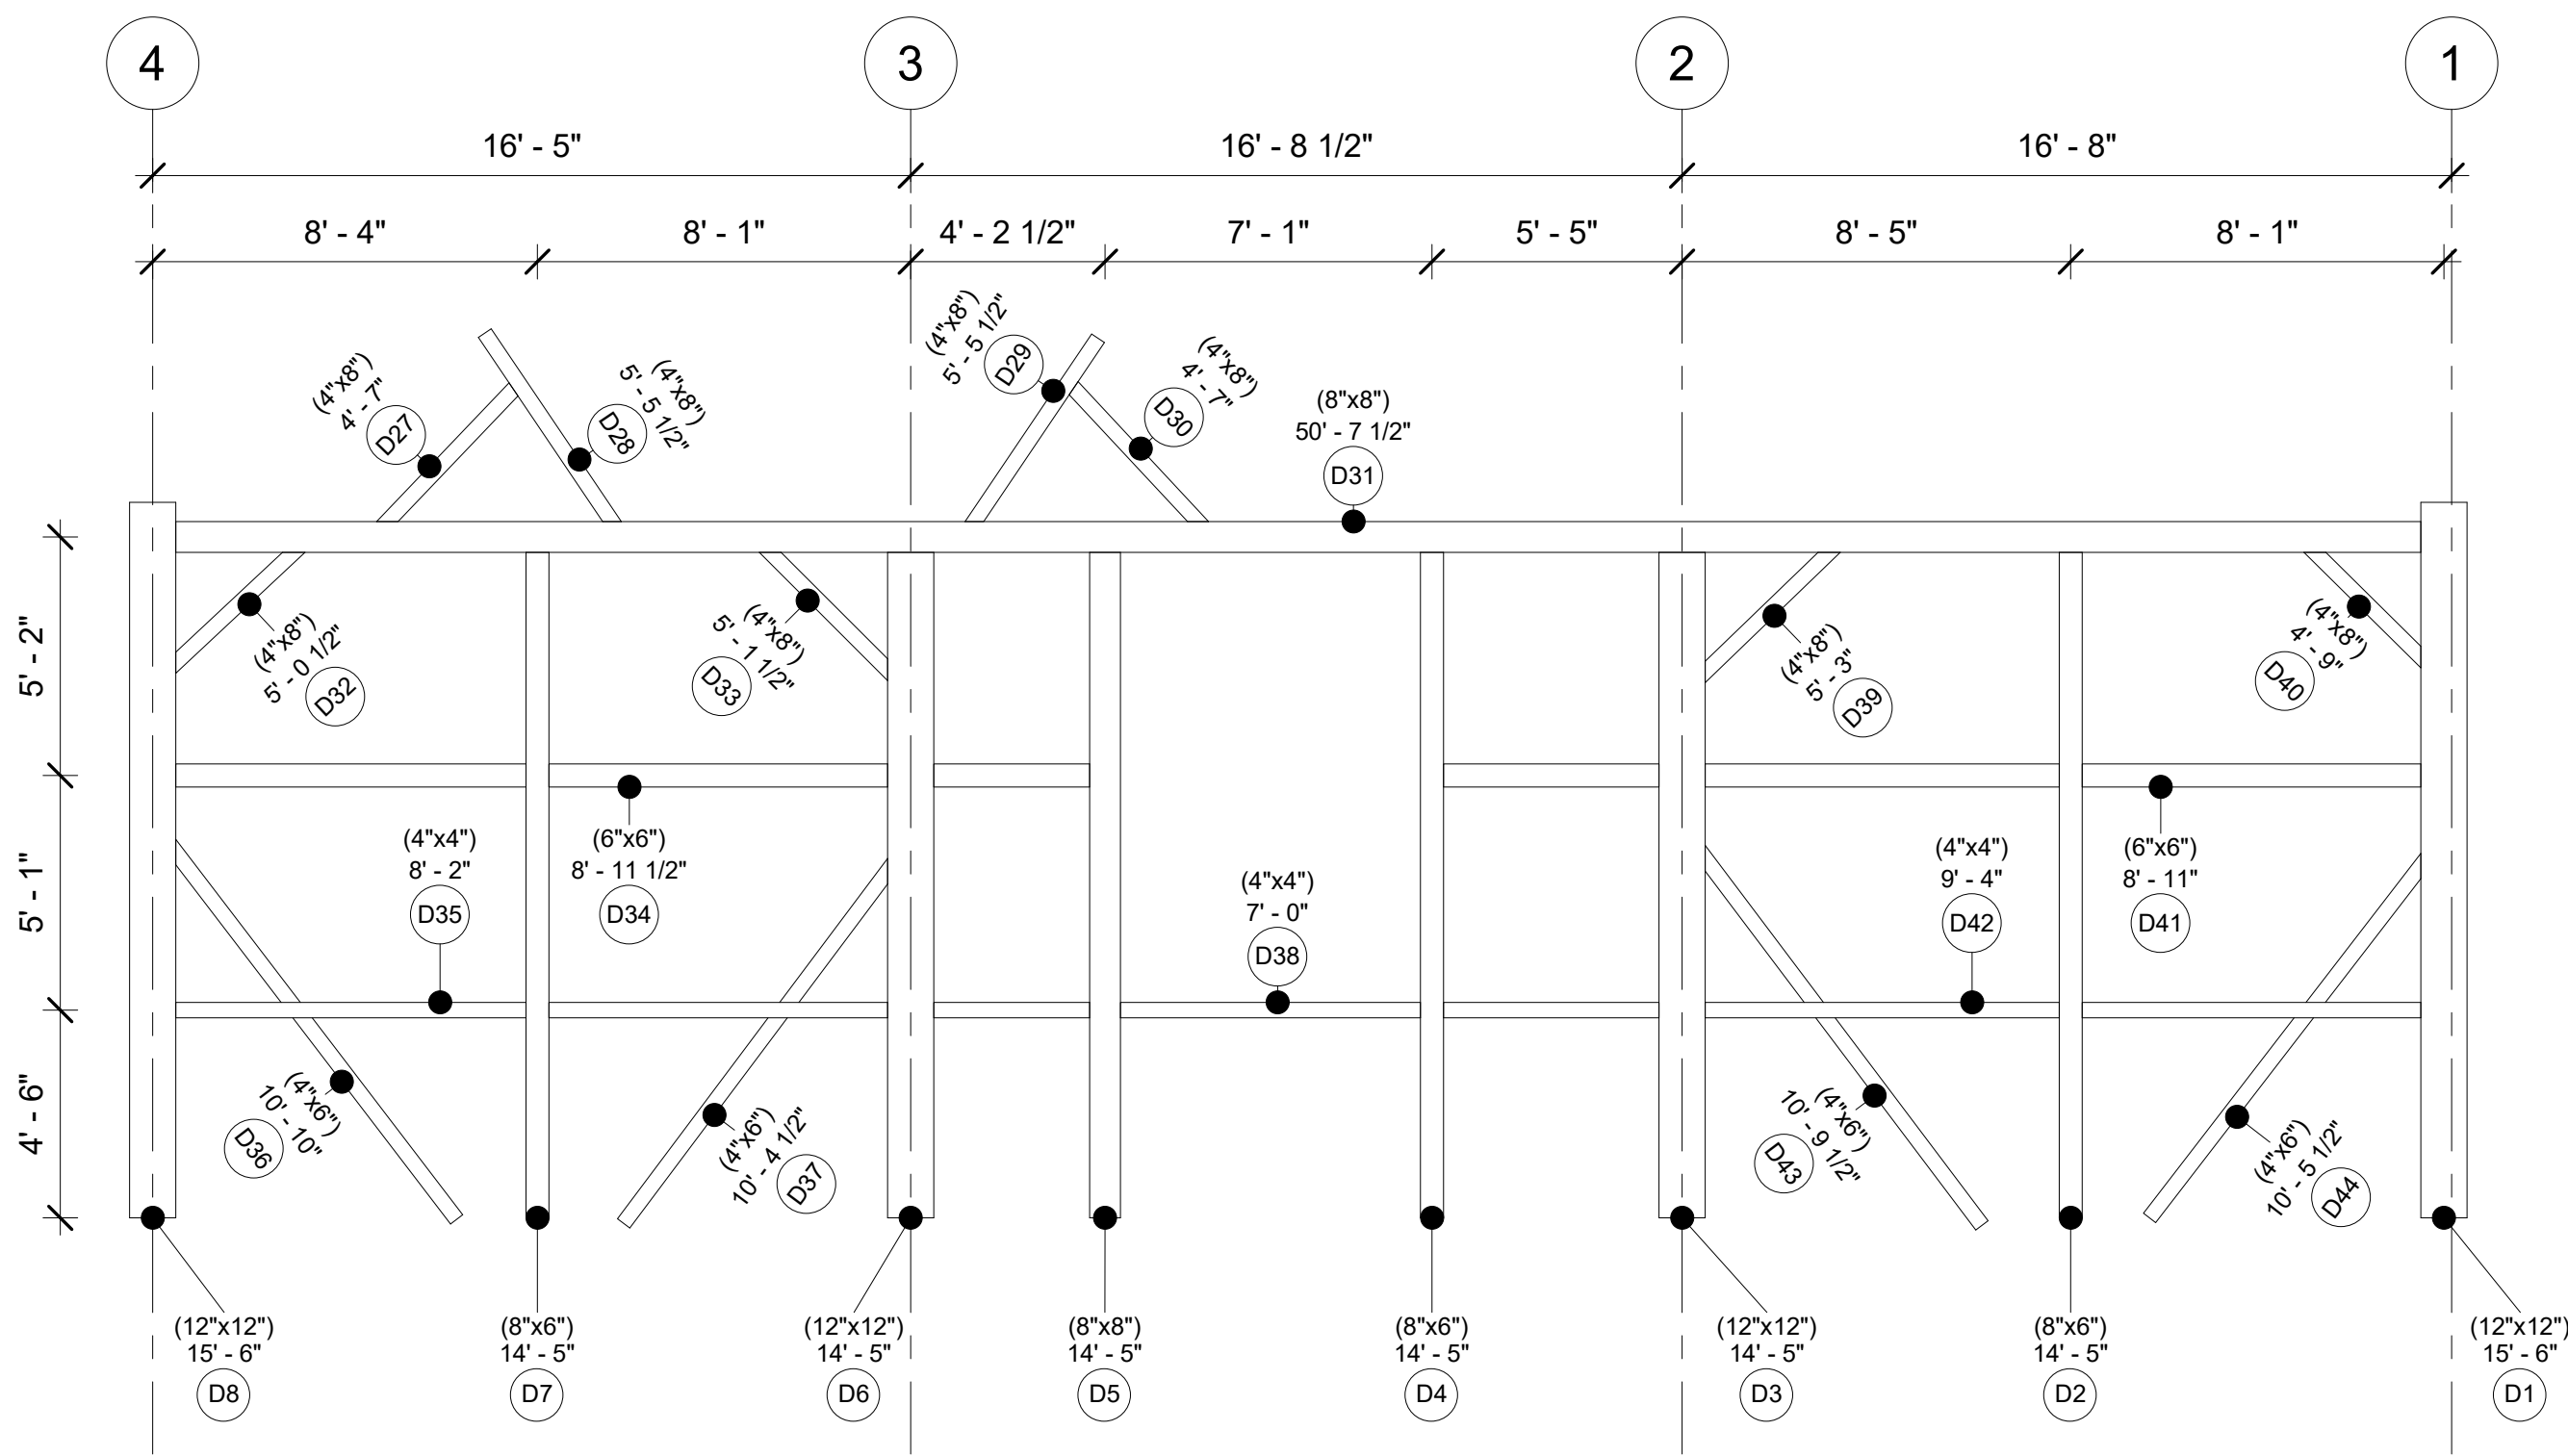

Bent B


Project Number	Project 19
Date	20250811
Drawn By	
Checked By	
A104	
Scale	1/4" = 1'-0"

Timber Home Services LLC

Sawmill Run

CELL PHONE/TEXT - 412-309-1161

DANTRIMBLE@TIMBERHOMESERVICES.COM

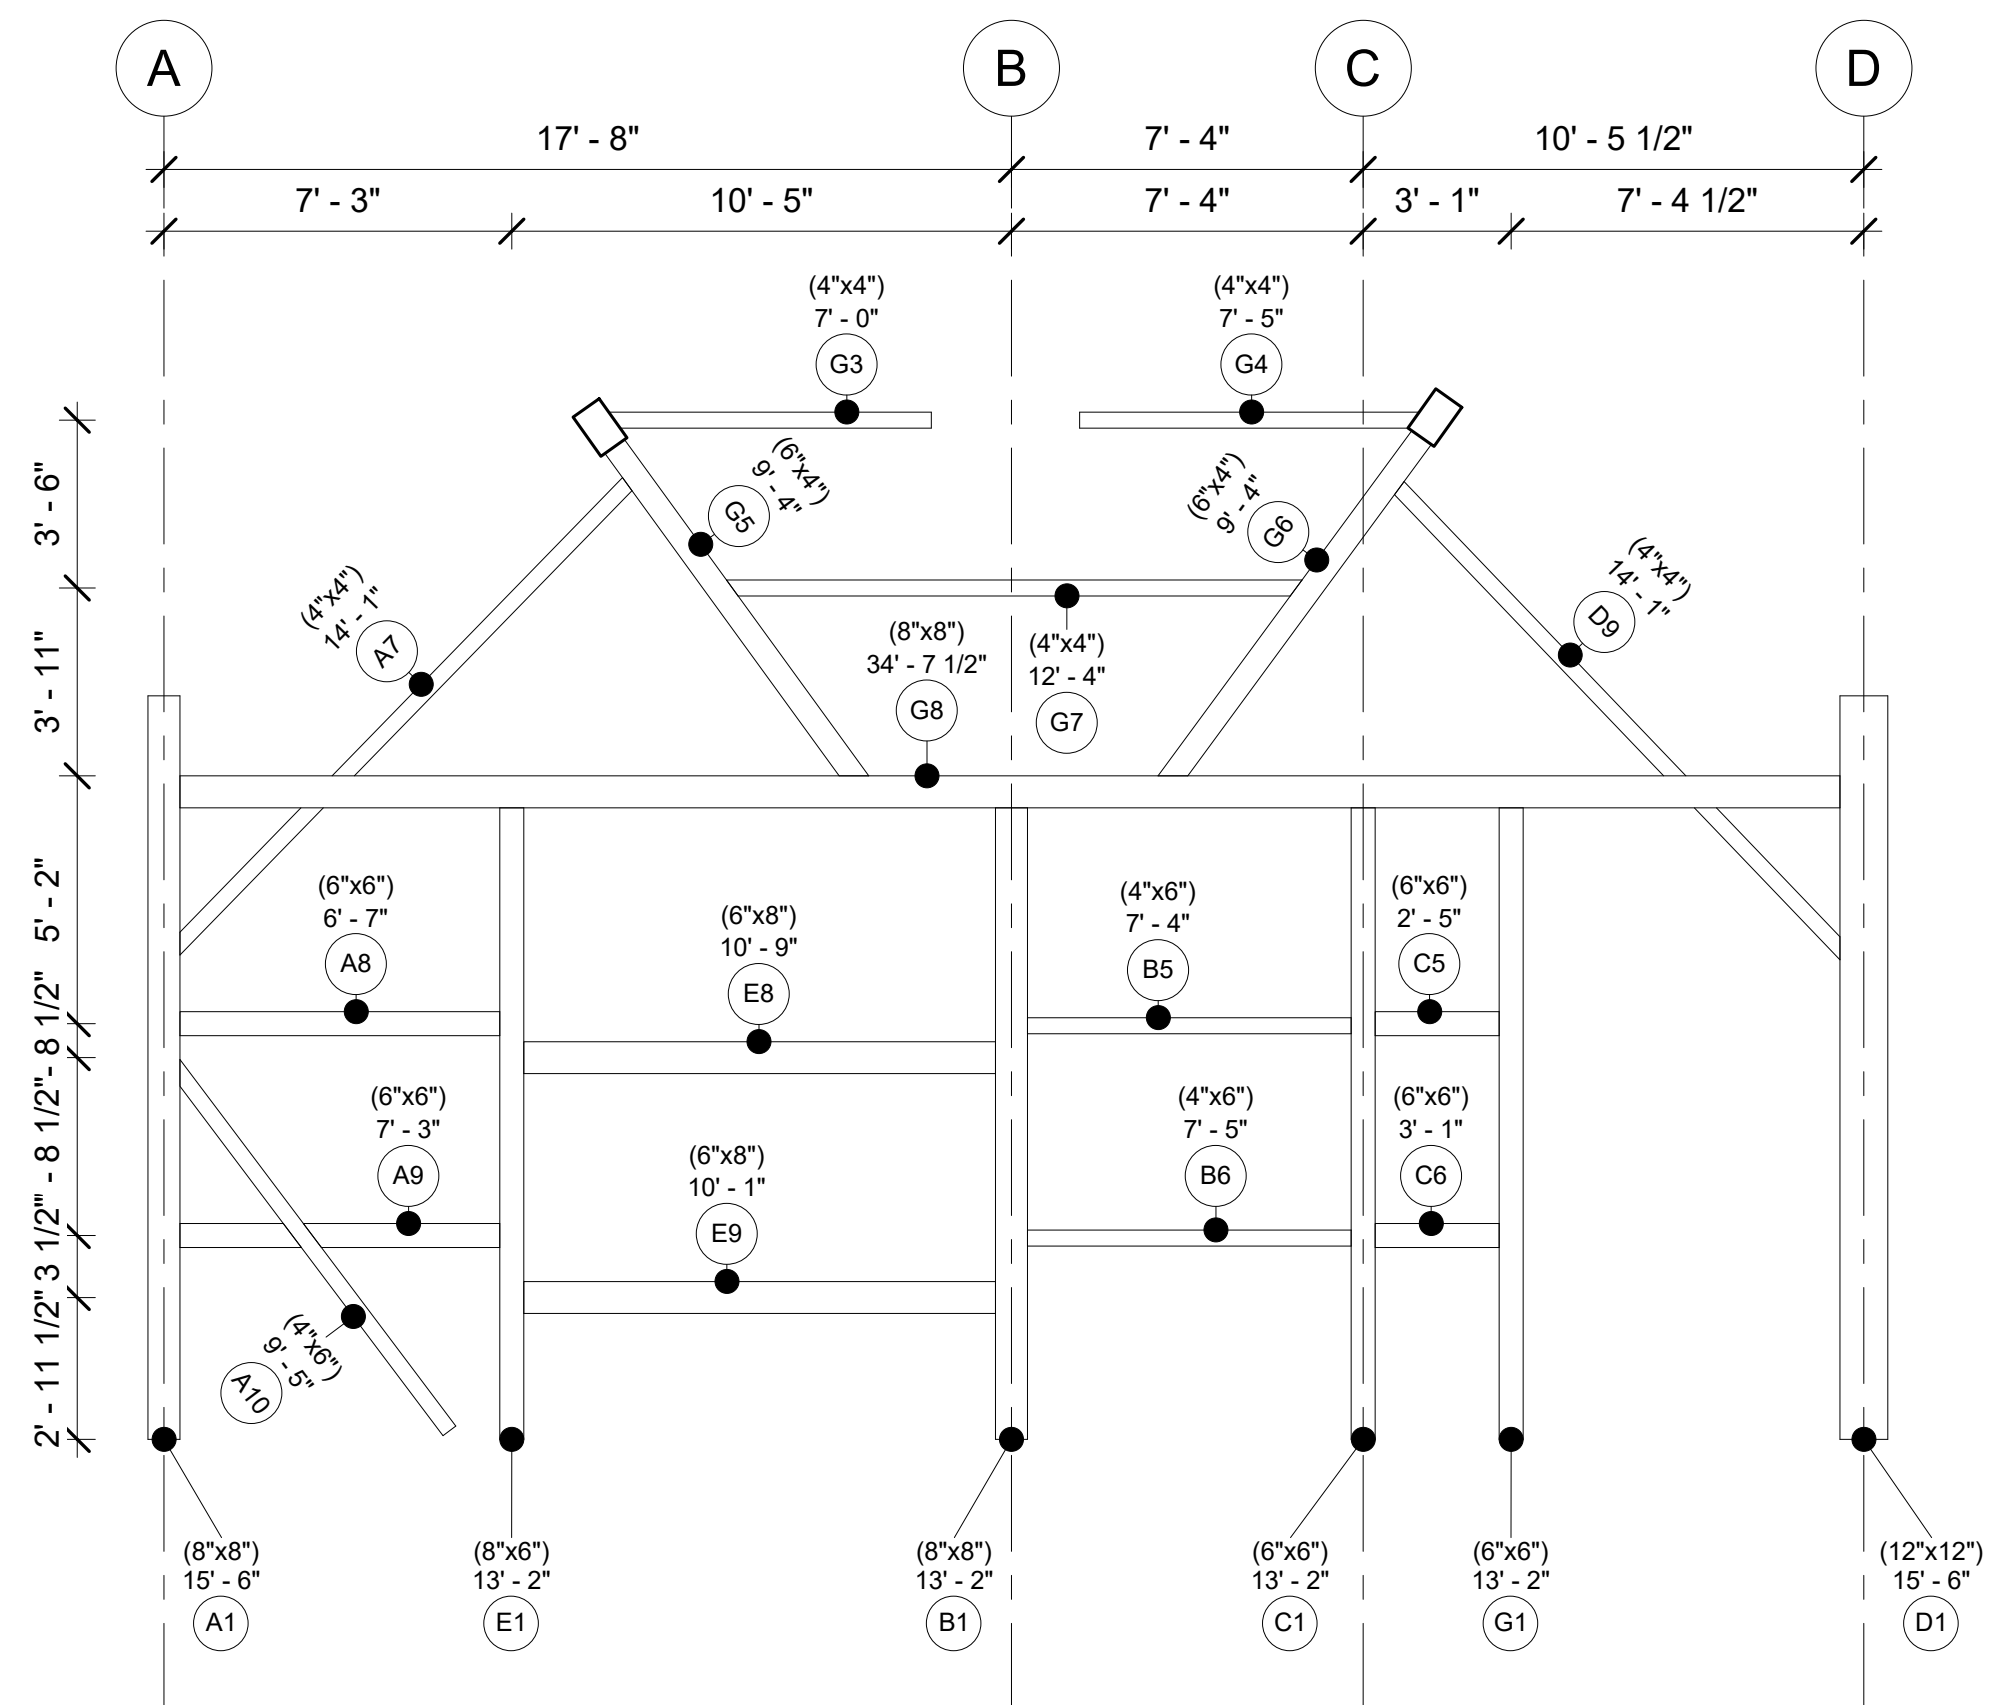

Bent 1

Date	20250811
------	----------

Checked By

A105

Timber
Home
Services LLC


Sawmill Run

DAN TRIMBLE
AA66 / TIMBER HOME SERVICES

CELL PHONE/TEXT - 412-309-1161

EMAIL:

DANTRIMBLE@TIMBERHOMESERVICES.COM

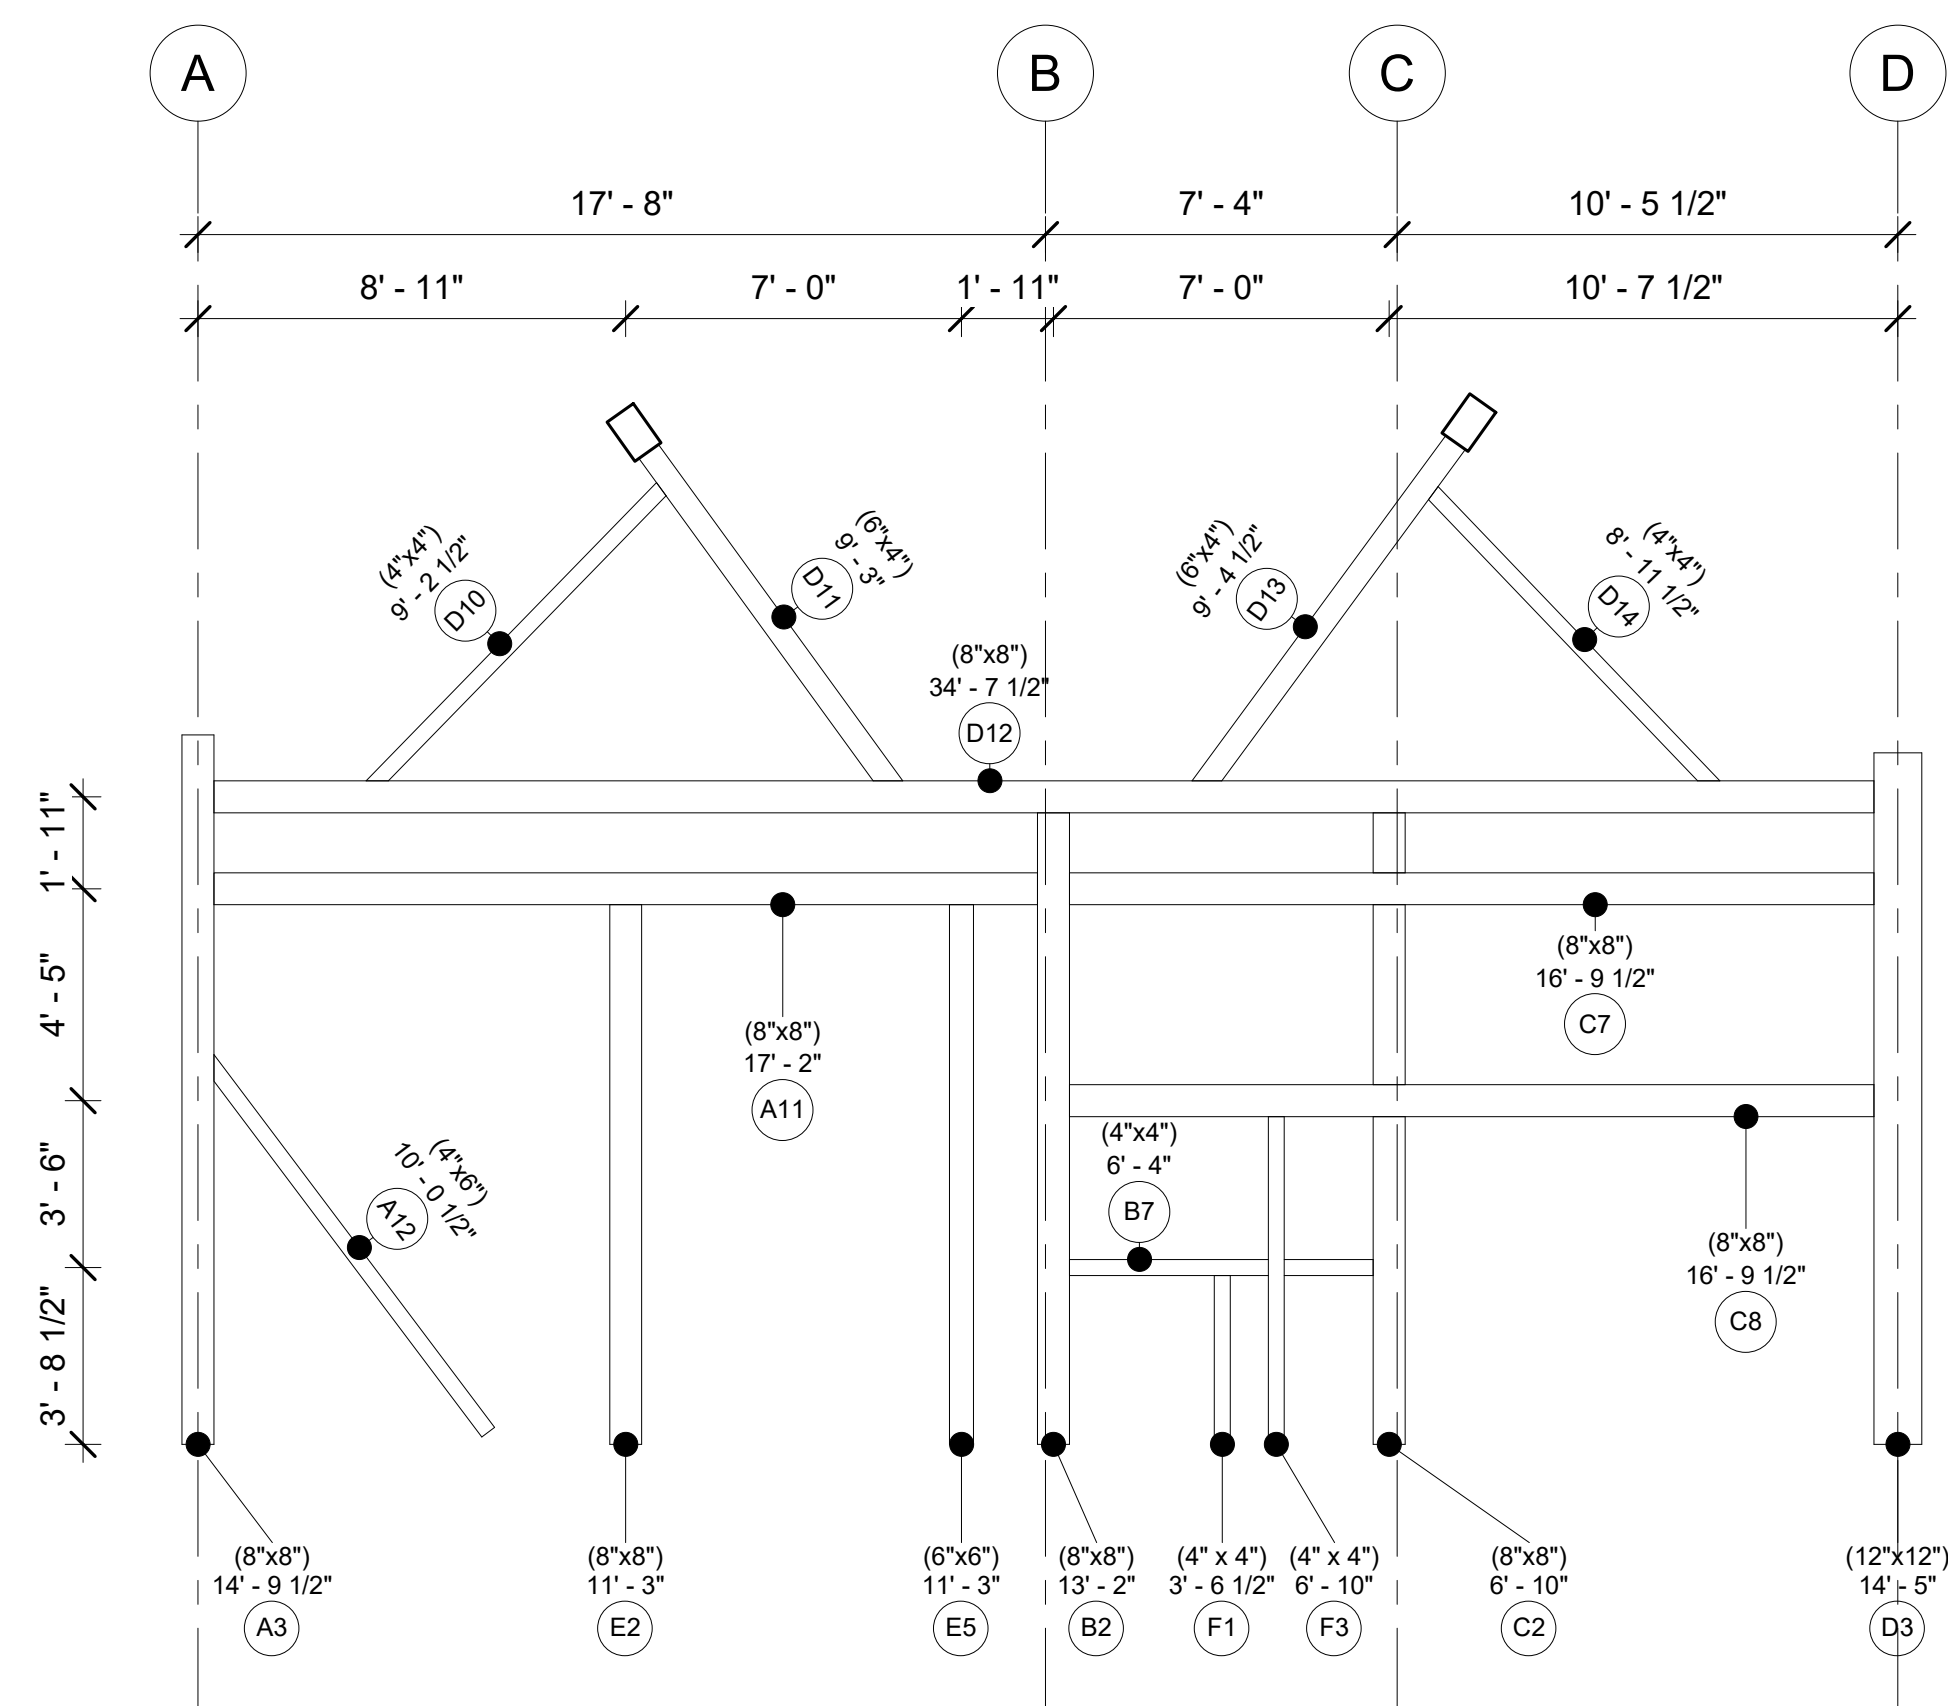

Bent 2

Project Number Project 19

Date	20250811
------	----------

Drawn By _____

Checked By _____

A106


Scale $1/4" = 1'-0"$

Timber
Home
Services LLC

Sawmill Run

DAN TRIMBLE
AA66 / TIMBER HOME SERVICES
CELL PHONE/TEXT - 412-309-1161

EMAIL:
DANTRIMBLE@TIMBERHOMESERVICES.COM

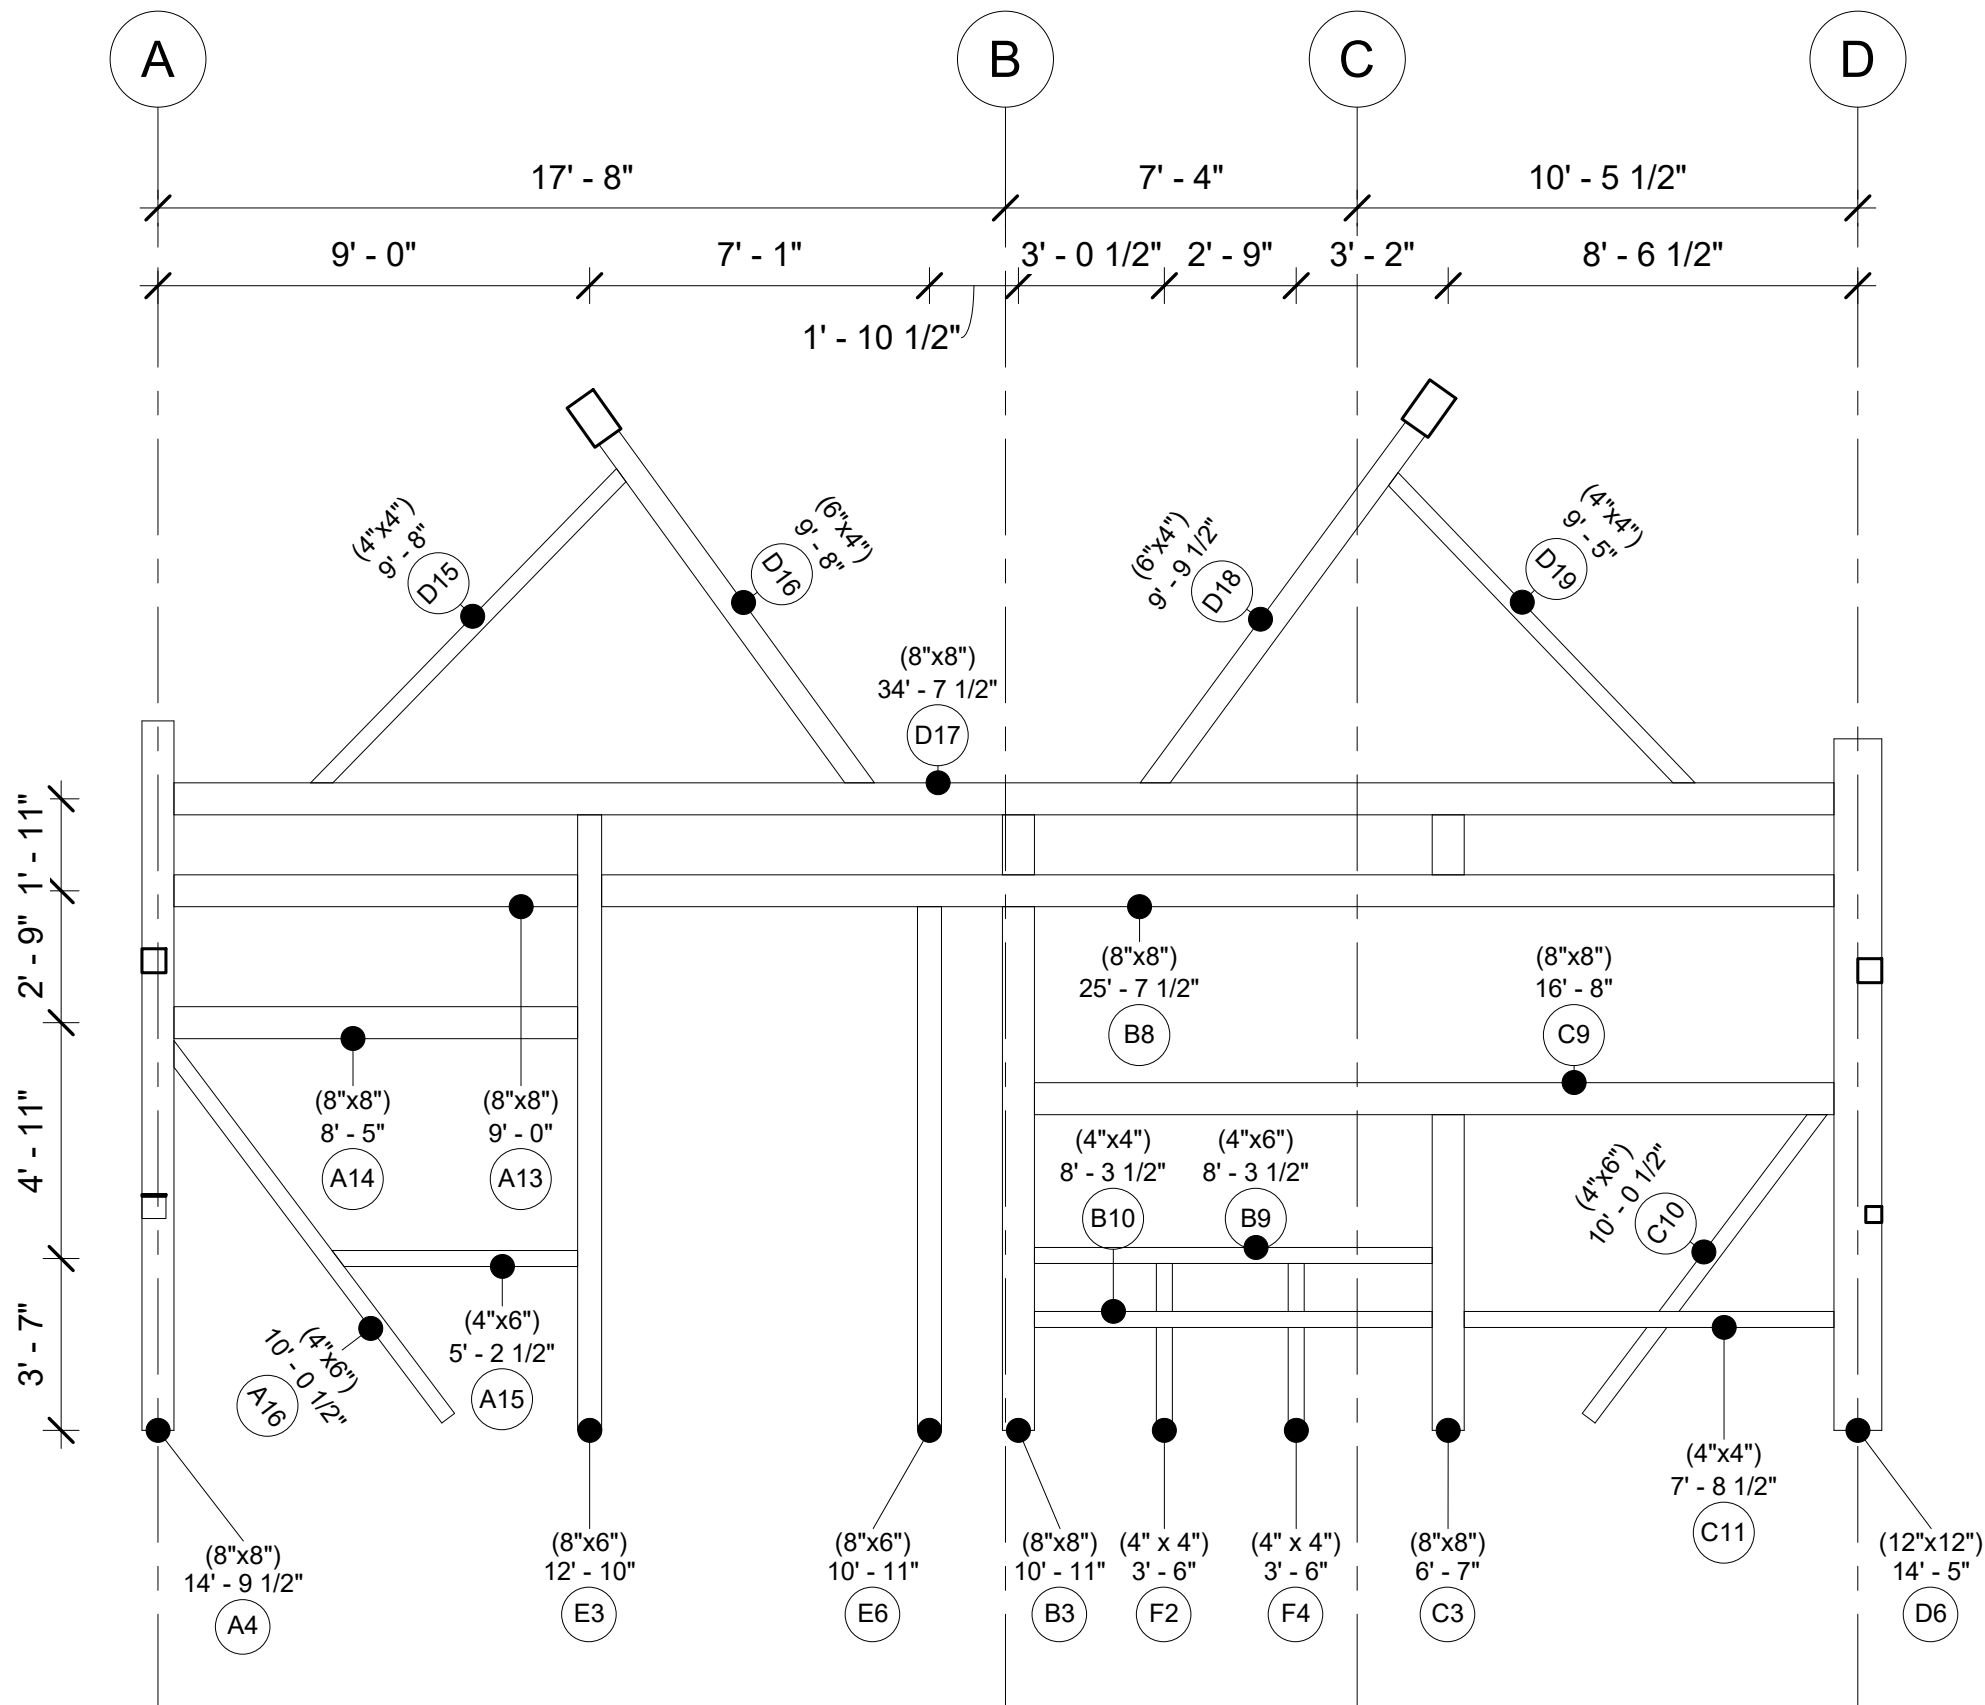

Bent 3


Project Number	Project 19
Date	20250811
Drawn By	
Checked By	
A107	
Scale	1/4" = 1'-0"

Timber
Home
Services LLC

Sawmill Run

DAN TRIMBLE
AA66 / TIMBER HOME SERVICES
CELL PHONE/TEXT - 412-309-1161

EMAIL:
DANTRIMBLE@TIMBERHOMESERVICES.COM

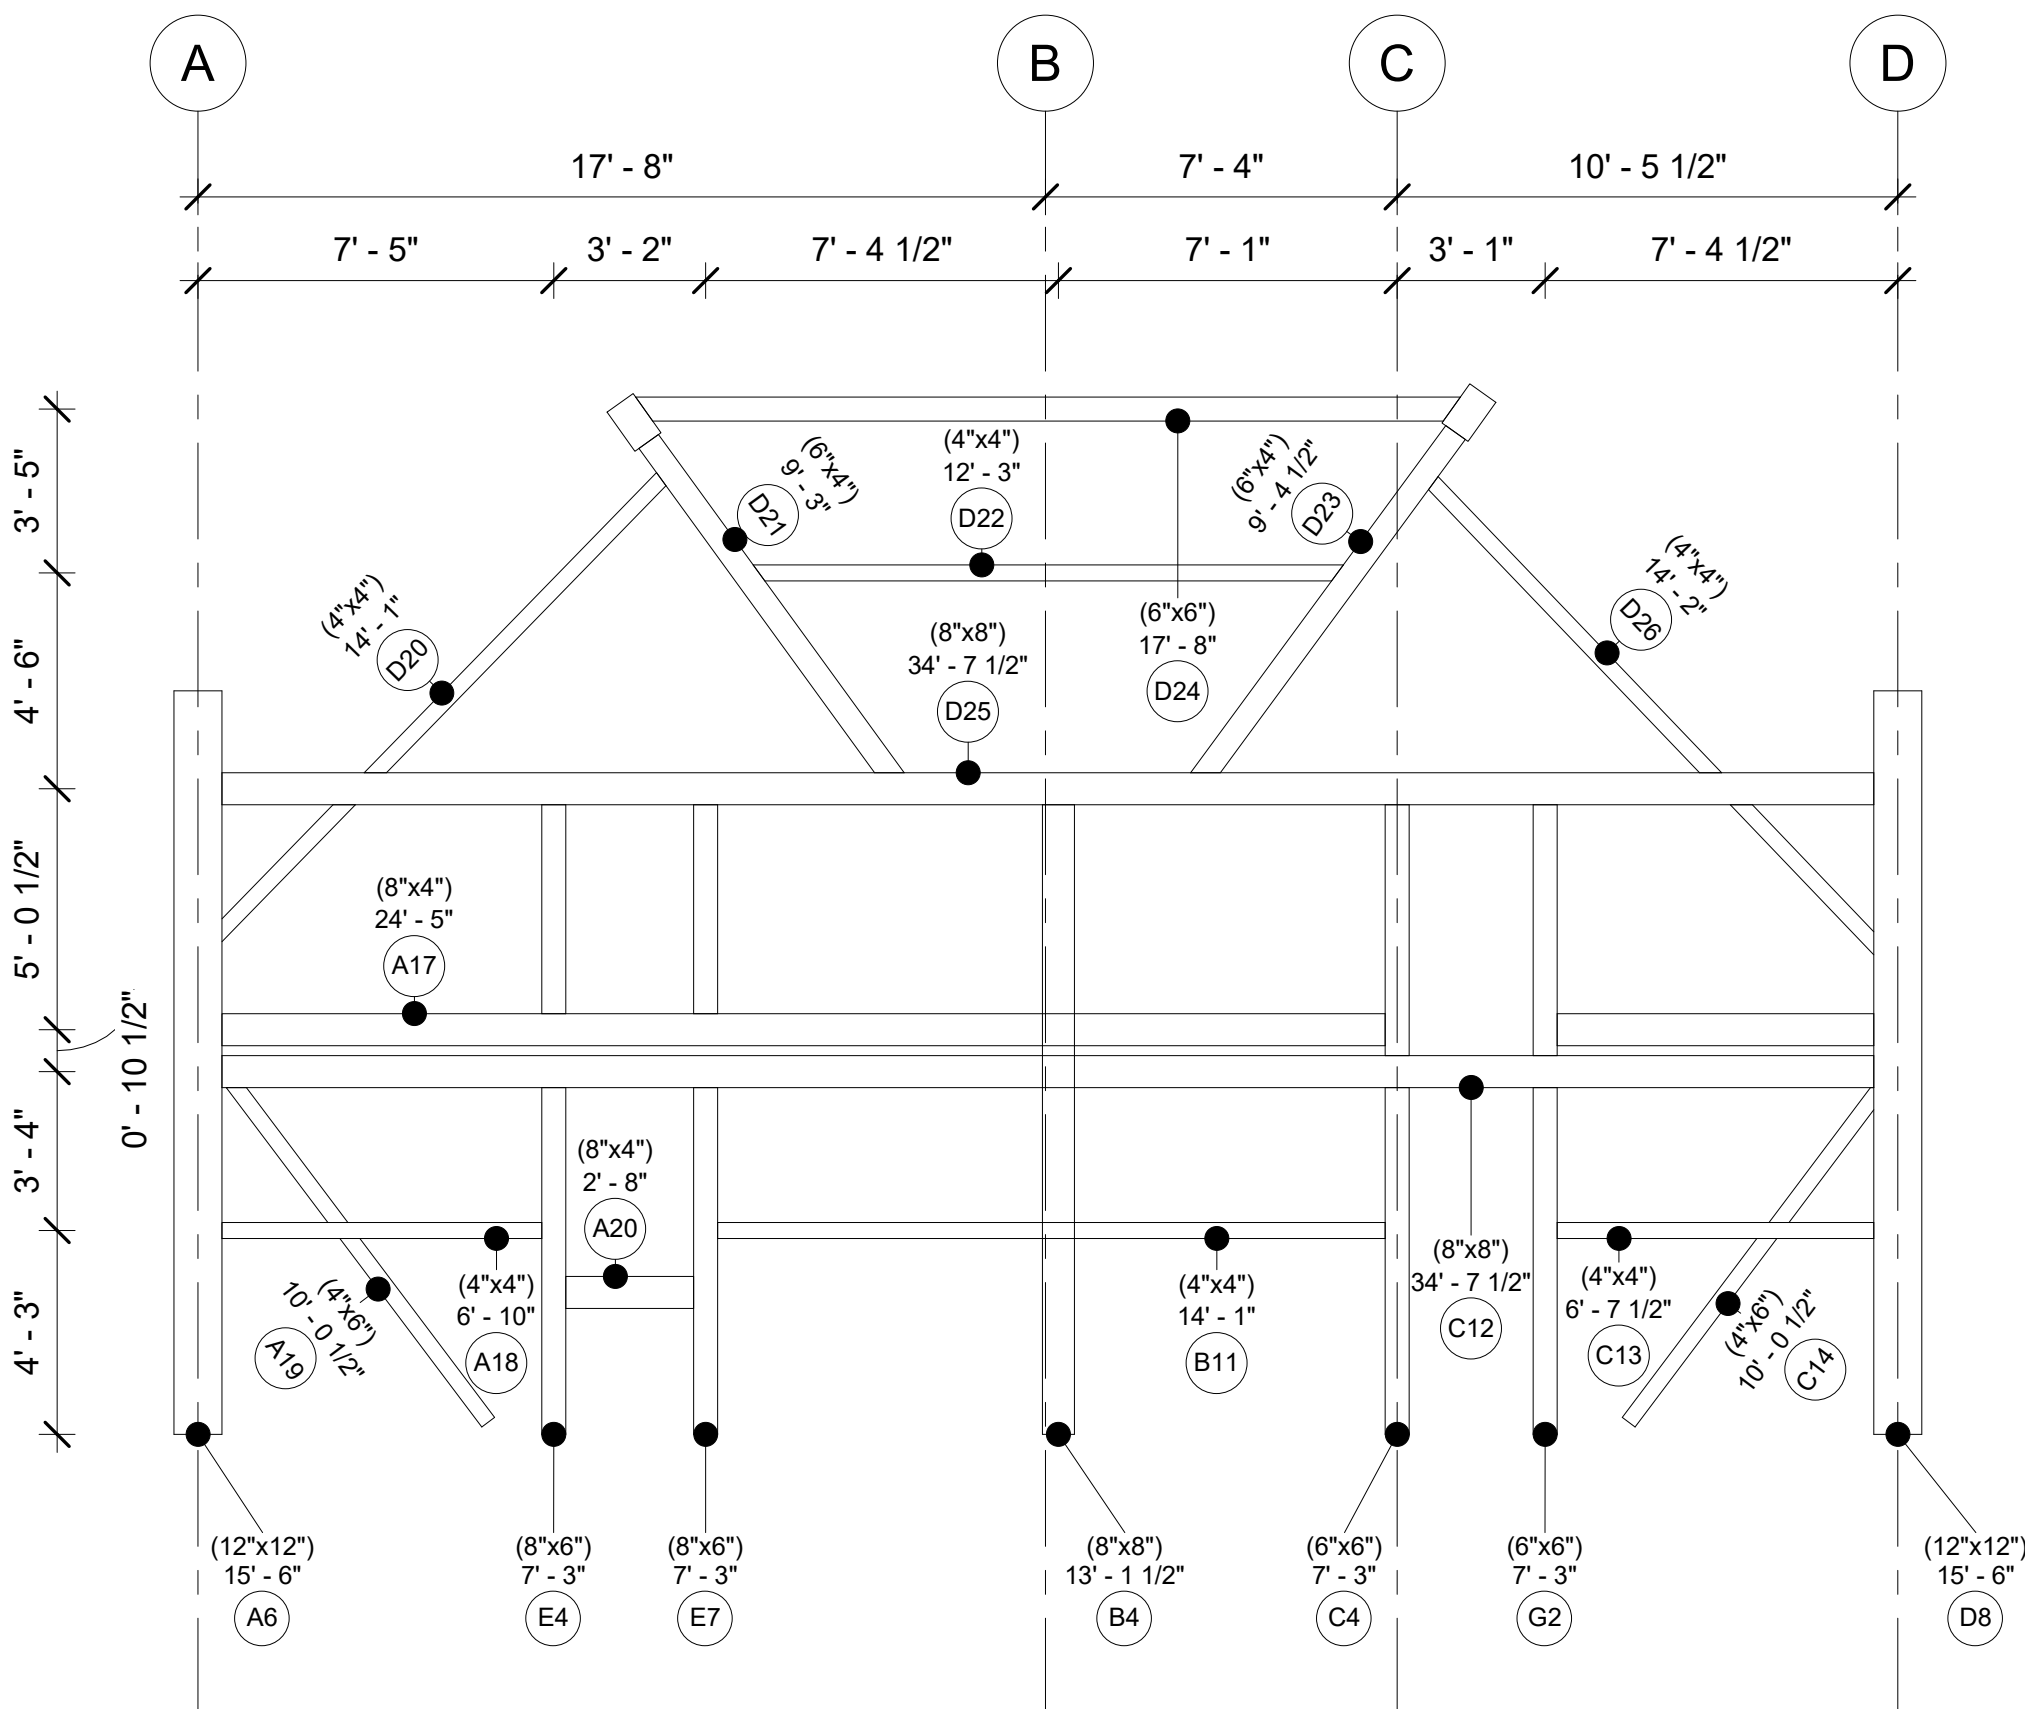

Bent 4

Project Number	Project 19
Date	20250811
Drawn By	
Checked By	
A108	
Scale	1/4" = 1'-0"