


PROJECT: 108 Little-Red

SCOPE: AS BUILT DRAWINGS

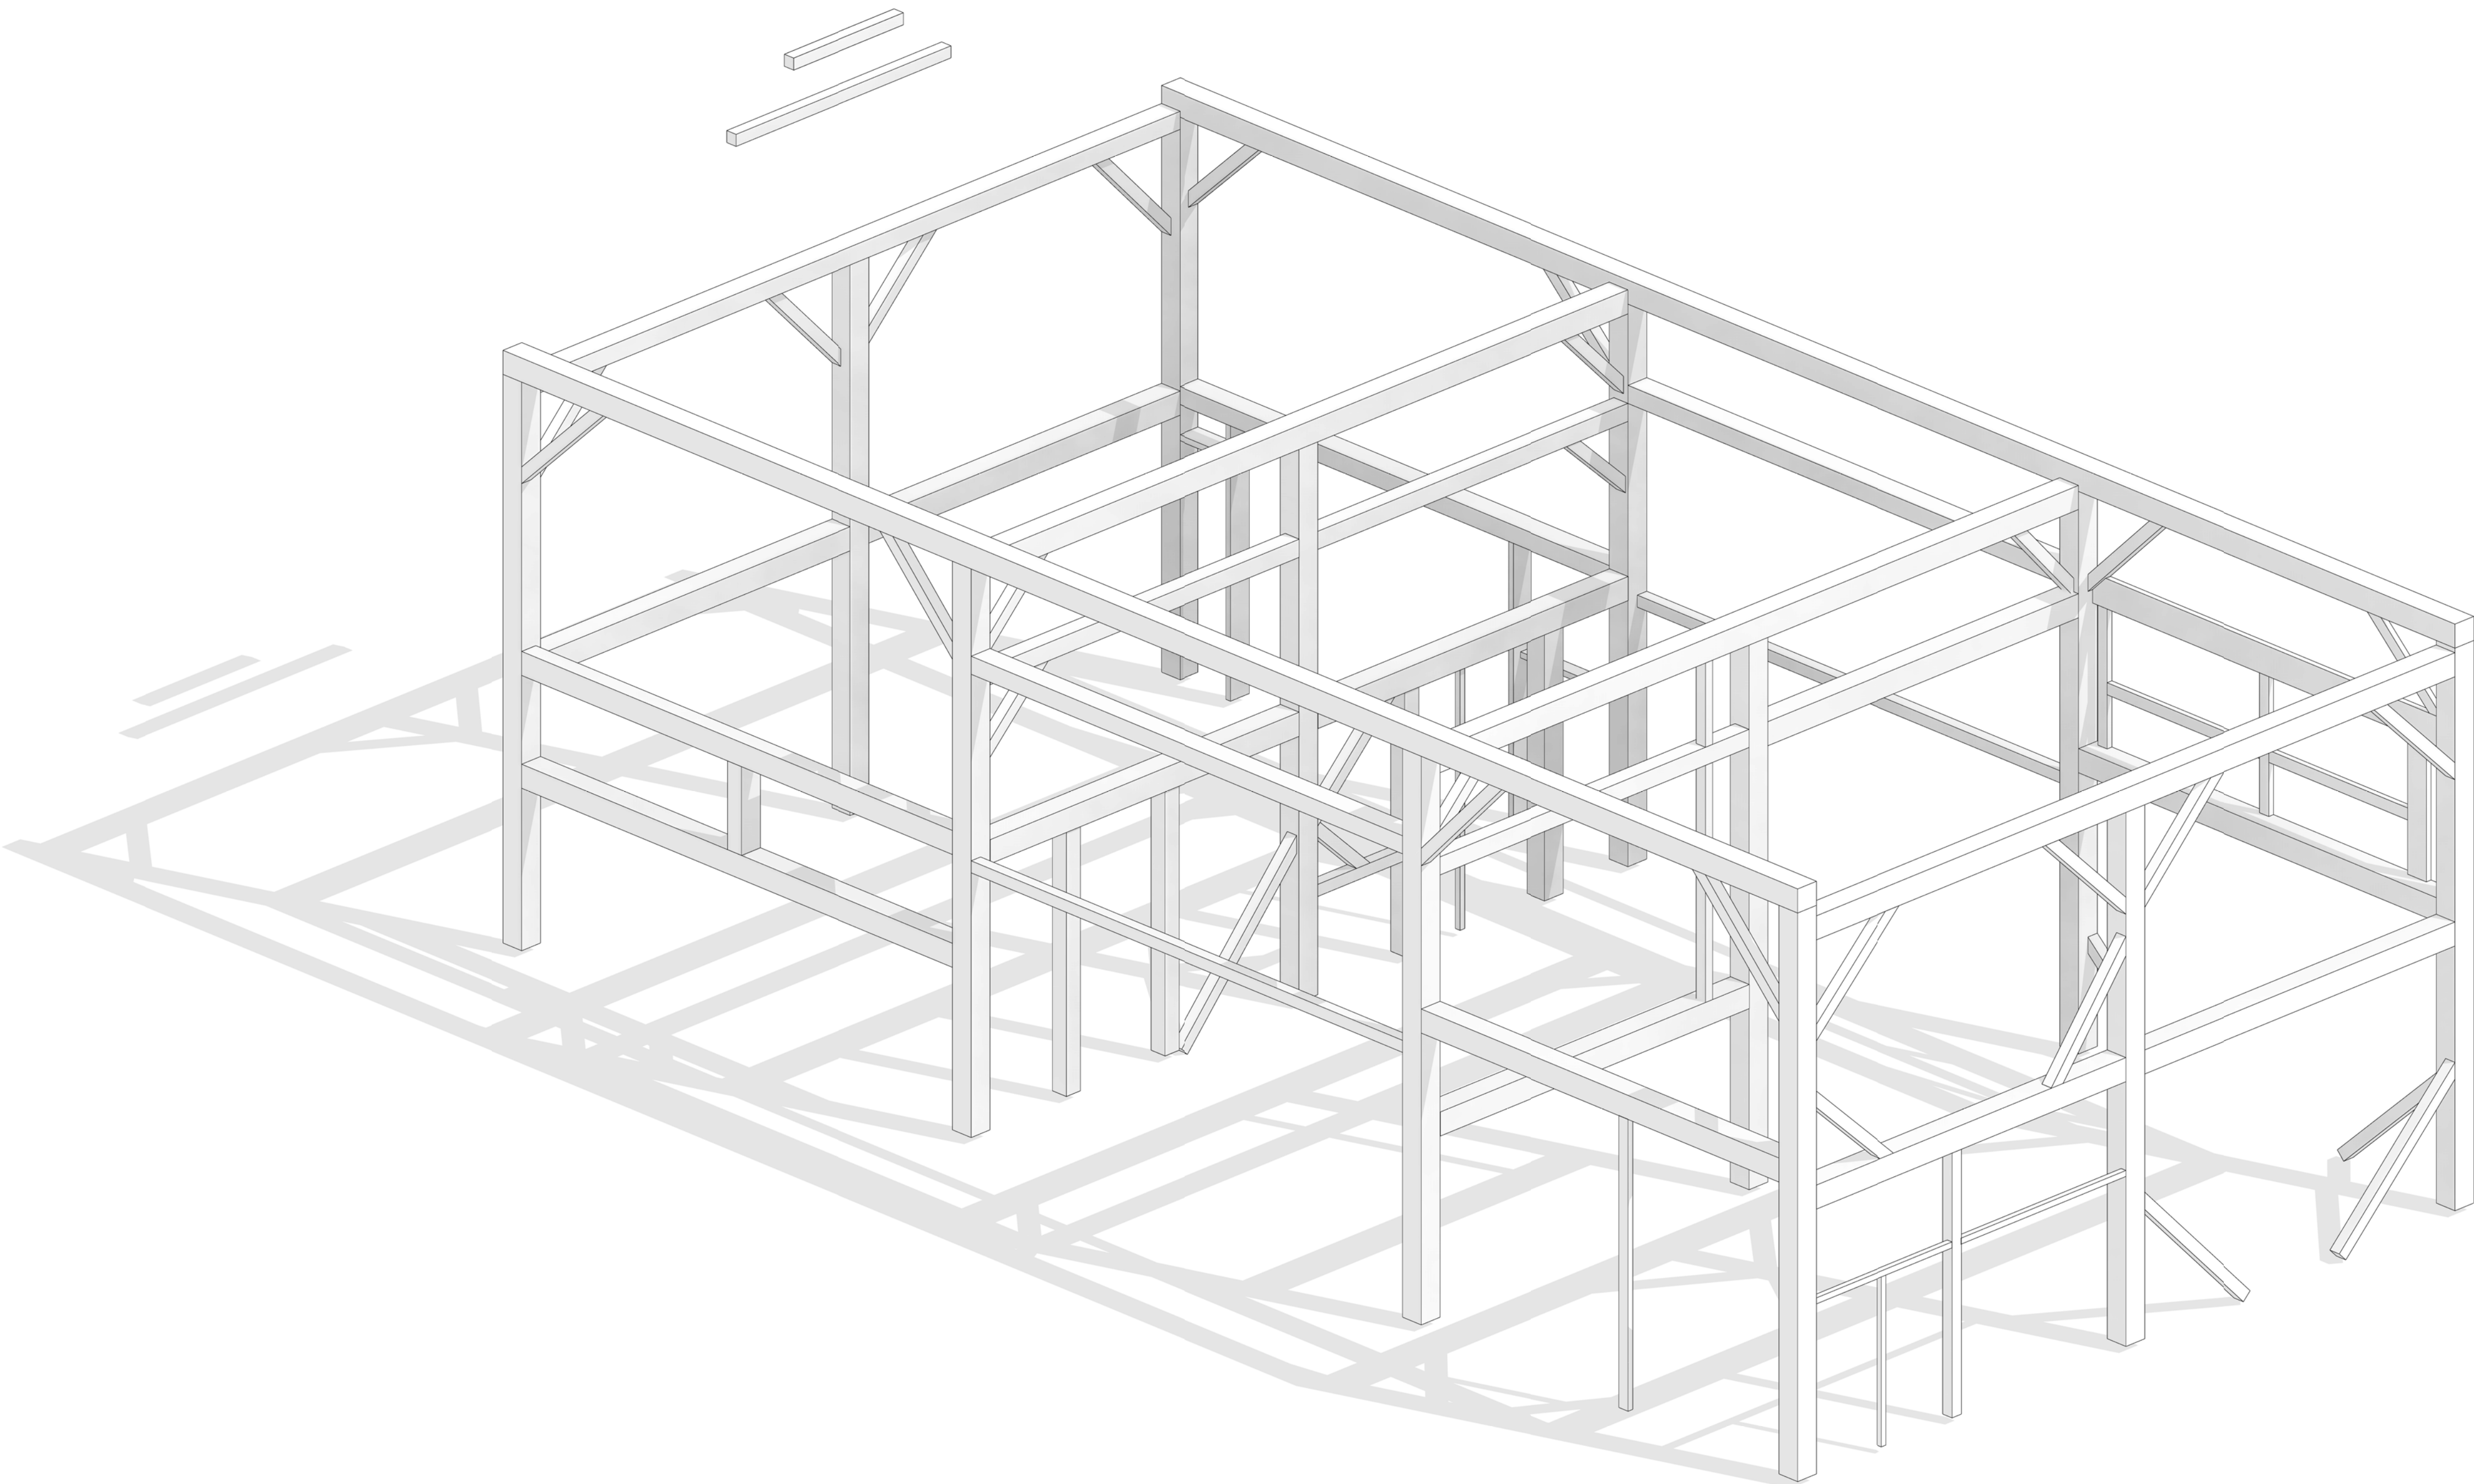

Timber
Home
Services LLC

108-Little-Red

DAN TRIMBLE
AA66 / TIMBER HOME SERVICES
CELL PHONE/TEXT - 412-309-1161

EMAIL:
DANTRIMBLE@TIMBERHOMESERVICES.COM

Cover Page

Project Number	Project 17
Date	20251113
Drawn By	
Checked By	

A101

Scale

Timber
Home
Services LLC


108-Little-Red

DAN TRIMBLE
AA66 / TIMBER HOME SERVICES
CELL PHONE/TEXT - 412-309-1161

EMAIL:
DANTRIMBLE@TIMBERHOMESERVICES.COM

Ground

Project Number	Project 17
Date	20251113
Drawn By	
Checked By	
A102	
Scale	1/2" = 1'-0"

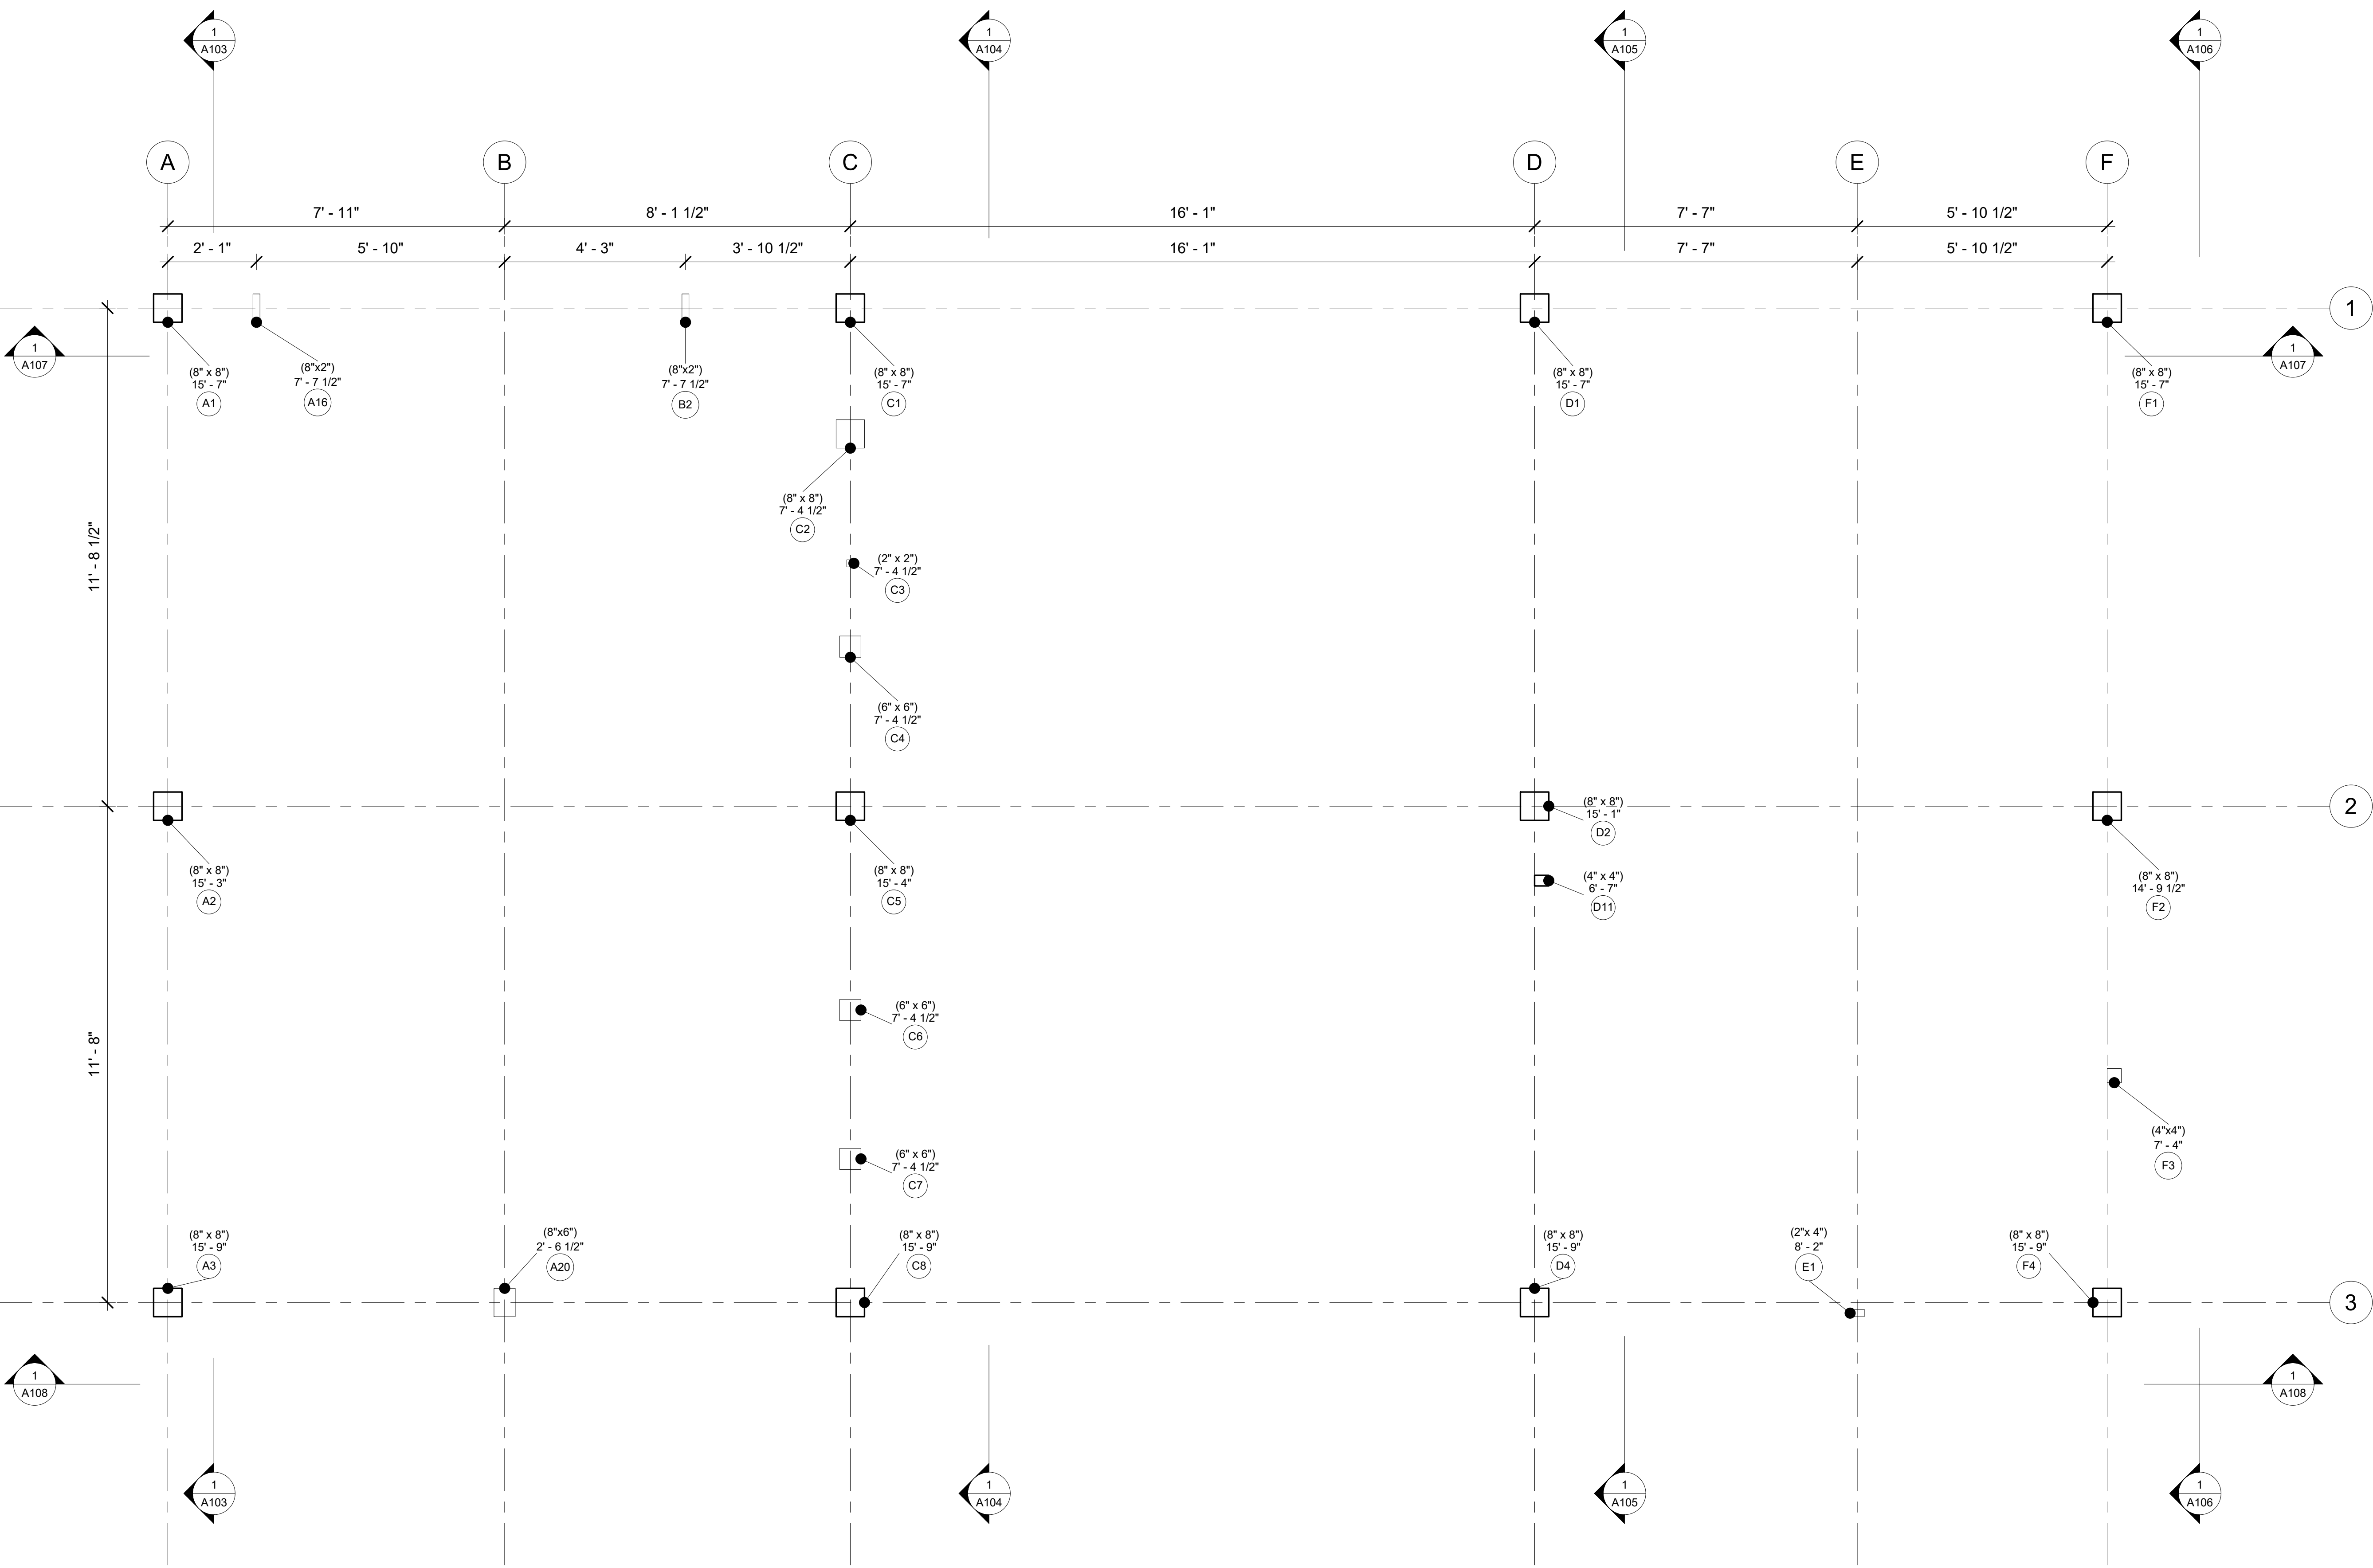

Timber
Home
Services LLC


108-Little-Red

DAN TRIMBLE
AA66 / TIMBER HOME SERVICES
CELL PHONE/TEXT - 412-309-1161

EMAIL:
DANTRIMBLE@TIMBERHOMESERVICES.COM

Bent A

Project Number	Project 17
Date	20251113
Drawn By	
Checked By	
A103	
Scale	1/2" = 1'-0"


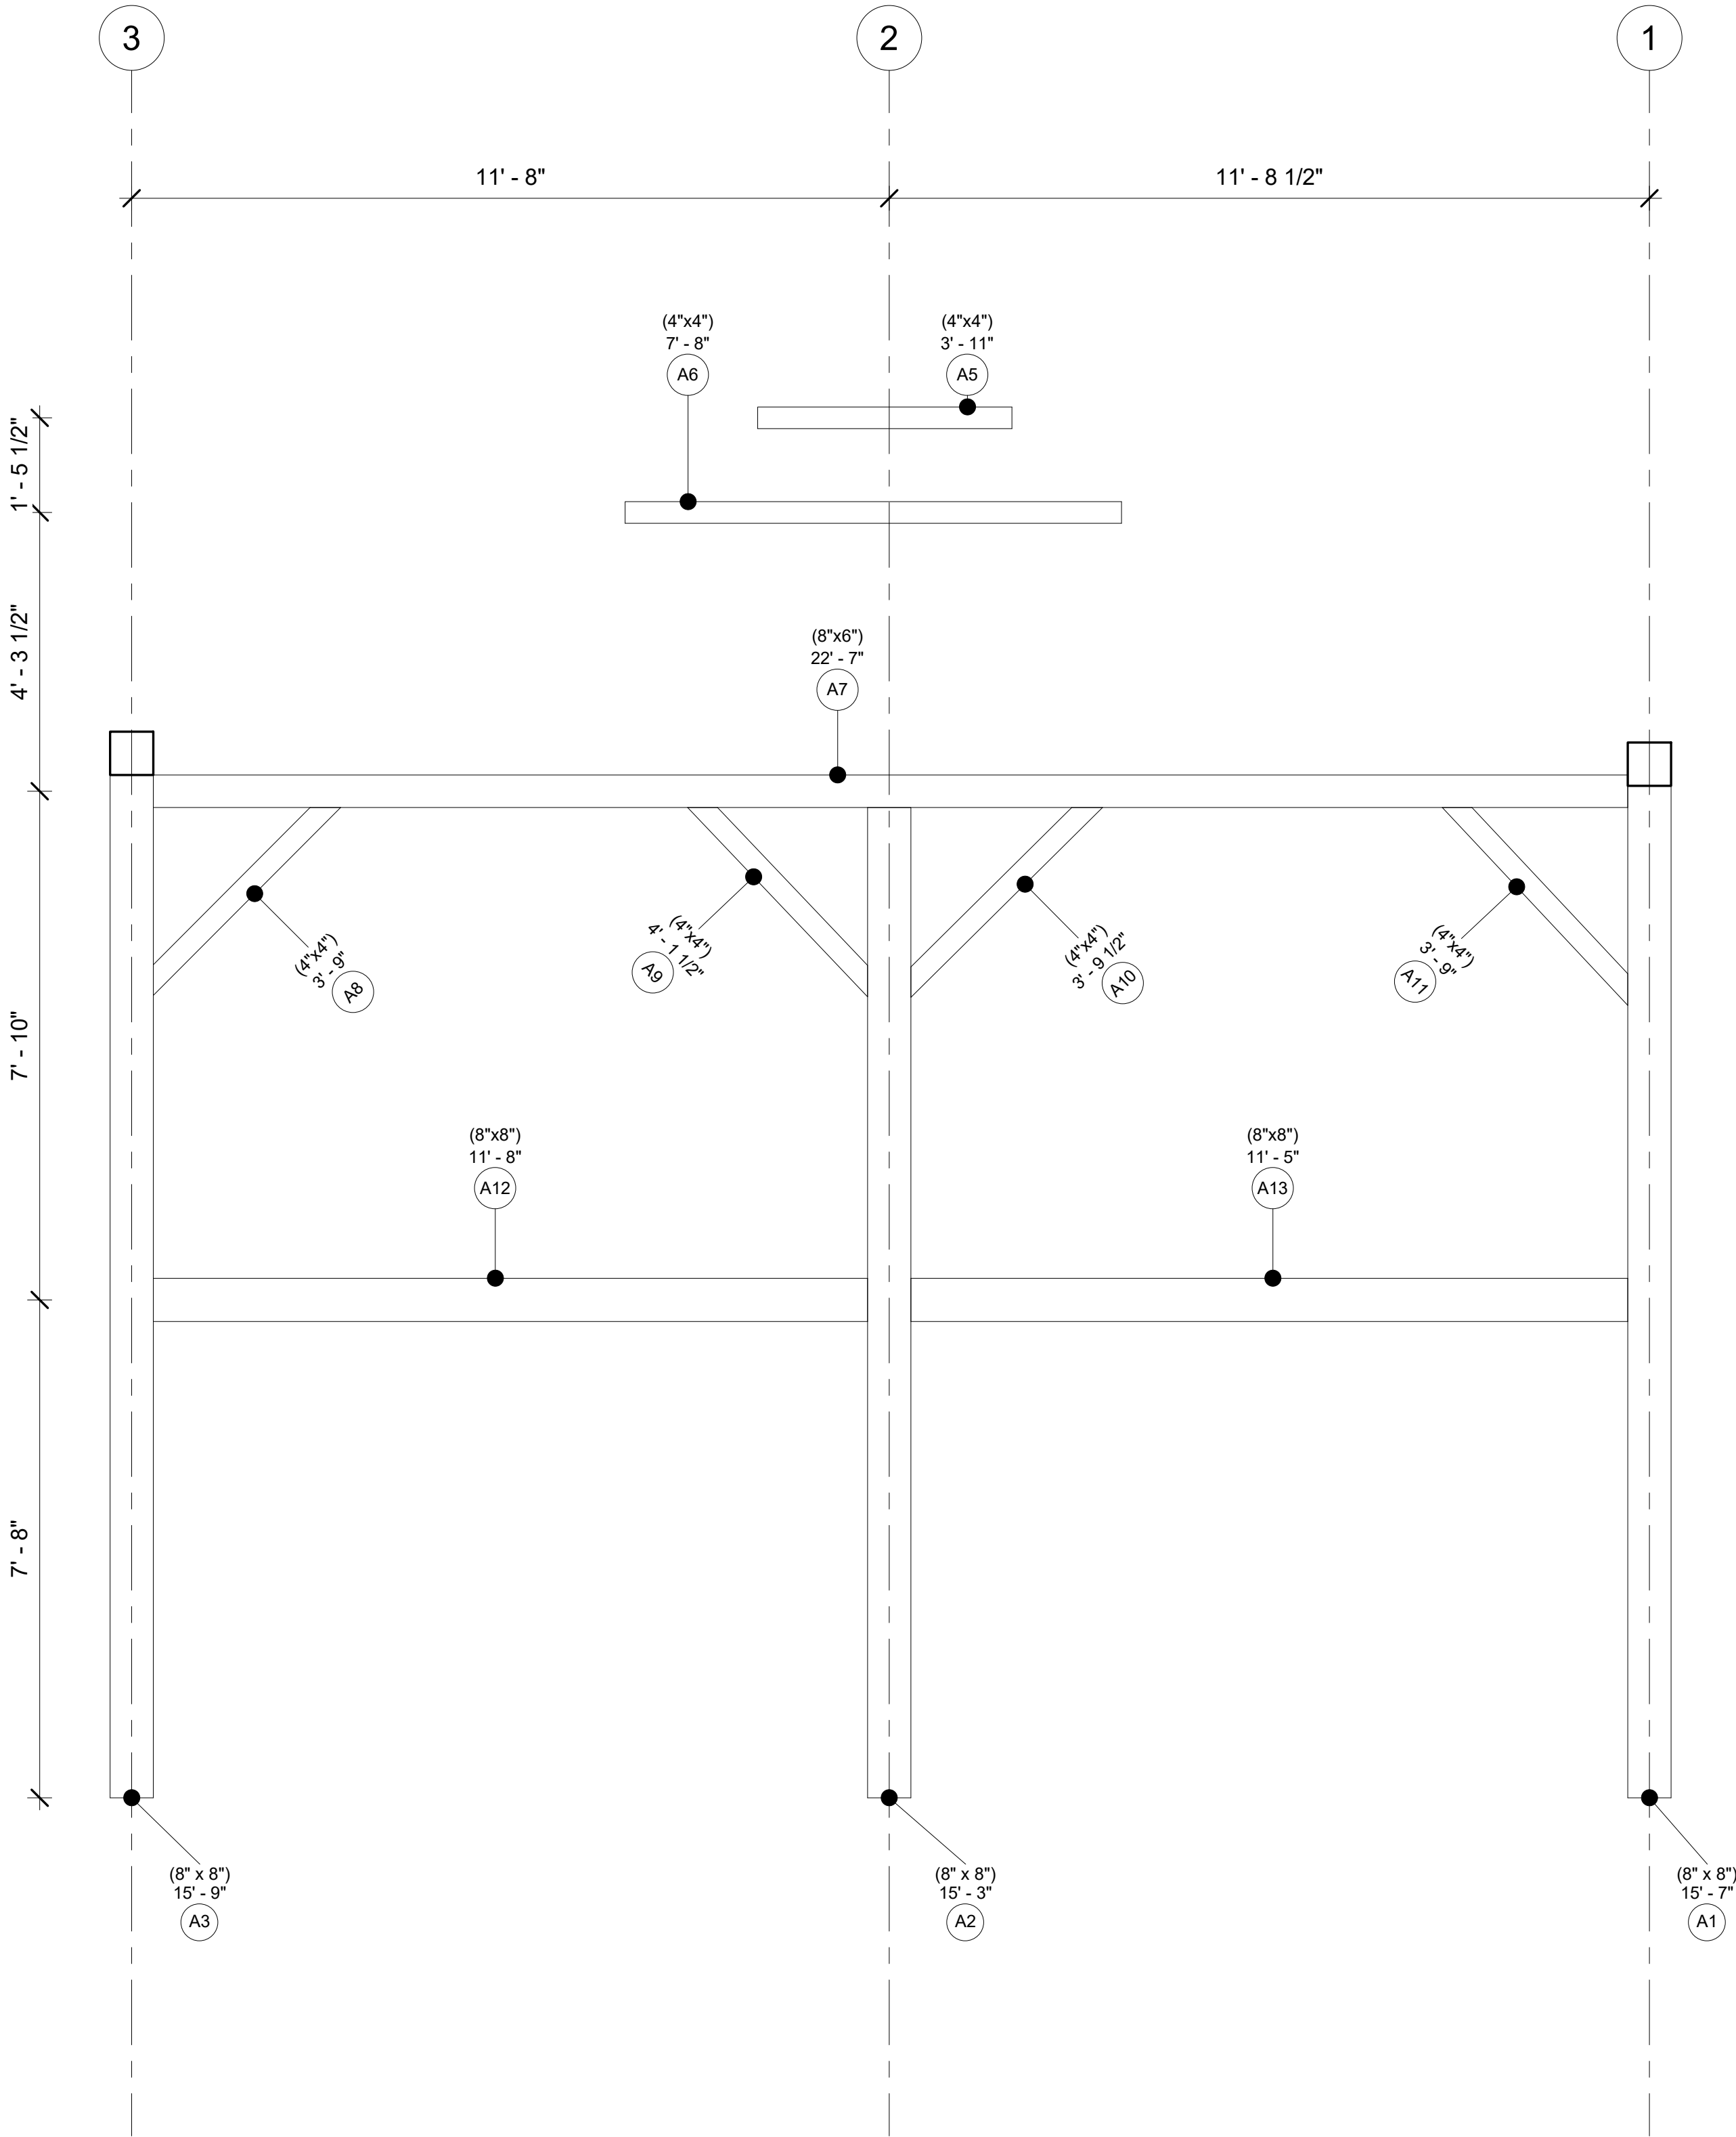


Timber
Home
Services LLC

108-Little-Red

DAN TRIMBLE
AA66 / TIMBER HOME SERVICES
CELL PHONE/TEXT - 412-309-1161

  EMAIL:
DANTRIMBLE@TIMBERHOMESERVICES.COM




Bent C

Project Number	Project 17
Date	20251113
Drawn By	
Checked By	

A104

Scale 1/2" = 1'-0"

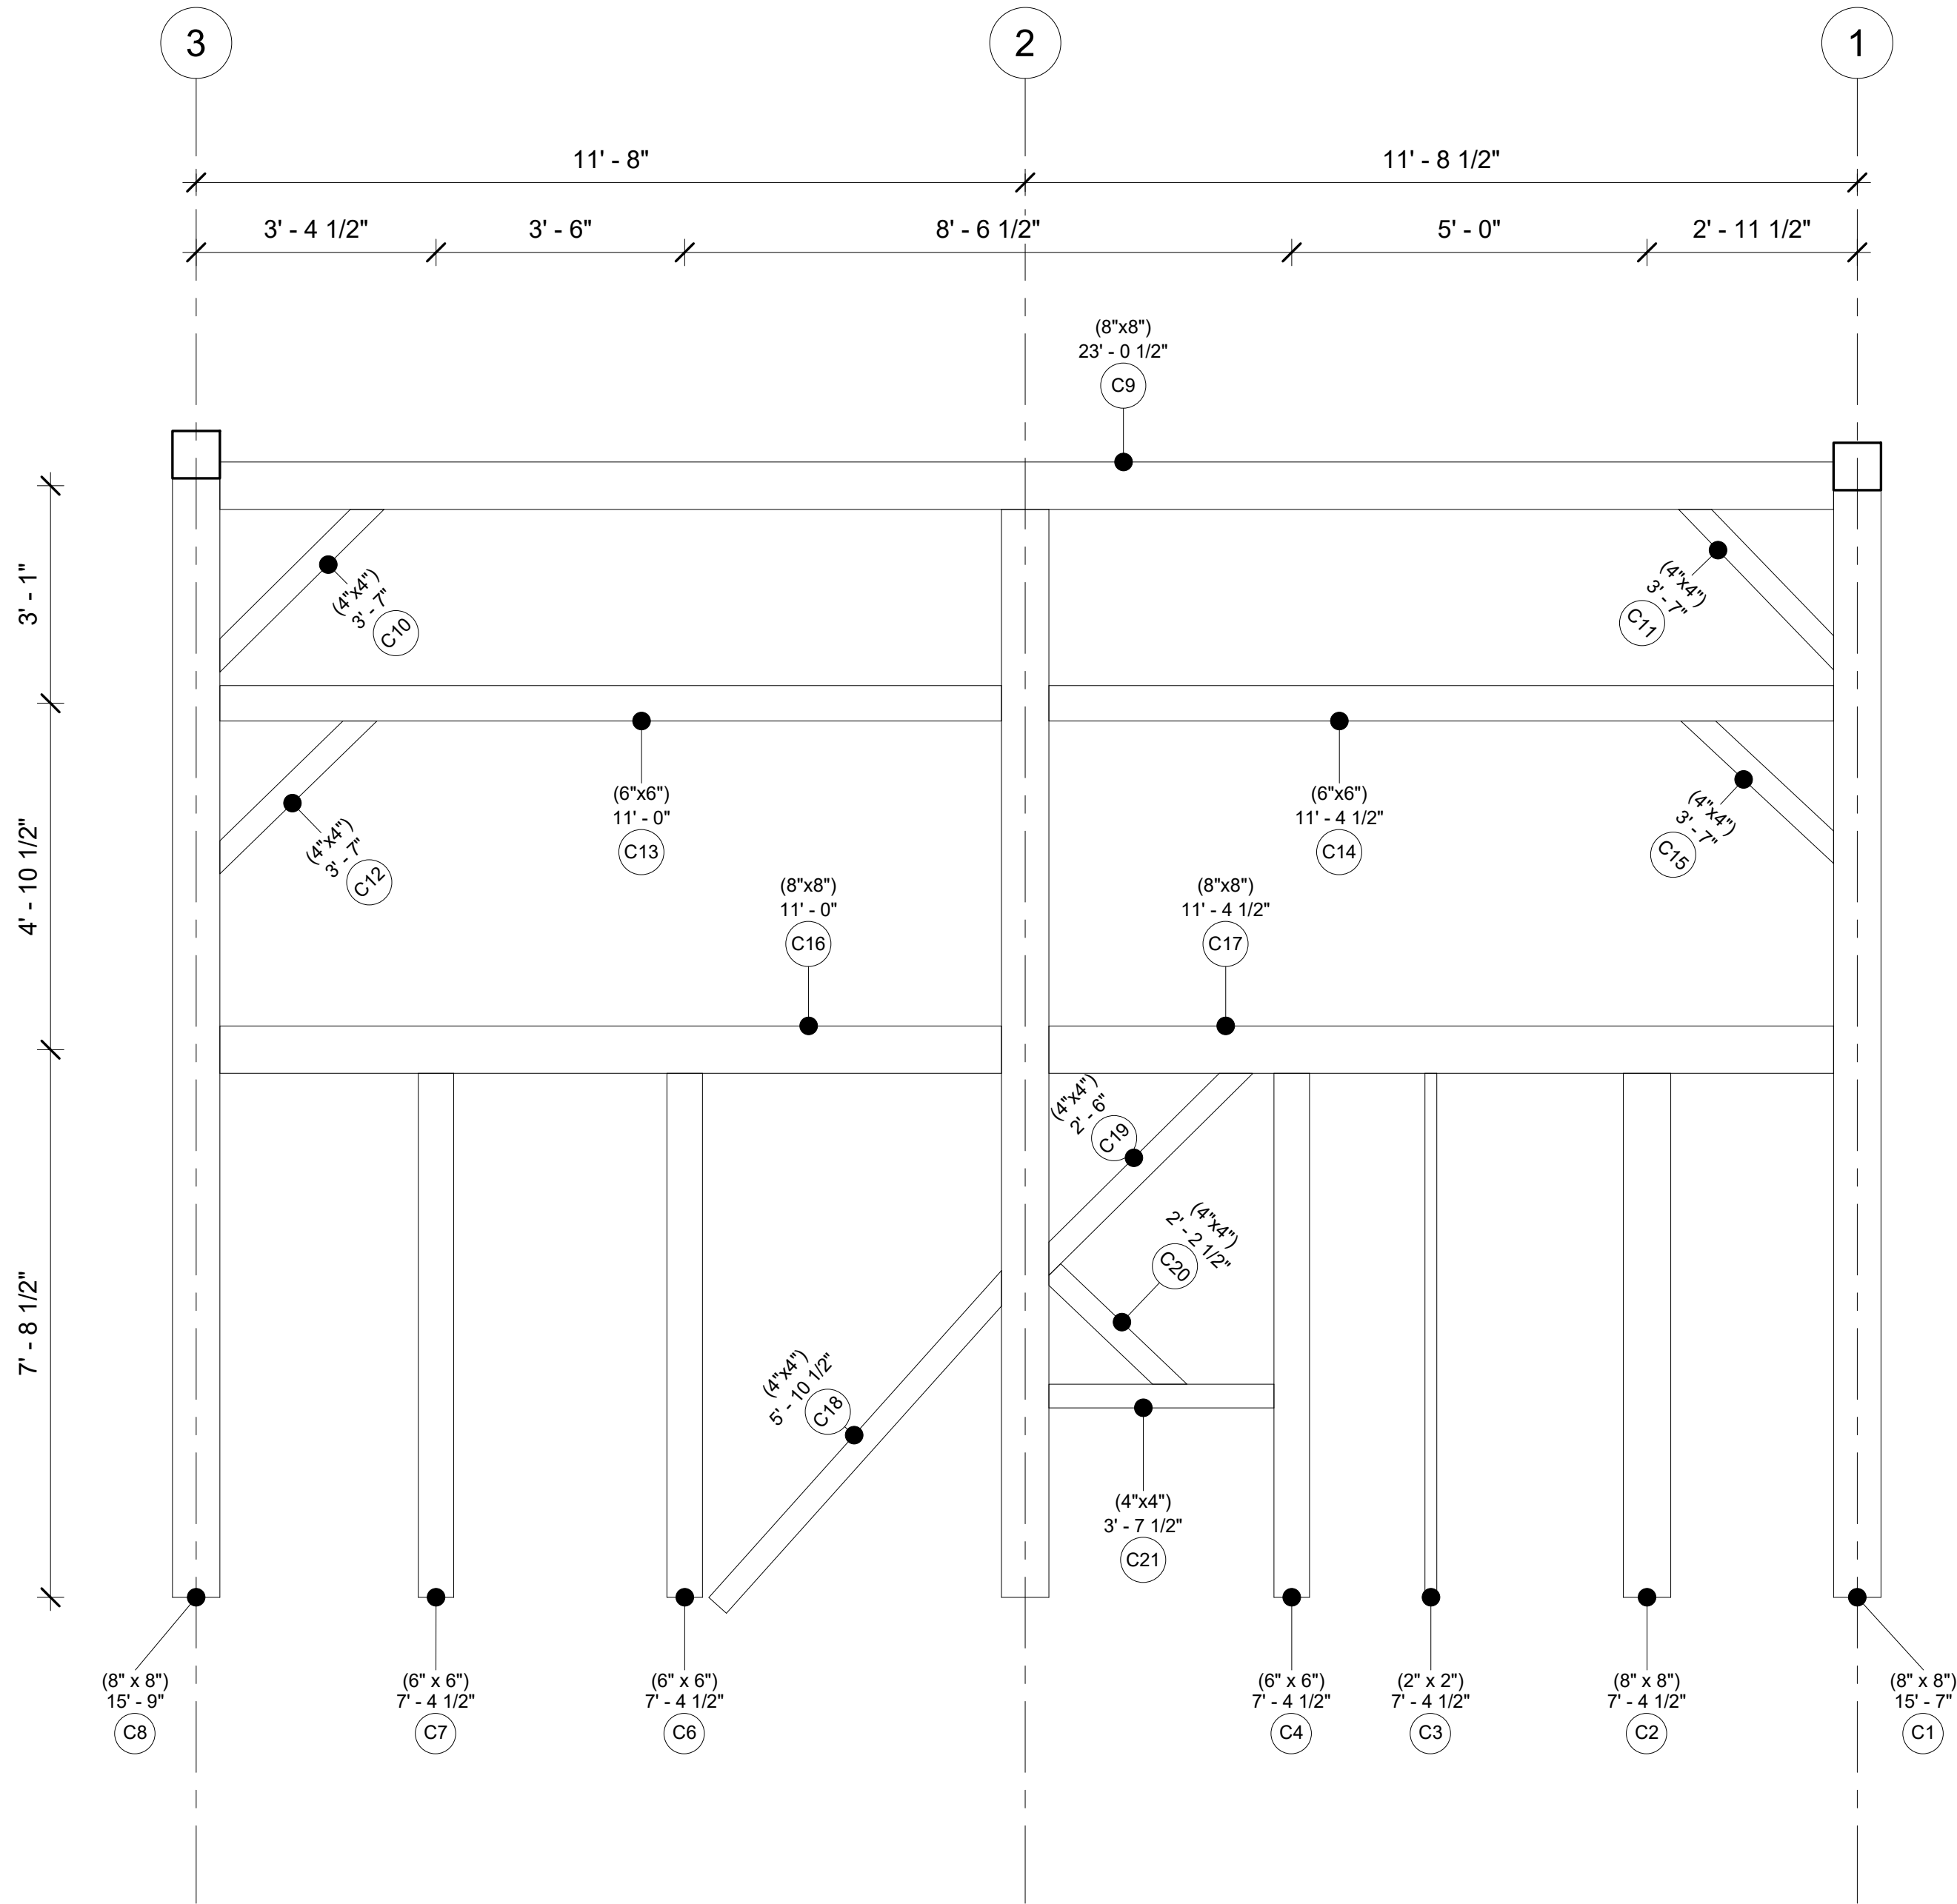


Timber
Home
Services LLC

108-Little-Red

DAN TRIMBLE
AA66 / TIMBER HOME SERVICES
CELL PHONE/TEXT - 412-309-1161

EMAIL:
DANTRIMBLE@TIMBERHOMESERVICES.COM

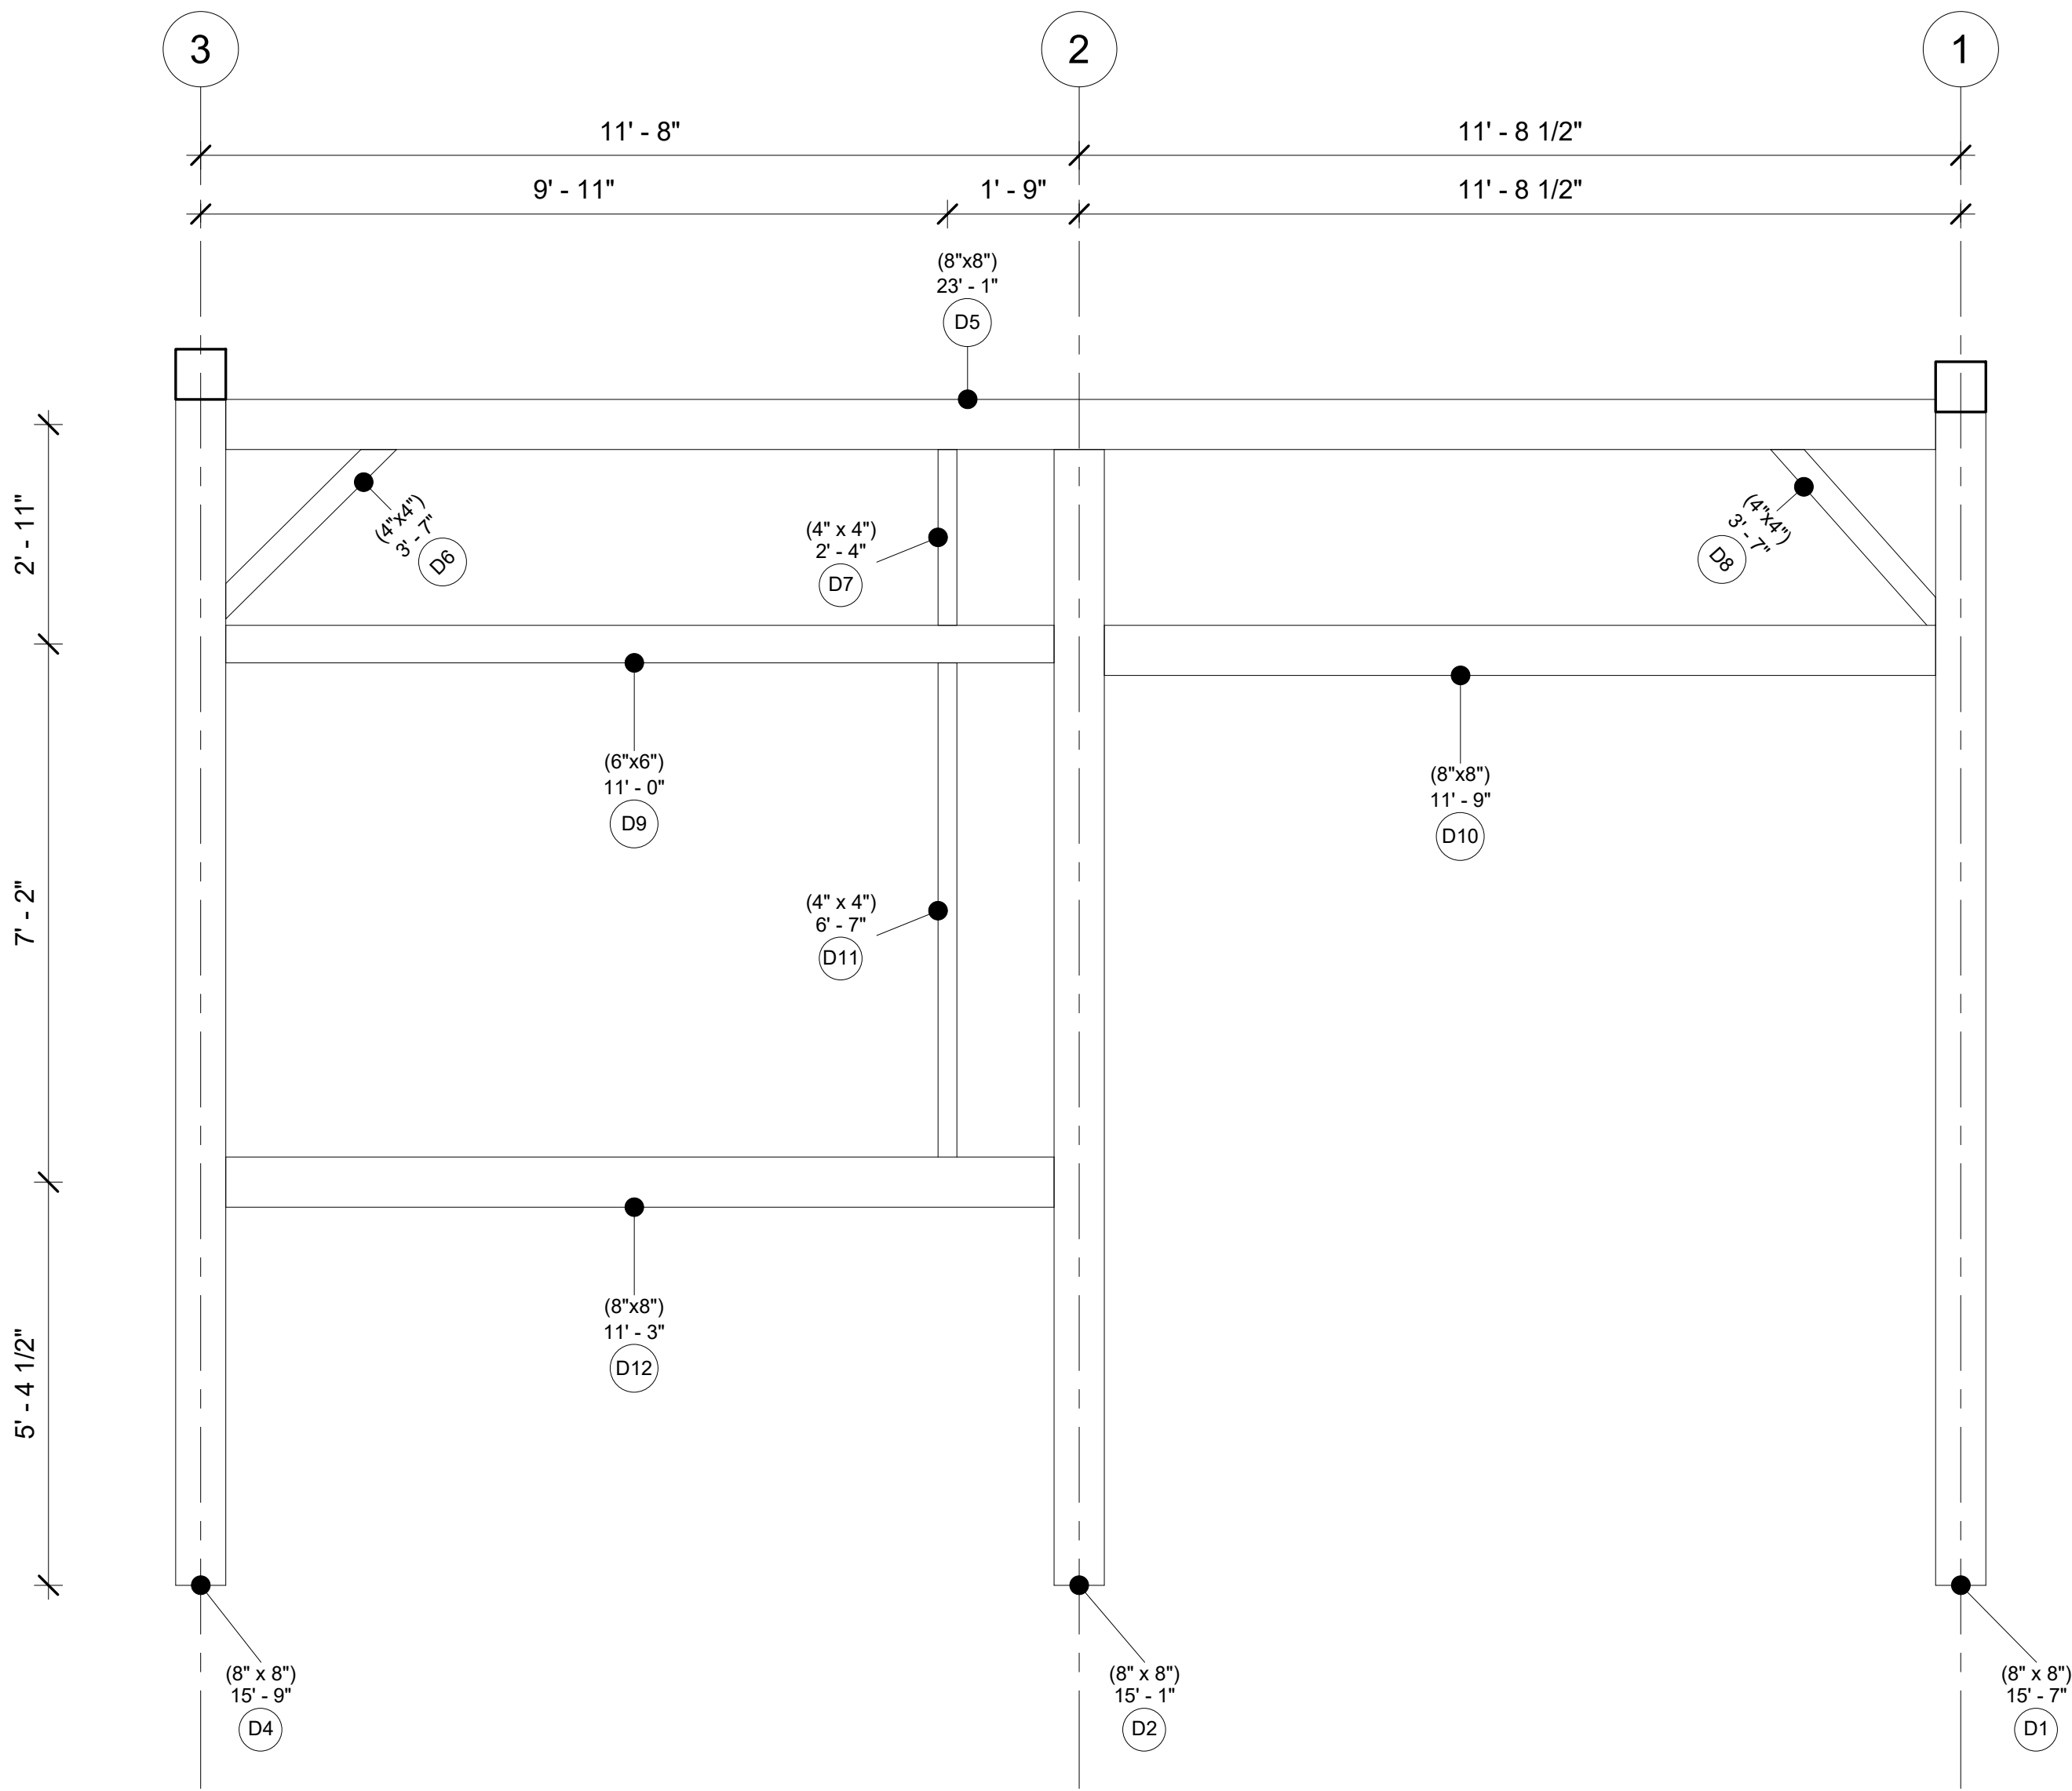

Bent D


Project Number	Project 17
Date	20251113
Drawn By	
Checked By	
A105	
Scale	1/2" = 1'-0"

Timber
Home
Services LLC

108-Little-Red

DAN TRIMBLE
AA66 / TIMBER HOME SERVICES
CELL PHONE/TEXT - 412-309-1161

EMAIL:
DANTRIMBLE@TIMBERHOMESERVICES.COM

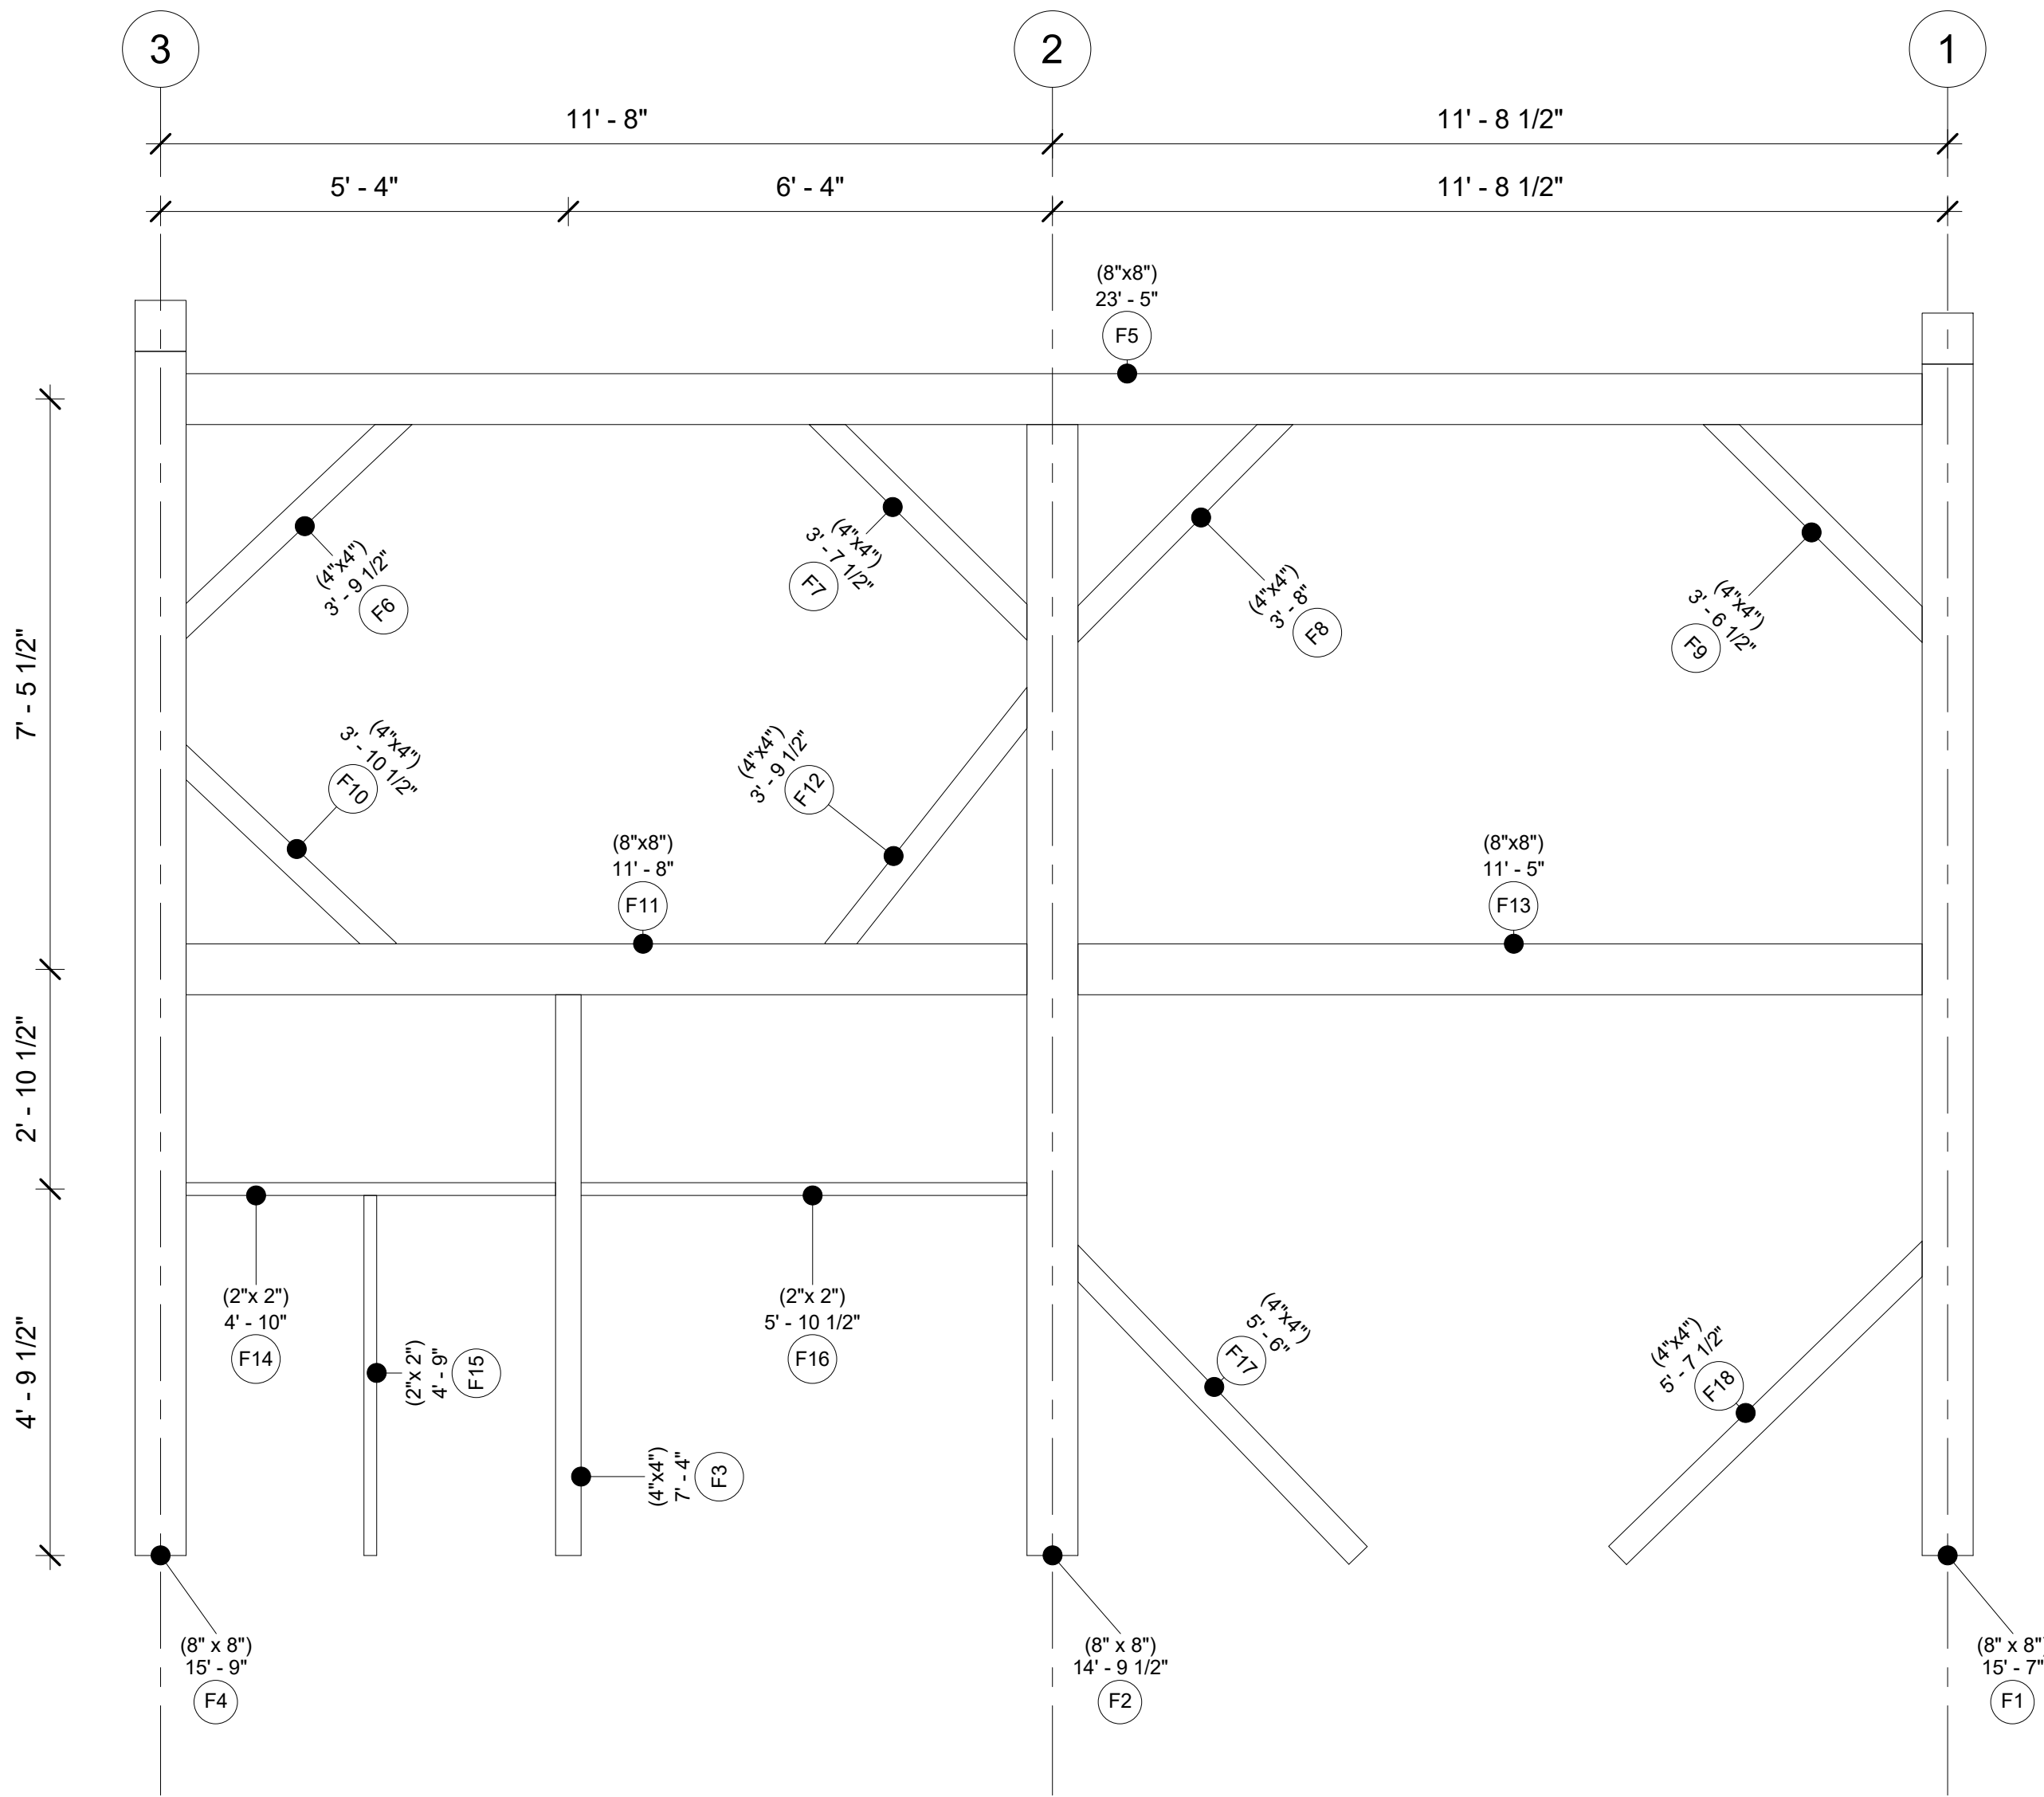

Bent F

Project Number	Project 17
Date	20251113
Drawn By	
Checked By	

A106

Scale	1/2" = 1'-0"
-------	--------------

Timber
Home
Services LLC

108-Little-Red

DAN TRIMBLE
AA66 / TIMBER HOME SERVICES
CELL PHONE/TEXT - 412-309-1161


EMAIL:
DANTRIMBLE@TIMBERHOMESERVICES.COM

Bent 1

Project Number	Project 17
Date	20251113
Drawn By	
Checked By	

A107

Scale 1/2" = 1'-0"

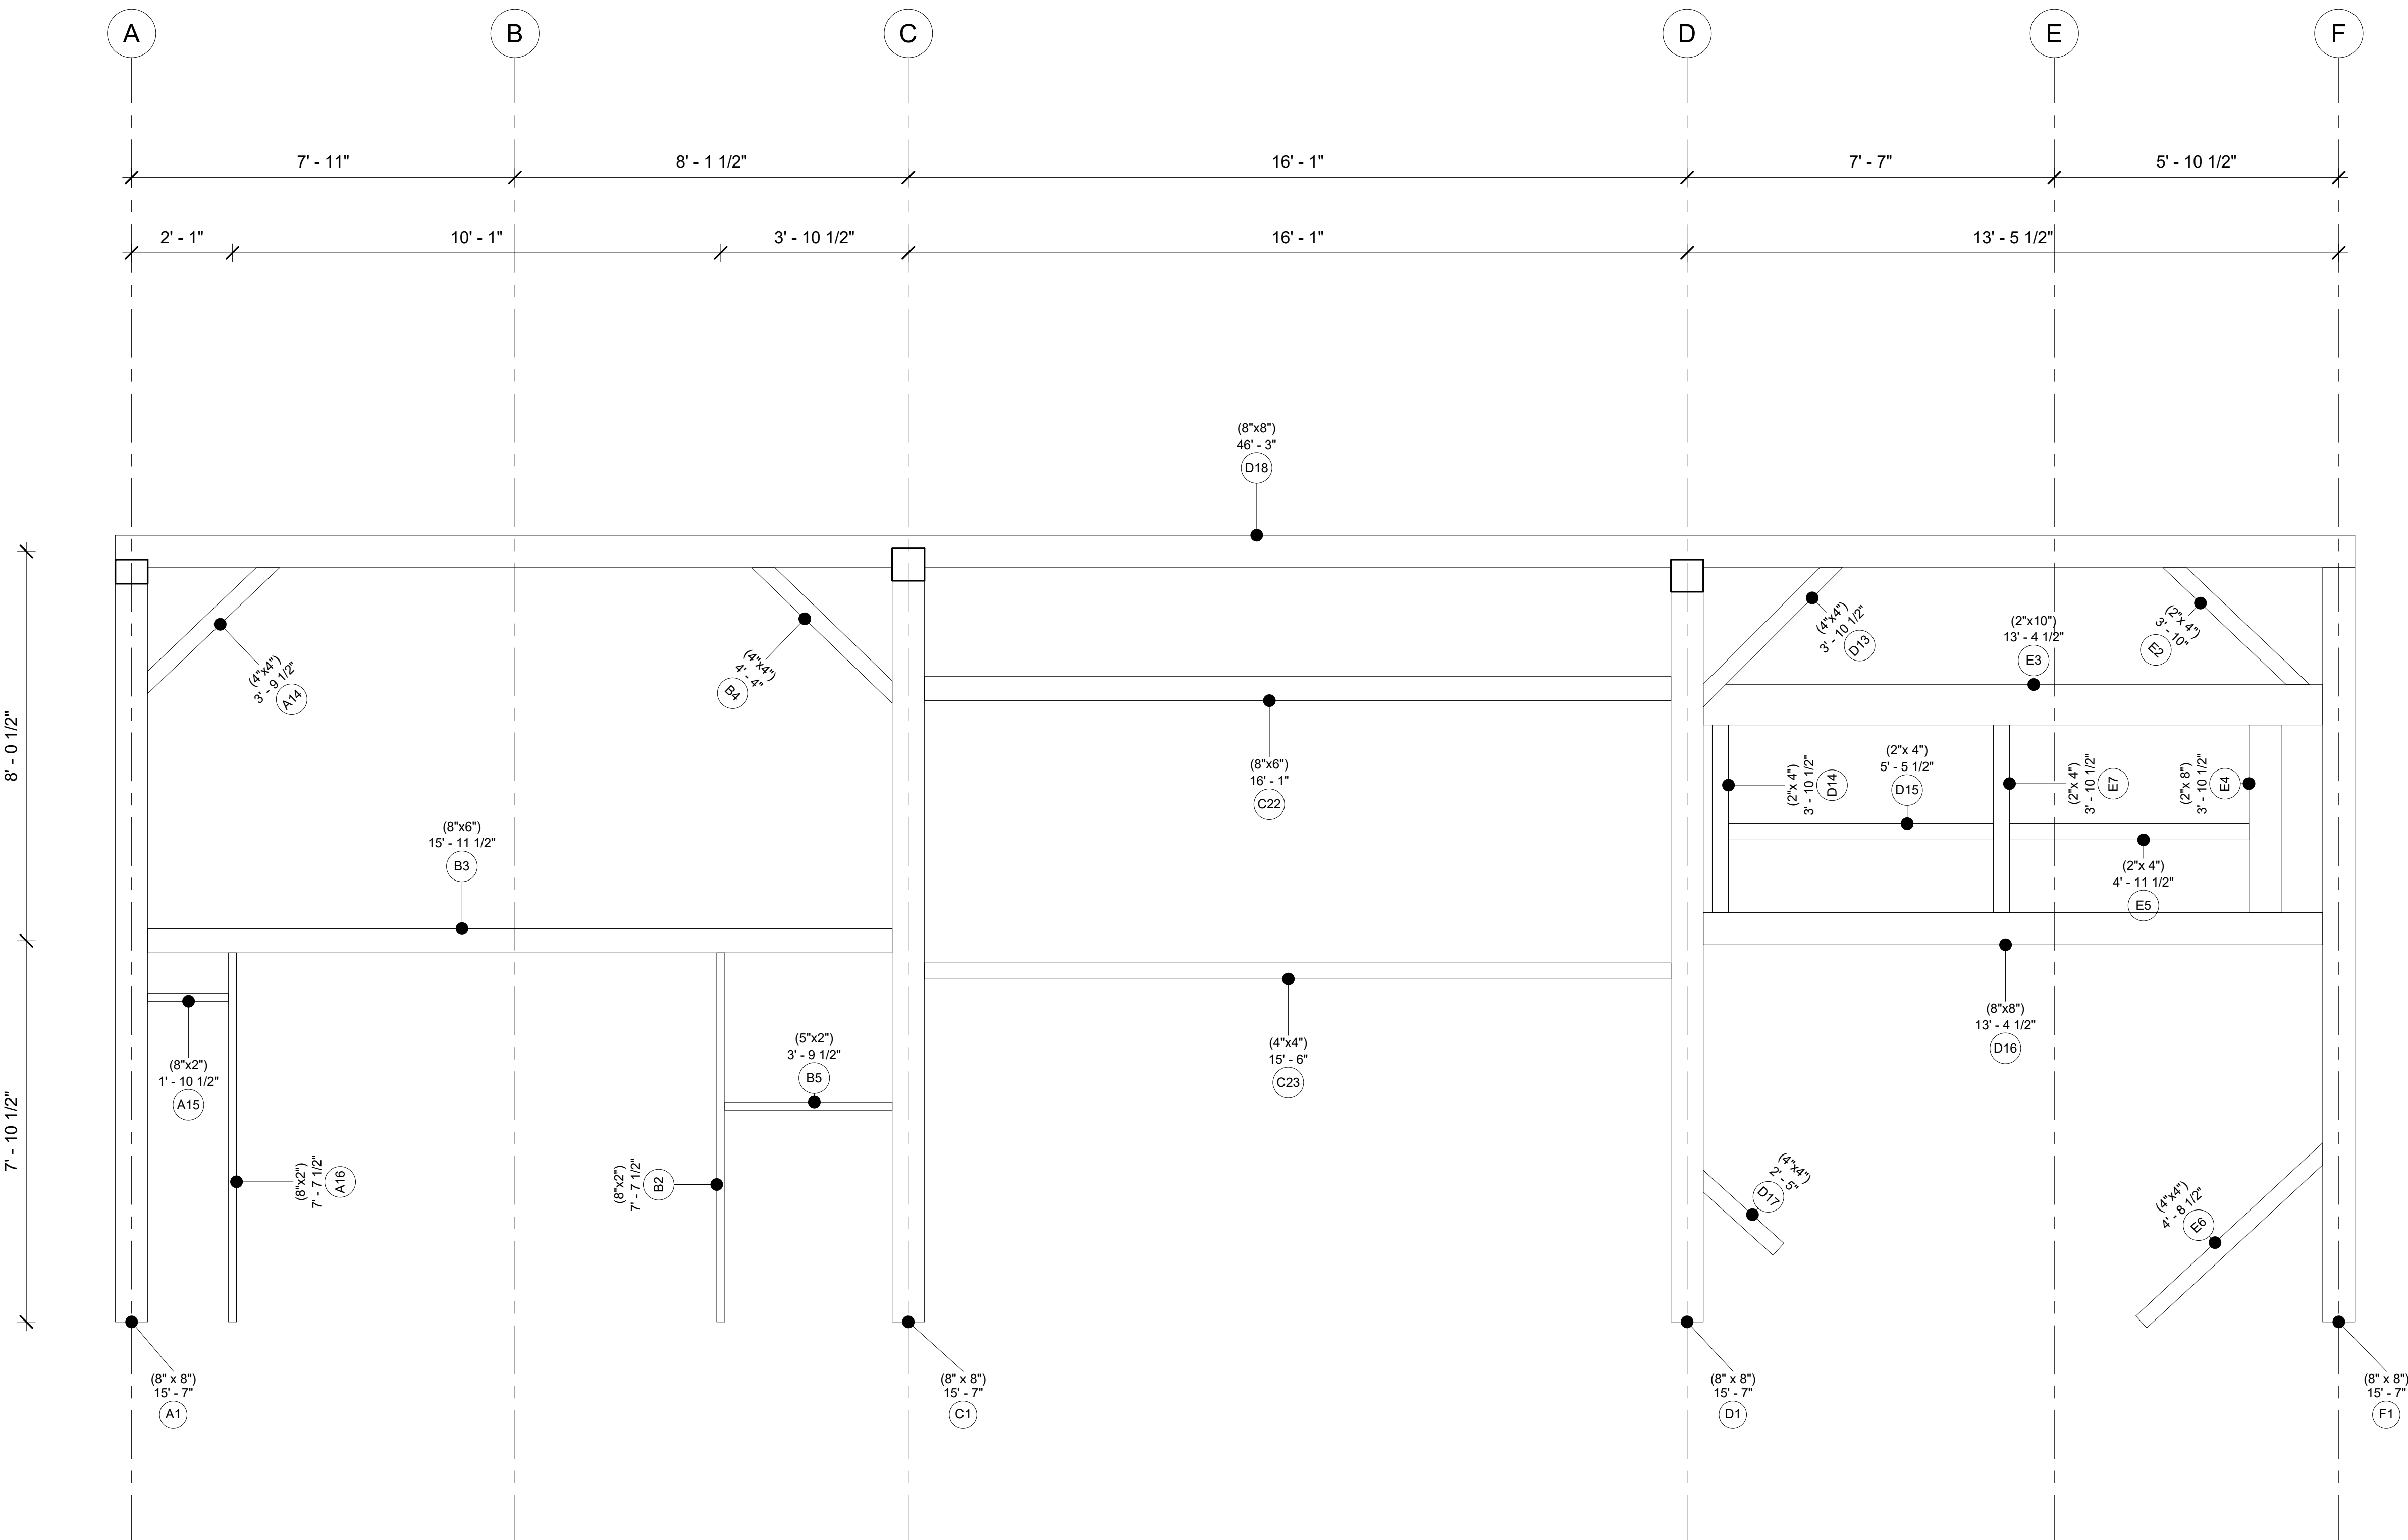

Timber
Home
Services LLC

108-Little-Red

DAN TRIMBLE
AA66 / TIMBER HOME SERVICES
CELL PHONE/TEXT - 412-309-1161

EMAIL:
DANTRIMBLE@TIMBERHOMESERVICES.COM

Bent 3

Project Number	Project 17
Date	20251113
Drawn By	
Checked By	

A108

Scale1/2" = 1'-0"

