


QUAN.	MARK NO	HAND	LOCATION		EXISTING WALL OPNG		FRAME OPNG		DOOR SIZE		DOOR ELEV	SECTIONS				REMARKS
			HINGE SIDE	STOP SIDE	WIDTH	HEIGHT	WIDTH	HEIGHT	WIDTH	HEIGHT		HINGE	STRIKE	HEAD	SILL	
1	1	LHRB	EXTERIOR	INTERIOR	40 1/2'	95 3/4'	39 1/4'	94 1/2'	38 1/2'	93 3/4'	A	1	2	3	4	
	2	LHRB														
	3	RHRB														

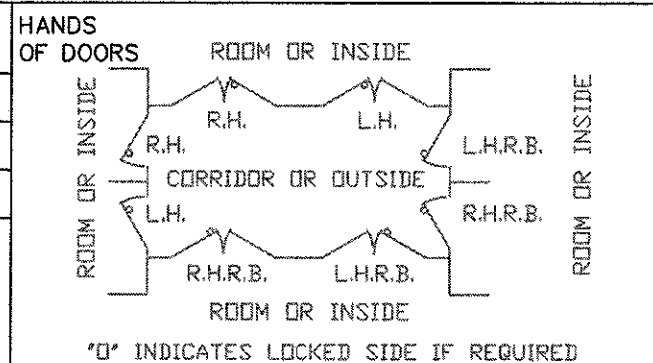


- NOTES:
- DESIGN PRESSURE: 0.25" W.G. DIFFERENTIAL
 - LEAK RATE: ZERO
 - FACTORY LEAK TEST
 - FINISH: DOORS AND MISC: STD GREY PRIMER FRAMES: STAINLESS STEEL AS FABRICATED
 - FIRE RATING: NONE
 - HARDWARE BY PDI:
 - (1) VON DUPRIN RX99ED EXIT DEVICE x ALUM FINISH x NO EXTERIOR TRIM x 24VDC
 - (1) PR SH-421 6' x 6' FULL SURFACE BUTT HINGES x STAINLESS STEEL FINISH
 - (1) YALE #4400 DOOR CLOSER x PA x ALUM FINISH
 - (1) ROCKWOOD #131 PULL x US32D FINISH
 - (1) SENTROL #2500 SERIES MAGNETIC SWITCH x 24VDC x SURFACE MOUNTED
 - (1) EPDM INFLATABLE SEAL x RADIAL EXPANDING OUTWARD ENDLESS SEAL x NON REINFORCED RECOMMENDED OPERATING PRESSURE = 25 PSI
 - (1) CONTROL PANEL x NEMA 1 INCLUDES SOLENOID VALVE, RELAY, TIMER, FILTER, REGULATOR W/GAUGE AND TERMINAL STRIP
 - ALL WIRING, CONDUIT, AIR LINES, ETC ARE BY OTHERS

1/28/04	1	AS BUILT	MF
DATE	MK	DESCRIPTION	BY

REVISIONS:


CUSTOMER:

PROJECT:

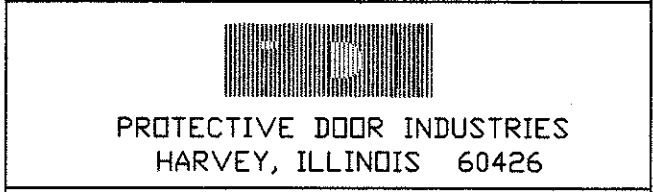

TITLE: AIRTIGHT DOORS SCHEDULE AND ELEVATIONS

DWG BY	MF	CHKD BY	
DATE	12/17/03	DATE	
SCALE		QA	
DWG NO.	1540-03	SHT NO.	1

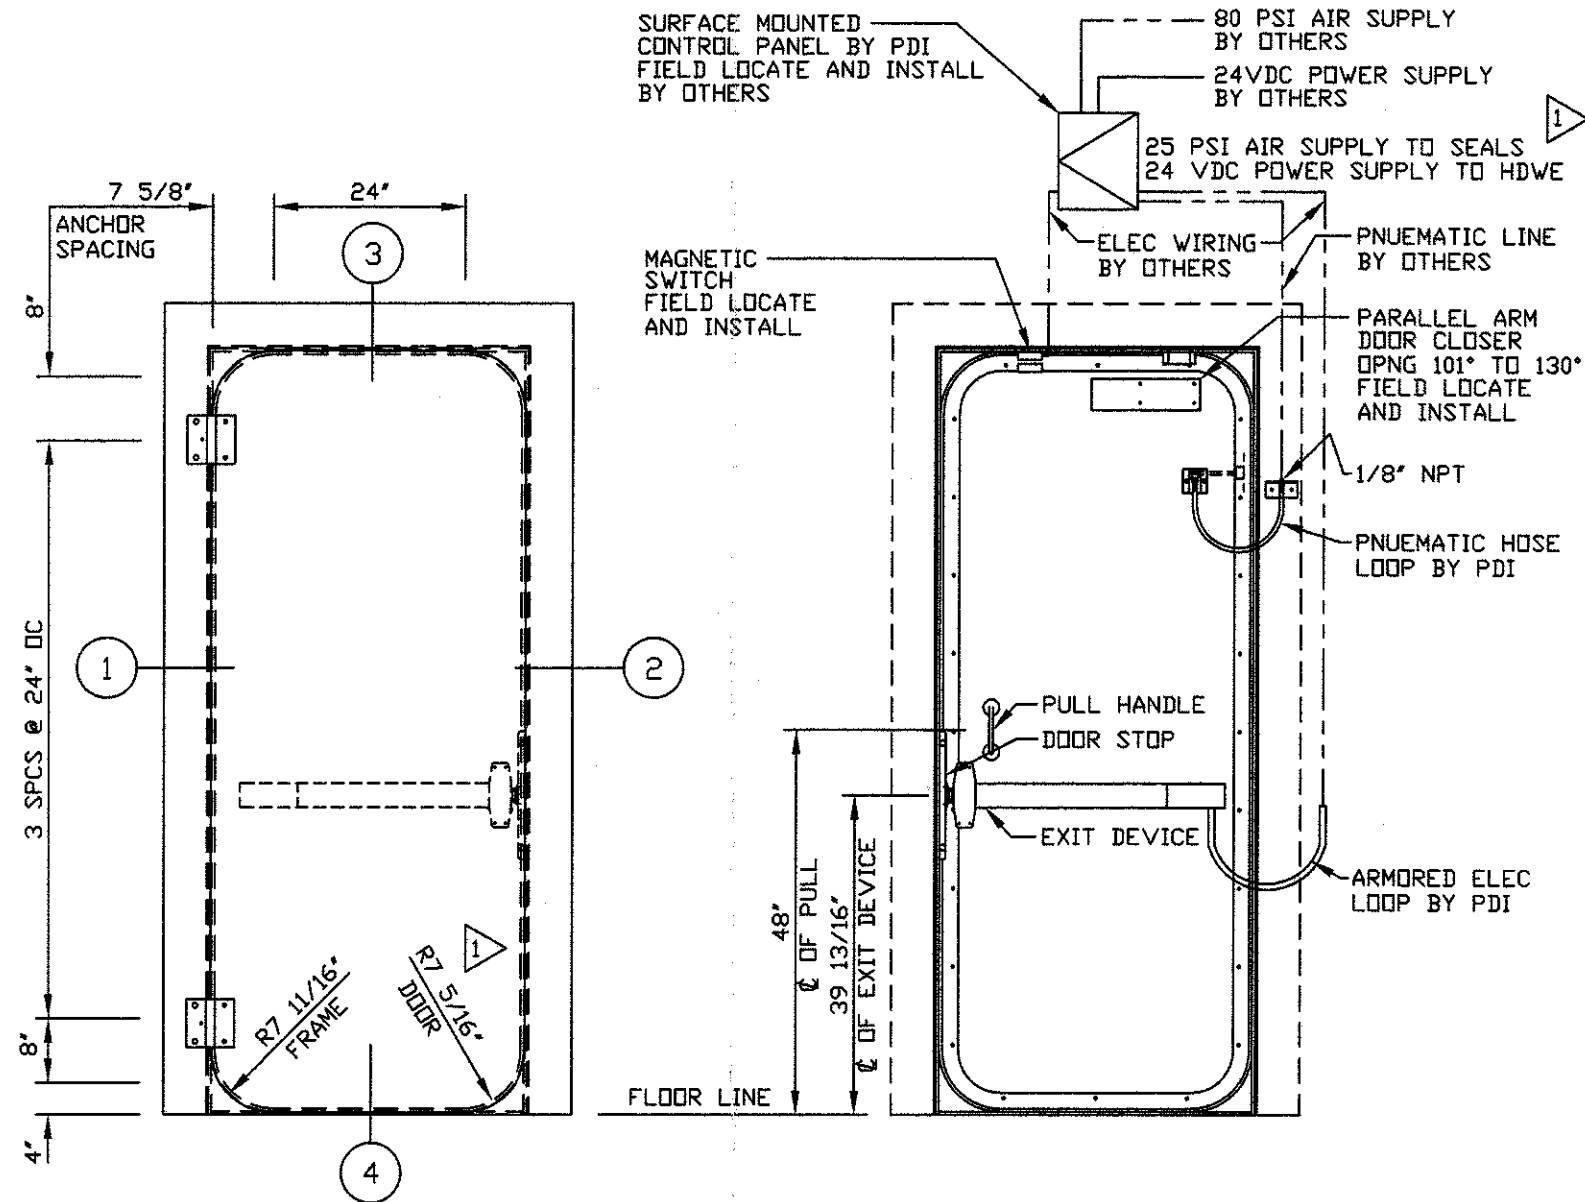

HINGE SIDE ELEVATION
RH / LHRB SHOWN
LH / RHRB OPPOSITE

STOP SIDE ELEVATION
RH / LHRB SHOWN
LH / RHRB OPPOSITE

ELEVATION A

FRAME INSTALLATION

- PROPERLY BRACE AND SUPPORT FRAME DURING INSTALLATION.
- JAMBS MUST BE PLUMB.
- HEAD MUST BE LEVEL.
- ALL DIMENSIONS TO BE WITHIN 1/16".
- DIAGONAL DIMENSIONS TO BE WITHIN 1/8".
- SEAL CONTACT AREA ON FRAME MUST BE PROTECTED FROM DAMAGE AT ALL TIMES.

NOTICE

THIS IS A CONFIDENTIAL DISCLOSURE LOANED BY PROTECTIVE DOOR IND. SUBJECT TO THE CONDITIONS THAT IT AND THE INFORMATION EMBODIED THEREIN SHALL BE USED ONLY FOR RECORD AND REFERENCE PURPOSES, SHALL NOT BE USED OR CAUSED TO BE USED IN ANYWAY PREJUDICIAL TO THE INTEREST OF THIS COMPANY, SHALL NOT BE REPRODUCED OR COPIED IN WHOLE OR IN PART, AND SHALL BE RETURNED UPON REQUEST.

GENERAL CONDITIONS

P.D.I. WILL NOT BE LIABLE FOR ANY ERRORS OCCURRING TO OTHER TRADES THROUGH THE USE OF THIS DRAWING. CONTRACTOR TO CHECK ALL DIMENSIONS AT JOB AS P.D.I. ASSUMES NO RESPONSIBILITY FOR GENERAL BUILDING DIMENSIONS.

PLOT SCALE 1-24
1540-1