


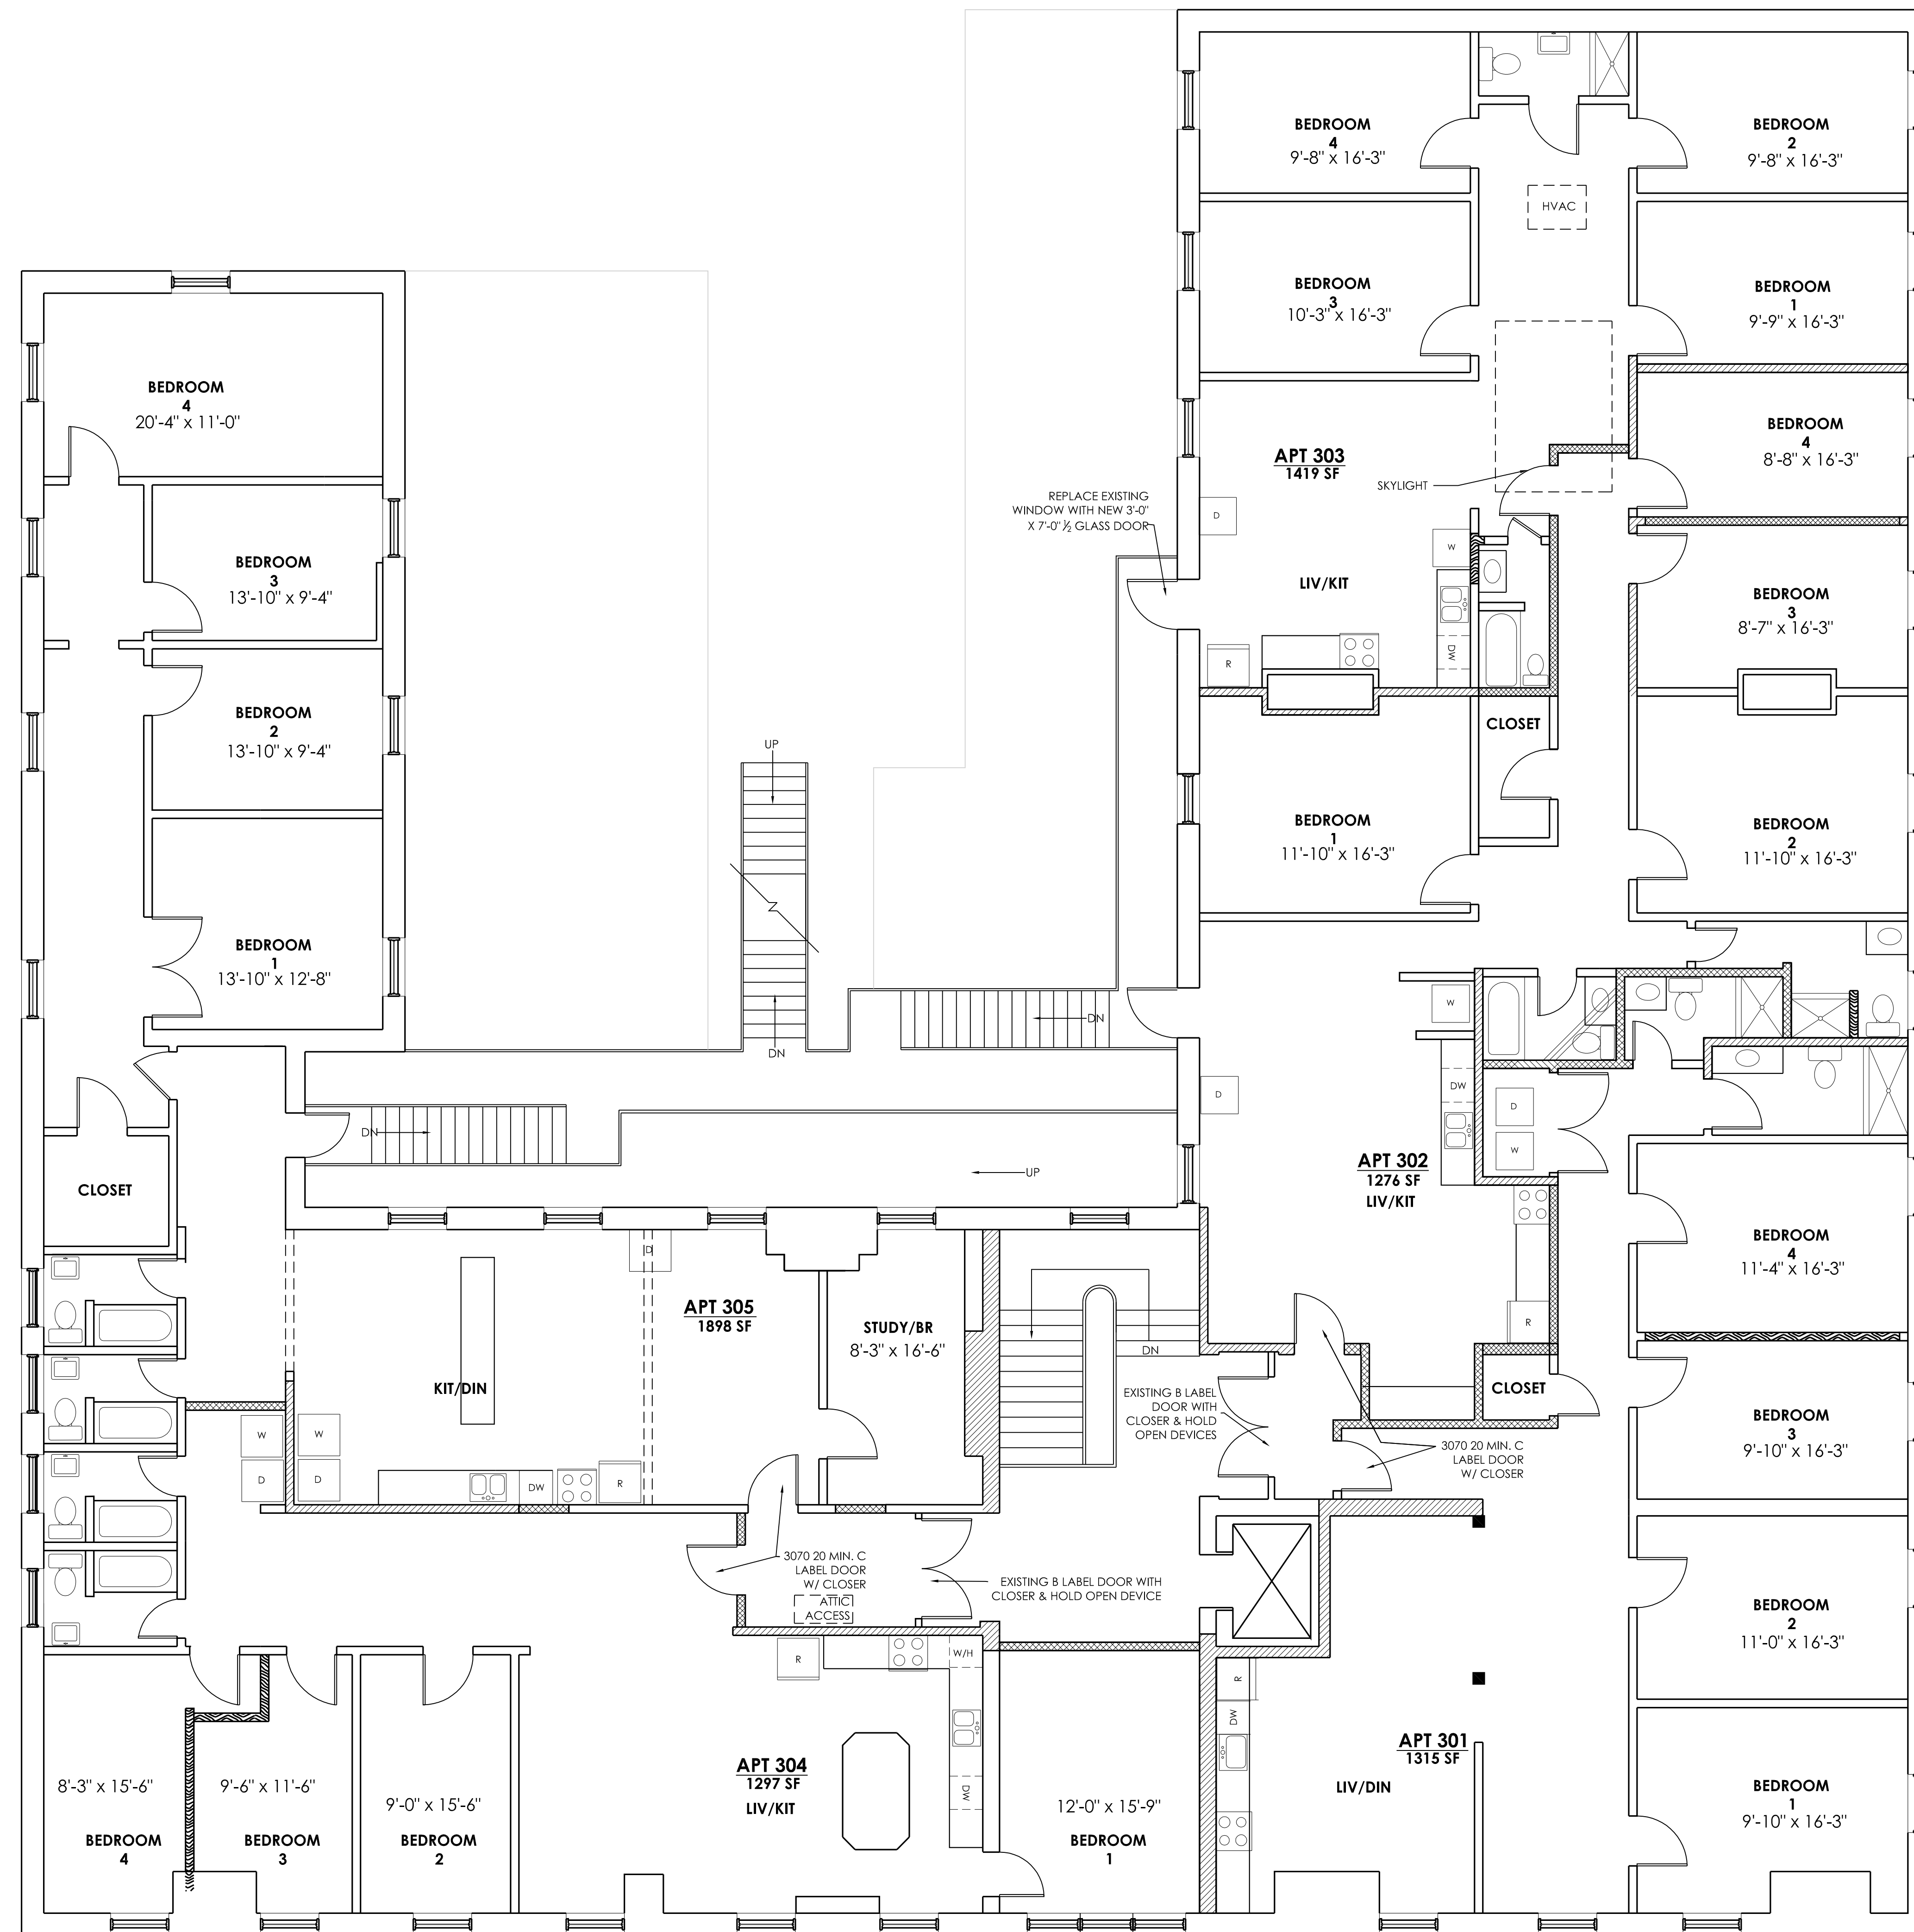


WALL LEGEND	
	EXISTING WALLS TO REMAIN
	EXISTING FIRE RATED WALLS
	NEW 2x4 FRAME WALLS W/ 5/8" TYPE GWB
	NEW FIRE RATED WALLS

REVISIONS		NO.	BY	REVISION
		1	DWM	SUBMIT PLANS TO ACC FOR REVIEW
		2	DWM	19 JUNE 2013
		3	DWM	11 JUNE 2013
		4	DWM	AS-BUILT

DESIGNED: DWM	MR
DRAWN: DWM	MR
CHECKED: DWM	MR
APPROVED: DWM	MR

THIS DRAWING IS THE PROPERTY OF ARMENTROUT & MATHENY. IT IS TO BE USED ONLY FOR THE PROJECT AND SITE SPECIFICALLY INDICATED. NO REUSE OR REPRODUCTION OF THIS DRAWING IS PERMITTED WITHOUT THE WRITTEN CONSENT OF ARMENTROUT & MATHENY.

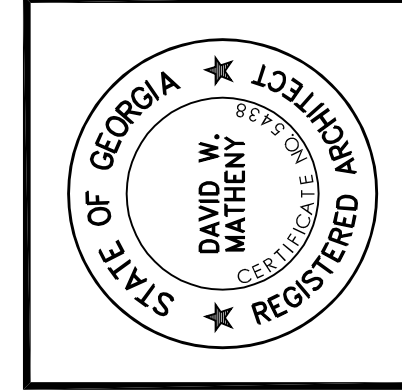

AMT ENGINEERS ARCHITECTS PLANNERS
Armentrout • Matheny • Thurmond

12055

COLLEGE SQUARE APARTMENTS
191 EAST BROAD STREET
ATHENS, GA

AS-BUILD 3RD FLOOR PLAN 1
SCALE: 3/16"=1'-0" A102