


Corporate

Interior

Design

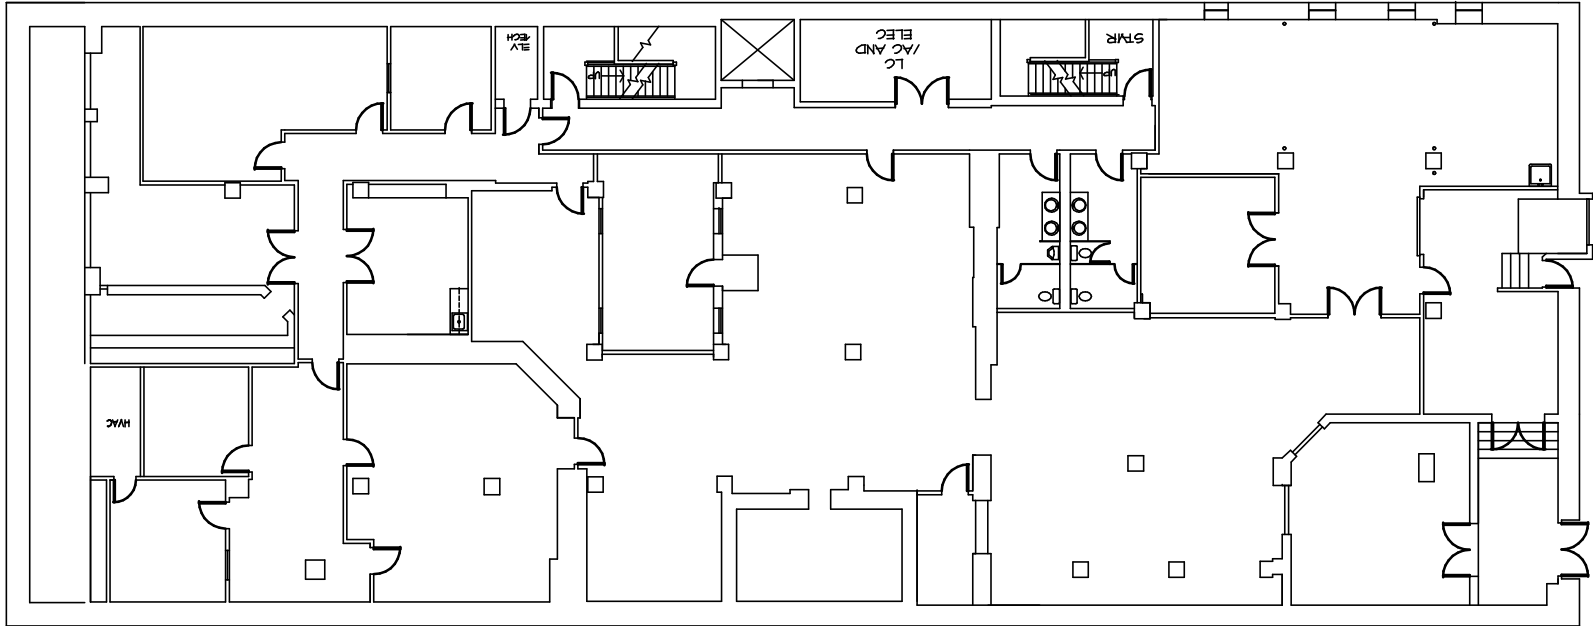

209 Tenth Avenue South  
Suite 209  
Nashville, Tennessee  
37203-4104

PH: (615) 728-1141  
FAX: (615) 728-1088

<b>AMBROSE CONDOMINIUMS</b> 162 4TH AVE. NORTH NASHVILLE, TN	FLOOR: BASEMENT	DATE: 10/17/2007
	AS-BUILT SCALE: NOT TO SCALE	JOB #: 10076-000