


A1

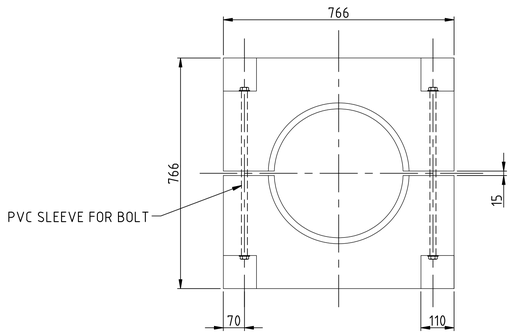

ELEVATION

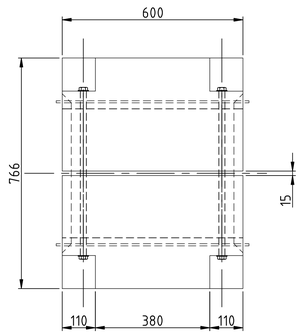


SIDE VIEW

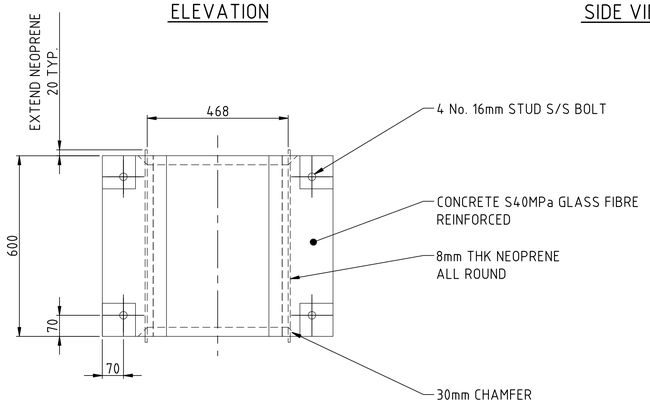


PLAN

SINGLE CONCRETE COLLAR
1:10

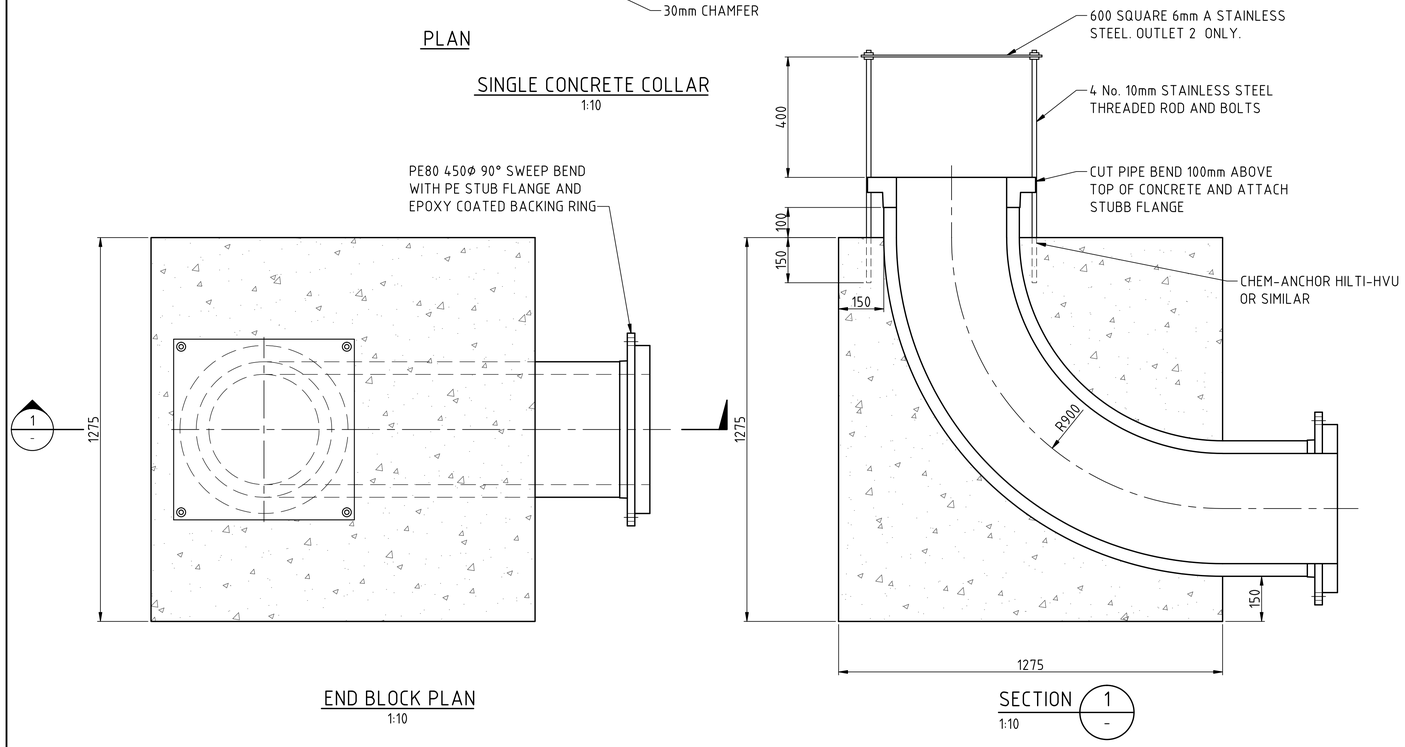


END BLOCK PLAN
1:10

SECTION 1/-
1:10

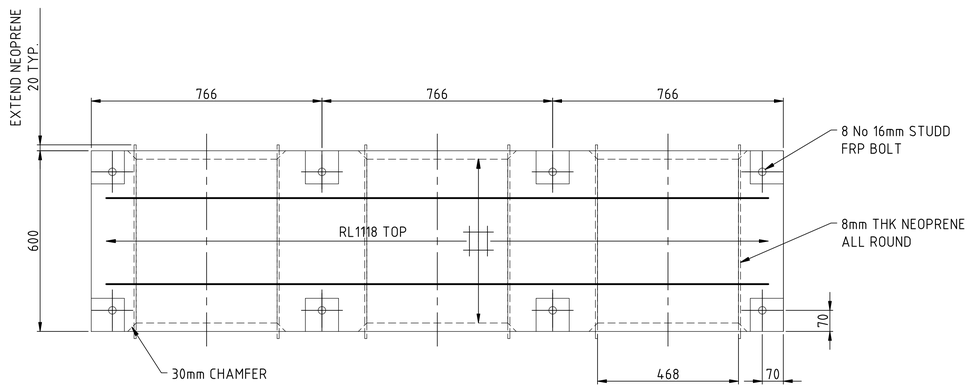

PLAN

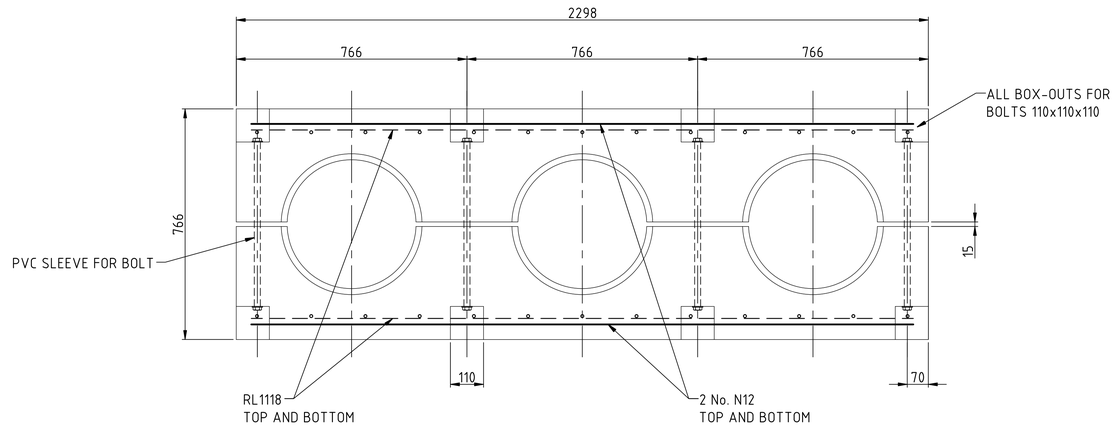

ELEVATION TRIPLE CONCRETE COLLAR
1:10

NOTES

1. BLOCK SPACING 6m CTR TO CTR.
2. 50mm COVER TO ALL REINFORCEMENT.

AS BUILT

COPYRIGHT OF THIS DESIGN IS THE PROPERTY OF CW-DC PTY LTD. THIS AS BUILT DRAWING HAS BEEN PREPARED BASED ON INFORMATION PROVIDED BY MACMAHON. IT HAS NOT BEEN CHECKED OR VERIFIED BY CW-DC.

Rev.	Date	Revision Details	By	Ver.	App.
E	08.01.09	AS BUILT	AH		
D	03.10.06	DETAIL A DELETED	NLC	BGN	RSJ
C	23.08.06	COVER PLATE ADDED	NLC	BGN	RSJ
B	14.08.06	STUB FLANGE RAISED	NLC	BGN	RSJ
A	11.08.06	ISSUED FOR CONSTRUCTION (100% ISSUE)	NLC	BGN	RSJ

CW-DC Pty Ltd
CW-DC Pty Ltd ABN 66 009 310 169
62 Cavenagh Street (PO Box 919) Darwin
Northern Territory 0800 Australia
Telephone: +61 8 8919 9770
Facsimile: +61 8 8919 9768
Email: cwdrw@cw-dc.com.au

A person using CW-DC Pty Ltd drawings and other data accepts the risk of:
1. using the drawings and other data in electronic form without requesting and checking them for accuracy against the original hard copy versions;
2. using the drawings or other data for any purpose not agreed to in writing by CW-DC Pty Ltd.

Client: MACMAHON

Client: Darwin Cove CONSORTIUM

Project: DARWIN CITY WATERFRONT STAGE 1 COMMUNITY & MARINE INFRASTRUCTURE WORKS
FLUSHING SYSTEM

	Drawn	Signed	Date
	NLC	NLC	11.08.06
	Designed	Signed	Date
	KRB	KRB	11.08.06
	Verified	Signed	Date
	BGN	BGN	11.08.06
	Approved	Signed	Date
	RSJ	RSJ	11.08.06

Drawing Title: TYPICAL DETAILS SHEET 2 OF 2

CW-DC Project No. JE02.03

Scale: AS SHOWN

Drawing No. JE02.03-C0-005 Rev. E

Cad File: P:\JE-Flexi\JE02.03\C4-Macmahon\CAD\dwg\03\JE02.03-C0-005.dwg Plot Date: 20/02/09 09:41 Xrefs: \\XBASE1\X-Z\3.4\1-TITLE - \\XBASE1\X-Z\BREAKWATER-TYP-SECTIONS

20 10 0 10 20 30 40 50 100mm