


A1

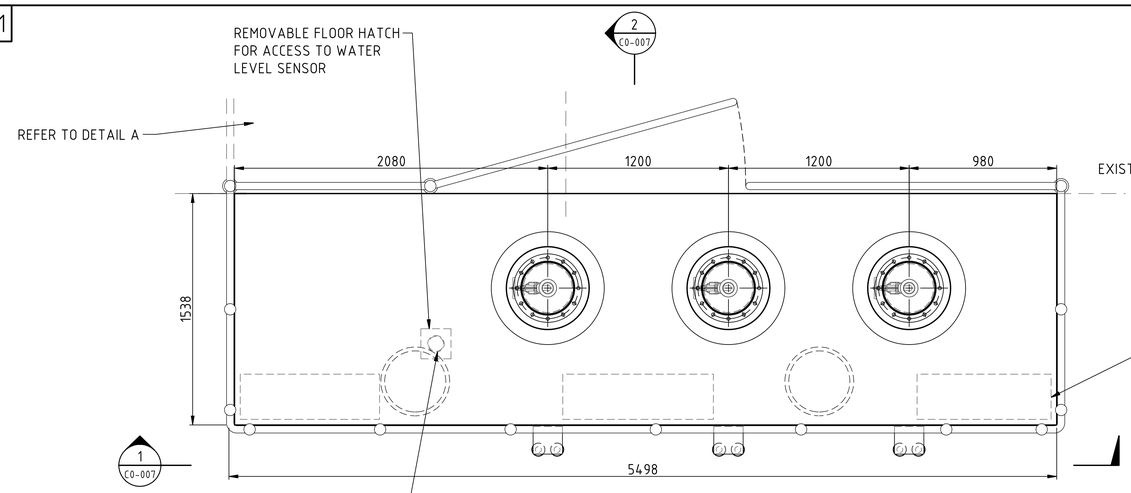


UPPER FRAME PLATFORM PLAN
1:20

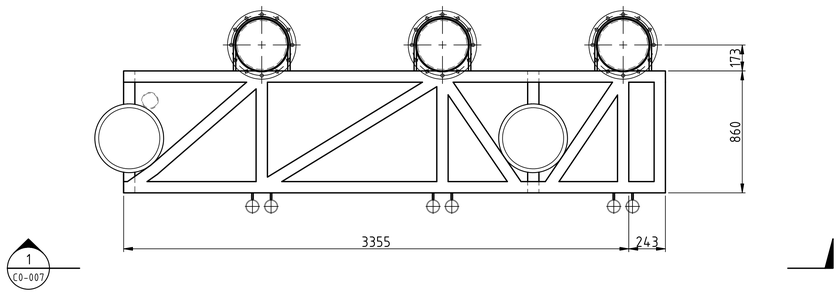

INTERMEDIATE FRAME PLATFORMS PLAN
1:20

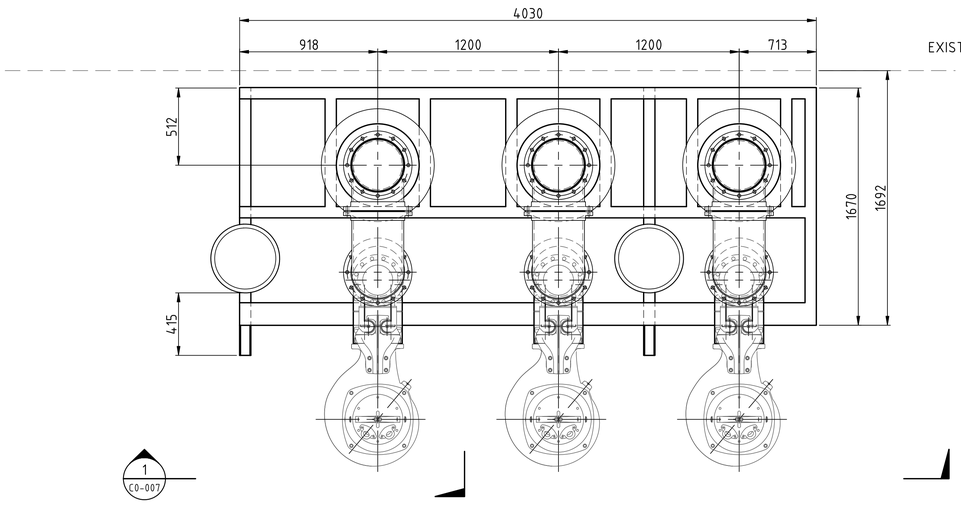

LOWER FRAME PLATFORM PLAN
1:20

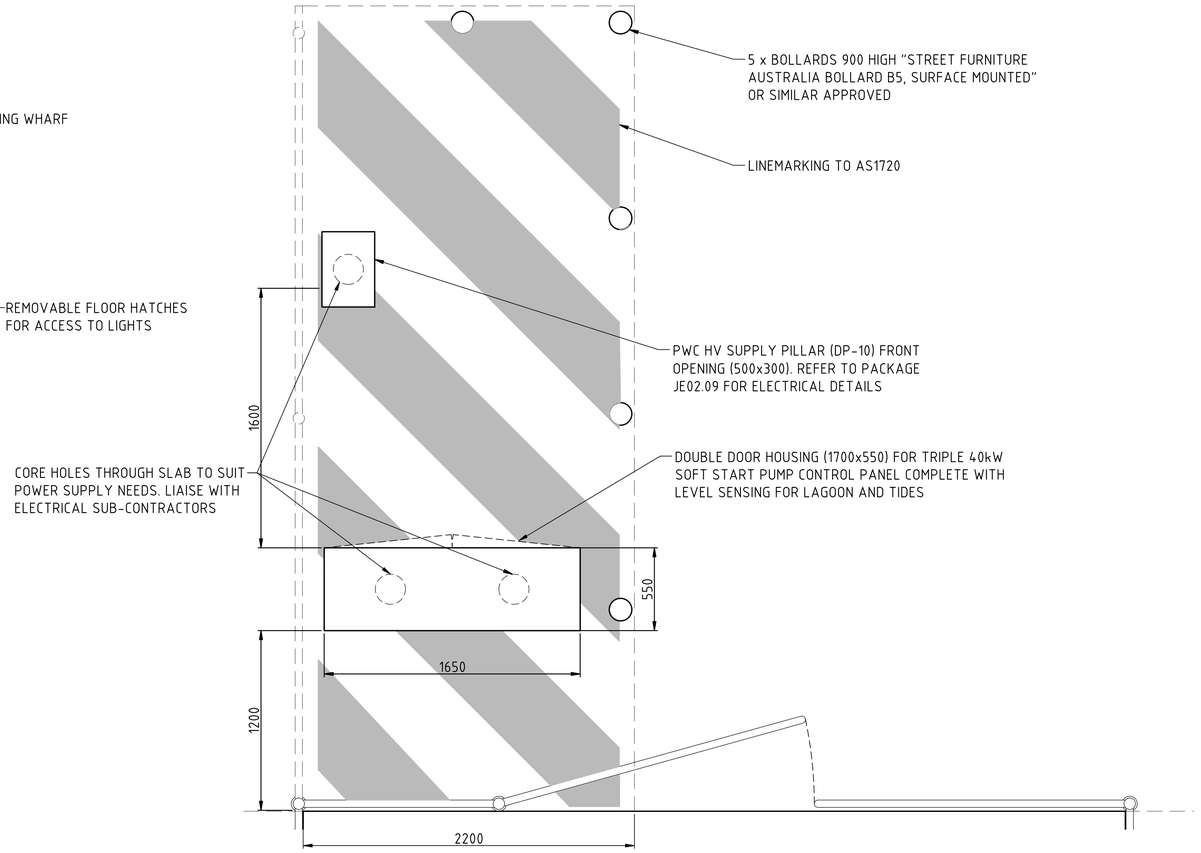

DETAIL A
1:20

REFERENCES

1. REFER TO DRG JE02.03-S0-002 FOR STRUCTURAL DETAILS.

NOTES

1. ALL STAINLESS STEEL TO BE FULLY INSULATED FROM DI AND MILD STEEL ITEMS WITH RUBBER/NYLON SPACES AND SLEEVE WASHERS.

AS BUILT

COPYRIGHT OF THIS DESIGN IS THE PROPERTY OF CW-DC PTY LTD. THIS AS BUILT DRAWING HAS BEEN PREPARED BASED ON INFORMATION PROVIDED BY MACMAHON. IT HAS NOT BEEN CHECKED OR VERIFIED BY CW-DC.

Rev.	Date	Revision Details	By	Ver.	App.
D	13.01.09	AS BUILT	AH		
C	20.04.07	CABINET RELOCATED AND DETAIL A ADDED	NLC	ESL	RSJ
B	30.10.06	LIGHT HATCHES ADDED & CABINET REVISED	NLC	ESL	RSJ
A	20.10.06	ISSUED FOR CONSTRUCTION (100% ISSUE)	NLC	ESL	RSJ

CW-DC Pty Ltd
CW-DC Pty Ltd ABN 66 009 310 169
62 Cavenagh Street (PO Box 919) Darwin
Northern Territory 0800 Australia
Telephone: +61 8 8919 9770
Facsimile: +61 8 8919 9768
Email: cwdrw@cw-dc.com.au

A person using CW-DC Pty Ltd drawings and other data accepts the risk of:
1. using the drawings and other data in electronic form without requesting and checking them for accuracy against the original hard copy versions;
2. using the drawings or other data for any purpose not agreed to in writing by CW-DC Pty Ltd.

Client: MACMAHON

Client: Darwin Cove CONSORTIUM

Project: DARWIN CITY WATERFRONT STAGE 1 COMMUNITY & MARINE INFRASTRUCTURE WORKS
FLUSHING SYSTEM

Drawn	NLC	Signed	NLC	Date	20.10.06
Designed	KRB	Signed	KRB	Date	20.10.06
Verified	ESL	Signed	ESL	Date	20.10.06
Approved	RSJ	Signed	RSJ	Date	20.10.06

Drawing Title: PUMP STATION PLANS

CW-DC Project No. JE02.03

Scale 1:20

Drawing No. JE02.03-C0-006 Rev. D

20 10 0 10 20 30 40 50 100mm

Cad File: P:\JE-Fleet\JE02\DCW-CT - Macmahon\CAD\Dwgs\S03\JE02.03-C0-006.dwg Plot Date: 20/02/09 09:42 Xrefs: \\VBASESVR-P\FLUSHING-PUMP-STATION - \\VBASESVR-03\A1-TITLE