

A1

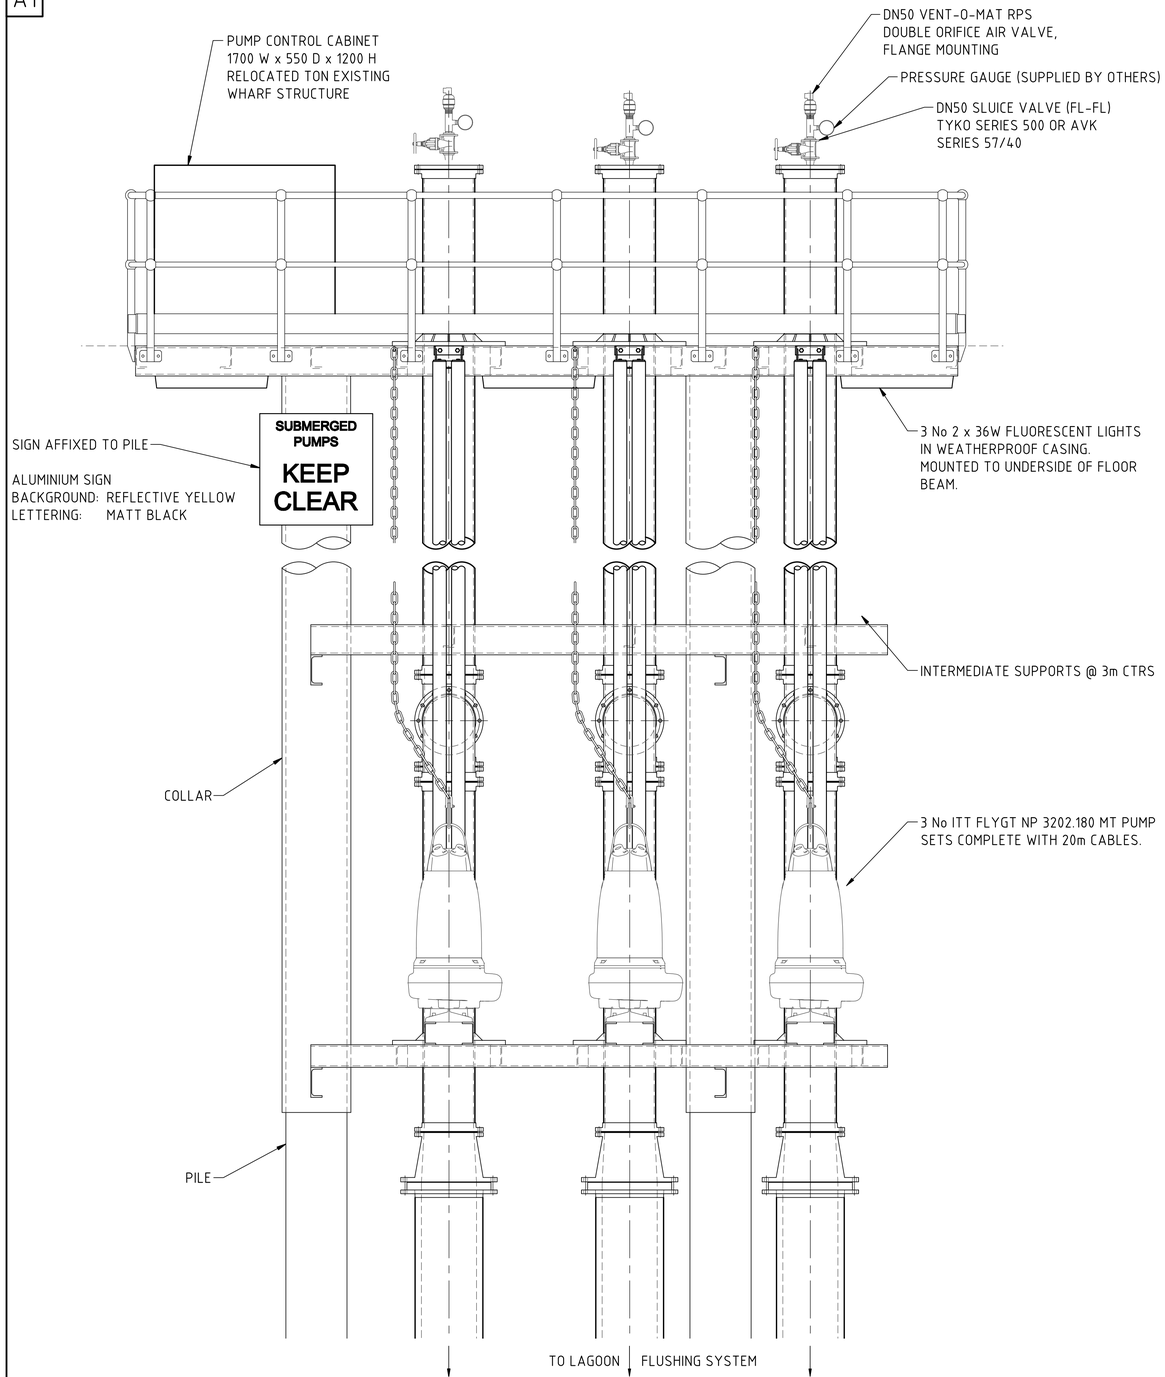

SECTION 1 (C0-006)
1:20

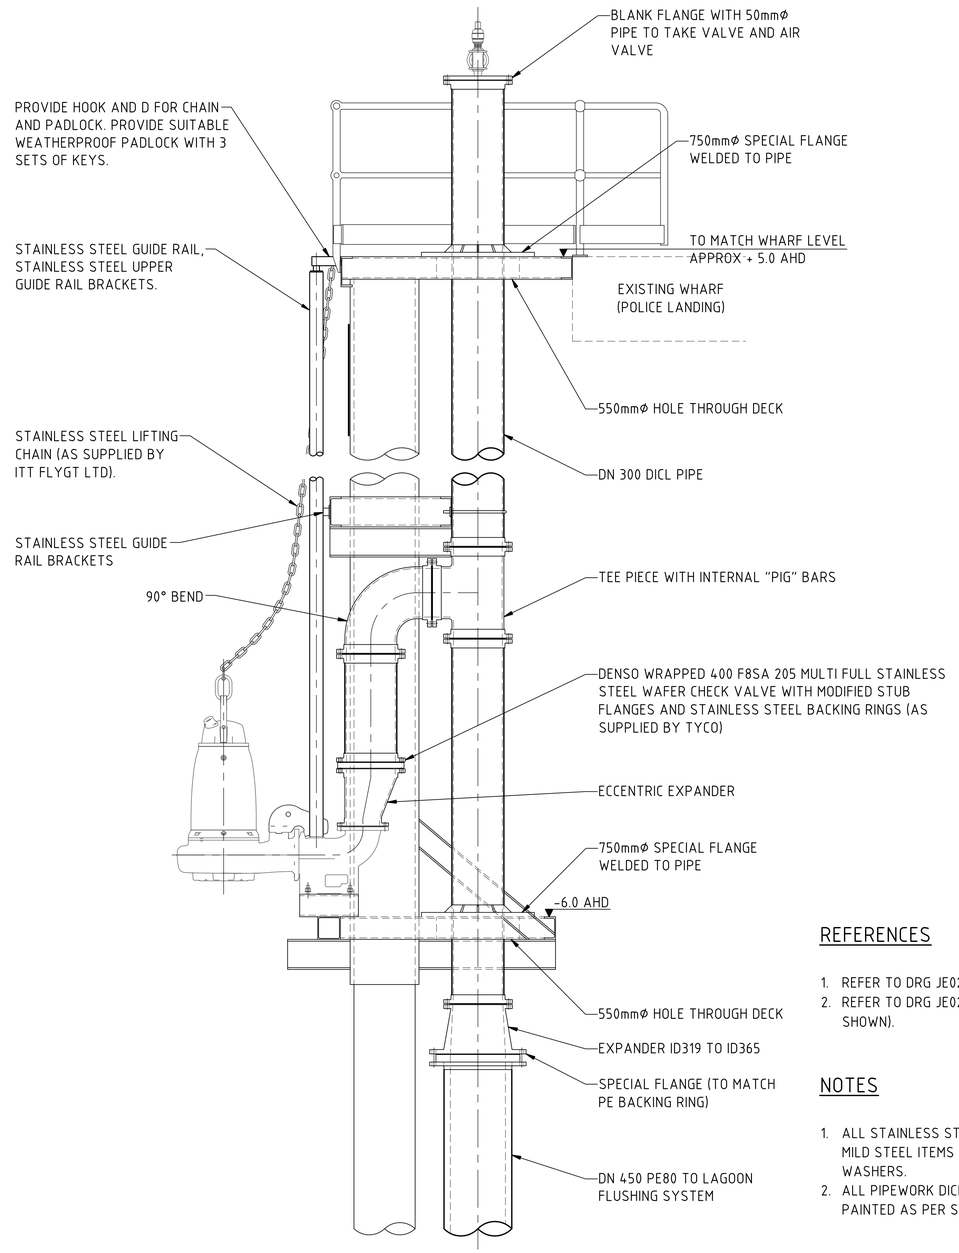

SECTION 2 (C0-006)
1:20

REFERENCES

1. REFER TO DRG JE02.03-S0-002 FOR STRUCTURAL DETAILS.
2. REFER TO DRG JE02.03-C0-006 FOR WATER LEVEL SENOR (NOT SHOWN).

NOTES

1. ALL STAINLESS STEEL TO BE FULLY INSULATED FROM DI AND MILD STEEL ITEMS WITH RUBBER/NYLON SPACES AND SLEEVE WASHERS.
2. ALL PIPEWORK DICL UNO. PIPEWORK TO BE EXTERNALLY PAINTED AS PER STEELWORK.

AS BUILT

COPYRIGHT OF THIS DESIGN IS THE PROPERTY OF CW-DC PTY LTD. THIS AS BUILT DRAWING HAS BEEN PREPARED BASED ON INFORMATION PROVIDED BY MACMAHON. IT HAS NOT BEEN CHECKED OR VERIFIED BY CW-DC.

Rev.	Date	Revision Details	By	Ver.	App.
D	13.01.09	AS BUILT	AH		
C	20.04.07	CABINET RELOCATED	NLC	ESL	RSJ
B	30.10.06	NOTES ADDED & FLANGE REVISED	NLC	ESL	RSJ
A	20.10.06	ISSUED FOR CONSTRUCTION (100% ISSUE)	NLC	ESL	RSJ

CW-DC Pty Ltd
CW-DC Pty Ltd ABN 86 009 310 169
62 Cavenagh Street (PO Box 919) Darwin
Northern Territory 0800 Australia
Telephone: +61 8 8919 9770
Facsimile: +61 8 8919 9768
Email: cwdrw@cw-dc.com.au

A person using CW-DC Pty Ltd drawings and other data accepts the risk of:
1. using the drawings and other data in electronic form without requesting and checking them for accuracy against the original hard copy versions;
2. using the drawings or other data for any purpose not agreed to in writing by CW-DC Pty Ltd.

Client: MACMAHON

Client: Darwin Cove CONSORTIUM

Project: DARWIN CITY WATERFRONT STAGE 1 COMMUNITY & MARINE INFRASTRUCTURE WORKS
FLUSHING SYSTEM

	Signed	Date
Drawn: NLC	NLC	20.10.06
Designed: KRB	KRB	20.10.06
Verified: ESL	ESL	20.10.06
Approved: RSJ	RSJ	20.10.06

Drawing Title: PUMP STATION SECTIONS

CW-DC Project No.: JE02.03

Scale: 1:20

Drawing No.: JE02.03-C0-007 Rev.: D

20 10 0 10 20 30 40 50 100mm

Cad File: P:\JE-Files\JE02.03\C-Macmahon\Cad\dwg\03\JE02.03-C0-007.dwg Plot Date: 20/02/09 09:42 Xrefs: \\KBASESVR-P\FLUSHING-PUMP-STATION-\...\KBASESVR-03-A1-TITLE