
A1

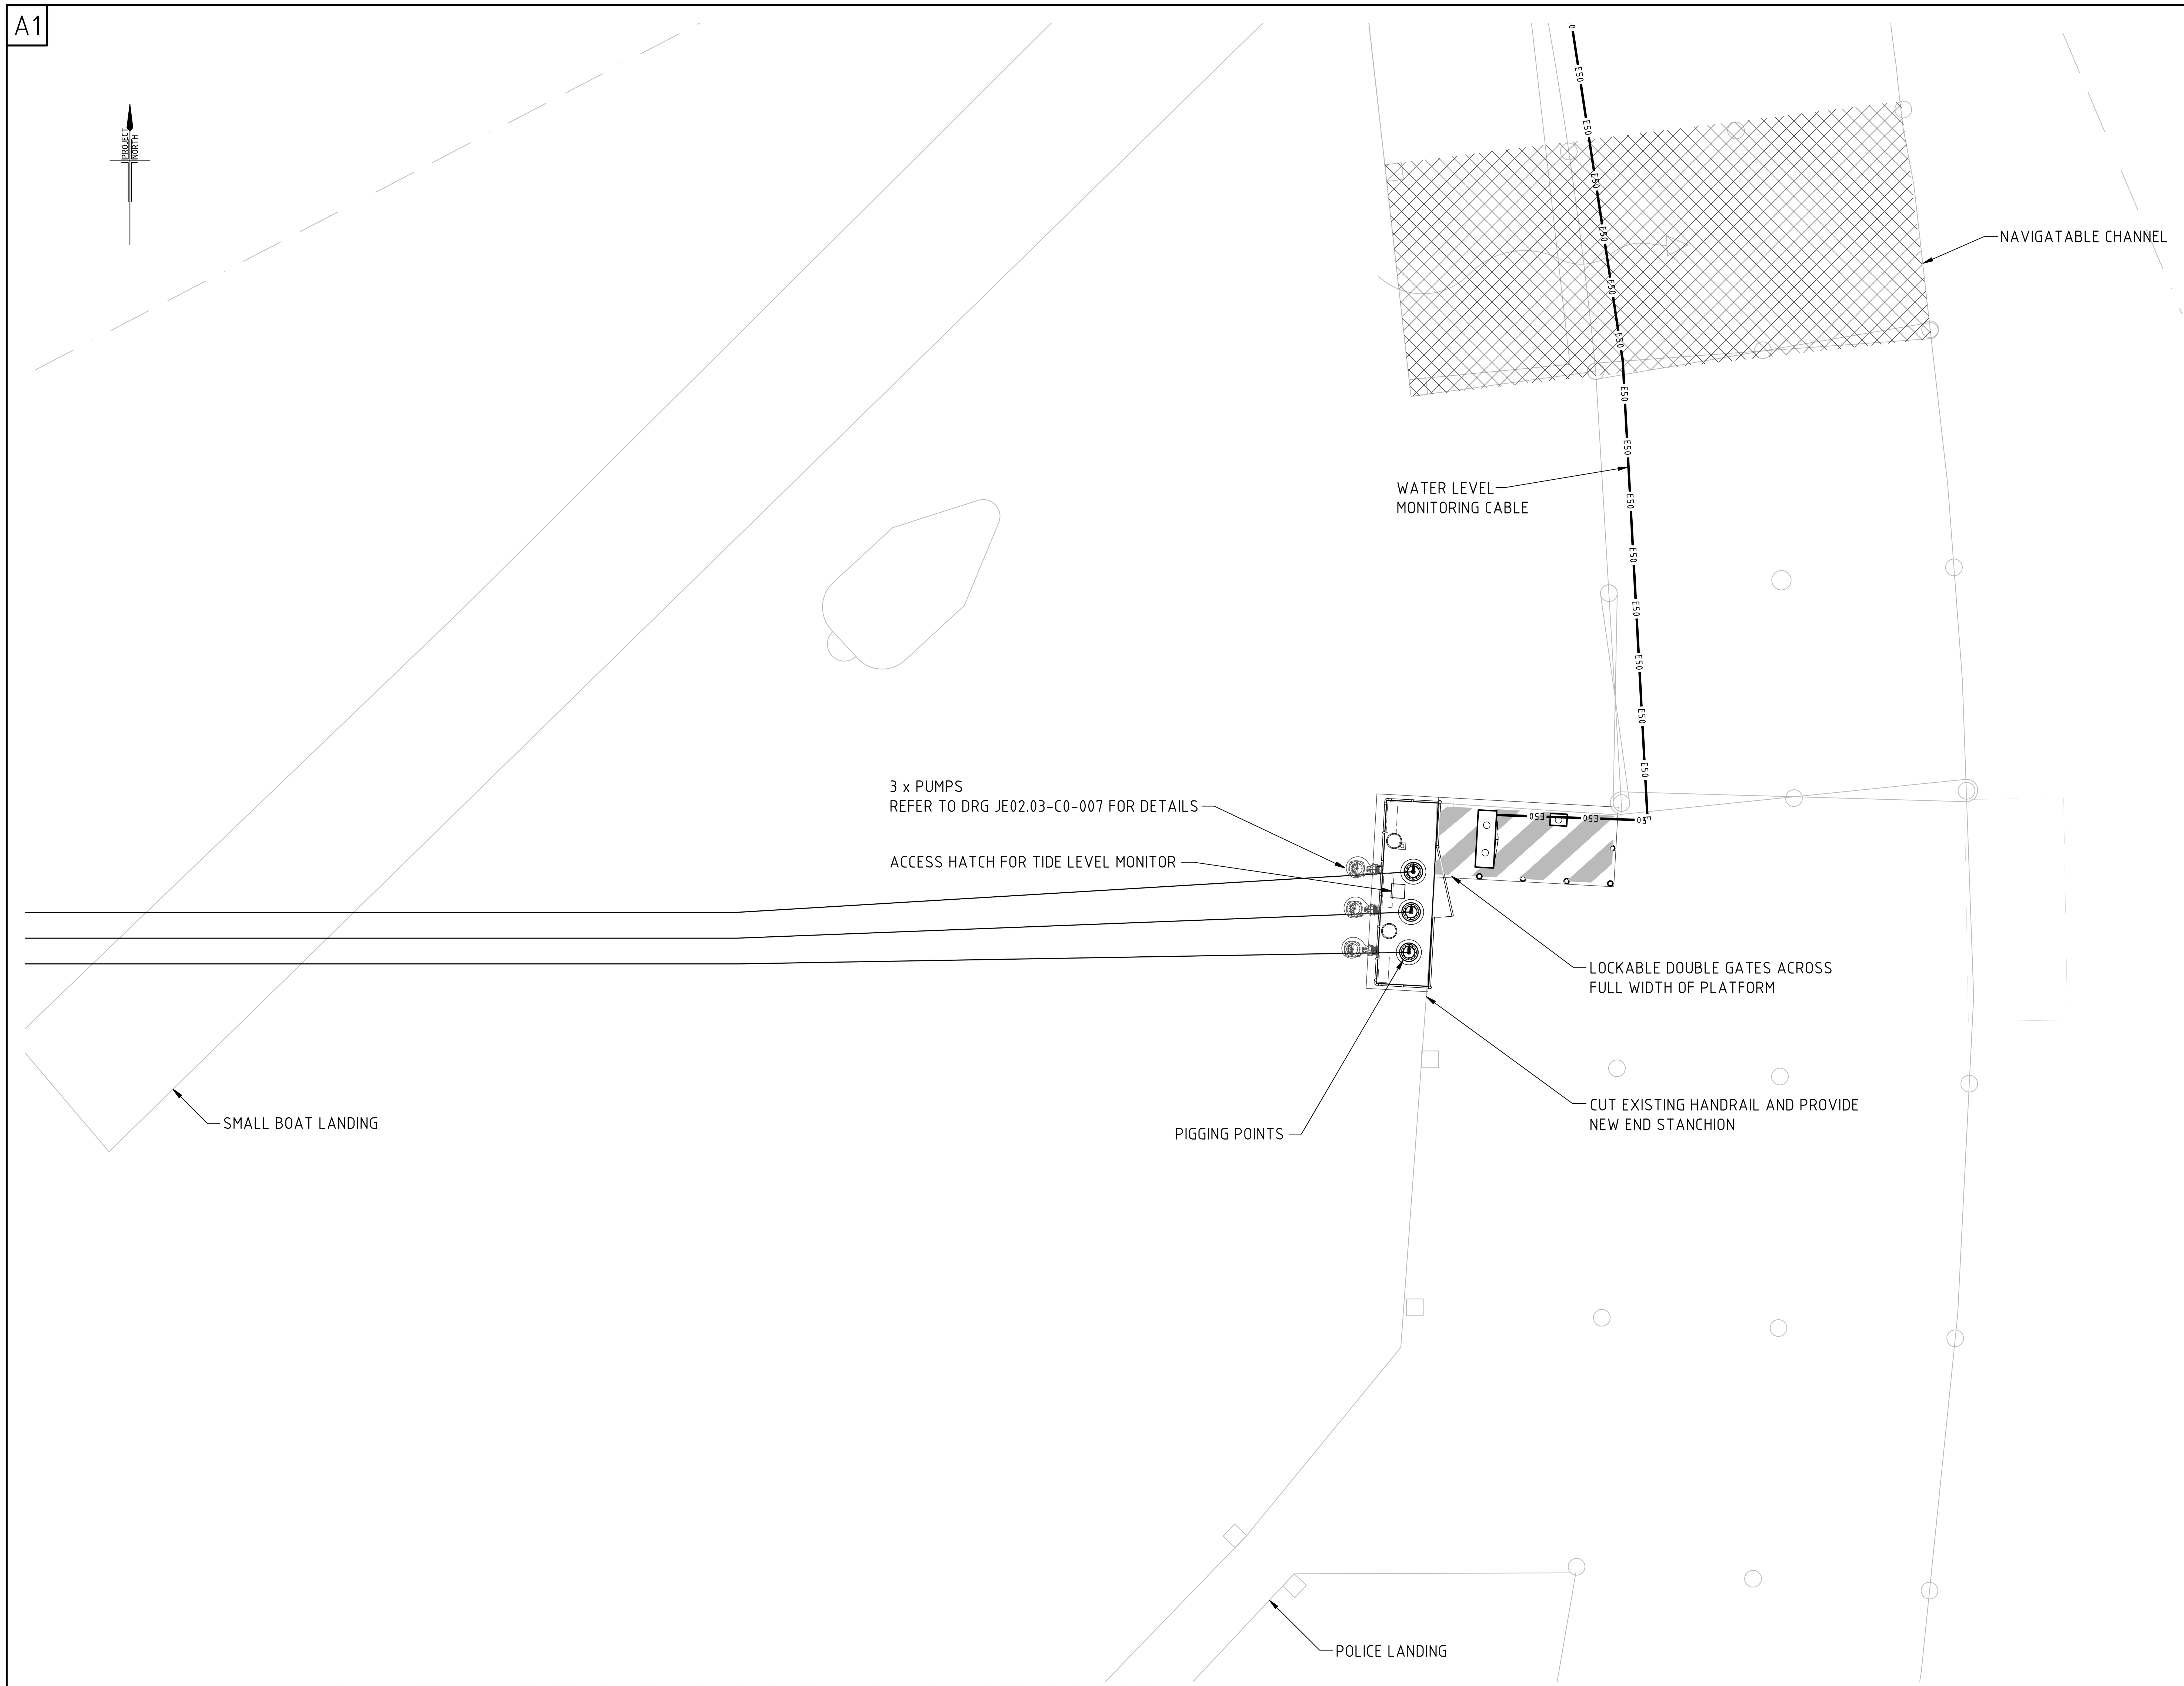

SETOUT NOTE:
Darwin Wharf Precinct Local Grid Coordinates are based on Ground Distances and a Rotation of 0°24' from MGA94 Grid North
Ground Distances = MGA94 Distance / 1.000090
True Bearing = Grid Bearing - 0°24'00"
EJA Ref Point E700094.241,N8621136.678

WARNING
BEWARE OF UNDERGROUND SERVICES
The locations of underground services are approximate only and their exact position should be proven on site.
No guarantee is given that all existing services are shown

REFERENCES

1. REFER TO DRG JE02.03-E1-001 FOR POWER SUPPLY (NOT SHOWN).
2. REFER TO DRG JE02.03-S0-002 FOR STRUCTURAL DETAILS OF PLATFORM.

AS BUILT

COPYRIGHT OF THIS DESIGN IS THE PROPERTY OF CW-DC PTY LTD.

THIS AS BUILT DRAWING HAS BEEN PREPARED BASED ON INFORMATION PROVIDED BY MACMAHON. IT HAS NOT BEEN CHECKED OR VERIFIED BY CW-DC.

Rev.	Date	Revision Details	By	Ver.	App.
C	13.01.09	AS BUILT	AH		
B	20.04.07	CABINET RELOCATED	NLC	ESL	RSJ
A	20.10.06	ISSUED FOR CONSTRUCTION (100% ISSUE)	NLC	ESL	RSJ

CW-DC Pty Ltd

CW-DC Pty Ltd ABN 66 009 310 169
62 Cavenagh Street (PO Box 919) Darwin
Northern Territory 0800 Australia
Telephone: +61 8 8919 9770
Facsimile: +61 8 8919 9768
Email: cwdrw@cw-dc.com.au

A person using CW-DC Pty Ltd drawings and other data accepts the risk of:
1. using the drawings and other data in electronic form without requesting and checking them for accuracy against the original hard copy versions;
2. using the drawings or other data for any purpose not agreed to in writing by CW-DC Pty Ltd.

Client: MACMAHON

Client: DarwinCove CONSORTIUM

Project:
DARWIN CITY WATERFRONT STAGE 1 COMMUNITY & MARINE INFRASTRUCTURE WORKS
FLUSHING SYSTEM

		Signed	Date
Drawn	NLC	NLC	20.10.06
Designed	KRB	KRB	20.10.06
Verified	ESL	ESL	20.10.06
Approved	RSJ	RSJ	20.10.06

Drawing Title: PUMP STATION DETAILED LAYOUT

CW-DC Project No. **JE02.03**

Scale 1:100

Drawing No. **JE02.03-C0-008** Rev. **C**

20 10 0 10 20 30 40 50 100mm

Cad File: P:\JE-Files\JE02 DCW CI - Macmahon\CAD\DWG\03\JE02.03-C0-008.dwg Plot Date: 20/02/09 09:44 Xrefs: ..\..\XBASE\X-P-BDYS ..\..\XBASE\X-P-FLUSHING ..\..\XBASE\X-03-A1-TITLE ..\..\XBASE\X-P-NOTES-SETOUT ..\..\XBASE\X-P-FLUSHING-PUMP-STATION ..\..\XBASE\X-P-FLUSHING-PUMP-STATION ..\..\XBASE\X-P-BREAKWATER-ELEC