



A1

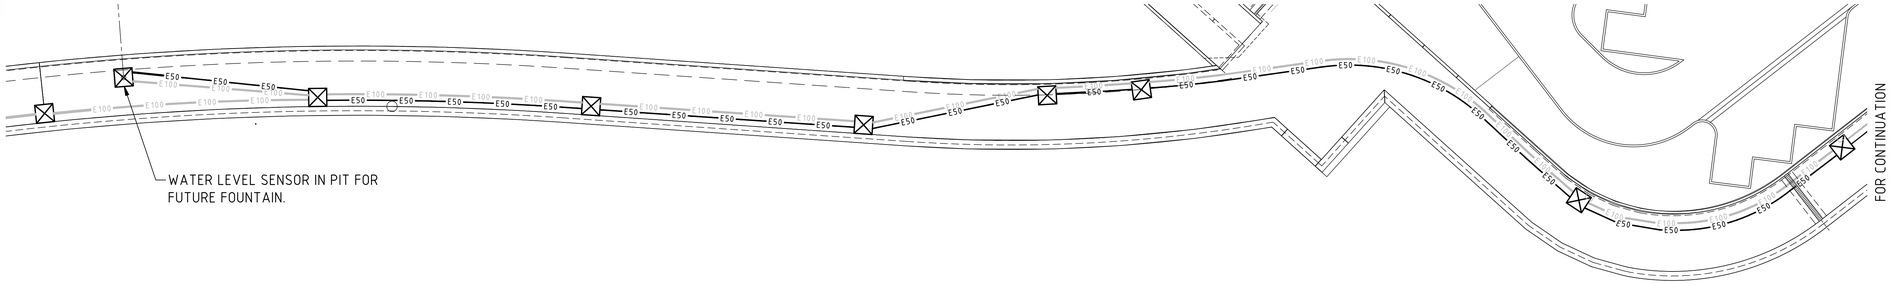

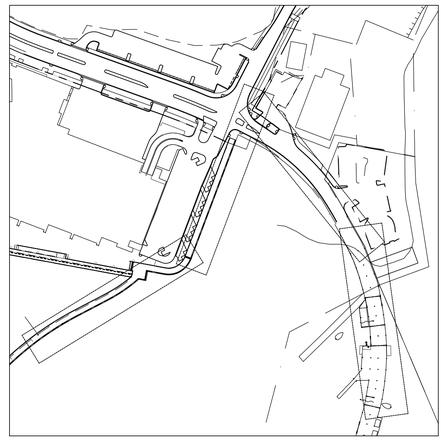

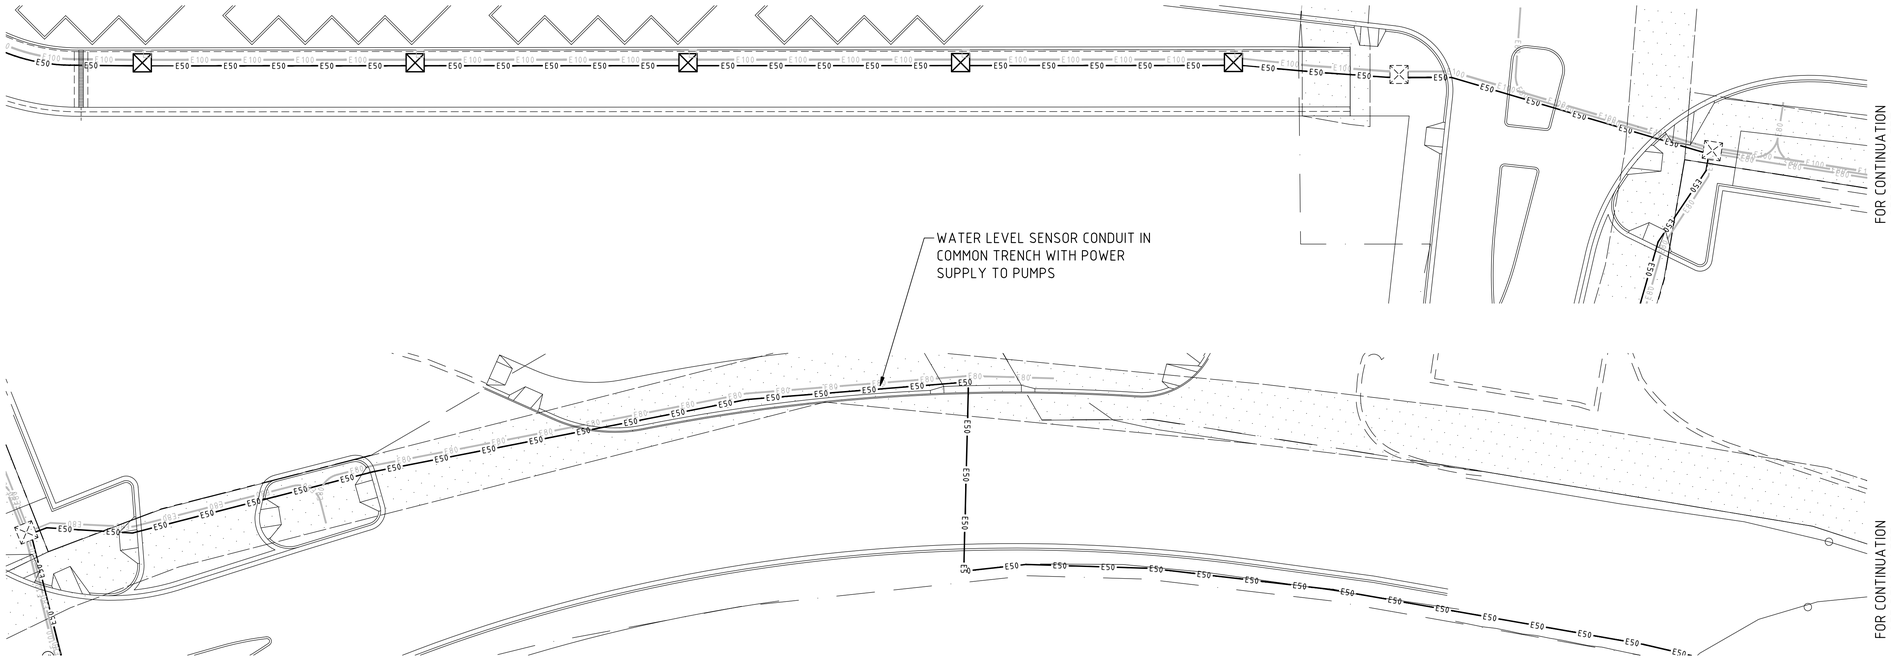

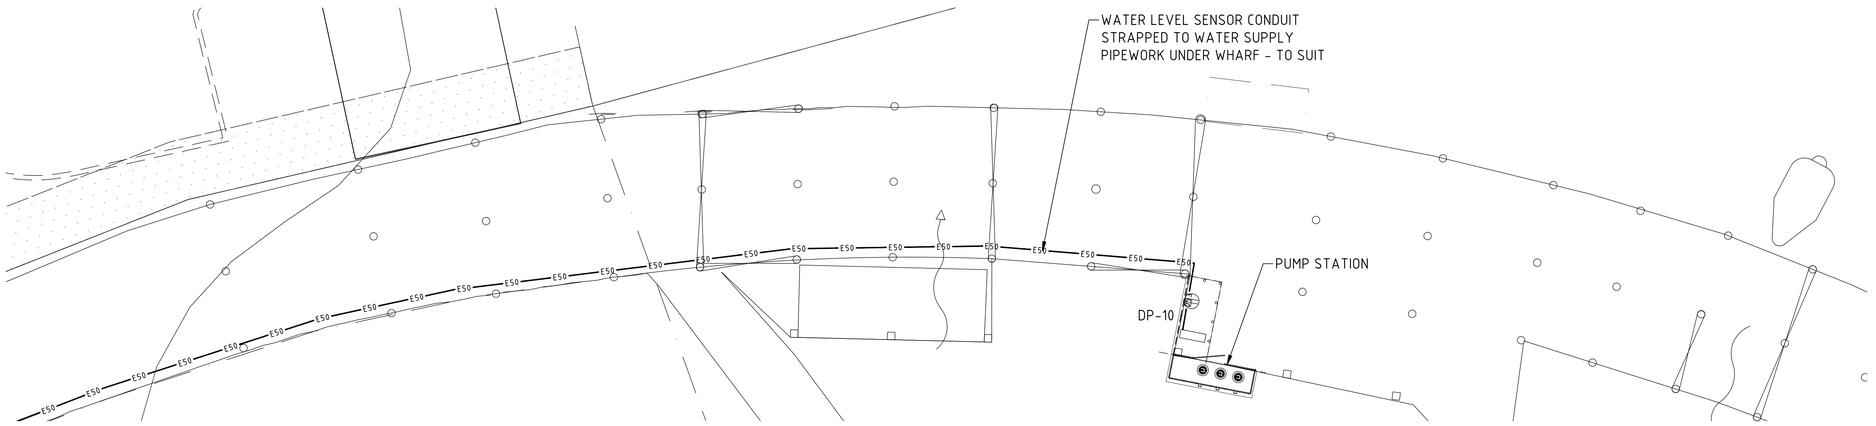

COPYRIGHT OF THIS DESIGN IS THE PROPERTY OF CW-DC PTY LTD. THIS AS BUILT DRAWING HAS BEEN PREPARED BASED ON INFORMATION PROVIDED BY MACMAHON. IT HAS NOT BEEN CHECKED OR VERIFIED BY CW-DC.

AS BUILT

Rev.	Date	Revision Details	By	Ver.	App.
F	13.01.09	AS BUILT	AH		
E	20.04.07	DP-10 RELOCATED	NLC	CT	RSJ
D	08.02.07	DP-10 LABELLED	NLC	PM	RSJ
C	20.12.06	MINOR REVISIONS	NLC	LW	RSJ
B	26.10.06	NOTE ADDED & ALIGNMENT REVISED	NLC	LW	RSJ
A	20.10.06	ISSUED FOR CONSTRUCTION (100% ISSUE)	NLC	LW	RSJ

CW-DC Pty Ltd
CW-DC Pty Ltd ABN 66 009 310 169
62 Cavenagh Street (PO Box 919) Darwin
Northern Territory 0800 Australia
Telephone: +61 8 8919 9770
Facsimile: +61 8 8919 9768
Email: cwdrw@cw-dc.com.au

A person using CW-DC Pty Ltd drawings and other data accepts the risk of:
1. using the drawings and other data in electronic form without requesting and checking them for accuracy against the original hard copy versions;
2. using the drawings or other data for any purpose not agreed to in writing by CW-DC Pty Ltd.

Client: MACMAHON

Client: Darwin Cove CONSORTIUM

Project: DARWIN CITY WATERFRONT STAGE 1 COMMUNITY & MARINE INFRASTRUCTURE WORKS
FLUSHING SYSTEM

Drawn	Signed	Date	
NLC	NLC	20.10.06	
Designed	Signed	Date	
MH	MH	20.10.06	
Verified	Signed	Date	
LW	LW	20.10.06	
Approved	Signed	Date	
RSJ	RSJ	20.10.06	

Drawing Title: WATER LEVEL SENSOR CONDUIT

CW-DC Project No. JE02.03

Scale 1:200

Drawing No. JE02.03-E1-001 Rev. F

20 10 0 10 20 30 40 50 100mm

LastFile: P:\JE-Flush\JE02.03\C1-Macmahon\CAD\DWGS\JE02.03-E1-001.dwg Plot Date: 20/02/09 9:44 Xrefs: \\XBASE1\X-A1-TITLE \\XBASE1\X-P-BOYS \\XBASE1\X-P-ROADS-ELEC \\XBASE1\X-P-BREAKWATER-ELEC \\XBASE1\X-P-LOCALITY-SML \\XBASE1\X-P-ROADS \\XBASE1\X-P-BREAKWATER \\XBASE1\X-P-ROADS-DECE - SERVITONAS\CIVIL\X-P-FLUSHING-PUMP-STATION \\.\GRID DECE - SERVITONAS\CIVIL\X-P-ROADS-DECE