
A1

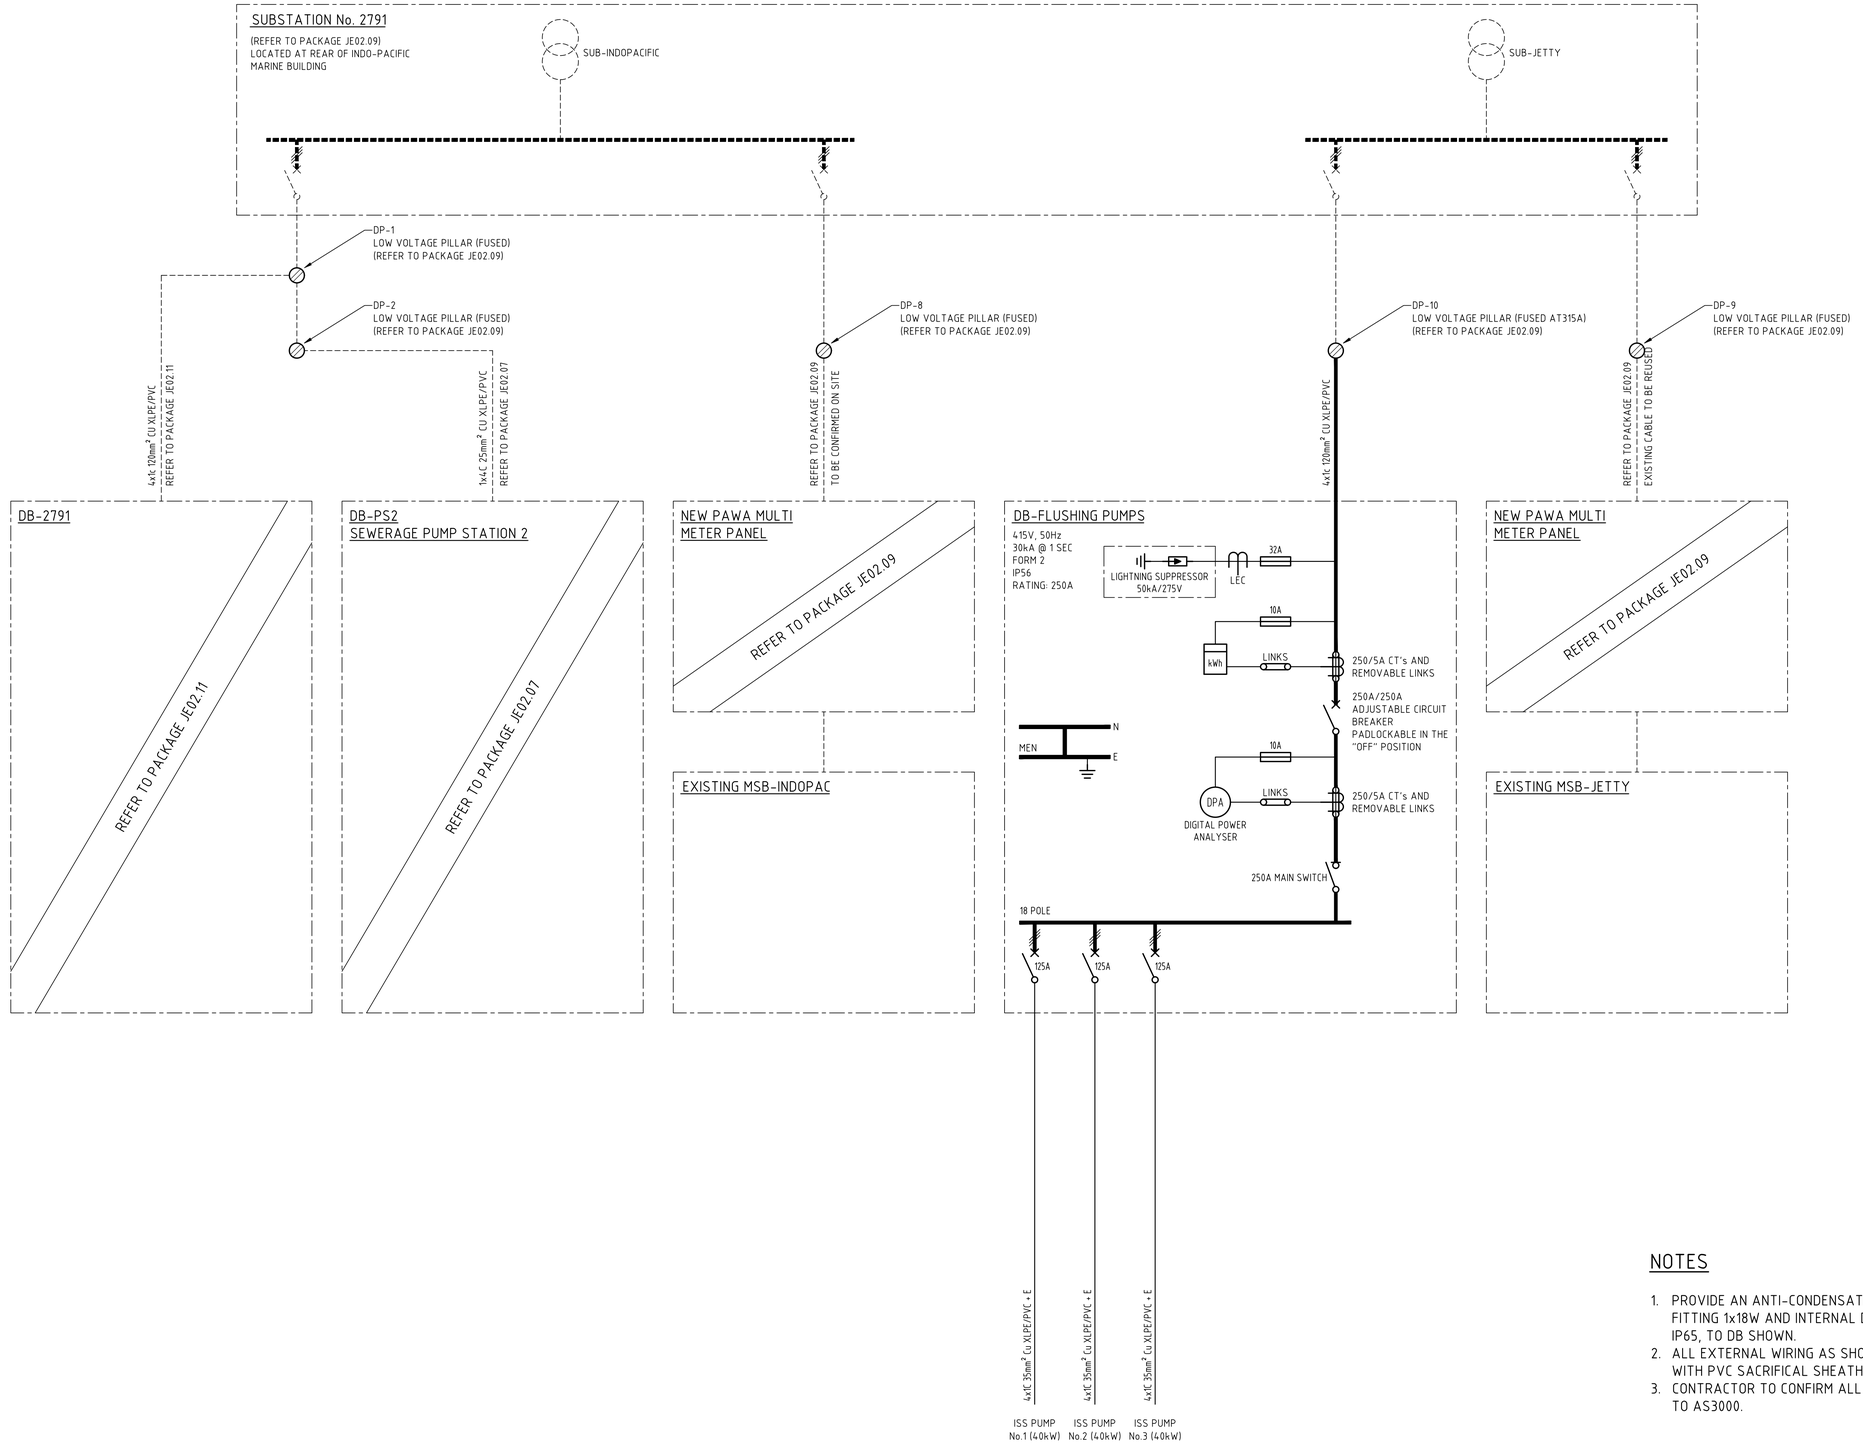

NOTES

1. PROVIDE AN ANTI-CONDENSATION HEATER, INTERNAL LIGHT FITTING 1x18W AND INTERNAL DOUBLE SOCKET OUTLET 2x10A IP65, TO DB SHOWN.
2. ALL EXTERNAL WIRING AS SHOWN INCLUDING NYLON JACKET WITH PVC SACRIFICAL SHEATHING.
3. CONTRACTOR TO CONFIRM ALL CONSUMER MSBS ARE EARTHED TO AS3000.

AS BUILT

COPYRIGHT OF THIS DESIGN IS THE PROPERTY OF CW-DC PTY LTD. THIS AS BUILT DRAWING HAS BEEN PREPARED BASED ON INFORMATION PROVIDED BY MACMAHON. IT HAS NOT BEEN CHECKED OR VERIFIED BY CW-DC.

Rev.	Date	Revision Details	By	Ver.	App.
E	13.01.09	AS BUILT	AH		
D	22.02.07	MINOR TEXT REVISIONS	NLC	PM	RSJ
C	20.02.07	MINOR REVISIONS	NLC	PM	RSJ
B	16.02.07	MINOR TEXT REVISIONS	NLC	PM	RSJ
A	19.01.07	ISSUED FOR CONSTRUCTION (100% ISSUE)	NLC	PM	RSJ

CW-DC Pty Ltd
CW-DC Pty Ltd ABN 66 009 310 169
62 Cavenagh Street (PO Box 919) Darwin
Northern Territory 0800 Australia
Telephone: +61 8 8919 9770
Facsimile: +61 8 8919 9768
Email: cwdrw@cw-dc.com.au

A person using CW-DC Pty Ltd drawings and other data accepts the risk of:
1. using the drawings and other data in electronic form without requesting and checking them for accuracy against the original hard copy versions;
2. using the drawings or other data for any purpose not agreed to in writing by CW-DC Pty Ltd.

Client: MACMAHON

Client: Darwin Cove CONSORTIUM

Project: DARWIN CITY WATERFRONT STAGE 1 COMMUNITY & MARINE INFRASTRUCTURE WORKS
FLUSHING SYSTEM

Drawn	Signed	Date	
NLC	NLC	19.01.07	
Designed	Signed	Date	
MH	MH	19.01.07	
Verified	Signed	Date	
PM	PM	19.01.07	
Approved	Signed	Date	
RSJ	RSJ	19.01.07	

Drawing Title: DB FLUSHING PUMPS SINGLE LINE DIAGRAM

CW-DC Project No.: JE02.03

Scale: N.T.S

Drawing No.: JE02.03-E1-002 Rev.: E

20 10 0 10 20 30 40 50 100mm

Cad File: P:\JE-Files\JE02.03\CW-Mechanical\CAD\DWGS\JE02.03-E1-002.dwg Plot Date: 20/02/09 09:45 Xrefs: \\XBASE\X-03-A1-TITLE \\XBASE\X-P-A-LV-SINGLE-LINE-DIAG