

A1

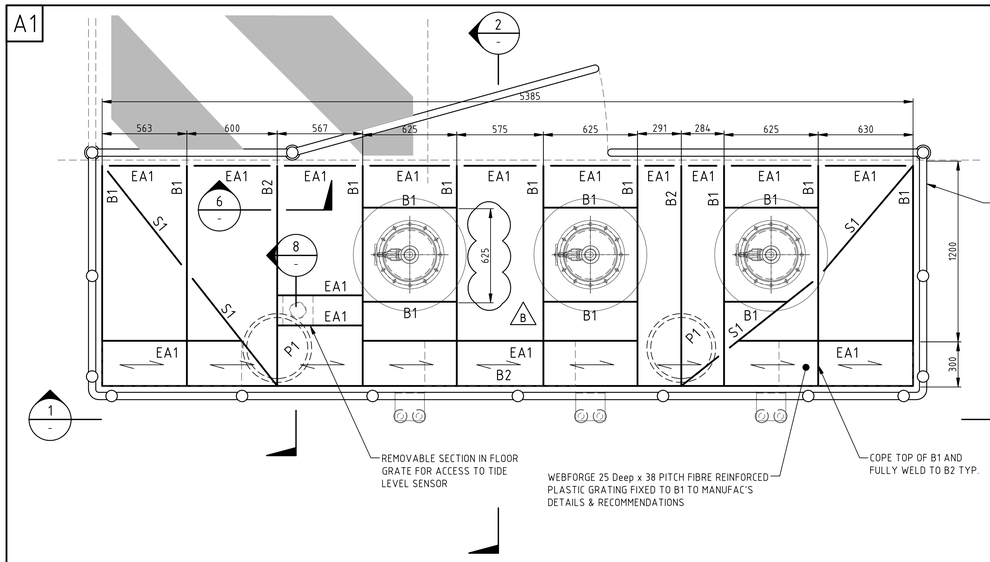

UPPER FRAMING PLAN
1:20

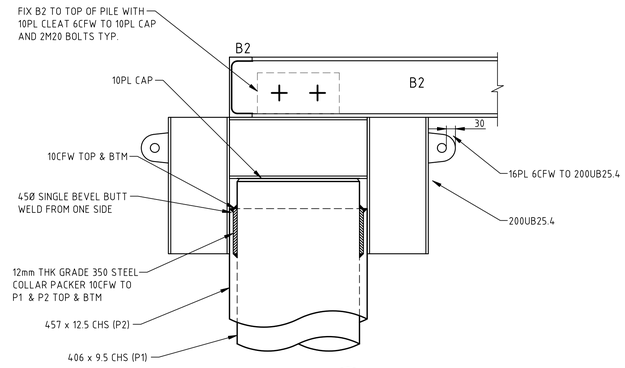


SECTION 8
1:10


STEELWORK MEMBER SCHEDULE

MARK	SIZE	REMARKS
B1	150 PFC	FLOOR BEAM (750 CRS MAX)
B2	200 PFC	FLOOR BEAM
B3	150 x 150 x 6 SHS	BEAM
B4	150 PFC	
EA1	75 x 75 x 6 EA	
S1	150 PFC	STRUT FULLY WELDED EACH END U.N.O.
P1	406 x 9.5 CHS	PILE
P2	457 x 12.5 CHS	SLEEVE


⟺ DENOTES SPAN OF WEBFORGE

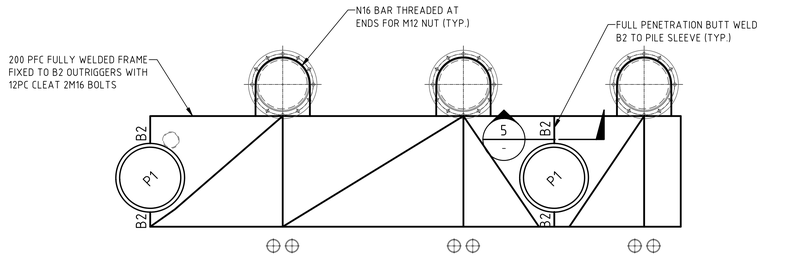


INTERMEDIATE SUPPORT FRAMING PLAN @ 3m CTRS
1:20

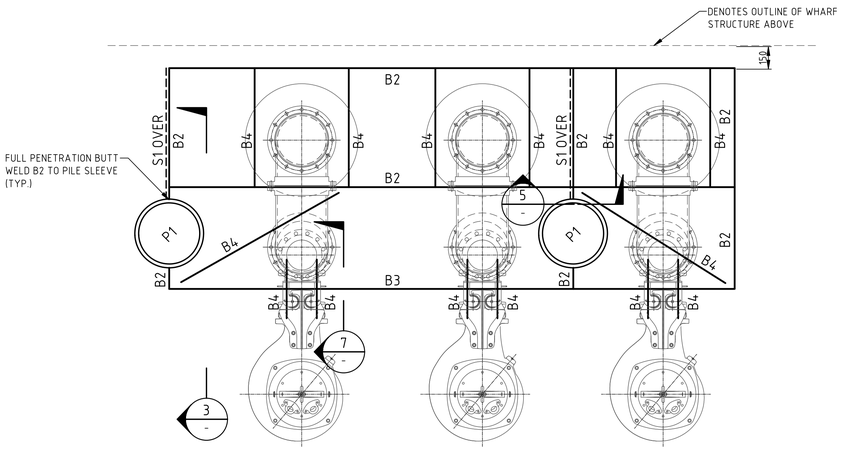


LOWER FRAMING PLAN
1:20

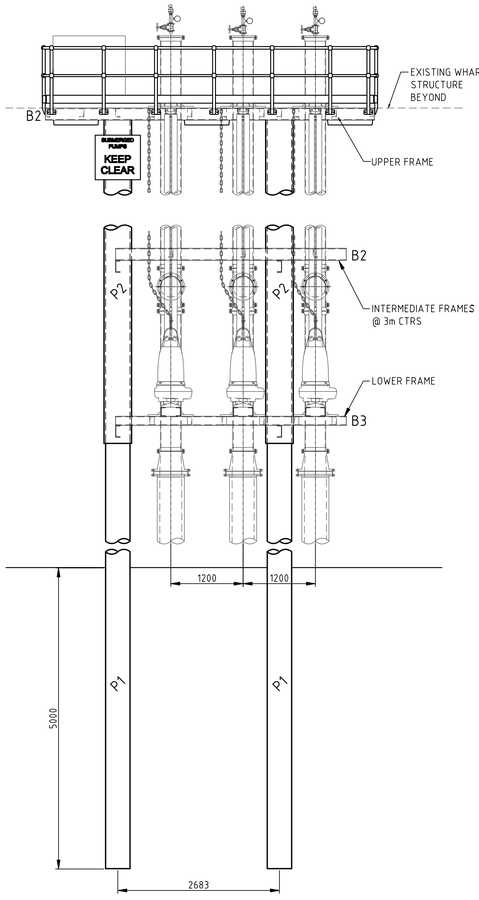


SECTION 1
1:50

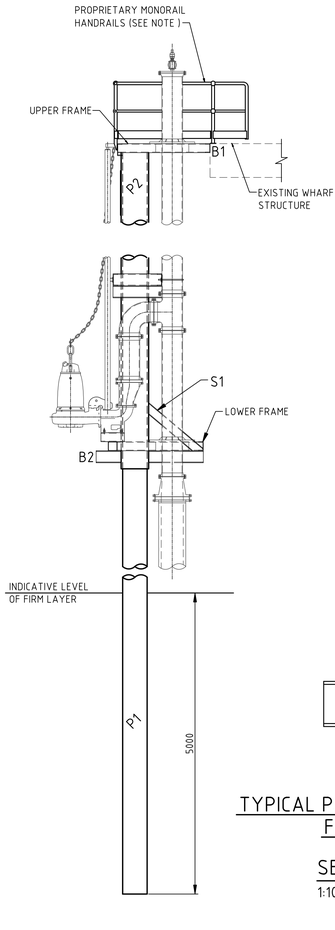

SECTION 2
1:50

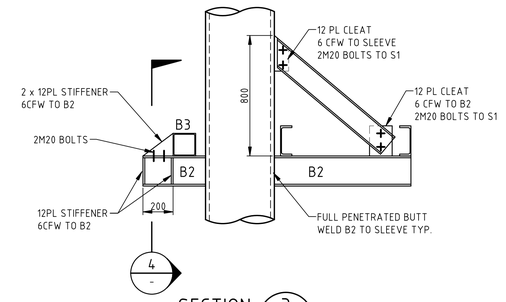


SECTION 3
1:20

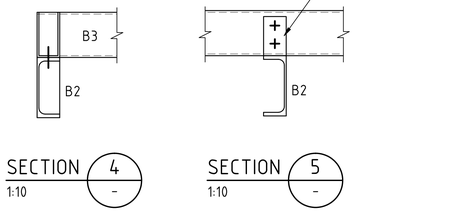


SECTION 4
1:10

SECTION 5
1:10

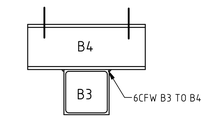

TYPICAL PUMP TO LOWER FRAME FIXING DETAIL

SECTION 7
1:10

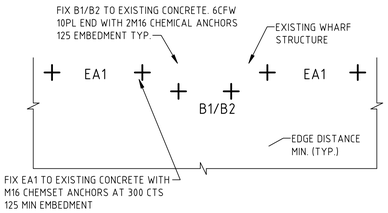

TYPICAL UPPER FRAME TO EXISTING WHARF FIXING DETAIL

SECTION 6
1:10

AS BUILT

COPYRIGHT OF THIS DESIGN IS THE PROPERTY OF CW-DC PTY LTD. THIS AS BUILT DRAWING HAS BEEN PREPARED BASED ON INFORMATION PROVIDED BY MACMAHON. IT HAS NOT BEEN CHECKED OR VERIFIED BY CW-DC.

Rev.	Date	Revision Details	By	Ver.	App.
C	13.01.09	AS BUILT	AH		
B	30.10.06	BEAMS ADDED FOR LIGHTING HATCHES & CABINET MOVED	NLC	RI	RSJ
A	13.10.06	ISSUED FOR CONSTRUCTION (100% ISSUE)	JEK	RI	RSJ

CW-DC Pty Ltd
CW-DC Pty Ltd ABN 66 009 310 169
62 Cavenagh Street (PO Box 919) Darwin
Northern Territory 0800 Australia
Telephone: +61 8 8919 9770
Facsimile: +61 8 8919 9768
Email: cwdrw@cw-dc.com.au

A person using CW-DC Pty Ltd drawings and other data accepts the risk of:
1. using the drawings and other data in electronic form without requesting and checking them for accuracy against the original hard copy versions;
2. using the drawings or other data for any purpose not agreed to in writing by CW-DC Pty Ltd.

Client: MACMAHON

Client: Darwin Cove CONSORTIUM

Project: DARWIN CITY WATERFRONT STAGE 1 COMMUNITY & MARINE INFRASTRUCTURE WORKS
FLUSHING SYSTEM

Drawn	JEK	Signed	JEK	Date	13.10.06
Designed	BWOH	Signed	BWOH	Date	13.10.06
Verified	RI	Signed	RI	Date	13.10.06
Approved	RSJ	Signed	RSJ	Date	13.10.06

Drawing Title: PUMP STATION PLAN AND SECTIONS

CW-DC Project No. JE02.03

Scale 1:5, 1:10, 1:20, 1:50

Drawing No. JE02.03-S0-002 Rev. C

CadFile: P:\JE-Files\JE02 Civil - Marshwater\CAD\Dwg\JE02.03-S0-002.dwg Plot Date: 29/01/09 10:38 Xrefs: \\DRAGSLV-P-FILESRV\...\DRAGSLV-P-FILESRV\...\DRAGSLV-03-A1-TITLE

20 10 0 10 20 30 40 50 100mm