

A1

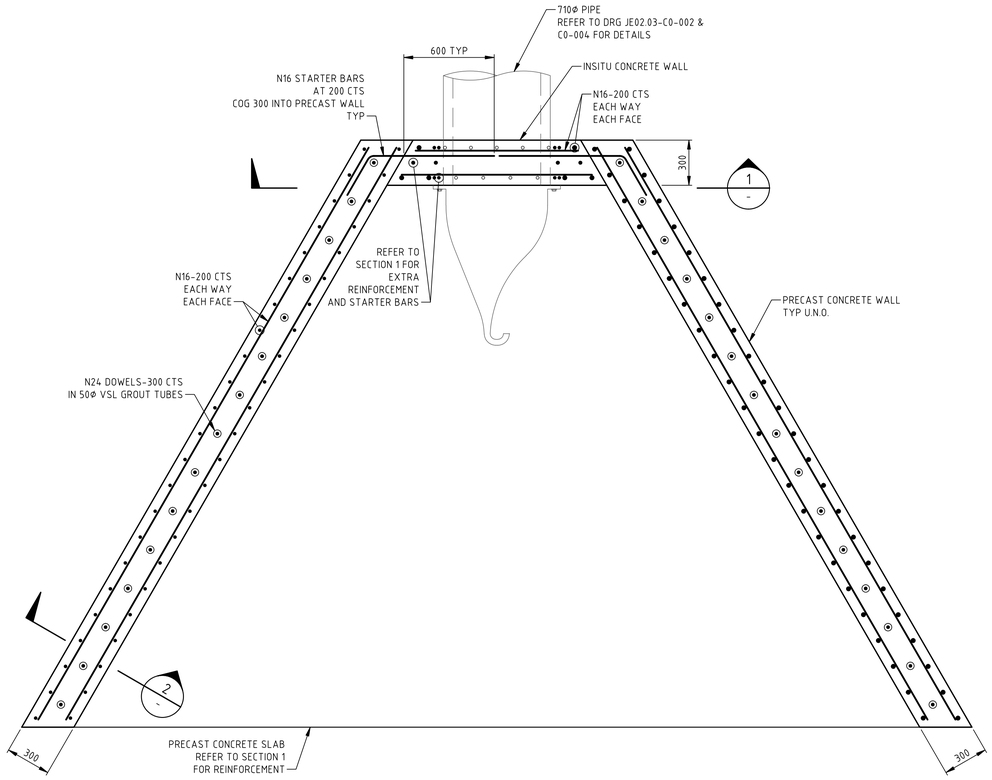


OUTLET HEADWALL PLAN
1:20

SECTION 1
1:20

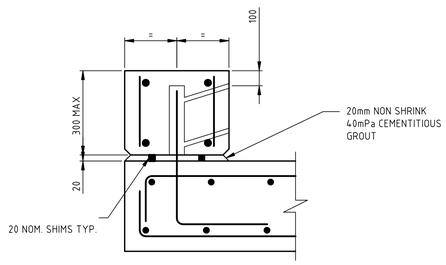


SECTION 2
1:10

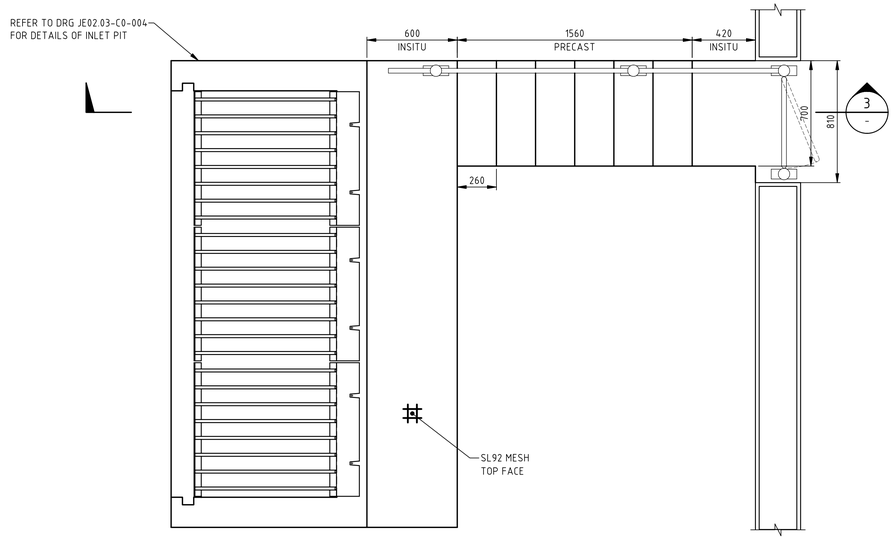

PLAN LAGOON FLUSHING
INLET PIT & STAIRS
1:20

NOTE: DIMENSIONS ARE TO BE CONFIRMED
ON SITE BEFORE MANUFACTURE

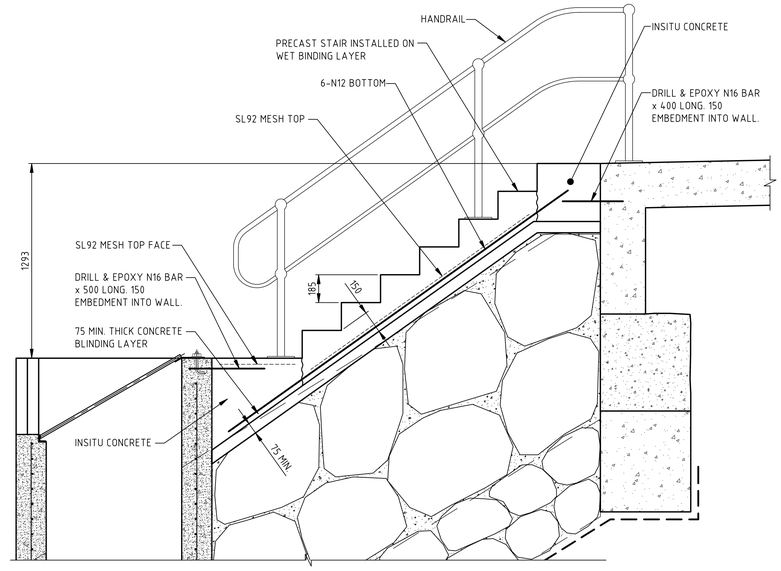

SECTION 3
1:20

50 MPa CONCRETE
50mm COVER TYP.

AS BUILT

COPYRIGHT OF THIS DESIGN IS THE PROPERTY OF CW-DC PTY LTD. THIS AS BUILT DRAWING HAS BEEN PREPARED BASED ON INFORMATION PROVIDED BY MACMAHON. IT HAS NOT BEEN CHECKED OR VERIFIED BY CW-DC.

Rev.	Date	Revision Details	By	Ver.	App.
D	13.01.09	AS BUILT	AH		
C	08.11.06	PIPE DIAMETER REVISED	NLC	DPB	RSJ
B	07.11.06	STAIR DETAILS REVISED	NLC	DPB	RSJ
A	11.08.06	ISSUED FOR CONSTRUCTION (100% ISSUE)	PGE	DPB	RSJ

CW-DC Pty Ltd
CW-DC Pty Ltd ABN 66 009 310 169
62 Cavenagh Street (PO Box 919) Darwin
Northern Territory 0800 Australia
Telephone: +61 8 8919 9770
Facsimile: +61 8 8919 9768
Email: cwdrw@cw-dc.com.au

A person using CW-DC Pty Ltd drawings and other data accepts the risk of:
1. using the drawings and other data in electronic form without requesting and checking them for accuracy against the original hard copy versions;
2. using the drawings or other data for any purpose not agreed to in writing by CW-DC Pty Ltd.

Client: MACMAHON

Client: Darwin Cove CONSORTIUM

Project: DARWIN CITY WATERFRONT STAGE 1 COMMUNITY & MARINE INFRASTRUCTURE WORKS
FLUSHING SYSTEM

Drawn	JEK	Signed	JEK	Date	11.08.06
Designed	BWOH	Signed	BWOH	Date	11.08.06
Verified	DPB	Signed	DPB	Date	11.08.06
Approved	RSJ	Signed	RSJ	Date	11.08.06

Drawing Title: OUTLET HEADWALL DETAILS & LAGOON FLUSHING INLET PIT

CW-DC Project No. JE02.03

Scale 1:20

Drawing No. JE02.03-S0-003 Rev. D

DatFile: P:\JE-Flocs\JE02.03\wip\C - Mechanical\CAD\Dwg\03\JE02.03-S0-003.dwg Plot Date: 20/02/09 09:34 Xrefs: \\DRASSLV-03-A1-TITLE \\DRASSLV-P-BREAKWATER-TYP-SECTIONS

20 10 0 10 20 30 40 50 100mm