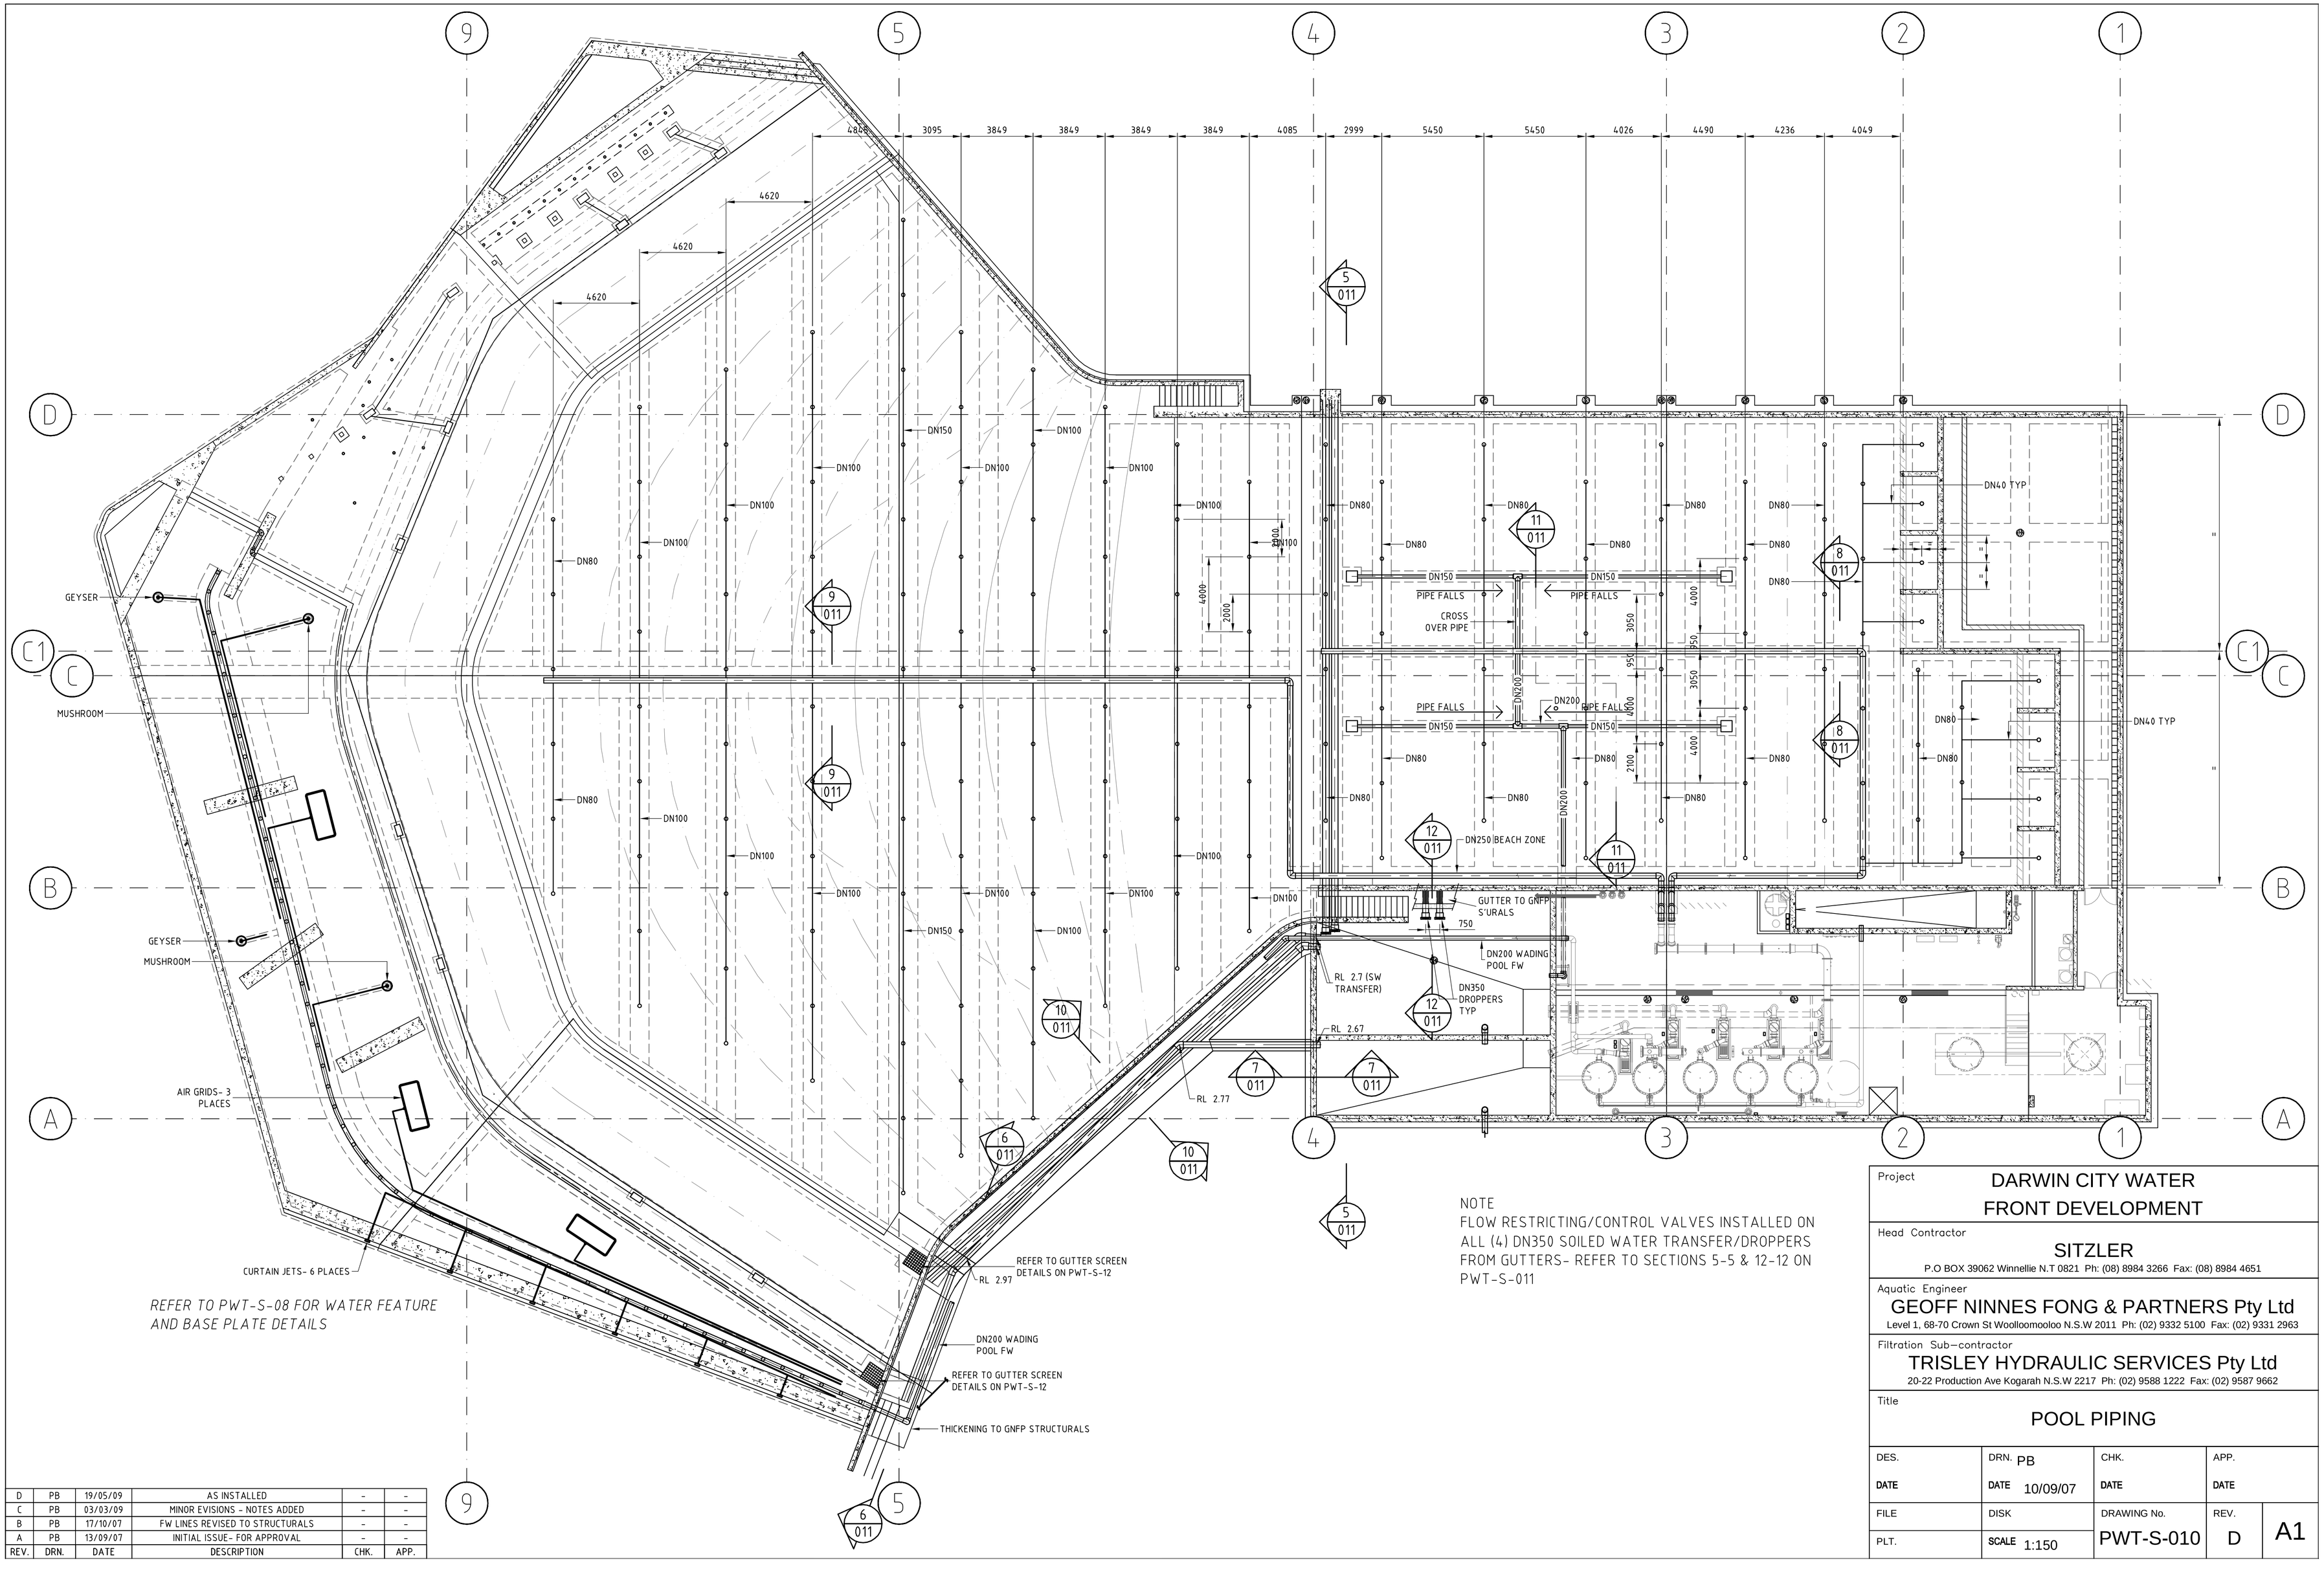


NOTE
FLOW RESTRICTING/CONTROL VALVES INSTALLED ON ALL (4) DN350 SOILED WATER TRANSFER/DROPPERS FROM GUTTERS- REFER TO SECTIONS 5-5 & 12-12 ON PWT-S-011

REV.	DRN.	DATE	DESCRIPTION	CHK.	APP.
D	PB	19/05/09	AS INSTALLED	-	-
C	PB	03/03/09	MINOR EVISIONS - NOTES ADDED	-	-
B	PB	17/10/07	FW LINES REVISED TO STRUCTURALS	-	-
A	PB	13/09/07	INITIAL ISSUE- FOR APPROVAL	-	-

Project
DARWIN CITY WATER FRONT DEVELOPMENT

Head Contractor
SITZLER
P.O BOX 39062 Winnellie N.T 0821 Ph: (08) 8984 3266 Fax: (08) 8984 4651

Aquatic Engineer
GEOFF NINNES FONG & PARTNERS Pty Ltd
Level 1, 68-70 Crown St Woolloomooloo N.S.W 2011 Ph: (02) 9332 5100 Fax: (02) 9331 2963

Filtration Sub-contractor
TRISLEY HYDRAULIC SERVICES Pty Ltd
20-22 Production Ave Kogarah N.S.W 2217 Ph: (02) 9588 1222 Fax: (02) 9587 9662

Title
POOL PIPING

DES.	DRN. PB	CHK.	APP.
DATE	DATE 10/09/07	DATE	DATE

FILE	DISK	DRAWING No.	REV.	
PLT.	SCALE 1:150	PWT-S-010	D	A1