

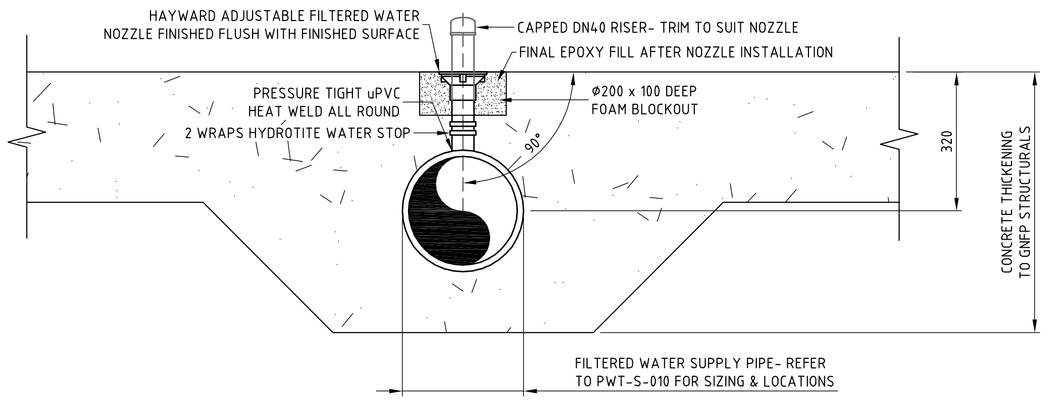



TYPICAL DETAIL
FILTERED WATER RETURN NOZZLE

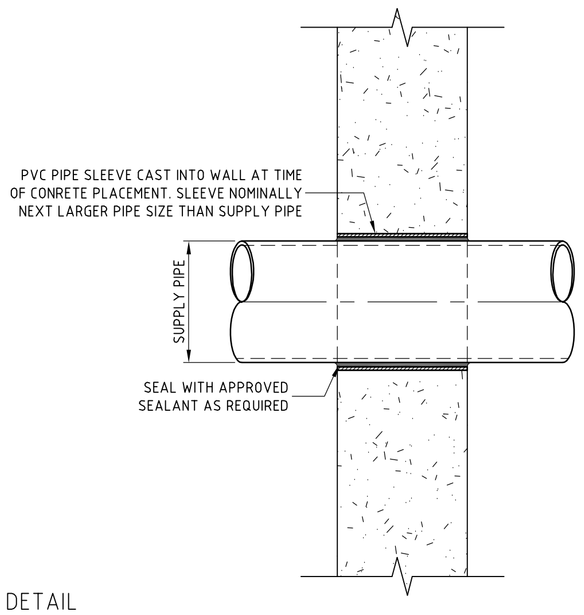

TYPICAL DETAIL
PIPE PASSING THRU NON WATER RETAINING STRUCTURES

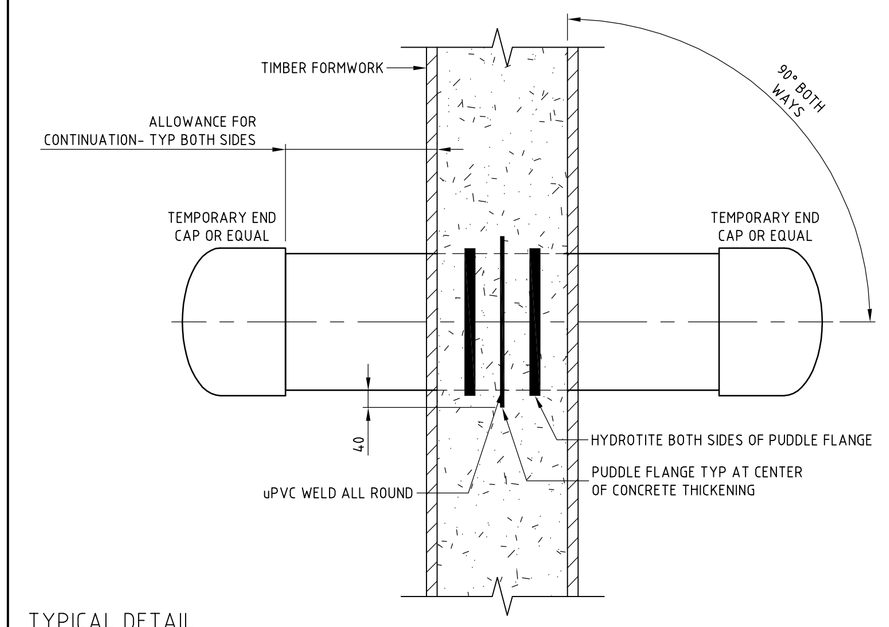

TYPICAL DETAIL
PIPE PASSING THRU WATER RETAINING STRUCTURES (CAST-IN)

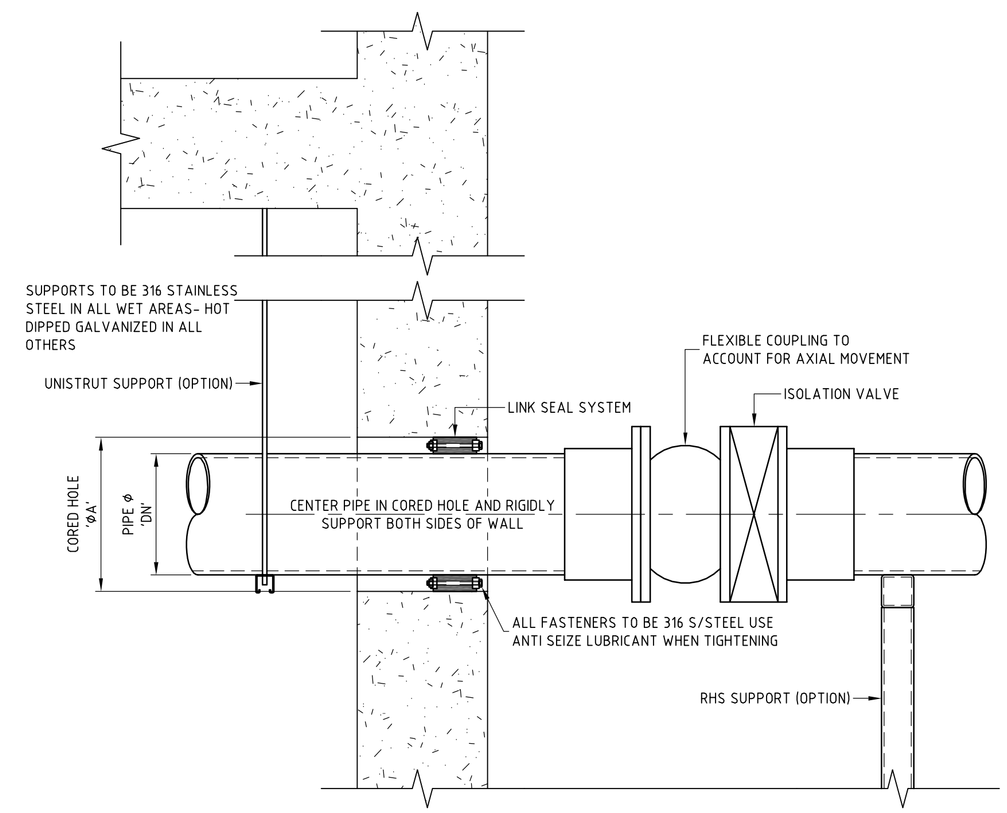


TYPICAL DETAIL
PIPE PASSING THRU WATER RETAINING STRUCTURES (CORED HOLE/LINK SEAL)


PIPE 'DN'	CORED HOLE 'ΦB'	LINK SEAL SIZE	No. LINKS per SEAL
100 (4")	6"	LS-315	10
150 (6")	8"	LS-315	15
200 (8")	10"	LS-475	12
250 (10")	14"	LS-475	14
300 (12")	16"	LS-475	17
350 (14")	18 (14")	LS-360	24


NOTE, DN350 STC


THIS DRAWING IS TO BE READ IN CONJUNCTION WITH NOTES ON GNFP STRUCTURAL DRAWING SP0

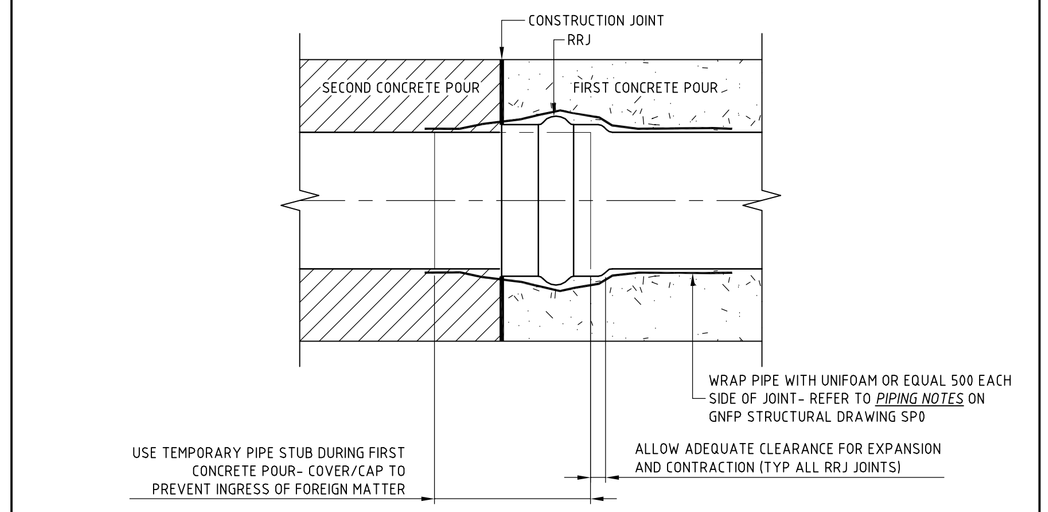

TYPICAL DETAIL
PIPE PASSING THRU CONSTRUCTION JOINTS

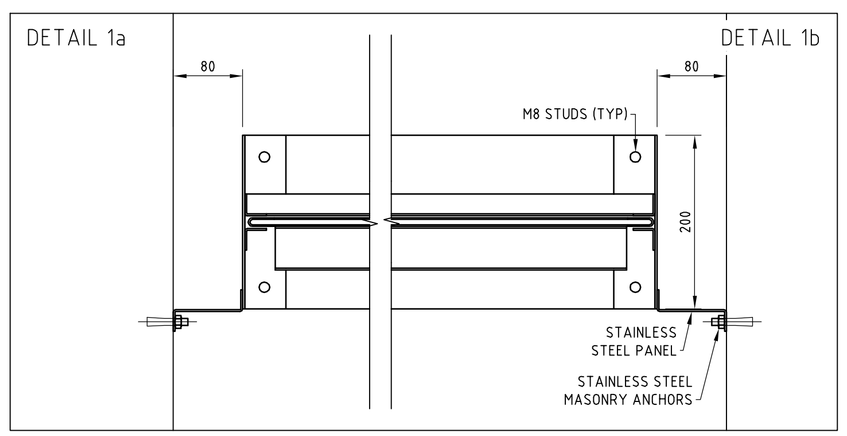

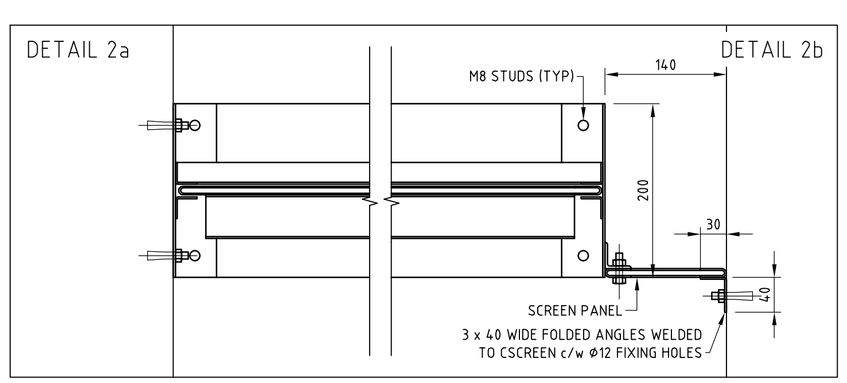

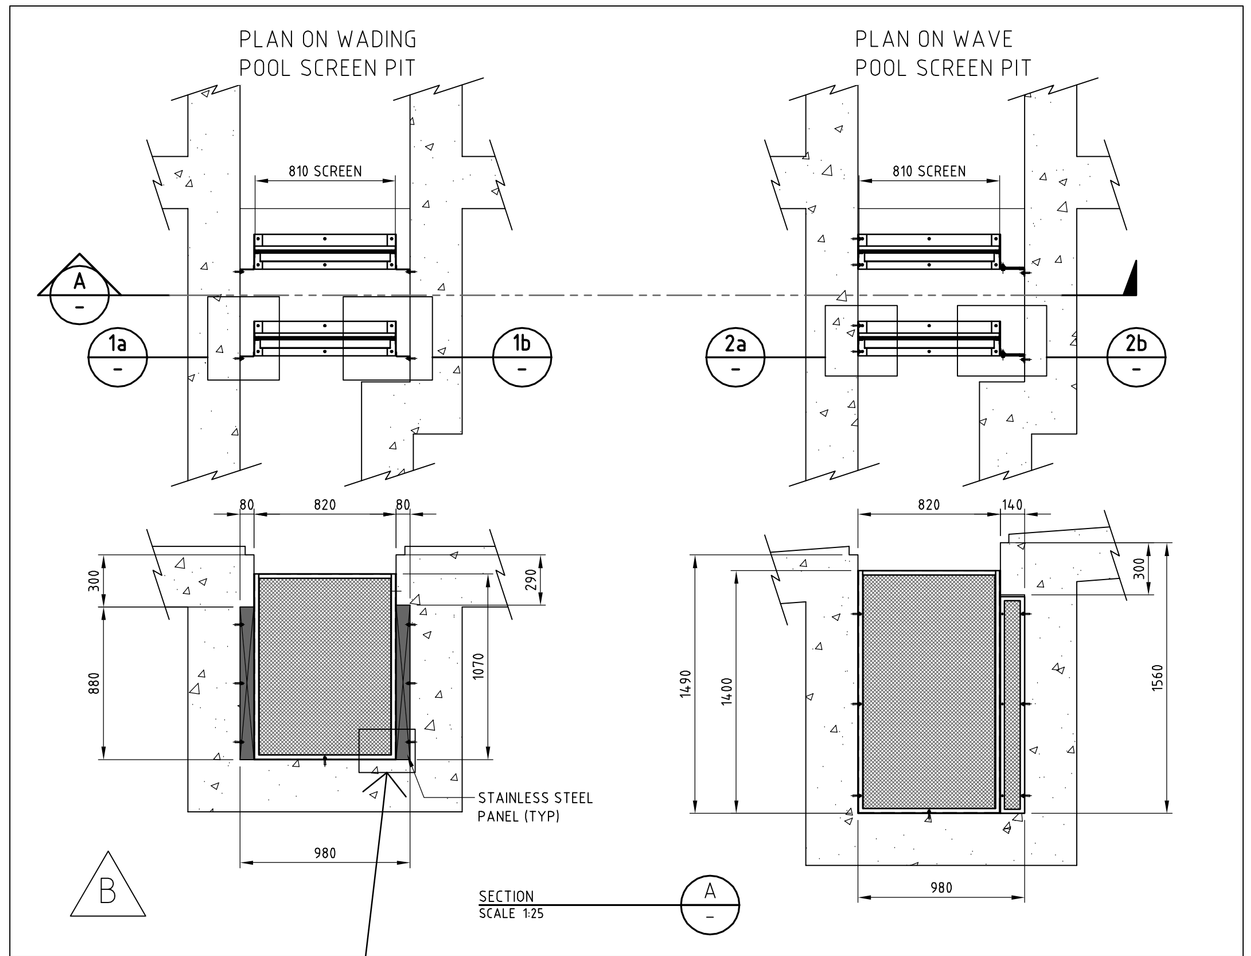

REV.	DRN.	DATE	DESCRIPTION	CHK.	APP.
C	PB	19/05/09	AS INSTALLED	-	-
B	PB	02/04/09	GUTTER SCREEN DETAIL ADDED (FROM PWT-S-09)	-	-
A	PB	13/09/07	INITIAL ISSUE- FOR APPROVAL	-	-

Project
DARWIN CITY WATER FRONT DEVELOPMENT

Head Contractor
SITZLER
P.O BOX 39062 Winnellie N.T 0821 Ph: (08) 8984 3266 Fax: (08) 8984 4651

Aquatic Engineer
GEOFF NINNES FONG & PARTNERS Pty Ltd
Level 1, 68-70 Crown St Woolloomooloo N.S.W 2011 Ph: (02) 9332 5100 Fax: (02) 9331 2963

Filtration Sub-contractor
TRISLEY HYDRAULIC SERVICES Pty Ltd
20-22 Production Ave Kogarah N.S.W 2217 Ph: (02) 9588 1222 Fax: (02) 9587 9662

Title
TYPICAL DETAILS

DES.	DRN. PB	CHK.	APP.
DATE	DATE 10/09/07	DATE	DATE
FILE	DISK	DRAWING No.	REV.
PLT.	SCALE NTS	PWT-S-012	C

A1