
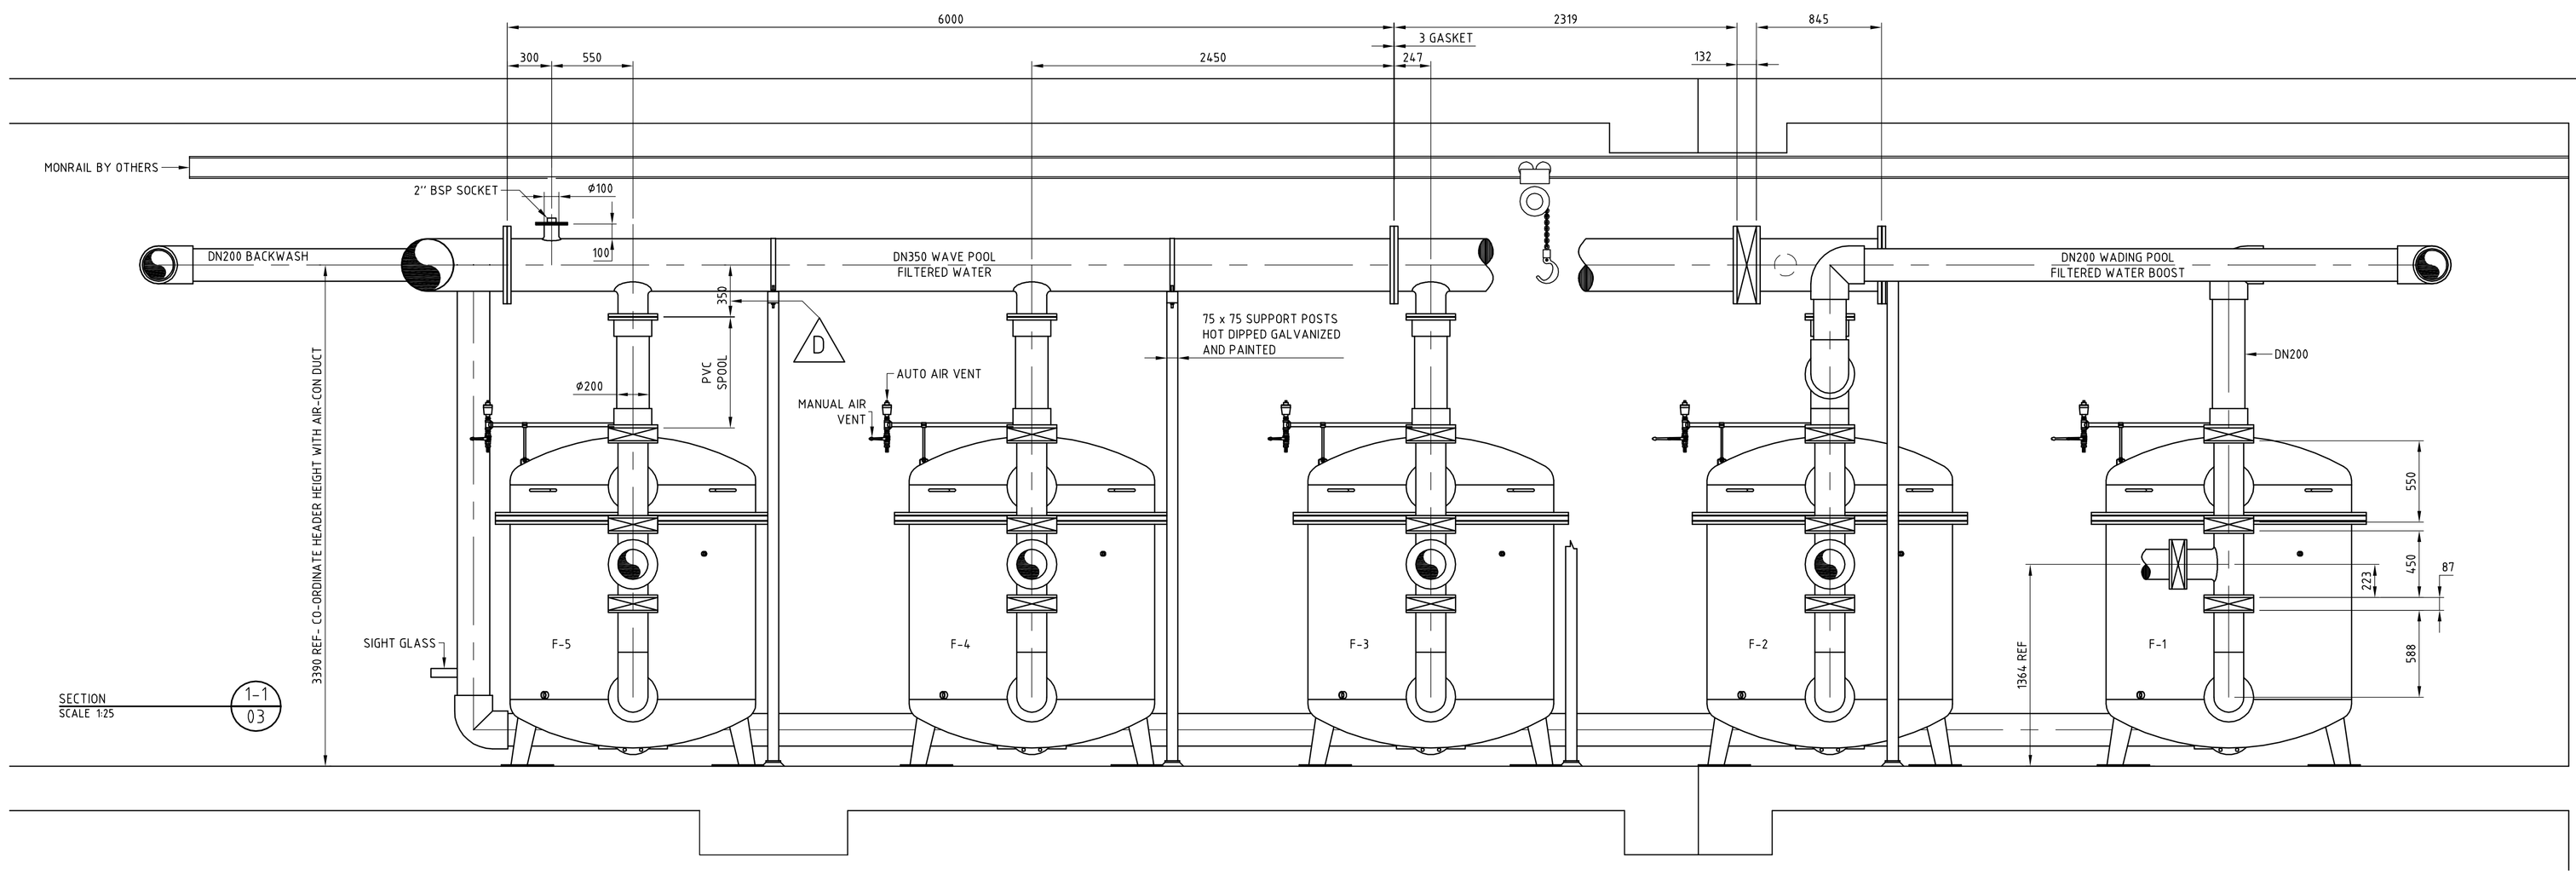


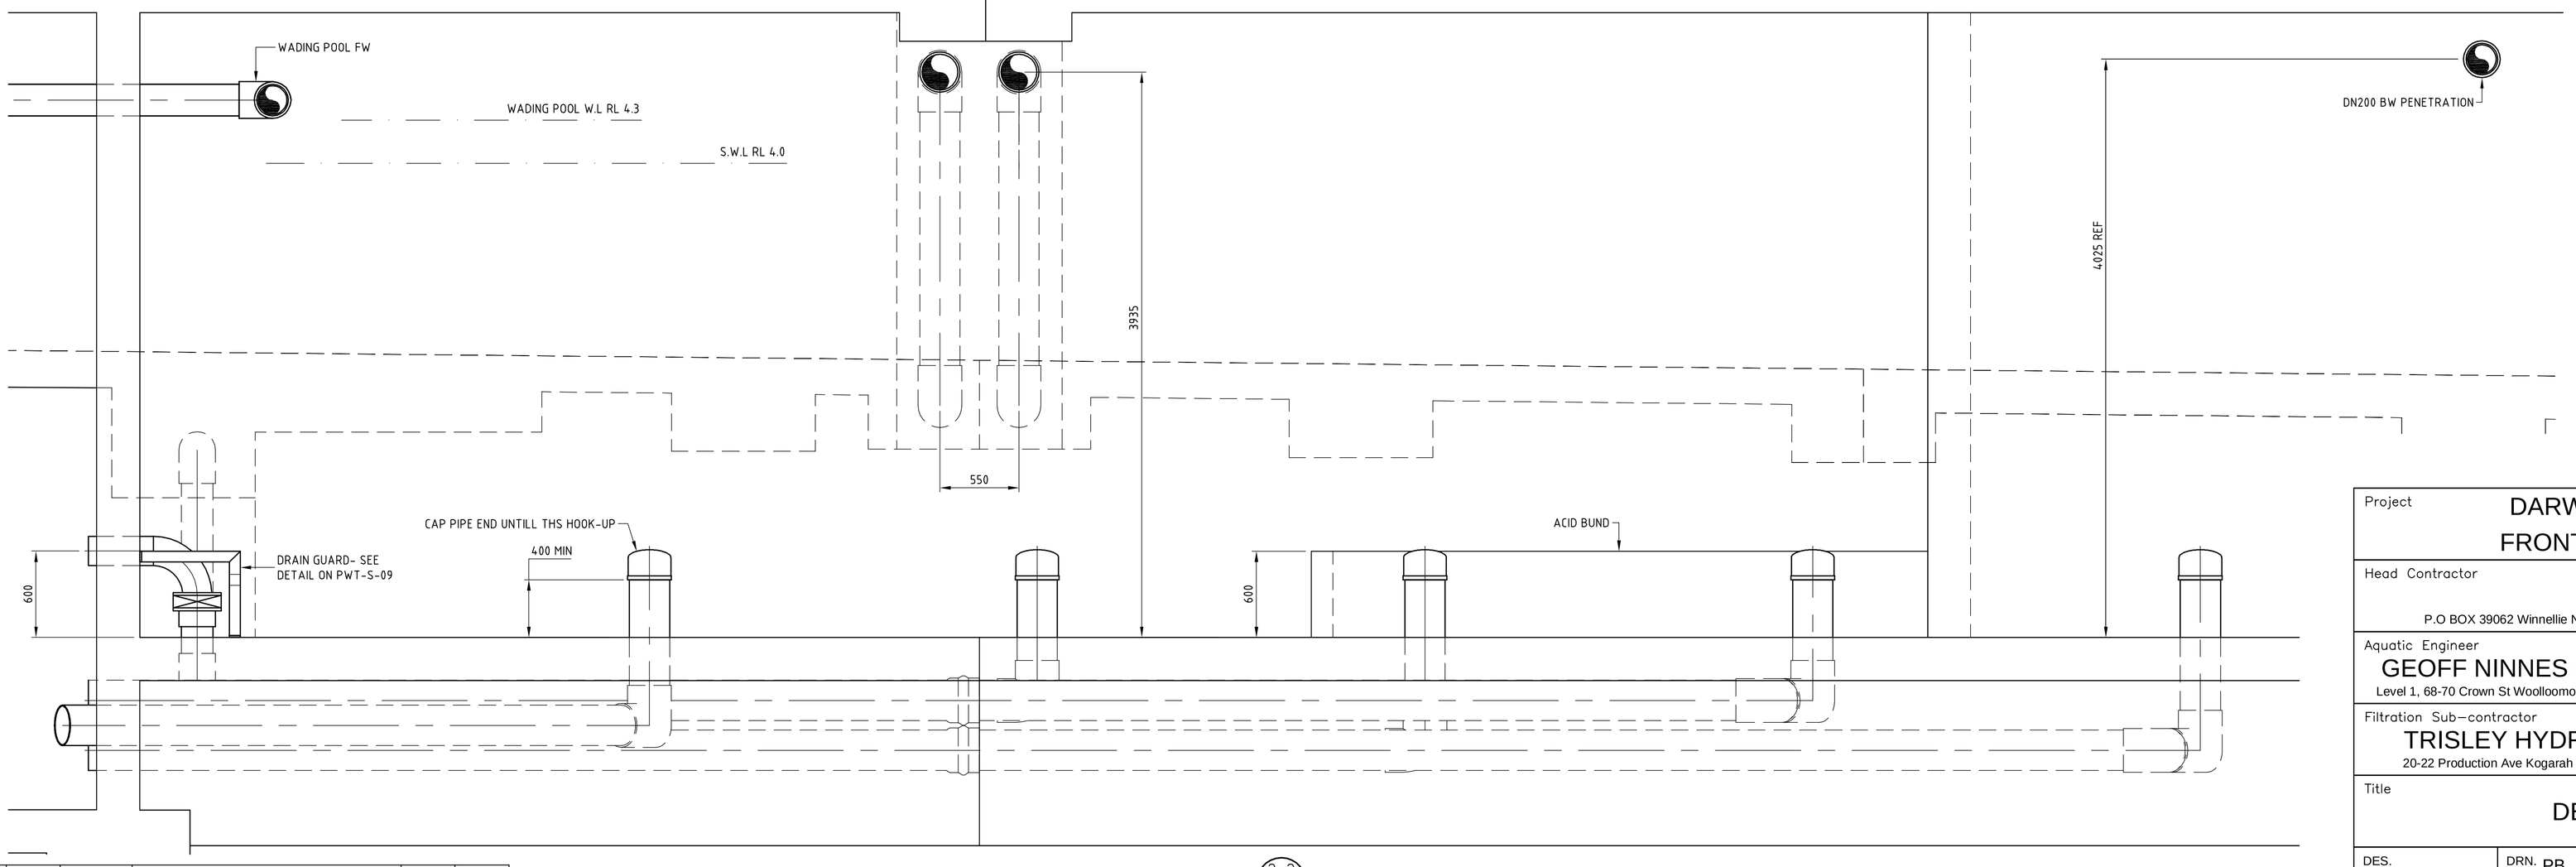

REV.	DRN.	DATE	DESCRIPTION	CHK.	APP.
F	PB	19/05/09	AS INSTALLED	-	-
E	PB	14/12/07	PAINTING NOTE TO POSTS ADDED	-	-
D	PB	22/10/07	DIM REVISED- 400 to 350	-	-
C	PB	11/09/07	WADING POOL FW LINE REROUTED	-	-
B	PB	14/08/07	REVISED TO R.T INSTUCTION	-	-
A	PB	20/06/07	APPROVAL	-	-

Project
DARWIN CITY WATER
FRONT DEVELOPMENT

Head Contractor
SITZLER
P.O BOX 39062 Winnellie N.T 0821 Ph: (08) 8984 3266 Fax: (08) 8984 4651

Aquatic Engineer
GEOFF NINNES FONG & PARTNERS Pty Ltd
Level 1, 68-70 Crown St Woolloomooloo N.S.W 2011 Ph: (02) 9332 5100 Fax: (02) 9331 2963

Filtration Sub-contractor
TRISLEY HYDRAULIC SERVICES Pty Ltd
20-22 Production Ave Kogarah N.S.W 2217 Ph: (02) 9588 1222 Fax: (02) 9587 9662

Title
DETAILS- Sht 1

DES.	DRN.	CHK.	APP.
DATE	PB DATE 20/06/07	DATE	DATE

FILE	DISK	DRAWING No.	REV.	
PLT.	SCALE 1:25	PWT-S-06	F	A1