

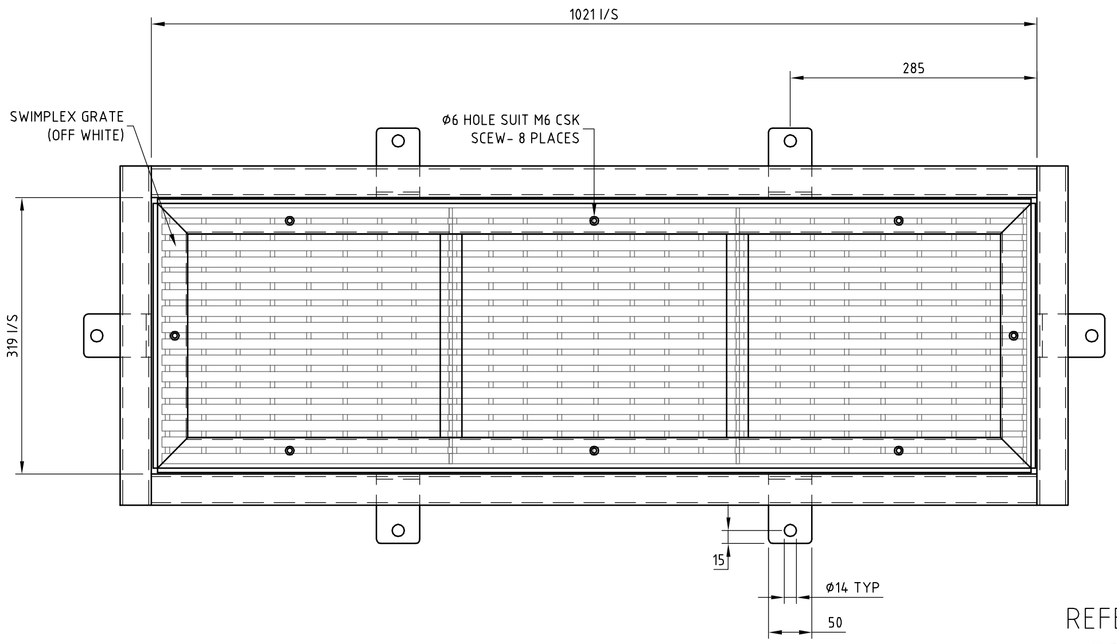



SCUPPER GRATES- 20 PLACES
GRADE 316L STAINLESS STEEL

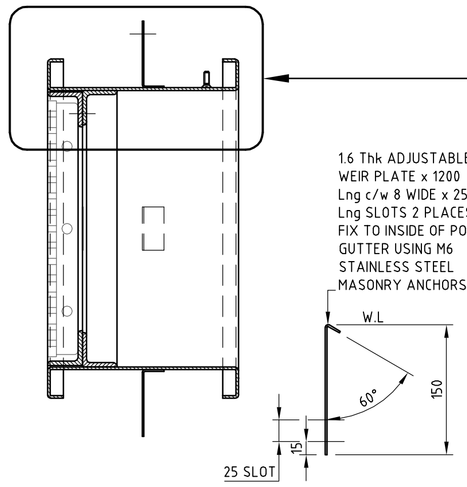


REFER TO PWT-S-09 FOR INSTALLED SCUPPER GRATE/BAFFLE DETAILS (C)

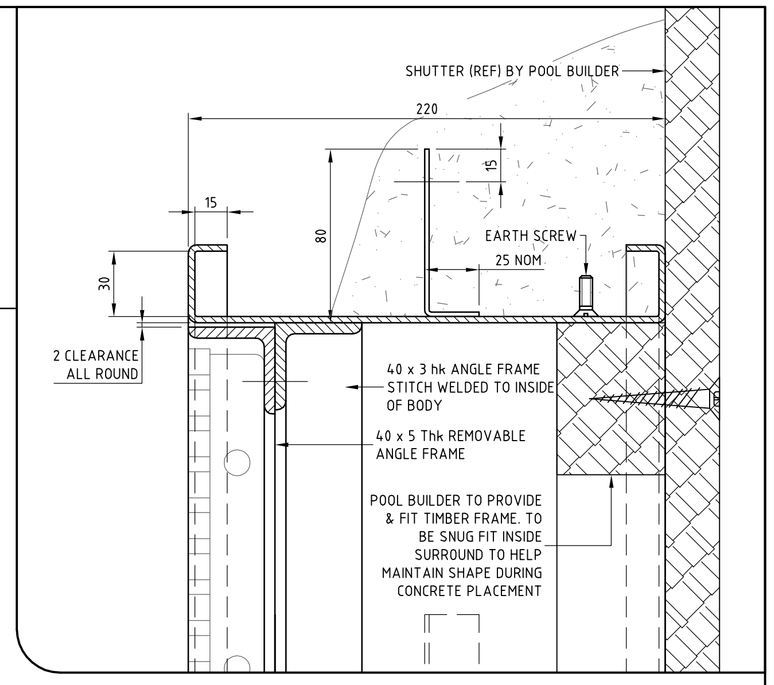

NOTE
CAP ALL SUPPLY LINES DURING CONSTRUCTION AND UNTIL FINAL INSTALLATION TO PREVENT INGRESS OF FOREIGN MATTER INTO PIPE.

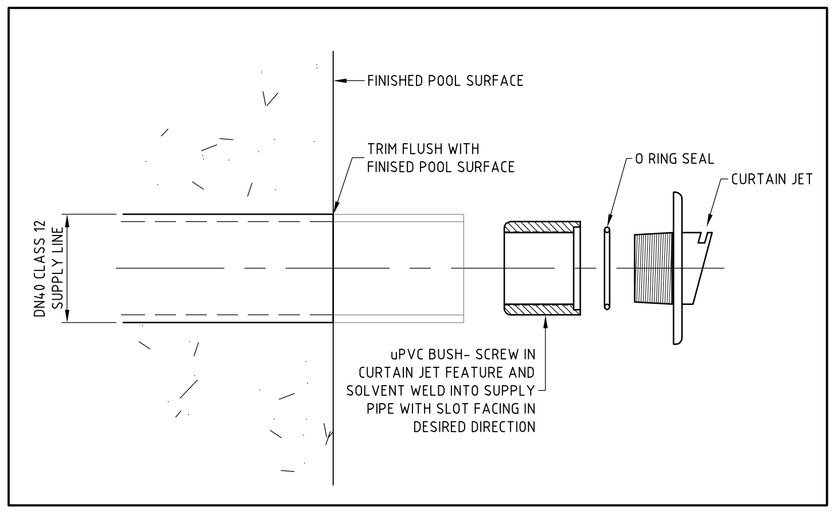



CURTAIN JETS- 6 PLACES

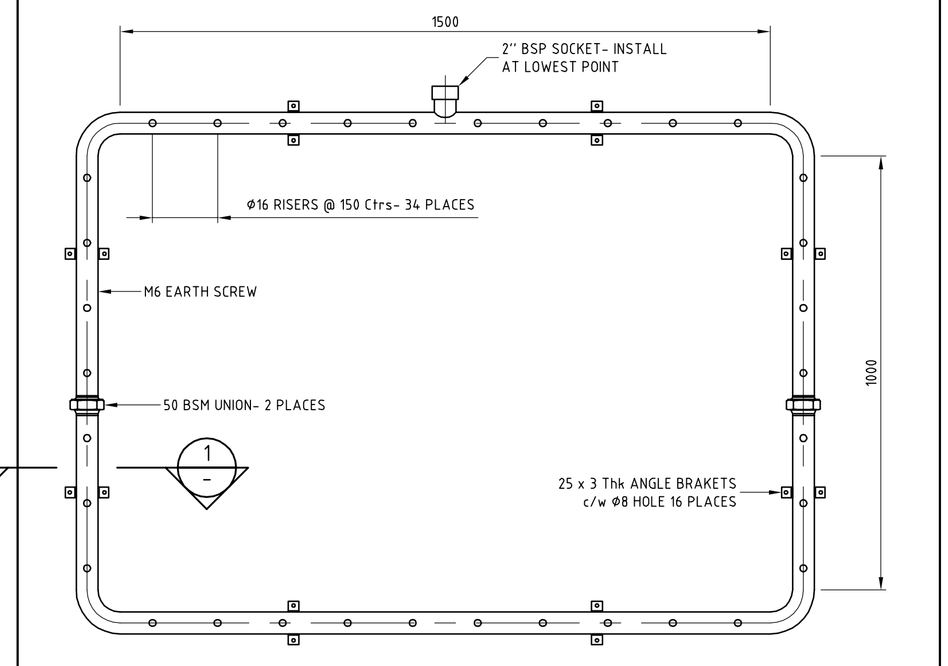


Ø50 AIR GRIDS- 3 PLACES

GEYSER FEATURE &
UNIVERSAL BASE PLATE
2 PLACES

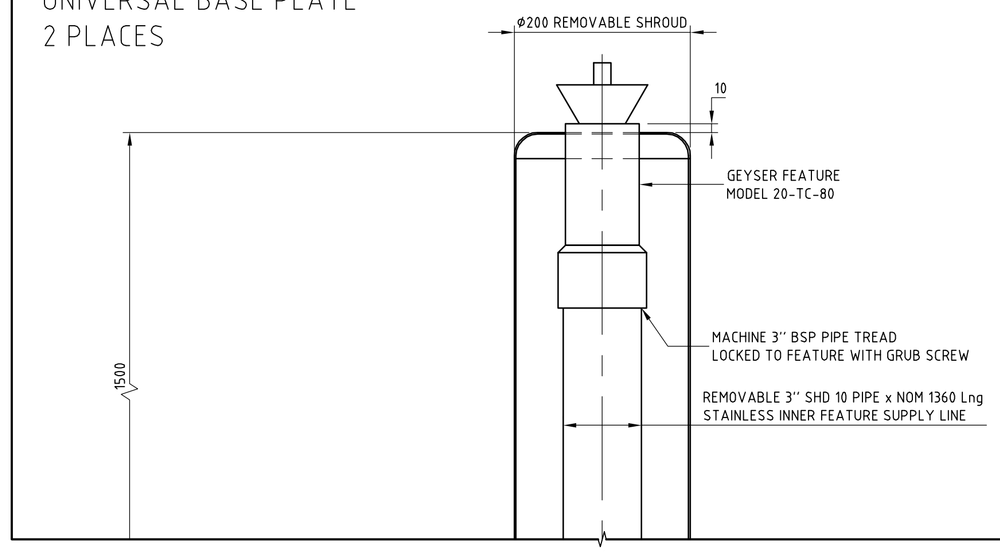


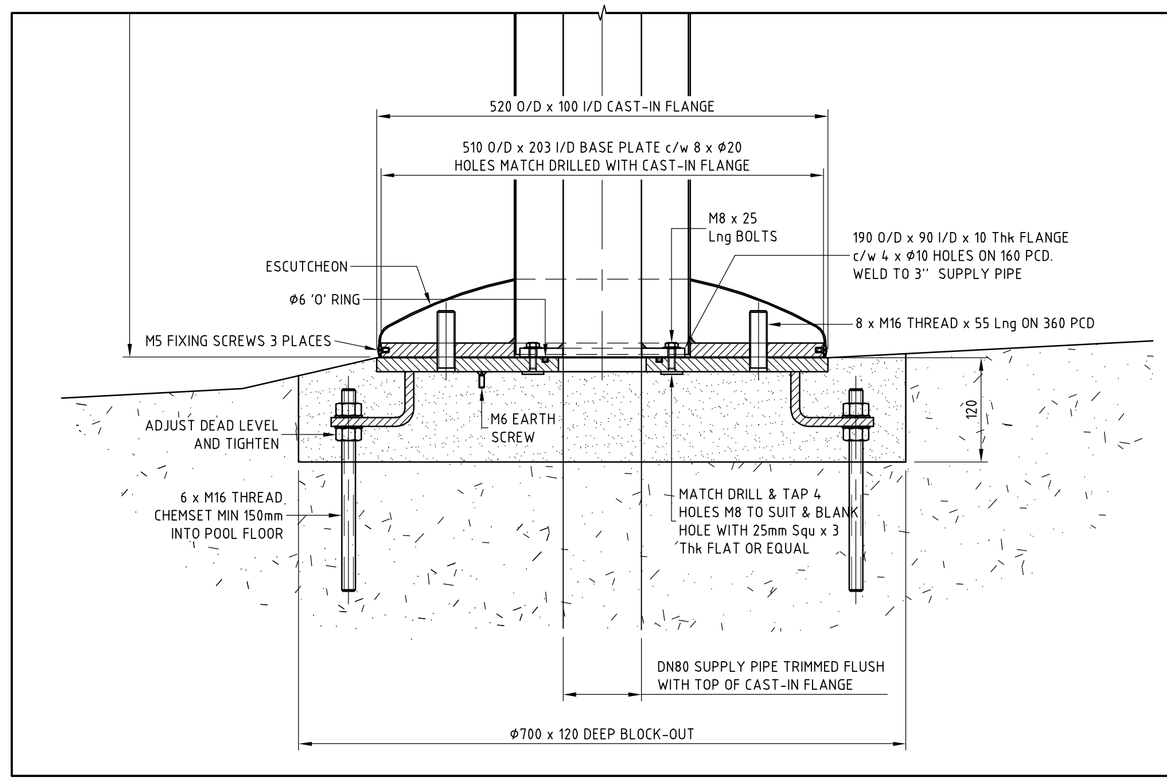

MUSHROOM FEATURE
UNIVERSAL BASE PLATE
2 PLACES

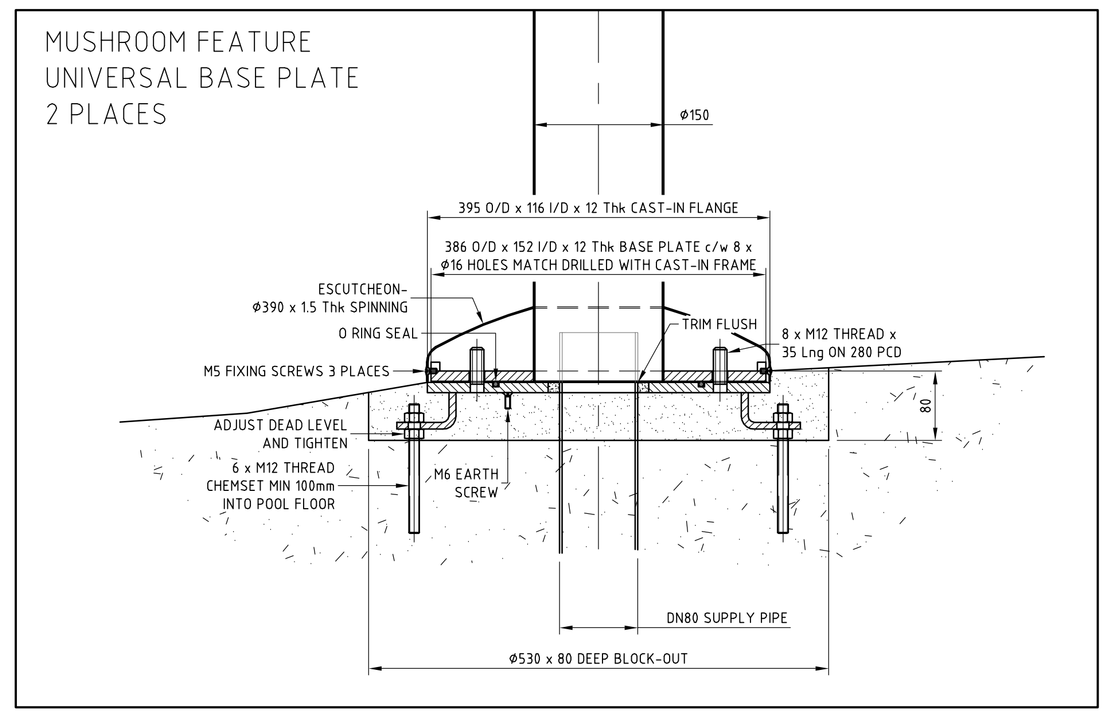

MUSHROOM FEATURE
2 PLACES

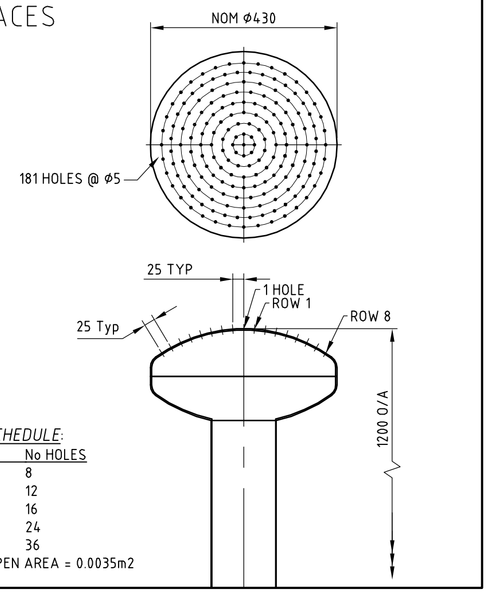

HOLE SCHEDULE:

ROW	No HOLES
1	8
2	12
3	16
4 to 6	24
7 to 8	36

TOTAL OPEN AREA = 0.0035m2

NOTE:
TYPICAL WATER FEATURE FINISH- SATIN POLISHED WITH CLEAR NYCOTE LACQUER FINISH

REV.	DRN.	DATE	DESCRIPTION	CHK.	APP.
D	PB	19/05/09	AS INSTALLED	-	-
C	PB	20/03/09	NOTE ADDED TO SCUPPER DETAIL	-	-
B	PB	03/10/07	FEATURES DETAILED FOR MANUFACTURE	-	-
A	PB	20/06/07	INITIAL ISSUE- FOR APPROVAL	-	-

Project
DARWIN CITY WATER FRONT DEVELOPMENT

Head Contractor
SITZLER
P.O BOX 39062 Winnellie N.T 0821 Ph: (08) 8984 3266 Fax: (08) 8984 4651

Aquatic Engineer
GEOFF NINNES FONG & PARTNERS Pty Ltd
Level 1, 68-70 Crown St Woolloomooloo N.S.W 2011 Ph: (02) 9332 5100 Fax: (02) 9331 2963

Filtration Sub-contractor
TRISLEY HYDRAULIC SERVICES Pty Ltd
20-22 Production Ave Kogarah N.S.W 2217 Ph: (02) 9588 1222 Fax: (02) 9587 9662

Title
DETAILS- Sht 3

DES.	DRN. PB	CHK.	APP.
DATE	DATE 20/06/07	DATE	DATE

FILE	DISK	DRAWING No.	REV.	
PLT.	SCALE Noted	PWT-S-08	D	A1