


| REV. | DRN. | DATE | DESCRIPTION | CHK. | APP. |
|---|---|---|---|---|---|
| A | PB | 20/06/07 | INITIAL ISSUE- FOR APPROVAL | - | - |
| B | PB | 12/09/07 | DRAIN GUARD DETAILED<br>REVISED TO ENGINEERS INSTRUCTION | - | - |
| C | PB | 03/10/07 | NOTES ADDED TO LEAF SCREENS | - | - |
| D | PB | 20/03/09 | INSTALLED SCUPPER GRATE/BAFFEL DETAILED<br>LEAF SCREEN DETAIL MOVED TO PWT-S-012 | - | - |
| E | PB | 19/05/09 | AS INSTALLED | - | - |

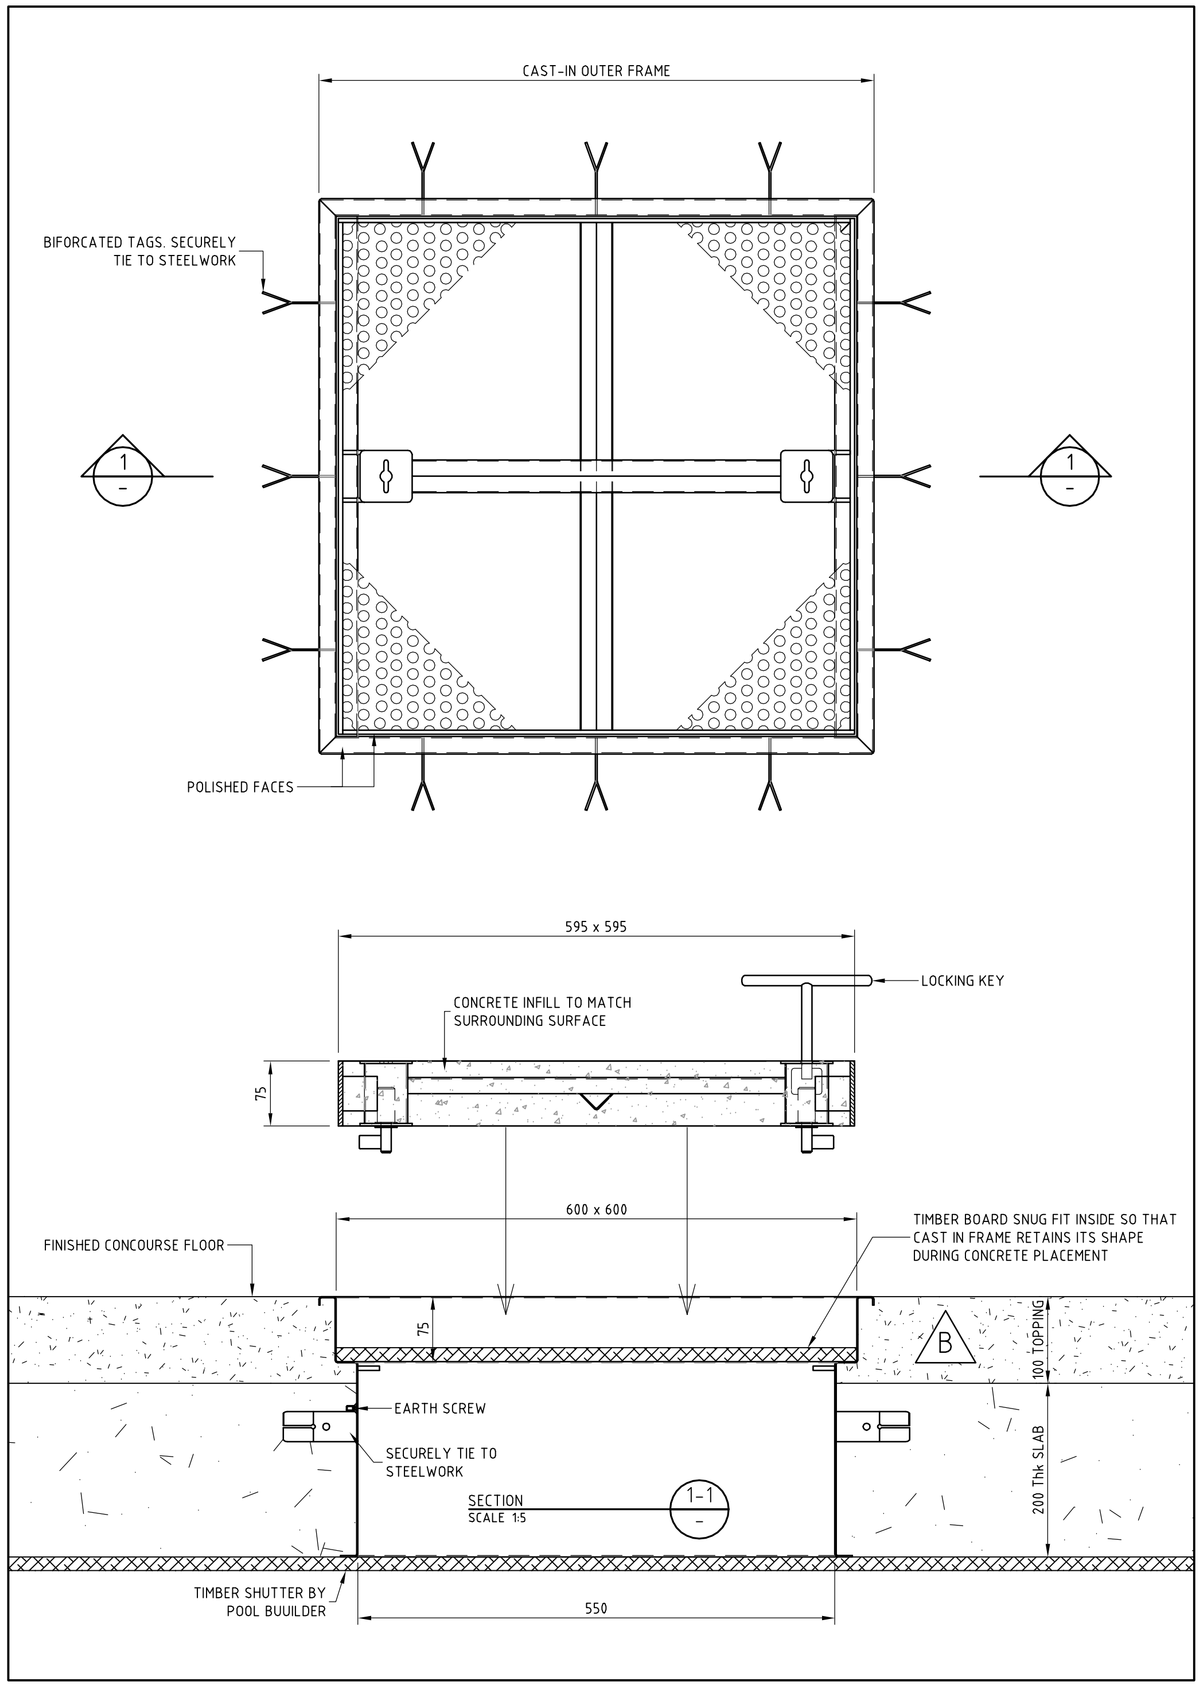



LOCKABLE DECK HATCHES-
6 PLACES

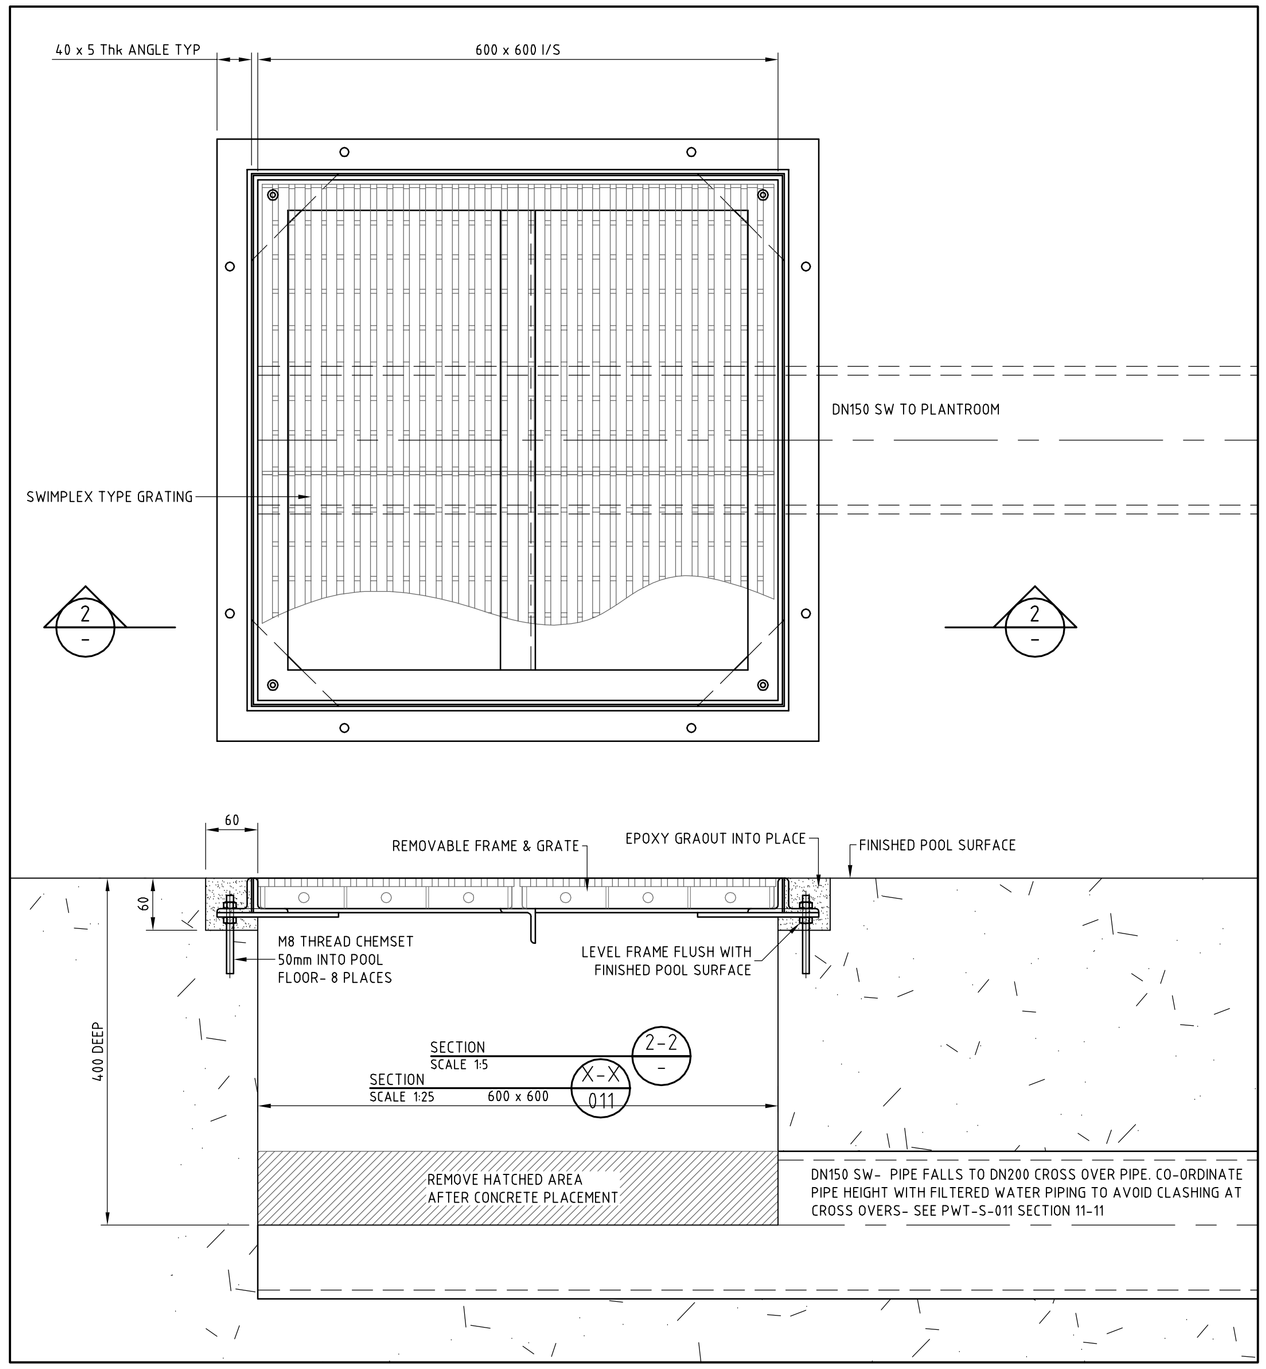



MAIN DRAIN FRAME & GRATES-
4 PLACES

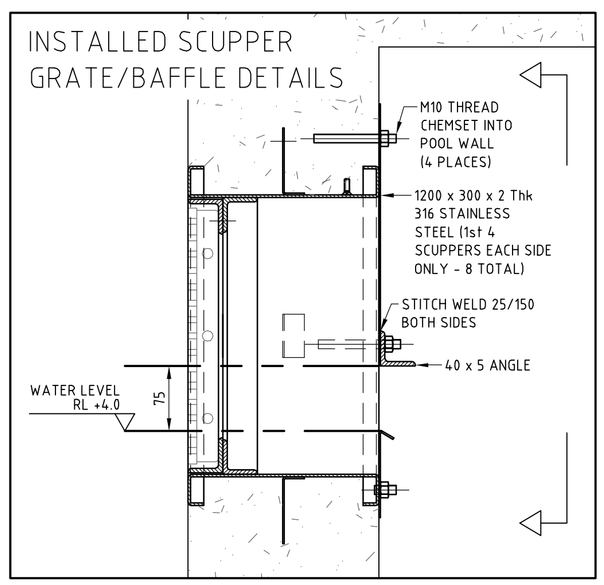

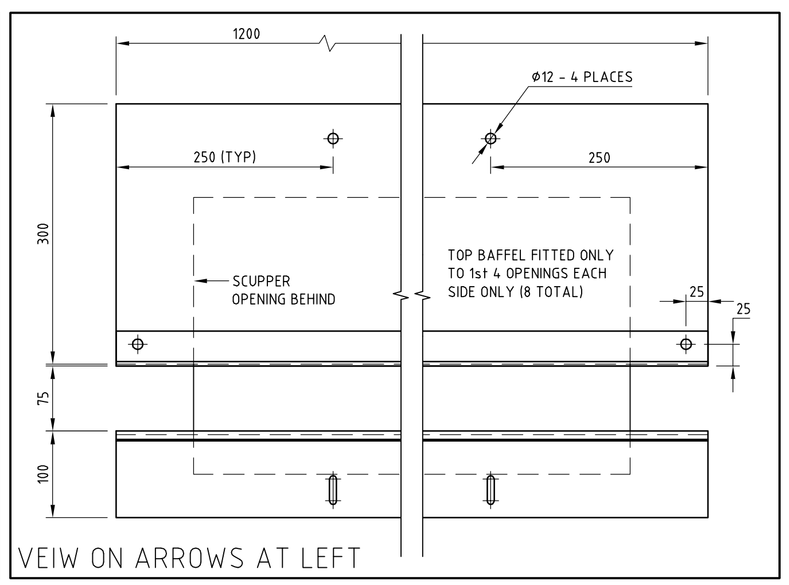
VEIW ON ARROWS AT LEFT

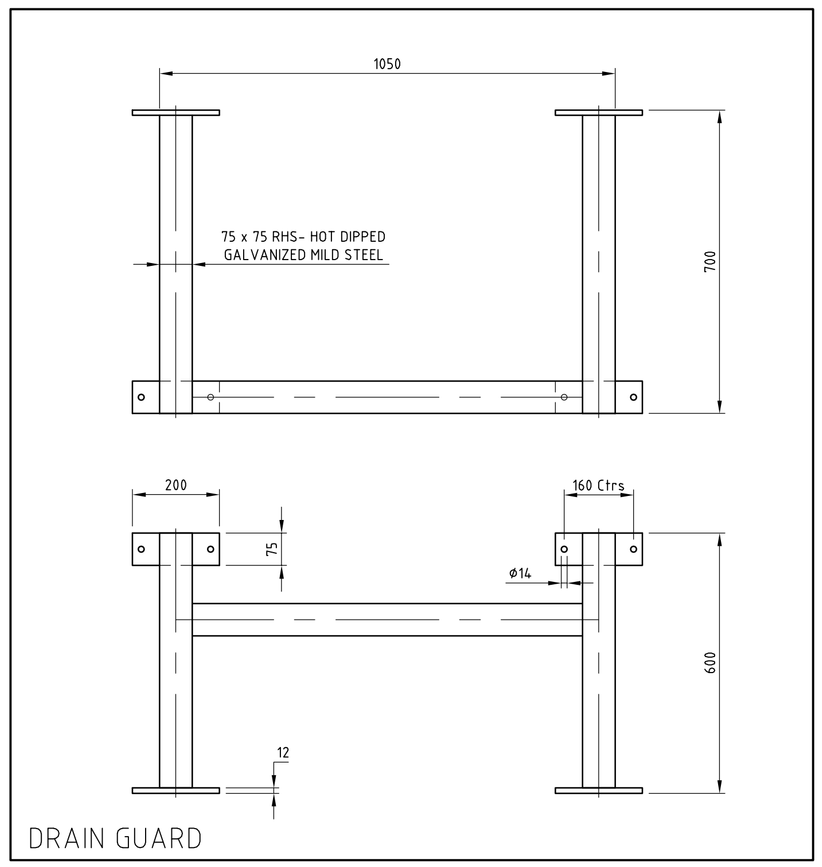


DRAIN GUARD

| | |
|---|---|
| Project | DARWIN CITY WATER FRONT DEVELOPMENT |
| Head Contractor | SITZLER<br>P.O BOX 39062 Winnellie N.T 0821 Ph: (08) 8984 3266 Fax: (08) 8984 4651 |
| Aquatic Engineer | GEOFF NINNES FONG & PARTNERS Pty Ltd<br>Level 1, 68-70 Crown St Woolloomooloo N.S.W 2011 Ph: (02) 9332 5100 Fax: (02) 9331 2963 |
| Filtration Sub-contractor | TRISLEY HYDRAULIC SERVICES Pty Ltd<br>20-22 Production Ave Kogarah N.S.W 2217 Ph: (02) 9588 1222 Fax: (02) 9587 9662 |
| Title | DETAILS- Sht 4 |

| | | | | |
|---|---|---|---|---|
| DES.<br>DATE | DRN. PB<br>DATE 20/06/07 | CHK.<br>DATE | APP.<br>DATE | |
| FILE | DISK | DRAWING No. | REV. | A1 |
| PLT. | SCALE Noted | PWT-S-09 | E | |